



DEPARTMENT OF THE ARMY
BLUE GRASS ARMY DEPOT
431 BATTLEFIELD MEMORIAL HIGHWAY
RICHMOND, KENTUCKY 40475-5060

24915-00-TKD-GGPT-20010

OPSEC Reviewed by RWR – No sensitive information was discovered

REPLY TO
ATTENTION OF:

February 20, 2014

Environmental Office

Commonwealth of Kentucky
Department for Environmental Protection
Division of Waste Management, Hazardous Waste Branch
ATTN: April J. Webb, P.E., Manager
200 Fair Oaks Lane, 2nd Floor
Frankfort, KY 40601

This document has been reviewed for
ITAR/EAR and no ITAR/EAR sensitive
information was found.

Subject: RCRA Research, Development & Demonstration Permit Revision 5

RE: RCRA RD&D Revision 5 Submission, 24915-000-GPE-GGPT-00001
Blue Grass Chemical Agent-Destruction Pilot Plant (BGCAPP)
Blue Grass Army Depot, Richmond, Kentucky
EPA ID # KY8-213-820-105, AI 2805

Dear Mrs. Webb:

Attached is the RCRA RD&D Revision 5 submission. This submission is considered OPSEC sensitive and is being provided in hard copy for your review. Per our earlier discussions, this document is to be managed as Operations Security Sensitive due to the information contained within the document and is not for public release. A redacted version is also being submitted in both electronic and hard copy, which will be available for unrestricted release to the public. Bechtel Parsons Blue Grass appreciates your cooperation with this matter and looks forward to your comments on the document.

If you have any questions or require additional information, please do not hesitate to contact BGAD / BPBG Environmental Offices: Mr. Ramesh Melarkode at (859) 779-6268, or Mr. John McArthur at (859) 625-6447.

"I certify under penalty of law that this document and all attachments were prepared under my direction or supervision in accordance with a system designed to assure that qualified personnel properly gather and evaluate the information submitted. Based on my inquiry of the person or persons directly responsible for gathering the information, the information submitted is, to the best of my knowledge and belief, true, accurate and complete. I am aware that there are significant penalties for submitting false information, including the possibility of fine and imprisonment for knowing violations."

Sincerely,



Doug Omichinski
Project Manager
Bechtel Parsons Blue Grass
BGCAPP Operator



Lee G. Hudson
COL, LG
Commanding
BGCAPP Owner

Enclosure

Copies Furnished:

John McArthur, BPBG
Jeff Brubaker, PEO-ACWA
Amy McCracken, KDEP-DWM

Jeff Krejsa, PEO-ACWA
Ramesh Melarkode, BGAD



Blue Grass Chemical Agent-Destruction Pilot Plant (BGCAPP)

Environmental Document

Research, Development, and Demonstration (RD&D) Permit Application

Contract W52P1J-09-C-0013
CDRL #A010

24915-000-GPE-GGPT-00001

This document did contain Operations Security (OPSEC) sensitive information. All OPSEC sensitive material has been removed. Information removed has been replaced with "(SENSITIVE INFORMATION REMOVED)" or the abbreviation "(SIR)." Persons with a need to know may apply to the Blue Grass Chemical Agent Destruction Pilot Plant Site Manager for release of sensitive information.

13 MAR 2014
Rev. 5 REWRITE
Final Page Is 181

prepared by
Bechtel Parsons Blue Grass Team (BPBGT)

prepared for
Program Executive Office –
Assembled Chemical Weapons Alternatives (PEO ACWA)

Rev.	Date	Issued for	Changes
5	13 MAR 2014	Approval	
4	JUN 2007	Use	

Electronic documents, once printed, are uncontrolled and may become outdated. Refer to the electronic document in InfoWorks for the current revision.

**24915-000-GPE-GGPT-00001 – RESEARCH, DEVELOPMENT, AND DEMONSTRATION (RD&D) PERMIT
APPLICATION CDRL #A010**

Approval:



Doug Omichinski, Project Manager



Rick Goetz, Deputy Project Manager

Date:

5-MAR-14

March 5, 2014

**24915-000-GPE-GGPT-00001 – RESEARCH, DEVELOPMENT, AND DEMONSTRATION (RD&D) PERMIT
APPLICATION CDRL #A010**

**Blue Grass Chemical Agent-Destruction Pilot Plant
Resource Conservation and Recovery Act
Research Demonstration & Development Permit Application
Revision 5**



Submitted To:
Energy and Environment Cabinet
Kentucky Department for Environmental Protection
Division of Waste Management
200 Fair Oaks Lane, 2nd Floor
Frankfort, Kentucky 40601

Submitted By:
Blue Grass Army Depot
431 Battlefield Memorial Highway
Richmond, Kentucky 40475-5060
and
Bechtel Parsons Blue Grass
830 Eastern Bypass, Suite 106
Richmond, Kentucky 40475



VOLUME 1

Date: 13 MAR 2014

Final Page Is 181

**24915-000-GPE-GGPT-00001 – RESEARCH, DEVELOPMENT, AND DEMONSTRATION (RD&D) PERMIT
APPLICATION CDRL #A010**

Table of Contents

1
2
3 Acronyms/Abbreviations 8
4 Executive Summary 12
5 1.0 Waste Description 29
6 1.1 Type and Quantity of Waste to be Processed 29
7 1.1.1 GB 115-mm Rockets 29
8 1.1.2 GB 8-Inch Projectiles 29
9 1.1.3 Energetics 29
10 1.1.4 Munitions Quantities and Agent Weights 30
11 1.2 Physical Description of Waste to be Processed 30
12 1.2.1 Waste Description 30
13 1.2.2 Projectiles 31
14 1.2.3 M55 Chemical Rocket Assembly 32
15 1.2.4 Secondary Wastes 34
16 1.2.5 Process Wastes Generated During GB Campaign 35
17 2.0 Process Engineering 39
18 2.1 Facility Description 39
19 2.1.1 Building and Structure Definitions 39
20 2.1.2 Buildings and Structures Containing Hazardous Waste Management Units 40
21 2.1.3 MDB Cascade HVAC System Description 41
22 2.1.4 Laboratory Filtration 43
23 2.1.5 Buildings and Structures Not Containing Hazardous Waste Management Units
24 (HWMUs) 43
25 2.1.6 Plant Systems and Subsystems Not Containing Hazardous Waste Management
26 Units 46
27 2.2 Construction Sequence 47
28 2.2.1 Site Preparation 47
29 2.2.2 Construction Sequence 47
30 2.2.3 Environmental Compliance During Construction 48
31 2.3 Facilities Construction Certification 49
32 2.4 Systemization 49
33 2.5 Performance of the RD&D Program – Pilot Testing 49
34 2.5.1 Quantities of Waste to be Treated 51
35 2.5.2 Testing Schedule and Criteria for Increasing Processing Rates 52
36 2.6 Operation Subject to Regulation by KHW Part B Permit 52
37 3.0 Research Plan 54
38 3.1 Pertinent Information for Proposed Operation of Experimental Waste Facility/Process 54
39 3.2 Objective Statement & Experimental Design 56

**24915-000-GPE-GGPT-00001 – RESEARCH, DEVELOPMENT, AND DEMONSTRATION (RD&D) PERMIT
APPLICATION CDRL #A010**

1	3.2.1	Justification for Research	56
2	3.2.2	Process Description.....	61
3	3.2.3	Performance Criteria.....	66
4	3.3	Operating Parameters Monitoring & Frequency.....	69
5	3.3.1	Performance Test Plan.....	69
6	3.3.2	99.9999 Percent DE Demonstration Testing.....	70
7	3.3.3	Waste Processing Sequences.....	71
8	3.3.4	Munitions Unpacking	75
9	3.4	Environmental Parameters Monitoring and Frequency.....	85
10	3.4.1	Groundwater Protection Plan--Groundwater Monitoring [401 KAR 34:060, Section 1 & 40 CFR 264.90(b)(2)]	85
11			
12	3.4.2	RCRA Organic Air Emissions	85
13	3.4.3	Environmental Protection Standards Compliance.....	88
14	3.5	Monitoring Methods, Regulatory Determinations and Sampling and Analytical Procedures.....	100
15			
16	3.5.1	Headspace Monitoring for >1 Vapor Screening Level (VSL) Waste	100
17	3.5.2	99.9999 percent DE Calculation Method	105
18	3.5.3	Sampling & Analytical Procedures.....	105
19	3.6	Equipment Inspection Procedures and Frequency	113
20	3.6.1	Equipment Maintenance and Inspection Schedule	113
21	4.0	Quality Assurance (QA)/Quality Control (QC) Plan	129
22	4.1	Calibration Procedures & Frequency	129
23	4.1.1	Field Instrument Calibration.....	129
24	4.1.2	Laboratory Instrument Calibration.....	129
25	4.2	Internal QC Checks	130
26	4.2.1	Field QC Checks.....	130
27	4.2.2	Laboratory QC Checks	130
28	5.0	Recordkeeping & Data Reporting.....	131
29	5.1	Waste Processing: Monitoring, Control, and Analysis of Data	131
30	5.1.1	Facility Control System (FCS).....	131
31	5.1.2	General Description of the FCS.....	131
32	5.1.3	Data Acquisition and Recording.....	132
33	5.1.4	Alarm Management	133
34	5.1.5	Waste Processing: Data Archiving and Analysis	133
35	5.1.6	Equipment Calibration	135
36	5.1.7	Batch Control.....	136
37	5.2	Electronic Recordkeeping for Laboratory Analyses	136
38	5.3	Recordkeeping for Hardcopy Documents	137
39	6.0	Safety Plan.....	138
40	6.1	Human Health & Environmental Effects Criteria	138

**24915-000-GPE-GGPT-00001 – RESEARCH, DEVELOPMENT, AND DEMONSTRATION (RD&D) PERMIT
APPLICATION CDRL #A010**

1	6.1.1	Use and Selection of PPE	138
2	6.2	Emergency Response Procedures	139
3	6.2.1	Definition of a Release.....	139
4	6.2.2	Emergency Response Procedures	140
5	6.2.3	Release Notifications.....	142
6	6.2.4	Release Reporting Requirements.....	143
7	6.3	Personnel Qualifications or Training	148
8	6.3.1	Training.....	148
9	7.0	Closure Plan.....	155
10	7.1	BGCAPP Closure Process	156
11	7.2	Procedures to Close	157
12	7.2.1	Closure of BGCAPP Permitted HWMUs with History of Possible “Liquid” Agent Contamination (i.e., in MDB).....	157
13			
14	7.2.2	Closure of BGCAPP Permitted HWMUs without History of “Liquid” Agent Contamination (i.e., areas and systems outside the MDB)	158
15			
16	7.3	Closure Date & Schedule	159
17	7.4	Disposition of Residues	160
18	7.5	Quantity of Waste	160
19	7.6	Procedures to Decontaminate Equipment	160
20	7.6.1	Criteria for Determining Contamination.....	160
21	7.6.2	Description of Decontamination Procedures Including Clean-up Materials, Equipment, and Residues.....	161
22			
23	7.6.3	Procedures for Disposal of Soil, Rinse Water, etc.	161
24	7.6.4	Proposed Procedures/Mean to Demonstrate Decontamination Has Been Effective	161
25	7.6.5	Closure of Container Storage Areas	161
26	7.6.6	Closure of Tank Systems.....	162
27	7.6.7	Closure of Subpart X Units	162
28	7.7	Time to Close	163
29	8.0	Financial Responsibility.....	172
30	8.1	Financial Assurance for Closure	172
31	8.2	Liability Coverage	172
32	9.0	Signatories	173
33	9.1	Owner Address.....	173
34	9.2	Operator Address	173
35	9.3	Public Notice Information.....	173
36		Phase 1 RCRA Drawings	175
37			

**24915-000-GPE-GGPT-00001 – RESEARCH, DEVELOPMENT, AND DEMONSTRATION (RD&D) PERMIT
APPLICATION CDRL #A010**

List of Figures

1
2
3 Figure 1-A – Updated Part A of the Kentucky Hazardous Waste Application – BGCAPP Facility... 14
4 Figure 1-1 – 155-mm Rocket Diagram.....32
5 Figure 2-1 – MDB HVAC Filter Unit 43
6 Figure 2-2 – BGCAPP Site Plan 53
7 Figure 3-1 –General Process Block Flow Diagram 63
8 Figure 3-2 – Photograph of EONC..... 64
9 Figure 3-3 – Projectile with Crushed Burster Tube 77
10 Figure 3-4 – Schematic of an SCWO Reactor 83
11 Figure 3-5 – Typical Weekly Inspection – Containers.....116
12 Figure 3-6 – Typical Daily Inspection Tanks, Subpart X (Miscellaneous) Systems 117
13 Figure 3-7 – Typical Daily Inspection Liquid Loading Stations 120
14 Figure 3-8 – Typical Inspection Log 3-122
15 Figure 3-9 – Commonly Used Hazardous Waste Containers 3-123
16 Figure 6-1 – Incident Report 144
17 Figure 6-2 – BGCAPP Evacuation Routes 145
18 Figure 7-1 – BGCAPP Closure Phases 170
19 Figure 7-2 – BGCAPP Closure Schedule 171
20

List of Tables

21
22 Table 1-1 – Summary Table – Topics Recommended By EPA’s Guidance Manual for RD&D Permit
23 13
24 Table 1-1 – Stored Munition Data 30
25 Table 1-2 – Estimated Quantity of Waste Stored Per Munition Type 30
26 Table 1-3– Waste Totals for GB Agent Campaign..... 30
27 Table 1-4 – Analytical Data for GB in 155-mm Rockets 37
28 Table 1-5 – Analytical Data for GB in 8-Inch Projectiles 38
29 Table 1-6 – Examples of Primary Process Wastes..... 38
30 Table 2-1 – BGCAPP Pilot Testing Nominal Feed Rates 50
31 Table 3-1 – Major NRC Reports Relevant to Destruction of Weapons at BGAD..... 55
32 Table 3-2 – Hydrolysis Types to be Used at BGCAPP for GB..... 62
33 Table 3-3 – AELs for GB..... 104
34 Table 3-4 – Summary of Bounding Conditions for GB..... 105
35 Table 3-5 – BGCAPP Wastes, Designations and Characterizations 106
36 Table 3-6 – Typical Sampling Methods and Equipment 109
37 Table 3-7 – Analytical Test Methods and Rationale 110
38 Table 3-8 – Tank Summary 124
39 Table 6-1 – Typical BGCAPP Emergency Response Equipment..... 146
40 Table 6-2 – Emergency Response Agency Notification List 147
41 Table 6-3 – Training Matrix 152
42 Table 7-1 – Maximum Inventory of Wastes at Beginning of Closure 164
43 Table 7-2 – Clean Closure Criteria for Final Rinse and Soil Samples 168

**24915-000-GPE-GGPT-00001 – RESEARCH, DEVELOPMENT, AND DEMONSTRATION (RD&D) PERMIT
APPLICATION CDRL #A010**

Acronyms/Abbreviations

1
2
3
4
5
6
7
8
9
10
11
12
13
14
15
16
17
18
19
20
21
22
23
24
25
26
27
28
29
30
31
32
33
34
35
36
37
38
39
40

Acronym	Definition
ACS	agent collection system
ACWA	Assembled Chemical Weapons Alternatives
AEGL	Acute Exposure Guideline Level
AEL	airborne exposure limit
AFS	aluminum filtration system
ANS	agent neutralization system
AOC	Army Operations Center
APS	aluminum precipitation system
ARS	aluminum removal system
ASTM	ASTM International (formerly the American Society for Testing and Materials)
BGAD	Blue Grass Army Depot
BGCA	Blue Grass Chemical Activity
BGCAPP	Blue Grass Chemical Agent-Destruction Pilot Plant
BTRA	Bounding Transportation Risk Assessment
CCR	central control room
CCTV	closed-circuit television
CDC	Centers for Disease Control and Prevention
CHB	container handling building
CLA	chemical limited area
CMA	Chemical Materials Activity
CRM	contaminated rocket motor
CSB	control and support building
DAAMS	depot area air monitoring system
DE	destruction efficiency
decon	decontaminate
DoD	Department of Defense
DOT	Department of Transportation
DPE	demilitarization protective ensemble
DSA	demilitarization protective ensemble (DPE) support area
DSC	differential scanning calorimeter
EAR	Export Administration Regulation
EBH	energetics batch hydrolyzer
EC	emergency coordinator
ECF	entry control facility
ECR	explosive containment room
ECV	explosive containment vestibule

**24915-000-GPE-GGPT-00001 – RESEARCH, DEVELOPMENT, AND DEMONSTRATION (RD&D) PERMIT
APPLICATION CDRL #A010**

1	ENR	energetics neutralization reactor
2	ENS	energetics neutralization system
3	EOC	emergency operations center
4	EONC	enhanced on-site container
5	EPA	U.S. Environmental Protection Agency
6	FCC	facility construction certification
7	FCS	facility control system
8	FPS	facility protection system
9	GB	nerve agent sarin, isopropyl methyl phosphonofluoridate
10	GC-MSD/FPD	gas chromatograph – mass spectrography detector/flame
11		photometric detector
12	GPL	general population limit
13	gpm	gallons per minute
14	H	blister agent mustard made by the Levinstein process,
15		bis(2-chloroethyl) sulfide or 2,2'-dichlorodiethyl sulfide
16	HAZMAT	hazardous material
17	HAZWOPER	Hazardous Waste Operations and Emergency Response
18	HEPA	high-efficiency particulate air (filter)
19	HMRT	hazardous material (HAZMAT) response team
20	HPLC	high pressure liquid chromatograph
21	HSA	hydrolysate storage area
22	HVAC	heating, ventilating, and air-conditioning
23	HW	hazardous waste
24	HWMU	hazardous waste management unit
25	IBC	International Building Code
26	IC	Incident Commander
27	ICP	inductively coupled plasma
28	ICS	integrated control system
29	IMMS	instrument maintenance management system
30	IPA	isopropyl alcohol
31	ITAR	International Traffic in Arms Regulations
32	KAR	Kentucky Administrative Regulation
33	KDEP	Kentucky Department for Environmental Protection
34	KRS	Kentucky Revised Statute
35	MDB	munitions demilitarization building
36	MOA	memorandum of agreement
37	MPR	motor packing room
38	MPT	metal parts treater
39	MS	mass spectroscopy
40	MSD	mass spectrometer detector
41	MSDS	material safety data sheet

**24915-000-GPE-GGPT-00001 – RESEARCH, DEVELOPMENT, AND DEMONSTRATION (RD&D) PERMIT
APPLICATION CDRL #A010**

1	MSR	motor shipping room
2	MWS	munitions washout system
3	NCR	nose closure removal
4	NCRS	nose closure removal station
5	NRC	National Research Council
6	OJT	on-the-job training
7	OPSEC	operations security
8	OSHA	Occupational Safety & Health Administration
9	OTE	off-gas treatment (effluent) EBH/ENR system (EBH/HDC/ENS)
10	OTM	off-gas treatment system (MPT/ANS)
11	P&ID	pipng and instrumentation diagram
12	PCB	polychlorinated biphenyl
13	PDCC	Project Document Control Center
14	P.E.	professional engineer
15	PFD	process flow diagram
16	PHS	projectile handling system
17	PMB	personnel and maintenance building
18	PMD	projectile/mortar disassembly
19	PPE	personal protective equipment
20	psi	pound per square inch
21	psia	pound per square inch, absolute
22	psig	pounds per square inch, gauge
23	PVDF	polyvinylidene fluoride
24	QA	quality assurance
25	QC	quality control
26	RCM	rocket cutting machine
27	RCRA	Resource Conservation and Recovery Act
28	RD&D	research, development, and demonstration
29	RDX	Research Department Explosive
30	RM	rocket motor
31	RO	reverse osmosis
32	RQ	reportable quantity
33	RSL	regional screening level
34	RSM	rocket shear machine
35	SCO	scene control officer
36	SCWO	supercritical water oxidation
37	SD	spent decon
38	SDG	standby diesel generator
39	SDS	spent decontaminant system
40	SFT	shipping and firing tube

**24915-000-GPE-GGPT-00001 – RESEARCH, DEVELOPMENT, AND DEMONSTRATION (RD&D) PERMIT
APPLICATION CDRL #A010**

1	SLHHRA	screening level human health risk assessment
2	SOP	standing operating procedure
3	SPB	supercritical water oxidation (SCWO) processing building
4	STA	supercritical water oxidation (SCWO) tank area
5	STEL	short-term exposure limit
6	SWMU	solid waste management unit
7	TAR	tank assessment report
8	TCLP	toxic characteristic leaching procedure
9	TMA	toxic maintenance area
10	TOC	total organic carbon
11	TOCDF	Tooele Chemical Agent Disposal Facility
12	TOX	thermal oxidizer
13	TRRP	technical risk reduction program
14	TSDF	treatment, storage, and disposal facility
15	TWA	time-weighted average
16	UN	United Nations
17	UNS	Unified Numbering System
18	UPA	unpack area
19	VSL	vapor screening level
20	VX	nerve agent, O-ethyl S-(2-diisopropylaminoethyl) methylphosphonothiolate
21		
22	WPL	worker population limit
23	WRS	water recovery system
24	WSA	waste storage area
25	WTS	waste transfer station
26		

Executive Summary

Updated RD&D Permit Application

This revision to the previously approved research, development, and demonstration (RD&D) permit application for the Blue Grass Chemical Agent-Destruction Pilot Plant (BGCAPP) facility provides additional, updated information that has become available since approval of a previous version of this application. In addition, the format for this version of the permit application was updated to reflect and align with the eight topics that the U.S. Environmental Protection Agency (EPA) identifies for consideration when preparing a RD&D permit application.

Most of the updated information describes how the BGCAPP facility will be operated and includes a revised list of engineering drawings necessary to describe the BGCAPP operations. Several of the engineering drawings have been deemed operations security (OPSEC), International Traffic in Arms Regulations (ITAR), or Export Administration Regulation (EAR) sensitive due to the information contained on the drawings. Environmental regulatory personnel may obtain any sensitive engineering drawings for review at their convenience at the BGCAPP offices located at 830 Eastern Bypass, Suite 106, Richmond, KY 40475.

Please note that there are two Volumes of this application, this one, which is Volume 1 and a Volume 2, which contains the RCRA drawings that will be submitted in 2 separate phases. This drawing submission (Volume 2) should be considered Phase 1, with the Phase 2 submission coming in the first quarter 2014 and will contain the remainder of the drawings that require a PE stamp and have change documentation associated with them.

Purpose and Objectives of RD&D Program

Section 4-1 of the EPA's RD&D Guidance [EPA Guidance Manual for Research, Development, and Demonstration Permit Units Under 40 Code of Federal Regulations (CFR) Section 270-65, EPA/530-SW-86-008, July 1986], advises the applicant to consider eight topics when preparing the application. Table 1-1 lists the eight topics and cites the sections of the RD&D permit application where the topics are addressed. The RD&D program will include the processing of only the GB munitions in the Blue Grass Army Depot (BGAD) stockpile. The VX and H munitions, as well as any GB munitions not treated under the RD&D program will be processed under the Kentucky Hazardous Waste (KHW) Part B Permit.

The following subsections present additional details, including the justification for conducting the RD&D with hazardous waste, the measurements and observations used to determine success, safety and environmental considerations, and the success criteria that will be used to evaluate the results at each ramp-up rate.

**24915-000-GPE-GGPT-00001 – RESEARCH, DEVELOPMENT, AND DEMONSTRATION (RD&D) PERMIT APPLICATION
CDRL #A010**

**Table 1-1 – Summary Table – Topics Recommended By EPA’s
Guidance Manual for RD&D Permit**

Item ^a	Topic	Location in Permit Application
1	Purpose of Project	Provided in this Executive Summary (see above)
2	Minimum Quantities of Hazardous Waste Required to meet the RD&D Objectives	Table 2-1
3	Anticipated Environmental Releases	Section 6.2.1
4	Sampling and Analytical Procedures	Sections 1.0 and 3.0
5	Research Personnel Experience	Section 6.3 and Table 6-3
6	Emergency Response Procedures	Section 6.0
7	Facility Closure at Conclusion of Research	Section 7.0
8	Financial Responsibility for Closure	Section 8.0
^a The section numbers correspond to the item numbers in the EPA’s Guidance Manual for RD&D Permits		

Updated Part A Form

The original and subsequent RD&D permit applications submitted by BGCAPP did include Part A forms, as does this revision. Please note the processes and processing rates included in this Part A form likely will change in the intervening years before BGCAPP waste processing actually begins and further updates to this form likely will be necessary.

Figure 1-A – Updated Part A of the Kentucky Hazardous Waste Application – BGCAPP Facility

<p style="text-align: center;">Kentucky Energy and Environment Cabinet Department for Environmental Protection Division of Waste Management 200 Fair Oaks Line - Frankfort, Kentucky 40601</p> <p style="text-align: center;">Part A of the Kentucky Hazardous Waste Permit Application</p>	<p>DO NOT WRITE IN THIS SPACE</p>													
<table border="1" style="width: 100%; border-collapse: collapse;"> <tr> <td style="width: 15%; padding: 2px;">Facility's EPA ID No.</td> <td style="width: 3%; text-align: center;">K</td> <td style="width: 3%; text-align: center;">Y</td> <td style="width: 3%; text-align: center;">8</td> <td style="width: 3%; text-align: center;">2</td> <td style="width: 3%; text-align: center;">1</td> <td style="width: 3%; text-align: center;">3</td> <td style="width: 3%; text-align: center;">8</td> <td style="width: 3%; text-align: center;">2</td> <td style="width: 3%; text-align: center;">0</td> <td style="width: 3%; text-align: center;">1</td> <td style="width: 3%; text-align: center;">0</td> <td style="width: 3%; text-align: center;">5</td> </tr> </table>	Facility's EPA ID No.	K	Y	8	2	1	3	8	2	0	1	0	5	
Facility's EPA ID No.	K	Y	8	2	1	3	8	2	0	1	0	5		
<p>FOR OFFICIAL USE ONLY</p>														

FIRST SUBMITTAL (*see INSTRUCTIONS*)
 REVISION
 RENEWAL
 PAGE 1 OF 14

Name of Facility: Blue Grass Chemical Agent Destruction Pilot Plant

1. Location of Facility: 431 Battlefield Memorial Highway

City: Richmond State: KY Zip Code: 40475-5001
 County: Madison *See INSTRUCTIONS*: Latitude: 37° 42' 00" N Longitude: 84° 12' 30" W

2. Name of Land Owner: *See INSTRUCTIONS*: U.S. Department of the Army

Legal status of Land Owner: Federal (F) State (S) County (C) Indian (I)
 Municipal (M) District (D) Private (P)
 Other (O) specify: N/A

Land Owner's Mailing Address: 431 Battlefield Memorial Highway
 City: Richmond State: KY Zip Code: 40475-5001
 Facility Land Owner's Telephone Number: (859) 779-6246

3. Existing Facilities, provide the date operation began or construction commenced: 01/01/1941
(Month, Day, Year)

New Facilities, provide the date operation is expected to begin: N/A
(Month, Day, Year)

4. Facility Mailing Address: 431 Battlefield Memorial Highway
 City: Richmond State: KY Zip Code: 40475-5001

5. Facility Contact Person: Ramesh Melarkode

Title: Environmental Manager Phone Number: (859) 779-6268
 Facility Contact Person may be reached at Mailing Address Location Address Other Specify: N/A
 Street Address: 431 Battlefield Memorial Highway
 City: Richmond State: KY Zip Code: 40475-5001

**24915-000-GPE-GGPT-00001 – RESEARCH, DEVELOPMENT, AND DEMONSTRATION (RD&D) PERMIT APPLICATION
CDRL #A010**

PAGE 2 OF 15

Facility's EPA ID Number

K	Y	8	2	1	3	8	2	0	1	0	5
---	---	---	---	---	---	---	---	---	---	---	---

8. Name of Facility Operator: *See INSTRUCTIONS:* Bechtel Parsons Blue Grass

Type of Owner: Federal (F) State (S) County (C) Indian (I)
 Municipal (M) District (D) Private (P)
 Other (O) specify: N/A

Operator's Mailing Address: 830 Eastern By-Pass, Suite 106
 City: Richmond State: KY Zip Code: 40475
 Facility Operator's Telephone Number: (859) 625-1665

New Operator Assumed Responsibility for Facility on this Date: N/A

9. Name of Facility Owner: *See INSTRUCTIONS:* U.S. Department of the Army

Legal status of Land Owner: Federal (F) State (S) County (C) Indian (I)
 Municipal (M) District (D) Private (P)
 Other (O) specify: N/A

Owner's Mailing Address: 431 Battlefield Memorial Highway
 City: Richmond State: KY Zip Code: 40475-5001
 Facility Owner's Telephone Number: (859) 779-6246

New Operator Assumed Responsibility for Facility on this Date: 01/01/1941
 (Month, Day, Year)

10. SIC Codes: (1) 9711

Briefly describe the type of business conducted at this site: National Security (U.S. Army)

24915-000-GPE-GGPT-00001 – RESEARCH, DEVELOPMENT, AND DEMONSTRATION (RD&D) PERMIT APPLICATION CDRL #A010

PAGE 3 OF 15 11. PROCESS DESCRIPTION. <i>See Instructions</i>							Facility's EPA ID Number											
							K	Y	8	2	1	3	8	2	0	1	0	5
Commercial Indicator	Unique Unit or Group Name	Legal Status Code	Process Codes	Process Design Capacity Of All Units Listed Under This Name	Unit of Measure	Number Of Individual Units In This Process	Operating Status Code	Description Of Process										
4	Container Handling Building (CHB)	PR	S01	9,500	G	1	UC	Store up to 53 EONCs, prior to movement into the MDB for processing. Further discussion is included on page 12 of this Part A.										
4	Waste Storage Area (WSA) – Inside CLA	PR	S01	5,500	G	1	UC	Store various hazardous wastes inside the CLA prior to transfer to the Waste Transfer Station (WTS)										
4	Waste Transfer Station (WTS) – Outside CLA	PR	S01	24,000	G	1	UC	Store various hazardous wastes outside of the CLA prior to transportation to final treatment/disposal facility										
4	*Box Transfer Area, Room 1	PR	S01	1,500	G	1	UC	Store 8 boxes of 30 rocket motors per box										
4	*Box Transfer Area, Room 2	PR	S01	1,500	G	1	UC	Store 8 boxes of 30 rocket motors per box										
4	*Agent Neutralization System (ANS) Storage Area	PR	S01	2,750	G	1	UC	Store various secondary wastes as well as contingency storage for the SDS										
4	*Tray/Container Transfer Room	PR	S01	550	G	1	UC	Store various secondary wastes										
4	*Metal Parts Treater (MPT) Cooling Conveyor Storage Area	PR	S01	8,190	G	1	UC	Store up to one 20-cubic yard roll-off bin and various trays queued on conveyor										
4	*Toxic Maintenance Area (TMA) Storage Area	PR	S01	5,500	G	1	UC	Store drums of various waste, contaminated equipment and/or leaking munitions										

DEP - 7058A (July 1997)

*Unit(s) located in the MDB

24915-000-GPE-GGPT-00001 – RESEARCH, DEVELOPMENT, AND DEMONSTRATION (RD&D) PERMIT APPLICATION CDRL #A010

PAGE 4 OF 15							Facility's EPA ID Number											
11. PROCESS DESCRIPTION. <i>See Instructions</i>							K	Y	8	2	1	3	8	2	0	1	0	5
Commercial Indicator	Unique Unit or Group Name	Legal Status Code	Process Codes	Process Design Capacity Of All Units Listed Under This Name	Unit of Measure	Number Of Individual Units In This Process	Operating Status Code	Description Of Process										
4	*Explosive Containment Vestibule (ECV) Storage Area, ECV-1	PR	S01	275	G	1	UC	Store various process and secondary wastes										
4	*Explosive Containment Vestibule (ECV) Storage Area, ECV-2	PR	S01	275	G	1	UC	Store various process and secondary wastes										
4	*Unpack Area (UPA) No. 1, UPA-1	PR	S01	2,400	G	1	UC	Store munitions and various secondary wastes										
4	*Unpack Area (UPA) No. 2, UPA-2	PR	S01	2,400	G	1	UC	Store munitions and various secondary wastes										
4	*Motor Shipping Room (MSR) / Covered Loading Area	PR	S01	350	G	1	UC	Store up to 2 boxes of 30 rocket motors/box & 2 boxes of empty warhead shipping and firing tubes										
4	*Motor Packing Room (MPR) Storage Area	PR	S01	350	G	1	UC	Store up to 2 boxes of 30 rocket motors/box & 2 boxes of empty warhead shipping and firing tubes										
4	*Explosive Containment Room (ECR) Storage Area No. 1, ECR-1	PR	S01	55	G	1	UC	Store various secondary wastes										
4	*Explosive Containment Room (ECR) Storage Area No. 2, ECR-2	PR	S01	55	G	1	UC	Store various secondary wastes										

DEP - 7058A (July 1997)

*Unit(s) located in the MDB

24915-000-GPE-GGPT-00001 – RESEARCH, DEVELOPMENT, AND DEMONSTRATION (RD&D) PERMIT APPLICATION CDRL #A010

PAGE 5 OF 15 11. PROCESS DESCRIPTION. <i>See Instructions</i>							Facility's EPA ID Number									
							K	Y	8	2	1	3	8	2	0	1
Commercial Indicator	Unique Unit or Group Name	Legal Status Code	Process Codes	Process Design Capacity Of All Units Listed Under This Name	Unit of Measure	Number Of Individual Units In This Process	Operating Status Code	Description Of Process								
4	SCWO Processing Building (SPB) Storage Area	PR	S01	8,355	G	1	UC	Store AFS Filter Cake/Media and various secondary wastes in roll-off containers and drums								
4	Hydrolysate Storage Area (HSA) Agent Hydrolysate Storage Tank – MT-HSS-0104	PR	S02	102,264	G	1	UC	Store agent hydrolysate prior to treatment in SPB								
4	Hydrolysate Storage Area (HSA) Agent Hydrolysate Storage Tank – MT-HSS-0105	PR	S02	337,184	G	1	UC	Store agent hydrolysate prior to treatment in SPB								
4	Hydrolysate Storage Area (HSA) Agent Hydrolysate Storage Tank – MT-HSS-0205	PR	S02	337,184	G	1	UC	Store agent hydrolysate prior to treatment in SPB								
4	Hydrolysate Storage Area (HSA) Energetics Hydrolysate Storage Tank – MT-HSS-0604	PR	S02	313,433	G	1	UC	Store energetics hydrolysate prior to treatment in SPB								
4	Hydrolysate Storage Area (HSA) Energetics Hydrolysate Storage Tank – MT-HSS-0704	PR	S02	313,433	G	1	UC	Store energetics hydrolysate prior to treatment in SPB								
4	*Agent Holding Tank – MT-ACS-0105	PR	S02	1,451	G	1	UC	Stores drained agent prior treatment in the Agent Hydrolyzer(s)								
4	*Agent Surge Tank – MT-ACS-0106	PR	T01, S02	1,451	G	1	UC	Stores drained agent or agent spilled from the SDS prior to treatment in the Agent Hydrolyzer(s)								

DEP - 7058A (July 1997)

*Unit(s) located in the MDB

24915-000-GPE-GGPT-00001 – RESEARCH, DEVELOPMENT, AND DEMONSTRATION (RD&D) PERMIT APPLICATION CDRL #A010

PAGE 6 OF 15 11. PROCESS DESCRIPTION. <i>See Instructions</i>							Facility's EPA ID Number											
							K	Y	8	2	1	3	8	2	0	1	0	5
Commercial Indicator	Unique Unit or Group Name	Legal Status Code	Process Codes	Process Design Capacity Of All Units Listed Under This Name	Unit of Measure	Number Of Individual Units In This Process	Operating Status Code	Description Of Process										
4	*Agent Hydrolysate Sampling Tank – MT-ANS-0103	PR	S02	4,838	G	1	UC	Stores agent hydrolysate until sampling is performed, then releases cleared hydrolysate to the Agent Hydrolysate Storage Tank										
4	*Agent Hydrolysate Sampling Tank – MT-ANS-0203	PR	S02	4,838	G	1	UC	Stores agent hydrolysate until sampling is performed, then releases cleared hydrolysate to the Agent Hydrolysate Storage Tank										
4	*Agent Hydrolysate Sampling Tank – MT-ANS-0303	PR	S02	4,838	G	1	UC	Stores agent hydrolysate until sampling is performed, then released cleared hydrolysate to the Agent Hydrolysate Storage Tank										
4	*Agent Neutralization Reactor – MV-ANS-0101	PR	T01	2,062	G	1	UC	Agent is neutralized before being sent to the Agent Hydrolysate Sampling Tank										
4	*Agent Neutralization Reactor – MV-ANS-0201	PR	T01	2,062	G	1	UC	Agent is neutralized before being sent to the Agent Hydrolysate Sampling Tank										
4	*Energetics Neutralization Reactor – MV-ENS-0101	PR	T01	3,070	G	1	UC	Energetics are neutralized before being released to the Energetics Hydrolysate Storage Tank										
4	*Energetics Neutralization Reactor – MV-ENS-0102	PR	T01	3,070	G	1	UC	Energetics are neutralized before being released to the Energetics Hydrolysate Storage Tank										
4	*Energetics Neutralization Reactor – MV-ENS-0103	PR	T01	3,070	G	1	UC	Energetics are neutralized before being released to the Energetics Hydrolysate Storage Tank										
4	*Spent Decontamination System (SDS) Tank – MV-SDS-0101	PR	T01	7,735	G	1	UC	Spent decontamination solution from MDB sumps is collected and treated before being sampled and sent to the appropriate HSA tank										

DEP - 7058A (July 1997)

24915-000-GPE-GGPT-00001 – RESEARCH, DEVELOPMENT, AND DEMONSTRATION (RD&D) PERMIT APPLICATION CDRL #A010

PAGE 7 OF 15 11. PROCESS DESCRIPTION. <i>See Instructions</i>							Facility's EPA ID Number											
							K	Y	8	2	1	3	8	2	0	1	0	5
Commercial Indicator	Unique Unit or Group Name	Legal Status Code	Process Codes	Process Design Capacity Of All Units Listed Under This Name	Unit of Measure	Number Of Individual Units In This Process	Operating Status Code	Description Of Process										
4	*Spent Decontamination System (SDS) Tank – MV-SDS-0201	PR	T01	7,735	G	1	UC	Spent decontamination solution from MDB sumps is collected and treated before being sampled and sent to the appropriate HSA tank										
4	*Spent Decontamination System (SDS) Tank – MV-SDS-0301	PR	T01	7,735	G	1	UC	Agent wash water from the munitions washout process is collected and treated before being sent to the Agent Hydrolyzer(s)										
4	*Hydrolysate Collection Tank – MT-EBH-1901	PR	S02	1,475	G	1	UC	Collects and stores hydrolysate generated in the EBHs before transferring hydrolysate to the ENRs for further treatment										
4	*Energetics Batch Hydrolyzer (EBH) – MV-EBH-1101	PR	X99	2,651	J	1	UC	Receives sheared rocket warhead pieces and neutralizes energetics and residual agent										
4	*Energetics Batch Hydrolyzer (EBH) – MV-EBH-1201	PR	X99	2,651	J	1	UC	Receives sheared rocket warhead pieces and neutralizes energetics and residual agent										
4	*Energetics Batch Hydrolyzer (EBH) – MV-EBH-1301	PR	X99	2,651	J	1	UC	Receives sheared rocket warhead pieces and neutralizes energetics and residual agent										
4	*Nose Closure Removal System (NCRS) – MY-NCR-0101	PR	X02	350	J	1	UC	Removes nose closures/lifting plugs from VX and GB projectiles										
4	*Rocket Cutting Machine (RCM) Line 1 – MX-RHS-0113	PR	X02	1,140	J	1	UC	Separates rocket motors from rocket warheads										
4	*Rocket Cutting Machine (RCM) Line 2 – MX-RHS-0114	PR	X02	1,140	J	1	UC	Separates rocket motors from rocket warheads.										

DEP - 7058A (July 1997)

24915-000-GPE-GGPT-00001 – RESEARCH, DEVELOPMENT, AND DEMONSTRATION (RD&D) PERMIT APPLICATION CDRL #A010

PAGE 8 OF 15 11. PROCESS DESCRIPTION. <i>See Instructions</i>							Facility's EPA ID Number											
							K	Y	8	2	1	3	8	2	0	1	0	5
Commercial Indicator	Unique Unit or Group Name	Legal Status Code	Process Codes	Process Design Capacity Of All Units Listed Under This Name	Unit of Measure	Number Of Individual Units In This Process	Operating Status Code	Description Of Process										
4	*Rocket Shear Machine (RSM) – MY-RHS-0101	PR	X02	1,140	J	1	UC	Punches and drains the warhead, flushes the agent cavity and shears rocket warheads into segments										
4	*Rocket Shear Machine (RSM) – MY-RHS-0102	PR	X02	1,140	J	1	UC	Punches and drains the warhead, flushes the agent cavity and shears rocket warheads into segments										
4	*Metal Parts Treater (MPT) – ME-MPT-0101	PR	X03	11,770	J	1	UC	Thermal decontamination of metal parts and various secondary wastes										
4	*Metal Parts Treater (MPT) – ME-MPT-0201	PR	X03	11,770	J	1	UC	Thermal decontamination of metal parts and various secondary wastes										
4	*Munitions Washout System (MWS) – MZ-MWS-0101D	PR	X02	910	J	1	UC	Access the agent cavity and washout GB projectiles										
4	*Munitions Washout System (MWS) – MZ-MWS-0101E	PR	X02	910	J	1	UC	Access the agent cavity and washout GB projectiles										
4	*MWS Reject Table – MJ-MWS-0103	PR	S01	5	G	1	UC	Provides container storage for projectile rejects associated with the MWS										
4	Bulk Waste Storage Area	PR	S01	185,000	G	1	UC	Provides container storage for off-site shipment of waste staged in tanker trucks as well as roll-off containers.										

DEP - 7058A (July 1997)

24915-000-GPE-GGPT-00001 – RESEARCH, DEVELOPMENT, AND DEMONSTRATION (RD&D) PERMIT APPLICATION CDRL #A010

PAGE 9 OF 15							Facility's EPA ID Number											
11. PROCESS DESCRIPTION. <i>See Instructions</i>							K	Y	8	2	1	3	8	2	0	1	0	5
Commercial Indicator	Unique Unit or Group Name	Legal Status Code	Process Codes	Process Design Capacity Of All Units Listed Under This Name	Unit of Measure	Number Of Individual Units In This Process	Operating Status Code	Description Of Process										
4	SCWO Tank Area (STA) – RO Reject Tank – MT-RO-0106	PR	S02	78,970	G	1	UC	Store Reverse Osmosis (RO) Reject until waste is shipped off-site										
4	SCWO Tank Area (STA) – RO Reject Tank – MT-RO-0206	PR	S02	78,970	G	1	UC	Store Reverse Osmosis (RO) Reject until waste is shipped off-site										
4	SCWO Tank Area (STA) – SCWO Effluent Tank – MT-SCWO-0101	PR	S02	45,626	G	1	UC	Store SCWO Effluent until it can be processed through the RO System										
4	SCWO Tank Area (STA) – SCWO Effluent Tank – MT-SCWO-0201	PR	S02	45,626	G	1	UC	Store SCWO Effluent until it can be processed through the RO System										
4	SCWO Tank Area (STA) – SCWO Effluent Tank – MT-SCWO-0301	PR	S02	45,626	G	1	UC	Store SCWO Effluent until it can be processed through the RO System										
4	SCWO Tank Area (STA) – RO Permeate Tank – MT-SWS-0101	PR	S02	54,002	G	1	UC	Store RO Permeate until it can be recycled back into the process to be used for make-up water										
4	SCWO Tank Area (STA) – RO Permeate Tank – MT-SWS-0201	PR	S02	54,002	G	1	UC	Store RO Permeate until it can be recycled back into the process to be used for make-up water										
4	SCWO Processing Building (SPB) – Aluminum Precipitation Reactor – MV-APS-0101	PR	T01	1,077	G	1	UC	Receives hydrolysate and through acidic addition, precipitates out the aluminum contained in the hydrolysate										

DEP - 7058A (July 1997)

24915-000-GPE-GGPT-00001 – RESEARCH, DEVELOPMENT, AND DEMONSTRATION (RD&D) PERMIT APPLICATION CDRL #A010

PAGE 10 OF 15							Facility's EPA ID Number											
11. PROCESS DESCRIPTION. <i>See Instructions</i>							K	Y	8	2	1	3	8	2	0	1	0	5
Commercial Indicator	Unique Unit or Group Name	Legal Status Code	Process Codes	Process Design Capacity Of All Units Listed Under This Name	Unit of Measure	Number Of Individual Units In This Process	Operating Status Code	Description Of Process										
4	SCWO Processing Building (SPB) – Aluminum Precipitation Reactor – MV-APS-0102	PR	T01	1,077	G	1	UC	Receives hydrolysate and through acidic addition, precipitates out the aluminum contained in the hydrolysate										
4	SCWO Processing Building (SPB) – Aluminum Filtration Unit – ML-AFS-1040	PR	X99	2,142	J	1	UC	Receives precipitated hydrolysate and filters out the aluminum before sending the filtrate to the SCWO for processing										
4	SCWO Processing Building (SPB) – Aluminum Filtration Unit – ML-AFS-2040	PR	X99	2,142	J	1	UC	Receives precipitated hydrolysate and filters out the aluminum before sending the filtrate to the SCWO for processing										
4	SCWO Processing Building (SPB) -- Reverse Osmosis (RO) Unit – ML-RO-0101	PR	X99	125,826	U	1	UC	Receives SCWO Effluent and removes dissolved solids to create RO Permeate (~70%) which is recycled as make-up water and RO Reject (~30%) which will be shipped off-site for disposal										
4	SCWO Processing Building (SPB) -- Reverse Osmosis (RO) Unit – ML-RO-0201	PR	X99	125,826	U	1	UC	Receives SCWO Effluent and removes dissolved solids to create RO Permeate (~70%) which is recycled as make-up water and RO Reject (~30%) which will be shipped off-site for disposal										
4	SCWO Processing Building (SPB) -- Reverse Osmosis (RO) Unit – ML-RO-0301	PR	X99	125,826	U	1	UC	Receives SCWO Effluent and removes dissolved solids to create RO Permeate (~70%) which is recycled as make-up water and RO Reject (~30%) which will be shipped off-site for disposal										

DEP - 7058A (July 1997)

24915-000-GPE-GGPT-00001 – RESEARCH, DEVELOPMENT, AND DEMONSTRATION (RD&D) PERMIT APPLICATION CDRL #A010

PAGE 11 OF 15							Facility's EPA ID Number											
11. PROCESS DESCRIPTION. <i>See Instructions</i>							K	Y	8	2	1	3	8	2	0	1	0	5
Commercial Indicator	Unique Unit or Group Name	Legal Status Code	Process Codes	Process Design Capacity Of All Units Listed Under This Name	Unit of Measure	Number Of Individual Units In This Process	Operating Status Code	Description Of Process										
4	SCWO Processing Building (SPB) -- SCWO Reactor – MV-SCWO-1030	PR	X99	1,231	J	1	UC	Receives filtered hydrolysates (energetics & agent) and treats the waste via Super Critical Water Oxidation										
4	SCWO Processing Building (SPB) -- SCWO Reactor – MV-SCWO-2030	PR	X99	1,231	J	1	UC	Receives filtered hydrolysates (energetics & agent) and treats the waste via Super Critical Water Oxidation										
4	SCWO Processing Building (SPB) -- SCWO Reactor – MV-SCWO-3030	PR	X99	1,231	J	1	UC	Receives filtered hydrolysates (energetics & agent) and treats the waste via Super Critical Water Oxidation										
4	SCWO Processing Building (SPB) – Hydrolysate Blend Tank – MT-SCWO-0030	PR	S02	6,124	G	1	UC	Blending of agent hydrolysate, energetics hydrolysate and feed additives to feed to the SCWO reactors										
4	SCWO Processing Building (SPB) – Hydrolysate Blend Tank – MT-SCWO-0031	PR	S02	6,124	G	1	UC	Blending of agent hydrolysate, energetics hydrolysate and feed additives to feed to the SCWO reactors										
4	SCWO Processing Building (SPB) – Batch Hydrolysate Holding Tank – MT-SCWO-0032	PR	S02	6,124	G	1	UC	Provides temporary storage of hydrolysate batches whose composition is unacceptable for processing in the SCWO reactors										
4	SCWO Processing Building (SPB) – Off-Spec Effluent Tank – MT-SCWO-0041	PR	T01	3,897	G	1	UC	Holds liquid effluent which does not meet the specification required for release to the RO units										

DEP - 7058A (July 1997)

24915-000-GPE-GGPT-00001 – RESEARCH, DEVELOPMENT, AND DEMONSTRATION (RD&D) PERMIT APPLICATION CDRL #A010

PAGE 12 OF 15							Facility's EPA ID Number											
11. PROCESS DESCRIPTION. <i>See Instructions</i>							K	Y	8	2	1	3	8	2	0	1	0	5
Commercial Indicator	Unique Unit or Group Name	Legal Status Code	Process Codes	Process Design Capacity Of All Units Listed Under This Name	Unit of Measure	Number Of Individual Units In This Process	Operating Status Code	Description Of Process										
4	SCWO Processing Building (SPB) – Emergency Relief Tank – MT-SCWO-0040	PR	T01	2,350	G	1	UC	In the event of an emergency shutdown, the SCWO reactor contents will be discharged to this tank. The distance from the bottom of the tank to the high-high liquid level is 25", the remainder of the tank volume is space for expansion. Liquid volume will not exceed the HLL.										
4	SCWO Processing Building (SPB) – Aluminum Filtration Feed Tank – MT-AFS-1010	PR	S02	917	G	1	UC	Receives energetics hydrolysate from the APRs and feeds to the AFS										
4	SCWO Processing Building (SPB) – Aluminum Filtration Feed Tank – MT-AFS-2010	PR	S02	917	G	1	UC	Receives energetics hydrolysate from the APRs and feed to the AFS										
4	SCWO Processing Building (SPB) – Aluminum Filtrate Tank – MT-AFS-1012	PR	S02	2,670	G	1	UC	Receives energetics hydrolysate from the AFS and feeds to the Hydrolysate Blend Tank(s)										
4	Movement of Munitions from Hazardous Waste Storage Unit to Enhanced On-Site Container (EONC)	PR	T04	522	J	1	CN	1 EONC can hold 6 GB Projectile pallets, with 6 projectiles per pallet, totaling 36 projectiles per EONC, maximum. Each projectile contains 14.5 lb of agent per round, which totals 522 lbs/agent max, per EONC. GB Rockets total 321 lb/agent max, per EONC. One EONC transferred per hour equals a 522lb/hr "processing" rate.										

DEP - 7058A (July 1997)

24915-000-GPE-GGPT-00001 – RESEARCH, DEVELOPMENT, AND DEMONSTRATION (RD&D) PERMIT APPLICATION CDRL #A010

PAGE 13 OF 15

Facility's EPA ID Number											
K	Y	8	2	1	3	8	2	0	1	0	5

12. WASTE STREAM DESCRIPTION. *See Instructions.*

WASTE STREAM NUMBER	ESTIMATED ANNUAL WASTE AMOUNT	UNIT OF MEASURE	EPA WASTE NUMBERS	PROCESS CODES ASSOCIATED WITH THIS WASTE
1	883	TONS	D004, D005, D006, D007, D008, D009, D010, D011, and/or N001	X03; MPT Residues & Ash
2	2,950	TONS	D004, D005, D006, D007, D008, D009, D010, D011, and/or N001	S01, S02, and X99; Aluminum Precipitate
3	84,500	TONS	D004, D005, D006, D007, D008, D009, D010, D011, and/or N001	S02 and X99; Reverse Osmosis (RO) Reject (RO Permeate (~70%) is recycled back into the process)
4	8	TONS	D024, D037, and/or N001	S01 and X03; Agent Contaminated Munitions Dunnage
5	774	TONS	D024, D037	S01 and X03; Munitions dunnage
6	1078	TONS	D001, D003, D008	S01; Rocket Motors
7	15.3	TONS	D001, D002, D003, D004, D005, D006, D007, D008, D009, D010, D011, D022, D024, D027, D028, D029, D037, F001-F005, and/or N001	S01; Lab Wastes
8	5.2	TONS	D001, D002, D003, D004, D005, D006, D007, D008, D009, D010, D011, F001-F005, and/or N001	S01; Maintenance and Miscellaneous Wastes; Oils, Paints, Spent Solvents, Hydraulic Fluids, etc.
9	204	TONS	N001	S01; Agent Derived, Listed Secondary Wastes including PPE, DPE Suits, Spent Activated Carbon, HEPA Filters and Pre-filters, Trash, Concrete, Rags and Components/Parts/Tools from Operations, and Maintenance activities

DEP - 7058A (July 1997)

1
2


- PAGE 14 OF 15
- Facility's EPA ID Number
K Y 8 2 1 3 8 2 0 1 0 5
13. Existing Environmental Permits:
- Inter-State Regional Program [A]:
 - Single Well (FURS) [B]:
 - County Program [C]:
 - DOE Program [D]:
 - Other EPA Program [E]: specify:
 - EPA 404 (dredge or fill program) [F]:
 - USGS Program [G]:
 - Area Wells (FURS) [H]:
 - NOTIS [J]:
 - Superfund (CERCLA) [K]:
 - FATES [L]:
 - Municipal (city, town, etc.) Program [M]:
 - NPDES/KPDES (discharges to surface water) [N]: KY0020737; KYR10
 - PSD (Prevention of Significant Deterioration - Clean Air Act) [P]: Title V Permit—BGCAPP V-10-023 (Revision 1)
 - CDS [Q]:
 - RCRA (hazardous wastes) [R]: KYB-213-820-105
 - State Program [S]:
 - DOT Program [T]:
 - UIC (underground injection of fluids) [U]:
 - Intra-State Regional Program [W]:
 - Other Federal Program [X]: specify:
 - CICIS (OTS Chemicals in Commerce Information System) [Y]:
 - Other Non-Federal Programs [Z]: Water Withdraw Permit No. 1013

14. FACILITY STATUS:
- Waste is NOT received from off-site Accepts waste from any off-site source(s) [A]
- Accepts waste from only a restricted group of off-site sources(s) [R]:
Specify: N/A

15. PHOTOGRAPHS, DRAWING AND MAP - See **INSTRUCTIONS**
- All existing facilities must include photographs (aerial or ground level) that clearly delineate all existing structures; existing storage, treatment or disposal areas; and sites of future treatment, storage or disposal areas. All existing facilities must include a drawing showing the general layout of the facility and a topographic map. The photographs, drawing and map must be attached to this form.


16. If the facility owner is also the facility operator, please skip this section and complete item 17 below.
- Owner Certification** - I certify under penalty of law that I have personally examined and am familiar with the information submitted in this and all attached documents, and that based on my inquiry of those individuals immediately responsible for obtaining the information, I believe that the submitted information is true, accurate, and complete. I am aware that there are significant penalties for submitting false information, including the possibility of fine and imprisonment.

Lee G. Hudson, Colonel, LG, U.S. Army Commanding Officer
 NAME (PRINT OR TYPE)
 DATE SIGNED

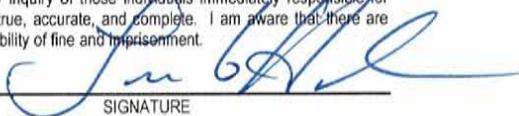
 SIGNATURE


17. **Operator Certification** - I certify under penalty of law that I have personally examined and am familiar with the information submitted in this and all attached documents, and that based on my inquiry of those individuals immediately responsible for obtaining the information, I believe that the submitted information is true, accurate, and complete. I am aware that there are significant penalties for submitting false information, including the possibility of fine and imprisonment.

Doug Omichinski, Project Manager, BPBG
 NAME (PRINT OR TYPE)
 DATE SIGNED

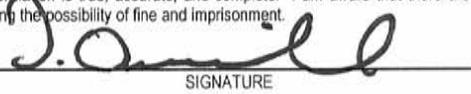
 SIGNATURE

18. **Land Owner Certification** - I certify under penalty of law that I have personally examined and am familiar with the information submitted in this and all attached documents, and that based on my inquiry of those individuals immediately responsible for obtaining the information, I believe that the submitted information is true, accurate, and complete. I am aware that there are significant penalties for submitting false information, including the possibility of fine and imprisonment.

Lee G. Hudson, Colonel, LG, U.S. Army Commanding Officer
 NAME (PRINT OR TYPE)
 DATE SIGNED

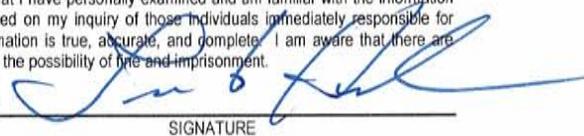
 SIGNATURE

DEP - 7058A (July 1997)

**24915-000-GPE-GGPT-00001 – RESEARCH, DEVELOPMENT, AND DEMONSTRATION (RD&D) PERMIT
APPLICATION CDRL #A010**

NOTES

1
2 The waste streams listed above in section 12, Waste Stream Description, are further described
3 below. These waste streams are those that will be disposed of offsite. One waste stream (Rocket
4 Motors) is still under evaluation with regards to the final disposition of this waste. There remains
5 the possibility that these wastes will be disposed of onsite, but for accountability, this waste stream
6 is listed in the waste stream list on page 12. When the final decision is made on the resolution of
7 the disposal action, the Part A will be revised to reflect any changes.
8

- 9 1) Waste stream number 1 is the residues; including munition bodies, that are processed in
10 the MPT. This also includes ash from the MPT as well as solids collected from the cyclone
11 in the <90-day drums.
- 12 2) Waste stream number 2 is the solid residues coming out of the Aluminum
13 Precipitation/Filtration System (APS/AFS), which include the waste filter media rolls from
14 the AFS filter unit(s).
- 15 3) Waste stream number 3 is the RO Reject from the recycling of the SCWO effluent through
16 the RO system. This is the ~30 percent of liquids from the SCWO treatment process that
17 can no longer be used as process water.
- 18 4) Waste stream number 4 is the agent contaminated munitions dunnage, including the
19 pallets, metal banding, and associated wastes.
- 20 5) Waste stream number 5 is the munitions dunnage that is not agent contaminated and
21 includes the pallets, metal banding, and associated wastes.
- 22 6) Waste stream number 6 includes the rocket motors and shipping and firing tubes. This
23 waste stream's final waste disposal determination has not been made yet (see intro
24 paragraph above). Any changes will be reflected on future revisions to this document.
- 25 7) Waste stream number 7 includes the various laboratory wastes generated by
26 monitoring/sampling activities associated with the operations process.
- 27 8) Waste stream number 8 includes the various maintenance and miscellaneous wastes, to
28 include waste oils, fluids, paints, spent solvents, etc.
- 29 9) Waste stream number 9 includes agent-derived listed secondary wastes generated in the
30 BGCAPP.
31

**24915-000-GPE-GGPT-00001 – RESEARCH, DEVELOPMENT, AND DEMONSTRATION (RD&D) PERMIT
APPLICATION CDRL #A010**

1 **1.0 WASTE DESCRIPTION**

2 **1.1 Type and Quantity of Waste to be Processed**

3 The BGCAPP eventually will treat munitions filled with two of the chemical agents stored at the
4 BGCA (i.e., GB and VX). However, the RD&D permit applies only to the treatment of munitions
5 containing the nerve agent GB.

6 Some GB 8-inch projectiles stored at the BGCA were sampled and analyzed during operations
7 conducted in 1979. Samples of the agent in other munition types stored at BGCA have not been
8 collected and analyzed. However, laboratory analytical data from other chemical agent-disposal
9 facilities are available for the GB used in BGCA chemical munitions and material safety data
10 sheets (MSDSs) for GB nerve agent have been provided in previous versions of this application.
11 The source and extent of the chemical agent data for each munition type is described in the
12 following subsections.

13 **1.1.1 GB 115-mm Rockets**

14 Table 1-4 provides the laboratory analytical data from sampling that was performed at the Tooele
15 Chemical Agent Disposal Facility (TOCDF). Although the analytical data from the other chemical
16 disposal facilities is not from the specific munitions stored by the Blue Grass Chemical Activity
17 (BGCA) at the BGAD, it is representative of the GB nerve agent stored at the BGAD.

18 **1.1.2 GB 8-Inch Projectiles**

19 Table 1-5 provides the data from sampling and laboratory analysis that was performed on the
20 GB 8-inch projectiles in storage at BGCA in 1979.

21 **1.1.3 Energetics**

22 **1.1.3.1 Rocket Energetics**

23 Rocket energetics consist of the following components:

- 24 1) Fuze composed of Research Department Explosive (RDX)
25 2) Detonator composed of lead azide and RDX
26 3) Burster composed of Comp B, which is a 60:40 mixture of RDX and trinitrotoluene (TNT)

27 **1.1.3.2 Rocket Propellant**

28 The rocket propellant consists of M-28, which is a mixture of the following components:

- 29 1) 60 percent nitrocellulose
30 2) 23.8 percent nitroglycerin
31 3) 9.9 percent triacetin
32 4) 2.6 percent diethylphthlate
33 5) 2 percent lead stearate
34 6) 1.7 percent 2-nitrodiphenylamine

**24915-000-GPE-GGPT-00001 – RESEARCH, DEVELOPMENT, AND DEMONSTRATION (RD&D) PERMIT
APPLICATION CDRL #A010**

1.1.4 Munitions Quantities and Agent Weights

Table 1-1 – Stored Munition Data

Munition	Agent Type	Type	Caliber	Quantity	Agent Weight (lb/munition)
M55	GB	Rocket	115 mm	51,716	10.7
M56	GB	Warhead	115 mm	24	10.7
M426	GB	Projectile	8 inch	3,977	14.5

Note: The munition quantities shown above include identified "leaker" munitions.

Table 1-2 – Estimated Quantity of Waste Stored Per Munition Type

Munition Type	Munitions, Total No.	Agent Weight, lbs	% of GB Stockpile, %
GB M55/M56	51,740	553,620	90.57
GB Projectiles	3,977	57,660	9.43

Table 1-3– Waste Totals for GB Agent Campaign

Agent Campaign	Total Munition Waste, lbs
GB	8,462,230

1.2 Physical Description of Waste to be Processed

1.2.1 Waste Description

The hazardous wastes that the BGCAPP will treat under the RD&D permit consist of: GB-filled M55 rockets, M56 warheads, and 8-inch projectiles. Under the proposed RD&D permit, the GB munitions will be used to demonstrate the effectiveness of the BGCAPP treatment processes. The assembled munitions stored at BGCA contain both chemical agent and energetic materials (i.e., propellant and/or explosive charges).

**24915-000-GPE-GGPT-00001 – RESEARCH, DEVELOPMENT, AND DEMONSTRATION (RD&D) PERMIT
APPLICATION CDRL #A010**

1 Table 1-1 lists the types and quantities of the GB munitions in the BGCA chemical stockpile. Each
2 type of chemical weapon is described in greater detail in the subsections below. The hazardous
3 waste codes associated with each waste stream generated from processing these chemical
4 weapons are provided in the Part A form submitted with this revised permit application
5 (see Figure 1-A). Additionally, Table 1-3 contains the total wastes generation during the GB
6 processing campaign.

7 Table 1-4 and Table 1-5, include the laboratory analytical data collected from waste analysis
8 performed at demilitarization facilities at other Chemical Materials Activity (CMA) sites. The data
9 include analytical results for organics (e.g., GB and energetics) and inorganics (i.e., metals) that
10 comprise the agent fill and energetics/propellant for each munition type.

11 **1.2.2 Projectiles**

12 Projectiles are fired from guns or cannons. Projectiles have cylindrically-shaped, steel bodies with
13 tapered noses, and chemical-filled projectiles have a hollow cylindrical tube (known as the
14 “burster well”) running down its center. This tube holds the burster, an explosive charge that
15 disperses the chemical agent upon detonation. The liquid agent itself is contained in the annular
16 region between the burster well and the outer wall of the projectile. All projectiles stored at BGCA
17 have a nose closure device installed instead of the fuze.

18 **1.2.2.1 8-Inch Projectiles**

19 The 8-inch (20.32-cm) projectile, designated as M426, has a mass of more than 90 kg and
20 contains GB chemical agent. These projectiles are stored without a burster charge and have a
21 nose closure attached at the top of the burster well.

22 **1.2.2.2 Overpacked Leaker Projectiles**

23 Currently, 26 leaking GB 8-inch projectiles have been overpacked at the BGAD. These munitions
24 will be processed in the same manner as non-leaking projectiles after being removed from the
25 overpack container.

**24915-000-GPE-GGPT-00001 – RESEARCH, DEVELOPMENT, AND DEMONSTRATION (RD&D) PERMIT
APPLICATION CDRL #A010**

1.2.3 M55 Chemical Rocket Assembly


The M55 Chemical Rocket Assembly consists of a chemical agent-filled M56 Warhead Assembly attached to a M67 Rocket Motor Assembly. The M55 Chemical Rocket Assembly has a diameter of 115 millimeters (4.44 inches), is 78 inches long, and weighs 57 pounds [74 pounds in the M441 Shipping and Firing Container/Tube (SFT)]. The warhead is filled with either 10.7 pounds of GB or 10.0 pounds of VX. The rocket is an airborne weapon propelled by a mixture of a fuel and an oxidizer. The only rocket type in the chemical stockpile is the 115-mm diameter M55 Chemical Rocket Assembly. It consists of two sections:

- M56 Warhead Assembly: An aluminum-alloy warhead section, which contains the chemical agent, two bursters, and the fuze, and
- M67 Rocket Motor Assembly: A steel motor section, which contains the propellant grain, the igniter assembly, and the nozzle and fins.

The bursters are composed of Composition B (Comp B) explosive. The propellant is double-base M28 (nitroglycerin/nitrocellulose). Each M55 Rocket Assembly is stored in a fiberglass [reinforced with plastic] cylindrical container (shipping and firing container/tube (SFT)). The container is closed at each end with a removable aluminum cap. Each cap is outfitted with a sampling plug. The rockets are stored in specially designed wooden pallets, which keep the rockets elevated from contact with the floor of the storage.

NOTE: Both GB and VX M55 rockets are part of the BGCA chemical stockpile, however, only the GB-filled rockets and warheads will be treated under the RD&D permit.

Figure 1-1 – 155-mm Rocket Diagram

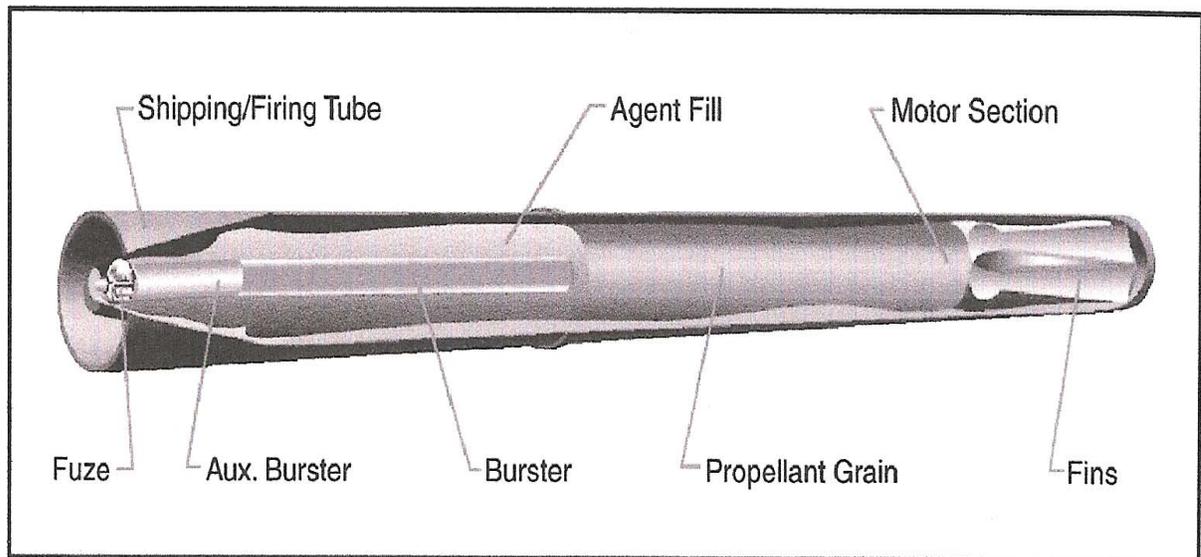

**24915-000-GPE-GGPT-00001 – RESEARCH, DEVELOPMENT, AND DEMONSTRATION (RD&D) PERMIT
APPLICATION CDRL #A010**

1 **1.2.3.1 M441 SFT Assembly**

2 The rocket is stored in the M441 SFT assembly. The container tube is made of
3 fiberglass-reinforced resin, either epoxy or polyester, and in some cases contains polychlorinated
4 biphenyls (PCBs). There is an indexing ring on the outside of the tube toward the fore end of the
5 rocket. There are end caps on each end made of aluminum and secured to the tube by pins.
6 Each end cap has a sampling port.

7 PCB concentrations in the SFTs range from under 50 parts per million (ppm) to more than
8 2,000 ppm. The PCB concentrations are regulated under the Toxic Substances Control Act
9 (TSCA) regulations and are subject to disposal requirements of 40 CFR 761.62(c).

10 Information provided in this section is based on a study by the U.S. Army Environmental Hygiene
11 Agency (i.e., Hazardous Waste Study No. 37-26-1345-86 and -87), which sampled and analyzed
12 SFTs in the Tooele Army Depot (now called the Deseret Chemical Depot) to determine the PCB
13 concentration in the SFTs. This information has been used by the EPA as the basis for issuing the
14 nationwide approval for incineration of PCBs at the four continental United States Chemical
15 Demilitarization Incineration Facilities. The PCB aspects of the project are subject to regulation by
16 the EPA Region 4. A separate environmental permit application has been prepared and submitted
17 to EPA Region 4 to address the processing of the PCB-contaminated SFTs as part of the
18 M55 "leaker" campaign.

19 **1.2.3.2 M56 Warhead Assembly**

20 The M56 Warhead Assemblies consist of a body, a burster well containing two bursters in series, a
21 fuze adapter, and a point detonating fuze. The body is a hollow, thin-walled structure made of
22 6061 T6 alloy aluminum with a wall thickness of 0.058±0.012 inches. The burster well also is
23 made from 6061 T6 alloy aluminum and is welded to the body at the nose end. Inside the rocket
24 body, the burster well terminates in an aluminum rod. The rod has a cup shaped fitting on the end,
25 which fits over the fill port in the base of the warhead. The rear burster consists of a low carbon
26 steel tube, with painted exterior and filled with Composition B (or Tetrytol, although none are
27 known to have this). The forward burster consists of a plastic tube filled with Composition B
28 (or Tetrytol although none are known to have this). The fuze contains a booster made from
29 research department explosive (RDX). Assembly of the fuze adapter to the warhead is made by
30 coating the threads with either Pettman cement or sealing compound and then screwing it into the
31 burster well. The fuze threads are also coated with either Pettman cement or sealing compound
32 before the fuze is screwed into the fuze adapter. Chemical agent (GB or VX) was added to the
33 warhead through a fill port in the base and then sealed inside by pressing two aluminum balls into
34 the fill port. The balls are of two different aluminum hardness. The harder ball goes in first and
35 then the softer ball. The softer ball is then pressed to produce a seal and is to be flush or below
36 flush with the base of the warhead.

37 M56 Warheads Assemblies are similar to the M55 Chemical Rocket Assemblies except that the
38 motor section has been removed; thus, M56 warheads contain agent and retain their bursters and
39 fuzes but do not contain M28 propellant.

**24915-000-GPE-GGPT-00001 – RESEARCH, DEVELOPMENT, AND DEMONSTRATION (RD&D) PERMIT
APPLICATION CDRL #A010**

1 **1.2.3.3 M67 Rocket Motor Assembly**

2 The Rocket Motor Assembly consists of a case, M150 fin/nozzle assembly, M28 propellant, anti-
3 resonance rod assembly (with M62 igniter assembly), and a fore closure. The case is a steel tube
4 with a wall thickness of 0.096±0.008 inch, which is threaded on the interior of both ends. The
5 M150 fin/nozzle assembly is attached to the motor case by coating the threads with either Pettman
6 cement or sealing compound and then screwing the assembly into the body. The M28 propellant
7 is a double-base cast grain per MIL-P-60071 specifications and weighs 19.25 pounds. It is
8 installed by first bonding a spacer to aft end, adding the anti-resonance rod assembly, and then
9 sliding the grain assembly into the motor case until the spacer rests on the M150 fin/nozzle
10 assembly. Assembly of the rocket motor is completed by coating the threads of the fore closure
11 with a sealing compound and then threading it into the body. When the closure is installed, it
12 compresses a spring on the anti-resonance rod assembly to hold the propellant grain in place
13 against the fin assembly. The warhead is assembled to the rocket motor by coating the threads
14 with either Pettman cement or a sealing compound and then screwing the two components
15 together.

16 **1.2.3.4 Overpacked “Leaker” M55 Rockets**

17 Currently, there are approximately 150 known, “leaker” munitions in storage at the BGAD, of which
18 less than 100 are GB rockets and the remainders are H projectiles. Leaker GB 115-mm
19 M55 rockets have been overpacked at BGCA and will be processed after they are removed from
20 the overpack container as discussed in paragraph 3.3.3.1.3.

21 **1.2.4 Secondary Wastes**

22 Six major types of secondary waste will be generated at the BGCAPP; these wastes are described
23 in the following subparagraphs.

24 **1.2.4.1 Wood Pallets**

25 All munitions are stored on wood pallets in the igloos. As munitions are transferred to the
26 BGCAPP, wood pallets and metal straps not contaminated with agent [i.e., determined by
27 enhanced onsite container (EONC) monitoring prior to opening], will be shipped off site for disposal
28 or treatment in an appropriate facility. All wood pallets and other dunnage associated with leaking
29 munitions will be treated as agent contaminated dunnage and will be processed as described in
30 section 3, paragraph 3.3.3.2.

31 **1.2.4.2 Agent-Contaminated Plastic and PPE**

32 Plastic materials and PPE that are not contaminated with agent will be shipped off site for disposal
33 or treatment in an appropriate facility. Plastic and PPE (plastic, rubber, and gas mask carbon
34 filters) are assumed to be contaminated if they have been exposed to agent; they will be processed
35 as described in section 3, paragraph 3.3.3.3.

36 **1.2.4.3 Miscellaneous Agent-Contaminated Metal Parts**

37 Miscellaneous agent-contaminated metal parts generated during the RD&D program are sent
38 directly to the metal parts treater (MPT) for thermal treatment (i.e., a minimum of 1,000°F for
39 15 minutes) before they are shipped off site for disposal or treatment in an appropriate facility.
40 These wastes will be processed as described in section 3, paragraph 3.3.3.4.

**24915-000-GPE-GGPT-00001 – RESEARCH, DEVELOPMENT, AND DEMONSTRATION (RD&D) PERMIT
APPLICATION CDRL #A010**

1 **1.2.4.4 Agent-Contaminated Spent Activated Carbon**

2 Agent-contaminated spent activated carbon from the heating, ventilating, and air conditioning
3 (HVAC) filters that is generated during the RD&D program will be processed as described in
4 section 3, paragraph 3.3.3.5.

5 **1.2.4.5 Reverse Osmosis (RO) Brine Solution**

6 The supercritical water oxidation (SCWO) effluent is a brine solution comprised primarily of sodium
7 sulfate (Na₂SO₄), sodium chloride (NaCl), sodium fluoride (NaF), and sodium monophosphate
8 (NaH₂PO₄). The RO Unit is designed to produce a water stream that is of sufficient quality to be
9 recycled to the SCWO process (approximately 70 percent) and a wastewater stream (RO reject)
10 that will be characterized and shipped for disposal or treatment in an appropriate facility. This
11 process is discussed further in section 3, paragraph 3.3.1.4.

12 **1.2.4.6 Other Secondary Wastes**

13 During the RD&D program, other secondary wastes may be generated at the BGCAPP. As these
14 waste streams are identified, they will be characterized prior to treatment. If they are contaminated
15 with agent, either the wastes will be treated at the BGCAPP through the appropriate waste
16 handling system, or decontaminated and shipped off site for disposal or treatment in an
17 appropriate facility. If the waste is not contaminated with agent, the secondary waste will be
18 shipped off site for disposal or treatment in an appropriate facility.

19 **1.2.4.7 Laboratory Wastes**

20 Various laboratory wastes will be generated during agent processing at the BGCAPP. These
21 include typical laboratory wastes [e.g., solvents, glassware, towels/rags, personal protective
22 equipment (PPE)]. The Kentucky hazardous waste code for GB (i.e., N001) will be attached to
23 many of the laboratory waste streams due to contact with agent containing samples and wastes.

24 Wastes that are generated as a part of normal laboratory operations will be managed on-site as
25 required in appropriate satellite accumulation areas (SAAs) or in other permitted waste storage
26 areas such as the Waste Storage Area (WSA) or the Waste Transfer Station (WTS). All laboratory
27 wastes will be sent off site for final disposal.

28 **1.2.5 Process Wastes Generated During GB Campaign**

29 Table 1-2 summarizes the estimated quantity of waste generated during the GB campaign. The
30 waste streams will come from four primary sources:

- 31 1) MPT residues – This waste stream will consist of projectile bodies and rocket pieces
32 consisting of steel as well as SFTs from Contaminated Rocket Motors after processing
33 through the MPT, as well as any miscellaneous metal parts and secondary wastes that are
34 generated during the treatment processes.
- 35 2) Aluminum filtration system (AFS) Precipitate – This waste stream will consist of the
36 aluminum compounds precipitated and filtered out of the energetics hydrolysate generated
37 from the treatment of rockets. This will primarily be in the form of a filter cake.
- 38 3) RO Reject Brine Solution – The treated hydrolysate from the SCWO units will be
39 processed through the RO system to recycle as much water as possible back into the
40 process. Waste brine solution will be shipped off site for disposal at a permitted treatment,
41 storage, and disposal facility (TSDF). The recovered water will be recycled back into the
42 process in lieu of makeup water or shipped off site to a permitted TSDF if necessary.

**24915-000-GPE-GGPT-00001 – RESEARCH, DEVELOPMENT, AND DEMONSTRATION (RD&D) PERMIT
APPLICATION CDRL #A010**

1 4) Rocket motors (RMs) – This waste stream consists of the rocket motors not associated
2 with the “leakers”. These rocket motors will be separated from the rocket warhead but are
3 not currently planned for processing in the BGCAPP. BGCAPP is currently working to
4 identify a treatment process and location for this waste stream.

5 It is important to note that the RO system greatly reduces the amount of waste that will be
6 generated for off-site disposal from BGCAPP during the life of the project and will be an integral
7 part of BGCAPP’s waste minimization program. Table 1-6 below further illustrates the examples of
8 the types of process wastes expected to be generated as well as the location and source of the
9 wastes.

10

**24915-000-GPE-GGPT-00001 – RESEARCH, DEVELOPMENT, AND DEMONSTRATION (RD&D) PERMIT
APPLICATION CDRL #A010**

1
2

Table 1-4 – Analytical Data for GB in 155-mm Rockets

Compound (wt%)	Average	Maximum	Minimum
Agent GB	85.1	97.0	44.8
DIMP	4.5	10.8	2.7
TBA	5.6	5.9	5.5
DIU	0.9	2.4	0.4
DICDI	0.4	1.1	0.0
Metals (mg/kg)			
Aluminum	628.3	3205.0	10.0
Antimony	26.3	154.0	0.2
Arsenic	7.0	34.0	3.5
Barium	4.7	40.0	0.1
Beryllium	0.1	0.6	0.0
Boron	1135.8	4585.0	4.1
Cadmium	3.2	12.0	1.1
Chromium	3.2	12.0	1.1
Cobalt	2.5	8.9	0.1
Copper	13.4	120.0	1.7
Lead	9.8	46.0	0.6
Manganese	2.7	18.2	0.6
Mercury	0.1	0.2	0.0
Nickel	7.2	31.0	2.1
Selenium	16.3	92.0	0.4
Silver	1.2	6.2	0.1
Thallium	26.3	154.0	0.1
Tin	53.3	308.0	1.1
Vanadium	1.4	6.2	0.7
Zinc	28.8	172.0	5.4
Source: Tooele Chemical Agent Destruction Facility, 1996-1998			

**24915-000-GPE-GGPT-00001 – RESEARCH, DEVELOPMENT, AND DEMONSTRATION (RD&D) PERMIT
APPLICATION CDRL #A010**

Table 1-5 – Analytical Data for GB in 8-Inch Projectiles

Agent Lot No.	1034-54-1005	1034-62-1330
% GB	89.59	86.53
Metals, ppm		
Iron	102.43	521.27
Copper	<0.010	<0.008
Nickel	<0.019	<0.015
Aluminum	34.61	28.49
Source: Surveillance Program, Lethal Chemical Agents and Munitions (SUPLECAM) Report, 1979		

Table 1-6 – Examples of Primary Process Wastes

Primary Process Waste	Source Equipment	Room Name	Room Number	Room Category
SFTs	RCMs	ECV-1	07-103	A/B
SFTs	RCMs	ECV-2	07-106	A/B
Strainer Basket Waste	RSMs	ECR-1	07-104	A
Strainer Basket Waste	RSMs	ECR-2	07-105	A
Strainer Basket Waste	NCRM/CAMs	MWS	07-135	A
Accumulated MPT Ash	MPT	MPT	07-146	B
Ash in MPT Trays	MPT	MPT Cooling Conveyor	07-150	D
OTM Cyclone Ash	TOX/Cyclone	OTM Area	07-140	C

**24915-000-GPE-GGPT-00001 – RESEARCH, DEVELOPMENT, AND DEMONSTRATION (RD&D) PERMIT
APPLICATION CDRL #A010**

1 **2.0 PROCESS ENGINEERING**

2 This section describes the overall facility and its individual systems and components.
3 Paragraph 2.1 describes the buildings and structures and the plant subsystems that constitute the
4 complete facility to include building structures and systems/subsystems (e.g., the air pollution
5 control systems) that capture contaminants that might be released from the processing equipment
6 and activities within the buildings. Comparatively few of the buildings, structures, and systems
7 store or treat hazardous waste, and only those so identified are subject to regulation under this
8 RD&D permit.

9 Paragraph 2.2 describes the construction sequence and environmental compliance during
10 construction, while Paragraphs 2.3 and 2.4 discuss the Independent Facility Construction
11 Certification and Plant Systemization, respectively. Paragraph 2.5 discusses the Performance and
12 Objectives of the RD&D Program while Paragraph 2.6 discusses operations subject to
13 KHW regulations.

14 **2.1 Facility Description**

15 Most of the buildings that constitute the BGCAPP are support structures which are not used to
16 manage or contain hazardous wastes and are not subject to regulation by the KDEP. The
17 buildings in which hazardous wastes are stored and/or treated are designed to provide
18 maximum protection to human health and the environment. Figure 2-2 shows the BGCAPP site
19 plan.

20 **2.1.1 Building and Structure Definitions**

21 **2.1.1.1 Pre-engineered Metal Buildings**

22 These are metal buildings constructed of prefabricated steel columns and trusses and erected
23 onsite. This type of building is covered with composite sheet metal siding (i.e., insulation
24 sandwiched between inner and outer sheet metal) and is pre-painted to color and coating
25 requirements. No architectural finishes, process, utility systems, or equipment are preinstalled.

26 **2.1.1.2 Modular Buildings**

27 These metal- and wood-framed buildings are of various lengths and widths that can be connected
28 together on site. They are fabricated of sheet metal or aluminum siding for the exterior, and metal
29 or wood studs with either gypsum board or paneling on the interior. To the maximum extent
30 possible, all architectural finishes, process and utility systems, and some equipment will be
31 preinstalled.

32 **2.1.1.3 Field Fabricated Areas and Buildings**

33 Various construction materials and pre-engineered bulk commodities are used to the maximum
34 extent possible; however, some field fabrication is required. All architectural finishes, process,
35 utility systems, and equipment are erected in place.

**24915-000-GPE-GGPT-00001 – RESEARCH, DEVELOPMENT, AND DEMONSTRATION (RD&D) PERMIT
APPLICATION CDRL #A010**

1 **2.1.2 Buildings and Structures Containing Hazardous Waste Management**
2 **Units**

3 **2.1.2.1 Container Handling Building (CHB)**

- 4 1) Description – Permitted CHB used to store munitions received from storage igloos.
5 2) Method of Construction – Pre-engineered metal building.
6 3) Major Equipment – Enhanced onsite containers (EONCs)

7 **2.1.2.2 Munitions Demilitarization Building (MDB)**

- 8 1) Description – Pre-engineered building shell with an inner, field-fabricated reinforced
9 concrete building that contains explosive containment rooms (ECRs).
10 2) Method of Construction – Field Fabrication
11 3) Major Equipment:
12 a. Rocket cutting machine (RCM)
13 b. Rocket shear machine (RSM)
14 c. Metal parts treater (MPT)
15 d. Energetics batch hydrolyzer (EBH)
16 e. Agent neutralization reactors (ANR)
17 f. Energetics neutralization reactors (ENR)
18 g. Munition washout system (MWS)
19 h. Nose Closure Removal System (NCRS)
20 i. Off-gas treatment units (OTE and OTM)
21 j. Material handling systems and components
22 k. Blast gates and doors

23 **2.1.2.3 SCWO Processing Building (SPB)**

- 24 1) Description – Pre-engineered building. SCWO equipment and Tank Area.
25 2) Method of Construction – Pre-engineered metal building.
26 3) Major Equipment:
27 a. SCWO units
28 b. RO system
29 c. Recycled water storage
30 d. Aluminum Precipitation System (APS)
31 e. Aluminum Filtration System (AFS)
32 f. SCWO Tank Area (STA) and Storage Tanks

33 **2.1.2.4 Hydrolysate Storage Tanks and Tank Area**

- 34 1) Description – Large carbon steel tanks and liquid transfer equipment for the agent and
35 energetics hydrolysate from the MDB. Serves as buffer storage for processing hydrolysate
36 feeds to the SPB.
37 2) Method of Construction – Field Fabrication.
38 3) Major Equipment:
39 a. Agent and energetic hydrolysate storage tanks
40 b. Transfer pumps and ancillary piping systems

**24915-000-GPE-GGPT-00001 – RESEARCH, DEVELOPMENT, AND DEMONSTRATION (RD&D) PERMIT
APPLICATION CDRL #A010**

1 **2.1.2.5 Modular Lab (LAB)**

- 2 1) Description – Modular building used to house shift LAB personnel and to conduct
3 procedures to support the neutralization operations and documentation requirements.
4 2) Method of Construction – Modular building.
5 3) Major Equipment – Laboratory instrumentation and hoods.

6 **2.1.2.6 Waste Transfer Station (WTS)**

- 7 1) Description – Container storage area with a sprung structure used for staging wastes
8 generated in the BGCAPP prior to offsite shipment to final treatment/disposal facility. This
9 area is outside the CLA.
10 2) Method of Construction – Field Fabrication
11 3) Major Equipment – Sprung storage structure and concrete pads

12 **2.1.2.7 Waste Storage Area (WSA)**

- 13 1) Description – Sprung structure located northeast of the MDB where various hazardous
14 wastes will be stored prior to transfer of wastes to the WTS. This area is inside the CLA.
15 2) Method of Construction – Field Fabrication
16 3) Major Equipment – Sprung storage structure and concrete pads.

17 **2.1.2.8 Bulk Waste Storage Area (BWSA)**

- 18 1) Description – Two separate, but equal outdoor storage areas capable of storing hazardous
19 wastes in tanker trucks. There will also be a concrete pad for roll-off container storage
20 prior to the shipment of the wastes off-site.
21 2) Method of Construction – Field Fabrication
22 3) Major Equipment – Pre-engineered slab with secondary containment for tankers and
23 roll-off containers.

24 **2.1.3 MDB Cascade HVAC System Description**

25 **2.1.3.1 HVAC System Functions**

26 The HVAC system of the MDB is an important system at the BGCAPP and is permitted in the
27 BGCAPP Title V air permit as an air pollution control system. Proper operation of the HVAC
28 system is required to maintain the negative pressure within the MDB while providing heating and
29 air conditioning for toxic and nontoxic areas. The cascade HVAC system serves a fourfold
30 purpose:

- 31 1) Maintain a negative pressure environment in the MDB.
32 2) Maintain the flow of air from areas of low contamination probability to areas of higher
33 contamination probability.
34 3) Remove agent from the air prior to discharge to the atmosphere after the air stream has
35 passed through other air pollution control systems including the off-gas treatment for the
36 MPT (OTM) and the EBH (OTE).
37 4) Provide for human comfort.

**24915-000-GPE-GGPT-00001 – RESEARCH, DEVELOPMENT, AND DEMONSTRATION (RD&D) PERMIT
APPLICATION CDRL #A010**

1 The primary means of preventing the release or spread of contamination is through the use of
2 cascaded pressure control. Toxic areas are maintained at a negative pressure with respect to
3 atmospheric pressure. This arrangement ensures a flow of air from the areas with the least agent
4 contamination to the areas with the most contamination in the MDB and ensures containment
5 within the MDB.

6 The amount of air exhausted from or supplied to a room is higher in areas likely to be
7 contaminated. This minimizes the spread of contamination and maintains the toxic boundaries.
8 Air flow is controlled by modulating the supply air, by modulating the flow of exhaust air, and by
9 setting dampers throughout the building.

10 **2.1.3.2 Room Category Description**

11 Each room in the MDB has a designated category rating (i.e., A, B, C, D, or E) based on the
12 potential for agent contamination:

- 13 1. Routinely contaminated by either agent liquid or vapor (Category A).
- 14 2. High probability of agent vapor contamination resulting from routine operations
15 (Category B).
- 16 3. Low probability of agent vapor contamination (Category C).
- 17 4. Not expected to be contaminated by agent (Category D).
- 18 5. Maintained at positive atmospheric pressure at all times to prevent contamination by agent.
19 For example, the central control room (CCR) is maintained at a positive atmospheric
20 pressure since it will remain occupied even in the event of an emergency (Category E).

21 Only rooms with Category A, Category B, or Category C ratings are maintained under a continuous
22 negative pressure by the HVAC system. All process components that involve agent or
23 agent-contaminated materials are contained in the MDB, which is vented into HVAC filters that
24 process all air drawn by the HVAC system. It is described here to support the assertion that the
25 RD&D activities will be performed in a manner that is protective of human health and the
26 environment. The HVAC system controls contaminants that might be released from the process
27 whether as a point source or as a fugitive emission.


28 Each filter unit consists of the following stages:

- 29 1) A row of pre-filters, which remove the larger particulate matter
- 30 2) A row of high-efficiency particulate air (HEPA) filters, which remove very fine particulate
31 matter
- 32 3) Six rows of carbon filters, which remove agent and other gaseous contaminants such as
33 organic vapors

34 A final row of HEPA filters, which capture any particulate that may be released from the carbon
35 filters. Figure 2-1 shows the typical configuration of an HVAC filter unit.

**24915-000-GPE-GGPT-00001 – RESEARCH, DEVELOPMENT, AND DEMONSTRATION (RD&D) PERMIT
APPLICATION CDRL #A010**

Figure 2-1 – MDB HVAC Filter Unit

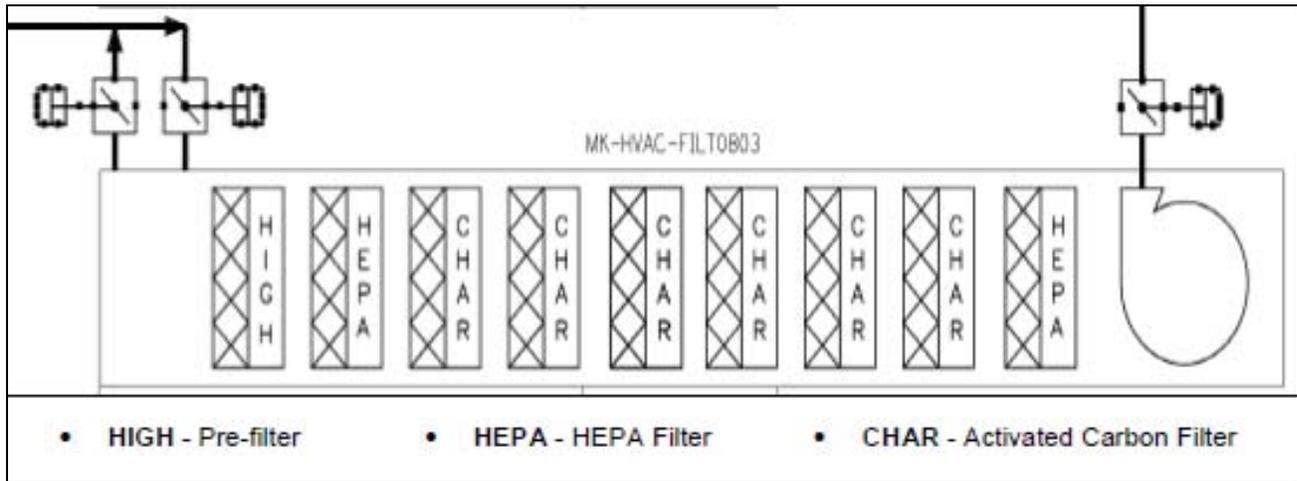

2.1.4 Laboratory Filtration

The original design basis for the filtration of the laboratory included LAB filter bank housings to be used at the BGCAPP, similar to baseline incineration sites. Based on a 2009 review of applicable laboratory requirements, and a white paper titled “BGCAPP Laboratory Exhaust Filtration”, dated June 8, 2010, it was determined that the dual LAB filter banks were not necessary to provide filtration of the 14 lab fume hoods, as the BGCAPP LAB is not a “Surety” lab, but a research, development, test, and evaluation (RDTE) LAB, which would allow the filter bank requirement to be excepted.

The modification consisted of adding inline charcoal filters to the ventilation hoods in the lab, which would provide adequate, necessary filtration of the fume hoods in question. This design change was submitted to KDEP and approved via correspondence dated August 6, 2010 and the modified design has been incorporated in accordance with this approval. Additional requested information, including as-built drawings, the inspection schedule, and a revised site plan will be provided when these documents are prepared.

2.1.5 Buildings and Structures Not Containing Hazardous Waste Management Units (HWMUs)

2.1.5.1 Access Control Building (ACB)

The ACB is a freestanding building that will be located at the entrance of the BGAD and will be used to control access to the BGAD.

- 1) Description – Facility size and shape will depend on outcome of security requirement discussions with BGAD and recent security changes for installations.
- 2) Method of Construction – Modular or field fabricated (decision pending).
- 3) Major Equipment – SDG.

**24915-000-GPE-GGPT-00001 – RESEARCH, DEVELOPMENT, AND DEMONSTRATION (RD&D) PERMIT
APPLICATION CDRL #A010**

1 **2.1.5.2 Badging Facility**

- 2 1) Description – Houses security personnel who issue badges for site access.
3 2) Method of Construction – Prefabricated modular building.
4 3) Major Equipment – None.

5 **2.1.5.3 Control and Support Building (CSB) and Integrated Control System (ICS)**

- 6 1) Description – CCR and ICS used to operate BGCAPP, some storage and change facility,
7 and breathing air auxiliary systems, and demilitarization protective ensemble (DPE)
8 storage. The ICS includes all of the programming, graphics, wiring, and devices located
9 throughout BGCAPP for the facility control system (FCS) and facility protection system
10 (FPS).
11 2) Method of Construction – Pre-engineered metal building included as part of the MDB
12 separated by an access way.
13 3) Major Equipment – CCR, consoles, and cabinets.

14 **2.1.5.4 Entry Control Facility (ECF)**

- 15 1) Description – Provides access to the new BGCAPP chemical limited area (CLA).
16 2) Method of Construction – Modular.
17 3) Major Equipment – SDG.

18 **2.1.5.5 Gas Mask Storage Building (GSB)**

- 19 1) Description – Modular building with no major systems or equipment. Its only requirement
20 is to store gas masks within their storage requirements. Lighting and lockers are the only
21 other known requirements.
22 2) Method of Construction – Modular building.
23 3) Major Equipment – None.

24 **2.1.5.6 Maintenance Building (MB)**

- 25 1) Description – Pre-engineered building with utility system. It is expected to house a shop
26 area, tool crib, and a supply of operational material and spares. The maintenance shop
27 has areas for welding, small metal fabrication, conduit bending, tool storage, and
28 maintenance consumables and flammable material storage.
29 2) Method of Construction – Pre-engineered metal building.
30 3) Major Equipment – None.

31 **2.1.5.7 Personnel Maintenance Building (PMB)**

- 32 1) Description – Baseline facility expected to be a pre-engineered building with only utility
33 systems being supplied. It will house the medical facilities, personnel lockers, showers,
34 lunchroom, and equipment required to support operations.
35 2) Method of Construction – Pre-engineered metal building.
36 3) Major Equipment – None.

**24915-000-GPE-GGPT-00001 – RESEARCH, DEVELOPMENT, AND DEMONSTRATION (RD&D) PERMIT
APPLICATION CDRL #A010**

1 **2.1.5.8 Personnel Support Building (PSB)**

- 2 1) Description – Modular building with utility systems being supplied. Its primary purpose is to
3 house operation, maintenance, and engineering employees that support the daily activities
4 of the plant.
5 2) Method of Construction – Modular building.
6 3) Major Equipment – None.

7 **2.1.5.9 Standby Diesel Generators (SDGs)2**

- 8 1) Description – Diesel-fueled electrical power generators.
9 2) Method of Construction – Modular.
10 3) Major Equipment – SDGs.

11 **2.1.5.10 Substation (SUB)**

- 12 1) Description – An outdoor electrical switchyard constructed on the installation will furnish
13 power to the site.
14 2) Method of Construction – Modular.
15 3) Major Equipment – Switchgear and transformers.

16 **2.1.5.11 Utility Building (UB)**

- 17 1) Description – Pre-engineered steel framed structure with composite siding and a roof deck
18 over slab on grade. Houses plant utility systems and local control panels.
19 2) Method of Construction – Pre-engineered metal building.
20 3) Major Equipment:
21 a. Package boilers and related auxiliary systems
22 b. Compressors
23 c. Chillers
24 d. Motor control centers (MCCs)

25 **2.1.5.12 Bulk Chemical Storage (BCS)**

26 The BCS will provide tank storage for the following chemicals:

- 27 1) Sulfuric acid (H_2SO_4)
28 2) Sodium hypochlorite ($NaOCl$)
29 3) Sodium hydroxide ($NaOH$)
30 4) Phosphoric acid (H_3PO_4)
31 5) Isopropyl alcohol (C_3H_8O)
32 6) Liquid nitrogen

33 **2.1.5.13 Temporary Construction Facilities**

34 During construction, systemization, and possibly during pilot testing, the following temporary
35 facilities will be provided to effectively manage and perform the construction of BGCAPP:

- 36 1) Field offices (trailers)
37 2) Warehouses – storage handling
38 3) Change houses

**24915-000-GPE-GGPT-00001 – RESEARCH, DEVELOPMENT, AND DEMONSTRATION (RD&D) PERMIT
APPLICATION CDRL #A010**

- 1 4) Fabrication shops
- 2 5) Welder's test shop
- 3 6) First Aid Trailer
- 4 7) Temporary toilet facilities

2.1.5.14 Vehicle Support Facility (VSF)

- 6 1) Description – The building will be used to service vehicles and contains an area for
7 performing maintenance activities for uncontaminated equipment. On rare occasions,
8 decontamination equipment from the BGCAPP may be brought to the VSF for repair. The
9 building is expected to house a shop area, tool crib, and a supply of operational materials
10 and spares. It includes a maintenance shop that has areas for welding, small metal
11 fabrication, instrument calibration, tool storage, and storage space for maintenance
12 consumables. The VSF is a metal framed structure on a concrete slab. It is located inside
13 of the CLA. No hazardous waste, including energetics, agent or agent-contaminated
14 materials, will be stored or processed in the VSF.
- 15 2) Method of Construction – Field fabricated.
- 16 3) Major Equipment – None

**2.1.6 Plant Systems and Subsystems Not Containing Hazardous Waste
Management Units**

17 The following systems are an integral part of the plant, but they do not contain any hazardous
18 waste management units. They are included here only to provide a complete description of the
19 construction of the facility.

- 22 1) Process water system
- 23 2) Cooling water system
- 24 3) Compressed air and nitrogen
 - 25 a. Instrument air system
 - 26 b. Plant air system
 - 27 c. Life support air system
 - 28 d. Nitrogen supply system
- 29 4) Fire protection systems:
 - 30 a. Wet and/or dry pipe sprinkler system, through all permanent buildings
 - 31 b. Dry chemical system
 - 32 c. ECR deluge fire system
 - 33 d. CSB fire extinguishing medium (FEM) (inert gas) fire protection system
- 34 5) Fire detection systems for the following buildings:
 - 35 a. MDB
 - 36 b. Utility building (UB)
 - 37 c. SPB
 - 38 d. CHB
 - 39 e. LAB
 - 40 f. PMB
 - 41 g. CSB

**24915-000-GPE-GGPT-00001 – RESEARCH, DEVELOPMENT, AND DEMONSTRATION (RD&D) PERMIT
APPLICATION CDRL #A010**

- 1 h. PSB
- 2 i. ECF
- 3 6) Site communication systems (site communication meets all requirements of 401 Kentucky
- 4 Administrative Regulation (KAR) 34:020)
- 5 a. Site public address (PA) and paging system
- 6 b. Closed-circuit television (CCTV) system
- 7 c. Site radio system
- 8 d. Agent alarm lights
- 9 7) HVAC steam and hot water supply system
- 10 8) Site utilities (above ground and underground)
- 11 9) Intrusion prevention system
- 12 a. CCTV system
- 13 b. Motion detectors

14 **2.2 Construction Sequence**

15 The construction sequence is described in the following two subsections.

16 **2.2.1 Site Preparation**

17 The following site-preparation activities were performed prior to the start of construction of the
18 BGCAPP:

- 19 1) Installed the outer perimeter security fence, to include silt control specified by the BGCAPP
- 20 Soil Erosion Management Plan (24915-00-G01-GGEN-00001).
- 21 2) Cleared and grubbed the site, and prepared the lay down areas surrounding the facility
- 22 (including roads).
- 23 3) Brought the site to the proper grade and established drainage.
- 24 4) Installed the temporary construction roads, using the permanent plant road sub grade and
- 25 base course, wherever possible.
- 26 5) Excavated and installed the sediment retention basins.
- 27 6) Installed the storm drain system.

28 Dust control procedures were implemented immediately upon site occupancy. Water trucks with
29 water monitors were used as necessary to control dust during construction. These trucks or similar
30 equipment also were used during site preparation for soil compaction activities.

31 **2.2.2 Construction Sequence**

32 The precise construction sequence was dependent on funding availability and on the conditions
33 encountered during construction. The following tentative construction sequence is presented for
34 information but does not reflect the status of completed units. (Many units listed below have been
35 or are in the process of being completed.):

- 36 1) Access road and parking lot (ARP)
- 37 2) Site plan (SP)
- 38 3) Access control building (ACB)
- 39 4) Site utility systems underground (U/G)
- 40 5) Badging facility

**24915-000-GPE-GGPT-00001 – RESEARCH, DEVELOPMENT, AND DEMONSTRATION (RD&D) PERMIT
APPLICATION CDRL #A010**

- 1 6) Munitions demilitarization building (MDB)
- 2 7) Maintenance building (MB)
- 3 8) Control and support building (CSB)
- 4 9) Electrical substation (SS)
- 5 10) Utility block/building (UB)
- 6 11) MDB filter area (FIL)
- 7 12) Site utility systems – above ground (A/G)
- 8 13) Integrated process and facility control system (ICS)
- 9 14) Modular laboratory (LAB)
- 10 15) Container handling building (CHB)
- 11 16) SCWO processing building (SPB)
- 12 17) Hydrolysate storage area (HSA)
- 13 18) Entry control facility (ECF)
- 14 19) Personnel and maintenance building (PMB)
- 15 20) Standby diesel generators (SDGs)
- 16 21) Personnel support building (PSB)
- 17 22) Electronic security system (ESS)
- 18 23) Toxic maintenance building (TMB)
- 19 24) Gas mask storage building (GSB)

2.2.3 Environmental Compliance During Construction

21 The Safety and Health (S&H) construction safety plan includes specific details relating to
22 compliance with federal, state, and BGAD environmental regulations. The BGCAPP will comply
23 with the requirements of the RD&D permit version approved for the construction phase of the
24 project. For example, approval of the RD&D permit is required prior to the start of construction of
25 the HWMUs. Other items listed below provide the environmental regulatory framework in which
26 BGCAPP is being constructed (i.e., in addition to the hazardous waste requirements contained in
27 the RD&D permit).

- 28 1) Uncontaminated construction waste, including:
 - 29 a. Packing material
 - 30 b. Machinery components
 - 31 c. General household waste (e.g., food scraps, waste)
 - 32 d. Landscape waste
 - 33 e. Construction or demolition debris
- 34 2) Hazardous waste, including:
 - 35 a. Waste lubricating oil, motor fuel, hydraulic oils, and cutting oils
 - 36 b. Cleaning solvents such as those used by pipefitters, millwrights, and electricians
 - 37 c. Paint wastes (water- or oil-based) such as rags, slops, sludge, paint solvents, paint
38 and varnish removers and strippers, and paint cans containing paint residue
- 39 3) Use, storage, transportation, and disposal of hazardous materials and hazardous wastes
40 will comply with the BGAD, state, and federal requirements
- 41 4) Stormwater runoff control measures will comply with the KYR100000 permit for general
42 construction sites

**24915-000-GPE-GGPT-00001 – RESEARCH, DEVELOPMENT, AND DEMONSTRATION (RD&D) PERMIT
APPLICATION CDRL #A010**

1 **2.3 Facilities Construction Certification**

2 During construction, a Professional Engineer (P.E.) licensed in Kentucky (or designee) will be
3 present at the facility to verify the HWMUs are being built in accordance with the facility design.
4 Before pilot testing with hazardous waste begins, a P.E. (licensed in Kentucky) will perform
5 facilities construction certification (FCC) of each Kentucky-regulated hazardous waste building,
6 area, and system. The P.E. will certify that each building, area, and system has been constructed
7 as designed and in accordance with the RD&D permit. The FCC process is required by
8 401 KAR 38:030, which in this case is governed by 40 CFR 270.30 (l)(2)(i).

9 **2.4 Systemization**

10 The construction sequence described in paragraph 2.2 results in the individual subsystems being
11 completed in a staged manner. As a subsystem is completed, it will be turned over to the
12 Systemization Group who will test its mechanical ability, liquid and gas containment integrity, and
13 numerous other functions. Systemization will be conducted using simulant and surrogate materials
14 and no chemical agent or any agent-contaminated materials will be processed during
15 systemization. Although the systemization phase of the program does not involve the processing
16 of hazardous waste, it is the first part of the overall on-site RD&D program. The RD&D objective
17 that begins during systemization is the assessment of the system's overall ability to function as an
18 integrated unit and the identification of problems in the interfaces between the subsystems. It
19 should be noted that although systemization does not involve the treatment of hazardous wastes,
20 systemization may generate hazardous wastes (e.g., if sodium hydroxide is used during
21 systemization of agent treatment systems, the waste from this activity will likely be a hazardous
22 waste due to the characteristic of corrosivity). Hazardous wastes generated during systemization
23 will be handled in the same manner as hazardous wastes generated during construction.

24 **2.5 Performance of the RD&D Program – Pilot Testing**

25 After all of the subsystems have been subjected to rigorous testing under the systemization
26 program and the results of systemization have been deemed acceptable by the Army, Assembled
27 Chemical Weapons Alternatives (ACWA), and Bechtel Parsons Blue Grass (BPBG), the program
28 will move into the second on-site phase of the RD&D program, termed "pilot testing." Pilot testing
29 starts by processing the munitions at very slow rates with a large amount of testing and verification
30 taking place during the processing. Pilot testing will begin with the processing of GB rockets and
31 projectiles at the rates shown in Table 2-1. It is anticipated that testing with the GB inventory will
32 meet the system integration objectives of the RD&D program.

33 The bases for this conclusion are as follows:

- 34 • Table 2-1 shows that, during the RD&D program, GB munitions processing will begin slowly.
35 As the system is validated and issues are identified and resolved, the processing rates will
36 increase over a period of approximately 5 months. The 5-month period is based on an
37 assumption that no major problems arise. The program schedule is designed to allow sufficient
38 time to identify and overcome minor problems. If major problems arise during the RD&D period,
39 the RD&D program may require the full 1-year period allowed by the RD&D regulations that is
40 being requested in this permit application. It is the intent of BPBG to use the entire RD&D
41 campaign to treat all GB agent containing munitions and associated wastes. Should operations
42 take longer than the anticipated one year, BPBG may seek additional time as outlined in the
43 Office of Solid Waste and Emergency Response (OSWER) Policy Directive for RD&D permits.

**24915-000-GPE-GGPT-00001 – RESEARCH, DEVELOPMENT, AND DEMONSTRATION (RD&D) PERMIT
APPLICATION CDRL #A010**

Table 2-1 – BGCAPP Pilot Testing Nominal Feed Rates

Week of RD&D	Nominal Throughput, % ^a		Rounds/Hr ^b		Rounds/Week ^a		Rounds/Month		Hazardous Waste Processed, kg ^c	
	Rockets	Projectiles	Rockets	Projectiles	Rockets	Projectiles	Rockets	Projectiles	Hourly	Monthly
1	1.0	0.0	18	0	18	0			257	
2	2.0	0.0	20	0	36	0			285	
3	4.0	0.0	20	0	72	0			285	
4	4.0	0.0	20	0	72	0	198		285	2,823
5	7.9	0.0	20	0	144	0			285	
6	11.9	0.0	20	0	216	0			285	
7	18.9	0.0	20	0	342	0			285	
8	37.5	0.0	20	0	680	0	1,382		285	19,706
9	37.5	0.0	20	0	680	0			285	
10	37.5	0.0	20	0	680	0			285	
11	37.5	0.0	20	0	680	0			285	
12	50.0	0.0	20	0	907	0	2,947		285	42,022
13	50.0	0.0	20	0	907	0			285	
14	50.0	0.0	20	0	907	0			285	
15	50.0	0.0	20	0	907	0			285	
16	75.0	0.0	20	0	1,360	0	4,081		285	58,192
17	75.0	0.0	20	0	1,360	0			285	
18	75.0	0.0	20	0	1,360	0			285	
19	75.0	0.0	20	0	1,360	0			285	
20	100.0	56.4	20	16	1,814	352	5,894	352	390	86,359
21	100.0	56.4	20	16	1,814	352			390	
22	100.0	56.4	20	16	1,814	352			390	
23	100.0	56.4	20	16	1,814	352			390	
24	100.0	56.4	20	16	1,814	352	7,256	1,408	390	112,726
25	28.6	105.8	20	16	518	660			390	
26 ^d	0.0	0.0	0	0	0	0			0	
27-Test ^e	100.0	100.0	20	16	1,814	624			390	
28-Test ^e	100.0	100.2	20	16	1,814	625	4,146	1,909	390	71,675
TOTALS					25,904	3,669	25,904	3,669		393,503

^a The feed rates shown for the RD&D program are nominal. Actual processing rates will be established on the basis of RD&D.

^b These are the peak hourly rates that rockets (20/hr) and projectiles (16/hr) can be fed to the system. These rates do not necessarily correspond to the weekly peak operating rates because the plant can be operated to process agent and/or energetics even though no new munitions are being fed at the time.

^c Based on 14.3 kg of hazardous waste per rocket and 6.6 kg agent per projectile.

^d 12-day outage in preparation for performance test.

^e Test refers to the performance test, which will fully demonstrate the process at full operating rate.

**24915-000-GPE-GGPT-00001 – RESEARCH, DEVELOPMENT, AND DEMONSTRATION (RD&D) PERMIT
APPLICATION CDRL #A010**

2.5.1 Quantities of Waste to be Treated

This section justifies the need for the proposed quantities of waste that are to be treated under this RD&D program. The EPA Guidance Manual for Research, Development, and Demonstration Permit Units under 40 CFR Section 270-65 (EPA/530-SW-86-008, July 1986), page 8, recommends the following limits on the amount of waste that is to be treated under an RD&D permit:

1. Treat a maximum of 15,000 kg of hazardous waste per month for experimental purposes.
2. Store a maximum of 15,000 kg of hazardous waste intended for experimental purposes at any time.
3. Treat a maximum of 400 kg of hazardous waste per hour in any experiment.

Table 2-1 presents the hourly, weekly, and monthly hazardous waste processing rates in the proposed RD&D program. These processing rates are nominal and will be increased only after the success criteria have been achieved as described in paragraphs 2.5.1.1 through 2.5.2. The following discussion relates to these three rates. Since BGCAPP is a full-scale pilot plant, it is necessary that the above recommended maximum monthly rate (i.e., 15,000 kg/month) be exceeded in order to demonstrate full integration of the systems being tested under the RD&D program. Table 2-1 also presents the nominal ramp-up rates (as a percentage of full operation) for the processing of projectiles and rockets.

2.5.1.1 Hourly Operating Rate

The hourly processing rates shown in Table 2-1 are based on the maximum design processing rate for the BGCAPP, which for GB are 20 rockets and 16 projectiles per hour. Each rocket contains a total of 14.3 kg of hazardous waste (chemical agent, propellant, and explosives); each projectile, 6.6 kg. This results in a maximum of $(20 \times 14.3) + (16 \times 6.6) = 391.6$ kg/hr. This peak is less than the 400 kg/hr that is allowed by the RD&D guidance. This is the maximum processing rate for the design during any hour of operation. This maximum value is not achieved until week 20, when the nominal throughput (Table 2-1, columns 2 and 3) is increased to 100 percent because of the feeding of GB projectiles in preparation for the performance test.

2.5.1.2 Quantity of Waste Stored

The EPA's Guidance Manual for RD&D recommends that no more than 15,000 kg of hazardous waste intended for experimental purposes be stored at any one time. Because the quantities of wastes to be treated under the RD&D program exceed the 15,000 kg listed, the quantities of wastes to be stored resultingly will be greater than 15,000 kg as well.

2.5.1.3 Monthly Processing Rates

Table 2-1 also shows the monthly processing rates, which are calculated assuming 4 weeks of operation per month. These values exceed the 15,000 kg recommended by the EPA's Guidance Manual for RD&D. The justification for exceeding the recommended monthly quantity is based on the need to increase the processing rate to the maximum design rate by ramping up in small stepwise increments.

As discussed in paragraph 3.2.1.1, to safely test the system's integration (including the human factors) at rates approaching the BGCAPP's full operating rate, the hazardous waste must be processed at rates exceeding the 15,000 kg per month.

**24915-000-GPE-GGPT-00001 – RESEARCH, DEVELOPMENT, AND DEMONSTRATION (RD&D) PERMIT
APPLICATION CDRL #A010**

1 The hazardous waste (i.e., munitions) processing rates in Table 2-1 are maximums based on the
2 assumption that demonstrating integration of the BGCAPP processes will not identify any design
3 issues that require correction. This is an improbable scenario and startup of a pilot plant like
4 BGCAPP is expected to involve delays and stoppages. Hence, the most probable scenario will be
5 a slower processing rate than requested. Regardless of the actual waste processing rates, the
6 RD&D program will not compromise health or the environment. The following design and
7 operating characteristics of the BGCAPP ensure protection of public health and the environment:

- 8 1) All agent-related processing is performed in the MDB, which is fully contained by the MDB
9 HVAC system permitted under a Title V air permit. This is a proven system that maintains
10 protection even if an upset or operating anomaly occurs.
- 11 2) The MDB HVAC system is monitored for agent on a near-real-time basis as required to
12 demonstrate compliance with the Title V permit requirements.
- 13 3) Each batch of hydrolysate is tested and meets the target release levels for agent before it
14 is transferred to the HSA.
- 15 4) The process' ability to achieve 99.9999 percent destruction efficiency (DE) for agent is
16 demonstrated on the initial batches of agent processed in the ANR. This initial validation
17 satisfies the requirements of paragraph 3.5.3. The testing is performed in accordance with
18 the procedures described in the test plan.

19 In conclusion, the requested processing rates do not pose a risk to health or to the environment,
20 and are essential to meeting the process integration objectives and requirements of the RD&D
21 program.

22 **2.5.2 Testing Schedule and Criteria for Increasing Processing Rates**

23 Paragraph 3.1 explains the reasons for the processing rates proposed for the RD&D program. The
24 explanation is based on the need to demonstrate process integration through research, which is
25 discussed in paragraph 3.2.1. The increase in projectile and rocket processing rates will be based
26 on achieving the applicable success criteria identified in paragraphs 3.2.1.1 through 3.2.1.5. If
27 processes are operating as designed, batches of agent and energetics hydrolysate meet their
28 respective target release levels, and the success criteria (identified in paragraphs 3.2.1.1 through
29 3.2.1.5) are satisfied for the processing rate, then the processing rate will be increased to the next
30 higher rate. This approach recognizes human factors, provides safeguards at every step,
31 maximizes safety/health and environmental protection and results in the safe and effective
32 completion of the BGCAPP RD&D program.

33 **2.6 Operation Subject to Regulation by KHW Part B Permit**

34 During the design and construction phases of the BGCAPP program, the KHW Part B Permit
35 Application will be prepared and submitted to KDEP. This application will be submitted at least
36 2 years before the end of pilot testing to allow KDEP/Division of Waste Management (DWM) to
37 evaluate and approve the KHW Part B Permit. As shown in Table 2-1, a performance test will be
38 conducted during the RD&D program. This performance test will provide final confirmation of the
39 safety and environmental acceptability of the process. KDEP personnel will be present onsite
40 during this testing and will be provided the raw analytical needed to evaluate success of the
41 pilot/performance test. Due to the issues associated with facility shutdown following completion of
42 testing, BGCAPP plans and requests that KDEP allow operations to continue pending approval of
43 the Part B Permit or until KDEP notifies BGCAPP that it disapproves either the Part B Permit or the
44 results of demonstration testing..

(SENSITIVE INFORMATION REMOVED)

Electronic documents, once printed, are uncontrolled and may become outdated. Refer to the electronic document in InfoWorks for the current revision.

24915-000-GPE-GGPT-00001 – RESEARCH, DEVELOPMENT, AND DEMONSTRATION (RD&D) PERMIT APPLICATION CDRL #A010

1

Figure 2-2 – BGCAPP Site Plan

(SIR)

2

(SENSITIVE INFORMATION REMOVED)

**24915-000-GPE-GGPT-00001 – RESEARCH, DEVELOPMENT, AND DEMONSTRATION (RD&D) PERMIT
APPLICATION CDRL #A010**

1 **3.0 RESEARCH PLAN**

2 **3.1 Pertinent Information for Proposed Operation of Experimental**
3 **Waste Facility/Process**

4 This section describes the overall process that will be used to perform the RD&D program that is
5 covered under this permit application and presents the justification for this research. Section 3
6 explains how the process satisfies the requirements of Kentucky Revised Statute
7 (KRS) 224.50-130 and how this process will meet environmental protection standards in
8 accordance with 401 KAR 34.

9 The proposed facility is a full scale pilot plant that will be used to validate the National Research
10 Council's (NRC's) requirement for research on process integration discussed in paragraph 3.3.1.5.
11 Although some integration research of the BGCAPP can and will be conducted using surrogates
12 and simulants, testing with live agents and agent-containing munitions is necessary to verify that
13 the design will properly destroy the BGAD's chemical agent munitions stockpile. The overriding
14 criterion that drives this design is that the facility be capable of performing the RD&D in a manner
15 that is safe and protective of human health and the environment.

16 To this end, the BGCAPP is being designed and built to the same standards as a full scale
17 treatment facility. For example, the blast-resistant containments, the highly filtered HVAC
18 exhausts, and the numerous other protective systems that are necessary for a fully functional
19 system also are necessary to ensure safety and environmental protection during the RD&D
20 program. Because of this requirement, and because it is very difficult to add equipment after the
21 treatment areas are contaminated with agent, the full facility must be built to support the RD&D
22 program and then tested as one unit. As a result, the BGCAPP is described as a full scale, pilot
23 plant. However, this RD&D permit application only is for the destruction of GB under the RD&D
24 program.

25 The technology that is intended to be used by the BGCAPP was chosen to meet the requirement
26 of KRS 224.50-130 (3a) and (4), which requires the technology to:

- 27 • Exist in an operational facility, or to have been demonstrated in a disposal program at a
28 comparable scale, and
29 • Create less risk of release, acute or chronic health effect, or adverse environmental effect

30 This determination was made through an extensive testing, evaluation, and selection process that
31 was documented and critiqued by internal Department of Defense (DoD) groups and independently
32 reviewed by many National Research Council (NRC) panels. Table 3-1 lists the major reports in
33 which the NRC panels chronicled and critiqued the progress of the evaluation and selection
34 process.

35 The evaluation process first examined numerous alternative technologies (NRC 1993) and
36 NRC 2002 and NRC 2002a identified two technologies that were subsequently demonstrated
37 under the ACWA program. These evaluations (see Table 3-1) identified the General Atomics Total
38 Solution (GATS) process, on which the BGCAPP design is based, as the one with lower
39 hydrocarbon and carbon monoxide emissions. The final Environmental Impact Statement (EIS) for
40 BGCAPP (December 2002) also discusses alternate technologies and draws the same conclusion.

**24915-000-GPE-GGPT-00001 – RESEARCH, DEVELOPMENT, AND DEMONSTRATION (RD&D) PERMIT
APPLICATION CDRL #A010**

1 The ability to destroy the chemical weapons stockpile will be assessed during the BGCAPP RD&D
2 program. A KHW Part B Permit application will be submitted prior to completing the RD&D
3 program to allow the KDEP and other regulators to further evaluate the process' safety and
4 environmental compliance based upon the additional data collected during the RD&D
5 demonstration test.

**Table 3-1 – Major NRC Reports Relevant to Destruction
of Weapons at BGAD**

Report Date	Report Title
NRC 1993	Alternative Technologies for the Destruction of Chemical Agents and Munitions
NRC 1995	Review of Alternative Chemical Disposal Technologies
NRC 1999	Review and Evaluation of Alternative Technologies for Demilitarization of Assembled Chemical Weapons
NRC 2000	Evaluation of Demonstration Test Results of Alternative Technologies for Demilitarization of Assembled Chemical Weapons, a Supplemental Review for Demonstration II
NRC 2000a	Integrated Design of Alternative Technologies for Bulk-Only Chemical Agent Disposal Facilities
NRC 2001	Analysis of Engineering Design Studies for Demilitarization of Assembled Chemical Weapons at Pueblo Chemical Depot
NRC 2001a	Disposal of Neutralent Wastes
NRC 2002	Analysis of Engineering Design Studies for Demilitarization of Assembled Chemical Weapons at Blue Grass Army Depot, 2002
NRC 2002a	Update Engineering Design Studies for Demilitarization of Assembled Chemical Weapons at Blue Grass Army Depot
NRC 2004	Effects of Degraded Agent and Munition Anomalies
NRC 2005	Interim Design Assessment for the Blue Grass Chemical Agent Destruction Pilot Plant
NRC 2006	Review and Assessment of the Proposals for Design and Operation of Designated Chemical Agent Destruction Pilot Plants
NRC 2007	Review of Chemical Agent Secondary Waste Disposal and Regulatory Requirements
NRC 2008	Review and Assessment of Developmental Issues Concerning Metal Parts Treater Design for the Blue Grass Chemical Agent Destruction Pilot Plant
NRC 2008a	Review of Secondary Waste Disposal Planning for the Blue Grass and Pueblo Chemical Agent

**24915-000-GPE-GGPT-00001 – RESEARCH, DEVELOPMENT, AND DEMONSTRATION (RD&D) PERMIT
APPLICATION CDRL #A010**

Report Date	Report Title
	Destruction Pilot Plants
NRC 2009	Assessment of Explosive Destruction Technologies for Specific Munitions at the Blue Grass and Pueblo Chemical Agent Destruction Pilot Plants
NRC 2011	Assessment of Approaches for Using Process Safety Metrics at the Blue Grass and Pueblo Chemical Agent Destruction Pilot Plants
NRC 2012	The Blue Grass Chemical Agent Destruction Pilot Plant's Water Recovery System
NRC 2012a	Assessment of Agent Monitoring Strategies for the Blue Grass and Pueblo Chemical Agent Destruction Pilot Plants
NRC 2012b	Disposal Options for the Rocket Motors from Nerve Agent Rockets Stored at Blue Grass Army Depot
The NRC reports are available for purchase or download at www.nap.edu .	

1

2

3.2 Objective Statement & Experimental Design

3

3.2.1 Justification for Research

4

The BGCAPP ultimately will destroy all chemical weapons at the BGAD using alternative technologies. NRC panels reviewed the results of previous evaluations of alternative technologies in a series of reports listed in Table 3-1 and, in its last report, identified a process termed General Atomics Total Solution (GATS) as the most mature alternative process for use at the BGAD. The report suggested improvements in the design, but indicated that, although all of the individual processes are acceptable for application at the BGAD, RD&D must be performed to refine and demonstrate the integrated process before going to full operation. The BGCAPP design incorporates the design improvements identified by the NRC, and the BGCAPP RD&D program incorporates this integration research. The final stage of development is the testing and evaluation of the integrated process under a carefully developed RD&D program that is the purpose of this application.

5

6

7

8

9

10

11

12

13

14

15

The RD&D program to be conducted at the BGCAPP includes the following goals:

16

17

18

19

20

21

22

23

24

1. Conduct a thorough program of system integration including the conveyance of munitions and munition segments from one treatment location to the next to include the MPT treatment and release of the munition parts from the MDB.
2. Demonstrate that 99.9999 percent DE of GB agent can be achieved in the agent neutralization reactors (ANRs) as required by KRS 224.50-130.
3. Demonstrate that the energetics can be treated in the EBHs and the ENS.
4. Demonstrate that the MPT will thermally treat projectile bodies and solid residue from the EBH to a minimum of 1,000°F for a minimum of 15 minutes (i.e., the Army treatment standard for chemical agent destruction).

**24915-000-GPE-GGPT-00001 – RESEARCH, DEVELOPMENT, AND DEMONSTRATION (RD&D) PERMIT
APPLICATION CDRL #A010**

1 5. Demonstrate the performance of the SCWO reactor system.

2 The RD&D program described in this application is being conducted to demonstrate the agent and
3 energetics destruction capabilities of the BGCAPP integrated process. As data are obtained from
4 both ongoing equipment design and testing programs, data are fed back to the BGCAPP team so
5 that the information can be used to improve and validate the plant processes. This data feedback
6 will continue during the RD&D demonstration phase. However, no changes will be made that
7 could increase risk or environmental releases and the expected outcome of the RD&D program will
8 be further reductions in risk.

9 The present permit application requests approval for the BGCAPP to be built and operated as a full
10 scale pilot plant to conduct a demonstration of the agent and energetics destruction capabilities as
11 integrated plant processes. Much of the RD&D program will not involve hazardous wastes; the
12 initial tests will be performed using simulants and surrogate materials. After the overall plant's
13 performance, safety, environmental acceptability, and reliability have been established, the RD&D
14 program will progress to initially include small amounts of agent; after demonstrated performance,
15 increasingly larger amounts of agent and chemical munitions will be processed. At the conclusion
16 of the research, the facility will have demonstrated that it is capable of operating at full capacity and
17 the remainder of the stockpile will be processed under a Part B permit.

18 The information that is included in the RD&D permit compliance schedule (Appendix B to the
19 RD&D Permit issued on 30 September 2005) includes the additional information that would be
20 required in a Part B permit application for a hazardous waste treatment facility. Therefore, the
21 submission of the compliance schedule items will be used for the completion of a Part B permit
22 application.

23 Paragraph 3.2.3 presents a comprehensive overview of the activities to be performed under the
24 RD&D permit. As shown in section 2, Table 2-1, the performance test is the transition from
25 operation under the RD&D permit to operation under the full Resource Conservation and Recovery
26 Act (RCRA) KHW Part B permit with activities prior to and including the performance test occurring
27 under the RD&D permit.

28 **3.2.1.1 System Integration**

29 Conduct a thorough program of system integration including the conveyance of munitions and
30 munition components from one part of the treatment process to the next up to and including the
31 release of the munition residue from the MDB. System integration has two components:

- 32 1) Ability of the equipment to function as one unit with the actual wastes.
33 2) Maximizing the operators' proficiency under safe operating conditions.

34 Optimizing the operators' proficiency under carefully controlled and supervised conditions has
35 traditionally not been considered as RD&D. However, such human factors research is essential to
36 maximize safety and protect the environment; hence it has been made an important component of
37 the BGCAPP RD&D process. Before hazardous waste (agent) operations begin, the operators are
38 thoroughly trained in their duties and responsibilities through coursework, simulations, and actual
39 hands-on experience with simulated munitions. Simulated equipment training hardware (SETH)
40 munitions are constructed to have physical dimensions that are similar to the actual munitions, but
41 they do not contain the chemical agent and energetics.

**24915-000-GPE-GGPT-00001 – RESEARCH, DEVELOPMENT, AND DEMONSTRATION (RD&D) PERMIT
APPLICATION CDRL #A010**

1 However, only operations conducted with actual munitions can provide the required operator
2 experience and proficiency to verify that the process fully addresses human factors and, therefore,
3 minimizes risk to human health and to the environment. The proficiency in handling and
4 processing actual chemical munitions can only be achieved through slow and deliberate step rate
5 changes in which the operators handle the actual munitions at initially very low rates with
6 heightened direct supervision by management and system engineers. As the operators gain
7 experience, the processing rates are increased in accordance with the ramp-up schedule in
8 Table 2-1.

9 To ensure increased oversight by management and systems engineers, initial munition processing
10 will occur only on the day shift. Night shift activities will concentrate on preventive and corrective
11 maintenance activities, monitoring the EBH neutralization process and pre-staging of munitions for
12 the next day of operations. The step changes in processing rates are typically scheduled in
13 4-week intervals to ensure each of the four rotating operations shifts have an opportunity to
14 process munitions on day shift. The step rate changes also provide a logical progression which
15 fosters systematic improvements in operator proficiency. The RD&D demonstration phase with
16 agent munitions is required to demonstrate that the integrated BGCAPP facility and operators can
17 proficiently process actual munitions as compared to the simulated munitions used in
18 systemization. The step rate changes also allow protection of human health and the environment
19 to be verified.

- 20
- 21 a. Justification for Conducting with Hazardous Waste – To establish successful system
22 integration, all BGCAPP subsystems must operate as an integrated facility. This
23 requires that the processing include agent, agent hydrolysate, energetics, energetics
24 hydrolysate, munition components, dunnage, and secondary waste. Appropriate
25 development of this process integration requires the processing of real munitions
26 unique to BGAD.
- 27 b. Measurements and Observations Required – Process integration is considered to be
28 achieved when the process successfully operates at the peak munitions processing
29 rate in Table 2-1. Process integration is the overarching objective: it demonstrates
30 the facility and operators can achieve the necessary results when operating as a unit
31 and when treating the actual hazardous wastes at the peak processing rate. The
32 criteria that are required to assess and demonstrate the integrated process are
33 discussed in paragraphs 3.2.1.2 through 3.2.1.5.
- 34 c. Safety and Environmental – Maximum safety and environmental protection is
35 achieved by performing this verification at an initially very slow rate during weeks 1
36 through 4 and stepwise increases in the processing rate as information is gathered.
37 This slow ramp-up ensures adequate time to properly evaluate the agent and
38 energetic destruction results and to verify the operators' levels of knowledge and
39 performance ensure safe operation. Plant operating rates are progressively
40 increased at the nominal rates shown in Table 2-1.
- 41 d. Success Criteria – Process integration is considered to be successful at each
42 ramp-up rate when all operators are assessed to be proficient at their functions, and
43 all exit streams meet the safety and environmental requirements as discussed in the
44 following subsections.

**24915-000-GPE-GGPT-00001 – RESEARCH, DEVELOPMENT, AND DEMONSTRATION (RD&D) PERMIT
APPLICATION CDRL #A010**

3.2.1.2 Demonstrate 99.9999 Percent DE for GB

Demonstrate that 99.9999 percent DE can be achieved for GB agent in the agent neutralization reactors (ANRs) as required by KRS 224.50-13 and 401 KAR 34:350.

- a. Justification for Conducting Operations with Hazardous Waste – Agent hydrolysis has been demonstrated to achieve the requisite 99.9999 percent DE for GB in the previous testing conducted by the Program Executive Office, Assembled Chemical Weapons Assessment (PEO ACWA). Agent destruction at the BGCAPP must be demonstrated using the BGCAPP equipment with the BGAD munitions as required by KRS 224.50-130(3)(a). This only can be demonstrated by conducting tests with the chemical agent (i.e., state listed hazardous waste).
- b. Measurements and Observations Required – The GB drained from the munitions is stored in the agent collection system (ACS) until a sufficient quantity of agent has been accumulated for processing in the agent neutralization reactor (ANR). The agent is then transferred from the ACS to an ANR for hydrolysis and the hydrolysate is analyzed for GB. The DE is calculated using the equation presented in the BGCAPP RD&D Permit, Condition T-9, as outlined in paragraph 3.5.3. The number of ANS batches to be tested in this way will be established in the test plan, which will be submitted in accordance with the BGCAPP's compliance schedule.
- c. Safety and Environmental – The hydrolysate batches processed in the ANRs are not released from the MDB until the analytical results demonstrate that the target release level has been met. The ANR vents to the MPT off-gas treatment system (OTM) and then to the MDB HVAC filter system before release to the atmosphere. These multiple layers of protection provide a high degree of safety and protection of the environment. A slow start of operation (as specified in the test plan) maximizes personnel safety and protection of the environment by minimizing the amount of agent in process while the initial batch of agent is neutralized.
- d. Success Criteria – The process meets the 99.9999 percent DE as specified in paragraph 3.5.3.

3.2.1.3 Demonstrate EBH's Ability to Treat Rocket Energetics

Demonstrate that the rocket energetics can be treated in the EBHs and the ENS.

- a. Justification for Conducting with Hazardous Waste – EBH performance has been demonstrated to achieve this objective using pieces of M61 (i.e., training) rockets with energetics during the technical risk reduction program (TRRP) for the EBH. The test also demonstrated that the hydrogen (H₂) levels could be maintained below 25 percent of the lower flammability limit (LFL). Although energetics neutralization has been demonstrated, it is necessary to verify and demonstrate these results with the BGCAPP equipment and BGAD munitions. This involves system integration and includes the transfer of the rocket warhead segments from the RSM to the EBHs and the transfer of the treated EBH solid residue from the EBH to the MPT. This objective can only be validated by treating agent-contaminated energetic-components of the leakers in the BGCA stockpile. This verification must be completed for all installed EBHs.
- b. Measurements and Observations Required – The hydrogen (H₂) gas concentration must be monitored in the EBHs' vent gases to ensure H₂ gas concentration is below 25 percent of the LFL. The EBH and vent gas system will demonstrate the ability to safely control the increased hydrogen generation for each processing rate increase in the ramp-up schedule. Hydrolysate leaving each EBH batch goes to the

**24915-000-GPE-GGPT-00001 – RESEARCH, DEVELOPMENT, AND DEMONSTRATION (RD&D) PERMIT
APPLICATION CDRL #A010**

1 energetics neutralization reactors (ENRs) for further treatment. The solids leaving
2 the EBHs go to the MPT. No specific measurements are made on the EBH solid
3 residue except for observing that the mechanical equipment is operating properly
4 under agent munition operations. The energetics hydrolysate is sampled in the ENR
5 and tested to verify successful energetics and agent treatment.

- 6 c. Safety and Environmental – Maximum safety and environmental protection is
7 achieved by verifying the system performance at a slow rate during weeks 1
8 through 4 and increases stepwise as the performance objectives are met. This slow
9 ramp-up ensures adequate time to verify completion of energetics and agent
10 hydrolysis and that the energetics hydrolysate meets the target release levels
11 (i.e., for energetics and agent) before transfer to the HSA. The rocket feed rate is
12 increased in accordance with the nominal feed rates shown in Table 2-1.
- 13 d. Success Criteria:
- 14 ➤ Hydrogen monitoring system works as designed at all rocket processing rates in
15 each EBH.
 - 16 ➤ EBH solids transfer system to the MPT continues to effectively transfer solids as
17 the rocket feed rates increase.
 - 18 ➤ Hydrolysate leaving the ENR meets the required energetics destruction and the
19 agent target release level.

20 **3.2.1.4 Demonstrate MPT's Ability to Treat Projectiles**

21 Demonstrate that the MPT can thermally treat batches of projectile bodies to a minimum of 1,000°F
22 for a minimum of 15 minutes.

- 23 a. Justification for Conducting with Hazardous Waste – TRRP testing with ACWA test
24 equipment munitions have demonstrated that the MPT can thermally treat a full tray
25 of projectiles to a minimum of 1,000°F for a minimum of 15 minutes. Thermal
26 treatment in the MPT must be demonstrated to verify the previous results with actual
27 munitions from the BGCA stockpile.
- 28 b. Measurements and Observations Required – Temperature measurements are
29 performed to confirm the temperature profile previously demonstrated during
30 systemization. Thermal dosimeters will be used to ensure 1,000°F will have been
31 maintained for at least 15 minutes in accordance with DA performance standards for
32 agent destruction.
- 33 c. Safety and Environmental – Slow initial operating rates ensure all material in the
34 MPT achieves the appropriate temperature before it is removed from the MPT. The
35 batch nature of the operation allows the time per batch or the power input to be
36 increased to establish the operating conditions necessary to ensure proper
37 decontamination of the metal. Air pollution is controlled for MPT off-gas by discharge
38 through the OTM and then through the MDB HVAC filtration system.
- 39 d. Success Criteria – Verify by temperature measurements of the treated munition
40 bodies that the projectile carcasses in the first trays of material have been exposed
41 to a minimum of 1,000°F for a minimum of 15 minutes. This will be accomplished by
42 the use of thermal dosimeters on the munition bodies.

43 **3.2.1.5 Demonstrate Performance of SCWO Reactor System**

- 44 a. Justification for Conducting with Hazardous Waste – Tests with the agent and
45 energetic hydrolysates were performed under the PEO ACWA engineering design
46 study (EDS) test program. Testing under the RD&D program is required to

**24915-000-GPE-GGPT-00001 – RESEARCH, DEVELOPMENT, AND DEMONSTRATION (RD&D) PERMIT
APPLICATION CDRL #A010**

1 demonstrate the SCWO treatment of the blended hydrolysate. All materials fed to
2 the SCWO have previously been tested for agent and verified to be below the target
3 release level. Processing the hydrolysate ensures the SCWO effluent meets the
4 expected performance criteria before the water is further treated in the WRS.
5 Because the SCWO performance can be assessed early in the RD&D program, the
6 hydrolysate can either be stored in the HSA or it can continue to be processed
7 through the SCWO units while RD&D continues on the other upstream treatment
8 units.

- 9 b. Measurements and Observations Required – The operating parameters of the
10 SCWO reactors are monitored to verify that the equipment is performing properly.
11 The SCWO effluent is analyzed for total organic carbon (TOC).
- 12 c. Safety and Environmental – SCWO has been demonstrated to have extremely low
13 emissions. According to all available data, the air emissions from the SCWO do not
14 require further treatment prior to release to the environment.
- 15 d. Success Criteria – Demonstration of successful treatment of organics in wastewater
16 will be based on measurement of TOC at in the effluent stream.

17 **3.2.2 Process Description**

18 This section presents the overall processing sequence of the BGCAPP. The subsequent sections
19 describe the individual process units.

20 The BGCAPP design combines proven, low-risk, Army-approved, NRC-recommended
21 neutralization and SCWO technologies that have been successfully demonstrated for the
22 PEO ACWA into an integrated plant for testing during the RD&D program. The demonstration of
23 this integrated plant and the destruction processes is the subject of this permit application.

24 Chemical demilitarization of the BGCA stockpile occurs in the munitions demilitarization building
25 (MDB) and subsequent treatment of the residual organic compounds occurs in the SCWO
26 processing building (SPB). Section 6 describes the buildings and the high level of added safety
27 and environmental protection that it offers.

28 The BGCAPP design is an integrated system that will be used to safely destroy the agent and
29 energetics by the following environmentally acceptable procedure:

- 30 1) Agent and energetics access (mechanical).
- 31 2) Energetics removal and deactivation by hydrolysis.
- 32 3) Agent removal and neutralization by hydrolysis.
- 33 4) Post-treatment of agent/energetic hydrolysates using commercial-scale, solid-wall SCWO
34 units.
- 35 5) Metal and other solids decontamination by heating to a minimum of 1,000°F for 15 minutes
36 in the inductively heated MPTs.
- 37 6) Some secondary wastes (e.g., agent-contaminated pallets and PPE) will be treated by
38 chemical decontamination. The chemically decontaminated residue will be disposed of at
39 an off-site treatment, storage, and disposal facility (TSDF) or the residue will be treated in
40 the MPT and then managed by appropriate means to minimize waste.
- 41 7) Spent activated carbon will be shipped off site for further treatment at a permitted TSDF.
- 42 8) Agent-contaminated, metallic secondary wastes (e.g., miscellaneous metal parts, metal
43 reinforced hoses, piping, valves, and tools) that have not been chemically decontaminated
44 will be processed through the MPT and then managed by appropriate means to minimize
45 waste.

**24915-000-GPE-GGPT-00001 – RESEARCH, DEVELOPMENT, AND DEMONSTRATION (RD&D) PERMIT
APPLICATION CDRL #A010**

9) Secondary wastes that are not agent-contaminated will not be processed through the BGCAPP; they will be managed by appropriate means to minimize waste.

The process achieves the required 99.9999 percent (as a minimum) destruction of agent stored at the BGCA by neutralization via hydrolysis. Agent hydrolysis involves mixing the agent (GB) or agent-contaminated liquid in an enclosed vessel with hot caustic solution [i.e., sodium hydroxide (NaOH)]. Hydrolysis of the energetics also will be performed. Table 3-2 lists the types of hydrolysis to be used.

Table 3-2 – Hydrolysis Types to be Used at BGCAPP for GB

Hydrolysis Type	Agent
Hot sodium hydroxide solution	GB [nerve agent sarin: isopropyl methyl phosphonofluoridate (C ₄ H ₁₀ FO ₂ P)]
	Energetic materials (explosives and rocket propellants)

The munition bodies and other metallic components of the munitions are washed using high-pressure water and thermally treated in the MPT at a minimum of 1,000°F for a minimum of 15 minutes. The Army treatment standard for agent destruction is achieved by this treatment process and following this treatment the wastes may be either sent offsite for disposal or recycling (i.e., this thermal treatment meets the Army requirement for release to the public).

The facility has been designed to safely treat all chemical weapons, chemical warfare agent, and ancillary materials. However, certain ancillary (secondary) wastes may be decontaminated with sodium hydroxide (NaOH), sodium hypochlorite (NaOCl), or other appropriate decontamination (decon) solutions. These wastes, PPE, and other plastic/rubber items, will be decontaminated to the Airborne Exposure Limits (AELs) and then shipped off site to a permitted TSDF. If they cannot be decontaminated to the AELs, these wastes will be treated in the MPT before they are shipped off site for treatment or disposal in a permitted TSDF.

To the maximum extent possible, process liquid streams are recycled to conserve water and to prevent discharge to ground or surface water. Water is recycled via a water recovery system that produces water of a quality suitable for recycling back into the process during the pilot testing and operations phases.

Figure 3-1 is a process block flow diagram for the hazardous waste processing units. The figure shows the flow of munitions and other streams from the container handling building (CHB) through the various systems.

1

2

Figure 3-2 – Photograph of EONC



3

4

**24915-000-GPE-GGPT-00001 – RESEARCH, DEVELOPMENT, AND DEMONSTRATION (RD&D) PERMIT
APPLICATION CDRL #A010**

1 Palletized munitions are stored in “igloos” and are currently regulated under the BGAD hazardous
2 waste storage permit. The location of each type of munition is well documented and a specific
3 munition type required for testing can be easily located and transferred with minimum disturbance
4 of the overall stockpile of munitions. Any munitions selected for testing will be transported in
5 enhanced onsite containers (EONCs) from the storage igloos to the CHB.

6 The EONCs are airtight vessels that are specifically designed to contain munitions during transport
7 from the BGCA storage igloos to the CHB. Figure 3-2 (shown above) is a photograph of an EONC.
8 The EONC is a well-established design that has been used safely at the Tooele Chemical Agent
9 Disposal Facility (TOCDF), the Anniston Chemical Agent Disposal Facility (ANCDF), Umatilla
10 Chemical Agent Disposal Facility (UMCDF), and the Pine Bluff Chemical Agent Disposal Facility
11 (PBCDF).

12 The EONC is received in the CHB, where it is stored until its contents are to be treated. At that
13 time it is transferred to the west unpack area (UPA), which is under “Engineering Controls”, and the
14 air in the sealed EONC is monitored for agent. If agent monitoring indicates that the EONC does
15 not contain leaking munitions, the EONC is opened, and the munitions are transferred to the
16 appropriate conveyor line for treatment of that munition type.

17 If agent is detected in the EONC (indicating a leaking munition), the EONC is moved to an area
18 under a higher level of Engineering Control, where it is opened and the munitions are processed by
19 personnel wearing appropriate personal protective equipment (PPE). The munitions are removed
20 from the EONC and placed on the appropriate processing conveyor line, passing through the
21 explosive containment vestibule (ECV) or toxic maintenance area (TMA). The contaminated metal
22 straps are transferred to the MPT for treatment. The contaminated wood pallets may either be
23 treated on site by chemical decontamination or treated in the MPT and then shipped off site to a
24 permitted TSDF. The EONC is then decontaminated and released for further use.

25 The treatment operations are performed using remote control systems. The specific treatment
26 sequences for each type of munition and the operation of each unit within the system are
27 discussed below. Briefly, the demilitarization of munitions results in the following components for
28 treatment:

- 29 1) Liquid agent and agent-contaminated wash water.
- 30 2) Agent-contaminated wood/fiberglass/cardboard
- 31 3) Agent-contaminated metal
- 32 4) Explosive components (e.g., bursters, propellant and fuzes)
- 33 5) RMs and contaminated rocket motors (CRMs).

34 KDEP approval is not being sought to process agent for any purpose other than for RD&D.
35 Processing agent under the RD&D program is the basis for assessing the system’s performance
36 and developing the engineering information that is the objective of the RD&D program.

37 The munitions processing is conducted in the MDB, which contains the systems that provide the
38 following functions:

- 39 1) Remove energetic components and disassemble the munitions.
- 40 2) Drain the agent from the agent cavities.
- 41 3) Neutralize the agent (GB) by hydrolysis in hot caustic to a minimum of 99.9999 percent
42 DE.
- 43 4) Neutralize the explosives and CRM propellant by hydrolysis to meet the 40 CFR 268
44 treatment standard for D003 waste streams (deactivation).

**24915-000-GPE-GGPT-00001 – RESEARCH, DEVELOPMENT, AND DEMONSTRATION (RD&D) PERMIT
APPLICATION CDRL #A010**

- 1 5) Place the RMs in containers for transport to storage and/or treatment, recycling or
2 disposal.
- 3 6) Treat the agent-contaminated dunnage and most other agent-contaminated ancillary
4 wastes either by thermal treatment in the MPT or by chemical decontamination. Chemical
5 decontamination is the first choice for wood, PPE, other plastic/rubber wastes, and other
6 organic materials. These materials will be decontaminated using NaOH, NaOCl, or other
7 appropriate decontaminate solution to the AELs. Wastes that have been tested to meet
8 AELs will be shipped offsite to a permitted TSDF.
- 9 7) Ship the spent activated carbon off site for further treatment at a permitted TSDF.
- 10 8) Thermally treat agent-contaminated metal parts and other agent-contaminated wastes in
11 the MPT.

12 Before transferring agent and energetic hydrolysates from the MDB to the HSA, the hydrolysate
13 will be analyzed for residual agent concentration. If the agent concentration is above the target
14 release level, additional treatment will be required. If the agent concentration is below the target
15 release level, the batches of agent and energetic hydrolysate are transferred to the HSAs and
16 finally to the SPB for further treatment.

17 After demonstrating 99.9999 percent DE for agent hydrolysate, validated process controls and
18 statistical testing may be used in lieu of analyzing all batches of agent hydrolysate. This alternative
19 analytical approach will be submitted to KDEP as part of the Waste Analysis Plan (WAP) that is
20 included in the RD&D Permit Compliance Schedule, Item # 18.

21 In the SPB, the pH of the energetics hydrolysate is adjusted in the aluminum precipitation system
22 (APS). The dissolved aluminum compounds in the energetics hydrolysate are precipitated out of
23 the hydrolysate in the APS and then physically separated from the hydrolysate in the aluminum
24 filtration system (AFS). The AFS filtrate is blended with agent hydrolysate and fed to the SCWO
25 system for treatment. The filter cake is shipped off site to a permitted TSDF.

26 Agent-contaminated waste streams will either be treated at a minimum of 1,000°F for a minimum of
27 15 minutes to destroy residual agent and energetics, if present, or these waste streams will be
28 shipped off site after being decontaminated. All gas streams (including all exhaust air) are filtered
29 through multiple banks of both particulate (HEPA) filters and activated carbon and are monitored
30 for agent as required by the Title V air permit. The combination of liquid phase batch processing
31 (with analysis of the contents prior to release) and air stream filtration systems (with near real time
32 monitoring) minimize the risk to human health and the environment.

33 **3.2.3 Performance Criteria**

34 The main purpose of this RD&D is to demonstrate and evaluate the efficacy of the BGCAPP
35 integrated processes. This will be done by operating the individual (proven) components (e.g.,
36 RSM and EBH) first with surrogates (during systemization) and then with agent-bearing wastes
37 under the RD&D program. Using this approach, the efficiency and performance of the pilot plant
38 and its integrated processes can be adequately assessed.

39 During the RD&D program, the integrated processes will be assessed for the capability to meet
40 efficiency and performance criteria. The process will be tested to:

- 41 1) Demonstrate 99.9999 percent DE for agent via hydrolysis on the initial batches of agent
42 processed.
- 43 2) Demonstrate sufficient destruction of energetics by hydrolysis to ensure the solids exiting
44 the energetics neutralization system (ENS) meet the 401 KAR 37:040 treatment standard
45 for D003 waste streams (Deactivation).

**24915-000-GPE-GGPT-00001 – RESEARCH, DEVELOPMENT, AND DEMONSTRATION (RD&D) PERMIT
APPLICATION CDRL #A010**

- 1 3) Validate the plant's anticipated overall hazardous waste characteristics (i.e., to assess the
2 type of TSDF that is appropriate for each and to allow evaluation and acceptance by
3 TSDFs) and generation rates.
- 4 4) Identify the operating parameters and ranges which will ensure successful operation of
5 systems and processes and simultaneous compliance with applicable environmental
6 standards.
- 7 5) Confirm procedures developed for operations include sufficient environmental compliance
8 and hazardous waste management provisions to ensure regulatory compliance is
9 maintained.
- 10 6) Verify that the MPT can treat the materials to a minimum of 1000°F for a minimum of
11 15 minutes.
- 12 7) Verify that the EBH performs as designed.
- 13 8) Verify proper operation of the SCWO system on actual hydrolysate.

14 The following sections discuss how these criteria will be met. Paragraph 3.5.3 presents the
15 method to be used to demonstrate 99.9999 percent DE for agent. The remaining paragraphs show
16 how the RD&D objectives will be met. Process-specific RD&D objectives and performance criteria
17 are discussed throughout section 3.

18 **3.2.3.2 Munitions Demilitarization Building (MDB)**

19 Except for the processes listed below, all processes within the MDB perform mechanical processes
20 on the munitions (e.g., punching, draining, washing, and shearing of the munitions):

- 21 a. EBH vents to the EBH off-gas treatment system (OTE).
- 22 b. Energetics Neutralization Reactors normally vent to the MPT Off-gas treatment
23 (OTM), but may vent to the OTE if the OTM is unavailable or down for maintenance.
- 24 c. The Metal Parts Treaters (MPTs), and their associated inlet and outlet airlocks and
25 conveyors all vent to the MPT Off-gas treatment system (OTM). In addition, the
26 following also vent to the OTM: agent hydrolyzers, spent decontamination holding
27 and agent washout treatment tanks, agent holding and surge tanks, and agent
28 hydrolysate sampling tanks.

29 The emissions from these processes will proceed through various air pollution control systems
30 (i.e., venturi scrubbers, thermal oxidizers) and then vent directly to the MDB HVAC filtration
31 system.

32 **3.2.3.3 Agent and Energetics Hydrolysate Storage**

33 These storage tanks form a buffer between the treatment operations in the MDB and the SCWO
34 process. The hydrolysates' vapor pressures are very low. However, as a precaution and to control
35 possible vapors, the hydrolysate tanks are vented to a common header, which is routed back into
36 the MDB to the discharge side of the OTM blowers.

**24915-000-GPE-GGPT-00001 – RESEARCH, DEVELOPMENT, AND DEMONSTRATION (RD&D) PERMIT
APPLICATION CDRL #A010**

3.2.3.4 SCWO Processing Building (SPB)

This building includes the Aluminum Removal System (ARS), SCWO reactors and the water recovery system as well as their associated tanks and tank systems. Waste materials entering this building will be analyzed and shown to be below the target release level for agent. Therefore, the emissions from these sources will pose no agent hazard, however, this processing may produce small quantities of other emissions. Extensive tests have been conducted on SCWO systems treating agent and energetics hydrolysates and hydrolysate simulants as part of the Program Manager for Alternative Technologies and Approaches (PMATA) and PEO ACWA programs. These tests were reviewed and evaluated by a number of National Research Council (NRC) panels. The panels' findings and conclusions and an extensive list of references containing the data on which their conclusions are based are presented in the reports that are listed in Table 3-1. These NRC reports concluded that the emissions from the General Atomics Design SCWO reactor were extremely low.

The SCWO system selected at BGAD has been successfully demonstrated at a scale comparable to that to be used at BGCAPP during extensive ACWA demonstrations/testing. The demonstrations were performed at increasingly longer time frames and culminated in a series of long-term tests, termed the 500-hour tests, on the materials that will be treated by SCWO at BGAD. These tests included GB, VX, and mustard hydrolysates and energetic hydrolysates and demonstrated consistently high levels of organic chemical destruction. The tests were documented and critiqued by internal DoD groups and independently reviewed by many NRC panels. Table 3-1 lists the major reports in which the NRC panels chronicled and critiqued the progress of the evaluation and selection process. The NRC cited the numerous internal government reports documenting the demonstration programs.

Based on the testing referenced above, the gas streams exiting the SCWO unit are typically very low in total hydrocarbons (less than 1 ppm). The CO concentration has been demonstrated to be consistently less than 2 ppm and particulates less than 4 mg/dry standard cubic meter (DSCM). Cadmium (Cd) + lead (Pb) are less than 0.015 mg/DSCM, and antimony (Sb) + Arsenic (As) + Beryllium (Be) + Chromium (Cr) are less than 0.045 mg/DSCM. Most of these values are at or below the lower limit of detection of the measurement method and below levels commonly found in ambient air, but are not intended to serve as target levels for SCWO gas stream exhaust. These results support the conclusion that the SCWO technology has a negligible impact on the environment.

The concentrations identified above were measured during the system demonstration programs. Although these levels demonstrate the system is safe and protective of the environment, these levels should not be identified as limits for the final system. The emission limits and performance of a risk assessment for the BGCAPP are both established as environmental requirements in the Title V air permit granted by the Commonwealth of Kentucky.

3.2.3.5 Polychlorinated Biphenyls (PCBs)

PCBs are part of the matrix found in the rocket SFTs. The SFTs may exit the BGCAPP processes with the rocket motors separated from the non-leaking agent-filled warheads or as part of the wastes generated during treatment of "leaker" rockets. These waste streams will be treated or disposed of at a permitted, offsite TSCA facility. A TSCA permit application has been prepared and submitted to EPA Region 4 for management of this waste.

**24915-000-GPE-GGPT-00001 – RESEARCH, DEVELOPMENT, AND DEMONSTRATION (RD&D) PERMIT
APPLICATION CDRL #A010**

1 **3.3 Operating Parameters Monitoring & Frequency**

2 **3.3.1 Performance Test Plan**

3 Effectiveness of Treatment [401 KAR 38:230, Section 1 & 40 CFR 270.23(d)]

4 The BGCAPP is an integrated facility whose effectiveness depends on the integrated processes,
5 and not just the effectiveness of individual miscellaneous Subpart X (or other) treatment units. The
6 sole function of the BGCAPP is destruction of the chemical agent and treatment or disposal of the
7 associated energetics. The following text describes how the performance of the BGCAPP
8 Subpart X treatment units is evaluated:

9 **3.3.1.1 Hydrolysis of Agent and Energetics**

10 Destruction of GB to a 99.9999 percent DE has been demonstrated at bench scale. Temperature
11 and reaction time ensure energetics and aluminum components are dissolved, with primary
12 neutralization of energetics occurring within the EBH(s). A further discussion of achievement of the
13 99.9999 percent DE can be found in sections 3.2.1.3 and 3.3.2.

14 **3.3.1.2 MPT and Thermal Treatment**

15 The U.S. Army cites a temperature of 1000°F for at least 15 minutes as a performance-based
16 standard for the destruction of chemical agents. The MPT is an inductive thermal treatment unit
17 designed, tested, and demonstrated to meet this military unique chemical agent treatment
18 standard. This standard (previously referred to as XXXXX or 5X) has been used for more than
19 30 years and, when met, allows the release of the treated item or waste to the public. Treatment of
20 metallic and other solid wastes, including secondary wastes, potentially contaminated with
21 chemical agent at BGCAPP will occur in the MPT. To demonstrate achievement of the
22 performance standard, thermal dosimeters will be applied to munition bodies and other metal parts
23 after liquid agent has been removed. These dosimeters will be located on the outside and inside of
24 the munition bodies and will “pop” when the pre-determined criteria (1000°F for 15 minutes) has
25 been achieved. Further information regarding the success criteria for thermal treatment can be
26 found in section 3.2.1.5.

27 **3.3.1.3 SCWO**

28 BGCAPP SCWO units treat both energetics and agent hydrolysate and effectively mineralizes any
29 remaining organics in these wastes. The SCWO has treated (at the scale employed at the
30 BGCAPP) industrial wastewater in Japan and agent hydrolysate during tests for the U.S. Army at
31 Corpus Christi, TX. In both instances, the technology was extremely effective in treating organics.
32 Treatment of the highly corrosive hydrolysate at Corpus Christi produced an effluent that was
33 essentially devoid of any organics (i.e., TOC <10 ppm). Establishment of a performance standard
34 will occur during RD&D Testing associated with the GB Agent campaign. Further information
35 regarding the success criteria for the SCWO can be found in section 3.2.1.5.
36

**24915-000-GPE-GGPT-00001 – RESEARCH, DEVELOPMENT, AND DEMONSTRATION (RD&D) PERMIT
APPLICATION CDRL #A010**

1 **3.3.1.4 RO/Water Recovery**

2 Following SCWO treatment of hydrolysate the RO system treats, recovers, and recycles (in the
3 SCWO) the majority of the resulting wastewater (approximately 70 percent). The BGCAPP will
4 ship the RO reject off site to appropriately licensed and permitted RCRA facility(s). The bases for
5 selection of the off-site RCRA facility(s) will be the characteristics of the waste and the permits of
6 the receiving facility(s). The RO unit is a proven technology for removing contaminants like salts
7 from water. The U.S. Army and others have repeatedly demonstrated the RO's treatment
8 effectiveness by treating wastewaters ranging from brackish water to industrial waste streams
9 while meeting a wide variety of water quality requirements. RO Unit effluent will be evaluated and
10 a performance standard established during RD&D Testing associated with the GB Agent
11 campaign.

12 **3.3.1.5 Process Integration**

13 Process integration involves many individual units and systems performing together to achieve the
14 desired goal of final munitions demilitarization and agent/energetics destruction. This can best be
15 measured by the successful completion of the deliberate ramping up of munitions processing
16 during the GB campaign to the successful demonstration test at full rate. This full scale
17 demonstration will be accompanied by the achievement of the 99.9999 percent DE at the exit of
18 hydrolysate from the ANS. These two components (achievement of full scale throughput and
19 attainment of the 99.9999 percent DE) will demonstrate that all individual processes are working as
20 designed from the onset of munitions processing in the ANS to waste streams exiting the RO unit.

21 **3.3.2 99.9999 Percent DE Demonstration Testing**

22 The 99.9999 percent DE is accomplished in the ANS. Demonstration testing will be performed
23 during the RD&D phase of operations for nerve agent GB. The ANS is in a Category A room in the
24 ACS. The room has containment sumps to collect accidental agent spills. The major components
25 of the ANS includes: two jacketed hydrolyzers (2,062 gallons each) and three sampling tanks
26 (4,838 gallons each).

27 The hydrolyzers neutralize the agent, using process water and caustic and allow sampling of
28 hydrolysate. The sampling tanks are used to store treated hydrolysate while awaiting laboratory
29 analysis confirming agent destruction. The transfer of hydrolysate into the sampling tank allows
30 use of the hydrolyzer for processing another batch. The contents of the sampling tanks are
31 agitated to maintain uniform mixing and allow collection of representative samples for laboratory
32 analysis. After sampling, the sampling system is flushed with heated process water to remove any
33 remaining agent hydrolysate.

34 The ANS performs the following functions:

- 35 1) Neutralizes agent GB with caustic
- 36 2) Processes agent contaminated spent decontamination and wash water
- 37 3) Cools the hydrolysate from reaction temperature to 100°F for sampling
- 38 4) Holds hydrolysate until sample analyses confirm the 99.9999 percent agent DE is
39 achieved. GB hydrolysates are sampled in the agent hydrolysate sampling tanks
- 40 5) Transfers cleared hydrolysate (i.e., 99.9999 percent DE) to the agent hydrolysate storage
41 tanks
- 42 6) Reprocesses failed hydrolysate in the agent hydrolyzers until 99.9999 percent DE is
43 achieved

**24915-000-GPE-GGPT-00001 – RESEARCH, DEVELOPMENT, AND DEMONSTRATION (RD&D) PERMIT
APPLICATION CDRL #A010**

1 **3.3.3 Waste Processing Sequences**

2 The following sections provide the processing sequence for each waste. Each unit operation is
3 described in greater detail in subsequent subsections.

4 **3.3.3.1 GB Nerve Agent Munitions**

5 **3.3.3.1.1 GB 8-Inch Projectile (no energetics are associated with this munition)**

- 6 1) Remove the pallet of projectiles from the EONC
- 7 2) Load the projectiles into a tray
- 8 3) Convey the tray to the nose closure removal (NCR) and munitions washout system (MWS)
- 9 4) Via robot, transfer each individual projectile to the nose closure removal station (NCRS)
10 and remove the lifting plug from the nose
- 11 5) Via robot, transfer the individual projectiles from the NCRS and load them into the MWS
12 module, nose-down
- 13 6) Hydraulically collapse the burster well into the projectile's agent cavity
- 14 7) Gravity-drain the agent through the nose of the projectile
- 15 8) Wash out the agent cavity using high-pressure water
- 16 9) Send the drained agent and washout water to storage tanks in the agent neutralization
17 room (see paragraph 3.3.4.11 for a discussion of the ANS)
- 18 10) Replace each washed munitions body into its tray
- 19 11) Convey the tray of washed projectiles to the MPT for thermal treatment

20 **3.3.3.1.2 GB 8-inch Leaking Munition Processing Sequence**

- 21 1) The overpacked GB projectiles will be removed from the EONC in the UPA
- 22 2) The munition will be transferred to the TMA where they will be manually unpacked and
23 placed on a tray on the conveyor system for processing through the MWS.
- 24 3) In the ECV, the overpacked projectiles are manually unpacked and placed on the conveyor
25 system for transfer to the PMD for processing.
- 26 4) The empty overpack containers will be taken to the TMA for chemical decontamination or
27 thermal decontamination in the MPT prior to offsite recycling or disposal at a permitted
28 TSDF.

29 **3.3.3.1.3 GB M55 Rockets**

30 The majority of the M55 rockets are stored in the BGCA igloos on pallets in SFTs. These rockets
31 are termed "nonleakers." A small number of the M55 rockets have been overpacked because of
32 leaks that were identified during routine agent monitoring in the igloos; these rockets are termed
33 "leakers". Paragraph A of this subsection (Nonleaker Rocket Processing Sequence) presents the
34 processing sequence for the nonleakers; paragraph B [Processing Sequence for Leakers
35 (Rockets)], the overpacked rockets (also termed "leakers").

**24915-000-GPE-GGPT-00001 – RESEARCH, DEVELOPMENT, AND DEMONSTRATION (RD&D) PERMIT
APPLICATION CDRL #A010**

1 A. Nonleaker Rocket Processing Sequence

2 The motors from the nonleaker M55 rockets have also been called “rocket motors” (RMs). The
3 processing sequence for the nonleaker rockets is as follows:

- 4 1) Remove the pallet of rockets from the EONC (UPA)
- 5 2) Place each rocket individually onto the rocket input assembly, which conveys it through the
6 airlock to the ECV and to the RCM. The RCM separates the rocket into three pieces: the
7 warhead, the warhead’s SFT, and the RM
- 8 3) Transfer the RM (still contained in its section of the SFT) to a container approved for
9 intra-installation transportation for further treatment at another location on BGAD or an
10 offsite TSDf yet to be determined
- 11 4) Transfer the warhead’s SFT to a container for disposal at a permitted TSCA landfill
- 12 5) Convey the rocket warhead to the punch-and-drain station of the RSM in the ECR
- 13 6) Punch holes in the top and bottom of the rocket warhead agent cavity with the punch-and-
14 drain station
- 15 7) Drain the agent through the lower clamp. Send the drained agent into an agent storage
16 tank in the agent neutralization room (see paragraph 3.3.4.11 for a discussion of the ANS)
- 17 8) Introduce high-pressure water. Flush the agent cavity (the optimum flush duration,
18 pressure and flow rate will be evaluated during simulant, surrogate, and agent testing in
19 the RD&D program), maintaining suction at a slightly higher flow rate than the inflow
- 20 9) Send the washout water to a storage tank in the agent neutralization room
- 21 10) Move the rocket warhead to the shear station for cutting
- 22 11) Cut the warhead portion into segments. The warhead includes the fuze, the burster, and
23 the washed agent cavity
- 24 12) Send the warhead segments to the EBHs
- 25 13) Send the energetics hydrolysate from the EBH to the ENS for further hydrolysis, as
26 required
- 27 14) Sample and analyze the energetics hydrolysate to verify that it no longer exhibits the
28 characteristic of reactivity and that the agent concentration is below the target release level
29 for agent before transfer to the HSA
- 30 15) Transfer the energetics hydrolysate from the HSA to the APS and the AFS in the SPB
- 31 16) Chemically precipitate the aluminum and then remove the precipitate by filtration. The
32 aluminum precipitate is characterized and sent offsite to a permitted disposal facility. Send
33 the filtrate to the SCWO for further treatment
- 34 17) Send solid material (rocket sections and pieces) from the EBHs through the MPT for
35 thermal treatment at a minimum of 1,000°F for a minimum of 15 minutes

36 B. Processing Sequence for Leakers (Rockets)

37 The leakers are classified into two categories: known and unknown. The known leakers are those
38 that were identified through monitoring in the BGCA igloos and are stored in the igloos in
39 overpacks. The unknown leakers include those that did not arrive in the UPA as leakers but were
40 later identified as such in the EONC or in the RCM.

41 The known leakers will be processed at the end of each agent campaign at BGCAPP.

**24915-000-GPE-GGPT-00001 – RESEARCH, DEVELOPMENT, AND DEMONSTRATION (RD&D) PERMIT
APPLICATION CDRL #A010**

1 The unknown leakers will be accumulated in the ECVs and then processed in a leaker campaign,
2 or these previously unknown leakers will be overpacked and sent back to the leaker storage igloo
3 for processing during the known leaker rocket campaign. The processing sequences for both
4 known and unknown leakers are presented below:

- 5 1) For known overpacked leakers (stored in the igloos in overpacks):
 - 6 a. The EONCs of overpacked rockets are monitored for agent in the UPA. If agent
7 monitoring indicates that the EONC does not contain any leaking overpacks, the
8 EONC is opened and the overpacks are transferred to the ECV.
 - 9 b. In the ECV, the rocket overpack is opened manually by operations personnel in PPE
10 and the rocket is removed from the overpack. The rocket is placed on the RCM
11 conveyor system in the ECV.
- 12 2) For unknown leakers (leakers that are not overpacked and are identified in EONCs and at
13 the RCM):
 - 14 a. Leaking rocket(s) may be detected during agent monitoring of EONCs in the UPA.
15 EONCs found to contain previously unknown leakers will be transported to the
16 EONC leaker airlock so the leakers can be removed from the EONC and sent to the
17 ECV. Personnel in appropriate PPE will place each potentially contaminated rocket
18 onto the RCM conveyor system.
 - 19 b. A previously unknown leaker may also be detected when monitoring for agent at the
20 RCM or while observing the RCM. Leakers identified or found at the RCM may
21 either be stored for a short duration, overpacked, and sent back to the igloo for later
22 processing; or the leaker may be processed immediately if the number of stored
23 leakers in the ECV is sufficient to justify stopping normal rocket processing to
24 process the stored leakers. Personnel in appropriate PPE will place the leakers onto
25 the RCM conveyor system.
- 26 3) The RCM separates the leaking rocket into three pieces: warhead, warhead's SFT, and
27 CRM.
- 28 4) The warhead is processed in one of the two ECRs, as discussed in paragraph 3.3.4.6.4.
- 29 5) The agent-contaminated SFT is removed from the conveyor in the ECV and transferred to
30 the TMA for chemical decontamination and disposal at an off-site permitted TSCA TSDF or
31 the SFT may be thermally treated in the MPT.
- 32 6) The CRM is conveyed to the ECR for processing at the RSM, which shears the rocket
33 motor into four (approximately) 8-inch pieces and the tailfin.
- 34 7) The tailfin section and the segments of rocket propellant are transferred to and processed
35 in separate EBHs.
- 36 8) The energetics hydrolysate is sent from the EBHs to the ENS for further hydrolysis.
- 37 9) Before the energetics hydrolysate is transferred to the HSA, it is sampled and analyzed to
38 verify that it no longer exhibits the characteristic of reactivity and that the agent
39 concentration is below the target release level for agent. This is accomplished by use of
40 the ASTM E680 Standard, *Test Method for Drop Weight Impact Sensitivity of Solid-Phase
41 Hazardous Materials* and works with both solid and liquid waste samples.
- 42 10) The energetics hydrolysate is transferred from the HSA to the APS and AFS in the SPB

**24915-000-GPE-GGPT-00001 – RESEARCH, DEVELOPMENT, AND DEMONSTRATION (RD&D) PERMIT
APPLICATION CDRL #A010**

1 11) In the APS and AFS, aluminum is chemically precipitated from the energetics hydrolysate
2 and the precipitate is removed by filtration. The aluminum precipitate is characterized and
3 sent off site to a permitted disposal facility. The filtrate is sent to the SCWO for further
4 treatment.

5 12) Solid material (rocket sections and pieces) from the EBHs is sent through the MPT for
6 thermal treatment at a minimum of 1,000°F for a minimum of 15 minutes.

7 **3.3.3.1.4 GB M56 Warheads**

8 The GB M56 warheads will be processed and treated following the steps outlined in
9 subparagraph A of paragraph 3.3.3.1.3, except that (because they have no rocket motors) it will
10 not be necessary to cut and remove the rocket motor in the RCM.

11 **3.3.3.2 Wood Pallets**

12 Wood pallets not exposed to a leaking munition will not be processed through the BGCAPP and
13 will be managed by appropriate methods to promote waste minimization. The quantity of
14 agent-contaminated wood pallets and miscellaneous non-contaminated dunnage is reflected on
15 the Part A Application (see Figure 1-A).

16 All pallets and other dunnage associated with leaking munitions will be tested following Army-
17 approved methods. If they are contaminated, they will be treated by chemical decontamination.
18 The decontaminated wastes will be managed by appropriate means to minimize waste. If chemical
19 decontamination does not prove successful, the contaminated material will be treated in the MPT.

20 **3.3.3.3 Agent-Contaminated Plastic and PPE**

21 Plastic materials that are not contaminated with agent will be managed by appropriate methods to
22 promote waste minimization without any further treatment at BGCAPP. Plastic and PPE are
23 assumed to be contaminated if they have been exposed to agent. Agent-contaminated plastic
24 material (e.g., personnel protective ensembles, aprons, and gloves) generated during the RD&D
25 program will be chemically decontaminated. If chemical decontamination is not successful, the
26 material will be treated in the MPT. The decontaminated residue will be sent off-site to a permitted
27 TSDF for treatment/disposal.

28 **3.3.3.4 Miscellaneous Agent-Contaminated Metal Parts (e.g., banding, pumps,
29 and pipe)**

30 Metal material and parts not contaminated with agent will be appropriately managed to minimize
31 waste without any further treatment at BGCAPP. Agent-contaminated metal material and parts
32 generated during the RD&D program will be chemically decontaminated. If chemical
33 decontamination is not successful or efficient, the material will be treated in the MPT. The
34 decontaminated residue will be appropriately managed to minimize waste.

35 **3.3.3.5 Spent Activated Carbon**

36 Agent-contaminated spent activated carbon will be shipped off site for further treatment and/or
37 disposal at a permitted TSDF.

38 Spent activated carbon not contaminated with agent will be managed to minimize waste.

**24915-000-GPE-GGPT-00001 – RESEARCH, DEVELOPMENT, AND DEMONSTRATION (RD&D) PERMIT
APPLICATION CDRL #A010**

1 **3.3.3.6 Spent Decontamination Solution (SDS)**

2 SDS that is generated during the RD&D program will be processed as follows:

- 3 1) Pump the SDS from sumps in the Category A or Category B areas to the SDS storage
4 tanks. Liquid in the sumps in the Category C areas will be characterized and, based on the
5 results of the characterization; the sumps will either be pumped to the SDS storage tanks
6 or will be managed by other appropriate means
- 7 2) Sample and analyze the SDS in the SDS tanks to verify that it is below the target release
8 level for agent
- 9 a. If the agent concentration is below the target release level for agent, send the SDS to
10 the HSA for further treatment in the SPB
- 11 b. If the residual agent concentration is above the target release level for agent, treat
12 the SDS in the SDS tank with caustic and resample or send the SDS to the ANR for
13 further treatment

14 **3.3.4 Munitions Unpacking**

15 EONCs containing munitions are moved from the CHB to the UPA of the MDB for processing.
16 Before the EONC is opened (in the UPA) to access the munitions, the air in the sealed EONC is
17 monitored for agent. If agent is detected, the EONC will not be opened until it is transported to the
18 EONC leaker airlock, which is designed to handle the opening of the container as described in
19 paragraph 3.2.2. If no agent is detected, the EONC will be opened in the UPA and the munitions
20 will be unloaded for processing. Unburstered projectiles are loaded onto a munition tray; the tray is
21 placed on a conveyor and moved to the NCR/MWS station. Rockets are loaded onto the rocket
22 input assembly and conveyed into the ECV where the RCM begins the processing of the rockets.

23 In addition to the RCM operations, the overpacked rockets and overpacked projectiles are
24 removed from the overpacks and placed on their respective conveyors for processing as described
25 in paragraphs 3.3.4.2. Overpacked unburstered projectiles are loaded onto a munition tray for
26 processing through the nose closure removal station (NCRS) as described in paragraph 3.3.4.4.

27 The following subsections describe the munitions unpacking subsystems.

28 **3.3.4.1 Projectile Input Subsystem**

29 The 8-inch GB projectiles are unpacked in the UPA, placed onto the projectile feed conveyor, and
30 transferred through the ECV and into the ECR for reverse assembly by the NCRS.

31 The projectile feed conveyor is a combination of a roller-type conveyor and an airlock assembly
32 with a series of doors. The doors provide for an airlock into the ECV and provide a negative
33 pressure in the ECV preventing air from flowing into the UPA.

34 **3.3.4.2 Rocket Input Subsystem**

35 M55 rockets are unpacked on the receiving table in the UPA, placed onto the rocket input
36 assembly, and conveyed to the ECV for processing on the RCM. Following RCM processing, the
37 rocket warheads are conveyed into the ECR through a munition access blast gate for processing
38 by the RSM. The plant has two RCMs and two RSMs: each has its own rocket input system, and
39 one RCM is located in each ECV and one RSM is located in each ECR.

**24915-000-GPE-GGPT-00001 – RESEARCH, DEVELOPMENT, AND DEMONSTRATION (RD&D) PERMIT
APPLICATION CDRL #A010**

1 **3.3.4.3 Dunnage/Secondary Waste**

2 The main component of the dunnage is the wood pallets on which the munitions were stored and
3 transported. Most of the wood pallets are not agent-contaminated and can be segregated in the
4 UPA and not managed as a RCRA hazardous waste. Pallets that are associated with leaker
5 munitions will be processed as described in paragraph 3.3.3.2.

6 Other agent-contaminated (or potentially agent-contaminated) secondary waste, such as PPE and
7 plastic, will be managed as described in paragraphs 3.3.3.3 through 3.3.3.4.

8 Spent activated carbon will be managed as described in paragraph 3.3.3.5.

9 **3.3.4.4 Nose Closure Removal Station**

10 The NCRS removes the nose closures from the unburstered nerve agent projectiles by unscrewing
11 them from the nose of the projectile and placing them in a storage bin or tray. After the nose
12 closures have been removed from each projectile, a robot transfers the projectile from the NCR
13 station to the MWS station. The removed nose closures are placed on munitions trays and
14 processed through the MPT.

15 **3.3.4.5 Munition Washout System**

16 At the MWS, the projectile is inverted, placed into one of the MWS modules that contain a cavity
17 access machine. A ram is hydraulically forced into the projectile, collapsing the burster well into
18 the agent cavity as shown in Figure 3-3. The agent drains by gravity and is fed to the agent
19 storage tank in the ANS. The washout nozzle array (nozzles providing high-pressure water jets) is
20 integrated into the shaft of the burster well ram, and provide the high-pressure water sprays to
21 clean and flush the cavity. After flushing the cavity, the projectile is placed back on the munition
22 tray and transferred to the MPT. If for any reason, a projectile cannot be processed, there is a
23 reject table (Subpart I permitted storage area) in proximity to the MWS where rejects can be
24 managed until they can be further processed manually.

**24915-000-GPE-GGPT-00001 – RESEARCH, DEVELOPMENT, AND DEMONSTRATION (RD&D) PERMIT
APPLICATION CDRL #A010**

1
2 **Figure 3-3 – Projectile with Crushed**
3 **Burster Tube**

4
5 **3.3.4.6 Rocket Handling System**
6 **(RHS) (Drawing**
7 **24915-07-M5-RHS-00001)**

8 The RHS stations (to include the RSM and RCM)
9 and processing are described below.

10 **3.3.4.6.1 RCM**

11 The RCM's design is based on a commercially
12 available pipe cutter. The whole rocket, inside the
13 SFT, is placed into the RCM, which clamps the
14 motor end into a rotating chuck. A cutting wheel cuts
15 through the SFT and then through the rocket at the
16 point between the warhead and the rocket motor as
17 the chuck rotates. After the wheel cuts through the
18 rocket, the warhead's SFT is removed from the
19 warhead and sent out of the MDB. The warhead is
20 sent to the ECR and the rocket motor (if not
21 contaminated) is packaged for transport out of the
22 MDB.



**24915-000-GPE-GGPT-00001 – RESEARCH, DEVELOPMENT, AND DEMONSTRATION (RD&D) PERMIT
APPLICATION CDRL #A010**

1 **3.3.4.6.2** *RSM*

2 The RSM demilitarizes the M55 rocket warheads and CRMs. The RSM extracts agent from
3 rockets in a punch, drain, and wash station, and then shears them into segments to access the
4 energetics for neutralization in the EBH. Drained agent extracted at the RSM is pumped directly
5 into the agent storage tanks; all agent washout water is pumped to the spent decontamination
6 solution (SDS) storage tanks and agent surge tank. From the storage tanks, the agent and flush
7 material are pumped to the ANS for agent neutralization. The rocket warheads are processed at
8 the RSM after being removed from their fiberglass SFTs. The RSM used at the BGCAPP is similar
9 to the RSM used at baseline operations, but it has been modified to process warheads that have
10 been removed from the SFT to include a high-pressure flushing step that washes residual agent
11 from the agent cavity and removes any gelled agent. A fully automated, hydraulically powered
12 RSM is installed in each ECR.

13 **3.3.4.6.3** *Punch/Drain and Wash Station*

14 The punch/drain and wash station clamps the warhead while the warhead is punched, drained, and
15 washed out. To reduce residual agent in the rocket warhead cavity, and therefore minimize the
16 amount of agent processed in the EBH, the baseline RSM punch-and-drain station has been
17 modified to include a pressurized water spray system.

18 The sprays remove the residual agent and dissolve solidified material that does not drain during
19 the punch-and-drain cycle. The high-pressure water flush system improves cleaning of the rocket
20 warhead while minimizing changes to the baseline RSM system.

21 The flush rate is maintained at less than the drain rate capacity, assisted by vacuum, to avoid
22 pressurizing the warhead.

23 **3.3.4.6.4** *Rocket Shear Station*

24 The warhead, with the agent cavity drained and washed, is conveyed from the punch/drain and
25 wash station to the rocket shear station. Shearing is necessary to open the interior of the agent
26 cavity for improved decontamination, to open the interior of the burster for improved explosive
27 neutralization, and to cut the warhead into smaller sections that can be safely placed into the
28 EBHs. When processing the CRMs, cutting the CRM propellant into smaller pieces also exposes
29 more surface area to the hot caustic in the EBH, increasing the rate of hydrolysis.

30 The rocket shear station has an optical sensor that reads the position of a pusher arm that moves
31 the rocket forward for shearing. The sensor output identifies the location of each cut that the blade
32 will make. The rocket is progressively positioned under the blade, which shears the warhead and
33 rocket motor in a predefined pattern.

34 The solid material from the rocket shear station is transferred to the EBH for further processing.

35 **3.3.4.7** **Dunnage Treatment**

36 Dunnage will be managed in accordance with the procedures described in paragraphs 3.3.3.2
37 through 3.3.3.5.

38 **3.3.4.8** **Energetics Batch Hydrolyzer**

39 Explosives and CRM propellant contained in the rockets are treated in EBHs as shown in the PFD
40 for the EBH system. The EBH is a large steam-heated inclined drum similar in shape to a
41 traditional cement mixer.

**24915-000-GPE-GGPT-00001 – RESEARCH, DEVELOPMENT, AND DEMONSTRATION (RD&D) PERMIT
APPLICATION CDRL #A010**

1 After the M55 rockets and M56 warheads are drained of agent and sheared in the RSM, the
2 segments are placed in the EBHs for processing. The EBH drum is partially filled with hot NaOH
3 solution. During rocket processing, sheared rocket segments are placed in the rotating drum
4 where the energetics are dissolved and hydrolyzed. Rocket warhead segments and fin assemblies
5 (containing aluminum) are fed and processed separately from the steel-casing CRM segments in
6 the EBHs. Aluminum in the rocket segments is hydrolyzed while the propellant in the steel-cased
7 CRM segments is hydrolyzed in separate EBHs.

8 Hydrogen gas generated by the reaction of aluminum with sodium hydroxide is monitored, and an
9 air or nitrogen purge is provided to ensure hydrogen levels are maintained below 25 percent of the
10 lower flammability limit (LFL). The EBH room is designed as an ECR.

11 After the first EBH is charged, the second and third EBHs can receive energetics. Following
12 completion of energetics treatment in the first EBH, the solid residues are separated from the liquid
13 hydrolysate and transferred to the MPT for thermal decontamination. The hydrolysate is
14 transferred to the ENRs for final energetics destruction and confirmation of destruction. Samples
15 may be taken to verify that the hydrolysate is below the target release level for agent or statistical
16 methods may be used to establish minimum operating parameters that if met, ensure destruction
17 of energetics to a target release level. Following confirmation of destruction, the energetics
18 hydrolysate is transferred to the energetic hydrolysate storage tanks in the HSA. If the residual
19 agent concentration is above the target release level or the required minimum operating
20 parameters are not achieved, additional reaction time will be required in the ENRs before transfer
21 to the HSA.

22 Headspace gases from the EBHs and ENRs are sent to their respective, dedicated air pollution
23 control devices (i.e., EBH off-gas is sent to the OTE and ENR off-gas is sent to the OTM) and then
24 conveyed via piping to the MDB HVAC filtration system.

25 **3.3.4.9 ENS**

26 The energetics hydrolysate is not released from the MDB until it has been tested for agent and
27 verified to have met all requirements for release from engineering controls. The hydrolysate is
28 transferred to the energetic hydrolysate storage tanks in the HSA. If the residual agent
29 concentration is above the target release level, additional reaction time will be required in the
30 ENRs before transfer to the HSA.

31 Headspace gases from the ENRs are sent to an air pollution control device (i.e., MPT off-gas
32 treatment system [OTM]) and then conveyed via piping to the MDB HVAC filtration system.

33 **3.3.4.10 Aluminum Precipitation System (APS)/Aluminum Filtration System (AFS)**

34 The energetics hydrolysate is transferred from the HSA to the APS in the SPB, where pH of the
35 hydrolysate is adjusted to precipitate the aluminum compounds before it is sent to the AFS to filter
36 and remove the precipitated aluminum compounds.

37 The AFS filtrate is transferred to the SCWO feed tanks for blending with the agent hydrolysate.
38 The filter cake is managed in a Subpart I permitted container storage area (likely roll-off boxes)
39 until it can be removed and disposed at a permitted TSDF.

40 **3.3.4.11 Agent Neutralization by Hydrolysis**

41 The agent drained from the munitions, as well as the wash liquid from the drain-and-wash
42 operation, is hydrolyzed in the ANS reactors. Hot NaOH solution will be used to neutralize
43 GB agent.

**24915-000-GPE-GGPT-00001 – RESEARCH, DEVELOPMENT, AND DEMONSTRATION (RD&D) PERMIT
APPLICATION CDRL #A010**

1 In the neutralization process, the agent will be destroyed to at least 99.9999 percent on a mass
2 basis (i.e., the mass of agent entering the ANS versus mass of agent leaving the hydrolysis
3 system). Paragraph 3.5.2 discusses how the DE is determined.

4 **3.3.4.12 MPT, MPT Cooling System (MCS), and Off-gas Treatment System (OTM)**

5 Washed munition bodies from MWS, EBH solid residues, and secondary wastes are thermally
6 decontaminated in the MPT units. These items are placed on trays and are conveyed to the MPT;
7 the chamber is sealed, purged with nitrogen gas, and inductively heated until all components have
8 been thermally treated to a minimum of 1,000°F for a minimum of 15 minutes.

9 The MCS cools the trays exiting the MPT to a temperature which allows safe handling.

10 The OTM (i.e., an air pollution control device included in the Title V air permit) receives the
11 offgases from the MPT and the vent gases from the ACS, ANS, ENS, and SDS tank systems
12 before the offgases are conveyed via piping to the MDB HVAC filtration system.

13 The following subsections describe these three systems.

14 **3.3.4.13 MPT**

15 The MPT thermally decontaminates munitions bodies and other materials using inductive heating
16 and superheated steam. Air is excluded from the system through the use of airlocks and nitrogen
17 purges.

18 Projectiles and other materials are placed in trays on a conveyor for processing. The conveyor
19 carries them through the first MPT door into the inlet airlock. The tray is staged in the inlet airlock,
20 which is purged with nitrogen, until other trays in the MPT have completed processing and been
21 moved downstream. The tray is conveyed through the gate into MPT zone 1, where it is held until
22 it reaches the desired initial temperature. It is then moved into MPT zone 2 where it is further
23 heated for a sufficient time to ensure the complete mass of material has achieved a minimum of
24 1,000°F for a minimum of 15 minutes. After these conditions have been achieved, the tray from
25 zone 2 is moved into the exit airlock where it is kept for a sufficient period to ensure it has cooled in
26 the nitrogen atmosphere which prevents the formation of dioxins and related compounds. This
27 type of sequential operation allows for continuous treatment of trays of material while ensuring that
28 the material in each tray has been heated to a minimum of 1,000°F for a minimum of 15 minutes.

29 **3.3.4.14 OTM**

30 The OTM (a component of the permitted air pollution control system) is designed to remove air
31 pollutants from the MPT offgas and from the vent gases of the ACS, ANS, ENS, and SDS tank
32 systems.

33 The OTM consists of the following equipment:

- 34 • Two thermal oxidizers (TOXs)
- 35 • Two cyclones
- 36 • A common wet venturi scrubber system
- 37 • Filters and blowers

38 Each MPT has its own TOX and cyclone and the offgas from the two MPTs is combined prior to
39 further treatment in the scrubber system and filter before discharge to the MDB HVAC filtration
40 system.

**24915-000-GPE-GGPT-00001 – RESEARCH, DEVELOPMENT, AND DEMONSTRATION (RD&D) PERMIT
APPLICATION CDRL #A010**

1 The TOX unit is a flamed thermal oxidizer that oxidizes organics that may be present in the MPT,
2 ANS room tanks, and ENS offgases. It is designed to handle a wide variety of materials such as
3 halogenated organics, methane, hydrocarbons, ammonia, carbon monoxide, and hydrogen.

4 The TOX unit handles the following input streams:

- 5 1) Air feed to the oxidizing section to ensure the residual oxygen level in the unit effluent is at
6 least 5 percent.
- 7 2) Fine mist of water to the oxidizing section to maintain the operating temperature at 2,000°F
8 with capability to operate at 2,200°F if the gas feed has a higher heating value. A 2,200°F
9 temperature is required when contaminated wood pallets and SFTs from the rocket
10 handling system are processed in the MPT.
- 11 3) Natural gas to maintain the operating temperature at 2,000°F (or 2,200°F) if the heating
12 value in the gas feed is not sufficient to maintain the operating temperature.
- 13 4) Fine mist of water to the cooling section to maintain the exit temperature at 1,200°F.

14 The TOX consists of two sections, an oxidizing section, and a quench section. The oxidizing
15 section has a minimum gas residence time of 2 seconds at a minimum temperature of 2,000°F.

16 The MPT cyclone removes ash and other large particulate matter from the TOX unit effluent gases
17 and discharges the gases to the combined scrubber system.

18 The venturi/scrubber system is a combination of a venturi impaction scrubber that captures
19 particulates and rapidly quenches the hot gases, followed by an absorption tower that captures
20 acid gases. Caustic solution is added to the system to maintain pH and neutralize the captured
21 acids.

22 The OTM off-gas filter removes residual particulate matter greater than 3 microns in diameter. This
23 filter also is a demister, removing fine mist that may pass through the scrubber tower's demister
24 system.

25 The gas reheater reheats the OTM outlet gases to maintain the relative humidity of the blower
26 effluent stream below 55 percent to avoid condensation in the HVAC ducts. The treated offgases
27 from the OTM then go to the MDB HVAC filtration system.

28 **3.3.4.15 OTE**

29 The OTE (a component of the permitted air pollution control system) is designed to scrub the
30 offgases from the EBH and to remove contaminants from the ENS exhaust stream.

31 The OTE consists of the following equipment:

- 32 • EBH Scrubber Tower
- 33 • EBH Offgas Filters
- 34 • Air Reheaters, Blowers and Pumps
- 35 • Scrubber Recirculation Surge Tank & Chilled Water Cooler
- 36 • A Sulfuric Acid Day Tank and Metering Pump

**24915-000-GPE-GGPT-00001 – RESEARCH, DEVELOPMENT, AND DEMONSTRATION (RD&D) PERMIT
APPLICATION CDRL #A010**

1 The Offgas Treatment for the ENS (OTE) scrubs the exhaust gas from the Energetics Batch
2 Hydrolyzers (EBH) to remove contaminants (primarily ammonia) in the exhaust stream via
3 scrubbing with a sub-cooled, acidic solution. After the ammonia is removed, the exhaust gas
4 passes through a filter to remove any particulates greater than 3 microns in diameter with a
5 removal efficiency of 99.9 percent. Post filtration, the air stream passes through a heater to raise
6 the temperature before it goes to the exhaust blower and is sent to the MDB HVAC Filter at an
7 acceptable temperature and relative humidity. Excess scrubber liquid is sent to the Energetics
8 Neutralization Reactors (ENRs).

9 **3.3.4.16 Decontamination Solution Supply and Spent Decontamination Solution**
10 **Capture/Storage System**

11 Decontamination solution is used in the following activities:

- 12 1) Wash down and decontaminate agent spills
- 13 2) Decontaminate equipment
- 14 3) Decontaminate PPE that may have been contaminated during toxic area entries

15 Decontamination solution is applied to an area of contamination, and then rinsed with water after
16 allowing sufficient contact time. The wash water drains to sumps in the MDB.

17 The decontamination solution is based on NaOH, NaOCl, soap and water or other decontamination
18 solutions. Decontamination solutions will be evaluated and selected based on overall
19 performance, safety/health of workers, and environmental impacts.

20 The SDS is managed as described in paragraph 3.3.3.6.

21 **3.3.4.17 SCWO Units**


22 The SCWO units are used to treat the agent and energetics hydrolysates and spent
23 decontamination fluid. Various waste streams may be processed through the SCWO units either
24 individually or as blends. All materials fed to the SCWO units will have agent concentrations
25 previously verified as below the target release level for agent; therefore, the SCWO and
26 downstream operations do not require engineering controls.

27 The SCWO process is based on the unique properties of water at conditions above its
28 thermodynamic critical point of 374°C (705°F) and 3,206 pound per square inch, absolute (psia).
29 At these supercritical conditions, organic materials and oxidant gases are generally completely
30 miscible in water and the elevated pressure increases the mixture density in the reactor, thus
31 allowing rapid and complete oxidation reactions. Tests conducted as part of the TRRP have
32 provided data on the appropriate ratios of caustic and salt transport additives. The SCWO TRRP
33 reports have been submitted to KDEP as required by the RD&D Permit, Compliance Schedule Item
34 No. 1.

35 The SCWO reactor is a vertical down-flow high-pressure cylindrical vessel. Its general
36 configuration is shown in Figure 3-4. A replaceable annular liner is fitted into the vessel as shown.
37 A small flow of air or nitrogen is maintained in the annulus between the liner and the pressure
38 vessel to inhibit the ingress of process fluid into the annulus.

24915-000-GPE-GGPT-00001 – RESEARCH, DEVELOPMENT, AND DEMONSTRATION (RD&D) PERMIT
APPLICATION CDRL #A010

1
2
Figure 3-4 – Schematic of an SCWO Reactor

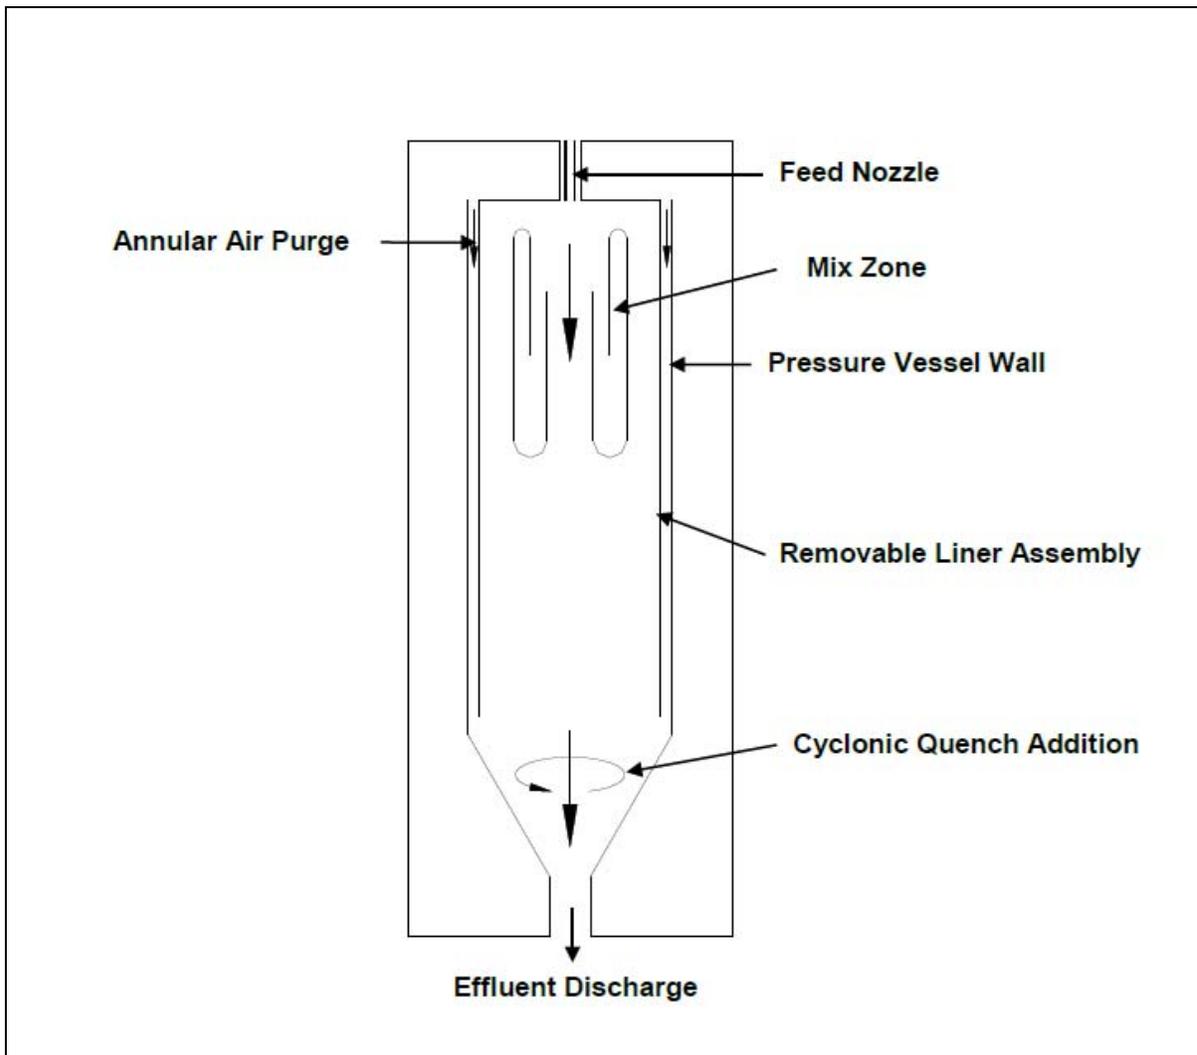

3
4 **Note:** This figure is presented as a general illustration of the functioning of a SCWO reactor. It
5 does not accurately depict the interior details of the BGCAPP SCWO reactors.

6 The material to be reacted (hydrolysate or spent decontamination solution) along with air is
7 pumped through the feed-nozzle at the top of the reactor. The feed material will be supplemented
8 with additional organic feed (supplemental fuel) in order to increase its heating value, as required
9 to maintain an autogenous reaction. Isopropyl alcohol (IPA), fuel oil, or kerosene may be used as
10 supplemental fuels at the BGCAPP, if necessary.

**24915-000-GPE-GGPT-00001 – RESEARCH, DEVELOPMENT, AND DEMONSTRATION (RD&D) PERMIT
APPLICATION CDRL #A010**

1 During system startup, an electric feed pre-heater heats the SCWO reactor to the fuel initiation
2 temperature at the nominal operating pressure of about 3,400 pounds per square inch (psi). At this
3 point, flows of oxidant and fuel are begun, and reaction is initiated. Oxidation of the fuel brings the
4 SCWO system to the full operating temperature before the hydrolysate is introduced. After the
5 hydrolysate flow is initiated, fuel flow is reduced to accommodate the heat released by hydrolysate
6 oxidation. As the hydrolysate feed rate is ramped up to the target throughput, the fuel, water, and
7 air flow rates are adjusted as required to maintain the desired operating conditions.

8 In the SCWO reactor, the organic constituents of the waste are converted to carbon dioxide (CO₂),
9 water (H₂O), nitrogen (N₂), or nitrous oxide (N₂O), and sulfates and phosphates (if sulfur or
10 phosphorus is present in the feed). Halogens are converted to their respective acids. The acids
11 react with the caustic to form sodium salts such as sodium chloride (NaCl), sodium fluoride (NaF),
12 monosodium phosphate (NaH₂PO₄), and sodium sulfate (Na₂SO₄), depending on the agent being
13 processed. The salts are not soluble in the supercritical fluid and they are carried through the
14 reaction zone (from the injector to the quench region) as solids or as slurries. At the bottom of the
15 reactor, quench water is introduced, lowering the temperature below the critical point and
16 converting the supercritical fluid to a liquid into which the salts dissolve. All of the reaction
17 products flow out the bottom of the SCWO reactor.

18 The quenched reactor effluent is passed through a series of heat exchangers to cool it to
19 near-ambient temperature, passed through a high-pressure gas/liquid separator (GLS), and then
20 passed through pressure reduction control valves. The gas stream and the liquid stream are
21 depressurized separately. The liquid stream goes to a second GLS to further remove gases that
22 were soluble at high pressure, principally residual CO₂. The gas is combined with the main gas
23 stream exiting the high-pressure GLS. The SCWO aqueous effluent exits the bottom of the low-
24 pressure gas/liquid separator and is pumped to the SCWO effluent tank for storage before it is
25 transferred to the RO system.

26 During upset conditions, the SCWO effluent is diverted to the Off-Spec Effluent Tank
27 (MV-SCWO-0041), and not to the tanks in the STA. The Off-Spec Effluent tanks are located in the
28 SPB and air emissions are controlled by the SPB HVAC system.

29 **3.3.4.18 Reverse Osmosis (RO)**

30 The RO unit processes the effluent from the SCWO units. SCWO effluent is first processed in the
31 feed preparation subsystem, consisting of a clarifier for removing suspended solids, a multimedia
32 filter, and a cartridge filter. The effluent, following this preparation step, is then fed to an RO unit
33 for brine concentration. The RO unit creates a permeate stream, which is of suitable quality for
34 reuse in the SCWO system and a slurry rejected by the RO unit. Reject from the RO unit is
35 combined with residues from the clarifier and filters and blow-down from processing units, stored in
36 the RO reject tanks, and then shipped off site to a permitted TSDF.

37 RO permeate is introduced into the SCWO reactor near the bottom to reduce the SCWO effluent's
38 temperature to below the critical point and results in the re-resolution of the inorganic constituents to
39 allow discharge from the reactor.

**24915-000-GPE-GGPT-00001 – RESEARCH, DEVELOPMENT, AND DEMONSTRATION (RD&D) PERMIT
APPLICATION CDRL #A010**

3.4 Environmental Parameters Monitoring and Frequency

**3.4.1 Groundwater Protection Plan--Groundwater Monitoring [401 KAR
34:060, Section 1 & 40 CFR 264.90(b)(2)]**

Groundwater monitoring requirements are not applicable. The BGCAPP is not a land based disposal unit. The facility was designed to contain and control all releases, thereby preventing impacts to the groundwater. Although the BGCAPP does receive wastes that contain free liquids (i.e., projectile and rocket warheads containing chemical agent), the design and hazard prevention procedures of the facility are extremely detailed and provide a high level of protection for the environment and general public, eliminating the requirement for groundwater monitoring in the vicinity of the facility.

In addition, the BGCAPP facility does not contain any identified solid waste management units (SWMUs) that require groundwater monitoring.

3.4.2 RCRA Organic Air Emissions

Franklin Engineering prepared the BGCAPP screening level human health risk assessment (SLHHRA) and the BGAD provided the SLHHRA to KDEP as a separate submittal. The SLHHRA demonstrates the hazardous constituents of concern released from the following points, which constitute the only emission points for hazardous waste processes, will not cause human health effects:

- 1) MDB HVAC stacks
- 2) SPB HVAC stack

The BGCAPP is a heavily robotic and mechanized operation, designed for additional protection of the operators. Under normal conditions (e.g., nonleaking munitions), the operators do not contact the wastes (chemical agents and energetics) because the wastes are contained in the munitions. In the case of leaking munitions, all agent operations take place in an area with the environment controlled by a negative pressure ventilation system (with air pollution control systems such as the OTM and OTE and final air stream treatment using HEPA filters and carbon adsorption). The BGCAPP monitors the air discharged from the ventilation system for agent. In addition, operators who deal with leaking munitions are trained to handle the munitions and wear PPE suitable for the risk associated with the task being performed.

Two or more BGCAPP personnel perform manual tasks involving wastes and CCR operators observe (via CCTV) all worker entries into areas that are possibly agent-contaminated.

Compliance with the requirements of 40 CFR 264.1030-1080 (RCRA Organic Air Emission Standards) are demonstrated as follows for wastes managed and treated in the BGCAPP:

- 1) 40 CFR 264.1030 – Subpart AA – Air Emission Standards for Process Vents: The BGCAPP does not treat or recycle hazardous wastes via any of the processes listed in Subpart AA. Therefore, Subpart AA requirements do not apply to the BGCAPP.
- 2) 40 CFR 264.1050 – Subpart BB – Air Emission Standards for Equipment Leaks: The BGCAPP does manage hazardous wastes in various types of equipment listed in Subpart BB, 264.1050(b). It is expected energetics hydrolysate and GB hydrolysate will contain less than 10 percent organics by weight. However, VX hydrolysate is expected to contain greater than 10 percent organics by weight. All wastes treated during the RD&D campaign are expected to contain less than 10 percent organics by weight.
- 3) 40 CFR 264.1080 – Subpart CC – Air Emission Standards for Tanks, Surface Impoundments, and Containers:

**24915-000-GPE-GGPT-00001 – RESEARCH, DEVELOPMENT, AND DEMONSTRATION (RD&D) PERMIT
APPLICATION CDRL #A010**

- 1 a. The BGCAPP does manage hazardous wastes in various containers and tanks as
2 well as Subpart X miscellaneous treatment units, as outlined in Subpart CC,
3 40 CFR 264.1082. These hazardous wastes will be managed in a combination of
4 both permitted and <90-day accumulation containers and tanks as well as various
5 Subpart X miscellaneous treatment units. BGCAPP expects those units that handle
6 hazardous wastes with a Volatile Organic (VO) concentration of at least 500 ppmw
7 will require emission controls as required in 40 CFR 264.1082(c)(2).
8 b. To demonstrate compliance with Subpart CC, the hazardous waste (Agent GB) will
9 be treated to reduce the VO concentration of the waste in accordance with the
10 applicable provisions of 40 CFR 264.1082(c)(2-4). This reduction in VO will occur for
11 agent waste in the Agent Neutralization Reactors (ANRs). Energetics will
12 simultaneously undergo treatment in the EBHs and ENRs.
13 c. The hydrolysates resulting from the initial treatment of each of these waste streams
14 undergoes secondary treatment in the Super Critical Water Oxidation (SCWO)
15 reactor(s), further reducing the total organics to less than 10 ppm TOC. The
16 resulting liquid waste stream (termed Reverse Osmosis (RO) reject) is sent off-site
17 for final disposal. All necessary controls required for regulated tanks and containers
18 (e.g., carbon filtration on tank vents) will be applied where necessary.

19 **3.4.2.2 Waste in Containers**

20 The BGCAPP uses approved Department of Transportation (DOT) containers to store hazardous
21 wastes in permitted container storage while meeting the container Level 1 control requirements of
22 EPA air emissions (Subpart CC) standards. Containers are not equipped with pumps,
23 compressors, pressure relief devices, sampling connections, valves, flanges and connectors, or
24 piping and are therefore not subject to Subpart BB requirements. Temporary storage of some
25 hazardous wastes may occur during operations (e.g., bagged agent-derived wastes or storage of
26 liquid wastes in portable tanks). However, the BGCAPP places hazardous wastes in DOT
27 approved waste containers prior to transport off site.

28 Although stored containers have only very limited quantities of free liquids, the container storage
29 areas comply with the secondary containment requirements for storing containers filled with free
30 liquids. Containers of agent-derived secondary wastes packaged for offsite shipment and
31 treatment/disposal are headspace monitored and packaged to eliminate free liquids.

32 The Part A (contained in the Executive Summary of this permit application) identifies the waste
33 streams managed/stored in containers (S01).

**24915-000-GPE-GGPT-00001 – RESEARCH, DEVELOPMENT, AND DEMONSTRATION (RD&D) PERMIT
APPLICATION CDRL #A010**

3.4.2.3 Waste in Tank Systems

The BGCAPP waste storage tanks were fabricated from carbon steel or chemical-resistant alloys (e.g., Hastelloy® or stainless steel), which through testing and use at other sites have been shown to be compatible with agent and energetics hydrolysates, spent decontamination solutions, and brines (e.g., RO reject). Fabrication of BGCAPP tanks includes additional shell thickness as a corrosion allowance and general corrosion should not become a critical factor during the life of the BGCAPP facility. The BGCAPP will perform non-destructive tank testing as necessary. Tank Assessment Reports (TARs) for the tanks used to store hydrolysates, spent decontamination solutions, and/or waste brine solutions were prepared and provided to KDEP in response to RD&D permit Compliance Schedule Item 8. Any remaining TARs for tanks identified subsequent to the Project's response to Compliance Schedule Item 8 will be provided to KDEP upon completion.

The HSA and SCWO tank area (STA) waste storage tanks will contain liquids that are agent-derived (N001) and corrosive (D002). Secondary containment capable of containing the contents of the largest tank surrounds these waste tanks (as is provided for the process/storage tanks inside the MDB and SPB). However, because these storage tanks are located outdoors, the associated containments can also capture a 25-year/24-hour storm event and have adequate "freeboard" to prevent "topping" during or following this type of heavy rainfall event (i.e., sufficient freeboard to prevent topping if both of these events occur simultaneously).

Each treatment or storage tank system (e.g., SDS, ANS, and ENS) processes a single waste stream, eliminating the possibility of waste stream incompatibilities.

The Part A identifies the waste volumes treated or stored in tanks (T01 or S02). All Subpart J-regulated tanks in the HSA and STA will contain carbon filtration on the tank vents as necessary, which serve as Level 2 controls required by Subpart CC.

3.4.2.4 Waste in Miscellaneous Treatment Units

The majority of the miscellaneous treatment units at the BGCAPP provide for reverse assembly of and access to chemical agents in munitions. The reverse assembly/treatment units include the MWS, nose closure removal system (NCRS), PMD, RSM, and RCM). Section 3.3 of this Permit Application describes these units in detail. The demonstration of the effectiveness of these reverse assembly/treatment units is the capability to provide the required reverse assembly while maintaining the expected throughput rate. Subpart X units in the SPB vent to the interior of the SPB, then are vented through the emergency relief tank room, and then out through the SPB HVAC system.

Five miscellaneous treatment units [i.e., MPT, EBH, RO Unit, APS/AFS, and SCWO] provide waste processing and treatment. Laboratory analyses and operating parameters evaluated to determine the effectiveness of this treatment include:

- 1) Temperature of at least 1000°F and hold time of at least 15 minutes for MPT (i.e., the criteria established by the U.S. Army for thermal treatment of all chemical agents for safe release to the public)
- 2) Temperature and reaction time ensure energetics and aluminum components are dissolved and primary neutralization of energetics occurs (i.e., criteria for EBH operation to be established during RD&D testing)
- 3) Total dissolved solids (TDS) will meet target levels as developed during RD&D testing for the RO System and APS/AFS Systems
- 4) Total organic carbon (TOC) analysis for the SCWO effluent

**24915-000-GPE-GGPT-00001 – RESEARCH, DEVELOPMENT, AND DEMONSTRATION (RD&D) PERMIT
APPLICATION CDRL #A010**

1 **3.4.3 Environmental Protection Standards Compliance**

2 The requirements of KAR 30:031 regulate the three mechanisms for contaminant release from a
3 TSDF:

- 4 1) Discharge to surface water
- 5 2) Contamination of soil and groundwater
- 6 3) Release to the atmosphere

7 The BGCAPP is a completely enclosed facility with no discharges to surface water, ground, or
8 groundwater. Although the potential to release contaminants to the air does exist at this facility,
9 control measures have been designed and constructed to control emissions. The following
10 discussion addresses those aspects of KAR 30.031 that relate to the first two mechanisms for
11 contaminant release. The discharges to the atmosphere and how the BGCAPP designed and
12 constructed control measures comply with and exceed all of the regulatory requirements are
13 discussed in addressing the requirements of 401 KAR 30:031, Section 9.

14 **3.4.3.2 KAR 30:031 Section 2 – Floodplains**

15 The BGCAPP is not located in a floodplain.

16 **3.4.3.3 KAR 30:031 Section 3 – Endangered Species**

17 As discussed in the Destruction of Chemical Munitions at Blue Grass Army Depot (BGAD),
18 Kentucky, Final Environmental Impact Statement (EIS) (December 2002), the area of construction
19 was surveyed and the BGCAPP was sited so that it did not impact any endangered species. Final
20 site determination was analyzed in a National Environmental Protection Act (NEPA) document
21 prepared in 2004.

22 **3.4.3.4 KAR 30:031 Section 4 – Surface Waters**

23 The BGCAPP is a zero-discharge facility; it does not discharge to surface waters.

24 **3.4.3.5 KAR 30:031 Section 5 – Groundwater**

25 The BGCAPP is totally enclosed. All hazardous waste storage tanks will be constructed to meet
26 the requirements of 401 KAR 34:190 and are provided with secondary containment designed and
27 operated to contain 100 percent of the capacity of the largest tank and the additional capacity to
28 contain the precipitation from a 25-year, 24-hour storm (5.3 inches).

29 **3.4.3.6 KAR 30:031 Section 6 – Application to Land Use for the Production of
30 Food Chain Crops**

31 The BGCAPP does not apply waste to the land or dispose of any waste on the land.

32 **3.4.3.7 KAR 30:031 Section 7 – Land Disposal of PCBs**

33 The BGCAPP will send all PCB waste only to EPA permitted TSCA treatment and disposal
34 facilities.

35 **3.4.3.8 KAR 30:031 Section 8 – Disease**

36 The BGCAPP will not process pathogenic or other biological wastes.

**24915-000-GPE-GGPT-00001 – RESEARCH, DEVELOPMENT, AND DEMONSTRATION (RD&D) PERMIT
APPLICATION CDRL #A010**

1 **3.4.3.9 KAR 30:031 Section 9 – Air**

- 2 1) Open burning of wastes – The BGCAPP will not perform open burning of any wastes.
3 2) KRS Chapter 224, Air Pollution Regulations – The BGCAPP will comply with all
4 requirements of KRS Chapter 224 or administrative regulations promulgated pursuant
5 thereto. A Kentucky Title V air permit (No V-10-023) has been issued to BGCAPP.

6 **3.4.3.10 KAR 30:031 Section 10 – Safety**

- 7 1) Explosive gases – Waste processing that may generate explosive gases is described in
8 paragraph 3.2.1.3. Additional information will be provided to KDEP in sufficient time before
9 the start of construction of the affected treatment units.
10 2) Fires – No waste will be disposed of on land; therefore, the types of fires covered by this
11 paragraph cannot occur.
12 3) Access – Access to all of the BGCA CLA is controlled and monitored by security. The
13 BGCA is surrounded by a heavy chain link fence topped by barbed wire. The BGCAPP will
14 be surrounded by a double fence topped with barbed wire. The BGCAPP can be accessed
15 through the manned ECF. The CLA will be continuously monitored by armed guards
16 performing roving patrols throughout the area.

17 **3.4.3.11 KAR 30:031 Section 11 – Public Nuisance**

18 The BGCAPP is within the confines of the BGAD and is located a significant distance inside a
19 secure, military facility and away from any public view or contact. It poses no public nuisance.

20 **3.4.3.12 KAR 30:031 Section 12 – Wetlands**

21 The BGCAPP is not located in a wetland.

22 **3.4.3.13 KAR 30:031 Section 13 – Karst**

23 All operations will be performed in enclosed buildings with no run-on or runoff.

24 **3.4.3.14 KAR 30:031 Section 14 – Compliance**

25 BGCAPP will comply with the applicable requirements of KRS 224, 401 KAR, and the BGCAPP
26 Permit. Regulated units within BGCAPP will be managed in accordance with 401 KAR Chapter 34
27 “Standards for Owners and Operators of Hazardous Waste Storage, Treatment and Disposal
28 Facilities.” Each regulated area or unit is discussed below with the appropriate regulatory
29 requirements from 401 KAR Chapter 34.

30 **3.4.3.14.1 Container Storage**

31 This section describes the areas in which BGCAPP will manage containers of hazardous waste
32 and some of the types of containers managed, and briefly describes the hazardous waste.
33 Containers listed below and additional containers selected and used during systemization and the
34 RD&D program at BGCAPP meet the definition and requirements of 401 KAR 38:005,
35 401 KAR 34:180, and 401 KAR 38:150.

**24915-000-GPE-GGPT-00001 – RESEARCH, DEVELOPMENT, AND DEMONSTRATION (RD&D) PERMIT
APPLICATION CDRL #A010**

1 **3.4.3.14.2** *Hazardous Waste Containers*

2 Several different containers will be used to manage, store, and transport hazardous waste within
3 BGCAPP, in addition to the munitions themselves. Several of these containers are described
4 below, but this listing is not all inclusive. As additional types of containers are identified, they will
5 be incorporated into BGCAPP procedures in compliance with 401 KAR 34:180 and
6 401 KAR 38:150. Only compatible wastes will be containerized together.

7 **A. Single Round Container (SRC)**

8 M55 rockets that have been found to be leaking are containerized in a single round container
9 (SRC). The SRC was specifically developed to contain the M-55 in a substantial steel shell, which
10 has been subjected to a helium leak test as part of the acceptance process. Leaking M-55 rockets,
11 which were containerized before the development of the SRC, are stored in a modified M-1
12 container. The modified M-1 is a heavy steel cylinder bolted on with a gasket seal with eight bolts.
13 All munitions are stored on specialized pallets designed to store the overpacked unit securely.

14 **B. M16 Series Overpack Container**

15 The M16 series containers are cylindrical steel containers designed to be air tight, designated for
16 the over-pack of projectiles. Overpacked 155-mm projectiles are stored in wooden “egg crates”
17 specifically designed to store the M16 overpack container.

18 **C. M10 Series Overpack Container**

19 The M10 series container is a cylindrical steel container that is designed to be airtight and is
20 designated for use as an overpack container for leaking or deteriorated M16 containers and as an
21 overpack container for 8-inch projectiles.

22 **D. Intermediate Bulk Containers (IBCs)**

23 IBCs may be used throughout the process to collect various liquid waste streams. Each IBC will
24 have a capacity of 300 gallons with nominal dimensions of 42 by 48 by 41 inch (LxWxH). IBCs
25 are manufactured from various materials including carbon steel, stainless steel and polymers in
26 accordance with DOT regulations.

27 **E. Enhanced Onsite Container (EONC)**

28 The Department of the Army uses EONCs to store and transport the munitions and bulk containers
29 for the time period immediately preceding demilitarization activities. The EONC is designed to
30 provide vapor tight containment of agent; all seals on the containers are impervious to agent and
31 are able to withstand decontamination solutions; and air monitoring can be performed of the
32 headspace within the EONCs. The EONC will provide secondary containment for the munitions or
33 containers stored within. The EONCs and any components mounted on the surface will fit within
34 an envelope that is 8.5 feet by 8.5 feet by 12 feet high. The combined weight of the EONC and
35 munition holding trays will not exceed 26,000 pounds (Figure 3-2).

36 **F. Commonly Used Containers**

37 There will be many different types of containers used for storage and transportation at BGCAPP.
38 See Figure 3-9 for a listing of the most commonly used container types expected to be utilized at
39 BGCAPP.

**24915-000-GPE-GGPT-00001 – RESEARCH, DEVELOPMENT, AND DEMONSTRATION (RD&D) PERMIT
APPLICATION CDRL #A010**

1 **3.4.3.14.3** *Container Management*

2 Containers at BGCAPP will be managed in accordance with 401 KAR 38:005, 401 KAR 34:180
3 and 401 KAR 38:150. Munitions destined for demilitarization are described in section 3.0. The
4 munitions are transported to the container handling building (CHB) for storage prior to processing
5 during the RD&D program. Munitions will be transported from the hazardous waste storage igloos
6 to the CHB as a permitted activity, as outlined in the Part A (see Figure 1-A). Details of the transfer
7 of custody have yet to be determined, however, BGCAPP personnel will be responsible for the
8 physical movement of the EONCs once the waste munitions have been loaded into the EONC.

9 Each truck can transport one EONC of munitions. The number of trucks per day and the loading
10 configuration in the EONCs will vary depending on the specific schedule of research activities.
11 EONC movement from the CHB to the munitions demilitarization building (MDB) continues
12 24 hours/day, 7 days/week.

13 When the truck enters the BGCAPP site, it will move to an off-loading area at the CHB. A bridge
14 crane or similar device will be used to unload the EONC. All containers present in the CHB will
15 contain the same agent because the facility will process only one chemical agent at a time. In
16 accordance with the Kentucky Hazardous Waste regulation 401 KAR 34:180 Section 5, the vapor
17 space of the EONCs containing waste that remain in the CHB for more than 1 week will be
18 monitored using an agent monitor port in the EONC on a weekly basis. This monitoring for agent
19 vapor is in lieu of the RCRA required visual inspections of the containers (munitions).

20 Wastes generated during the RD&D program and construction will be placed in containers whose
21 materials of construction are compatible with the waste. The selection of a container will be made
22 on a case-by-case basis consistent with generator knowledge of the waste stream. In cases of
23 uncertainty, the stream's pH or other relevant parameters will be evaluated and the container
24 material selected on the basis of this analysis. All waste containers will always be kept closed
25 during storage except when adding or removing waste.

26 Containers will be handled in a manner to avoid rupturing or leaking. Container handling will be
27 performed with drum dollies, forklifts, overhead cranes, or other means, as appropriate. A goal of
28 the RD&D demonstration will be to evaluate the safety, suitability and integration of the container
29 handling procedures within the overall process.

30 Development of container management will continue throughout systemization and the RD&D
31 program.

32 **3.4.3.14.4** *Hazardous Waste Container Storage Areas*

33 Several locations within BGCAPP will have permitted container storage areas. These areas will be
34 designed, constructed and managed in accordance with all applicable standards of
35 401 KAR 38:005, 401 KAR 34:180, and 401 KAR 38:150. The Part A form; included in the
36 Executive Summary section of this Application (Figure 1-A), summarizes the areas within BGCAPP
37 to be permitted for container storage; more detailed descriptions follow.

38 **A. CHB**

39 The CHB is a steel-frame building with insulated metal roofing and insulated siding panels. A side
40 loader truck will be used to move the EONCs into the CHB and also to transfer them to the UPA.

41 The EONC storage area is sized to store 53 EONCs.

42 Permitted storage will be limited to the storage of containers inside of EONCs. The EONC meets
43 secondary containment requirements of 401 KAR 34:180, Section 6 for the munitions contained
44 within.

**24915-000-GPE-GGPT-00001 – RESEARCH, DEVELOPMENT, AND DEMONSTRATION (RD&D) PERMIT
APPLICATION CDRL #A010**

1 The floor of the CHB is constructed of reinforced concrete. The CHB-MDB transition structure is
2 metal siding with a reinforced concrete floor. The number of construction and expansion joints will
3 be kept to a minimum. All joints between floors and walls will be covered and sealed.

4 B. MDB

5 Wastes stored in some of these MDB areas will include both munitions and secondary wastes.
6 The Part A provided with this revision to the RD&D permit application includes additional waste
7 storage details for each of these areas including both process and secondary wastes managed in
8 each area (see Figure 1-A). The MDB is the primary treatment facility in the chemical weapons
9 destruction process and includes the following permitted storage areas:

10 1) UPAs

11 Containers and munitions will be brought from the CHB into the MDB via the UPAs. Each UPA is a
12 transition area between the CHB and the hazardous waste processing in the MDB. Permitted
13 storage will be limited to the storage of containers inside of EONCs or on secondary containment
14 pallets. The EONC meets secondary containment requirements of 401 KAR 34:180, Section 6 for
15 the munitions contained within. This area will also provide a means to monitor the EONCs for
16 leakers, provides an unpack station, and provides a means to return empty EONCs to the CHB for
17 temporary storage. The floor of each UPA is constructed of reinforced concrete. The number of
18 construction and expansion joints will be kept to a minimum. In this area, the floor, sumps and
19 curbs will be coated with an applied material that provides a flexible liner. There is a 4,800-gallon
20 storage capacity to include both munitions and secondary wastes.

21 2) Explosive Containment Vestibules (ECVs)

22 Munitions will be stored on the conveyors in these rooms and the munitions will also be stored on
23 the reject systems located in these rooms. In addition, leaking or reject projectiles that have been
24 placed in overpacks may be stored on the floor in these rooms. Storage of projectiles or rockets, in
25 or out of EONCs, will not exceed the maximum number allowable determined by the net explosive
26 weight. Secondary containment will be provided by a coated, reinforced concrete floor, sumps,
27 and perimeter curbs/walls. The number of construction and expansion joints has been kept to a
28 minimum. In this area, the floor, sumps and curbs will be coated with an applied material that
29 provides a flexible, external liner. There is a 550-gallon (total) storage capacity for secondary
30 wastes in these two ECVs. If necessary, spill containment pallets also may be used.

31 3) Explosive Containment Rooms (ECRs)

32 Munitions containing explosives (projectiles with bursters and rockets) are processed in ECRs.
33 The number of projectiles in an explosive contaminant room at any time is limited by the explosive
34 force contained in the aggregate projectiles as determined by the net explosive weight. Munitions
35 will be stored on the conveyors in this room and the munitions will also be stored on the reject
36 systems located in this room. In addition, leaking projectiles that have been placed in overpacks
37 may be stored on the floor in this room. Secondary containment will be provided by a coated and
38 reinforced concrete floor, sumps, and perimeter curbs/walls. The number of construction and
39 expansion joints will be kept to a minimum in this area. In this area, the floor, sumps and curbs will
40 be coated with an applied material that provides a flexible, external liner. There is a 110-gallon
41 (total) storage capacity for secondary wastes in these two ECRs. If necessary, spill containment
42 pallets also may be used.

43 4) Tray/Container Transfer Room

44 Miscellaneous secondary waste will be stored in this area until it is removed for disposal. Typical
45 containers include 55-gallon drums, plastic bags, and boxes. There is a 550-gallon storage
46 capacity for secondary wastes in this area.

**24915-000-GPE-GGPT-00001 – RESEARCH, DEVELOPMENT, AND DEMONSTRATION (RD&D) PERMIT
APPLICATION CDRL #A010**

1 5) ANS Room

2 Miscellaneous secondary waste will be stored in this room until it is removed for disposal. The
3 room may also be used to store spent decontamination solution (SDS) on a contingency basis.
4 Typical containers include IBCs, 55-gallon drums, plastic bags, and boxes. There is a 2,750-gallon
5 storage capacity for secondary wastes as well as contingency SDS storage in this area.

6 6) Motor Packing Room (MPR)

7 Separated rocket motors will be stored in this room prior to transfer from the building for storage or
8 treatment/disposal. In addition to the rocket motors, empty SFT segments removed from the
9 warheads will also be stored here. Typical containers include DOT-approved shipping boxes.
10 There is a 350-gallon storage capacity for the storage of 2 boxes of rocket motors and 2 boxes of
11 empty SFTs in this area.

12 7) Motor Shipping Room (MSR)/Covered Loading Area

13 Separated rocket motors will be stored in this room prior to transfer from the building for storage or
14 treatment/disposal. In addition to the rocket motors, empty SFT segments removed from the
15 warheads will also be stored here. There is a 350-gallon storage capacity for the storage of
16 2 boxes of rocket motors and 2 boxes of empty SFTs in this area.

17 8) Box Transfer Areas 1 and 2

18 Separated rocket motors will be stored in these rooms prior to transfer from the facility for storage
19 or treatment/disposal. In addition to the rocket motors, empty SFT segments removed from the
20 warheads will also be stored here. There is a 3,000-gallon (total) storage capacity for 36 boxes of
21 rocket motors in these 2 areas.

22 C. SPB Area

23 Miscellaneous secondary waste will be stored in this area until it is removed for disposal. Typical
24 containers include rolloff bins, 55-gallon drums, plastic bags, and boxes. There is an 8,550-gallon
25 storage capacity for AFS filter cake and secondary wastes in this area.

26 D. Waste Storage Area

27 Various liquid and solid hazardous wastes will be stored in this area until it is transferred to the
28 WTS for eventual off-site disposal. Typical containers include rolloff bins and 55-gallon drums.
29 There is a 5,500-gallon storage capacity for various process and secondary wastes in this area.
30 This area will include a sprung structure that will house 32 single stacked 55-gallon drums. Liquid
31 containment will be provided by the use of portable containment pallets whenever liquids are
32 stored in this area.

33 E. Waste Transfer Station

34 Various liquid and solid hazardous wastes will be stored in this area in drums and other container
35 types as necessary. This area is permitted for 24,000 gallons and will be sized to contain
36 approximately 176 single stacked 55 gallon drums. Drums may be double stacked if necessary,
37 which accounts for the requested permitted storage capacity. This area will include a sprung
38 structure to allow for heating and ventilation. Fire protection and communication systems will also
39 be included. Liquid containment will be provided by the use of portable containment pallets
40 whenever liquids are stored in this area.

**24915-000-GPE-GGPT-00001 – RESEARCH, DEVELOPMENT, AND DEMONSTRATION (RD&D) PERMIT
APPLICATION CDRL #A010**

1 F. Bulk Waste Storage Area

2 Various liquid and solid hazardous wastes will be stored in this area primarily in tanker trucks and
3 roll-off containers. The tanker storage area includes two separate but equal permitted storage
4 areas capable of storing 80,000 gallons each. This will include the storage of approximately
5 sixteen, 5,000-gallon tankers of hazardous waste (RO Reject) in each area. These areas are
6 pre-engineered concrete and will include appropriate secondary containment as required in
7 Subpart I. There also will be an additional concrete pad that will be used to store roll-off containers
8 with a permitted capacity of 25,000 gallons. Wastes stored in this area include filter cake, filter
9 media, shipping and firing tubes, as well as munitions and metallic components that will be shipped
10 off-site for recycling. Total storage capacity for these areas totals 185,000 gallons. Appropriate
11 fire protection and communication systems will be included.

12 **3.4.3.14.5** *Hazardous Waste Tank Storage Areas*

13 Tank systems within BGCAPP will be permitted for storage of hazardous wastes. These tank
14 systems are located outside, within the MDB, and within the SPB and will be designed,
15 constructed, and operated in accordance with all applicable standards of 401 KAR 38:005, 401
16 KAR 34:190 and 401 KAR 38:160.

17 **3.4.3.14.6** *Hazardous Waste Treatment Units*

18 Numerous hazardous waste treatment units will be used to destroy the chemical weapons
19 stockpile at BGCAPP. These treatment units will be installed during the construction phase of the
20 RD&D program. Each hazardous waste treatment unit will be designed, constructed, and operated
21 in accordance with the applicable standards from 401 KAR Chapter 34 (Standards for Owners and
22 Operators of Hazardous Waste Storage, Treatment and Disposal Facilities).

23 See section 2, paragraph 2.1.2 for the process description of these treatment units. Materials of
24 construction and dimensions of miscellaneous treatment units will be provided to KDEP in
25 sufficient time before the start of construction of the miscellaneous treatment units to allow full
26 evaluation of their adequacy.

27 **3.4.3.14.7** *Waste Transfer Station*

28 Wastes generated in the MDB will be containerized for eventual off-site shipment. Before these
29 wastes are shipped off-site, they will be transferred out of the MDB to the Waste Transfer Station
30 (WTS), which is located east of the MDB in the proximity of the firewater storage tanks. Here, the
31 wastes will be stored until they are loaded for off-site shipment to a permitted TSDF. There is a
32 24,000-gallon storage capacity for process and secondary wastes in this area.

33 **3.4.3.15** **401 KAR 38:230 Section 1 (4) – Effectiveness of Treatment**

34 See paragraph 3.1, for a list of the National Research Council (NRC) Reports, which evaluated the
35 various technologies and identified neutralization by hydrolysis to be an effective and safe method
36 for treating the chemical agent and the energetics that are stored at BGAD. The NRC reports are
37 prepared by committees selected for their experience and knowledge of the subject matter being
38 evaluated and were heavily peer-reviewed prior to publication. All reports identified in Table 3-1
39 (as well as numerous other reports) have identified neutralization followed by SCWO as
40 appropriate treatment technologies for BGCAPP. A nerve agent (i.e., other than GB) has
41 previously been destroyed using caustic hydrolysis.

**24915-000-GPE-GGPT-00001 – RESEARCH, DEVELOPMENT, AND DEMONSTRATION (RD&D) PERMIT
APPLICATION CDRL #A010**

1 **3.4.3.16 401 KAR 38:230 Section 1 (5) – Air Emissions, Additional Information**

2 Sources of agent emissions are contained within the MDB by the HVAC system and potential
3 airborne agent must pass through the MDB HVAC filtration system, which is described in section 2,
4 paragraph 2.1.3 and are removed. As indicated, the MDB HVAC filtration system has been used
5 at all of the chemical demilitarization facilities with a highly successful record of performance for the
6 past 30 years.

7 **3.4.3.17 401 KAR 34:190 and 401 KAR 38:160 – Tank Systems**

8 This section presents additional information on the tank systems. Part A of this application
9 (Figure 1-A) lists the tanks and their aggregate volumes. All tanks are maintained at essentially
10 ambient pressure and temperature. All agent and agent-contaminated storage tanks are kept
11 inside the MDB and headspace emissions from these tanks are vented through the off-gas
12 treatment and MDB HVAC filtration systems.

13 **3.4.3.18 401 KAR 34:190 Section 3(1) – Assessment of New Tank System's
14 Integrity**

15 The assessment of adequacy of the tank systems design was performed by an independent P.E.
16 and the resulting TARs were submitted to KDEP, for review and approval prior to starting
17 installation of each hazardous waste tank system. All tanks that recently have been identified as
18 Subpart J-regulated tank systems currently are undergoing a Tank Assessment Report (TAR)
19 review and preparation by the TAR subcontractor. These TARs will be provided to KDEP upon
20 their completion. Underground storage tanks will not be used for hazardous wastes at BGCAPP
21 and tanks storing hazardous waste are located above ground only.

22 **3.4.3.19 401 KAR 34:190 Section 3 – Description of Tank System Installation and
23 Testing Plans and Procedures**

24 An independent, qualified installation inspector or an independent, qualified registered professional
25 engineer will inspect each new tank system prior to placing a new tank system in service.
26 Inspection will include evaluation of the following items:

- 27 1) Welds to ensure the absence of breaks
- 28 2) Integrity to ensure the absence of punctures and cracks
- 29 3) Integrity of the protective coatings to ensure it has not been scraped through or otherwise
30 removed in locations
- 31 4) Lack of corrosion
- 32 5) Other structural damage or inadequate construction/installation.

33 Discrepancies identified by inspection will be repaired by appropriate methods and tank systems
34 will not be placed into service without satisfactory inspection results and repairs (if needed).

35 Hazardous waste tanks and associated ancillary equipment will be tested for tightness to liquid and
36 vapor before being placed into use. Identified discrepancies will be repaired by and the tank
37 systems will not be placed into service until applicable inspections have been satisfactorily
38 completed.

39 Ancillary equipment will be supported and protected against physical damage and excessive stress
40 due to settlement, vibration, expansion, or contraction.

**24915-000-GPE-GGPT-00001 – RESEARCH, DEVELOPMENT, AND DEMONSTRATION (RD&D) PERMIT
APPLICATION CDRL #A010**

3.4.3.20 401 KAR 38:160 Section 2 – Dimensions and Capacity of Each Tank

The capacity and number of hazardous waste tanks is specified in the Part A permit application. The tank dimensions were submitted to KDEP in the TARs submitted prior to beginning BGCAPP tank construction.

- 1) Description of Feed Systems, Safety Cutoff, Bypass Systems, and Pressure Controls – This information will be submitted to KDEP 24 months prior to the receipt of hazardous waste as specified in the BGCAPP RD&D Permit KY8-213-820-105, Appendix B.
- 2) Diagram of Piping, Instrumentation, and Process Flow – The piping and instrumentation diagram (P&IDs) will be submitted to KDEP 24 months prior to the receipt of hazardous waste as specified in the BGCAPP RD&D Permit KY8-213-820-105, Appendix B.

3.4.3.21 401 KAR 34:190 Section 4 – Containment and Detection of Releases

Plans and Description of Design, Construction, and Operation of Secondary Containment System

Assessment information on the containment design was submitted to KDEP either as part of a system-specific TAR [e.g., Hydrolysate Storage Area (HSA) tanks] or a part of a TAR specifically addressing the containment (e.g., MDB Horizontal Concrete). KDEP subsequently evaluated and approved these TARs to include calculations comparing the minimum required containment volumes and volume provided by the containment design.

3.4.3.22 401 KAR 34:190 Section 4(4)&(5) – Requirements for External Liner, Vault, Double-Walled Tank or Equivalent Device

External liners provide the secondary containment for the BGCAPP new tank systems in this permit application. The following subparagraphs summarize how these containments comply with environmental regulations:

- a. The design of secondary containments for the BGCAPP tank system(s) includes capacities that exceed the maximum capacity of the largest tank within its boundary. The volumes for these secondary containments are provided in the PE certified TARs previously submitted to KDEP
- b. Roofs over the BGCAPP tank systems prevent run-on or infiltration into secondary containments except for the outdoor hazardous waste tank systems (i.e., STA and HSA). The secondary containments for these outdoor tank systems are of sufficient capacity to contain the largest tank and run-on/precipitation from a 25-year, 24-hour rainfall event with adequate allowance for “freeboard” (i.e., sufficient freeboard to prevent topping due to wind action if both a leak of the largest tank in the containment and the 25-year, 24-hour rainfall event occur simultaneously)
- c. These secondary containments are free of cracks or gaps
- d. These secondary containments are all designed to surround the tanks and cover all the surrounding soils and prevent contact with tank wastes if leaks from the tanks occur
- e. These secondary containments are lined with coating materials, compatible with the wastes stored, and are effective as proven at other waste management facilities

**24915-000-GPE-GGPT-00001 – RESEARCH, DEVELOPMENT, AND DEMONSTRATION (RD&D) PERMIT
APPLICATION CDRL #A010**

1 **NOTE:** The secondary containment system in the MDB and SPB are currently being re-evaluated
2 with respect to the extent of waterstop used during the construction of each building.
3 BPBG expects to apply external, retrofit waterstop in some areas as well as re-coat some
4 of these areas. When the extent of condition is determined and final measures selected,
5 those modifications will be outlined in the white paper previously discussed between BPBG
6 and KDEP. These changes also will be captured in the next RCRA RD&D Permit Revision
7 (Rev. 6).

8 Category A and Category B sumps are part of the SDS tank system. As such, the sumps are
9 double-walled and have metal liners. An ultrasonic level detection sensor detects the presence of
10 liquid in the sump. The capacitance probe detects fluid in the interstitial area between the inner
11 and outer sump walls. This is the leak detection method for leaks occurring in primary sumps.
12 These sumps meet the regulatory requirements for an open-surface tank because these sumps
13 routinely receive/store agent-derived decontamination solutions during PPE decontamination
14 following entry of personnel into the Category A and Category B areas. CCR operators pump
15 wastes reaching these sumps to the SDS. If an operator identifies a leak from the outer sump wall
16 to the inner sump wall, the BGCAPP removes the sump from service for repair.

17 Containments in Category A and Category B areas slope so that liquid spills or leaks in the
18 containment drain to the sump(s). The sumps in these areas incorporate leak detection sensors
19 instrumented to sound an alarm in the CCR. The CCR operator responsible for the area with the
20 leak detection alarm can take actions needed to investigate the leak, identify the cause of the leak,
21 and initiate appropriate corrective action (e.g., begin repairs, remotely initiate a pumping of the
22 liquid in the sump to the SDS or to the agent collection/toxic storage tanks). Category C and D
23 sumps and sumps in outdoor hazardous waste tank areas are lined but may not have alarms or
24 stationary, instrumented pumps to drain the sumps. Tank systems in these areas are inspected
25 daily, and leaks identified, reported, contained, and repaired/removed consistent with
26 40 CFR 264.193(c)(4).

27 HVAC Condensate is generated by Recirculating Cooling Units (RCUs) in Category C and
28 Category D areas, in the same manner that condensate is generated in Category A and
29 Category B areas. However, the management of the condensate streams in Category C and
30 Category D areas will differ from that in Category A and Category B areas. For those RCUs
31 located in Category C areas, the condensate will be drained to Category C sumps. These sumps
32 are connected to the MDBs Spent Decontamination System (SDS), and will be emptied within
33 24 hours of accumulation of wastes. Category D sumps are inspected daily and the results
34 documented on the applicable inspection forms. If any wastes are discovered in these sumps, the
35 wastes will be removed as soon as possible, within 24 hours, and properly disposed. Also, based
36 on the configuration of these sumps, a check valve on the sump line combined with the top feeding
37 of the SDS tanks would not allow for any agent contaminated SDS liquids to flow back into the
38 sumps. MINICAMS® monitoring is continuous in the Category C areas and would detect the
39 presence of any agent containing liquids/wastes in these sumps.

40 **3.4.3.23 401 KAR 34:190 Section 4(6) – Secondary Containment and Leak**
41 **Detection Requirements for Ancillary Equipment**

42 Piping and fittings are either above ground and will be visually inspected for leaks daily or will be
43 equipped with leak detection. All piping and fittings containing agent or agent-contaminated liquids
44 are located in the MDB, which has engineering controls for liquids, monitoring for agent vapors,
45 and closed circuit TV surveillance allowing remote observations of areas for the detection of leaks.

**24915-000-GPE-GGPT-00001 – RESEARCH, DEVELOPMENT, AND DEMONSTRATION (RD&D) PERMIT
APPLICATION CDRL #A010**

1 **3.4.3.24 401 KAR 34:190 Sections 5 and 6: Controls and Practices to Prevent**
2 **Spills and Overflows**

3 The BGCAPP tanks and tank systems are equipped with multiple layers of protection to minimize
4 the possibility that the hazardous wastes or treatment reagents will cause any elements of a tank
5 system to rupture, leak, corrode, or otherwise fail.

6 **3.4.3.24.1 Wastes or Treatment Reagents Will Not Cause Damage:**

7 The TARs previously submitted to KDEP certified the design of all the hazardous waste tank
8 systems in this Permit Application. These TARs provided information on the tank systems,
9 including the associated secondary containments and ancillary equipment. These PE certified
10 TARs provide independent assurances that the tank systems can function without releasing wastes
11 to the environment and that hazardous waste or treatment residues placed in the tank system do
12 not cause any element of the system to rupture, leak, corrode, or otherwise fail.

13 These tanks have fixed roofs and, with the exception of the STA and HSA tank systems, the
14 associated secondary containment sumps and the secondary containment system are located
15 indoors without the additional capacity required to capture precipitation. The volumes of the
16 secondary containments for the outdoor HSA and STA provide adequate volume to contain the
17 largest tank, provide capacity for a 25-year, 24-hour rainfall event and sufficient freeboard (i.e.,
18 sufficient freeboard to prevent topping) to address overtopping by wave or wind action.

19 **3.4.3.24.2 Spill and Overfill Prevention Controls:**

20 Operation of BGCAPP tanks incorporates controls and follows practices designed to prevent spills
21 and overflows. These tank systems have spill prevention controls such as check valves and tight
22 shutoff valves. Lines that are below the liquid level in the tank incorporate one or more check
23 valves to prevent backflow from downstream equipment that might cause overfilling.

24 All tanks also have overfill controls, including level transmitters, high level and high-high level
25 alarms, and automatic feed cutoffs. The overfill controls consist of level sensors that are observed
26 and controlled by operators in the CCRs located in the CSB and the SPB. Trained operators and
27 supervisors staff these CCRs when the process is operational. In addition to these level controls,
28 tank design incorporates the following automatic protective features:

- 29 1) On high level reading, an alarm sounds in the CCR
30 2) On high-high level, the ICS shuts off power to the feed pump
31 3) On tanks with high-high-high level sensors, waste feed valves to those tanks are
32 automatically shut
33 4) Every tank is in a spill containment whose volume is adequate to hold the liquid from the
34 largest tank. Each tank is equipped with an overflow line or pressure relief that leads to the
35 sump in the containment

36 **3.4.3.24.3 Calibration and Testing of Tank Control Equipment:**

37 Calibration and testing of the level indicators and shutdowns occurs at a minimum of once per year
38 or based on manufacturer's recommendations. BGCAPP maintenance verifies the calibration of
39 the level indicators, checking against the inventory records for each tank to ensure accuracy, and
40 the BGCAPP tests the alarms and automatic feed cutoffs each month to ensure operation as
41 designed.

**24915-000-GPE-GGPT-00001 – RESEARCH, DEVELOPMENT, AND DEMONSTRATION (RD&D) PERMIT
APPLICATION CDRL #A010**

1 **3.4.3.24.4** *Inspection Schedule and Procedure:*

2 Plant operators conduct daily inspections of overfill controls, tanks, data from monitoring and leak
3 detection equipment, construction materials, and the area surrounding the tank systems.
4 Inspections of the tank systems within the Category A and Category B areas (within the MDB) may
5 be conducted from observation areas around the systems or during worker entries into these
6 areas. Scheduling of these inspections may be less than daily based on worker entry schedules.
7 Worker entries will not be conducted solely for tank system inspections (i.e., due to inherent risks).
8 CCR operators also can use CCTV to conduct inspections of the Category A and Category B areas
9 within the MDB on a weekly basis. The basis for the frequency of inspection is the rate of possible
10 deterioration of equipment and the probability of an environmental or human health incident if the
11 deterioration, malfunction, or operator error goes undetected between inspections. The BGCAPP
12 conducts daily inspections of areas subject to spills, such as loading and unloading areas when in
13 use. Figure 3-6 and Figure 3-7 also identify examples of the types of “Inspection Criteria” used for
14 these tank system inspections.

15 The following paragraphs summarize the criteria and regulatory requirements for these
16 inspections.

- 17 a. The aboveground portions of each tank system are inspected daily for signs of
18 external corrosion or releases of waste – 40 CFR 264.195.
- 19 b. Overfill controls are visually inspected monthly, when waste is present in the tank
20 system. The inspection consists of visual observation of the external overfill controls
21 for evidence of deterioration or malfunction. A reading of the level sensors and
22 transmitters associated with overfill control is obtained daily by operators –
23 40 CFR 264.195(a).
- 24 c. The BGCAPP hazardous waste tank systems outside the Category A and
25 Category B areas in the MDB (including tank shell and bottom, piping and valves,
26 pumps, tank supports, and construction materials, area around the tank, and
27 secondary containment system) are visually inspected once daily to detect corrosion,
28 erosion, or signs of waste releases – 40 CFR 264.195(b).
- 29 d. BGCAPP personnel monitor the temperature, pressure, and flow/level during transfer
30 operations. BGCAPP personnel also conduct daily inspections of leak detection
31 equipment, such as the level indicators in the sumps. The data gathered from
32 monitoring is reviewed at least daily to ensure tank systems are operating in
33 accordance with design specifications – 40 CFR 264.195(b).
- 34 e. The BGCAPP personnel inspect hazardous waste tank area sumps, trenches, and
35 secondary containments at least daily. The inspection consists of a visual
36 observation (i.e., using CCTV and instrument readings) of the sumps, trenches,
37 secondary containment, and readings of the level indicators in the sumps –
38 40 CFR 264.195(b).
- 39 f. The tank systems within the Category A and Category B areas in the MDB are
40 inspected weekly – 40 CFR 264.195(c) and (d).
- 41 g. The BGCAPP does not provide external cathodic protection for the hazardous waste
42 tanks; therefore, inspections of this item are not required.

43 The BGCAPP complies with the requirements of 40 CFR 264.196 if a leak or spill occurs in the
44 tank system.

**24915-000-GPE-GGPT-00001 – RESEARCH, DEVELOPMENT, AND DEMONSTRATION (RD&D) PERMIT
APPLICATION CDRL #A010**

3.5 Monitoring Methods, Regulatory Determinations and Sampling and Analytical Procedures

3.5.1 Headspace Monitoring for >1 Vapor Screening Level (VSL) Waste

Headspace monitoring is used to meet U.S. Army requirements for characterizing agent-derived, secondary wastes to determine whether the wastes can be transported off-site in accordance with U.S. Army policy and regulations. The process used to characterize and/or monitor, and transport secondary wastes off-site for commercial treatment or disposal is described in the following paragraphs. Included is a discussion of relevant U.S. Army guidance and the Bounding Transportation Risk Assessment (BTRA).

3.5.1.1 Definitions of Airborne Exposure Limits (AELs)

AELs are unique military standards for exposure of unprotected workers and the general population to chemical agents. These airborne, time weighted average (TWA) standards are based upon recommendations of the Centers for Disease Control and Prevention (CDC) promulgated in the Federal Register^{1,2} and incorporated into U.S. Army regulations³. The AELs are the allowable, average concentrations in air for workplace and general population exposures. AELs include worker population limits (WPLs), short-term exposure limits (STELs), and general population limits (GPLs). Basis of AELs is exposure to a concentration for a set duration (time). The TWA is the average concentration of a chemical agent for a specified duration or length of time. Specific definitions for the AELs are as follows:

- 1) WPL is an 8 hour TWA. Exposure below the WPL is safe and not expected to produce any adverse health effect. This is the TWA airborne concentration for exposure of unmasked worker for an 8 hour workday, 40 hour week, for 30 years without adverse effect.
- 2) STEL is the maximum concentration for exposure of unprotected chemical workers for up to 15 minutes continuously. The number of exposures allowed for a worker at the STEL is dependent on the chemical agent. For GB exposure, the STEL should not exceed 15 minutes and should not occur more than 4 times per day with each successive exposure separated by at least 60 minutes.
- 3) GPL is a 24-hour TWA for nerve agents (GB). Basis for the GPL is exposure for 7 days per week for a 70-year lifetime.

Table 3-3 provides the AEL values for the chemical agent (GB) stored and processed at the BGCAPP under this RD&D permit.

3.5.1.2 VSL and Agent Contamination in Secondary Wastes

U.S. Army policy, regulations, and procedures require evaluation of the waste for the presence and degree of agent contamination prior to transport of non-liquid secondary wastes from the BGCAPP site^{3,4,5}. The evaluation or assessment process for chemical agent in wastes involves monitoring the agent concentration in the air above the contained waste (i.e., headspace) or use of generator knowledge. VSL determinations are the result of monitoring the headspace above an item contained in an enclosed space (i.e., limiting the incoming air – preventing significant dilution). The BGCAPP monitors and reports the results of headspace monitoring in terms of VSLs. The VSL value depends on the chemical agent being headspace monitored. The VSL concentration for GB is 1×10^{-4} mg/m³.

**24915-000-GPE-GGPT-00001 – RESEARCH, DEVELOPMENT, AND DEMONSTRATION (RD&D) PERMIT
APPLICATION CDRL #A010**

1 VSL concentrations determined from headspace monitoring are reported in multiples of the VSL
2 (e.g., 5 VSL, 150 VSL) or simply less than or greater than or equal to one VSL (<1 or ≥1 VSL).
3 The VSL measurements from waste characterization monitoring can then be used to assess
4 (i.e., using risk assessment techniques) whether a waste should be released (i.e., based on the
5 amount of risk) for off-site shipment to an appropriately permitted, commercial TSD or must be
6 decontaminated and re-monitored.

7 The BGCAPP may use generator knowledge (perhaps supported by previous headspace
8 monitoring of waste samples or wastes from the same type activity) to characterize secondary
9 waste (e.g., PPE, pumps, absorbent) for the presence of agent ≥1 VSL secondary waste streams
10 but must apply consistent segregation practices to separate wastes or waste streams based on
11 potential hazard. The BGCAPP maintains records to document and support generator knowledge.
12 Documentation used to support generator knowledge can include:

- 13 1) Logbook entries
- 14 2) Known absence of liquid agent
- 15 3) Suspected or known agent contamination of waste(s)
- 16 4) Systems worked on
- 17 5) Type of waste material(s) (e.g., PPE, metals parts, rags) and decontamination or
18 disassembly accomplished
- 19 6) Airborne agent monitoring results (e.g., for airlocks, life support systems, room agent)
20 associated with activity generating the waste(s)

21 Headspace monitoring can initially establish a waste characterization that, if verified by subsequent
22 repeated headspace monitoring, may serve as a basis for generator knowledge. For example,
23 maintenance activities (i.e., on non-agent systems) generating metals parts and PPE from areas
24 without liquid agent present could be, based on previous monitoring data, established as having a
25 range (e.g., ≥1 to <32 VSL). Therefore, generator knowledge without requiring headspace
26 monitoring of each waste container may be used as a basis for waste shipment.

27 **3.5.1.3 Headspace Monitoring Methods**

28 MINICAMS® and Depot Area Air Monitoring System (DAAMS) are the two air monitoring methods
29 used for VSL headspace monitoring at the BGCAPP.

30 The MINICAMS® is an automatic air monitoring system that collects compounds on a solid sorbent
31 trap, thermally desorbs compounds from the trap into a capillary gas chromatography column for
32 separation, and detects the compounds with a flame-photometric detector. The MINICAMS® is a
33 lightweight portable, near real time, low level monitor for chemical agent with alarm capability.

34 The DAAMS is a portable air sampling unit designed to draw a controlled volume of air through a
35 glass tube filled with collection material (e.g., Tenax™ GC). As the air passes through the solid
36 sorbent tube, agent is collected. After sampling is complete, the monitoring technician removes
37 the tube from the sample line and sends it to the onsite laboratory for analysis. The airborne agent
38 concentration calculation uses the known sampling volume collected during air sampling.

39 **3.5.1.4 Requirements for Headspace Monitoring**

40 U.S. Army policy and regulation, headspace air monitoring (i.e., for waste characterization), and
41 off-site transport requirements include⁶:

- 42 1) Monitoring after a minimum hold time
- 43 2) Attaining and maintaining a minimum temperature throughout the hold time

**24915-000-GPE-GGPT-00001 – RESEARCH, DEVELOPMENT, AND DEMONSTRATION (RD&D) PERMIT
APPLICATION CDRL #A010**

- 1 3) Determining the minimum air volume for monitoring (based upon the air monitoring
- 2 method/procedure used)
- 3 4) Prior to monitoring, verifying wastes have no occluded spaces (i.e., dismantle,
- 4 decontaminate, flush, rinse, and drain items with cavities)
- 5 5) Verifying composition of the material being monitored does not interfere with the
- 6 headspace monitoring (e.g., carbon)
- 7 6) Eliminating free liquids (i.e., bagged waste must have an absorbent pad placed inside the
- 8 bag and bagged waste must be double-bagged)
- 9 7) Minimizing dilution air during monitoring (i.e., monitoring of bagged wastes is performed by
- 10 making a small hole in the bag only large enough to insert the sampling wand)
- 11 8) Conducting representative monitoring of wastes (i.e., bags in drums must be individually
- 12 monitored or, if monitored inside the drum, the bags are open to allow air circulation)
- 13 9) Placing absorbent pads in the bottom of each drum
- 14 10) Verifying sufficient volume is present for monitoring (i.e., item monitored is bagged or
- 15 contained within space with sufficient volume to permit sample air to be withdrawn)

16 **NOTE:** Minimum hold time and temperature for headspace monitoring established based upon
17 data collected by the BGCAPP.

18 **NOTE:** Personnel trained and certified to operate and maintain the sampling devices perform
19 headspace monitoring. Air monitoring equipment calibrated and calibration methods
20 approved before use. The BGCAPP Laboratory Quality Assurance Manual contains the
21 specific requirements for training/certification of monitoring personnel and calibration of the
22 air monitoring equipment.

23 **3.5.1.5 Secondary Wastes**

24 Secondary wastes are not process wastes but are instead agent-derived wastes (e.g., due to
25 contact with liquid agent or agent-contaminated liquids or aerosols) that are generated during
26 maintenance, operations, and closure activities. The National Research Council (NRC), in “Review
27 of Chemical Agent Secondary Waste Disposal and Regulatory Requirements” (2007),
28 recommended to the CMA that offsite shipment and disposal of ≥ 1 STEL (equivalent to 1 VSL)
29 secondary wastes be pursued⁵. The CMA has implemented a secondary waste management
30 policy based on this NRC recommendation. Based upon the CMA policy, secondary wastes can
31 be treated and disposed off-site at an appropriately permitted, commercial TSDF; thereby allowing
32 100 percent devotion of the BGCAPP operations to destruction of the chemical weapon stockpile⁴.

33 **3.5.1.6 Bounding Transportation Risk Assessment (BTRA)**

34 The U.S. Army Chemical Materials Activity, “Bounding Transportation Risk Assessment for >1 VSL
35 Waste” (BTRA), September 2008⁶, defines the conditions under which ≥ 1 VSL agent-contaminated
36 secondary waste can be shipped to an appropriately permitted, commercial TSDF (i.e., incinerator)
37 with various levels of risk (i.e., negligible and marginal). The BTRA was prepared to identify and
38 assess the potential risks to members of the public due to accidents during transport of hazardous
39 waste. The levels of risk in the BTRA are based upon:

- 40 1) Average headspace readings in a truckload of 55-gallon or 95-gallon containers
- 41 2) Number of shipments to be made
- 42 3) Distance to an appropriately permitted, commercial TSDF

**24915-000-GPE-GGPT-00001 – RESEARCH, DEVELOPMENT, AND DEMONSTRATION (RD&D) PERMIT
APPLICATION CDRL #A010**

- 1 4) The BTRA includes secondary wastes contaminated with the chemical agents treated at
2 the BGCAPP.

3 The objective of the BTRA was to provide a framework for assessing and controlling risks to TSDF
4 workers and the public arising from ≥ 1 VSL waste shipments. The BTRA applies to secondary
5 wastes or closure wastes leaving a chemical demilitarization facility and creates continuity and
6 consistency in the risk criteria applied to secondary waste shipments. The bounding conditions
7 determine the level of public risk based on:

- 8 1) Agent concentrations and/or agent quantity per drum
9 2) Distance and number of shipments during the shipment operation

10 An “Information Package” is prepared prior to U.S. Army approval of offsite shipment of secondary
11 waste [e.g., waste profile, monitoring plans and standing operating procedures (SOPs), waste
12 segregation and packaging SOPs, transportation plans, health and safety approach].

13 **3.5.1.7 Off-site Shipments**

14 Off-site shipments of secondary wastes must comply with DOT regulations found in
15 49 CFR 100-185. The demilitarization facility is required to⁶:

- 16 1) Package, in 55-gallon or 95-gallon polyethylene drums, secondary wastes with headspace
17 monitoring results ≥ 1 VSL. Use polyethylene drums as waste containers for direct feed
18 into an appropriately permitted, commercial TSDF incinerator. Direct waste feed prevents
19 additional TSDF worker exposure
20 2) Allow a maximum of eighty 55-gallon or fifty-one 95-gallon drums per vehicle (as defined in
21 the BTRA)⁷
22 3) Palletize and shrink wrap waste drums and place the palletized drums into the cargo area
23 without stacking the pallets
24 4) Ensure the cargo areas for shipments are climate controlled (i.e., $<70^{\circ}\text{F}$)

25 Additional shipping requirements are included in the BTRA⁶. Table 3-4 summarizes the bounding
26 conditions for secondary wastes shipments for each of the three chemical agents treated at the
27 BGCAPP. The BTRA indicates that relatively high agent concentrations in individual drums result
28 in negligible risks; however, the CMA accepted and implemented a CDC recommendation not to
29 exceed a ceiling headspace monitoring value for any waste container within a waste shipment.
30 The ceiling concentration for GB as 500 VSL⁶.

**24915-000-GPE-GGPT-00001 – RESEARCH, DEVELOPMENT, AND DEMONSTRATION (RD&D) PERMIT
APPLICATION CDRL #A010**

References

- 1) 53 Federal Register (FR) 8504 (15 March 1988) (corrected in 53 FR 11002, 4 April 1988), Final Recommendations for Protecting Human Health and Safety Against Potential Adverse Effects of Long-term Exposure to Low Doses of Agents: GA, GB, VX, Mustard Agent (H, HD, and HT), and Lewisite (L).
- 2) 68 FR 54460 (17 September 2003)(corrected in 68 FR 58348, 9 October 2003), Final Recommendations for Protecting Human Health from Potential Adverse Effects of Exposure to Agents GA (Tabun), GB (Sarin), and VX.
- 3) Department of Army Pamphlet 385-61, Toxic Chemical Agent Safety Standards, 17 December 2008.
- 4) CMA Memorandum, Requirements for Implementation of the U.S. Army Chemical Agency (CMA) Bounding Transportation Risk Analysis (TRA) for Shipment of Greater Than 1 Vapor Screening Level (VSL) Chemical Agent Contaminated Secondary Waste, 15 September 2008.
- 5) National Research Council (NRC), Review of Chemical Agent Secondary Waste Disposal and Regulatory Requirements, National Academy Press, 2007.
- 6) Chemical Materials Agency (CMA), Final Bounding Transportation Risk Assessment for >1 Vapor Screening Level (VSL) Waste, September 2008.

Table 3-3 – AELs for GB

Chemical Agent	WPL (mg/m³)	STEL (mg/m³)	GPL (mg/m³)
GB	3×10^{-5}	1×10^{-4}	1×10^{-6}

NOTES:

- 1) 53 Federal Register (FR) 8504 (15 March 1988) (corrected in 53 FR 11002, 4 April 1988), Final Recommendations for Protecting Human Health and Safety Against Potential Adverse Effects of Long-term Exposure to Low Doses of Agents: GA, GB, VX, Mustard Agent (H, HD, and HT), and Lewisite (L).
- 2) 68 FR 54460 (17 September 2003)(corrected in 68 FR 58348, 9 October 2003), Final Recommendations for Protecting Human Health from Potential Adverse Effects of Exposure to Agents GA (Tabun), GB (Sarin), and VX.

**24915-000-GPE-GGPT-00001 – RESEARCH, DEVELOPMENT, AND DEMONSTRATION (RD&D) PERMIT
APPLICATION CDRL #A010**

Table 3-4 – Summary of Bounding Conditions for GB

Shipment of GB Secondary Wastes						
Shipping Distance (miles)	Hazard Severity	55-gallon Drum Shipments		95-gallon Drum Shipments		Risk Level
		Headspace Concentration (VSL)	Number of Shipments	Headspace Concentration (VSL)	Number of Shipments	
3,000	Negligible	<250	894	<390	894	Low
	Marginal	250 to 3,100	8	390 to 4,900	8	Low
2,000	Negligible	<250	1,341	<390	1,341	Low
	Marginal	250 to 3,100	13	390 to 4,900	13	Low
1,000	Negligible	<250	2,683	<390	2,683	Low
	Marginal	250 to 3,100	26	390 to 4,900	26	Low
500	Negligible	<250	5,366	<390	5,366	Low
	Marginal	250 to 3,100	53	390 to 4,900	53	Low

As recommended by the CDC and implemented by the U.S. Army, waste containers with the following VSL reading or greater are not shipped offsite without further decontamination: 500 VSL for GB. Based on CMA Memorandum, Requirements for Implementation of the U.S. Army Chemical Agency (CMA) Bounding Transportation Risk Analysis (TRA) for Shipment of Greater Than 1 Vapor Screening Level (VSL) Chemical Agent Contaminated Secondary Waste, 15 September 2008.

3.5.2 99.9999 percent DE Calculation Method

DE will be calculated according to the equation described in BGCAPP permit KY8-213-820-105, Condition T-9.

3.5.3 Sampling & Analytical Procedures

3.5.3.1 Sampling Methods

The BGCAPP collects non-routine samples for analysis if waste characterization using process knowledge is not possible. For liquid wastes, U.S. EPA-approved sampling methods are used and sampling activities conform to SW-846 requirements.

3.5.3.1.1 Frequency of Analysis

Analysis, testing, and monitoring of each waste stream occurs for the initial batch or batches of each agent destroyed at the BGCAPP. Analyses, tests, and monitoring of these waste streams are performed at least annually (to ensure the waste analyses and testing is accurate and up-to-date) and analyses are repeated as often as necessary to ensure the characterization of each waste stream is accurate and up-to-date. This means that an analysis of a waste is necessary if any of the following circumstances occur:

- a. The BGCAPP becomes aware of a change in the process that produces the waste
- b. The BGCAPP becomes aware that a waste was inadvertently mixed with another waste
- c. The BGCAPP determines through analysis a waste no longer matches the expected characteristics
- d. A change occurred to the hazardous waste regulations that apply to that waste

**24915-000-GPE-GGPT-00001 – RESEARCH, DEVELOPMENT, AND DEMONSTRATION (RD&D) PERMIT
APPLICATION CDRL #A010**

3.5.3.1.2 Process Knowledge

BGCAPP personnel use process (generator) knowledge (perhaps in conjunction with air monitoring) to determine whether solid wastes such as PPE, components/parts, glassware, and disposable items may be contaminated with chemical agent. The BGCAPP also uses generator knowledge to characterize non-agent wastes. These items may also be placed into an enclosed volume of air (e.g., within a plastic bag) where the headspace above these items is air monitored until the appropriate U.S. Army decontamination level is attained which could require additional decontamination.

3.5.3.1.3 Analytical and Air Monitoring Methods

For each waste stream listed in Table 3-5, Table 3-6 shows appropriate sampling equipment and methods for sampling and analysis of wastes based on the waste stream media. Table 3-7 provides the specific analytical, testing, and monitoring methods, and techniques used to make waste determinations with the rationale and the basis for selecting the method(s) for each waste stream. The headspace air monitoring approach for agent-derived waste characterization is described in paragraph 3.5.1.

Table 3-5 – BGCAPP Wastes, Designations and Characterizations

Waste Material	EPA/KY Waste Number	RCRA Hazardous Waste Regulatory Citations (401 KAR; 40 CFR)	Basis for Designation
Munition Remnants Residues, Particulates and Ash from MPT	Toxicity (D004, D005, D006, D007, D008, D009, D010, and/or D011)	31:030, Section 5; and 261.24	Wastes may contain increased concentrations of RCRA regulated metals due to concentrating effect of processes. Laboratory analyses performed initially to characterize these wastes.
	N001	31:010; 261.3(a)(2)(iv); and 261.3(c)(2)(i); and 31:040 Section 7, Nerve Agent	Waste is agent-derived and therefore carries the waste number for the agent.
APS/AFS Precipitate (filter cake)	Toxicity (D004, D005, D006, D007, D008, D009, D010, and/or D011)	31:030, Section 5; and 261.24	Wastes may contain increased concentrations of RCRA regulated metals due to concentrating effect of processes. Laboratory analyses performed initially to characterize these wastes.
	N001	31:010; 261.3(a)(2)(iv); and 261.3(c)(2)(i); and 31:040 Section 7, Nerve Agent	Waste is agent-derived and therefore carries the waste number for the agent.

**24915-000-GPE-GGPT-00001 – RESEARCH, DEVELOPMENT, AND DEMONSTRATION (RD&D) PERMIT
APPLICATION CDRL #A010**

Waste Material	EPA/KY Waste Number	RCRA Hazardous Waste Regulatory Citations (401 KAR; 40 CFR)	Basis for Designation
Reject Waste Stream from RO Unit	Toxicity (D004, D005, D006, D007, D008, D009, D010, and/or D011)	31:030, Section 5; and 261.24	Wastes may contain increased concentrations of RCRA regulated metals due to concentrating effect of RO processes. Laboratory analyses performed initially to characterize these wastes.
	N001	31:010; 261.3(a)(2)(iv); and 261.3(c)(2)(i); and 31:040 Section 7, Nerve and Blister Agents	Waste is agent-derived and therefore carries the waste numbers for the agent.
Contaminated Dunnage	Toxicity (D024 and/or D037)	31:030, Section 5; and 261.24	Preservatives for dunnage may contain contaminants above regulatory levels.
	N001	31:010; 261.3(a)(2)(iv); and 261.3(c)(2)(i); and 31:040 Section 7, Nerve and Blister Agents	Identify agent-contaminated dunnage using generator knowledge and headspace air monitoring.
Munitions Dunnage (non-contaminated)	Toxicity (D024 and/or D037)	31:030, Section 5; and 261.24	Preservatives for dunnage may contain contaminants above regulatory levels.
Non contaminated Rocket Motors	Ignitability (D001)	31:030, Section 2; and 261.21	Rocket propellant is ignitable, reactive, and may contain lead.
	Reactivity (D003)	31:030, Section 4; and 261.23	
	Toxicity (D008)	31:030, Section 5; and 261.24	
Agent Contaminated / Derived KY Hazardous Waste (PPE, Agent Contaminated or Derived KY Wastes: Carbon and HEPA/Pre-filters, Trash, Rags, and Components/Parts from Operations and Maintenance Activities)	N001	31:010; 261.3(a)(2)(iv); and 261.3(c)(2)(i); and 31:040 Section 9, Nerve and Blister Agents	Waste from these activities mixed with or derived from Kentucky listed wastes N001.
Laboratory Wastes	Ignitability (D001)	31:030, Section 2; and 261.21	Laboratory wastes generated from onsite chemical analysis may exhibit these characteristics and/or
	Corrosivity (D002)	31:030, Section 3; and 261.22	

**24915-000-GPE-GGPT-00001 – RESEARCH, DEVELOPMENT, AND DEMONSTRATION (RD&D) PERMIT
APPLICATION CDRL #A010**

Waste Material	EPA/KY Waste Number	RCRA Hazardous Waste Regulatory Citations (401 KAR; 40 CFR)	Basis for Designation
	Reactivity (D003)	31:030, Section 4; and 261.23	toxicity. Changes in reagents or procedures can change the Laboratory wastes.
	Toxicity (D004, D005, D006, D007, D008, D009, D010, D011, D022, D024, D027, D028, D029, and/or D037)	31:030, Section 5; and 261.24	
	Listed Processes (F001–F005)	31:040, Section 2; and 261.31	Spent solvents from the Laboratory may be listed hazardous wastes—depending on the solvents used.
	N001	31:010; 261.3(a)(2)(iv); and 261.3(c)(2)(i); and 31:040 Section 7, Nerve and Blister Agents	These wastes also may be mixed with/derived from Kentucky listed wastes N001
Maintenance and Miscellaneous Wastes: (Oils, Hydraulic Fluids, Paints, and Spent Solvents)	Ignitability (D001)	31:030, Section 2; and 261.21	Wastes generated may exhibit the characteristics of ignitability, corrosivity, reactivity, or toxicity due to chemical composition of materials used.
	Corrosivity (D002)	31:030, Section 3; and 261.22	
	Reactivity (D003)	31:030, Section 4; and 261.23	
	Toxicity (D004, D005, D006, D007, D008, D009, D010, and/or D011)	31:030, Section 5; and 261.24	
	Listed Processes (F001–F005)	31:040, Section 2; and 261.31	
	Possibly N001	31:010; 261.3(a)(2)(iv); and 261.3(c)(2)(i); and 31:040 Section 9, Nerve and Blister Agents	Waste from these activities may be mixed agent-derived wastes and become Kentucky listed wastes N001.

**24915-000-GPE-GGPT-00001 – RESEARCH, DEVELOPMENT, AND DEMONSTRATION (RD&D) PERMIT
APPLICATION CDRL #A010**

Table 3-6 – Typical Sampling Methods and Equipment

Waste Type	Sampling Method ^{1,2}	Equipment ¹
Extremely viscous liquid	ASTM standard D140/D140-09	Tubing or trier
Crushed or powdered material	ASTM standard D346-04(2010)	Tubing, trier, auger, scoop, or shovel
Soil or rock-like material	ASTM standard D420-98(2003)	Tubing, trier, auger, scoop, or shovel
Soil-like material	ASTM standard D1452-09	Tubing, trier, auger, scoop, or shovel
	ASTM standard D5633-04(2008)	
	ASTM standard D5451-93(2008)	
Fly ash-like material	ASTM standard C311-07	Tubing, trier, auger, scoop, or shovel
Containerized liquid waste	SW-846	Coli-wasa or tubing
Liquid waste in tanks	Tap	Sample bottle

1. The methods and equipment used at the BGCAPP may differ from those on this table as outlined by the BGCAPP Laboratory Monitoring and Analytical plans or individual laboratory operating procedures
2. American Society for Testing and Materials, annual book of ASTM standards, Volumes 04-03, 04-08, 05-05, Philadelphia, PA

**24915-000-GPE-GGPT-00001 – RESEARCH, DEVELOPMENT, AND DEMONSTRATION (RD&D) PERMIT
APPLICATION CDRL #A010**

1
2
3

Table 3-7 – Analytical Test Methods and Rationale

Waste Stream	Waste Parameter(s) and Analytical/Test Method	Media Type	Rationale
Energetics/Chemical Agent Hydrolysate and Spent Decontamination Solution ¹	Chemical agent to 99.9999 percent DE as determined by site-specific method developed for chemical agent hydrolysate	Liquid	Waste characterization obtained at beginning of GB destruction campaign.
	Ignitability tested using Pensky Martin Closed-Cup Method 1010A, SW-846		Ignitability tested in initial batches of each agent campaign.
	Corrosive nature of wastes verified by pH Method 9040C, SW-846		Nature of waste virtually assures pH of waste >12.5 units.
	Toxic Characteristic Leaching Procedure (TCLP)-Method 1311, SW-846; and Eight (8) RCRA Toxic Metals by Method 6010C		RCRA metals tested in initial batches of each agent campaign.
MPT Residue, Particulates, and Ash ¹	TCLP - Method 1311, SW-846; and Eight (8) RCRA Toxic Metals by Method 6010C	Solid	Characterization of RCRA metals in these solid residues is required to ensure appropriate waste management and off-site treatment/disposal.
APS/AFS Filter Cake ¹	TCLP - Method 1311, SW-846; and Eight (8) RCRA Toxic Metals by Method 6010C	Sludge/Filter Cake	Characterization of RCRA metals in this sludge is required to ensure appropriate waste management and off-site treatment/disposal.
RO Reject Waste Stream/Brine ¹	TCLP - Method 1311, SW-846; and Eight (8) RCRA Toxic Metals by Method 6010C	Liquid/Sludge	Characterization of RCRA metals in this liquid is initially required to ensure appropriate waste management and off-site treatment/disposal. However, generator knowledge is expected to be sufficient after initial waste determinations.

**24915-000-GPE-GGPT-00001 – RESEARCH, DEVELOPMENT, AND DEMONSTRATION (RD&D) PERMIT
APPLICATION CDRL #A010**

Waste Stream	Waste Parameter(s) and Analytical/Test Method	Media Type	Rationale
Agent Contaminated Dunnage	Derived from/mixed with Kentucky N001. These wastes are screened using headspace air monitoring of waste in compliance with site procedures using near real time monitoring instrument - MINICAMS® or DAAMS. Department of Army (DA) decontamination level (identified through headspace monitoring) is used to manage these wastes.	Solid	Concern with possible presence of agent is due to leaking munitions. Headspace screening can be used to assess this concern and safely manage this waste.
	TCLP - Method 1311, SW-846; with m-Creol and Pentachlorophenol by SW-846 Method 8041A following preparation using Technique 3510 or 3580		Characterization of RCRA (Toxicity) constituents (D024 and D037) in these solids is required to ensure appropriate waste management and off-site treatment/disposal.
Munitions Dunnage (not chemical agent contaminated)	TCLP - Method 1311, SW-846; with m-Creol and Pentachlorophenol by SW-846 Method 8041A following preparation using Technique 3510 or 3580.	Solid	Presence of these contaminants suspected due to use as preservative for the dunnage.
Non contaminated Rocket Motors ^{2, 3}	TCLP - Method 1311, SW-846; and Lead by Method 6010C.	Solid	Propellant may contain lead.
PPE, Spent Activated Carbon HEPA Filters and Pre-filters, Trash, Rags and Components/Parts from Operations and Maintenance activities ³	May be mixed with/derived from Kentucky listed waste (N001). Generator knowledge and headspace monitoring are used to assess the presence of agent.	Solid	May be mixed with/derived from Kentucky listed waste. Current DA secondary waste requirements necessitate headspace monitoring (to determine whether agent is present) and compliance with BTRA prior to shipment off-site to an appropriately permitted, commercial TSDF.

**24915-000-GPE-GGPT-00001 – RESEARCH, DEVELOPMENT, AND DEMONSTRATION (RD&D) PERMIT
APPLICATION CDRL #A010**

Waste Stream	Waste Parameter(s) and Analytical/Test Method	Media Type	Rationale
Laboratory Wastes and Spent Solvents ³	Ignitability (D001) tested using Pensky-Martin Closed-Cup - Method 1010A, SW-846.	Liquid	Ignitable determination may be needed for some waste mixtures or generator knowledge may be sufficient without analysis.
	Corrosivity (D002) tested using pH electrometric measurement - Method 9040C, SW-846.		Corrosive nature of hydrolysate samples may result in some laboratory wastes having pH >12 units.
	Toxicity Characteristic (D004, D009, D011, and D022 and other volatile solvents listed under Toxicity Characteristic) - analyzed by TCLP - Method 1311, SW-846; Eight (8) RCRA Toxic Metals - Methods 3010A and 6020A, SW-846; and Volatiles by Methods 5030B and 8260B, SW-846.		Characterization of RCRA metals and volatiles in these wastes needed to ensure appropriate waste management and off-site treatment and/or disposal. However, generator knowledge is expected to be sufficient after initial waste determinations.
	Volatiles (F001-F005) by Methods 5030B and 8260B, SW-846		Spent solvents are analyzed when generator knowledge is not sufficient to determine hazard identification. These wastes, after analysis, could be added to the Laboratory waste containers.
Oils, Hydraulic Fluids, Paints, and Spent Solvents ³	Ignitability (D001) tested using Pensky-Martin Closed-Cup - Method 1010A, SW-846.	Liquid	Ignitable determination may be needed for some waste mixtures or generator knowledge may be sufficient without analysis.
	TCLP - Method 1311, SW-846; and Eight (8) RCRA Toxic Metals by Method 6010C.		RCRA metals contamination of these liquids is expected and analysis of individual products - especially paints - is necessary.
	Volatiles (F001-F005) by Methods 5030B and 8260B, SW-846		Spent solvents from operations and maintenance tasks are characterized for treatment/disposal using generator knowledge and analysis when generator knowledge is not sufficient.

1. Waste is agent-derived based on generator knowledge.
 2. Waste is reactive and ignitable based on generator knowledge.
 3. Generator knowledge used to determine whether waste is agent-derived.

**24915-000-GPE-GGPT-00001 – RESEARCH, DEVELOPMENT, AND DEMONSTRATION (RD&D) PERMIT
APPLICATION CDRL #A010**

3.6 Equipment Inspection Procedures and Frequency

3.6.1 Equipment Maintenance and Inspection Schedule

3.6.1.1 Equipment Requirements

3.6.1.1.1 Internal Communications

The BGCAPP maintains an internal communications system consisting of hard-wired telephones, two-way hand held radios, cellular phones, a public address system, and audible signals. This system provides a combination of voice and signal information throughout the facility to employees and BGAD Security.

3.6.1.1.2 External Communications

The BGCAPP maintains an external communications system consisting of hard-wired telephones; two-way hand held radios, and cellular phones. This system provides redundant communication channels to summon security, and emergency response from the BGCA operations center (OC). Additional emergency response resources are coordinated through the BGCA OC as needed.

3.6.1.1.3 Emergency Equipment

The BGCAPP maintains portable fire extinguishers as required by the National Fire Protection Association (NFPA) in all buildings, access gates, motorized material handling equipment, and storage areas. Critical chemical demilitarization areas (i.e., much of the MDB) are equipped with deluge fire suppression. Additionally, the BGCAPP buildings have fire suppression sprinkler systems and the site has exterior fire hydrants located to provide fire water to fire response personnel. Table 6-1 lists typical BGCAPP Emergency Response Equipment.

In chemical agent handling areas, the BGCAPP provides pre-positioned decontamination equipment for emergency and routine decontamination wash downs. Engineering controls are designed to contain the spent decontamination material or other agent-derived liquid wastes for collection and processing in the ANS.

3.6.1.1.4 Water for Fire Control

The BGCAPP maintains two 250,000 gallon fire water tanks with pumps that provide fire suppression water to building sprinkler systems and specific chemical agent processing areas. Each of the tanks is designed to maintain a 25,000-gallon reserve, equaling a total reserve of 50,000 gallons. The fire water pumps operate at 2,500 gallons per minute (gpm) with a rated pressure of 100 psi. Critical chemical agent handling areas also have deluge fire suppression that delivers 2 gpm/ft². Additionally, this system uses a valve system to allow direct access to the BGAD water system for additional fire water, if needed.

The site also employs a separate fire hydrant system supplied by the BGAD water system throughout the plant area. These hydrants are outside the BGCAPP buildings and readily accessible by responding fire personnel.

3.6.1.1.5 General Inspection Requirements

The scheduled inspections of the BGCAPP waste storage and treatment tanks, Subpart X systems, and the container storage areas include containers/tanks/Subpart X systems, containment, safety, emergency, and operating equipment needed to prevent, detect, or respond to environmental or human health hazards. The BGCAPP Project Document Control Center (PDCC) maintains the completed inspections and other related documents.

**24915-000-GPE-GGPT-00001 – RESEARCH, DEVELOPMENT, AND DEMONSTRATION (RD&D) PERMIT
APPLICATION CDRL #A010**

1 **3.6.1.1.6** *Types of Problems*

2 Figure 3-5, Figure 3-6, and Figure 3-7 identify the criteria used during container storage, tank
3 system, Subpart X, and liquid loading and unloading station inspections.

4 **3.6.1.1.7** *Frequency of Inspection*

5 The “Inspection Frequency” columns in Figure 3-5, Figure 3-6, and Figure 3-7 provide the
6 frequency of inspection for containers, tank systems, Subpart X units, and liquid loading stations.
7 Basis for selection of these frequencies was the rate of possible deterioration of equipment and the
8 probability of an environmental or human health incident if the deterioration, malfunction, or
9 operator error goes undetected between inspections. The BGCAPP performs daily inspections of
10 areas subject to spills, such as loading and unloading areas, when in use.

11 **3.6.1.2** **Specific Process Inspection Requirements**

12 **3.6.1.2.1** *Container Inspections*

13 The BGCAPP conducts weekly inspections of containers in storage areas for deterioration,
14 corrosion, spills, and evidence of leakage. In addition, containers are inspected initially and weekly
15 thereafter for tightness of closure devices in compliance with 40 CFR 264 Subpart CC. These
16 weekly inspections include a visual inspection for obstructions and proper maintenance of aisle
17 space between the rows of palletized containers. Figure 3-5 shows a typical inspection checklist
18 for container inspection activities.

19 **3.6.1.2.2** *Tank System Inspections*

20 The BGCAPP conducts daily inspections of waste tank and Subpart X systems. The inspections
21 address:

- 22 • Overfill and spill control equipment
- 23 • Aboveground portions of the tank and Subpart X systems
- 24 • Data gathered from monitoring and leak detection equipment
- 25 • Construction materials
- 26 • The area immediately surrounding the externally accessible portion of the tank and Subpart X
27 systems as well as the secondary containment system.

28 Figure 3-6 shows a typical inspection checklist for the tank system and Subpart X inspection
29 activities.

30 Figure 3-7 provides the typical inspection checklist for liquid loading/unloading areas, when in use.

31 **3.6.1.2.3** *Waste Pile Inspections*

32 Not applicable. The BGCAPP does not have any waste piles.

33 **3.6.1.2.4** *Surface Impoundment Inspections*

34 Not applicable. The BGCAPP does not have any surface impoundments.

35 **3.6.1.2.5** *Incinerator Inspections*

36 Not applicable. The BGCAPP does not have any incinerators.

37 **3.6.1.2.6** *Landfill Inspections*

38 Not applicable. The BGCAPP does not have any landfills.

**24915-000-GPE-GGPT-00001 – RESEARCH, DEVELOPMENT, AND DEMONSTRATION (RD&D) PERMIT
APPLICATION CDRL #A010**

1 **3.6.1.2.7** *Land Treatment Inspections*

2 Not applicable. The BGCAPP does not have any land treatment units.

3 **3.6.1.2.8** *Remedial Action*

4 The BGCAPP facility/area currently has no SWMUs or corrective actions identified. Figure 3-8
5 presents a typical log the BGCAPP maintains, showing the remedial actions required if deficiencies
6 are identified during routine inspections. Section 6 describes the BGCAPP emergency response
7 plans and section 7.0 describes the closure of the BGCAPP.

8 **3.6.1.2.9** *Inspection Log*

9 An inspection summary log tracks observations made during inspections. This form includes the
10 following:

- 11 1) Dates and times of inspections
- 12 2) Name(s) of inspector(s)
- 13 3) Observations made
- 14 4) Date and nature of repairs or remedial actions taken

15 Figure 3-8 contains a typical log.

16 **3.6.1.3 Waiver of Preparedness and Prevention Requirements**

17 Not applicable. A waiver of preparedness and prevention requirements is not requested or sought
18

24915-000-GPE-GGPT-00001 – RESEARCH, DEVELOPMENT, AND DEMONSTRATION (RD&D) PERMIT APPLICATION CDRL #A010

Figure 3-5 – Typical Weekly Inspection – Containers

BGCAPP Area(s)			Date	Time	Inspector(s)	
Hazardous Waste Container Storage						
Inspected (√)	Item	Regulatory Citation	Inspection Criteria	Corrective Action Required (Yes/No) (if Yes, describe)	Deficiency (Describe)	
	Inventory	262.34	Check container fill date (90 day or 365 day limit not exceeded).	EXAMPLE		
	Container Label	262.31	Label legible, each container labeled, and marked with words "Hazardous Waste".			
	Container Condition	264.171	Evidence or signs of corrosion, leaks, or other deterioration. A leaking container must be repaired or the contents transferred to a container in good condition.			
	Container Closed	264.173(a)	Bungs, plugs, caps, seals, or other closure devices are tightly closed.			
	Aisle Space	264.35	Sufficient space (min 30") to inspect containers and for access with emergency equipment.			
	Incompatible Wastes	264.171 264.176	Placed on a containment pallet and separated from other wastes by at least 4 feet.			
	Secondary Containment	264.175	Evidence or signs of cracks, gaps, mars, scuffs, or other deterioration.			
	Loading, Unloading, and Transfer Areas (inspect daily when in use)	264.15(b)(4)	Evidence or signs of leaks, spills, and integrity of the area.			
Security						
	Fences, Gates, and Locks	264.14	Evidence of gaps, holes, or damage to fence. Downed or damaged fence or gate posts. Erosion gaps and/or holes under the fence/gate. Vandalism, open or missing locks.			
	Perimeter Warning Signs	264.14	Presence of warning signs on fences and gates. Visible and legible.			
	Security of Process Areas	264.14	Doors locked to prevent unauthorized entry when buildings or processes are not in use.			
<u>ADDITIONAL COMMENTS:</u>						

Figure 3-6 – Typical Daily Inspection Tanks, Subpart X (Miscellaneous) Systems

BGCAPP Area(s):			Date:	Time:	Inspector(s):
Hazardous Waste Tanks and Subpart X Systems					
Inspected (√)	Item	Regulatory Citation	Inspection Criteria	Corrective Action Required (Yes/No) (if Yes, describe)	Deficiency (Description) Corrective Action Completed
	Overfill, Spill Prevention, and Waste Feed Cutoff Systems	262.194	Operating in accordance with design specifications and operating procedures.	EXAMPLE	
	Aboveground Portions of Tank System	264.193(f)(1) 264.194(c)(1)	Evidence of corrosion, leaks, or spills. Any leaks or spills must be reported immediately to the CCR.		
	Data from Monitoring Equipment (e.g., temperature, pressure, level gauges)	264.195(b)	Operating in accordance with design specifications and operating procedures.		
	Data from Leak Detection Equipment or Level Indicating Devices	264.195 ¹	Operating in accordance with design specifications and operating procedures, and calibration is current.		
	Ancillary Equipment (in area immediately surrounding the system, including secondary containment)	264.193(f) 264.194(c)(2)	Evidence or signs of corrosion, releases, leaks, or spills of hazardous waste. Any leaks or spills must be reported immediately to the CCR.		
	Ancillary Equipment Not in Secondary Containment	264.195	Evidence or signs of corrosion, releases, leaks, or spills of hazardous waste. Any leaks or spills must be reported immediately to the CCR.		
	Piping, Pumps, Flanges, and Connectors	Contingency Plan	Check for potential leaks ¹ .		

24915-000-GPE-GGPT-00001 – RESEARCH, DEVELOPMENT, AND DEMONSTRATION (RD&D) PERMIT APPLICATION CDRL #A010

	Loading, Unloading, Transfer, and Sample Connection Systems	Contingency Plan	Capped, plugged, or blind-flanged when not in use.		
	Incompatible Ignitable/Reactive	264.17 264.198 264.199	Incompatible waste separated from ignition sources. No ignitable or reactive waste stored in tank. No ignitable or incompatible wastes stored in the same tank system.		
	Air Emission Air Pollutant Emissions (tanks)	264.200 264.1084	Tank is not heated to a temperature greater than design temperature. Tank is open only for routine inspection, maintenance, or other normal operations.		
Loading/Unloading/Transfer Area					
	Vehicle	Contingency Plan	Wheel chocks available. Fire extinguisher present, current inspection date, and adequate pressure.		
	Secondary Containment	264.193	Evidence or signs of cracks, gaps, mars, scuffs, or other deterioration. Stormwater accumulation must be removed as soon as it is possible, but in any case within 24 hours.		
	Spill Cleanup and Decontamination Equipment and Supplies	Contingency Plan	Check for adequate inventory and condition of required decontamination/spill cleanup equipment and supplies.		
Security					
	Fences, Gates, and Locks	264.14	Evidence of gaps, holes, or damage to fence. Downed or damaged fence or gate posts. Erosion gaps and/or holes under the fence/gate. Vandalism, open or missing locks.		
	Perimeter Warning Signs	264.14	Presence of warning signs on fences and gates. Visible and legible.		
	Security of Process Areas	264.14	Doors locked to prevent unauthorized entry when buildings or processes are not in use.		
ADDITIONAL COMMENTS:					

24915-000-GPE-GGPT-00001 – RESEARCH, DEVELOPMENT, AND DEMONSTRATION (RD&D) PERMIT APPLICATION CDRL #A010

1

Notes:

1 Record equipment name, tag number, and date of discovery for leaking sources. Confirmatory monitoring is required within 5 calendar days. Use "Monthly Subpart BB Equipment Monitoring and Follow-up" checklist to document leak and repair confirmation monitoring. Place a weatherproof tab on the leaking equipment that is marked with equipment identification or tag number and the date evidence of leak was discovered.

Figure 3-7 – Typical Daily Inspection Liquid Loading Stations

BGCAPP Area(s):			Date:	Time:	Inspector(s):
Liquid Waste Loading Station					
Inspected (√)	Item	Regulatory Citation	Inspection Criteria	Corrective Action Required (Yes/No) (if Yes, describe)	Deficiency (Description) Corrective Action Completed
	Loading, Unloading, and Transfer Connections	Contingency Plan	Capped, plugged, or blind-flanged when not in use.	EXAMPLE	
	Associated Piping, Valves, Pumps, Flanges, and Connections	264.195(b)(1)	Operating in accordance with design specifications and operating procedures. Immediately report any leaks to CCR and tag the leaking equipment. ¹		
	Aboveground Portions of Liquid Waste Loading Dock System	264.195(b)(1)	Evidence or signs of releases, leaks, or spills. Immediately report any leaks, spills, or releases to the CCR and tag the leaking equipment. ¹		
Loading/Unloading/Transfer Area					
	Vehicle	Contingency Plan	Wheel chocks available. Fire extinguisher present, current inspection date and adequate pressure.		
	Containment	264.193	Evidence of corrosion, leaks, or spills. Any leaks or spills must be immediately reported to the CCR.		
	Secondary Containment	264.193	Evidence or signs of cracks, gaps, mars, scuffs, or other deterioration. Storm water accumulation must be removed as soon as it is possible, but in any case within 24 hours.		
	Spill Cleanup and Decontamination Equipment and Supplies	Contingency Plan	Check for adequate inventory and condition of required decontamination/spill cleanup equipment and supplies.		
Security					

24915-000-GPE-GGPT-00001 – RESEARCH, DEVELOPMENT, AND DEMONSTRATION (RD&D) PERMIT APPLICATION CDRL #A010

	Fences, Gates, and Locks	264.14	Evidence of gaps, holes, or damage to fence. Downed or damaged fence or gate posts. Erosion gaps and/or holes under the fence/gate. Vandalism, open or missing locks.		
	Perimeter Warning Signs	264.14	Presence of warning signs on fences and gates. Visible and legible.		
	Security of Process Areas	264.14	Doors locked to prevent unauthorized entry when buildings or processes are not in use		
ADDITIONAL COMMENTS:					

EXAMPLE

1

NOTE:
¹ Record equipment name, tag number, and date of discovery for leaking sources. Confirmatory monitoring is required within 5 calendar days. Use "Monthly Subpart BB Equipment Monitoring and Follow-up" checklist to document leak and repair confirmation monitoring. Place a weatherproof tab on the leaking equipment that is marked with equipment identification or tag number and the date evidence of leak was discovered.

2

**24915-000-GPE-GGPT-00001 – RESEARCH, DEVELOPMENT, AND DEMONSTRATION (RD&D) PERMIT
APPLICATION CDRL #A010**

1

2

Figure 3-8 – Typical Inspection Log

Time/Date	Inspector(s)	BGCAPP Area(s) Inspected	Observation Made	Date/Nature of Repair(s) or Remedial Action(s)

EXAMPLE

**24915-000-GPE-GGPT-00001 – RESEARCH, DEVELOPMENT, AND DEMONSTRATION (RD&D) PERMIT
APPLICATION CDRL #A010**

Figure 3-9 – Commonly Used Hazardous Waste Containers

CAPACITY (gallons)	DESCRIPTION	UNITED NATIONS (UN) MARKINGS
350	Open head steel/poly intermediate bulk container	UN 31A/31H1/31H2
110	Open head steel drum	UN 1A2
95	Open head polyethylene salvage drum	UN 1H2
85	Open head steel salvage drum	UN 1A2
85	Open head polyethylene salvage drum	UN 1H2
55	Open head steel salvage drum	UN 1A2
55	Closed head steel drum	UN 1A1
55	Closed head polyethylene drum	UN1H1
55	Open head steel drum	UN 1A2
55	Open head polyethylene drum	UN 1H2
30	Closed head steel drum	UN 1A1
30	Closed head polyethylene drum	UN 1H1
30	Open head steel drum	UN 1A2
15	Closed head polyethylene drum	UN 1H1
8	Open head steel pail	UN 1A2
5	Open head polyethylene pail	UN 1H2
5	Closed head polyethylene pail	UN 1H1
1	Open head polyethylene pail	UN 1H2

24915-000-GPE-GGPT-00001 – RESEARCH, DEVELOPMENT, AND DEMONSTRATION (RD&D) PERMIT APPLICATION CDRL #A010

Table 3-8 – Tank Summary

Process Code	Room #	Tank System – Number of Tanks and Capacity ¹	Waste Managed	Waste Codes	Range for Specific Gravity of Waste (@ Operating Temperature unless otherwise specified)	Dimensions	Range for Operating Temperatures (°F)	Range for Operating Pressure (psig)	Materials of Construction	Tank ID#	PFDs (24915-)	P&IDs (24915-)	Comments
Hydrolysate Storage Area (HSA)													
S02	HSA	Agent Hydrolysate Storage Tank with Agitator 1 × 102,264 gallons Working volume: 1 x 92,217 gal	Agent Hydrolysate from ANS	D002, and/or N001	~ 1.05 to 1.29 ² , ~ 0.94 to 1.14 ³ @ 77°F	24 ft diameter, 32 ft height	~ 70 to 110 ^{2,3}	~ 32.88 to 40.18 ^{2,3}	Carbon steel	MT-HSS-0104	11-M5-HSS-00001	11-M6-HSS-00001	Calc 11-M6C-HSS-00003
S02	HSA	Agent Hydrolysate Storage Tank 2 × 337,184 gallons Working volume: 2 x 308,791 gal	Agent Hydrolysate from ANS	D002, and/or N001	~ 1.05 to 1.29 ² , ~ 0.94 to 1.14 ³ @ 77°F	38.5 ft diameter, 40.0 ft height	~ 70 to 110 ^{2,3}	~ 32.88 to 40.18 ^{2,3}	Carbon steel	MT-HSS-0105, MT-HSS-0205	11-M5-HSS-00001	11-M6-HSS-00004/ -00007	Calc 11-M6C-HSS-00002
S02	HSA	Energetics Hydrolysate Storage Tank 2 × 313,433 gallons Working volume: 2 x 287,209 gal	Energetics Hydrolysate from ENS	D002, and/or N001	~ 1.11 to 1.35 ⁴	37 ft diameter, 40 ft height	~ 70 to 154 ⁴	~ 54.27 to 66.33 ⁴	Carbon steel	MT-HSS-0604, MT-HSS-0704	11-M5-HSS-00002	11-M6-HSS-00010/ -00012	Calc 11-M6C-HSS-00001
Agent Collection / Toxic Storage Tanks													
S02	07-123	Agent Holding Tank 1 × 1,451 gallons Working volume: 1 x 1,200 gal	Agent drained from RSM and MWS	D002, and/or N001	~ 0.91 to 1.11 ⁶ , ~ 1.16 to 1.42 ⁷ ~ 0.98 to 1.20 ⁵	5.5 ft diameter, 8.25 ft height	~ 70 to 84 ^{5,6,7}	~ 12.18 to 44.58 ^{5,6} , ~ 12.18 to 14.88 ⁷	Polyvinylidene Fluoride (PVDF)-lined Carbon Steel	MT-ACS-0105, MT-ACS-0106	07-M5-ACS-00001	07-M6-ACS-00003/ -00002	Calc 07-M6C-ACS-00003 Calc 07-M6C-ACS-00002
S02	07-123	Agent Surge Tank 1 x 1,451 gallons Working volume: 1 x 1,200 gal	Incidental Spill Residues & Decontamination Solution	D002, and/or N001	~ 1.09 ⁵ , ~ 1.01 ⁶ , ~ 1.29 ⁷	5.5 ft diameter, 8.25 ft height	~ 100 to 194 ^{6,7} , ~100 to 160 ⁵	~ 3 to 15 ^{5,6,7}	Polyvinylidene Fluoride (PVDF)-lined Carbon Steel	MT-ACS-0106	07-M5-ACS-00001	07-M6-ACS-00002	Calc 07-M6C-ACS-00002, Data Sheet 07-MTD-ACS-00002
SCWO Tank Area (STA)													
S02	STA	RO Reject Tank 2 × 78,970 gallons Working volume: 2 x 73,842 gal	RO Reject	D004, D005, D006, D007, D008, D009, D010, D011, and/or N001	~ 0.89 to 1.12 ⁵ , ~ 0.89 to 1.16 ⁶ , ~ 0.89 to 1.14 ⁷	21 ft diameter, 32 ft height	~ 99 to 121 ^{5,6,7}	~0.42 to 17.08 ^{5,6,7}	Carbon steel w/epoxy lining	MT-RO-0106, MT-RO-0206	10-M5-RO-00002	10-M6-RO-00010/ -00011	Calc 10-M5C-RO-00002, Calc 10-M6C-RO-00009

1
2
3

24915-000-GPE-GGPT-00001 – RESEARCH, DEVELOPMENT, AND DEMONSTRATION (RD&D) PERMIT APPLICATION CDRL #A010

1

Process Code	Room #	Tank System – Number of Tanks and Capacity ¹	Waste Managed	Waste Codes	Range for Specific Gravity of Waste (@ Operating Temperature unless otherwise specified)	Dimensions	Range for Operating Temperatures (°F)	Range for Operating Pressure (psig)	Materials of Construction	Tank ID#	PFDs (24915-)	P&IDs (24915-)	Comments
S02	STA	SCWO Effluent Tank 3 × 45,626 gallons Working volume: 3 x 41,878 gal	SCWO effluent	N001	~ 0.90 to 1.10 ^{5,7} ~ 0.90 to 1.11 ⁶	18 ft diameter, 26 ft height	~ 81 to 154 ^{5,6,7}	~ 0.42 to 17.08 ^{5,6,7}	Carbon steel	MT-SCWO-0101, MT-SCWO-0201, MT-SCWO-0301	10-M5-RO-00002	10-M6-RO-00013/ -00014/ -00015	Calc 10-M5C-RO-00002, Calc 10-M6C-SCWO-00100
S02	STA	RO Permeate Tank 2 × 54,002 gallons Working volume: 2 x 49,352 gal	RO permeate	N001	~ 0.89 to 1.09 ^{5,6,7}	20 ft diameter, 24 ft height	~ 99 to 121 ^{5,6,7}	~ 13.98 to 17.08 ^{5,6,7}	Carbon steel w/epoxy lining	MT-SWS-0101, MT-SWS-0201	10-M5-RO-00002	10-M6-RO-00016	Calc 10-M5C-RO-00002, Calc 10-M6C-SCWO-00102
Spent Decontamination System (SDS)													
T01	07-123	Spent Decontamination System Treatment Tank 3 × 7,735 gallons Working volume: 3 x 6,463 gal	Spent Decontamination, Sumps, Agent washout from MWS and RSM	D002, and/or N001	~ 0.89 to 1.10 ^{5,6,7}	10 ft diameter, 13 ft height	~ 70 to 119 ⁵ ~ 70 to 121 ⁶ ~ 70 to 160 ⁷	~ 5.88 to 21.48 ^{5,6} ~ 11.28 to 21.48 ⁷	PVDF-lined carbon steel	MV-SDS-0101, MV-SDS-0201, MV-SDS-0301	07-M5-SDS-00001	07-M6-SDS-00001/ -00002/ -00003	Calc 07-M6C-SDS-00004
Agent Neutralization System (ANS)													
T01	07-123	Agent Neutralization Reactor 2 × 2,062 gallons	Neutralized Agent/ Hydrolysate	D002, and/or N001	~ 0.89 to 1.20 ⁵ ~ 0.89 to 1.11 ⁶ ~ 0.90 to 1.41 ⁷	6 ft diameter, 9 ft height	~ 70 to 106 ⁵ ~ 70 to 110 ⁶ ~ 70 to 160 ⁷	~ 17.58 to 175.48 ^{5,6,7}	Carbon steel clad w/UNS N10276, Jacket Carbon steel	MV-ANS-0101, MV-ANS-0201	07-M5-ANS-00001/ -00002	07-M6-ANS-00001/ -00002	Calc issued for cancellation (11/11/04), Data sheet: 07-MVD-ANS-00001
T01	07-123	Agent Hydrolysate Sampling Tank 3 × 4,838 gallons	Neutralized agent / hydrolysate from agent hydrolyzers	D002, and/or N001	~ 0.96 to 1.18 ⁵ ~ 1.03 to 1.29 ⁶ ~ 0.94 to 1.14 ⁷	9 ft diameter, 9 ft height	~ 90 to 110 ⁵ ~ 90 to 213 ^{6,7}	~ 32.88 to 40.18 ^{5,6,7}	316L SS	MT-ANS-0103, MT-ANS-0203, MT-ANS-0303	07-M5-ANS-00001/ -00002	07-M6-ANS-00011/ -00012/ -00013	Calc 07-M6C-ANS-00001
Energetics Neutralization System (ENS)													
T01	07-119	Energetics Neutralization Reactor 3 × 3,070 gallons	Energetics Hydrolysate from EBH	D002, and/or N001	~ 0.95 to 1.43 ^{5,6} ~ 0.91 to 1.23 ⁷ ~ 0.90 to 1.43 ⁸	7 ft diameter, 12 ft height	~ 81 to 259 ^{5,6} ~ 82 to 243 ⁷ ~ 79 to 236 ⁸	~ 22.8 to 88.3 ^{5,6,7} ~ 57.18 to 88.3 ⁸	Carbon steel w/UNS N02200 clad Jacket Carbon steel	MV-ENS-0101, MV-ENS-0102, MV-ENS-0103	07-M5-ENS-00001	07-M6-ENS-00005/ -00006/ -00007	Data sheet 07-MVD-ENS-00001

24915-000-GPE-GGPT-00001 – RESEARCH, DEVELOPMENT, AND DEMONSTRATION (RD&D) PERMIT APPLICATION CDRL #A010

Process Code	Room #	Tank System – Number of Tanks and Capacity ¹	Waste Managed	Waste Codes	Range for Specific Gravity of Waste (@ Operating Temperature unless otherwise specified)	Dimensions	Range for Operating Temperatures (°F)	Range for Operating Pressure (psig)	Materials of Construction	Tank ID#	PFDs (24915-)	P&IDs (24915-)	Comments
Energetics Batch Hydrolyzer (EBH)													
X99	07-111	Energetics Batch Hydrolyzer Discharge (GB) 3 x 2,651 pounds/hour Discharge (VX) 3 x 3,200 pounds/hr Sequential operation	Sheared rocket warhead pieces	D003, and/or N001		7.5 ft diameter, 10.03 ft length		~181 to 150 @ 375°F	UNS S32205	MV-EBH-1101, MV-EBH-1201, MV-EBH-1301	07-M5-EBH-00001	07-M6-EBH-01035/ -01036/ -01037	Data sheet 07-M6D-EBH-00034
S02	07-111	Hydrolysate Collection Tank 1 x 1,475 gallons Working Volume: 1 x 1,293 gal	Energetics Hydrolysate	D002, and/or N001	~ 1.11 to 1.49 ^{5,6} ~ 0.94 to 1.49 ⁷	6.83 ft diameter, 6.33 ft height	~205 to 265 ^{5,6} ~ 177 to 273 ⁷ ~ 178 to 277 ⁸	~ 0.42 to 0.52 ^{5,6,7,8}	UNS S32205	MT-EBH-1901	07-M5-EBH-00001, Sheet 1	07-M6-EBH-01085	Calc 07-M6C-EBH-00024, Data Sheet 07-M6D-EBH-00019
SCWO Processing Building (SPB)													
S02	10-102	Aluminum Filtration Feed Tank 2 x 1,584 gallons Working volume: 2 x 1,300 gal	Energetics Hydrolysate from APS	D004, D005, D006, D007, D008, D009, D010, D011, and/or N001	~ 1.06 to 1.30 ⁵ ~ 1.01 to 1.23 ⁶ ~ 0.92 to 1.12 ⁷	7 ft diameter, 5 ft 2 in height	~ 99 to 121 ^{5,6,7}	~ 71.31 to 87.15 ^{5,6,7}	316L SS	MT-AFS-1010, MT-AFS-2010	10-M5-AFS-00001, Sheet 1	10-M6-AFS-00001/ -00002	Calc 10-M6C-AFS-00006, Data sheet 10-M6D-AFS-00001
S02	10-102	Aluminum Filtrate Tank 1 x 4,136 gallons Working volume: 1 x 3,450 gal	Energetics Hydrolysate filtrate	D004, D005, D006, D007, D008, D009, D010, D011, and/or N001	~ 1.04 to 1.27 ^{5,6} ~ 0.93 to 1.13 ⁷	9 ft diameter, 10 ft height	~ 99 to 121 ^{5,6,7}	~ 0.52 to -0.42 ^{5,6,7}	316L SS	MT-AFS-1012	10-M5-AFS-00001, Sheet 1	10-M6-AFS-00003	Calc 10-M6C-AFS-00001, Data sheet 10-M6D-AFS-00005
T01	10-102	Aluminum Precipitation Reactor 2 x 1,077 gallons Working volume: 2 x 930 gal	Energetics Hydrolysate	N001		5 ft diameter, 9 ft height	~ 110 to 140		UNS N10276	MV-APS-0101, MV-APS-0102	10-M5-APS-00001, Sheet 1	10-M6-APS-00001/ -00002/ -00004	Calc issued for cancellation (3/27/06), Data Sheet 10-MVD-APS-00003

24915-000-GPE-GGPT-00001 – RESEARCH, DEVELOPMENT, AND DEMONSTRATION (RD&D) PERMIT APPLICATION CDRL #A010

Process Code	Room #	Tank System – Number of Tanks and Capacity ¹	Waste Managed	Waste Codes	Range for Specific Gravity of Waste (@ Operating Temperature unless otherwise specified)	Dimensions	Range for Operating Temperatures (°F)	Range for Operating Pressure (psig)	Materials of Construction	Tank ID#	PFDs (24915-)	P&IDs (24915-)	Comments
X99	10-102	Aluminum Filtration Unit Discharge (GB) 2 x 2,142 pounds/hour Filtrate; 2 x 439 Pounds/hour Cake Discharge (VX) 2 x 2143 Pounds/hour Filtrate; 358 pounds/hour Cake	Precipitated Energetics Hydrolysate	N001		15 ft length, 10 ft width, 10 ft height			LDX 2101 Duplex SS	ML-AFS-1040, ML-AFS-2040	24915-10-M5-AFS-00001	24915-10-M6-AFS-00001/ -00002	
X99	10-111	RO Unit Discharge (GB) 3 x 87,8924 gallons/day Permeate; 3 x 37,934 gallons/day Reject Discharge (VX) 3 x 62,017 Gallons/day Permeate; 3 x 26,836 gallons/day Reject	SCWO Effluent	D002, and/or N001		16.67 ft length, 6.3 ft width, 6.16 ft height		~ 60 to 100 @ 110F	316L SS	ML-RO-0101, ML-RO-0201, ML-RO-0301	10-M5-RO-00001, Sheet 1	10-M6-RO-00013/ -00014/ -00015	Data Sheet 10-M5D-RO-00002

24915-000-GPE-GGPT-00001 – RESEARCH, DEVELOPMENT, AND DEMONSTRATION (RD&D) PERMIT APPLICATION CDRL #A010

Process Code	Room #	Tank System – Number of Tanks and Capacity ¹	Waste Managed	Waste Codes	Range for Specific Gravity of Waste (@ Operating Temperature unless otherwise specified)	Dimensions	Range for Operating Temperatures (°F)	Range for Operating Pressure (psig)	Materials of Construction	Tank ID#	PFDs (24915-)	P&IDs (24915-)	Comments
Supercritical Water Oxidation (SCWO)													
X99	10-101	SCWO Reactor Feed (GB) 3 x 1,231 pounds/hour Feed (VX) 3 x 1,217 pounds/hour	AFS Filtrate	N001		7.625 in diameter, 10 ft length	~ 1200 to 1250	~ 3400 to 4300 @ 1100°F	Carbon Steel	MV-SCWO-1030, 2030, 3030	10-M5-SCWO-00001	10-M0-SCWO-01013/ -02013/ -03013	Calc 10-M6C-SCWO-00001, Data Sheet 10-M6D-SCWO-00017
S02	10-101	Hydrolysate Blend Tank 2 x 6,124 gallons Working volume: 2 x 5,845 gal	Energetics Hydrolysate	D002, and/or N001	~ 1.02 to 1.24 ⁵ ~ 1.02 to 1.25 ⁶ ~ 0.94 to 1.14 ⁷	8 ft diameter, 17 ft height	~ 99 to 121 ^{5,6} ~ 99 to 122 ⁷	~ 19.76 to 26.98 ^{5,6,7}	316L SS	MT-SCWO-0030, 0031	10-M5-RO-00001 Sheet 3	10-M6-SCWO-00013/ -00015	Calc 10-M6C-SCWO-00016, Data sheet 10-M6D-SCWO-00002
S02	10-101	Batch Hydrolysate Holding Tank 1 x 6,124 gallons Working volume: 1 x 5,845 gal	Hydrolysate blend tank	D002, and/or N001	~ 1.02 to 1.24 ^{5,6} ~ 0.94 to 1.14 ⁷	8 ft diameter, 17 ft height	~ 99 to 121 ^{5,6,7}	~ 22.08 to 26.98 ^{5,6,7}	316L SS	MT-SCWO-0032	10-M5-SCWO-00001 Sheet 3	10-M6-SCWO-00020	Calc 10-M6C-SCWO-00016, Data sheet 10-M6D-SCWO-00002
T01	10-101	Off-Spec Effluent Tank 1 x 3,897 gallons Working volume: 1 x 3,619 gal	Failed batches from SCWO	N001	~ 1.02 to 1.24 ⁹	8 ft diameter, 2 ft height	~ 95 to 121 ⁹	~ 19.76 to 26.98 ⁹	316L SS	MT-SCWO-0041	10-M5-SCWO-00001 Sheet 3	10-M6-SCWO-00014	Calc 10-M6C-SCWO-00037, Data sheet 10-M6D-SCWO-00006
T01	10-103	Emergency Relief Tank 1 x 11,053 gallons ¹⁰ RCRA Regulated Volume: 2,350 gal	Emergency pressure relief from SCWO	N001		8 ft diameter, 27 ft height	~ 77 to 125		316L SS	MV-SCWO-0040	24915-10-M5-SCWO-00001, Sheet 3		Calc 10-M6C-SCWO-00018

NOTES:
¹ Working capacities as shown on the Part A form DEP 7058A
² VX Hydrolysate
³ H Hydrolysate
⁴ GB or VX Energetics Hydrolysate
⁵ GB
⁶ VX
⁷ H
⁸ Rockets
⁹ Off-normal throughput
¹⁰ Volume from tank bottom to the High-High Liquid Level (25" from bottom of tank to HLL) which is the maximum liquid volume of the tank. Remaining volume is for expansion.

**24915-000-GPE-GGPT-00001 – RESEARCH, DEVELOPMENT, AND DEMONSTRATION (RD&D) PERMIT
APPLICATION CDRL #A010**

1 **4.0 QUALITY ASSURANCE (QA)/QUALITY CONTROL (QC)**
2 **PLAN**

3 **4.1 Calibration Procedures & Frequency**

4 The BGCAPP currently operates under the BGCAPP Quality Management Plan
5 (24915-000-G01-GAM-00008) for overall construction site QA/QC procedures. This plan
6 addresses project specific training, design criteria, site audits and inspections, and QA/QC
7 recordkeeping among others. The QA/QC procedures with respect to waste demilitarization and
8 monitoring are more closely associated with the BGCAPP Laboratory Quality Assurance Manual
9 which is currently under development and includes specific requirements for training/certification of
10 monitoring personnel and calibration of air monitoring equipment.

11 Tools, gauges, instruments, and other sampling measuring and test equipment used for data
12 generation or collection activities that affect quality must be controlled and, at specified periods,
13 calibrated to maintain performance within specified limits. Procedures will be developed for
14 calibration of operations equipment in the future (to include schedules and frequency for
15 calibration). Maintenance personnel will conduct calibration using certified equipment and/or
16 standards with known valid relationships to nationally recognized performance standards.
17 Maintenance personnel will use similar instrument response for calibration of equipment for which
18 no nationally recognized standard exists. Laboratory procedures will define calibration and
19 maintenance requirements for laboratory equipment. Records of calibration will be maintained and
20 be traceable to the instrument.

21 **4.1.1 Field Instrument Calibration**

22 Chemical agent sampling and analysis will not require field instruments. If the sampling team uses
23 field instruments for any reason, BGCAPP will perform and document calibration as specified in the
24 manufacturer's manual.

25 **4.1.2 Laboratory Instrument Calibration**

26 Calibration procedures for a specific laboratory instrument consist of initial calibrations (three to
27 five points), initial calibration verifications (ICVs), and continuing calibration verifications (CCVs).
28 The SOP for chemical agent analyses will describe the calibration procedures, their frequency,
29 acceptance criteria, and the conditions under which recalibration will be required. If available, the
30 initial calibration will use an independently prepared calibration standard to verify calibration.

31 For each instrument, the Laboratory will maintain a logbook that will contain the following
32 information:

- 33 1) Instrument identification
- 34 2) Serial number
- 35 3) Date of calibration
- 36 4) Name of analyst
- 37 5) Calibration solution analyzed
- 38 6) Samples associated with the calibration

**24915-000-GPE-GGPT-00001 – RESEARCH, DEVELOPMENT, AND DEMONSTRATION (RD&D) PERMIT
APPLICATION CDRL #A010**

1 **4.2 Internal QC Checks**

2 Internal QC checks currently in place for construction activities include quality inspections of
3 applicable construction efforts, identifying and documenting nonconforming conditions, ensuring
4 non-conformances are corrected, maintaining a tracking system for nonconformance reports
5 (NCRs), performing surveillance and oversight activities, exercising stop/suspend work authority
6 when necessary, and ensuring that facility construction meets technical and quality requirements of
7 governing documents. These overarching goals will be applicable for personnel
8 training/certification and calibration of monitoring instruments and will be discussed further in the
9 BGCAPP Laboratory Quality Assurance Manual. A general overview of QC checks is described
10 below.

11 **4.2.1 Field QC Checks**

12 Sampling personnel will not use portable field instruments for this project.

13 **4.2.2 Laboratory QC Checks**

14 Prior to conducting the chemical agent sampling program, the laboratory will have SOPs and a QC
15 program in place. The QC program will ensure the reliability and validity of the analyses
16 performed. Each SOP will include a QC section that addresses the minimum requirements for the
17 procedure. The internal QC checks for these SOPs include the following:

- 18 1) Method blanks
- 19 2) Instrument blanks
- 20 3) Matrix Spike (MS)/ Matrix Spike Duplicates (MSDs)
- 21 4) Surrogate spikes
- 22 5) Laboratory duplicates
- 23 6) Laboratory Control Sample (LCS)

24 The data package will include a full deliverable package capable of allowing the recipient to
25 reconstruct QC information and compare it to QC criteria. The laboratory will reanalyze any
26 samples analyzed in nonconformance with the QC criteria, if sufficient volume is available.
27 Sampling personnel will collect sufficient volumes of samples to allow for reanalysis when
28 necessary.
29

**24915-000-GPE-GGPT-00001 – RESEARCH, DEVELOPMENT, AND DEMONSTRATION (RD&D) PERMIT
APPLICATION CDRL #A010**

1 **5.0 RECORDKEEPING & DATA REPORTING**

2 Due to the waste being processed, the recordkeeping and reporting associated with waste
3 processing and plant operations at BGCAPP are complex and extensive. Records are maintained
4 to demonstrate environmental regulatory, international treaty, and contractual compliance. In
5 addition, data, to include video, is maintained for possible review should questions arise
6 concerning the actions of personnel operating the plant when confronted with processing,
7 emergency incident or safety/agent exposure challenges. To address these requirements, data
8 collection, recordkeeping and reporting involves electronic processing data; electronic
9 recordkeeping for laboratory analytical results; and hard copy documents.

10 **5.1 Waste Processing: Monitoring, Control, and Analysis of Data**

11 **5.1.1 Facility Control System (FCS)**

12 The FCS provides automatic continuous control of BGCAPP during steady state operating
13 conditions; a combination of both manual and automatic control of BGCAPP during transient
14 conditions (e.g., startup and shutdown); capability for manual intervention at the operator's
15 discretion; and automatic data acquisition and recording of FCS input/output (I/O), events, and
16 messages. The FCS interfaces via hardware connection and/or data links. The primary function of
17 the FCS will be to monitor and control the process systems, process support systems, and facility
18 control systems that are located within BGCAPP. The FCS will have a data historian, data
19 archiving, and perform functions on the server to include export of historical data to other systems
20 and software [e.g., American Standard Code for Information Interchange Exchange (ASCII) text
21 files, Microsoft Office Access and Excel]. The FCS also allows data calculations and manipulation
22 on the collected data for integration, average, maximum/minimum, material balance, efficiency
23 calculations, etc.

24 BGCAPP personnel will use these FCS data archiving, exporting and calculating functions during
25 waste processing. The use of the FCS will involve the capture, export, and any calculations
26 associated with the process monitoring data being collected (e.g., temperature, reaction time). The
27 following subsections present a general description of the FCS and the uses that will be made of it
28 during waste processing.

29 **5.1.2 General Description of the FCS**

30 BGCAPP personnel can operate the FCS from two major operations locations: a CCR located in
31 the CSB, and from the local control room (LCR) located in the SCWO Process Building (SPB).
32 These locations contain consoles for the BGCAPP operators. Each console houses FCS operator
33 workstations (OWSs) consisting of video display units (VDUs), keyboards, and pointing devices;
34 CCTV monitor displays; auxiliary panel to house stop pushbuttons, keyboard, video, and mouse
35 (KVM) switches; printers; and other accessories necessary to perform automatic or manual control
36 and monitoring tasks.

37 The FCS provides automatic control for the following functions:

- 38 1) Display overall BGCAPP operating information
- 39 2) Control process, utilities, and facility equipment
- 40 3) Alert CCR personnel to out-of-tolerance process conditions

**24915-000-GPE-GGPT-00001 – RESEARCH, DEVELOPMENT, AND DEMONSTRATION (RD&D) PERMIT
APPLICATION CDRL #A010**

- 1 4) Prevent BGCAPP system equipment damage resulting when process excursions beyond
- 2 predetermined limits occur (equipment shutdown)
- 3 5) Display information from BGCAPP analyzers that monitor potentially contaminated areas
- 4 6) Provide sufficient information to the operator to verify required control system operation
- 5 during automatic operation
- 6 7) Prevent agent/waste feed when the system is outside of permitted operating ranges
- 7 8) Log the sequence of alarm and operator actions
- 8 9) Time-stamp and store process parameter values at predetermined intervals

9 **NOTE:** This includes the time and temperature for the EBHs and the time, temperature,
10 and pressure for the ENRs.

- 11 10) Provide scheduled and on-demand reports of BGCAPP operation

12
13 The FCS provides manual control for the following:

- 14 1) Operate BGCAPP system equipment
- 15 2) Initiate automatic operation of equipment after meeting the preconditions
- 16 3) Monitor control system parameters during automatic operation including the EBH and ENR
- 17 during processing of “leaker” rockets
- 18 4) Respond to out-of-tolerance conditions and prevent the occurrence of conditions that
- 19 invoke equipment protection, personnel safety interlocks, or that result in automatic
- 20 shutdown in accordance with 29 CFR 1910 and MIL STD 882D
- 21 5) Place equipment into semi-automatic or manual control mode and control the equipment
- 22 manually when required by certain process or environmental permit conditions and support
- 23 of BGCAPP maintenance operations
- 24 6) Isolate equipment failures or malfunctions that have caused shutdown conditions to occur
- 25 7) Coordinate all BGCAPP activities associated with munitions disposal, including those not
- 26 directly involved with the process
- 27 8) Provide direction for activities within the secured area in the event of an upset condition,
- 28 incident, or contingency
- 29 9) Capability to select equipment to be in service, and operational sequence; change the
- 30 mode of control; change the set points of operation and alarm, allow local operation, etc.

31 **5.1.3 Data Acquisition and Recording**

32 The design of the FCS includes Data Acquisition and Recording capabilities for the following
33 functions:

- 34 1) Collect process data, process alarms, equipment alarms, and operator’s entries
- 35 2) Provide time-stamp and storage for process parameters at selected intervals
- 36 3) Provide the CCR operator with real-time and historical trends
- 37 4) Prepare operational reports for the BGCAPP process
- 38 5) Provide software tools for process data analysis
- 39 6) Provide long term and permanent data storage
- 40 7) Interface with the FPS and with several programmable logic controllers (PLCs) located
- 41 throughout BGCAPP to collect process data, alarms, and operator’s entries
- 42 8) Reply to data queries from external system

**24915-000-GPE-GGPT-00001 – RESEARCH, DEVELOPMENT, AND DEMONSTRATION (RD&D) PERMIT
APPLICATION CDRL #A010**

5.1.4 Alarm Management

The following are the standard alarm capabilities of the control software:

- 1) Analog inputs provide warnings for high (HIGH), low (LOW), high absolute (HIGH-HIGH), low absolute (LOW-LOW), rate of change, input out of range high/failure, and input out of range low/failure
- 2) System provides temporarily suppression of an alarm based on operator request or a calculation of an external point
- 3) System can assign different priorities to alarms. Sound horns, colored text display and print of alarms, acknowledge requirements (e.g., authorized type of user to acknowledge alarms), and sort on alarm summary displays will be based on alarm priority

Alarm and messaging management has the following attributes:

- 1) The system can suppress individual alarms but logs the date and time of the alarm suppression and the user identification of the person suppressing the alarm
- 2) Assists with diagnosis of situations where a large number of alarms occur in a very short time
- 3) Integrates with the other human-machine interface displays such that the operator uses minimal keystrokes or mouse clicks to navigate to the display most relevant to the alarm
- 4) Provides alarm capabilities for discrete devices (such as interlock execution, command/status discrepancies, invalid state)
- 5) Provides alarms based on events and faults in sequence programs
- 6) Provides system generated alarms, such as failure of equipment, equipment diagnostic warnings and alerts, and communication problems
- 7) Provides the ability to embed alarms and messages within given graphic displays
- 8) Provides information needed to distinguish between alarms, informational messages, and messages requiring response from operators
- 9) Annunciates both with audible and visual alarming and has multiple colors for alarms and messages to aid in prioritizing alarms
- 10) Acknowledges visual and audible alarms and remains “on” until the alarm resets or the alarm condition clears
- 11) Displays a summary of current alarms to include alarm tag identification, description, limits for the alarm, current value at the time of the alarm went active, current status (e.g., active, acknowledged, unacknowledged, return to normal), time and date of occurrence. Alarm control software can also sort the alarms by occurrence, priority, suppressed alarms, and process area/unit

5.1.5 Waste Processing: Data Archiving and Analysis

The BGCAPP ICS has a single, fault-tolerant historian for archiving data from various integrated systems and FCS subsystems. The laboratory historian is independent of the ICS historian. There will be a redundant ICS historian server to support FCS continuous and batch data archival, sequence of events, online and offline history retrieval, and FPS data archival functionality. The historian server will have sufficient memory capacity and computing power to perform periodic, on demand, and by exception history archival, batch historian, report generation and will have the capability to interface with external devices. The historian server will be capable of performing all OWS functions.

**24915-000-GPE-GGPT-00001 – RESEARCH, DEVELOPMENT, AND DEMONSTRATION (RD&D) PERMIT
APPLICATION CDRL #A010**

5.1.5.1 Continuous Historian

A configurable, real-time, and historical data collection package supports data analysis, trending, logging, and reporting. The system can store at least 3 years of data in the online history at a rate of 10,000 points every 10 seconds.

The FCS provides the following data logging functions:

- 1) Log analog variables, including calculated analog values, by either time configurable or upon change in value (based on percent of range)
- 2) Log critical event occurrence for safety related events
- 3) Log all alarms, such as those for changes in equipment status
- 4) Log all operator actions, such as set-point changes, configuration changes, alarm acknowledgement and inhibit, and changes in operating modes
- 5) Log running averages for selected data
- 6) Export historical data to other systems and software, such as ASCII text files, and Microsoft Office Access and Excel
- 7) Import historical data and events from other systems, such as FPS, open database connectivity systems, and PLCs
- 8) Import and merge FPS sequence of events with FCS events. Log FPS events with the original time-stamp provided by the FPS
- 9) Data calculation and manipulation of the collected data to include integration, average, maximum/minimum, material balance, efficiency calculations.

The system can provide time stamping of all alarms and critical events down to a resolution of 50 milliseconds. The FPS logs data with a time and date stamp, and the actions of an operator with the operator's identification.

The FPS plots trend data versus time on the real time and historical trend displays with minimum of eight points represented by different colors. User customizable data includes trend characterization, collection, storage, and use.

5.1.5.2 Batch Historian

The batch historian tracks the batch process data, alarm and event data, quality data, recipe formula data, produced lot, calculated data, and manual entries with audit trail, stage, batch, and lot identification with date. FCS can also place time stamps on all data for a given lot. The system provides a tool to compare historical data of one lot/batch against other different lots/batches.

Each batch automatically produces an end-of-batch report that, in addition to each lot data specified above, retains the total operational sequence chronologically with date and time.

- 1) Offline History Storage – The system can transfer and back up historical data (from continuous and batch historians) to removable media for long-term historical data storage. The system provides this data archiving for all data types and the system can recall and display any data backed up on removable media. The system was designed for automatic scheduled backups of data (i.e., based either on a fixed time each day and/or when the disk is full) into storage media. The entire database can be backed up either manually or automatically to execute an incremental backup (i.e., back up only the data that have been changed since the last backup), or to back up daily or during a specified time interval.

**24915-000-GPE-GGPT-00001 – RESEARCH, DEVELOPMENT, AND DEMONSTRATION (RD&D) PERMIT
APPLICATION CDRL #A010**

- 1 2) Data Collection and Storage – Online storage media provide historical data storage and
2 retrieval. If a process point is not available, the system enters an unavailable code into the
3 history file.
- 4 a. The system stores the value of any of the following parameters in the online history
5 storage:
- 6 ➤ Process I/O values
 - 7 ➤ Device status
 - 8 ➤ Sequence alarms and events (e.g., start, stop, malfunction, forced step)
 - 9 ➤ Agent/air monitoring values and status
 - 10 ➤ Calculated value
 - 11 ➤ Controller set point
 - 12 ➤ Controller output
- 13 b. The system supports the following historical data collection rates for the above items:
- 14 ➤ 1, 5, 10, 15-second snapshot
 - 15 ➤ 1, 2, 5-min snapshot
 - 16 ➤ 5- or 6-min average
 - 17 ➤ 1-hr average
 - 18 ➤ Shift average
 - 19 ➤ Daily average
 - 20 ➤ Monthly average

21 **5.1.6 Equipment Calibration**

22 Instrument Maintenance Management Server provides asset management of the diverse
23 instruments connected to the ICS. Typical functions of this subsystem include, but are not limited
24 to, the following:

- 25 1) Retrieve digital data residing in highway-addressable remote transducer-capable field
26 instruments connected to the ICS. These data contain information, such as, manufacturer
27 brand, model and serial number; factory settings; default instrument range and calibration
28 span values, etc. In addition, the system can retrieve digital information of the current
29 values of process data measured by the instrument in engineering units; instrument self-
30 diagnostic test results, statistics, etc.
- 31 2) Store retrieved data in a common database. The database may contain different instances
32 of the same instrument, reflecting a history of the modifications performed to the instrument
- 33 3) Display useful diagnostic screens that represent the current and historical status of the
34 instrument
- 35 4) Alarm if the diagnostic status of the instrument indicates failure
- 36 5) Perform remote upload, download, and online calibration of field instruments through IMMS
37 display screens
- 38 6) Automatically sense smart instruments and buildup databases of data points collected from
39 these instruments
- 40 7) Import/export field instrument databases

**24915-000-GPE-GGPT-00001 – RESEARCH, DEVELOPMENT, AND DEMONSTRATION (RD&D) PERMIT
APPLICATION CDRL #A010**

- 1 8) Interface with BGCAPP maintenance software for automatic work order generation upon
2 instrument maintenance management system (IMMS) sensing failed instruments via object
3 linking and embedding for process control
- 4 9) Serve engineer and maintenance workstations, as well as, remote clients (minimum 10
5 clients inclusive)
- 6 10) Provide interface to connect hand-held calibration device (Fluke or equal) for uploading
7 and downloading maintenance data

8 **5.1.7 Batch Control**

9 The batch control portion of the FCS includes a batch management system that provides the
10 following capabilities:

- 11 1) Automatically calculates operating parameters based on selected recipes
- 12 2) Create records for each batch, controls batch recipe, and stores the records
- 13 3) Support mixing and tracking of BGCAPP agent and energetic hydrolysate batches
- 14 4) Automatically collects data on the amount of materials used in each batch
- 15 5) Warn operators if real-time batch process information for processing parameters fall
16 outside of specifications
- 17 6) Provide diagnoses to operators if a batch function fails or does not start
- 18 7) Transfer a process batch into a safe/exception status when processing of a batch does not
19 conform to routine processing parameters and/or procedures
- 20 8) Allocate and arbitrates the coordination of common resources
- 21 9) Allows a batch operation to automatically continue, hold, or abort after a system fault
- 22 10) Provide capability to issue a message requiring an operator action
- 23 11) Provide capability to schedule the processing of batches
- 24 12) Configure user-defined reports for processing of batches

25 **5.2 Electronic Recordkeeping for Laboratory Analyses**

26 The BGCAPP ICS has a single, fault-tolerant historian for archiving data from various integrated
27 systems and FCS subsystems --- discussed above. The laboratory historian is independent of this
28 historian. Laboratory analytical results will be captured from the analytical instrumentation and
29 archived in this historian and hardcopy analytical reports can be printed from this electronic
30 system.

**24915-000-GPE-GGPT-00001 – RESEARCH, DEVELOPMENT, AND DEMONSTRATION (RD&D) PERMIT
APPLICATION CDRL #A010**

5.3 Recordkeeping for Hardcopy Documents

The PDCC uses Citrix (an electronic platform/software) to access InfoWorks (software) stored electronic versions of project hardcopy documents. This software (InfoWorks) provides the ability to archive and retrieve electronic versions of BGCAPP hardcopy documents. The combination of Citrix and InfoWorks provides for a secure database for these hardcopy documents. Examples of documents that will be stored using this combination of electronic software include:

- 1) Operator inspection or maintenance check sheets for rounds
- 2) Environmental inspections of container storage, tank systems, and Subpart X units by BGCAPP personnel
- 3) Hazardous waste manifests
- 4) Copies of regulatory inspections
- 5) Photographs and videos of operations and existing site conditions
- 6) Compiled Daily Operating Records

**24915-000-GPE-GGPT-00001 – RESEARCH, DEVELOPMENT, AND DEMONSTRATION (RD&D) PERMIT
APPLICATION CDRL #A010**

1 **6.0 SAFETY PLAN**

2 **6.1 Human Health & Environmental Effects Criteria**

3 AELs are unique military standards for exposure of unprotected workers and the general
4 population to chemical agents. These airborne TWA standards are based upon recommendations
5 of the CDC promulgated in the Federal Register^{1,2} and incorporated into U.S. Army regulations³.
6 The AELs are the allowable, average concentrations in air for workplace and general population
7 exposures. AELs include WPLs, STELs, and GPLs. Basis of AELs is exposure to a concentration
8 for a set duration (time). The TWA is the average concentration of a chemical agent for a specified
9 duration or length of time. Specific definitions for the AELs are as follows:

10 WPL is an 8 hour TWA. Exposure below the WPL is safe and not expected to produce any
11 adverse health effect. This is the TWA airborne concentration for exposure of unmasked worker
12 for an 8 hour workday, 40 hour week, for 30 years without adverse effect.

13 STEL is the maximum concentration for exposure of unprotected chemical workers for up to
14 15 minutes continuously. The number of exposures allowed for a worker at the STEL is dependent
15 on the chemical agent. For GB exposure, the STEL should not exceed 15 minutes and should not
16 occur more than 4 times per day with each successive exposure separated by at least 60 minutes.

17 GPL is a 24 hour TWA for nerve agents (GB) and a 12 hour TWA. Basis of this GPL are
18 exposures for 7 days per week and a 70-year lifetime.

19 **6.1.1 Use and Selection of PPE**

20 Hazard identification; routes of exposure (inhalation, skin absorption, ingestion, or injection); and
21 performance of the PPE material as a barrier to potential hazards determines the selection of PPE
22 to be worn during agent operations. Other factors in the selection process include matching the
23 PPE to work requirements and task-specific conditions, task duration, and potential for heat stress.
24 Health hazard assessments and job task analyses for any hazardous operation consider these
25 factors. Selecting the appropriate level of dress also includes the requirements provided in
26 DA PAM 385-61 and those required for handling explosive munitions or components.

27 The following subparagraphs list the PPE levels for normal munitions operations and support
28 activities. Normal munitions operations and support activities include routine maintenance,
29 calibration, adjustments, and processing in BGCAPP demilitarization systems, as well as leaker
30 processing. The BGCAPP upgrades PPE levels, as operating or emergency conditions require.
31 The health and safety professionals involved with PPE selection recognize that PPE must be
32 compatible with the agent that may be present, compatible with electro-explosive devices, and
33 resistant to other industrial chemicals, that may be present.

- 34 a. Occupational Safety & Health Administration (OSHA) Level A is DPE or comparable
35 commercially available encapsulating suits worn during normal munitions and
36 support operations in HVAC Category A, Category A/B, and Category B areas. Fully
37 encapsulating, Level A protection is worn in Category B rooms unless the hazard of
38 dermal exposure to agent is known not to exist.
- 39 b. OSHA Level B protection provides the same level of respiratory protection as Level A
40 but does not incorporate an encapsulating suit and instead uses chemical resistant
41 suits (not fully encapsulating) and other items of PPE such as aprons, hoods, and

**24915-000-GPE-GGPT-00001 – RESEARCH, DEVELOPMENT, AND DEMONSTRATION (RD&D) PERMIT
APPLICATION CDRL #A010**

1 gloves. Level B protection is worn only if the dermal exposure hazard does not
2 require full dermal protection.

- 3 c. OSHA Level C provides very limited dermal protection and is used only in areas with
4 a very limited potential for release of airborne hazardous materials and only with
5 continuous air monitoring present. This level of protection (e.g., air purifying
6 respirator) when used in environments that could contain agent is precautionary and
7 allows for safe evacuation. It is not normally used where an agent hazard is known
8 to exist. This level of PPE can also be used for protection against industrial hazards
9 (i.e., acid gases) if cartridges and PPE fabrics are properly selected.
- 10 d. OSHA Level D provides no protection for respiratory exposure to agent or an
11 industrial chemical, so BGCAPP personnel use Level D only if a respiratory exposure
12 cannot exist. Examples of OSHA Level D protection include maintenance coveralls
13 and street clothes.

14 When responding to a chemical agent release, the required level of protection is determined for
15 each emergency response activity and situation. However, for known or suspected agent liquid or
16 vapor releases, OSHA Level A or B protection is required.

17 When responding to an industrial chemical release, the Scene Control Officer (SCO), with
18 assistance/approval of the Safety representative, selects the correct level of PPE. The MSDSs for
19 the chemical involved, National Institute for Occupational Safety and Health (or “NIOSH”)
20 guidance, the DOT Emergency Response Guidebook, and BGCAPP emergency response
21 procedures are references used in making this selection. The PPE selection made by the SCO
22 also considers the work requirements of the entry, to ensure the durability of the PPE is
23 appropriate for that work.

24 **6.2 Emergency Response Procedures**

25 **6.2.1 Definition of a Release**

26 Currently, KDEP has indicated any detectable agent is considered a release regardless of the
27 location of the detected agent. However, by necessity, accessing and disassembly of chemical
28 munitions at BGCAPP will involve the release of liquid and airborne agent into process areas within
29 the MDB and, if each detectable release of agent within the MDB must be reported, the public
30 would be unduly alarmed and processing of agent would be hindered and delayed unnecessarily.

31 The MDB design prevents the release of agent outside of engineering controls and allows the
32 processing of agent munitions without significant danger to workers, the public or the environment.
33 Therefore, a revised definition of an “agent release” is needed for BGCAPP agent operations due
34 to the nature of the chemical agent demilitarization work activities that will be performed within the
35 MDB and the extensive engineering controls inherent in the MDB design.

36 The following definition of an environmental release of chemical agent is proposed for the
37 BGCAPP facility:

**24915-000-GPE-GGPT-00001 – RESEARCH, DEVELOPMENT, AND DEMONSTRATION (RD&D) PERMIT
APPLICATION CDRL #A010**

1 *“An environmental release of chemical agent would include the release of either liquid or*
2 *airborne chemical agent outside of engineering controls (i.e., outside of ventilation controls and*
3 *outside of a building or containment). For purposes of this definition, hydrolysate (i.e., liquid*
4 *waste generated during the neutralization of agent) would not be included as liquid chemical*
5 *agent and the definition of liquid chemical agent would be limited to chemical agent that has not*
6 *undergone chemical reaction/destruction. Airborne (i.e., aerosol or vapors) environmental*
7 *releases of chemical agent would include instances of confirmed detections of chemical agent*
8 *outside of engineering controls at a concentration in excess of the agent’s short term exposure*
9 *limit (STEL).”*

10 The standard definition for environmental releases and reportable quantities for other contaminants
11 will continue to be applied.

12 **6.2.2 Emergency Response Procedures**

13 The BGCAPP fire alarm system panel is hard-wired to the BGAD Fire Department providing nearly
14 instantaneous notification (i.e., of a BGCAPP fire) to the BGAD Fire Department. The
15 implementation of the Contingency Plan occurs in the following specific situations at the discretion
16 of the BGCAPP Incident Commander:

- 17 1) A fire or explosion occurs at or on the route to the BGCAPP
- 18 2) A fire threatens the BGCAPP or the route to the facility
- 19 3) A fire or potential explosion involving the BGCAPP or the route to the facility threatens
20 off-site areas
- 21 4) Use of water or chemical fire suppressant on a fire could result in contaminated run-off
- 22 5) An imminent danger exists that an explosion could occur, causing a safety hazard due to
23 flying fragments or shock waves
- 24 6) An imminent danger exists of an airborne or liquid release of hazardous constituents from
25 the BGCAPP
- 26 7) A spill of hazardous material or wastes results in a fire, explosion, or potential fire or
27 explosion
- 28 8) A spill of hazardous material or wastes is contained on-site, but may potentially
29 contaminate soils, groundwater, or surface water resources

30 Emergency response begins with the notification of BGCAPP CCR personnel of an emergency
31 condition involving a release of hazardous waste or hazardous waste constituents into a secondary
32 containment, the environment or outside of engineering controls. This notification initiates the
33 following emergency response activities:

- 34 1) The BGCAPP Plant Shift Manager notifies the BGCA Operations Center/Emergency
35 Coordinator (OC/EC) that an emergency exists, provides available information on the
36 situation, and assumes responsibilities as the BGCAPP Incident Commander
- 37 2) After making this notification, the BGCAPP Incident Commander directs the BGCAPP SCO
38 and the BGCAPP Hazardous Material Response Team (HMRT) Leader to gather
39 information, and plan the emergency response to mitigate the source, and contain,
40 cleanup, store, and dispose of released material and cleanup/decontamination residues

**24915-000-GPE-GGPT-00001 – RESEARCH, DEVELOPMENT, AND DEMONSTRATION (RD&D) PERMIT
APPLICATION CDRL #A010**

1 3) BGCAPP HMRT personnel, wearing appropriate PPE (the Safety Officer provides
2 assistance in PPE selection) for the waste or waste constituents released, mobilize to the
3 emergency response location and respond to the release of hazardous waste or hazardous
4 waste constituents. If the release, spill, or leak is into secondary containment, the Incident
5 Commander informs the BGCA OC/EC the event is not reportable unless an air release
6 requiring reporting is a possibility

7 The first priority in the emergency response (i.e., assuming that no injured personnel or personnel
8 otherwise unable to clear the area remain behind) is to stop the release.

9 If the emergency involves a leaking container, the leak is to be stopped by transferring the waste
10 into a container(s) or tank(s) that is in good condition and compatible with the material being
11 transferred. If transfer is not immediately possible, the leak or spill is to be contained until waste
12 can be placed into the appropriate container(s)/tank(s). Containment in a permitted storage area is
13 adequate to ensure hazardous waste does not reach the environment; however, further
14 containment may be advisable to limit the cleanup required and can be accomplished using best
15 available materials (e.g., absorbent pigs, absorbents, or dirt/other materials can be used to
16 construct temporary dikes).

17 If the emergency involves a tank system, the feed to the tank is to be stopped, and the source of
18 the leak, spill, or release is to be identified. The containment provided for all permitted BGCAPP
19 process and storage tanks is adequate to contain the waste; however, if possible, the release
20 should be stopped (e.g., using process controls, plug kit, or transfer into another tank system).

21 If a release from a tank or container occurs outside of secondary containment, unprotected
22 personnel are to be evacuated to an upwind location. Personnel wearing the appropriate PPE
23 contain the spill and prevent further leakage at the source of the spill. Spilled process waste
24 solutions are to be transferred to another tank, a portable tank, or into containers. Other liquid
25 wastes, solid wastes, or contaminated media are to be transferred into containers or portable
26 tanks. The containerized waste materials are stored temporarily prior to disposal.

27 If the emergency involves a fire or explosion, the response consists of removing any injured
28 personnel and isolating or removing other wastes in the area. For significant fires or explosions,
29 the BGCAPP HMRT Leader establishes a safe “stand-off” distance and monitors the situation while
30 awaiting additional support from the BGAD Fire Department and BGAD HMRT. HMRT personnel
31 are not placed at risk.

32 If the emergency involves an air release of contaminants, the BGCAPP MDB HVAC system may
33 mitigate the release (i.e., if the emergency occurs inside the MDB). Release of agent into the
34 atmosphere (e.g., outside the MDB) may require the activation of the BGAD Chemical Accident or
35 Incident Response and Assistance (CAIRA) Plan and the BGCAPP HMRT performs monitoring of
36 the release using MINICAMS® and the in-place air monitoring systems (DAAMS), or other air
37 monitoring equipment.

38 In the event that wastes mix with water (e.g., firefighting water), the BGCAPP uses sorbent
39 materials and/or containment equipment and devices to control the contamination. BGCAPP
40 HMRT personnel place sorbent materials directly on the waste to prevent further spread and to aid
41 in recovery and/or construct berms of earthen or sorbent materials downstream of the spill or
42 release to contain larger waterborne spills.

43 **NOTE:** The BGCAPP designed the containments in the MDB to have sufficient volume to contain
44 fire water released during a 15–20 minute firefighting event with the additional volume
45 needed to contain leakage from the largest tank or container within the firefighting zone.

**24915-000-GPE-GGPT-00001 – RESEARCH, DEVELOPMENT, AND DEMONSTRATION (RD&D) PERMIT
APPLICATION CDRL #A010**

1 After initial emergency response to a liquid release, follow-on actions may include:

- 2 1) Perform inspection and decontamination (with appropriate decontamination solutions
3 and/or water) of the release area
- 4 2) Repeat the decontamination procedure until cleanup is satisfactory if observation or
5 monitoring indicates the presence of contaminants
- 6 3) Collect the released chemical, spent decontamination solution, and any contaminated
7 water for temporary storage prior to disposal. Place any contaminated sorbents, earthen
8 materials, or other containment devices in DOT approved containers, and store to await
9 disposal. Do not leave uncontained contaminated materials at the spill site
- 10 4) Use a portable pump or the installed sump pump to remove as much of the spilled/leaked
11 waste as possible. Use squeegees, absorbents, and/or a wet-dry vacuum (with HEPA
12 filter) to remove the remaining spilled/leaked waste, and any wastes in secondary
13 containments, within 24 hours of detecting the leak
- 14 5) Remove other wastes from a leaking tank system to prevent further spills or leaks of
15 hazardous waste or to allow inspection and repair of the tank system within 24 hours from
16 detection of the leak

17 The Incident Commander notifies the BGCAPP Environmental Department if hazardous waste
18 removal within 24 hours of detection is not possible. If the BGCAPP Incident Commander
19 determines the release affects or may affect the environment beyond the BGCAPP boundary, at
20 any time during the emergency response, he/she notifies the BGCA OC/EC.

21 An incidental release is a release of hazardous waste or hazardous waste constituents, including
22 agent, where the substance can be absorbed, can be neutralized, or can otherwise be controlled
23 by BGCAPP personnel in the immediate release area, at the time of the release.

24 In the event of an incidental release of hazardous waste or hazardous constituents at the
25 BGCAPP:

- 26 1) The Incident Commander directs the BGCAPP HMRT to mitigate the source, and to
27 contain, clean up, and temporarily store the wastes
- 28 2) As soon as practicable, the BGCAPP Incident Commander notifies the BGCAPP Site
29 Manager of the incidental release and of the actions taken to mitigate the release
- 30 3) BGCAPP HMRT personnel place spilled liquid, solid waste, and contaminated residuals
31 into containers and temporarily store the wastes prior to disposal
- 32 4) BGCAPP HMRT personnel place contaminated sorbents, earthen materials, or other
33 containment devices in DOT approved containers, and store the wastes prior to disposal or
34 treatment. BGCAPP personnel remove other contaminated materials from the spill site
35 and decontaminate the materials for reuse or disposal as wastes

36 **6.2.3 Release Notifications**

37 The BGCAPP Plant Shift Manager or his delegate receives a report from the first observer or
38 supervisor of a fire, explosion, or release of hazardous material/hazardous material constituent on
39 or near the BGCAPP. The BGCAPP Plant Shift Manager or his delegate assumes the
40 responsibilities of the BGCAPP Incident Commander and assesses the situation, determines the
41 appropriate response, and notifies the BGCA OC/EC of the incident. The BGCAPP coordinates
42 and requests support from the BGCA OC/EC for emergencies governed by the BGCAPP
43 Contingency Plan, and for response to releases/spills beyond the BGCAPP's capability. The
44 BGCA OC/EC oversees BGCAPP emergency response activities, makes notification to state and
45 local agencies, and determines whether to request support from organizations outside the BGAD.

**24915-000-GPE-GGPT-00001 – RESEARCH, DEVELOPMENT, AND DEMONSTRATION (RD&D) PERMIT
APPLICATION CDRL #A010**

1 The BGCAPP Plant Shift Manager or his delegate makes the initial response or requests
2 assistance from the BGAD. Public address announcement, two-way radio, cellular phone, and/or
3 audible alarm notify BGCAPP personnel throughout the plant of the emergency. The
4 announcement or signal contains information for plant employees regarding response, evacuation,
5 or additional instructions. Should a site evacuation be necessary, employees will exit the site via
6 evacuation routes found in Figure 6-2 and in accordance with guidance from the OC.

7 **6.2.4 Release Reporting Requirements**

8 BGCAPP personnel prepare a written follow-up report in addition to the verbal notifications initiated
9 by the BGCA OC/EC. All emergencies that require the implementation of the BGCAPP
10 Contingency Plan or that involve the release of a hazardous waste equal to or exceeding a
11 reportable quantity (RQ) require a written report within 15 days to KDEP, Division of Waste
12 Management. The BGCAPP provides to the BGAD Commander the written report for submittal to
13 KDEP (with a copy of the report sent to the Administrator for U.S. EPA Region 4):
14

Energy and Environment Cabinet
Director, Division of Waste Management
Department for Environmental Protection
200 Fair Oaks Lane, 2nd Floor
Frankfort, KY 40601

15 The report includes the following information:

- 16 1) Name, address, and telephone number of the owner or operator
- 17 2) Name, address, and telephone number of the facility
- 18 3) Date, time, and type of incident
- 19 4) Name and quantity of material(s) involved
- 20 5) The extent of injuries, if any
- 21 6) An assessment of actual or potential hazards to human health or the environment, if
22 applicable
- 23 7) Estimated quantity and disposition of recovered material resulting from the incident

24 The BGCAPP places a record of all emergencies requiring implementation of the Contingency Plan
25 in the Facility Operating Record.

26 Any leaks, spills or other releases within the MDB are not subject to reporting due to the controls
27 designed into this building (e.g., lined concrete containments, containment curbing, door thresholds
28 and HVAC with extensive air emission controls) that prevent the environmental release of liquids or
29 vapors to the environment. Figure 6-1, Table 6-1, and Figure 6-2 (which follow) are examples of
30 forms used to collect information for Incident Reports, a listing of BGCAPP Emergency Response
31 Equipment and an Emergency Response Agency Notification List.
32

**24915-000-GPE-GGPT-00001 – RESEARCH, DEVELOPMENT, AND DEMONSTRATION (RD&D) PERMIT
APPLICATION CDRL #A010**

1
2

Figure 6-1 – Incident Report

Name, address, and phone number of owner or operator

Name, address, and phone number of facility

Date, time, and type of incident (e.g., fire, explosion)

Name and quantity of material(s) involved

Extent of injuries (if any)

Assessment of actual or potential hazards to human health or the environment (if applicable)


EXAMPLE

3

24915-000-GPE-GGPT-00001 – RESEARCH, DEVELOPMENT, AND DEMONSTRATION (RD&D) PERMIT
APPLICATION CDRL #A010

1
2

Figure 6-2 – BGCAPP Evacuation Routes

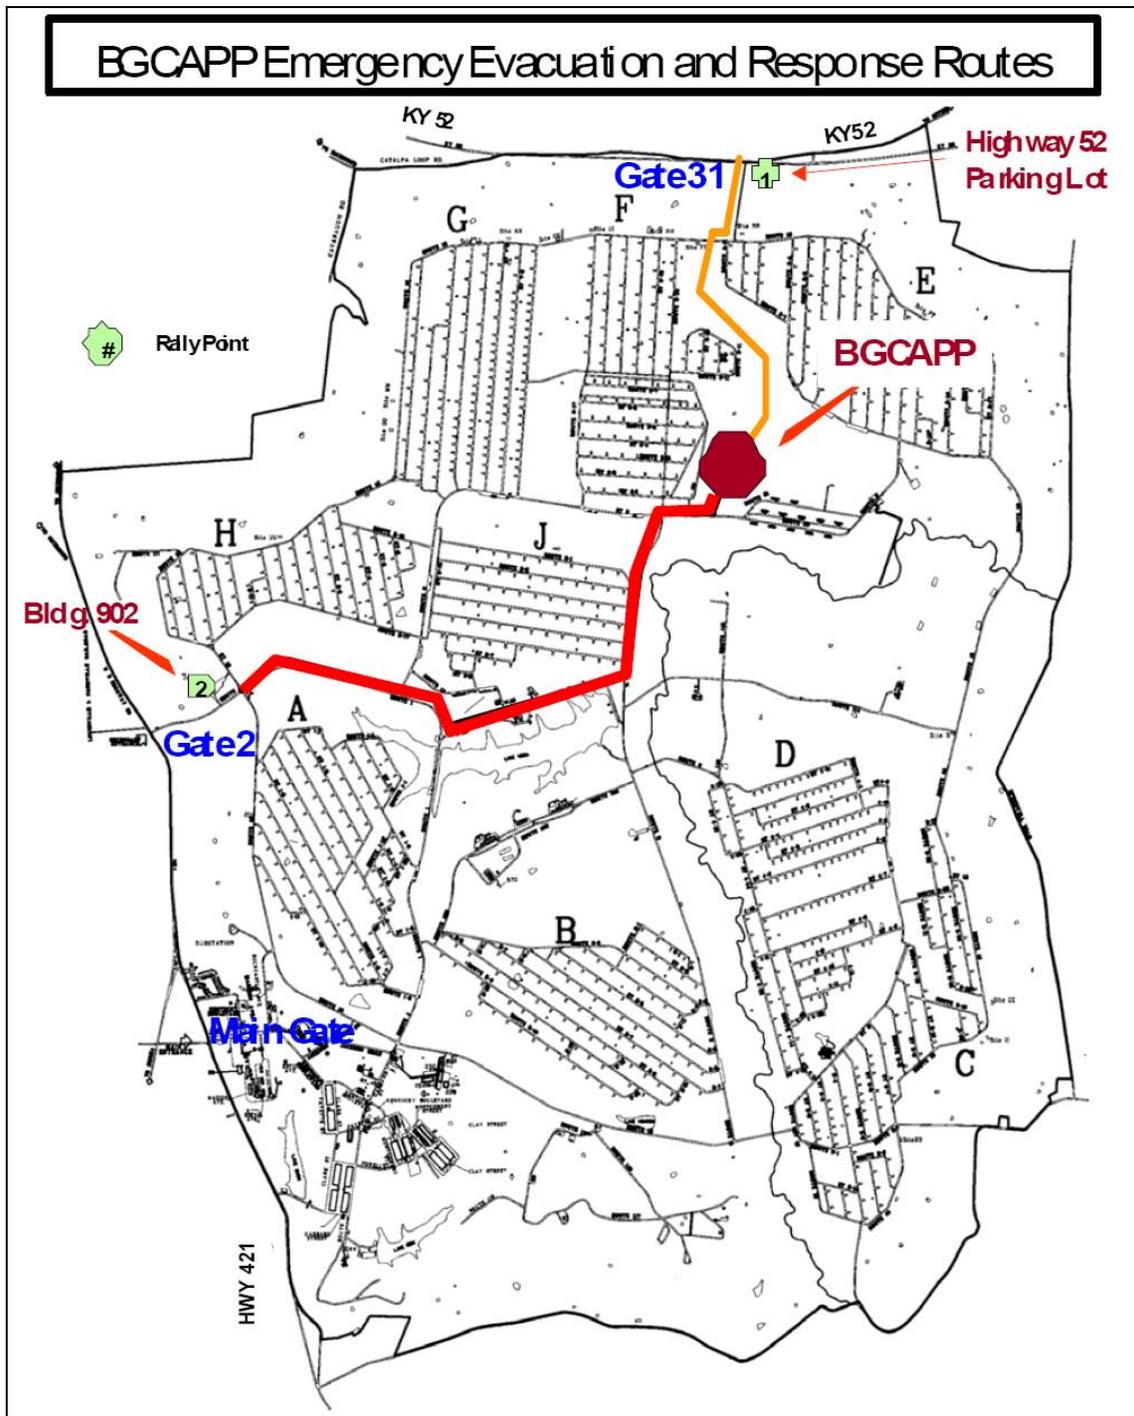

3
4

**24915-000-GPE-GGPT-00001 – RESEARCH, DEVELOPMENT, AND DEMONSTRATION (RD&D) PERMIT
APPLICATION CDRL #A010**

Table 6-1 – Typical BGCAPP Emergency Response Equipment

Emergency Equipment	
Description	Location
Fire Engine/HAZMAT Response ¹	BGAD Fire Department
Drum Plug Kit	Drum Storage Areas
Fire Extinguishers	Throughout Facility
Fire Hydrants	Throughout Facility
Pick-up Trucks	Throughout Facility
Absorbent Sheets/Bags/Pads	Throughout Facility
Containment Booms	Throughout Facility
Granular Absorbent	Throughout Facility
Ambulance	PMB
PPE	CSB/MDB/PMB/Laboratory
Sumps and containment curbs	All chemical agent handling areas
Spill Kits	Throughout Facility
Emergency Medical Treatment Facility	PMB
Emergency Response Trailer ²	PMB

NOTES:

¹ BGAD Fire Department equipment in the BGAD spill prevention control and countermeasure (SPCC)/Installation Spill Contingency Plan (ISCP).

² BGCAPP emergency response trailer and vehicle contain spill response materials for industrial spills and emergency/rescue equipment including entry suits and self-contained breathing apparatus (SCBA).

**24915-000-GPE-GGPT-00001 – RESEARCH, DEVELOPMENT, AND DEMONSTRATION (RD&D) PERMIT
APPLICATION CDRL #A010**

Table 6-2 – Emergency Response Agency Notification List

Agency ^a	Phone Number
BGAD Fire Department ^b	911 (from facility phone) (859) 779-6911 (from off-post or cell phone)
Kentucky Department of Environmental Protection (KDEP), Environmental Response Team	(502) 564-2380 (Monday-Friday, 0730-1530) ^c (800) 928-2380 (24 hr)
Kentucky Emergency Response Commission (ERC) ^c	(800) 255-2587 (502) 564-7815
National Response Center	(800) 424-8802 (D.C. area) (202) 267-2675
Madison County 911 Center and Central Dispatch	(859) 624-4776
Local Emergency Planning Committee ^e	(859) 624-4787
State Fire Marshall ^f	(502) 564-3626
Motor Vehicle Enforcement ^g	(502) 564-3276
U.S. EPA, Region 4, 24-hr Spill Reporting ^h	(404) 562-8700
U.S. Coast Guard, 8th District, Marine Safety	(504) 589-6261
U.S. Army Environmental Center (optional)	(410) 436-4714
HODA (DAEN-2CE)-AOC ⁱ	(703) 697-0218
CHEMTREC (Information Only)	(800) 424-9300

NOTES:

- ^a Agency notifications are only made by the BGAD Environmental Office.
- ^b The fire department having jurisdiction must be notified. The BGAD onsite fire department is designated as the fire department with jurisdiction.
- ^c Notify both the KDEP and Kentucky Emergency Response Coordinator of a release at or above the reportable quantity (RQ).
- ^d The NRC notifies the U.S. Coast Guard and U.S. EPA (includes chemical surety and toxic gases).
- ^e 911 should notify adjoining jurisdictions if they are at risk. Notify the following jurisdictions, if required:
 - Clark County (859) 744-2111
 - Estill County (606) 723-2201
 - Fayette County (859) 258-3600
 - Garrard County (859) 792-3023
 - Jackson County (606) 287-8305
 - Jessamine County (859) 887-5447
 - Rockcastle County (606) 256-2195
- ^f If a fire hazard exists, the State Fire Marshall must also be notified; therefore, when reporting to KDEP and Kentucky ERC, tell them to notify the State Fire Marshall of the fire hazard.
- ^g Notify Motor Vehicle Enforcement if hazardous material was released on public roadway, or if motor vehicle enforcement assistance is needed.
- ^h The NRC notifies U.S. EPA Region 4. The BGAD may also notify Region 4.
- ⁱ Notify the U.S. Army Operations Center (AOC) in a crisis only.

NOTE: In Kentucky, the following specific RQs apply to petroleum products. Notify state and local agencies of a release at or above following RQs:

Diesel:	Federal	=	Any quantity that poses any threat to water
	KY RQ	=	75 gallons on land or water
All other petroleum products:	Federal	=	Any quantity that poses any threat to water
KY RQ	=		25 gallons on land or water

**24915-000-GPE-GGPT-00001 – RESEARCH, DEVELOPMENT, AND DEMONSTRATION (RD&D) PERMIT
APPLICATION CDRL #A010**

1 **6.3 Personnel Qualifications or Training**

2 **6.3.1 Training**

3 The purpose of BGCAPP operations is the treatment and destruction of chemical agents and
4 associated explosives. The chemical agents are Kentucky listed hazardous wastes and KDEP
5 permits the facility under the RCRA. As required by RCRA, BGCAPP personnel receive
6 specialized training if their job requires performance of waste management and/or emergency
7 response activities. These job activities include generating, handling, storing, treating, disposing,
8 or responding to releases of hazardous waste. Their training will also address health hazards,
9 PPE, workplace controls, spills/emergencies (i.e., to include fires, explosions, severe weather and
10 other possible emergencies during BGCAPP operations), and handling/storage.

11 The Training Department prepares a Job & Task Analysis and this analysis serves as the basis for
12 developing the Training Program for BGCAPP. The Job & Task Analysis takes each job duty and
13 breaks it down to the task level. The evaluation assesses each task to determine if hazardous
14 wastes or hazardous materials are managed while performing the task. After this determination is
15 complete, the Training Department develops the level and type of training based upon the tasks
16 performed and hazards encountered by the worker.

17 Table 6-3 provides a table with job titles and the hazardous waste and hazardous material training
18 requirements.

19 **6.3.1.1 Training Courses**

20 Each person expected to be involved in hazardous waste management activities receives Initial
21 Hazardous Waste Operations and Emergency Response (HAZWOPER) training. Employees must
22 successfully complete this initial training within six months after the date of their employment or
23 assignment to a new position involving hazardous waste management at BGCAPP. New
24 employees or employees transferred to new positions do not work unsupervised prior to successful
25 completion of the initial training and an on-the-job supervised training period.

26 Facility personnel involved in hazardous waste management activities must successfully complete
27 an annual review of their initial training. Training may include classroom instruction, on-the- job
28 training (OJT), hands on exercises, practical exercises (e.g., donning/doffing PPE.), or a
29 combination of these delivery methods. Implementation of training falls into five groups:

- 30 1) New Employee and Visitors Site Orientation – Any individual who is temporarily at the
31 BGCAPP site must complete an orientation that includes site rules, safety, surety, and
32 emergency response procedures. All new and transferring employees must also attend
33 the site orientation training. The Human Resources Department has a program that
34 notifies the Training Department and other impacted organizations of visitors and new or
35 transferring employees prior to their start date.
- 36 2) Initial Workforce Training – Initial workforce training is required before personnel perform
37 the tasks associated with their job position without supervision. The basis of workforce
38 training is the Job & Task Analysis performed for that job position. For the operations
39 phase of the project, workforce training includes qualification and certification. Operations
40 personnel are qualified within six months of hire.
- 41 3) Follow-on Training – The Training Department prepares OJT and/or classroom training as
42 the systemization and operations activities identify needs or areas for improvement.

**24915-000-GPE-GGPT-00001 – RESEARCH, DEVELOPMENT, AND DEMONSTRATION (RD&D) PERMIT
APPLICATION CDRL #A010**

- 1 4) Cross training – Cross training is required to qualify an employee for a new or second job
2 position (e.g., backup for other personnel). BGCAPP requires the completion of cross
3 training within six months of the assignment to the new position. Employees cannot work
4 without direct supervision until their cross training is complete.
- 5 5) Refresher Training – The Training Department offers annual refresher training complying
6 with the requirements of 29 CFR 1910.120 and 40 CFR 264.16. Any personnel involved in
7 hazardous waste management activity will successfully complete an annual review of the
8 initial training.

9 Training Department maintains training records using the Compliance Suite®. In addition, the
10 Project Document Control Center receives training records for entry and retention in the
11 InfoWorks® system. Training Department also receives and maintains documentation of employee
12 training received from off-site organizations. BGCAPP maintains training records of current
13 employees until closure of the facility. Training records for former employees are retained for three
14 years from the date the employee last worked at BGCAPP.

15 **6.3.1.2 Training Course Descriptions**

16 The Training Department makes available employee training records for regulatory agency review
17 during normal business hours. The following paragraphs provide descriptions of the general types
18 of training provided to BGCAPP employees.

- 19 1) New Employee Orientation -- New employee orientation is required before any employee
20 gains access to the site. This course provides the new employee with an understanding of
21 environmental, safety and health, and special job site requirements. Specifically, it
22 provides the employee the knowledge and information necessary to identify the
23 environmental and safety hazards in their work environment, and to apply the preventive
24 measures and techniques to eliminate or reduce environmental incidents and the exposure
25 to illness and injury; and introduces employees to the Zero Accident Philosophy and
26 explains how BGCAPP strives to achieve this goal.

27 Elements addressed are:

- 28 a. Management commitment
29 b. Incident investigation
30 c. Safe behavior overview
31 d. Injury/illness reporting
32 e. General project/facility rules
33 f. STARRT/AHA/JSA (types of analyses performed to identify hazards)
34 g. Emergency procedures
35 h. Lock-out and tag-out
36 i. Personal protective equipment
37 j. Confined spaces
38 k. Safe Access to elevated work areas
39 l. Hazard Communication
40 m. Quality & Environmental Awareness
41 n. Compressed gas cylinders
42 o. Housekeeping
43 p. Back injury prevention
44 q. Fire prevention and protection
45 r. Workers' compensation
46 s. Safety, Toolbox meetings
47 t. Excavations and trenching

**24915-000-GPE-GGPT-00001 – RESEARCH, DEVELOPMENT, AND DEMONSTRATION (RD&D) PERMIT
APPLICATION CDRL #A010**

- 1 u. Fall protection/prevention
- 2 v. Industrial Relations
- 3 w. Barricades
- 4 x. Hand power tool safety
- 5 2) HAZWOPER Initial Training 29 CFR 1910.120 (40 Hours) – This course is not required by
- 6 RCRA but BGCAPP. The purpose of this course is to ensure awareness and promote
- 7 safety among employees potentially exposed to chemical hazards in the work-site. The
- 8 objective is to ensure employees operate in the safest possible manner in situations where
- 9 contact with potentially hazardous materials is likely. The training objectives are to control
- 10 or eliminate the potential hazards and/or losses and protect the health and safety of
- 11 workers, the public, and the environment. This course provides employees:
- 12 a. An understanding of hazardous materials/wastes handling, identification, and human
- 13 responses to exposure
- 14 b. The importance of the Health and Safety Plan (HSP)
- 15 c. Knowledge of what to do in case of site emergencies (i.e., Site Emergency
- 16 Response Plan)
- 17 d. Appropriate safety methods and work practice controls
- 18 e. Ability to recognize signs and labels that are used to alert personnel of danger
- 19 involving hazardous material/waste
- 20 f. Understanding how to prevent environmental releases and knowledge of site/stack
- 21 air monitoring and regulatory requirements for air monitoring
- 22 g. Site control methods for confinement, management, and cleanup to protect the
- 23 public and the environment
- 24 3) HAZWOPER Refresher 29 CFR 1910.120 (8 Hours) – This refresher course is required by
- 25 RCRA but addresses PCBs as well. General site workers managing hazardous or PCB
- 26 wastes or potentially exposed to hazardous substances or health hazards, attend this
- 27 course. Only employees completing the 40 hour training course may take the refresher
- 28 course. Topics covered include:
- 29 a. HAZWOPER regulations
- 30 b. Safety and health plans
- 31 c. Hazardous chemicals
- 32 d. Safety hazards
- 33 e. Air monitoring
- 34 f. Medical surveillance
- 35 g. Site control
- 36 h. Decontamination
- 37 i. PPE including respiratory equipment
- 38 4) HAZWOPER Supervisor/ Management 29 CFR 1910.120 (8 hours) – The Supervisor and
- 39 Management training requirement applies to all onsite managers and supervisors directly
- 40 responsible for, or who supervise employees performing hazardous waste operations.
- 41 Supervisor/management personnel must have completed at least 24 hours of hazardous
- 42 waste training prior to receiving the supervisor/management training.

**24915-000-GPE-GGPT-00001 – RESEARCH, DEVELOPMENT, AND DEMONSTRATION (RD&D) PERMIT
APPLICATION CDRL #A010**

- 1 5) First Responder Awareness Level 29 CFR 1910.120(q)(6)(i) – The First Responder
2 Awareness Level training applies to all BPBG employees and is required for access to the
3 site. This training provides employees with the knowledge and information needed if they
4 observe or discover spilled/released hazardous substance. First responders at the
5 Awareness Level shall receive annual refresher training of sufficient content and duration
6 to maintain their competencies, or shall demonstrate competency in those areas at least
7 yearly.
- 8 6) First Responder Operations Level 29 CFR 1910.120(q)(6)(ii) (8 hours) – The First
9 Responder Operations Level training applies to employees designated to provide the initial
10 response to spilled/released hazardous substance and protect near-by persons, property,
11 or the environment. First responders at the operations level shall receive annual refresher
12 training of sufficient content and duration to maintain their competencies, or shall
13 demonstrate competency in those areas at least yearly.
- 14 7) Technician Level 29 CFR 1910.120(q)(6)(iii) (24 hours) – The Technician Level training
15 applies to those individuals designated to respond to spilled/released hazardous
16 substances, to stop the spill/release. These employees are trained in accordance with
17 paragraph (q)(6) of 29 CFR 1910.120 and receive annual refresher training of sufficient
18 content and duration to maintain their competencies, or shall demonstrate competency in
19 those areas at least yearly.
- 20 8) DOT Requirements – Hazardous Material Employee 49 CFR 172.704 -- DOT training is
21 required for employees involved in the receiving, shipping, storing, or managing hazardous
22 material (HAZMAT) or hazardous waste (HW). Employees involved in these HAZMAT
23 activities include any person who directly affects HAZMAT or HW transportation safety
24 including a person who:
- 25 a. Loads, unloads, or handles HAZMAT/HW
 - 26 b. Prepares HAZMAT/HW for transportation
 - 27 c. Is responsible for safety of transporting HAZMAT/HW
 - 28 d. Operates a vehicle used to transport HAZMAT/HW

29 **NOTES:**

- 30 1) 53 Federal Register (FR) 8504 (15 March 1988) (corrected in 53 FR 11002, 4 April 1988),
31 Final Recommendations for Protecting Human Health and Safety Against Potential
32 Adverse Effects of Long-term Effects of Long-term Exposure to Low Doses of Agents: GA,
33 GB, VX, Mustard Agent (H, HD, and HT), and Lewisite (L).
- 34 2) 68 FR 54460 (17 September 2003)(corrected in 68 FR 58348, 9 October 2003), Final
35 Recommendations for Protecting Human Health from Potential Adverse Effects of
36 Exposure to Agents GA (Tabun), GB (Sarin), and VX.
- 37 3) Department of Army Pamphlet 385-61, Toxic Chemical Agent Safety Standards,
38 17 December 2008.
- 39

24915-000-GPE-GGPT-00001 – RESEARCH, DEVELOPMENT, AND DEMONSTRATION (RD&D) PERMIT APPLICATION CDRL #A010

Table 6-3 – Training Matrix

Job Title	New Employee Site Orientation	HAZWOPER – 40 Hr	HAZWOPER –Refresher 8 Hr	HAZWOPER – Supervisor/ Management 8 Hr	First Responder Awareness & Annual Refresher	First Responder Operations & Annual Refresher	Technician Level & Annual Refresher	DOT	RCRA & Annual Refresher
Environmental Manager	X	X	X	X	X	X		X	X
Environmental Compliance Manager	X	X	X	X	X	X		X	X
Environmental Permitting Manager	X	X	X	X	X	X		X	X
Waste Manager	X	X	X	X	X	X		X	X
Environmental Compliance Specialist	X	X	X		X	X	X	X	X
Environmental Engineer	X	X	X		X	X		X	X
Emergency Preparedness Manager	X	X	X	X	X	X	X		X
Plant Safety Engineer	X	X	X	X	X	X	X		X
Additional Safety Personnel									
Deputy Plant Manager	X	X	X		X				
Operations Manager	X	X	X		X	X			X
Plant Shift Manager	X	X	X	X	X	X			X
Inside/Outside Supervisor	X	X	X	X	X		X		X
Control Room Supervisor	X	X	X	X	X		X		X
Control Room Operator	X	X	X	X	X	X			X
Inside/Outside Utility Operator	X	X	X		X	X			X
CHB/UPA Supervisor	X	X	X		X	X			X
CHB/UPA Operator	X	X	X		X	X			X
Munitions Transporter	X	X	X		X		X	X	X
TMA Supervisor	X	X	X		X	X			X
TMA Operator	X	X	X		X	X			X
SCWO Supervisor	X	X	X		X	X			X
SCWO Operator	X	X	X		X	X			X
SCWO Control Room Operator	X	X	X		X	X			X
Bulk Chemical Operator	X	X	X		X	X			X
DSA Supervisor	X	X	X		X	X			X
DSA Operator	X	X	X		X	X			X

24915-000-GPE-GGPT-00001 – RESEARCH, DEVELOPMENT, AND DEMONSTRATION (RD&D) PERMIT APPLICATION CDRL #A010

Job Title	New Employee Site Orientation	HAZWOPER – 40 Hr	HAZWOPER –Refresher 8 Hr	HAZWOPER – Supervisor/ Management 8 Hr	First Responder Awareness & Annual Refresher	First Responder Operations & Annual Refresher	Technician Level & Annual Refresher	DOT	RCRA & Annual Refresher
Residue Operators	X	X	X		X		X	X	X
Bin Truck Operator	X	X	X		X	X		X	X
RM Operator	X	X	X		X	X			X
PMB Attendant	X	X	X		X	X			
Maintenance Manager	X	X	X		X	X			X
Maintenance Manager	X	X	X	X	X	X			X
Maintenance Technician	X	X	X		X	X			X
Warehouse Personnel	X	X	X		X		X	X	X
Laboratory Manager	X	X	X	X	X				X
LAB Training Coordinator	X	X	X		X				X
LAB Supply Specialist	X	X	X		X				X
Administrator	X	X	X		X				X
LAB Safety Specialist	X	X	X		X	X			X
Monitoring Branch Manager	X	X	X	X	X	X			X
Deputy Monitoring Branch Manager	X	X	X	X	X	X			X
Monitoring Shift Lead	X	X	X	X	X	X			X
MINICAMS® Technician	X	X	X		X	X			X
DAAMS Technician	X	X	X		X	X			X
Monitoring Instrument Technician	X	X	X		X	X			X
Operations Branch Manager	X	X	X	X	X	X			X
Deputy Operations Branch Manager	X	X	X	X	X	X			X
Wet Chemist	X	X	X		X	X			X
Agent Chemist	X	X	X		X	X			X
Laboratory information management system (LIMS) Administrator/ Specialist	X	X	X		X				
LIMS Information Security and Technology Specialist	X	X	X						
Statistician	X	X	X		X				

24915-000-GPE-GGPT-00001 – RESEARCH, DEVELOPMENT, AND DEMONSTRATION (RD&D) PERMIT APPLICATION CDRL #A010

Job Title	New Employee Site Orientation	HAZWOPER – 40 Hr	HAZWOPER –Refresher 8 Hr	HAZWOPER – Supervisor/ Management 8 Hr	First Responder Awareness & Annual Refresher	First Responder Operations & Annual Refresher	Technician Level & Annual Refresher	DOT	RCRA & Annual Refresher
GC-MSD- Purge and Trap (P&T) Operator	X	X	X		X	X			X
Programmer	X	X	X		X				
Chemical Technician	X	X	X		X	X			X
Data Technician	X	X	X		X				
ICP-MS Operator	X	X	X		X	X			X
HPLC Operator	X	X	X		X	X			X
DSC Operator	X	X	X		X	X			X
Senior Chemist	X	X	X		X	X			X
IC Operator	X	X	X		X	X			X
Operations Shift Lead	X	X	X	X	X	X			X
GC-MSD/FPD Operator	X	X	X		X	X			X
Hazardous Waste Technician	X	X	X		X		X		X
HPLC Operator	X	X	X		X	X			X
Sampling Technician	X	X	X		X	X			X
QA/QC Manager	X	X	X		X				X
Senior QC Specialist	X	X	X		X				X
QC Specialist	X	X	X		X				X

1
2

1
2
3
4
5
6
7
8
9
10
11
12
13
14
15
16
17
18
19
20
21
22
23

7.0 CLOSURE PLAN

(This Page Intentionally Left Blank)

**24915-000-GPE-GGPT-00001 – RESEARCH, DEVELOPMENT, AND DEMONSTRATION (RD&D) PERMIT
APPLICATION CDRL #A010**

1 **7.1 BGCAPP Closure Process**

2 The BGCAPP includes permitted hazardous waste management units (HWMUs) providing
3 container storage, tank storage and treatment, and miscellaneous (Subpart X) treatment.
4 Following elimination of the chemical weapons stockpile at the BGCA by treatment of chemical
5 agents and explosives, the BGCAPP will “clean close” the HWMUs under the provisions of this
6 plan. The objective of “clean closure” is to remove RCRA hazardous wastes from a HWMU to
7 eliminate the possibility of future releases in a manner protective of human health and the
8 environment. The BGCAPP will achieve “clean closure” by removal, demolition, or
9 decontamination of equipment, areas, and facilities.

10 BGCAPP entry into closure activities will include the entire facility and other units at the facility will
11 not continue to operate except to treat or store decontamination residues/solutions and other
12 secondary wastes generated during closure. Therefore, the BGCAPP does not anticipate any
13 partial closures. If partial closures are needed, the BGCAPP will revise the hazardous waste
14 management permit in accordance with 401 KAR 34:070, Section 3 and 40 CFR 264.112.

15 The performance standard (40 CFR 264.111, Closure performance standard) for closure of the
16 facility requires the following:

- 17 1) Minimize need for further maintenance or post closure care
- 18 2) Control, minimize, or eliminate escape of hazardous waste or its constituents from the
19 closed facility to the extent necessary to protect human health and the environment
- 20 3) Comply with the closure provisions of Commonwealth of Kentucky environmental
21 regulations (which incorporate by reference Federal requirements)

22 Specifics for BGCAPP compliance with the performance standard for HWMUs are as follows:

- 23 1) The basis for “clean closure” of HWMUs that have stored or treated “liquid” chemical agent
24 (i.e., HWMUs in the MDB) is disassembly and removal of equipment, and demolition of
25 facilities and structures. BGCAPP closure includes MPT treatment or off-site shipment for
26 treatment and/or disposal of removed materials and equipment. Demolition wastes (from
27 these areas) will be characterized for off-site shipment and shipped to appropriately
28 permitted, commercial TSDFs for further treatment or disposal
- 29 2) The basis for “clean closure” of HWMUs that have not stored or treated “liquid” agent is
30 meeting the regional screening levels (RSLs) for the waste constituent(s) of concern. The
31 final rinse or wipe samples of surfaces within tanks and Subpart X units must be less than
32 RSLs for waste constituents of concern in final rinse samples or non-detect for waste
33 constituents of concern from wipe samples

34 **NOTE:** The term “liquid” chemical agent is used in this section to indicate the storage, treatment,
35 or other management of chemical agent and is used to differentiate from other wastes that
36 may be agent derived but which do not contain detectable agent concentrations
37 (i.e., above those concentrations occurring after treatment at a 99.9999 percent DE).

38 The BGCAPP will treat and/or dispose of closure wastes from waste storage areas and
39 treatment units (i.e., areas and units not contaminated with “liquid” agent) only in a facility
40 approved to accept the waste.

**24915-000-GPE-GGPT-00001 – RESEARCH, DEVELOPMENT, AND DEMONSTRATION (RD&D) PERMIT
APPLICATION CDRL #A010**

1 The BGCAPP will base the clean closure of permitted units on decontamination,
2 disassembly, removal, and/or demolition. The permitted units are separated into two
3 broad groups (i.e., those potentially contaminated with “liquid” agent, and those not
4 contaminated with “liquid” agent), with different closure tasks required for each group. The
5 BGCAPP will perform demolition of HWMUs within the MDB (assumed to have a history of
6 potential contamination with “liquid” agent). The MDB HVAC carbon banks, filters, and
7 ductwork will be demolished with the MDB. The closure of the other permitted systems
8 (i.e., those without a history of contamination with “liquid” agent) will include using
9 decontamination, wipe and rinsate samples, and closure in place if sampling confirms
10 areas/systems can be “clean closed.”

11 **7.2 Procedures to Close**

12 The Army adopted the risk-based worker and community AELs and Acute Exposure Guideline
13 Levels (AELs) for agents (Department of Army Pamphlet 385-61, Toxic Chemical Agent Safety
14 Standards, 17 December 2008). AELs are concentrations for specific exposure durations that
15 reflect health-based risks for chemical agent exposures to humans via inhalation. AELs are
16 concentrations used to assess the health-based risks associated with acute exposures during
17 emergencies.

18 The BGCAPP will use monitoring of airborne concentrations of chemical agents to determine the
19 appropriate level of PPE for BGCAPP closure workers and to ensure the general population is not
20 at risk due to airborne agent concentrations. In areas where monitoring cannot be performed,
21 mathematical modeling will be used. A comparison of the expected agent concentrations to the
22 STEL, WPL, and GPL will be used in making these determinations.

23 **7.2.1 Closure of BGCAPP Permitted HWMUs with History of Possible** 24 **“Liquid” Agent Contamination (i.e., in MDB)**

25 The BGCAPP’s closure objectives include the demolition of areas potentially exposed to agent
26 contamination (e.g., ductwork, plenums, and liquid agent management areas) and the removal of
27 non-agent waste constituents in other waste management areas.

28 The closure of BGCAPP permitted HWMUs in the MDB will be accomplished using removal of
29 equipment and demolition of the entire facility, to include the concrete pad and foundation
30 materials. The BGCAPP will characterize the waste materials resulting from the demolition of the
31 MDB and ship these wastes offsite for disposal in an appropriately permitted, commercial TSDF.
32 The layout of the MDB lends itself to closure in three phases – All areas of the MDB are capable of
33 isolation in terms of power and utilities. The agent systems are equipped with flushing ports to
34 facilitate removal of agent contamination from these systems, and are located only within Category
35 A areas. In addition, the BGCAPP planned and designed the flow of closure and secondary
36 wastes during closure such that the mechanical aids, doorways, and conveyors will be available for
37 the sequencing of these three phases, ultimately leading to RCRA closure of the MDB. Figure 7-1
38 shows the MDB zones or areas in these three closure phases.

39 A brief summary of each phase is as follows:

- 40 1) Phase I will include the western quadrant of the MDB, which includes, but is not limited to,
41 the ECVs, ECRs, MPR, MSR, UPA-1, and the EONC transfer airlocks

**24915-000-GPE-GGPT-00001 – RESEARCH, DEVELOPMENT, AND DEMONSTRATION (RD&D) PERMIT
APPLICATION CDRL #A010**

- 1 2) Phase II will be started while Phase I is being finished. Phase II includes the south central
2 quadrant of the MDB, which includes, but is not limited to, the DPE Corridor, ENS room,
3 secondary heat transfer room, and ANS room
- 4 3) Phase III will be completed after Phase II and will include the balance of the MDB (i.e., the
5 eastern quadrant). This includes, but is not limited to, the MWS room, TMA, airlocks,
6 OTE/OTM area, MPT room, and UPA 2

7 The BGCAPP will take the following steps to release areas and systems in the MDB for demolition:

- 8 1) Certify the MDB (by a qualified PE) and operate under the provisions of 40 CFR 264.1100
9 (Subpart DD) as a containment building. Manage solid items removed from the areas of
10 potential liquid agent contamination within the MDB. The identification and use of the MDB
11 as a containment building allows:
 - 12 a. Management of agent-derived non-liquid hazardous wastes within the MDB outside
13 of containers without labeling
 - 14 b. Increased efficiency of the removal tasks and improved safety of closure workers
 - 15 c. Containerization and removal of closure wastes from within the MDB on a routine
16 schedule to ensure the 90-day limitation imposed by 40 CFR 262.34, Accumulation
17 time, is not exceeded
- 18 2) Dismantle, remove process systems, and characterize the removed items/wastes for offsite
19 shipment and treatment/disposal at a RCRA TSDF
- 20 3) Remove and appropriately dispose of wastes contained within BGCAPP tank systems
21 based upon generator knowledge and analytical waste characterization
- 22 4) Remove and resize RCRA waste management tanks and associated ancillary equipment
23 located within the MDB for processing in the MPT
- 24 5) Characterize the wastes from the removal of the ductwork and HVAC filter units prior to
25 demolition

26 **7.2.2 Closure of BGCAPP Permitted HWMUs without History of “Liquid”**
27 **Agent Contamination (i.e., areas and systems outside the MDB)**

28 In these non-agent HWMUs, the BGCAPP will decontaminate the containment surfaces/equipment
29 and close in place. The BGCAPP will use pressure washing as the primary decontamination
30 method with other decontamination methods used as needed (e.g., steam cleaning and air
31 washing).

32 RCRA decontamination of container storage or treatment of HWMUs not potentially contaminated
33 with “liquid” agent, including the containment systems and sumps, will include the following
34 activities:

- 35 1) Waste removal from the containment area, and disposal of waste at an approved facility
- 36 2) Visual inspection of containment systems
- 37 3) Dry mechanical cleaning of container storage floors and walls (by scraping, vacuuming,
38 and/or sweeping)
- 39 4) Repair of cracks, gaps, or damage to containment, of unsealed areas, and of damage to
40 the liner (caused by previous closure operations) prior to beginning use of liquids for
41 cleaning
- 42 5) Low-volume pressure washing/rinsing (with possible use of non-ionic surfactant detergent,
43 if required)
- 44 6) Two subsequent low-pressure ambient-temperature water rinses

**24915-000-GPE-GGPT-00001 – RESEARCH, DEVELOPMENT, AND DEMONSTRATION (RD&D) PERMIT
APPLICATION CDRL #A010**

- 1 7) Sampling and analysis of final rinsate to confirm effectiveness of RCRA decontamination
- 2 8) If decontamination is not effective, return to low-volume pressure washing step above and
- 3 repeat wash/rinse cycle
- 4 9) Repeat sampling and analysis of final rinsate to determine whether RCRA decontamination
- 5 was effective

6 If decontamination is still not effective after the second waste/rinse cycle, the BGCAPP will develop
7 alternate decontamination methods and inform KDEP of the revised approach.

8 The BGCAPP will demonstrate clean closure of HWMUs without liquid agent contamination by
9 collecting final rinse samples (i.e., for containments) and wipe samples (i.e., from within tanks and
10 Subpart X units). Bases for analyses performed are the waste inventory stored or wastes
11 processed in a given area, and the analyses will take into account the nature of the treatment and
12 spill or release history. SCWO reactors and the MPT provide destructive treatment, and the
13 BGCAPP will not evaluate these units for the presence of organic hazardous wastes but will
14 decontaminate and perform wipe sampling/analysis for inorganic hazardous wastes (e.g., metals)
15 as appropriate. For these HWMUs, achieving “clean closure” will be demonstrated when
16 containment rinse samples are analyzed and do not contain waste constituents above the RSLs;
17 and when wipe samples for tanks and Subpart X units are non-detect for the waste constituents of
18 concern. The waste storage and treatment areas that the BGCAPP will sample and analyze for
19 waste constituent contamination include:

- 20 1) STA and SPB Storage Area
- 21 2) ARS
- 22 3) RO Unit
- 23 4) WTA
- 24 5) WSA
- 25 6) HSA
- 26 7) CHB (only if history indicates agent contamination is potentially present)

27 **7.3 Closure Date & Schedule**

28 Closure of the MDB will include the three phases or MDB areas shown in Figure 7-1. The
29 sequence of closures for the container storage areas facilitates storage of wastes generated during
30 closure activities, with the WTA and WSA closed last. Closure of the other permitted units will
31 follow the path of chemical agent and munitions through the CHB and MDB, with the STA and SPB
32 closed after the MDB but prior to the WTA and WSA. The BGCAPP will update the schedule of
33 closure activities when the BGCAPP notifies KDEP of the closure start (at least 45 days prior to
34 initiation of closure).

35 The current BGCAPP closure schedule indicates closure will exceed two years. The long duration
36 of these closure activities is necessary due to the:

- 37 1) High visibility and toxicity of the wastes being treated at this facility dictating a safe and
- 38 error-free closure, a situation requiring a careful and methodical approach to facility closure
- 39 2) Size and complexity of the facility being closed
- 40 3) Number of units and amount of closure information and data that must be compiled into a
- 41 PE closure certification report

**24915-000-GPE-GGPT-00001 – RESEARCH, DEVELOPMENT, AND DEMONSTRATION (RD&D) PERMIT
APPLICATION CDRL #A010**

1 Figure 7-2 provides a schedule for the BGCAPP closure by area/phase. The BGCAPP will also
2 update the schedule of closure activities when the BGCAPP notifies KDEP of the initiation of
3 closure.

4 **7.4 Disposition of Residues**

5 Hazardous wastes and closure residues may be treated onsite or sent offsite for treatment and/or
6 disposal. These closure wastes and residues will not be disposed onsite and only facilities with
7 appropriate permits will be used to treat or dispose of closure wastes. In addition, metallic wastes
8 that have been treated in the MPT may be recycled. Facilities have not yet been identified for
9 closure waste treatment and disposal contracts due to the number of intervening years before
10 closure begins.

11 **7.5 Quantity of Waste**

12 The maximum waste inventory in storage at the BGCAPP at closure would be the total volume of
13 wastes stored in containers and tanks. The total of 1,766,283 gallons for these units is the
14 maximum hazardous waste inventory for the BGCAPP facility.

15 Table 7-1 provides the maximum waste inventory (by HWMU) remaining at the BGCAPP when
16 closure begins. There will be a maximum of 63,089 gallons of waste remaining in the container
17 storage areas and a maximum of 1,703,194 gallons remaining in storage tanks.

18 **7.6 Procedures to Decontaminate Equipment**

19 The U.S. Army will not formally identify the BGCAPP facility end-state until near the end of agent
20 destruction operations. Therefore, the plan for closure of the entire facility is incomplete.
21 Currently, the BGCAPP plan is to remove the equipment from the MDB and demolish the entire
22 structure, including the concrete foundation and pad. The BGCAPP also plans to decontaminate
23 and leave in place, for transfer to the BGAD, the tank systems associated with the storage of
24 hydrolysate and other permitted structures and associated containments/equipment [i.e., CHB,
25 SPB (to include the Water Recovery System, ARS, and SCWO Reactors), STA, WSA, and WTA].

26 **7.6.1 Criteria for Determining Contamination**

27 The BGCAPP will use two approaches for the closure of BGCAPP hazardous waste management
28 systems and areas. These approaches are:

- 29 1) Wipe and rinse sampling for facilities and structures without a history of “liquid” agent
30 contamination, and continued decontamination until RSL concentrations are attained for
31 closure samples
- 32 2) Disassembly of equipment and demolition of facilities and structures in the MDB where a
33 history of possible “liquid” agent contamination exists

34 Table 7-2 contains the criteria for determining whether contamination exists in a facility without a
35 history of “liquid” agent contamination.

**24915-000-GPE-GGPT-00001 – RESEARCH, DEVELOPMENT, AND DEMONSTRATION (RD&D) PERMIT
APPLICATION CDRL #A010**

7.6.6 Closure of Tank Systems

The RCRA permitted tank systems at the BGCAPP have secondary containments that are lined with impervious materials compatible with the wastes stored in the tank systems. Therefore, contamination of soils beneath the containments is not expected, and the integrity of the containments over the operating life of the facility will be confirmed by review of records and physical inspection. No effort is expected to be required to sample or remove such soils (absent any evidence of a breach in the containment system) and, therefore, the requirements of 40 CFR 264.197(b) for post-closure care would not be applicable and “clean closure” can be certified.

Closure of the BGCAPP MDB tank systems (i.e., systems with a history of possible liquid agent contamination) will require removal of visible waste residues and will be accomplished by flushing and cleaning (i.e., using power washing/steam), followed by visual inspection of tank systems including ancillary equipment and tank interiors. The BGCAPP will remove and treat agent tank systems, tanks, and ancillary equipment in the MPT prior to subsequent offsite treatment and/or disposal. For permitted tank systems (i.e., systems without history of “liquid” agent contamination), the BGCAPP will use generator knowledge (in most instances) to characterize the materials generated during closure and after cleaning and visual inspection, and the BGCAPP will perform wipe sampling for waste constituents to demonstrate the surfaces have been sufficiently decontaminated for closure.

The BGCAPP will remove and demolish MDB containments and tank systems, including ancillary equipment. For tank systems without a history of “liquid” agent contamination (i.e., systems and areas not in the MDB), the BGCAPP will clean the systems prior to rinse sampling of the containments. The basis for BGCAPP closure of these containments is achievement of the RSLs for waste constituents previously stored in these tank systems. These tank systems and containments (outside the MDB) will remain in place after closure of the BGCAPP.

The estimated inventory provided in this section includes a maximum tank storage volume of 1,703,194 gallons. This estimate assumes the hazardous waste quantities in tank storage will be highest as closure begins.

7.6.7 Closure of Subpart X Units

BGCAPP Subpart X units include both those units with a history of possible “liquid” agent contamination (i.e., units in the MDB) and those without a history of “liquid” agent contamination (i.e., units in the SPB). The BGCAPP will apply to these Subpart X units the same criteria and approach used for closure of tanks and container storage areas. This approach includes:

- 1) Wastes and waste constituents will be removed from all Subpart X units (i.e., to include associated air pollution control equipment such as the MPT scrubber)
- 2) Wastes and waste residues will be characterized and shipped off site for appropriate final treatment and/or disposal
- 3) Containments (i.e., in areas other than the MDB) will be cleaned and monitored to determine whether cleaning and decontamination was effective. Containments in the MDB will be demolished and the demolition wastes removed, containerized, and shipped offsite for treatment/disposal
- 4) The BGCAPP will use disassembly, removal, and demolition for units in areas with a history of “liquid” agent contamination, and rinsate and wipe sampling for analysis of units in areas without a history of “liquid” agent contamination (i.e., outside the MDB)

**24915-000-GPE-GGPT-00001 – RESEARCH, DEVELOPMENT, AND DEMONSTRATION (RD&D) PERMIT
APPLICATION CDRL #A010**

- 1 5) The BGCAPP will disassemble the Subpart X units (located within the MDB) and remove
- 2 the waste for shipment offsite to an appropriate facility
- 3 6) Subpart X units outside the MDB will be closed in-place

4 **7.7 Time to Close**

5 Estimates of the MDB closure activity durations indicate it will require more than 2 years for
6 complete closure of the entire BGCAPP facility. The BGCAPP therefore requests KDEP approve a
7 closure schedule of two years for the BGCAPP. The BGCAPP will request (i.e., in accordance with
8 the requirements of 401 KAR 34:070, Section 4(2) and 40 CFR 264.113) an extension to this
9 schedule if the closure requires additional time.

**24915-000-GPE-GGPT-00001 – RESEARCH, DEVELOPMENT, AND DEMONSTRATION (RD&D) PERMIT
APPLICATION CDRL #A010**

1
2**Table 7-1 – Maximum Inventory of Wastes at Beginning of Closure**

Hazardous Waste Management Unit	Location/ Room #	Volume (gal)	Waste Name	Waste Code(s)	Notes
Container Handling Building (CHB)	CHB	0	N/A	N/A	
Waste Storage Area (WSA) – Inside the CLA	WSA	5,500	Secondary Waste and Filter cake	D001, D002, D003, D004, D005, D006, D007, D008, D009, D010, D011, and/or N001	
Waste Transfer Station (WTS) – Outside the CLA	WTS	24,000	Secondary Waste and Filter cake	D001, D002, D003, D004, D005, D006, D007, D008, D009, D010, D011, F001–F005, and/or N001	
Storage in Box Transfer Area, Room 1	07-165	0	N/A	N/A	
Storage in Box Transfer Area, Room 2	07-166	0	N/A	N/A	
Agent Neutralization System (ANS) Storage Area	07-123	0	N/A	N/A	
Tray/Container Transfer Room	07-124	0	N/A	N/A	
Metal Parts Treater (MPT) Cooling Conveyor Storage Area	07-150	8,190	Secondary Waste	D004, D005, D006, D007, D008, D009, D010, D011, and/or N001	
Toxic Maintenance Area (TMA) Storage Area	07-125	5,500	Secondary Waste	D001, D002, D004, D005, D006, D007, D008, D009, D010, D011, F001–F005, and/or N001	

**24915-000-GPE-GGPT-00001 – RESEARCH, DEVELOPMENT, AND DEMONSTRATION (RD&D) PERMIT
APPLICATION CDRL #A010**

Hazardous Waste Management Unit	Location/ Room #	Volume (gal)	Waste Name	Waste Code(s)	Notes
Explosive Containment Vestibule (ECV) Storage Area, ECV-1	07-103	0	N/A	N/A	
Explosive Containment Vestibule (ECV) Storage Area, ECV-2	07-106	0	N/A	N/A	
Unpack Area (UPA) No. 1	07-101	0	N/A	N/A	
Unpack Area (UPA) No. 2	07-128	0	N/A	N/A	
Motor Shipping Room (MSR) Covered Loading Area (for NCRM)	07-167	0	N/A	N/A	
Motor Packing Room (MPR) Storage (for RM)	07-163	0	N/A	N/A	
Explosive Containment Room (ECR) Storage Area No. 1	07-104	0	N/A	N/A	
Explosive Containment Room (ECR) Storage Area No. 2	07-105	0	N/A	N/A	
SCWO Processing Building (SPB) Storage Area	10-102	8,355	Secondary Waste Filter cake Brine	D004, D005, D006, D007, D008, D009, D010, D011, and/or N001	Filter cake and media stored in area at start of closure. Use for storage of closure waste prior to off-site shipment.
Hydrolysate Storage Area (HSA)	HSA	1,457,544	Hydrolysate	D004, D005, D006, D007, D008, D009, D010, D011, and/or N001	Hydrolysate stored at start of closure.

**24915-000-GPE-GGPT-00001 – RESEARCH, DEVELOPMENT, AND DEMONSTRATION (RD&D) PERMIT
APPLICATION CDRL #A010**

Hazardous Waste Management Unit	Location/ Room #	Volume (gal)	Waste Name	Waste Code(s)	Notes
Agent Collection/Toxic Storage Tanks	07-123	0	N/A	N/A	
SCWO Tank Area (STA)	STA	427,073	Brine	D004, D005, D006, D007, D008, D009, D010, D011, and/or N001	Effluent and RO Reject & Permeate stored at the beginning of closure.
Spent Decontamination System (SDS) Tanks	07-123	28,788	Decontamination solutions	D002, and/or N001	Decontamination solutions from the end of operations and beginning of closure.
Agent Neutralization System (ANS)	07-123	0	N/A	N/A	
Energetics Neutralization System (ENS)	07-119	0	N/A	N/A	
Munitions Washout System (MWS)	07-135	0	N/A	N/A	
Nose Closure Removal System (NCRS)	07-104	0	N/A	N/A	
Projectile Mortar/Disassembly Machine (PMD)	07-104	0	N/A	N/A	
Rocket Cutting Machine (RCM) Line 1	07-104	0	N/A	N/A	
Rocket Shear Machine (RSM), Line 1	07-104	0	N/A	N/A	
Rocket Cutting Machine (RCM) Line 2	07-105	0	N/A	N/A	
Rocket Shear Machine (RSM), Line 2	07-105	0	N/A	N/A	

**24915-000-GPE-GGPT-00001 – RESEARCH, DEVELOPMENT, AND DEMONSTRATION (RD&D) PERMIT
APPLICATION CDRL #A010**

Hazardous Waste Management Unit	Location/ Room #	Volume (gal)	Waste Name	Waste Code(s)	Notes
Metal Parts Treater (MPT)	07-146	0	Secondary Waste	D004, D005, D006, D007, D008, D009, D010, D011, and/or N001	Used for treatment of closure generated waste. Waste remaining on conveyor at start of closure and in waste storage area.
Energetics Batch Hydrolyzer (EBH)	07-111	0	N/A	N/A	
Reverse Osmosis (RO) Unit	10-102	0	RO Reject and RO Permeate	D004, D005, D006, D007, D008, D009, D010, D011, and/or N001	Unit continues operation during closure.
Aluminum Filtration System (AFS)	10-102	5,000	Filter cake Brine Neutralized Energetics Hydrolysate	D004, D005, D006, D007, D008, D009, D010, D011, and/or N001	Unit continues operation during closure.
Supercritical Water Oxidation (SCWO) Reactors	10-101	0	Decontamination solutions and wastes	D004, D005, D006, D007, D008, D009, D010, D011, and/or N001	Unit will not store waste, but will continue to operate during closure. Used to treat some decontamination solutions and wastes.

24915-000-GPE-GGPT-00001 – RESEARCH, DEVELOPMENT, AND DEMONSTRATION (RD&D) PERMIT APPLICATION CDRL #A010**Table 7-2 – Clean Closure Criteria for Final Rinse and Soil Samples**

Constituent of Concern	Sample Container	Preservation	Hold Time	SW-846 Test Method ¹	Clean Closure Criteria	
					Soil ³ RSL (ppm)	Tap Water ³ RSL (ppm)
GB				MINICAMS/DAAMS	<1VSL ²	
Arsenic	P	HNO ₃ to pH<2	6 mos.	Method 6020	1.6	0.000045
Barium	P	HNO ₃ to pH<2	6 mos.	Method 6020	190,000.00	7.3
Cadmium	P	HNO ₃ to pH<2	6 mos.	Method 6020	800.0	0.018
Chromium	P	HNO ₃ to pH<2	6 mos.	Method 6020		0.0000000
Lead	P	HNO ₃ to pH<2	6 mos.	Method 6020	800.0	0.0000000
Mercury	P, G	HNO ₃ to pH<2	28 days	Method 6020	34.0	0.00057
Selenium	P	HNO ₃ to pH<2	6 mos.	Method 6020	5,100.00	0.18
Silver	P	HNO ₃ to pH<2	6 mos.	Method 6020	5,100.00	0.18
Acetone	G	Cool to 4 deg. C	7 days	Methods 5031/8260	630,000.00	22.0
Benzene	G	Cool to 4 deg. C	14 days	Methods 5031/8260	5.4	0.00041
2-Butanone (MEK)	G	Cool to 4 deg. C	7 days	Methods 5031/8260	200,000.0	7.1
Carbon disulfide	G	Cool to 4 deg. C	14 days	Methods 5031/8260	3,700.0	1.0
Chloroform	G	Cool to 4 deg. C	14 days	Methods 5031/8260	1.5	0.00019
1,4-Dichlorobenzene	G	Cool to 4 deg. C	14 days	Methods 5031/8260	12.0	0.00043
1,1-Dichloroethylene	G	Cool to 4 deg. C	14 days	Methods 5031/8260	1,100.0	0.34
1,2-Dichloroethylene	G	Cool to 4 deg. C	14 days	Methods 5031/8260	9,200.0	0.33
Ethyl Benzene	G	Cool to 4 deg. C	14 days	Methods 5031/8260	27.0	0.0015
Methanol	G	Cool to 4 deg. C	7 days	Methods 5031/8260	310,000.0	18.0
Methylene Chloride (Dichloromethane)	G	Cool to 4 deg. C	14 days	Methods 5031/8260	53.0	0.0048
Methyl Isobutyl Ketone (MIBK)	G	Cool to 4 deg. C	14 days	Methods 5031/8260	53,000.0	2.0
Nitrobenzene	G	Cool to 4 deg. C	14 days	Methods 5031/8260	24.0	0.00012
Tetrachloroethylene	G	Cool to 4 deg. C	14 days	Methods 5031/8260	2.6	0.00011
Toluene	G	Cool to 4 deg. C	14 days	Methods 5031/8260	2.6	0.00011

24915-000-GPE-GGPT-00001 – RESEARCH, DEVELOPMENT, AND DEMONSTRATION (RD&D) PERMIT APPLICATION CDRL #A010

1

Constituent of Concern	Sample Container	Preservation	Hold Time	SW-846 Test Method ¹	Clean Closure Criteria	
					Soil ³ RSL (ppm)	Tap Water ³ RSL (ppm)
Trichloroethylene	G	Cool to 4 deg. C	14 days	Methods 5031/8260	14.0	0.002
Xylenes	G	Cool to 4 deg. C	14 days	Methods 5031/8260	2,700.00	0.2
Cresol	G	Cool to <6 deg. C and adjust pH to <2 with H ₂ SO ₄ , HCL or NAHSO ₄	14 days	Methods 3510/8041	91,000.00	0.93
Pentachlorophenol	G	Cool to <6 deg. C and adjust pH to <2 with H ₂ SO ₄ , HCL or NAHSO ₄	14 days	Methods 3510/8041	9.0	0.00056
Nitroglycerine	G	Cool to <6 deg. C	40 days	Methods 3535/8095	62.0	0.0037
RDX	G	Cool to <6 deg. C	40 days	Methods 3535/8095		0.000000
TNT	G	Cool to <6 deg. C	40 days	Methods 3535/8095	79.0	0.0022
2,4,6-Trinitrophenyl Methylnitramine	G	Cool to <6 deg. C	40 days	Methods 3535/8095		
Calcium hypochlorite	G	NA	ASAP	Method 9040		5.0-9.0
Sodium hypochlorite	G	NA	ASAP	Method 9040		5.0-9.0
Sodium hydroxide	G	NA	ASAP	Method 9040		5.0-9.0

FOOTNOTES:

¹ EPA= ENVIRONMENTAL PROTECTION AGENCY, SW-846 METHODS.

² Headspace air monitoring for characterization of wastes and areas were described earlier in section 3, monitoring equipment used is either near real-time (MINICAMS®) or laboratory analysis of agent collected on absorbent tube (DAAMS) usually within a few hours of collection. Thus sample container, preservation, or hold time are not at issue. Laboratory procedures developed prior to initial agent operations will provide details of this monitoring.

³ Regional Screening Levels, which have recently been suggested by EPA as replacements for PRG's.

2

**24915-000-GPE-GGPT-00001 – RESEARCH, DEVELOPMENT, AND DEMONSTRATION (RD&D) PERMIT
APPLICATION CDRL #A010**

1 **8.0 FINANCIAL RESPONSIBILITY**

2 **8.1 Financial Assurance for Closure**

3 The Federal government owns the BGCAPP and surrounding property, therefore no financial
4 assurance is necessary.

5 **8.2 Liability Coverage**

6 The Federal government owns the BGCAPP and surrounding property, therefore no liability
7 coverage is necessary.

**24915-000-GPE-GGPT-00001 – RESEARCH, DEVELOPMENT, AND DEMONSTRATION (RD&D) PERMIT
APPLICATION CDRL #A010**

1
2 **9.0 SIGNATORIES**

3 **9.1 Owner Address**

4 The BGCAPP is located on property owned by the Federal government/U.S. Army and the Army
5 organization responsible for managing this property is the BGAD. The signatory for this
6 organization is the Commander of BGAD located at the following address:
7

8
9
10
11
12
13
14
15
16
17
18
19
20
21
22
23
24
25
Commander, Blue Grass Army Depot
431 Battlefield Memorial Highway
Richmond, Kentucky 40475-5901

9 **9.2 Operator Address**

10 The BGCAPP operator is the Bechtel Parsons Blue Grass Team (BPBGT). The responsible
11 signatory for this commercial organization is the General Manager located at the following address:
12

13
14
15
16
17
18
19
20
21
22
23
24
25
Project Manager, Bechtel Parsons Blue Grass
830 Eastern Bypass, Suite 106
Richmond, Kentucky 40475

14 **9.3 Public Notice Information**

15 This application is a revision to the original RD&D Permit application submitted by BGCAPP. The
16 original RD&D Permit Application was presented to the public during a two-hour meeting open to
17 the public on January 22, 2004 between 6 and 8 p.m. The meeting was held at the following
18 location:
19

20
21
22
23
24
25
Carl D. Perkins Conference Center
Eastern Kentucky University
Kit Carson Drive, Richmond, Kentucky

20 In the future, BGCAPP may schedule and hold a public meeting to present this permit application
21 revision (Revision No. 5). However, whether this public meeting will occur and the location, date,
22 and time of this public meeting have not been established.
23
24
25

**Blue Grass Chemical Agent-Destruction Pilot Plant
Resource Conservation and Recovery Act
Research Demonstration & Development Permit Application
Revision 5**



Submitted To:
Energy and Environment Cabinet
Kentucky Department for Environmental Protection
Division of Waste Management
200 Fair Oaks Lane, 2nd Floor
Frankfort, Kentucky 40601

Submitted By:
Blue Grass Army Depot
431 Battlefield Memorial Highway
Richmond, Kentucky 40475-5060
and
Bechtel Parsons Blue Grass
830 Eastern Bypass, Suite 106
Richmond, Kentucky 40475



VOLUME 2

Date: 13 MAR 2014

1
2
3

**24915-000-GPE-GGPT-00001 – RESEARCH, DEVELOPMENT, AND DEMONSTRATION (RD&D) PERMIT
APPLICATION CDRL #A010**

Phase 1 RCRA Drawings

Document	Sheet	Description	Rev	Rev Date	System
24915-00-M6-00-00010	1	NON-FACILITY SPECIFIC SYMBOLS AND LEGEND P AND ID	4	2/4/2012	General
24915-00-M6-00-00011	1	NON-FACILITY SPECIFIC SYMBOLS AND LEGEND P AND ID	4	1/11/2011	General
24915-00-M6-00-00012	1	NON-FACILITY SPECIFIC SYMBOLS AND LEGEND P AND ID	3	2/4/2012	General
24915-00-M6-00-00013	1	NON-FACILITY SPECIFIC SYMBOLS AND LEGEND P AND ID	3	2/4/2012	General
24915-00-M6-00-00014	1	NON-FACILITY SPECIFIC SYMBOLS AND LEGEND P AND ID	3	2/4/2012	General
24915-00-M6-00-00015	1	NON-FACILITY SPECIFIC SYMBOLS AND LEGEND P AND ID	1	10/5/2007	General
24915-07-M5-MPT-00001	1	MDB METAL PARTS TREATMENT PROCESS FLOW DIAGRAM - REVS. A-C WERE 07-M5-TMP-00001	9	9/25/2013	MPT
24915-07-M5-OTM-00001	1	MDB OFFGAS TREATMENT MPT PROCESS FLOW DIAGRAM - REVS. A-C WERE 07-M5-QGM-00001 SHT 1 OF 4	10	9/18/2013	OTM
24915-07-M6-OTM-00001	1	MDB MPT THERMAL OXIDIZER UNIT LN 1 PID	8	5/23/2012	OTM
24915-07-M6-OTM-00002	1	MDB MPT THERMAL OXIDIZER UNIT - LN 2 PID	4	5/23/2012	OTM
24915-07-M6-OTM-00011	1	MDB MPT OFFGAS VENT VALVING PID	7	1/15/2009	OTM
24915-07-M6-OTM-00013	1	MDB SCRUBBER RECIRCULATION COOLERS PID	8	5/23/2012	OTM
24915-07-MVD-SDS-00001	0	SPENT DECON HOLDING-AGENT WASHOUT TREATMENT TANKS MV-SDS-0101, 0201, 0301	2	9/3/2010	SDS
24915-10-M5-SCWO-00001	0	SPB SCWO PROCESS FLOW DIAGRAM - 10 SHEETS	11	8/21/2013	SCWO
24915-10-M6-SCWO-00013	1	SPB HYDROLYSATE BLEND TANK 1 PID	7	9/24/2012	SCWO
24915-10-M6-SCWO-00014	1	SPB OFF-SPEC TANK AND PRESS. RELIEF VESSEL PID	6	9/24/2012	SCWO
24915-10-M6-SCWO-00015	1	SPB HYDROLYSATE BLEND TANK 2 PID	7	9/24/2012	SCWO

**24915-000-GPE-GGPT-00001 – RESEARCH, DEVELOPMENT, AND DEMONSTRATION (RD&D) PERMIT
APPLICATION CDRL #A010**

Document	Sheet	Description	Rev	Rev Date	System
24915-10-M6-SCWO-00016	1	SPB HP AIR DISTRIBUTION PID	6	10/22/2012	SCWO
24915-10-M6-SCWO-00018	1	SPB AGENT-ENRGTCs HYDROLYSATE DIST HDR PID	6	10/22/2012	SCWO
24915-10-M6-SCWO-00019	1	SPB PRESSURE RELIEF HEADERS PID	6	10/22/2012	SCWO
24915-10-M6-SCWO-00020	1	SPB BATCH HYDROLYSATE HOLDING TANK PID	6	9/24/2012	SCWO
24915-10-M6-SCWO-00025	1	SPB CONDENSATE COLLECTION POT PID	6	10/22/2012	SCWO
24915-10-M6-SCWO-00026	1	SPB REACTOR BLOWDOWN AND PRESS RELIEF HDR PID	6	10/22/2012	SCWO
24915-10-M6-SCWO-00029	1	SPB HYROL BATCH TANK HEATER P&ID	4	9/24/2012	SCWO
24915-10-M6-SCWO-00030	1	SPB HYROL BLEND TANK HEATERS 1 AND 2 PID	4	9/24/2012	SCWO
24915-10-M6-SCWO-01012	1	SPB TRAIN 1 QUENCH WATER AND HYDROL FEED PID	7	7/1/2013	SCWO
24915-10-M6-SCWO-01013	1	SPB TRAIN 1 REACTOR PID	7	7/1/2013	SCWO
24915-10-M6-SCWO-01014	1	SPB TRAIN 1 EFFLUENT COOLING PID	7	7/1/2013	SCWO
24915-10-M6-SCWO-01015	1	SPB TRAIN 1 GAS-LIQUID SEPARATION PID	7	7/1/2013	SCWO
24915-10-M6-SCWO-01019	1	SPB TRAIN 1 TOC SAMPLE ANALYZER PID	4	10/22/2012	SCWO
24915-10-M6-SCWO-02012	1	SPB TRAIN 2 QUENCH WATER AND HYDROL FEED PID	4	7/1/2013	SCWO
24915-10-M6-SCWO-02013	1	SPB TRAIN 2 REACTOR PID	4	7/1/2013	SCWO
24915-10-M6-SCWO-02014	1	SPB TRAIN 2 EFFLUENT COOLING PID	4	7/1/2013	SCWO
24915-10-M6-SCWO-02015	1	SPB TRAIN 2 GAS-LIQUID SEPARATION PID	4	7/1/2013	SCWO
24915-10-M6-SCWO-02019	1	SPB TRAIN 2 TOC SAMPLE ANALYZER PID	3	10/22/2012	SCWO
24915-10-M6-SCWO-03012	1	SPB TRAIN 3 QUENCH WATER AND HYDROL FEED PID	4	7/1/2013	SCWO

**24915-000-GPE-GGPT-00001 – RESEARCH, DEVELOPMENT, AND DEMONSTRATION (RD&D) PERMIT
APPLICATION CDRL #A010**

Document	Sheet	Description	Rev	Rev Date	System
24915-10-M6-SCWO-03013	1	SPB TRAIN 3 REACTOR PID	4	7/1/2013	SCWO
24915-10-M6-SCWO-03014	1	SPB TRAIN 3 EFFLUENT COOLING PID	4	7/1/2013	SCWO
24915-10-M6-SCWO-03015	1	SPB TRAIN 3 GAS-LIQUID SEPARATION PID	4	7/1/2013	SCWO
24915-10-M6-SCWO-03019	1	SPB TRAIN 3 TOC SAMPLE ANALYZER PID	3	10/22/2012	SCWO
24915-07-B2-MPT-00001	0	MPT INTERFACE CONNECTION DRAWING – 20 SHEETS	4	7/22/2010	MPT
24915-07-M6-ANS-00020	1	MDB AGENT HYDROLYSATE SAMPLER PID	9	5/16/2011	ANS
24915-07-M6-EBH-00001	1	MDB EBH BLAST DOORS (FIRST LEVEL) P AND ID	4	2/15/2012	EBH
24915-07-M6-EBH-00002	1	MDB EBH BLAST DOORS (SECOND LEVEL) P AND ID	4	2/13/2012	EBH
24915-07-M6-EBH-01005	1	EBH CONDENSATE TANK PID	9	5/6/2010	EBH
24915-07-M6-EBH-01006	1	EBH STM-WTR AND CHILLED SEC. LOOP PID	9	5/6/2010	EBH
24915-07-M6-EBH-01018	1	EBH NITROGEN SUPPLY PID	4	2/3/2009	EBH
24915-07-M6-EBH-01021	1	EBH UNIT 1 FEED VALVES PID	5	5/6/2010	EBH
24915-07-M6-EBH-01022	1	EBH UNIT 2 FEED VALVES PID	5	5/6/2010	EBH
24915-07-M6-EBH-01023	1	EBH UNIT 3 FEED VALVES PID	5	5/6/2010	EBH
24915-07-M6-EBH-01030	1	EBH CAUSTIC HEATER PID	9	5/6/2010	EBH
24915-07-M6-EBH-01035	1	EBH UNIT 1 PID	11	1/31/2013	EBH
24915-07-M6-EBH-01036	1	EBH UNIT 2 PID	7	1/31/2013	EBH
24915-07-M6-EBH-01037	1	EBH UNIT 3 PID	8	1/31/2013	EBH
24915-07-M6-EBH-01085	1	EBH HYDROLYSATE COLLECTION PID	10	5/24/2011	EBH
24915-07-M6-ENS-00001	1	MDB ENR FEED 50 PERCENT CAUSTIC PID	7	7/6/2011	ENS
24915-07-M6-ENS-00025	1	MDB ENR FEED OTE CONDENSATE P&ID	5	5/16/2007	ENS
24915-07-M6-MCS-00001	1	MDB MPT COOLING SYSTEM - LINE 1 PID	6	9/10/2012	MCS
24915-07-M6-MCS-00002	1	MDB MPT COOLING SYSTEM - LINE 2 PID	6	9/10/2012	MCS

**24915-000-GPE-GGPT-00001 – RESEARCH, DEVELOPMENT, AND DEMONSTRATION (RD&D) PERMIT
APPLICATION CDRL #A010**

Document	Sheet	Description	Rev	Rev Date	System
24915-07-M6-OTE-00007	1	MDB EBH SCRUBBER RECIRC PUMP PID	8	2/8/2012	OTE
24915-07-M6-PHS-00051	1	MDB PROJECTILE INPUT CONVEYOR PIPING AND INSTRUMENT DIAGRAM	5	7/6/2009	PHS
24915-07-M6-RHS-00051	1	MDB ROCKET PROCESSING SYSTEM DWG1-LN1 PID	4	8/12/2009	RHS
24915-07-M6-RHS-00052	1	MDB ECV CONVEYOR DWG 1 - LINE 1 PID	5	10/8/2012	RHS
24915-07-M6-RHS-00053	1	MDB ECV CONVEYORS DWG 2 - LINE 1 PID	5	12/22/2010	RHS
24915-07-M6-RHS-00056	1	MDB ROCKET SHEAR MACHINE - LINE 1 PID	7	10/8/2012	RHS
24915-07-M6-RHS-00059	1	MDB ROCKET PROCESSING SYSTEM DWG1-LN2 PID	4	8/12/2009	RHS
24915-07-M6-RHS-00060	1	MDB ECV CONVEYORS DWG 1 - LINE 2 PID	6	10/8/2012	RHS
24915-07-M6-RHS-00061	1	MDB ECV CONVEYORS DWG 2 - LINE 2 PID	7	10/8/2012	RHS
24915-07-M6-RHS-00064	1	MDB ROCKET SHEAR MACHINE - LINE 2 PID	7	10/8/2012	RHS
24915-07-M6-RHS-00069	1	MDB SFT BOX LOAD CONVEYOR PIPING AND INSTRUMENT DIAGRAM	2	3/1/2007	RHS
24915-07-M6-RHS-00070	1	MDB MOTOR BOX LOAD AND BUFFER CONVEYORS PID	3	8/12/2009	RHS
24915-07-M6-RHS-00071	1	MDB BUFFER AND TRANSFER CONVEYORS P&ID	2	3/1/2007	RHS
24915-07-M6-RHS-00072	1	MDB MONITORING AIRLOCK AND CONVEYOR PID	6	10/8/2012	RHS
24915-07-M6-RHS-00074	1	MDB FULL CONTAINER OUTPUT CONVEYOR P&ID	2	3/1/2007	RHS
24915-07-M6-RHS-00075	1	MDB MOTOR-SFT EMPTY BOX INPUT CONVEYOR P&ID	2	3/1/2007	RHS
24915-07-M6-RHS-00076	1	MDB MPR INLET AIRLOCK AND CONVEYOR PID	6	10/8/2012	RHS
24915-07-M6-RHS-00077	1	MDB RSM-1 HYDRAULIC SYSTEM SHT-1 P&ID	3	10/8/2012	RHS
24915-07-M6-RHS-00078	1	MDB RSM-1 HYDRAULIC SYSTEM SHT-2 P&ID	2	10/8/2012	RHS

**24915-000-GPE-GGPT-00001 – RESEARCH, DEVELOPMENT, AND DEMONSTRATION (RD&D) PERMIT
APPLICATION CDRL #A010**

Document	Sheet	Description	Rev	Rev Date	System
24915-07-M6-RHS-00079	1	MDB RSM-2 HYDRAULIC SYSTEM SHT-1 P&ID	2	10/8/2012	RHS
24915-07-M6-RHS-00080	1	MDB RSM-2 HYDRAULIC SYSTEM SHT-2 P&ID	2	10/8/2012	RHS
24915-07-M6-RHS-00081	1	MDB RCM CUTTER AND TABLE ASSEMBLY LN-1 PID	5	10/8/2012	RHS
24915-07-M6-RHS-00082	1	MDB RCM SFT REMOVAL ASSEMBLY LN-1 PID	5	10/8/2012	RHS
24915-07-M6-RHS-00083	1	MDB RCM ROTATING CONVEYOR LN-1 PID	4	10/8/2012	RHS
24915-07-M6-RHS-00084	1	MDB RCM CUTTER AND TABLE ASSEMBLY LN-2 PID	3	10/8/2012	RHS
24915-07-M6-RHS-00085	1	MDB RCM SFT REMOVAL ASSEMBLY LN-2 PID	4	10/8/2012	RHS
24915-07-M6-RHS-00086	1	MDB RCM ROTATING CONVEYOR LN-2 PID	4	10/15/2012	RHS
24915-07-M6-SDS-00010	1	MDB SPENT DECON SAMPLER PIPING AND INSTRUMENT DIAGRAM	10	8/8/2012	SDS
24915-07-M6-SDS-00011	1	MDB CAT-A SUMP PUMPS DISTRIBUTION HDR PIPING AND INSTRUMENT DIAGRAM	3	3/12/2007	SDS
24915-07-M6-SDS-00012	1	MDB CAT-B SUMP PUMPS DISTRIBUTION HDR PIPING AND INSTRUMENT DIAGRAM	5	4/14/2011	SDS
24915-07-M6-SDS-00013	1	MDB CAT-C SUMP PUMPS DISTRIBUTION HDR PIPING AND INSTRUMENT DIAGRAM	4	6/10/2009	SDS
24915-07-M6-THS-00001	1	MDB TMA LOAD AND INPUT AIRLOCK/CONVEYOR PID	7	2/27/2012	THS
24915-07-M6-THS-00002	1	MDB TMA TRANSFER CONVEYORS PID	7	2/27/2012	THS
24915-07-M6-THS-00004	1	MDB TMA OUTPUT AIRLOCK/CONVEYOR PID	6	2/27/2012	THS
24915-07-M6-THS-00005	1	MDB TURNTABLE CONVEYOR NO. 3 PID	5	1/24/2012	THS
24915-07-M6-THS-00006	1	MDB MPT BUFFER CONVEYOR PID	5	2/27/2012	THS
24915-07-M6-THS-00007	1	MDB TURNTABLE CONVEYOR NO. 2 PID	5	1/24/2012	THS
24915-07-M6-THS-00008	1	MDB TRAY INUPT CONVEYORS PID	3	7/23/2009	THS
24915-07-M6-THS-00009	1	MDB TRAY INPUT AIRLOCK/CONVEYOR NO. 1 PID	6	2/27/2012	THS

**24915-000-GPE-GGPT-00001 – RESEARCH, DEVELOPMENT, AND DEMONSTRATION (RD&D) PERMIT
APPLICATION CDRL #A010**

Document	Sheet	Description	Rev	Rev Date	System
24915-07-M6-THS-00010	1	MDB TRAY TRANSFER CONVEYOR PID	5	2/27/2012	THS
24915-07-M6-THS-00011	1	MDB TRAY INPUT AIRLOCK/CONVEYOR NO. 2 PID	5	2/27/2012	THS
24915-07-M6-THS-00012	1	MDB PROJECTILE BUFFER CONVEYOR PID	5	2/27/2012	THS
24915-07-M6-THS-00013	1	MDB TURNTABLE CONVEYOR NO. 1 PID	4	1/24/2012	THS
24915-07-M6-THS-00015	1	MDB RESIDUE BUFFER CONVEYOR PID	5	2/27/2012	THS
24915-07-M6-THS-00016	1	MDB MWS INPUT AIRLOCK/CONVEYOR PID	6	2/27/2012	THS
24915-07-M6-THS-00019	1	MDB TRAY TRANSFER COOLING CONVEYOR LN 1 PID	5	2/27/2012	THS
24915-07-M6-THS-00020	1	MDB TRAY TRANSFER COOLING CONVEYOR LN 2 PID	5	2/27/2012	THS
24915-07-M6-THS-00021	1	MDB TRAY BUFFER COOLING CONVEYORS PID	3	2/27/2012	THS
24915-07-MTD-ACS-00001	0	AGENT HOLDING TANK MT-ACS-0105	1	11/3/2009	ACS
24915-07-MTD-ACS-00002	0	AGENT SURGE TANK MT-ACS-0106	1	11/3/2009	ACS
24915-07-MTD-ANS-00001	0	AGENT HYDROLYSATE SAMPLING TANKS MT-ANS-0103, 0203, 0303	2	11/12/2009	ANS
24915-10-DB-00-00014	1	SPB PERIMETER FOOTINGS AND SLAB SECTIONS AND DETAILS	2	9/24/2012	SPB
24915-10-DBC-00-00004	0	GAS BOTTLE CANOPY, SUPPORT, EQUIPMENT AND MISC FDN CALCS (SPB)	D	2/1/2010	SPB
24915-10-M6-RO-00007	1	SPB MULTIMEDIA FILTERS PID	2	8/6/2011	RO
24915-10-M6-RO-00008	1	SPB MULTIMEDIA FILTERS PID	2	8/6/2011	RO
24915-10-M6-RO-00017	1	SPB RO PERMEATE PUMPS PID	2	8/25/2009	RO
24915-10-M6-RO-00021	1	SPB SCWO EFFLUENT CAUSTIC DAY TK AND PUMP PID	3	5/22/2012	RO
24915-10-M6-RO-00022	1	SPB CANISTER FILTER AND RO UNIT 0101 PID	3	8/6/2011	RO
24915-10-M6-RO-00023	1	SPB CANISTER FILTER AND RO UNIT 0201 PID	3	8/6/2011	RO
24915-10-M6-RO-00024	1	SPB CANISTER FILTER AND RO UNIT 0301 PID	3	8/6/2011	RO
24915-10-M6-SCWO-00021	1	SPB SOLID FEED ADDITIVES PID	7	4/26/2012	SCWO


**24915-000-GPE-GGPT-00001 – RESEARCH, DEVELOPMENT, AND DEMONSTRATION (RD&D) PERMIT
APPLICATION CDRL #A010**

Document	Sheet	Description	Rev	Rev Date	System
24915-10-M6-SCWO-00022	1	SPB HCL AND NAOH FEED ADDITIVES PID	6	1/26/2012	SCWO
24915-10-M6-SCWO-00023	1	SPB H2SO4 FEED ADDITIVES PID	6	1/26/2012	SCWO
24915-10-M6-SCWO-00024	1	SPB FLUSH WATE HEATER PID	5	1/26/2012	SCWO
24915-10-M6-SCWO-00027	1	SPB GAS EFFLUENT DUCT HEATER PID	5	10/22/2012	SCWO
24915-10-M6-SCWO-01011	1	SPB TRAIN 1 REACTOR FUEL FEED PID	7	7/1/2013	SCWO
24915-10-M6-SCWO-01016	1	SPB TRAIN 1 GAS ANALYZER SYSTEM PID	6	1/26/2012	SCWO
24915-10-M6-SCWO-01017	1	SPB TRAIN 1 FEED WATER AND PREHEATER PID	7	7/1/2013	SCWO
24915-10-M6-SCWO-02011	1	SPB TRAIN 2 REACTOR FUEL FEED PID	4	7/1/2013	SCWO
24915-10-M6-SCWO-03011	1	SPB TRAIN 3 REACTOR FUEL FEED PID	4	7/1/2013	SCWO
24915-11-DBC-00-00002	0	HSA MAT FOUNDATION CONTAINMENT CAPACITY EVALUATION	C	7/12/2012	HSS
24915-11-M6-HSS-00006	1	HSA ORG HYDRO PUMPS AND SUMP PUMP TR-1 PID	5	6/11/2012	HSS
24915-11-M6-HSS-00009	1	HSA ORGANIC HYDROLYSATE PUMPS TRAIN 2 PID	3	6/12/2012	HSS

1
2
3

<p>8 NAMING CONVENTIONS DRAWING NUMBERS (NOTE 1)</p> <p>24915-07-M6-MPTC-00001</p> <p>BGCAPP PROJECT NUMBER FACILITY CODE DOCUMENT TYPE SYSTEM LOCATOR DRAWING SEQUENTIAL NUMBER</p>	<p>7 PIPING IDENTIFICATION</p> <p>07-CHPS-1001-2"-W-HC</p> <p>EMBEDDED FACILITY CODE (NOT VISIBLE) FLUID SERVICE CODE SEQUENCE NUMBER LINE SIZE PIPING MATERIAL CLASS</p> <p>INSULATION CODE (IF APPLICABLE) PP- PERSONNEL PROTECTION HC- HEAT CONSERVATION EM- EXPANDED METAL ET- ELECTRIC TRACE IC- INSULATION COLD</p>	<p>5 FLUID SERVICE CODES</p> <ul style="list-style-type: none"> ACS - AGENT ACSD - DILUTED AGENT ACSH - AGENT HYDROLYSATE SAMPLE AF - ANTI-FOAM CHEMICAL INJECTION AG - ANALYZER GAS AN - ACID INJECTION ANH - AGENT NEUTRALIZATION HYDROLYSATE ANT - ANTI-SCALE CHEMICAL INJECTION ATM - ATMOSPHERIC REFERENCE AIR BFW - BOILER FEED WATER BH - BLENDED HYDROLYSATE BIS - BISULFITE CHEMICAL INJECTION BLCH - SODIUM HYPOCHLORITE SOLUTION (5.5% BLEACH) BR - BROWN CA - COMBUSTION AIR CAS - COMPRESSED AIR CHR - HVAC CHILLED WATER RETURN CHS - HVAC CHILLED WATER SUPPLY CHPR - PROCESS CHILLED WATER RETURN CHPS - PROCESS CHILLED WATER SUPPLY CI - CHEMICAL INJECTION CP - COAGULANT AND POLYMER CHEMICAL INJECTION CSW - COLD HP SCWO FEED WATER CU - CLARIFIER UNDERFLOW CWPR - PROCESS COOLING WATER RETURN CWPS - PROCESS COOLING WATER SUPPLY DCN - DECON SOLUTION (1% CAUSTIC OR 5.5% NaOCL) DMWL - LOW PRESSURE DEMINERALIZED WATER DMWH - HIGH PRESSURE DEMINERALIZED WATER (600 PSIG) DS - DUNNAGE SLURRY ECB - EVAPORATIVE COOLER BLOWDOWN EH - ENERGETICS HYDROLYSATE ENH - ENERGETICS NEUTRALIZATION HYDROLYSATE EV - EVAPORATOR/CRYSTALLIZER VAPOR FG - FLUE GAS FOR - FUEL OIL RETURN FOS - FUEL OIL SUPPLY FFW - FILTER PRESS WATER (FROM FILTER PRESS) FWS - FIRE WATER (SUPPLY) GEA - GAS EFFLUENT ANALYSIS HCH - HYPOCHLORITE CHEMICAL INJECTION HCL - HYDROCHLORIC ACID HCSE - HIGH PRESSURE (HP) COOLED SCWO EFFLUENT HE - HELIUM HHSE - HOT HP SCWO EFFLUENT HPA - HIGH PRESSURE AIR HPAF - HP AIR FOR SCWO FEED/PURGE HPAR - HP AIR TO REACTOR HPCD - HP AIR RECEIVER CONDENSATE HPCS - HP CARBON SLURRY HPF - HP FUEL HPGE - HP GAS EFFLUENT HPH - HP HYDROLYSATE HPHR - HIGH PRESSURE HYDRAULIC FLUID RETURN HPHS - HIGH PRESSURE HYDRAULIC FLUID SUPPLY HLRL - HP LIQUID RELIEF HPPA - HP PURGE AIR HPQW - HP QUENCH WATER HPRB - HP REACTOR BLOWDOWN HPRL - HP RELIEF HEADERS/LINES HSFW - HOT HP SCWO FEED WATER HWR - HVAC HOT WATER RETURN HWS - HVAC HOT WATER SUPPLY HWPR - PROCESS HOT WATER RETURN HWPS - PROCESS HOT WATER SUPPLY HYD - HYDROGEN GAS HYPD - HYDRAULIC FLUID DRAIN HYPR - HYDRAULIC FLUID RETURN HYPS - HYDRAULIC FLUID SUPPLY IA - INSTRUMENT AIR IPA - ISOPROPYL ALCOHOL LCSE - LOW PRESSURE SCWO EFFLUENT LOR - LUBE OIL RETURN LOS - LUBE OIL SUPPLY LPCC - LOW PRESSURE AIR COMPRESSOR/ RECEIVER CONDENSATE LPCS - LOW PRESSURE CARBON SLURRY LPGE - LOW PRESSURE GAS EFFLUENT LPH - LOW PRESSURE AGENT HYDROLYSATE LPQW - LOW PRESSURE QUENCH WATER LPRH - LOW PRESSURE RELIEF HEADER LSS - LIFE SUPPORT AIR LW - LAB WASTE MPTC - METAL PARTS TREATER CONDENSATE MWW - HIGH PRESSURE (11,000 PSIG) WASHOUT WATER NAH - 50% CAUSTIC NAHL - 1% CAUSTIC NAHM - 18% CAUSTIC NCD - NON-CONTAMINATED DRAIN NG - NATURAL GAS NIG - NITROGEN GAS (80 PSIG) NITM - NITROGEN GAS (240 PSIG) NIL - NITROGEN LIQUID NITH - NITROGEN GAS (400 PSIG) ONH - OFF-NORMAL HYDROLYSATE OSE - OFF-SPEC EFFLUENT OTE - EBH/HDC/ENS OFFGAS OTEC - OTE CONDENSATE OTM - MPT/ANS OFFGAS PHC - pH CORRECTION CHEMICAL INJECTION PHOS - PHOSPHORIC ACID PLA - PLANT AIR PLW - PLANT WATER PLWH - HIGH PRESSURE PLANT WATER PMW - PMB WASTE WATER POT - POTABLE WATER POTT - TEMPERED POTABLE WATER PWS - PROCESS WATER RA - ROOM AIR RAH - ROOM AIR HOT ROP - REVERSE OSMOSIS PERMEATE ROR - REVERSE OSMOSIS REJECT RW - RECOVERED WATER SAN - SANITARY SEWER (WATER) SAS - SULFURIC ACID SCS - SPENT CARBON SOLUTION SCWE - SCWO EFFLUENT SCWF - SCWO BLENDED HYDROLYSATE FEED SCWW - SCWO WATER SDS - SPENT DECONTAMINATION SOLUTION SEG - SCRUBBER EXHAUST GAS SHTR - SECONDARY HEAT TRANSFER RETURN SHTS - SECONDARY HEAT TRANSFER SUPPLY SPB - SOFTENER REGENERATION WASTE STREAM SSW - SPB SOFTENED WATER STM - STEAM STMB - STEAM BOILER BLOWDOWN STMC - STEAM CONDENSATE STMH - SUPER HEATED STEAM USW - UB SOFTENED WATER 	<p>4 MISCELLANEOUS ABBREVIATIONS</p> <ul style="list-style-type: none"> A/M - AUTOMATIC/MANUAL AG - ABOVEGROUND AHU - AIR HANDLING UNIT ASD - ADJUSTABLE SPEED DRIVER ATM - ATMOSPHERE CAM - CAVITY ACCESS MACHINE CO - CLEANOUT COS - CHANGEOVER STATION CS - CAR SEALED CLOSED CSO - CAR SEALED OPEN CTA - COMMONTROUBLE ALARM DE - DE-ENERGIZED DEO - DE-ENERGIZED OPEN DIF - DIFFERENTIAL EL - ELEVATION EO - ENERGIZED OPEN ET - ELECTRIC TRACED F/S/R - FORWARD/STOP/REVERSE FC - FAIL CLOSED FCS - FACILITY CONTROL SYSTEM FDC - FLOOR DRAIN CONTAMINATED FDMC - FLOOR DRAIN NON-CONTAMINATED FL - FAIL LAST POSITION FO - FAIL OPEN FP - FULL PORT FPFS - FACILITY PROTECTION SYSTEM FV - FULL VACUUM FWD - FORWARD HC - HOSE CONNECTION HPV - HIGH POINT VENT ID - INSIDE DIAMETER LC - LOCKED CLOSED LPD - LOW POINT DRAIN LO - LOCKED OPEN LOR - LOCAL OFF/REMOTE LT - LOCKED THROTTLED MAINT BP - MAINTENANCE BY-PASS MH - MANHOLE (SEWER/SUMP) MOV - MOTOR OPERATED VALVE MW - MANWAY (VESSELS) NC - NORMALLY CLOSED NNF - NORMALLY NO FLOW NO - NORMALLY OPEN O/C - OPEN/CLOSE REV - REVERSE S/S - START/STOP S/C - SAMPLE CONNECTION S/D - SHUTDOWN SO - STEAMOUT SP - SET POINT ST - STEAM TRACED STD - STANDARD STM - STEAM THD - THREADED CONNECTION TSD - TIGHT SHUTOFF T-T - TANGENT-TO-TANGENT TW - THERMOWELL TYP - TYPICAL U/D - UP/DOWN UC - UTILITY CONNECTION UG - UNDERGROUND US - UTILITY STATION VB - VORTEX BREAKER VIB - VIBRATION VFD - VARIABLE FREQUENCY DRIVE Z - S/D BY FPS * - VENDOR SUPPLIED 	<p>GENERAL NOTES:</p> <ol style="list-style-type: none"> REFER TO SDN-24915-000-GPP-GE-00004 FOR DOCUMENT NUMBERING INSTRUCTIONS. INFORMATION ON DOCUMENT TYPE, SYSTEM LOCATOR AND FACILITY CODE ARE PROVIDED IN THE SDN. DELETED. AGENT CONTAMINATION CATEGORY AREAS: <ul style="list-style-type: none"> A- AREAS THAT HAVE ROUTINE CONTAMINATION, EITHER LIQUID OR VAPOR. B- AREAS WITH HIGH PROBABILITY OF AGENT VAPOR CONTAMINATION RESULTING FROM ROUTINE OPERATIONS. C- AREAS WITH LOW PROBABILITY OF AGENT VAPOR CONTAMINATION. D- AREAS THAT ARE UNLIKELY TO EVER HAVE AGENT CONTAMINATION. E- AREAS KEPT FREE OF ANY CHANCE OF AGENT CONTAMINATION BARRING A MAJOR EVENT. DELETED. ELECTRIC TRACING WILL INDICATE REQUIRED TEMPERATURE IF OTHER THAN 40°F (FREEZE PROTECTION). INSULATION/ELECTRIC TRACING FOR PUMPS/COMPRESSORS/ROTATING EQUIPMENT SHALL BE CONSISTENT WITH CORRESPONDING SUCTION AND DISCHARGE LINES. FOR TERMINATION OF ELECTRIC HEAT TRACING NEAR WALL PENETRATIONS, SEE THE ELECTRICAL HEAT TRACING PLAN. 	
<p>6 DOCUMENT TYPE (NOTE 1)</p> <p>M2 CATALYST & CHEMICAL SUMMARY M4 HEAT AND MATERIAL BALANCE M5 FLOW DIAGRAM M6 P&ID M1 MATERIAL HANDLING M0 MULTIPURPOSE DRAWING</p>	<p>PROCESS FLOW</p> <p>MAN PROCESS FLOW SECONDARY PROCESS FLOW ELECTRIC TRACING (NOTE 5)</p>	
<p>5 EQUIPMENT NUMBERS</p> <p>07-MP-MPTC-0001A</p> <p>FACILITY CODE COMPONENT IDENTIFIER SYSTEM LOCATOR SEQUENCE NUMBER SUFFIX</p>	<p>P&ID CONNECTORS</p> <p>OFF PAGE PIPING CONNECTORS OPEN DRAIN</p>	
<p>4 VALVE NUMBERS</p> <p>VALVE (MANUAL OR CHECK) SEQUENCE NUMBER SUFFIX FOR MULTIPLE TRAINS SECONDARY SUFFIX FOR TRAINS WITHIN MULTIPLE TRAINS</p> <p>V 14 A A</p> <p>VALVE SIZE IS THE LINE SIZE, OR IS SHOWN ON THE P&ID. VALVE SEQUENCE NUMBERS FOR EACH FACILITY (BLDG OR AREA) WILL START AT V1, V2, ETC. AND WILL BE UNIQUE FOR EACH FACILITY FOR FULL DESCRIPTION OF VALVE NUMBERING PROCEDURE, SEE STANDARD COMPONENT NUMBERING PROCEDURE, SDN-24915-000-GPP-GE-00003</p>	<p>BOUNDARIES</p> <p>BREAK POINT</p> <p>TYPES OF BOUNDARIES: PIPE CLASS CHANGE QUALITY LEVEL SEISMIC CATEGORY AGENT CONTAMINATION CATEGORY AREA CLOSURE WASTE TYPE CLOSURE WASTE PACKAGE NO. SYSTEM TURNOVER NO. OP MAINT PACKAGE DIV OF RESPONSIBILITY INTERFACE & OTHER (e.g. VENDOR) ABOVE GROUND/BELOW GROUND ROOM NAME ROOM NUMBER</p>	
<p>3 IN LINE/SPECIALTY COMPONENT NUMBERS</p> <p>PIPING SPECIALTY NUMBERS</p> <p>PREFIX SEQUENCE NUMBER SUFFIX FOR MULTIPLE TRAINS SECONDARY SUFFIX FOR TRAINS WITHIN MULTIPLE TRAINS</p> <p>SC 12 A A</p> <p>EACH PIPING SPECIALTY ITEM SHALL HAVE ONE OF THE FOLLOWING PREFIXES: SC- HOSE, HOSE CONNECTIONS SH- ENGINEERED SUPPORTS SJ- EXPANSION JOINTS SN- FOR ANY KIND OF STRAINER SM- FOR ALL OTHER MISCELLANEOUS PIPING SPECIALTY ITEMS</p> <p>EACH PIPING SPECIALTY ITEM NUMBER IS UNIQUE AND WILL NOT BE REPEATED REGARDLESS OF THE FACILITY CODE FOR FULL DESCRIPTION OF PIPING SPECIALTY ITEM NUMBERING PROCEDURE, SEE STANDARD COMPONENT NUMBERING PROCEDURE, SDN-24915-000-GPP-GE-00003</p>	<p>BOUNDARIES</p> <p>VENDOR/MODULE PACKAGE</p> <p>RESPONSIBILITY BOUNDARY (RICHMOND/PASCO, RICHMOND/GA, ETC.) BUILDING/AREA BOUNDARY EQUIPMENT/PIPING/INSTRUMENTS SHOWN IN PHANTOM ARE SHOWN ON ANOTHER DRAWING</p> <p>TIE-IN POINT (NEW PIPE TO EXISTING PIPE)</p>	
<p>2 MODULE NUMBERS</p> <p>07-MX-ENS-0101</p> <p>FACILITY CODE COMPONENT GROUP CODE SYSTEM LOCATOR SEQUENCE NUMBER</p> <p>FOR FULL DESCRIPTION OF MODULE NUMBERING PROCEDURE, SEE STANDARD COMPONENT NUMBERING PROCEDURE, SDN-24915-000-GPP-GE-00003</p>	
<p>1 NAMING CONVENTIONS DRAWING NUMBERS (NOTE 1)</p> <p>24915-07-M6-MPTC-00001</p> <p>BGCAPP PROJECT NUMBER FACILITY CODE DOCUMENT TYPE SYSTEM LOCATOR DRAWING SEQUENTIAL NUMBER</p>				<p>BASED ON PUEBLD P&ID 24852-M6-M00-M0001 REV. B</p> <p>REFERENCE DRAWINGS</p> <table border="1"> <tr> <th>NO.</th> <th>DATE</th> <th>DESCRIPTION</th> <th>DR</th> <th>CK</th> <th>DL</th> <th>PE</th> <th>APVD</th> </tr> <tr> <td>23</td> <td>01/31/12</td> <td>IFC, INCORPORATED DCN-350 & -696</td> <td>JP</td> <td>JLL</td> <td>PEB</td> <td>JB</td> <td>BBB</td> </tr> <tr> <td>24</td> <td>10/04/07</td> <td>IFC, ADDED NOTE 6, UPDATED SYMBOLS, CHGD Q LEVEL</td> <td>JP</td> <td>JLL</td> <td>PEB</td> <td>JB</td> <td>TAV</td> </tr> <tr> <td>25</td> <td>05/10/06</td> <td>ISSUED FOR DESIGN (IFD), ADD DESIGN DEVELOPMENT</td> <td>JP</td> <td>JSM</td> <td>PEB</td> <td>JB</td> <td>BBB</td> </tr> <tr> <td>26</td> <td>10/31/05</td> <td>IFD INCORPORATE DESIGN DEVELOPMENT</td> <td>RJ</td> <td>JLL</td> <td>PEB</td> <td>JB</td> <td>PCK</td> </tr> <tr> <td>27</td> <td>01/10/05</td> <td>ISSUED FOR DESIGN (IFD)</td> <td>JP</td> <td>EW</td> <td>PEB</td> <td>JB</td> <td>JU</td> </tr> </table> <p>QUALITY <input type="checkbox"/> Non-0 <input checked="" type="checkbox"/> Non-0</p> <p>BECHTEL PARSONS BLUE GRASS</p> <p>DDO PROGRAM MANAGER FOR ASSEMBLED CHEMICAL WEAPONS ASSESSMENT EDWOOD, MARYLAND</p> <p>US ARMY ENGINEERING AND SUPPORT CENTER, HUNTSVILLE, ALABAMA</p> <p>BLUE GRASS CHEMICAL AGENT DESTRUCTION PILOT PLANT PROJECT (BGCAPP) RICHMOND, KENTUCKY DAAA09-03-D-0023</p> <p>CONTRACT NO. BGCAPP - NON FACILITY SPECIFIC SYMBOLS AND LEGEND PIPING & INSTRUMENT DIAGRAM</p> <p>DRAWING NUMBER SHEET REV 24915-00-M6-00-00010 1 OF 1 4</p> <p>DRAWING CONTAINS PE SEAL ORIGINAL ON FILE</p> <p>PROFESSIONAL STAMP</p>	NO.	DATE	DESCRIPTION	DR	CK	DL	PE	APVD	23	01/31/12	IFC, INCORPORATED DCN-350 & -696	JP	JLL	PEB	JB	BBB	24	10/04/07	IFC, ADDED NOTE 6, UPDATED SYMBOLS, CHGD Q LEVEL	JP	JLL	PEB	JB	TAV	25	05/10/06	ISSUED FOR DESIGN (IFD), ADD DESIGN DEVELOPMENT	JP	JSM	PEB	JB	BBB	26	10/31/05	IFD INCORPORATE DESIGN DEVELOPMENT	RJ	JLL	PEB	JB	PCK	27	01/10/05	ISSUED FOR DESIGN (IFD)	JP	EW	PEB	JB	JU
NO.	DATE	DESCRIPTION	DR	CK	DL	PE	APVD	
23	01/31/12	IFC, INCORPORATED DCN-350 & -696	JP	JLL	PEB	JB	BBB	
24	10/04/07	IFC, ADDED NOTE 6, UPDATED SYMBOLS, CHGD Q LEVEL	JP	JLL	PEB	JB	TAV	
25	05/10/06	ISSUED FOR DESIGN (IFD), ADD DESIGN DEVELOPMENT	JP	JSM	PEB	JB	BBB	
26	10/31/05	IFD INCORPORATE DESIGN DEVELOPMENT	RJ	JLL	PEB	JB	PCK	
27	01/10/05	ISSUED FOR DESIGN (IFD)	JP	EW	PEB	JB	JU	

02/01/12
DESIGN FILE: D05SPEC
PLOTTED BY: USER ON DATE: 02/01/12 AT 11:56 AM

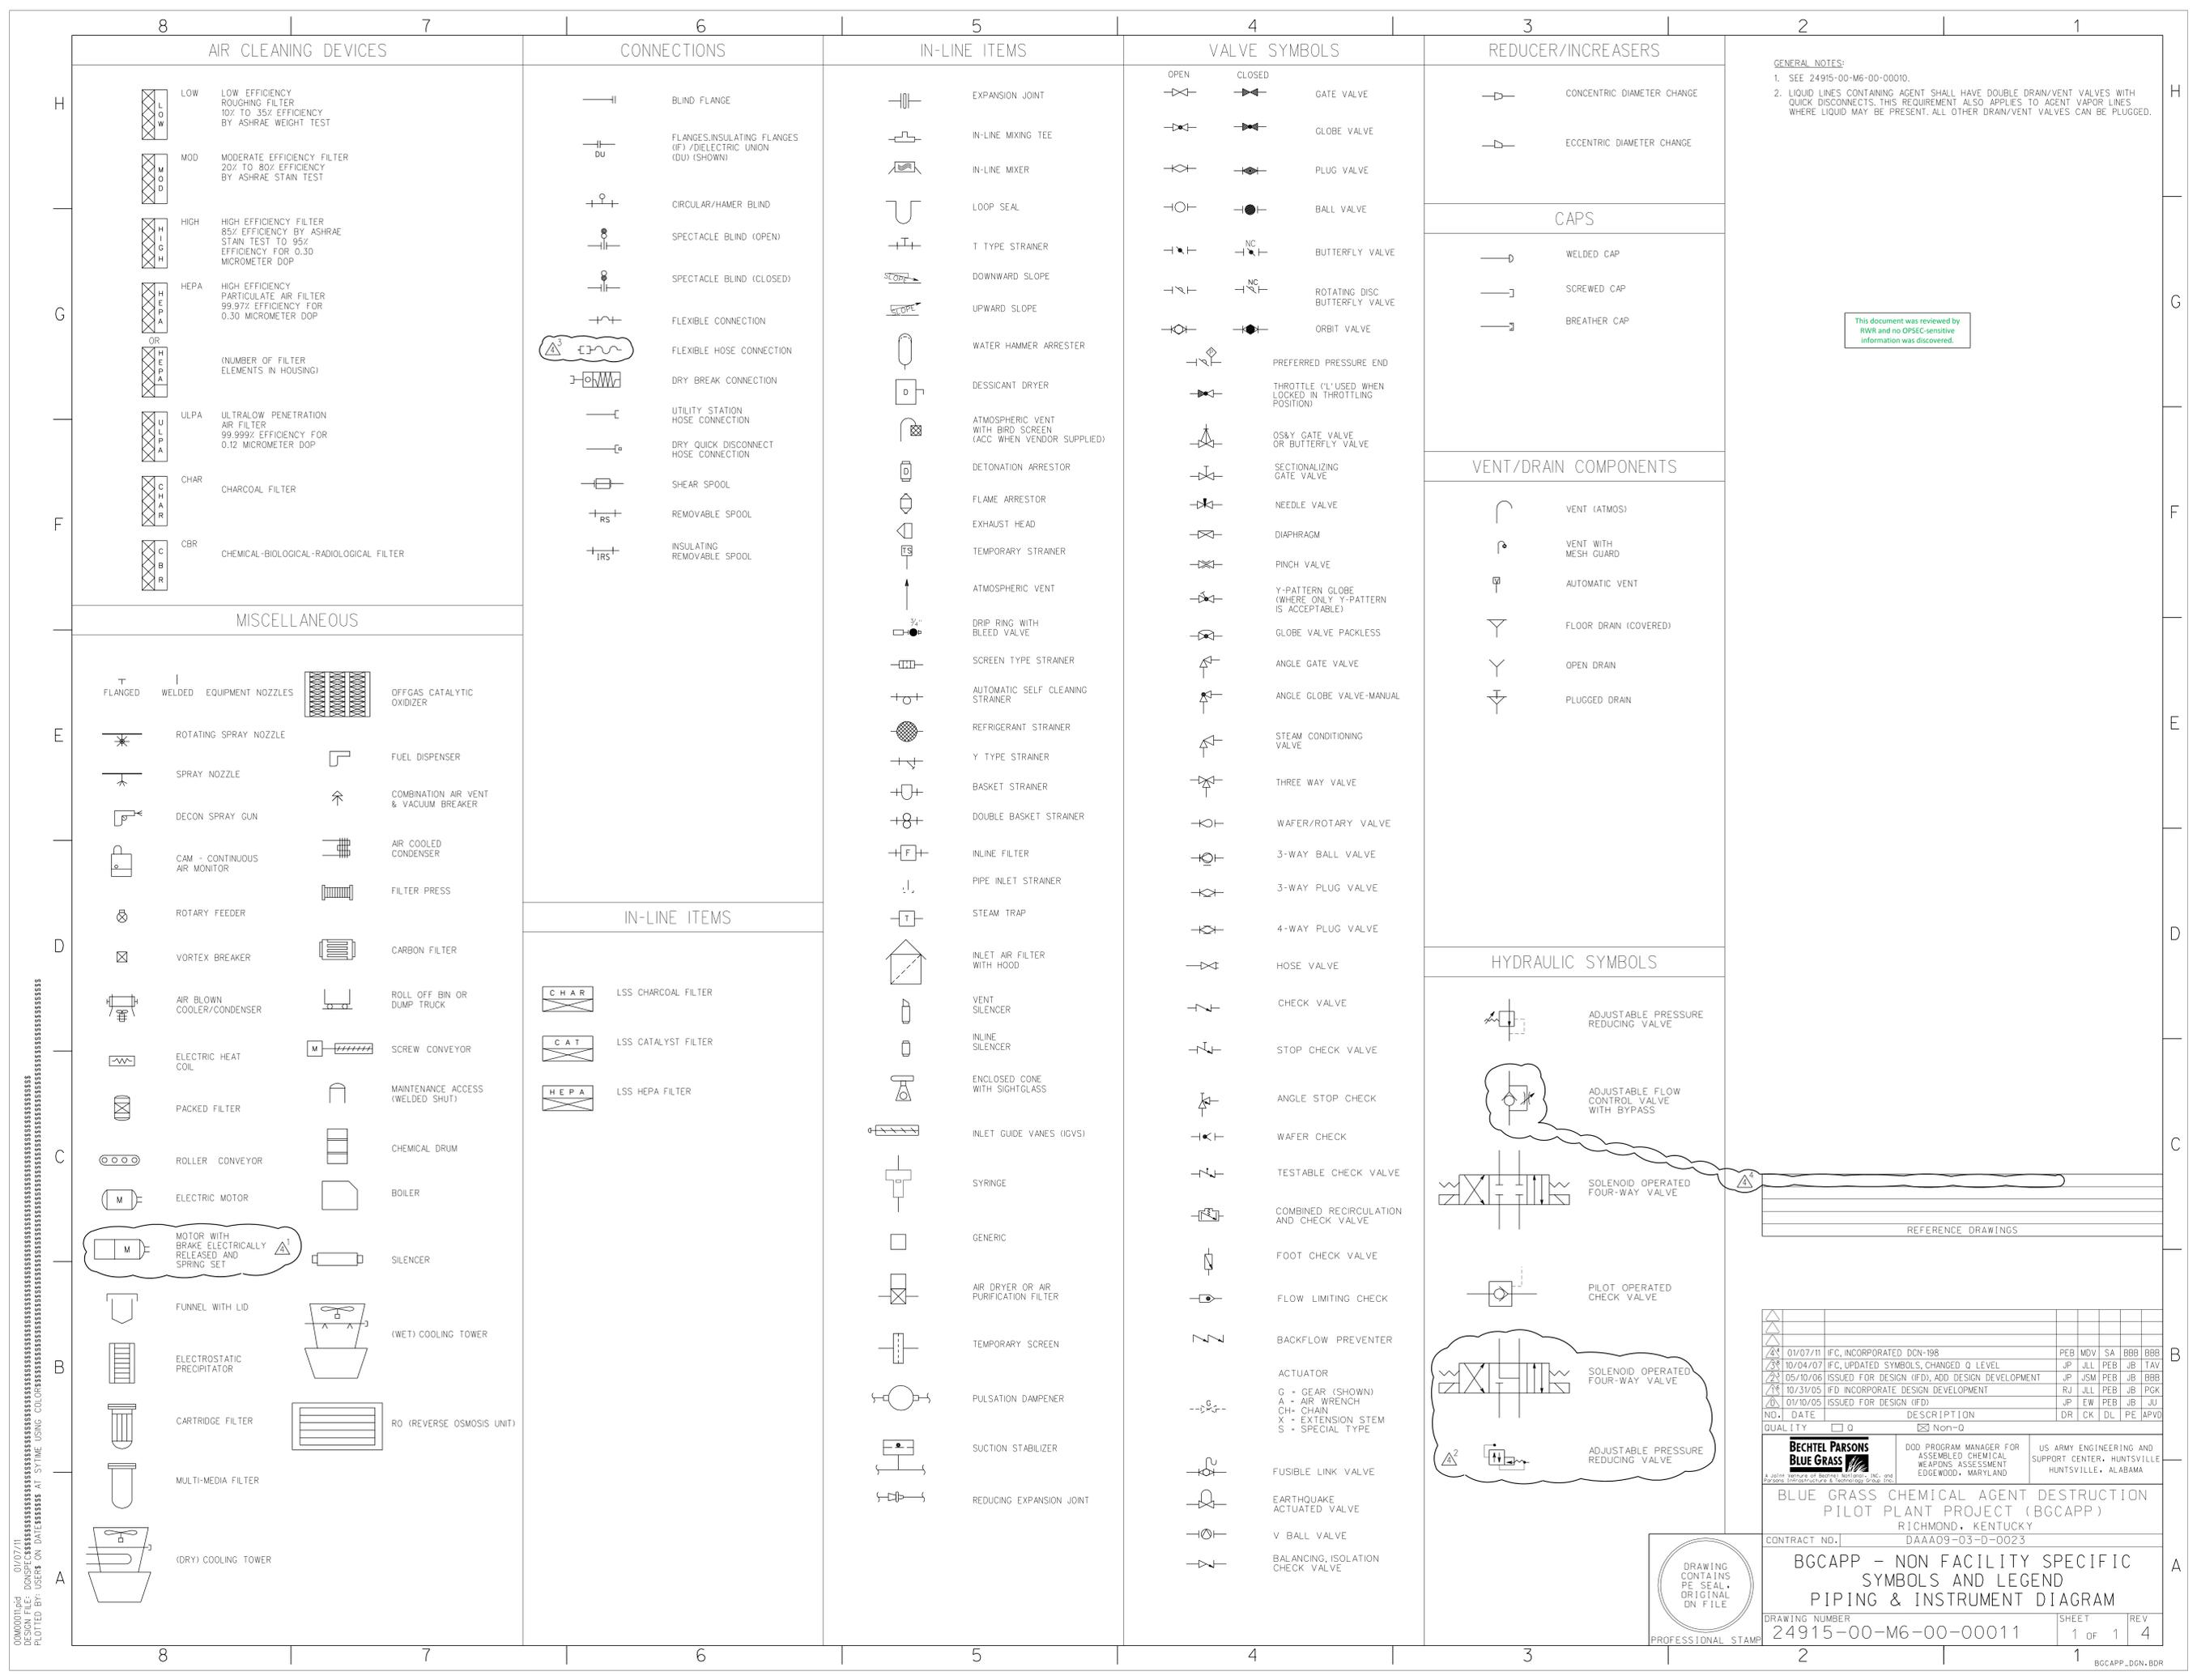

GENERAL NOTES:
 1. SEE 24915-00-M6-00-00010.
 2. LIQUID LINES CONTAINING AGENT SHALL HAVE DOUBLE DRAIN/VENT VALVES WITH QUICK DISCONNECTS. THIS REQUIREMENT ALSO APPLIES TO AGENT VAPOR LINES WHERE LIQUID MAY BE PRESENT. ALL OTHER DRAIN/VENT VALVES CAN BE PLUGGED.

This document was reviewed by RWR and no OPSC-sensitive information was discovered.

NO.	DATE	DESCRIPTION	DR	CK	DL	PE	APVD
44	01/07/11	IFC, INCORPORATED DCN-198	PEB	MOV	SA	BBB	BBB
38	10/04/07	IFC, UPDATED SYMBOLS, CHANGED Q LEVEL	JP	JLL	PEB	JB	TAV
23	05/10/06	ISSUED FOR DESIGN (IFD), ADD DESIGN DEVELOPMENT	JP	JSM	PEB	JB	BBB
14	10/31/05	IFD INCORPORATE DESIGN DEVELOPMENT	RJ	JLL	PEB	JB	PCK
6	01/10/05	ISSUED FOR DESIGN (IFD)	JP	EW	PEB	JB	JU

QUALITY Q Non-Q

BECHTEL PARSONS BLUE GRASS
 A Joint Venture of Bechtel Technology, Inc. and Parsons Infrastructure & Technology Group, Inc.

DDO PROGRAM MANAGER FOR ASSEMBLED CHEMICAL WEAPONS ASSESSMENT EDGEWOOD, MARYLAND

US ARMY ENGINEERING AND SUPPORT CENTER, HUNTSVILLE, ALABAMA


BLUE GRASS CHEMICAL AGENT DESTRUCTION PILOT PLANT PROJECT (BGCAPP)
 RICHMOND, KENTUCKY
 CONTRACT NO. DAAA09-03-D-0023

BGCAPP - NON FACILITY SPECIFIC SYMBOLS AND LEGEND PIPING & INSTRUMENT DIAGRAM

DRAWING NUMBER 24915-00-M6-00-00011 SHEET 1 OF 1 REV 4

DRAWING CONTAINS PE SEAL ORIGINAL ON FILE
 PROFESSIONAL STAMP

01/07/11 00M00011.dwg DONSPEC AT SYTIME USING COLOR...
 DESIGN FILE: DONSPEC AT SYTIME USING COLOR...
 PLOTTED BY: USER4 ON DATE: 1/7/2011 2:44:56 PM

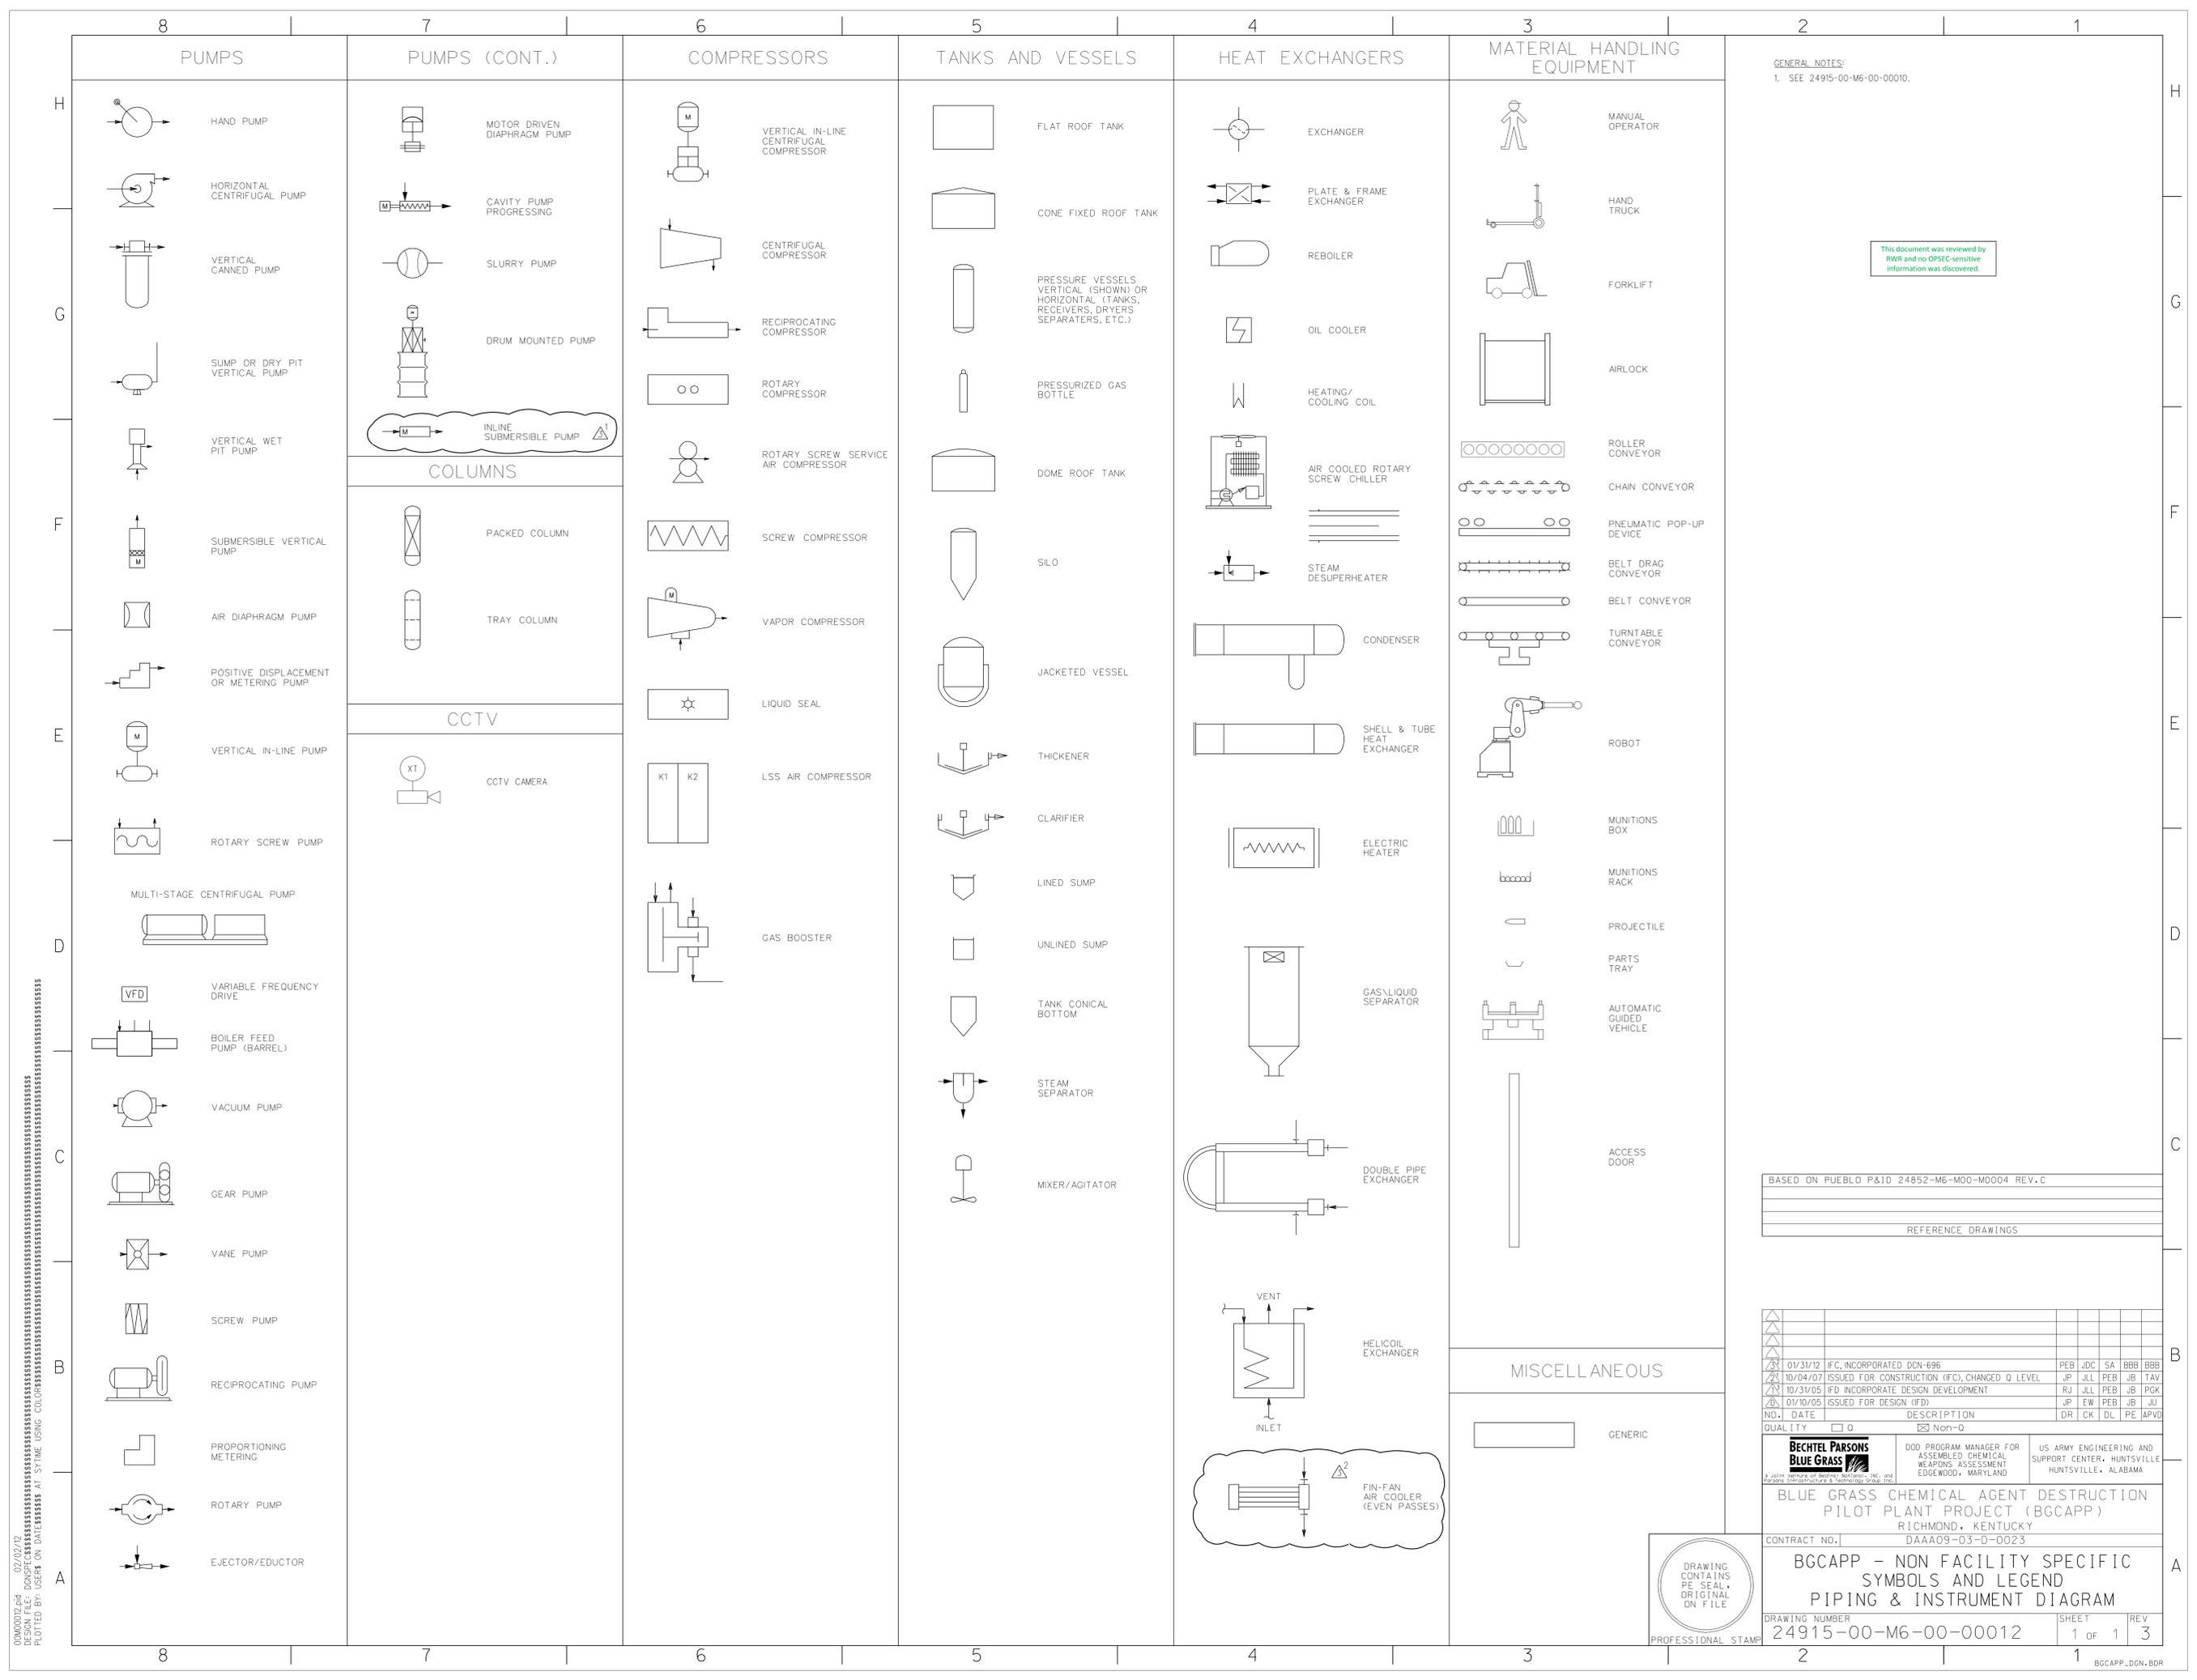

GENERAL NOTES:
1. SEE 24915-00-M6-00-00010.

This document was reviewed by RWR and no OPSEC-sensitive information was discovered.

BASED ON PUEBLD P&ID 24852-M6-M00-M0004 REV. C
REFERENCE DRAWINGS

NO.	DATE	DESCRIPTION	DR	CK	DL	PE	APVD
1	01/31/12	IFC, INCORPORATED DCN-696	PEB	JDC	SA	BBB	BBB
2	10/04/07	ISSUED FOR CONSTRUCTION (IFC), CHANGED Q LEVEL	JP	JLL	PEB	JB	TAV
3	10/31/05	IFD INCORPORATE DESIGN DEVELOPMENT	RJ	JLL	PEB	JB	PKG
4	01/10/05	ISSUED FOR DESIGN (IFD)	JP	EW	PEB	JB	JU

BECHTEL PARSONS BLUE GRASS
A JOINT Venture of Bechtel, Parson, Inc. and Parsons Infrastructure & Technology Group, Inc.

DDO PROGRAM MANAGER FOR ASSEMBLED CHEMICAL WEAPONS ASSESSMENT EDGEWOOD, MARYLAND
US ARMY ENGINEERING AND SUPPORT CENTER, HUNTSVILLE, ALABAMA

BLUE GRASS CHEMICAL AGENT DESTRUCTION PILOT PLANT PROJECT (BGCAPP)
RICHMOND, KENTUCKY
CONTRACT NO. DAAA09-03-D-0023

BGCAPP - NON FACILITY SPECIFIC SYMBOLS AND LEGEND PIPING & INSTRUMENT DIAGRAM
DRAWING NUMBER 24915-00-M6-00-00012 SHEET 1 OF 1 REV 3

DRAWING CONTAINS PE SEAL ORIGINAL ON FILE
PROFESSIONAL STAMP

00000102.dwg 02/02/12
DESIGN FILE: DONSPEC AT SYTIME USING COLORPLOT
PLOTTED BY: USER ON DATE: 2/2/2012 8:22:24 AM

8

7

6

5


4

3


2

1


INSTRUMENT LINE SYMBOLS

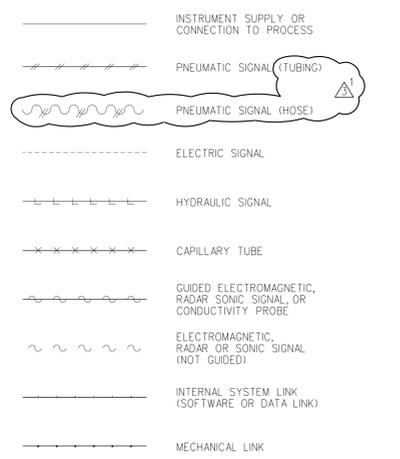


TYP. INSTRUMENT TO PROCESS CONNECTIONS (ANY VARIABLE)

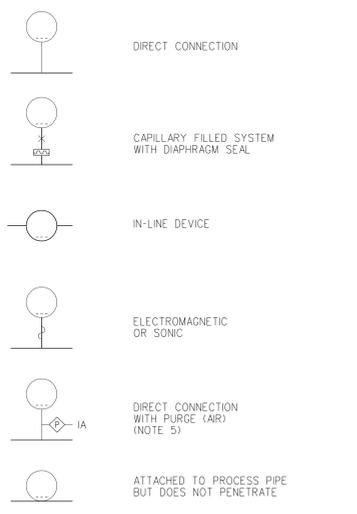


CONDITIONING SYMBOLS

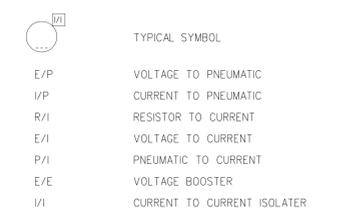


FUNCTION SYMBOLS

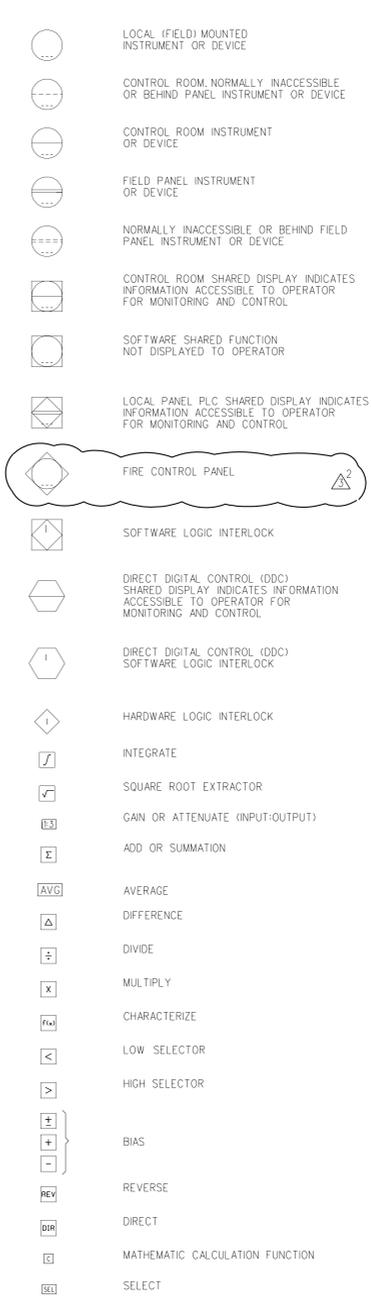


INSTRUMENT NUMBERING

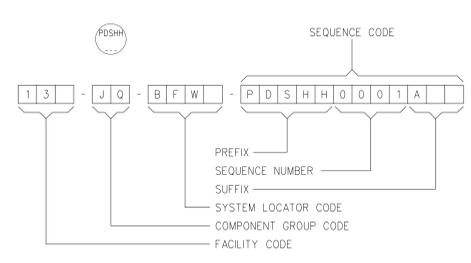

MISCELLANEOUS SYMBOLS AND EXAMPLES

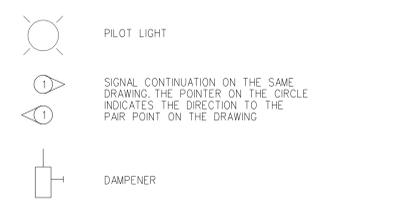

FLOW

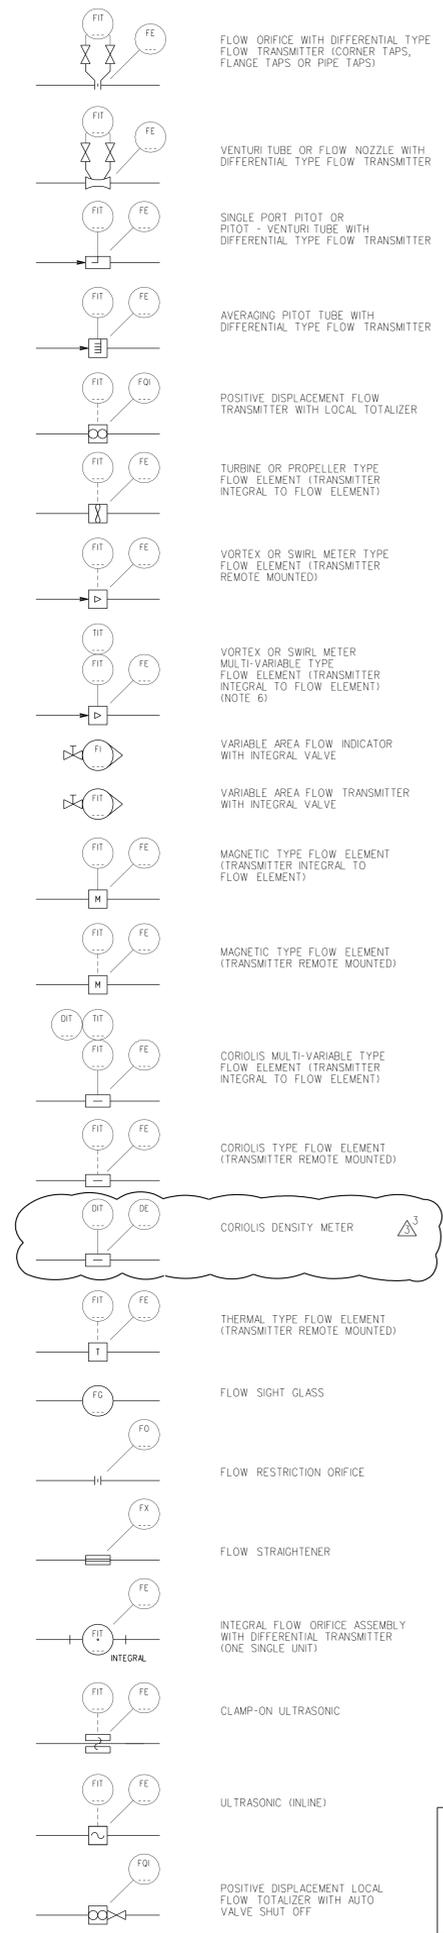

- GENERAL NOTES:
- THE SYMBOLS AND LEGEND SHOWN ARE BASED ON ISA STANDARD, ANSI/ISA-55.1-1984 (R1992) "INSTRUMENTATION SYMBOLS AND IDENTIFICATION" AND STANDARD ISA-55.3-1983 "GRAPHIC SYMBOLS FOR DISTRIBUTED CONTROL/SHARED DISPLAY INSTRUMENTATION, LOGIC AND COMPUTER SYSTEMS."
 - ALL INSTRUMENT PROCESS CONNECTION (IMPULSE) LINES ARE UNDERSTOOD TO HAVE SINGLE PIPING CLASS ROOT VALVES. ROOT VALVES ARE SHOWN ON APPROPRIATE INSTALLATION DETAIL DRAWING BUT NOT ON P&ID.
 - TEXT LOCATION AROUND INSTRUMENTATION SYMBOLS ARE:
 - J1: INSTRUMENT FUNCTION CODE, E.G., PDSHH
 - J2: UNIQUE LOOP NUMBER
 - J3: FUNCTION (E.G., \int) OR DEVICE DESIGNATION (I/P, P/I, I/I, P/H, ETC.)
 - Z: Z DESIGNATES SAFETY ITEM
 - J4: MISC. DESCRIPTION (E.G., J, K, R & D, A (AUTO), H (HAND), SEL (SELECT), O (OPEN), C (CLOSE), ETC.)
 - NORMAL OPERATION MEANS PLANT EQUIPMENT IS IN OPERATING MODE FOR A CONTINUOUS OR BATCH PROCESS
 - THE FOLLOWING ABBREVIATIONS DENOTE THE TYPES OF POWER SUPPLY AND PURGE FLUID:
 - IA - AIR SUPPLY
 - ES - ELECTRIC SUPPLY
 - WS - WATER SUPPLY
 - NS - NITROGEN SUPPLY
 - GS - GAS SUPPLY
 - EXAMPLES OF USE OF TANGENTIAL INSTRUMENT CIRCLES TO DENOTE A SINGLE INSTRUMENT WITH TWO VARIABLES AND/OR TWO FUNCTIONS:
 - TWO VARIABLES - "TIT" FOR TOP BALLOON AND "FIT" IN THE BOTTOM - MULTI-VARIABLE VORTEX FLOW METER.
 - TWO FUNCTIONS - "LIT" FOR TOP BALLOON AND "LIC" IN THE BOTTOM - A DUAL FUNCTION LEVEL INSTRUMENT, ONE A TRANSMITTER, ONE A CONTROLLER.
 - THE UPPER IMPULSE LINE IS OMITTED IF LEVEL IS MEASURED USING ATMOSPHERIC PRESSURE AS REFERENCE.
 - TEST POINTS NOT ASSOCIATED WITH AN INSTRUMENT TAG.
 - TP/PP MAY BE USED IN THE CASE OF A HOT TAP TESTING DEVICE WHERE NO THERMOWELL EXISTS (CLEAN SYSTEMS ONLY).
 - TRANSMITTERS WITH FLAT DIAPHRAGM SEAL TO HAVE CALIBRATION RINGS WITH VENT AND DRAIN VALVES. CALIBRATION RINGS ARE SHOWN ON RESPECTIVE INSTALLATION DETAIL DRAWINGS BUT NOT ON P&ID.

This document was reviewed by RWR and no OPSEC-sensitive information was discovered.

BASED ON PUEBLO P&ID 24852-M6-M00-M0005 REV. A

NO.	DATE	DESCRIPTION	DR	CK	DL	PE	APVD
33	01/31/12	IFC, INCORPORATED DCN-696	PEB	JDC	SA	BBB	BBB
32	10/04/07	IFC, UPDATED SYMBOL, CHANGED Q LEVEL	JP	JLL	PEB	JB	TAV
31	10/31/05	IFC, INCORPORATE DESIGN DEVELOPMENT	RJ	JLL	PEB	JB	PGK
30	01/10/05	ISSUED FOR DESIGN (IFD)	JP	EW	PEB	JB	JU

QUALITY Non-Q

BECHTEL PARSONS BLUE GRASS

DOD PROGRAM MANAGER FOR ASSEMBLED CHEMICAL WEAPONS ASSESSMENT EDGWOOD, MARYLAND

US ARMY ENGINEERING AND SUPPORT CENTER, HUNTSVILLE, ALABAMA

BLUE GRASS CHEMICAL AGENT DESTRUCTION PILOT PLANT PROJECT (BGCAPP)

RICHMOND, KENTUCKY

CONTRACT NO. DAAA09-03-D-0023

DRAWING CONTAINS PE SEAL. ORIGINAL ON FILE

PROFESSIONAL STAMP


BGCAPP - NON FACILITY SPECIFIC SYMBOLS AND LEGEND PIPING & INSTRUMENT DIAGRAM

DRAWING NUMBER 24915-00-M6-00-00013

SHEET 1 OF 1

REV 3

00M00013.ppt 02/01/12
 DESIGN FILE: D0NSPEC4... AT SYTIME USING COLOR...
 PLOTTED BY: USER4 ON DATE: 02/01/12

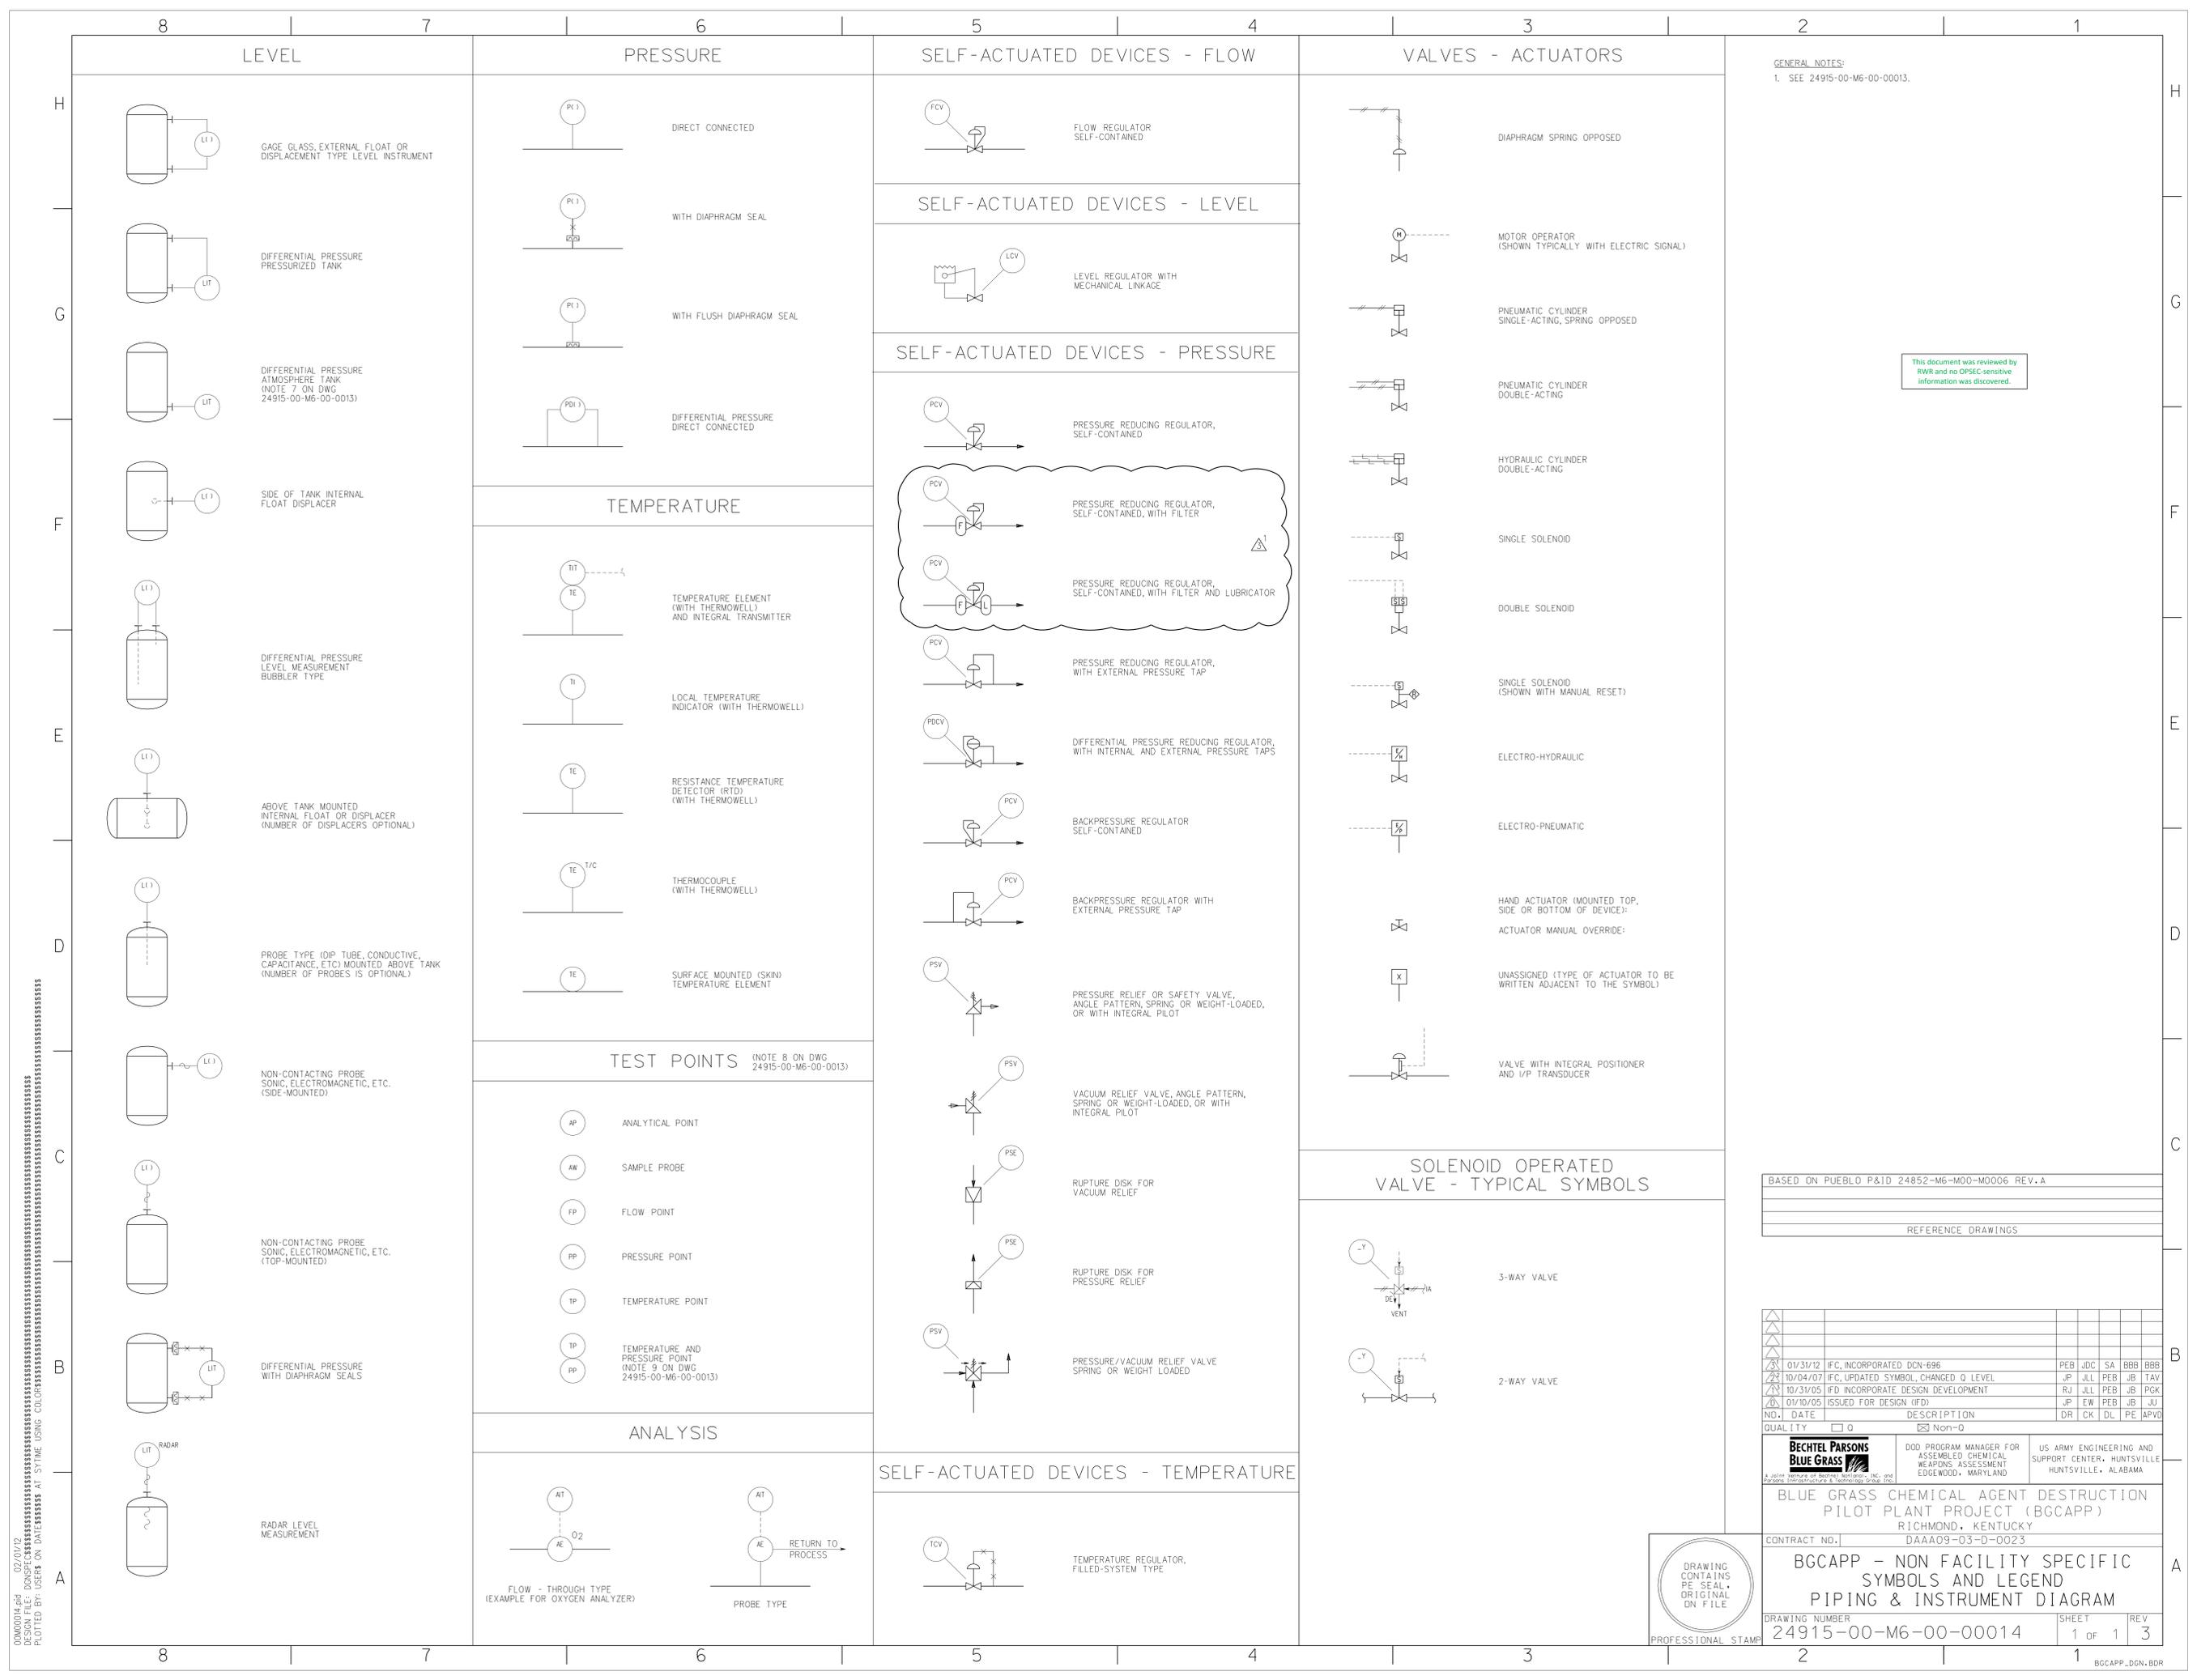

GENERAL NOTES:
1. SEE 24915-00-M6-00-00013.

This document was reviewed by RWH and no OPSEC-sensitive information was discovered.

BASED ON PUEBLO P&ID 24852-M6-M00-M0006 REV. A

REFERENCE DRAWINGS

NO.	DATE	DESCRIPTION	DR	CK	DL	PE	APVD
1	01/31/12	IFC, INCORPORATED DCN-696	PEB	JDC	SA	BBB	BBB
2	10/04/07	IFC, UPDATED SYMBOL, CHANGED Q LEVEL	JP	JLL	PEB	JB	TAV
3	10/31/05	IFD INCORPORATE DESIGN DEVELOPMENT	RJ	JLL	PEB	JB	PCK
4	01/10/05	ISSUED FOR DESIGN (IFD)	JP	EW	PEB	JB	JU

BECHTEL PARSONS BLUE GRASS
A joint venture of Bechtel Technology, Inc. and Parsons Infrastructure & Technology Group, Inc.

DDO PROGRAM MANAGER FOR ASSEMBLED CHEMICAL WEAPONS ASSESSMENT EDGEWOOD, MARYLAND
US ARMY ENGINEERING AND SUPPORT CENTER, HUNTSVILLE, ALABAMA

BLUE GRASS CHEMICAL AGENT DESTRUCTION PILOT PLANT PROJECT (BGCAPP)
RICHMOND, KENTUCKY
CONTRACT NO. DAAA09-03-D-0023

BGCAPP - NON FACILITY SPECIFIC SYMBOLS AND LEGEND PIPING & INSTRUMENT DIAGRAM

DRAWING NUMBER 24915-00-M6-00-00014 SHEET 1 OF 1 REV 3



02/01/12
 DESIGN FILE: DONSPEC... AT SYTIME USING COLOR...
 PLOTTED BY: USER4 ON DATE: 02/01/12

This document was reviewed by RWR and no OPSEC-sensitive information was discovered.

- GENERAL NOTES:**
- THE INSTRUMENT LEGEND IS BASED ON ISA-S5.1-1984, INSTRUMENTATION SYMBOLS AND IDENTIFICATION STANDARD (ISA). EXCEPTIONS SPECIFIC TO BGCAPP ARE NOTED IN THIS LEGEND. REFER TO THE ISA STANDARD FOR FURTHER DETAILS AND CLARIFICATION. THE COMPONENT FUNCTIONAL IDENTIFIER FOR AN INSTRUMENT CONSISTS OF LETTERS DERIVED FROM THE INSTRUMENT LEGEND SHEET AND THESE NOTES. THE FIRST LETTER IS SELECTED ACCORDING TO MEASURED OR INITIATION VARIABLE. SUCCEEDING LETTERS IDENTIFY FUNCTIONS PERFORMED. MODIFYING LETTER MAY BE USED TO MODIFY EITHER A FIRST LETTER OR SUCCEEDING LETTERS AS APPLICABLE.
 - PILOT OR INDICATOR LIGHTS ARE NORMALLY NOT SHOWN ON P&IDs. ESPECIALLY THOSE LIGHTS ASSOCIATED WITH HAND SWITCHES. HOWEVER, THE FOLLOWING EXCEPTIONS APPLY:
 - WHEN A PILOT LIGHT IS PART OF AN INSTALLED LOOP, IT SHOULD BE DESIGNATED BY A FIRST LETTER, FOLLOWED BY THE SUCCEEDING LETTER "L".
 - STATUS INDICATOR LIGHTS ASSOCIATED WITH VALVE STATUS SWITCHES USED IN FIRE SYSTEM MAY USE THE DESIGNATION "ZL".
 - SPECIFIC CASES WHERE THE PILOT LIGHT IS ESSENTIAL FOR EXPLAINING SPECIAL FUNCTION OR LOCATION OF THE LIGHT, ALSO USED AS VALVE LIMIT SWITCH INDICATION IN PROGRAMMABLE ELECTRONIC SYSTEM (PES).
 - WHEN "A" IS USED FOR ANALYSIS VARIABLES NOT ASSIGNED FIRST LETTER DESIGNATORS, THE FOLLOWING TERMS MAY BE PLACED OUTSIDE THE INSTRUMENT CIRCLE TO DENOTE THE SPECIFIC MEASURED VARIABLES, FOR EXAMPLE:
 - H - DISSOLVED HYDROGEN NO_x - NITROGEN OXIDE CO - CARBON MONOXIDE
 - H₂ - GASEOUS HYDROGEN pH - pH
 - NO - SODIUM TRB - TURBIDITY
 - MODIFYING LETTERS SHALL HAVE THE FOLLOWING MEANING: (EXAMPLES GIVEN WITH POSITION SWITCH, ZS)
 - ZSH - HIGH, UP, RASIED, EXTENDED ON, ENERGIZED, VERTICAL, INFLATED, CLAMPED.
 - ZSL - LOW, DOWN, LOWERED, RETRACTED, OFF, HORIZONTAL, DEFLATED, UNCLAMPED.
 - ZSO - DESIGNATES POSITION SWITCH OPEN
 - ZSC - DESIGNATES POSITION SWITCH CLOSED
 - THE LETTER "Z" WHICH FOLLOWS A MEASURED VARIABLE REPRESENTS FINAL CONTROL ELEMENT, OTHER THAN CONTROL VALVES, SUCH AS HYDRAULIC COUPLING, VARIABLE SPEED MOTOR/DEVICE, ETC.
 - "FO" DESIGNATES FLOW RESTRICTION ORIFICE.
 - BURNER/COMBUSTION "B" SHALL BE USED FOR ALL FIRE PROTECTION AND BURNER/COMBUSTION APPLICATIONS.
 - A TEST POINT IS A PROCESS CONNECTION TO WHICH NO INSTRUMENT IS PERMANENTLY CONNECTED, BUT WHICH IS INTENDED FOR TEMPORARY, INTERMITTENT OR FUTURE CONNECTION OF AN INSTRUMENT.
 - AP - ANALYTICAL POINT PP - PRESSURE POINT
 - AW - SAMPLE PROBE TP - TEMPERATURE POINT
 NOTE: TP/PP MAY BE USED IN THE CASE OF A HOT TAP TESTING DEVICE WHERE NO THERMOWELL EXISTS (UTILITY SYSTEM ONLY). WHERE THERMOWELL IS USED FOR TEST POINT, IT MUST HAVE AN INSTRUMENT TAG.
 - INTEGRAL INDICATORS WILL BE PROVIDED WITH TRANSMITTERS ONLY WHEN SPECIFIED ON THE APPLICABLE INSTRUMENT DATA SHEET.
 - "X" IS USED TO REPRESENT ANY "SPECIAL" VARIABLES AND MAY BE DEFINED AS REQUIRED.
 - PSE - DESIGNATES RUPTURE DISKS OR PRESSURE AND VACUUM RELIEF DEVICE. PSV - DESIGNATES RELIEF VALVES.
 - THE DESIGNATION "D" REPRESENTS HVAC CONTROL DAMPERS.
 - ANY FIRST LETTER, WHEN COMBINED WITH MODIFYING LETTER "R" (RATIO), "M" (MOMENTARY), "Q" (TOTALIZER) OR "K" (TIME RATE OF CHANGE), REPRESENTS A SINGLE MEASURED VARIABLE AND IS CONSIDERED THE SAME AS A FIRST LETTER ONLY VARIABLE.
 - USING "X" AS A MODIFIER DESIGNATES AN ACCESSORY PURCHASED WITH AN INSTRUMENT SYSTEM, SUCH AS A SAMPLE CONDITIONING SYSTEM.
 - ALL TEMPERATURE ELEMENTS UNLESS SPECIFIED ARE RTD TYPE. THERMOCOUPLES SHALL BE IDENTIFIED AS "T/C" OR "SKIN T/C".
 - "HS" IS USED FOR MANUAL COMMAND FROM FCS/FPS SUCH AS OPEN/CLOSE/START/ STOP ETC. "HS" IS USED FOR COMMAND TO ALLOW LOCAL OPERATION OF VARIOUS FIELD DRIVES.

INSTRUMENT CODE LETTER IDENTIFICATION																									
FIRST LETTER		SUCCEEDING LETTERS (* FUNCTION IDENTIFIER COMBINATION IS NOT USED - NOTE 13)																							
MEASURED OR INITIATING VARIABLE (NOTE 1)	SYMBOL	SENSING DEVICE				DISPLAY DEVICE					CONTROL DEVICE				SWITCH				MISCELLANEOUS DEVICE						
		PRIMARY ELEMENT	BLIND TRANSMITTER (NOTE 9)	INDICATOR	RECORDER	INTGR. INDICATOR	HIGH	HIGH HIGH	LOW	LOW LOW	HIGH LOW (COMB)	CONTROL STATION	CTRLR.	CONTROL DAMPER (NOTE 12)	SELF-ACTUATED VALVE	CONTROL VALVE	FINAL CONTROL ELEMENT (NOTE 5)	HIGH	HIGH HIGH	LOW	LOW LOW	HIGH LOW (COMB)	LOCAL OBSERV. GLASS	TEST POINT (NOTE 8)	RELAY/ COMPUTE
TYPICAL SYMBOLS	()	()E	()T	()I	()R	()QI	()AH	()AHH	()AL	()ALL	()AHL	()K	()C	()D	()CV	()V	()Z	()SH	()SHH	()SL	()SLL	()SHL	()G	()P	()Y
ANALYSIS (NOTE 3)	A	AE	AT	AI	AR	*	AAH	AAHH	AAL	AALL	A AHL	AK	AC	*	*	AV	AZ	ASH	ASHH	ASL	ASLL	ASHL	*	AP	AY
BURNER COMBUSTION (NOTE 7)	B	BE	BT	BI	BR	*	BAH	BAHH	BAL	BALL	B AHL	*	BC	BD	*	*	BZ	BSH	BSHH	BSL	BSLL	B SHL	BG	BP	BY
CONDUCTIVITY	C	CE	CT	CI	CR	*	CAH	CAHH	CAL	CALL	CAHL	CK	*	*	CV	CZ	CSH	CSHH	CSL	CSLL	C SHL	*	CP	CY	
DENSITY	D	DE	DT	DI	DR	*	DAH	DAHH	DAL	DALL	DAHL	DK	DC	*	*	DV	DZ	DSH	DSHH	DSL	DSLL	D SHL	*	DP	DY
VOLTAGE (EMF)	E	EE	ET	EI	ER	*	EAH	EAHH	EAL	EALL	E AHL	EK	EC	*	*	EZ	ESH	ESHH	ESL	ESLL	E SHL	*	EP	EY	
FLOW RATE (NOTE 6)	F	FE	FT	FI	FR	FQI	FAH	FAHH	FAL	FALL	F AHL	FK	FC	FD	FCV	FV	FZ	FSH	FSHH	FSL	F SLL	F SHL	FG	FP	FY
FLOW RATIO	FF	FE	FT	FFI	FFR		FFSH		FFSL			FFK	FFC		*			FFSH	FFSHH	FFSL	FFSLL	FFSHL			
HAND (MANUAL) (NOTE 16)	H	*	*	HI	*	*	*	*	*	HA	HK	HC/HC	HD	HCV	HV	HZ	*	*	*	*	HS	*	*	HY	
CURRENT	I	IE	IT	II	IR	*	IAH	IAHH	I AL	I ALL	I AHL	IK	IC	ID	*	*	IZ	ISH	ISHH	ISL	ISLL	I SHL	*	IP	IY
POWER	J	JE	JT	JI	JR	JQI	JAH	J AHH	JAL	J ALL	J AHL	JK	JC	*	*	JZ	JSH	JSHH	JSL	J SLL	J SHL	*	JP	JY	
TIME	K	*	KT	KI	*	KQI	KAH	KAHH	KAL	KALL	KAHL	*	KC	*	*	KZ	KSH	KSHH	KSL	K SLL	K SHL	*	KP	KY	
LEVEL	L	*	LT	LI	LR	*	LAH	LAHH	LAL	LALL	LAHL	LK	LC	*	LCV	LV	LZ	LSH	LSHH	L SL	L SLL	L SHL	LG	LP	LY
MOISTURE	M	ME	MT	MI	MR	*	MAH	MAHH	MAL	MALL	MAHL	MK	MC	MD	*	MZ	MSH	MSHH	MSL	MSLL	M SHL	*	MP	MY	
PRESSURE OR VACUUM	P	*	PT	PI	PR	*	PAH	PAHH	PAL	PALL	PAHL	PK	PC	*	PCV	PV	PZ	PSH	PSHH	PSL	PSLL	P SHL	*	PP	PY
PRESSURE DIFFERENTIAL	PD	*	PDT	PDI	PDR	*	PDH	PDHH	PDAL	PDALL	P AHL	PDK	PDC	*	PDCV	PDV	PDZ	PDSH	PDSHH	PDSL	PDSLL	P DSHL	*	PP	PY
QUANTITY OR EVENT	Q	QE	QT	QI	QR	QQI	QAH	QAHH	QAL	QALL	Q AHL	QK	QC	*	*	QZ	QSH	QSHH	QSL	Q SLL	Q SHL	*	QP	QY	
SPEED OR FREQUENCY	S	SE	ST	SI	SR	*	SAH	SAHH	SAL	SALL	SAHL	SK	SC	*	*	SZ	SSH	SSHH	SSL	S SLL	S SHL	*	SP	SY	
TEMPERATURE	T	TE	TT	TI	TR	*	TAH	TAHH	TAL	TALL	TAHL	TK	TC	TD	TCV	TV	TZ	TSH	TSHH	TSL	T SLL	T SHL	*	TP	TY
TEMPERATURE DIFFERENTIAL	TD	*	*	TDI	TDR	*	TDH	TDHH	TDAL	TDALL	T AHL	*	TDC	TD	TDV	TDZ	TDSH	TDSHH	TDSL	TDSLL	T DSHL	*	TP	TY	
MULTI-VARIABLE	U	*	*	UI	UR	*	UAH	UAHH	UAL	UALL	U AHL	UK	UC	*	*	UZ	USH	USHH	USL	U SLL	U SHL	*	UP	UY	
VIBRATION / MECH. ANALYSIS	V	VE	VT	VI	VR	*	VAH	VAHH	VAL	VALL	V AHL	VK	VC	*	*	VZ	VSH	VSHH	VSL	V SLL	V SHL	*	VP	VY	
WEIGHT	W	WE	WT	WI	WR	WQI	WAH	WAHH	WAL	WALL	W AHL	WK	WC	*	*	WZ	WSH	WSHH	WSL	W SLL	W SHL	*	WP	WY	
USER DEFINED (NOTE 10)	X	XE	XT	XI	XR	XQI	XAH	X AHH	XAL	XALL	X AHL	XX	XC	XD	*	XV	XZ	XSH	XSHH	XSL	X SLL	X SHL	XG	XP	XY
EVENT/STATE OR PRESENCE	Y	YE	YT	YI	YR	*	*	*	*	*	*	YK	YC	*	*	YZ	YSH	YSHH	YSL	Y SLL	Y SHL	*	YP	YY	
POSITION (NOTE 4)	Z	ZE	ZT	ZI(L)	ZR	*	ZAH	Z AHH	ZAL	ZALL	Z AHL	ZK	ZC	*	*	ZZ	ZSH	ZSHH	ZSL	Z SLL	Z SHL	*	ZP	ZY	

BASED ON PUEBLO P&ID 24852-M6-M00-M0007 REV. A

REFERENCE DRAWINGS

10/04/07	IFC, DELETED REFERENCE, CHANGED Q LEVEL	JP	JLL	PEB	JB	TAV
01/10/05	ISSUED FOR DESIGN (IFD)	JP	EW	PEB	JB	JU
NO.	DATE	DESCRIPTION	DR	CK	DL	PE
QUALITY	0	Non-0				

BECHTEL PARSONS
BLUE GRASS

DOD PROGRAM MANAGER FOR ASSEMBLED CHEMICAL WEAPONS ASSESSMENT EDGEWOOD, MARYLAND

US ARMY ENGINEERING AND SUPPORT CENTER, HUNTSVILLE, ALABAMA


BLUE GRASS CHEMICAL AGENT DESTRUCTION PILOT PLANT PROJECT (BGCAPP)
 RICHMOND, KENTUCKY

CONTRACT NO. DAAA09-03-D-0023

BGCAPP - NON FACILITY SPECIFIC SYMBOLS AND LEGEND PIPING & INSTRUMENT DIAGRAM

DRAWING NUMBER: 24915-00-M6-00-00015
 SHEET: 1 OF 1
 REV: 1



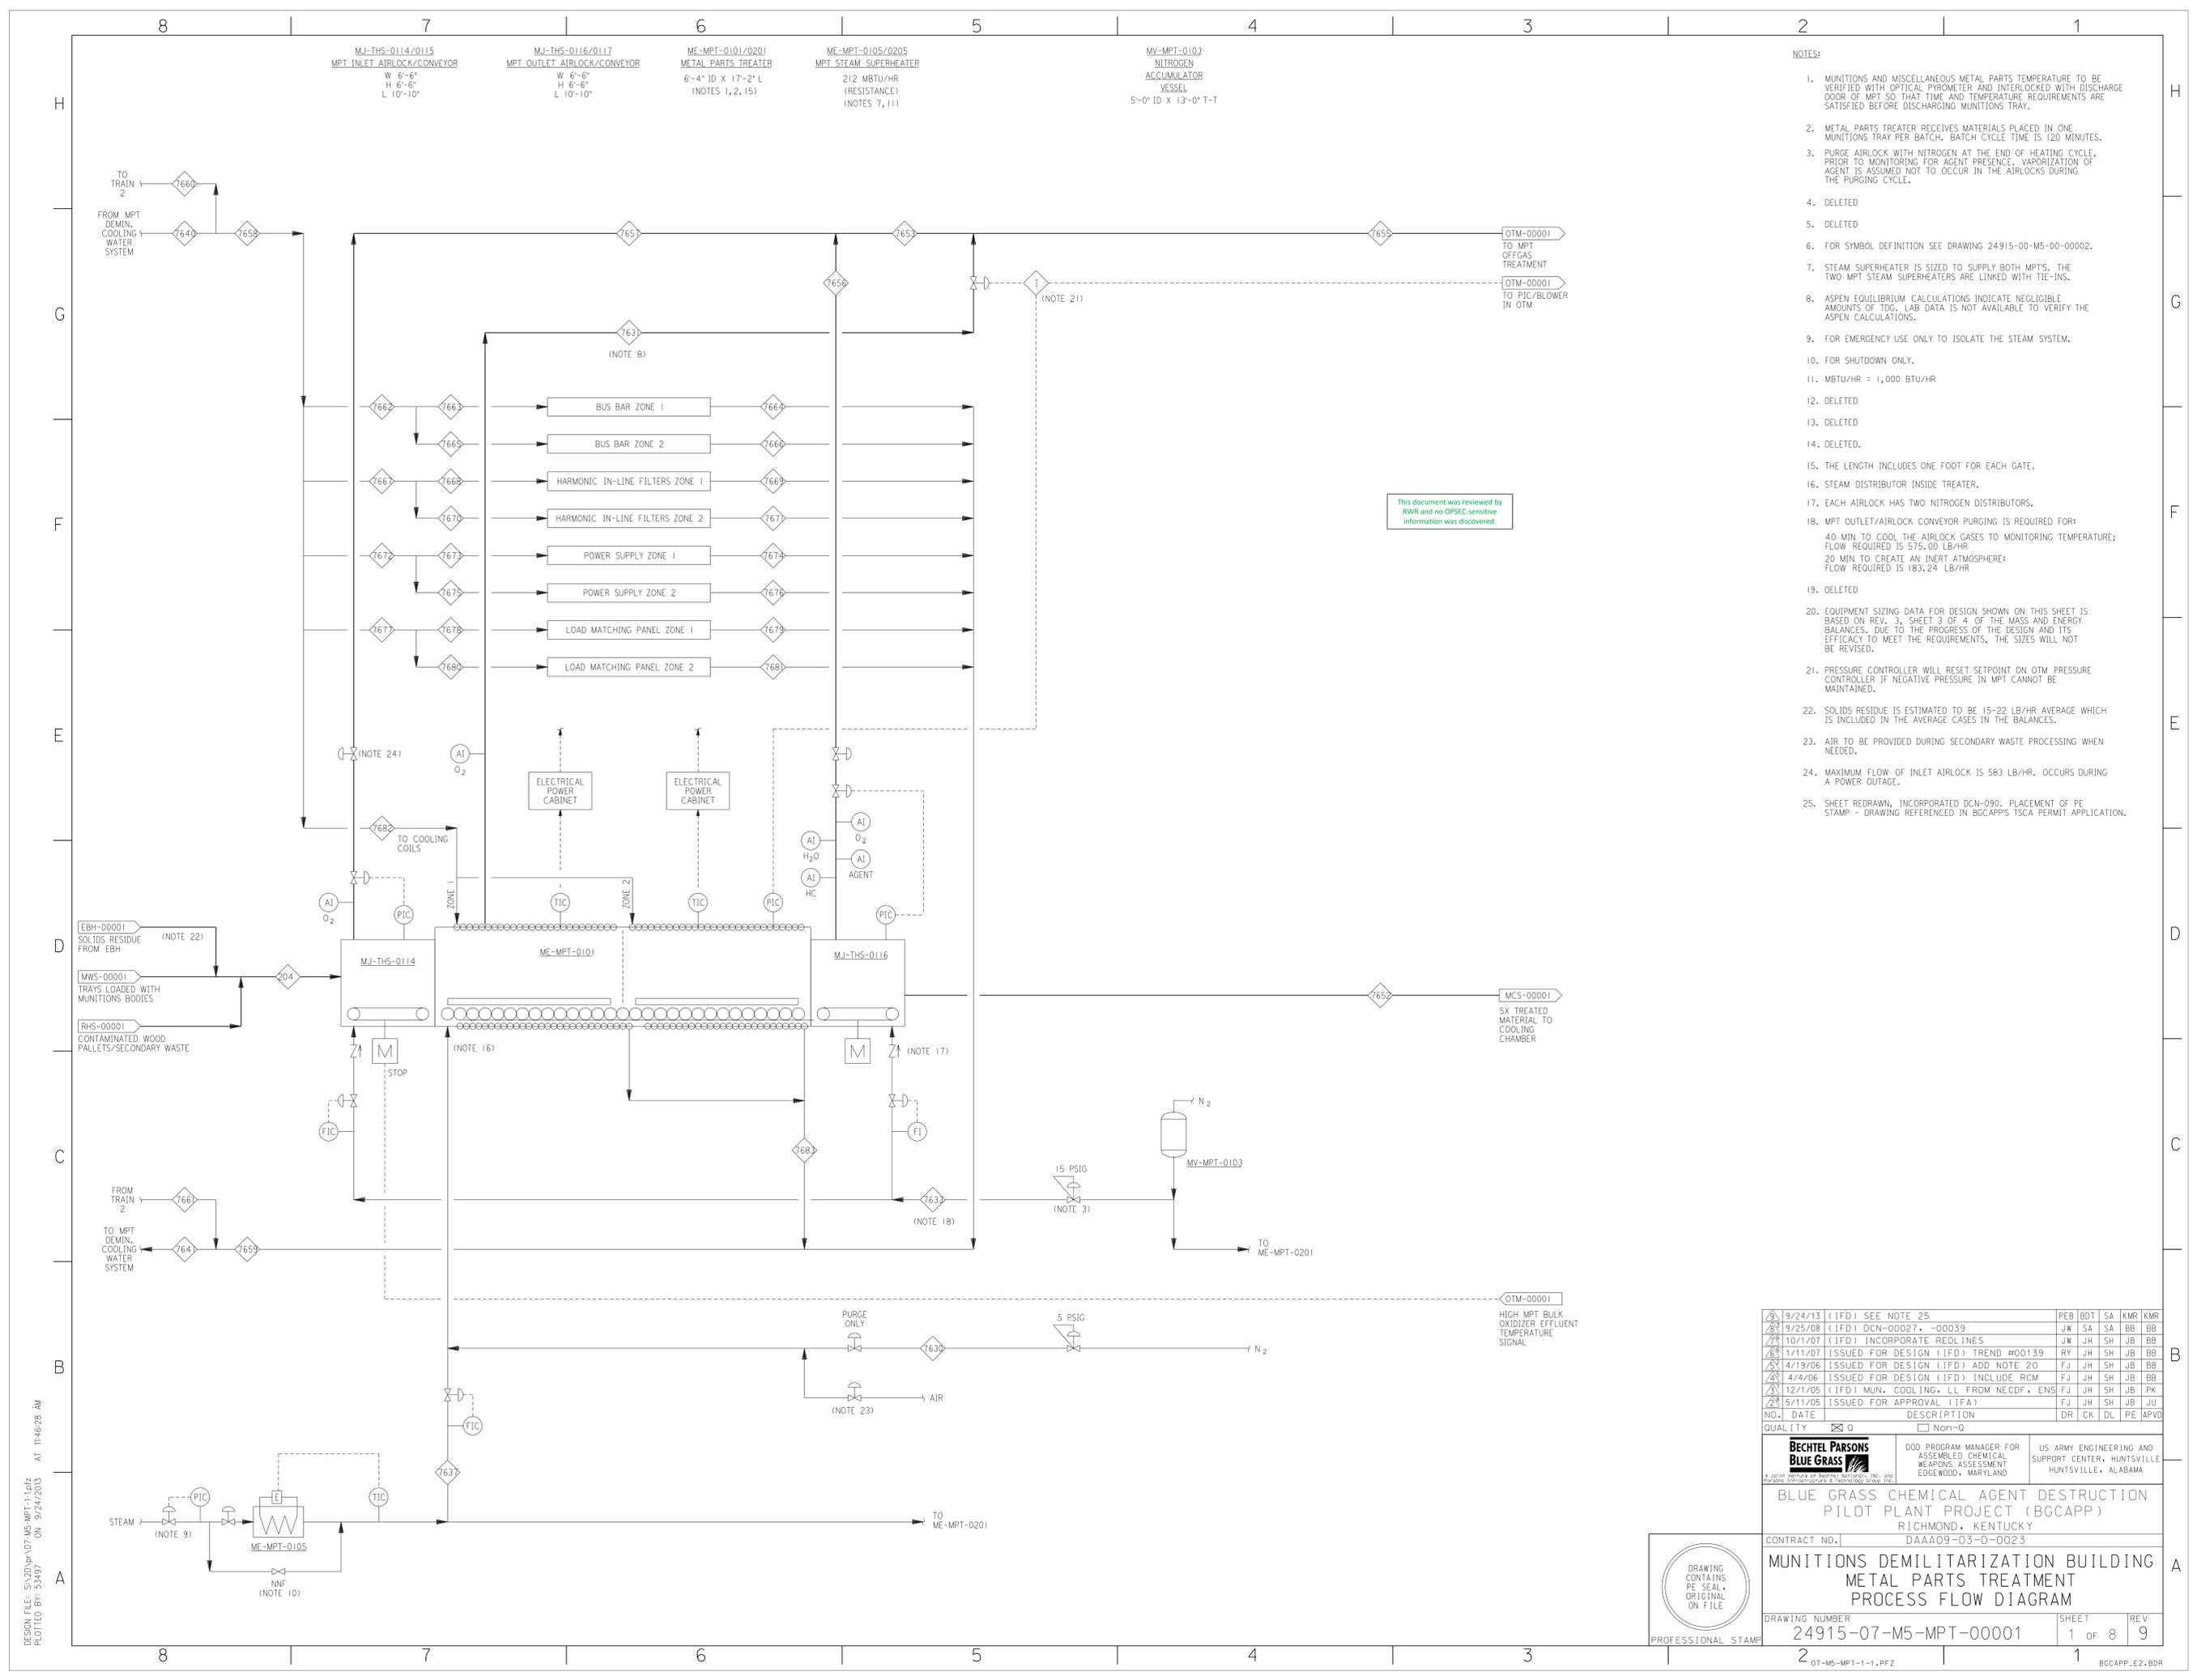

- NOTES:**
- MUNITIONS AND MISCELLANEOUS METAL PARTS TEMPERATURE TO BE VERIFIED WITH OPTICAL PYROMETER AND INTERLOCKED WITH DISCHARGE DOOR OF MPT SO THAT TIME AND TEMPERATURE REQUIREMENTS ARE SATISFIED BEFORE DISCHARGING MUNITIONS TRAY.
 - METAL PARTS TREATER RECEIVES MATERIALS PLACED IN ONE MUNITIONS TRAY PER BATCH. BATCH CYCLE TIME IS 120 MINUTES.
 - PURGE AIRLOCK WITH NITROGEN AT THE END OF HEATING CYCLE, PRIOR TO MONITORING FOR AGENT PRESENCE. VAPORIZATION OF AGENT IS ASSUMED NOT TO OCCUR IN THE AIRLOCKS DURING THE PURGING CYCLE.
 - DELETED
 - DELETED
 - FOR SYMBOL DEFINITION SEE DRAWING 24915-00-M5-00-00002.
 - STEAM SUPERHEATER IS SIZED TO SUPPLY BOTH MPTS. THE TWO MPT STEAM SUPERHEATERS ARE LINKED WITH TIE-INS.
 - ASPEN EQUILIBRIUM CALCULATIONS INDICATE NEGLIGIBLE AMOUNTS OF TOC. LAB DATA IS NOT AVAILABLE TO VERIFY THE ASPEN CALCULATIONS.
 - FOR EMERGENCY USE ONLY TO ISOLATE THE STEAM SYSTEM.
 - FOR SHUTDOWN ONLY.
 - MBTU/HR = 1,000 BTU/HR
 - DELETED
 - DELETED
 - DELETED.
 - THE LENGTH INCLUDES ONE FOOT FOR EACH GATE.
 - STEAM DISTRIBUTOR INSIDE TREATER.
 - EACH AIRLOCK HAS TWO NITROGEN DISTRIBUTORS.
 - MPT OUTLET/AIRLOCK CONVEYOR PURGING IS REQUIRED FOR:
40 MIN TO COOL THE AIRLOCK GASES TO MONITORING TEMPERATURE:
FLOW REQUIRED IS 575.00 LB/HR
20 MIN TO CREATE AN INERT ATMOSPHERE:
FLOW REQUIRED IS 183.24 LB/HR
 - DELETED
 - EQUIPMENT SIZING DATA FOR DESIGN SHOWN ON THIS SHEET IS BASED ON REV. 3, SHEET 3 OF 4 OF THE MASS AND ENERGY BALANCES. DUE TO THE PROGRESS OF THE DESIGN AND ITS EFFICACY TO MEET THE REQUIREMENTS, THE SIZES WILL NOT BE REVISED.
 - PRESSURE CONTROLLER WILL RESET SETPOINT ON OTM PRESSURE CONTROLLER IF NEGATIVE PRESSURE IN MPT CANNOT BE MAINTAINED.
 - SOLIDS RESIDUE IS ESTIMATED TO BE 15-22 LB/HR AVERAGE WHICH IS INCLUDED IN THE AVERAGE CASES IN THE BALANCES.
 - AIR TO BE PROVIDED DURING SECONDARY WASTE PROCESSING WHEN NEEDED.
 - MAXIMUM FLOW OF INLET AIRLOCK IS 583 LB/HR. OCCURS DURING A POWER OUTAGE.
 - SHEET REDRAWN, INCORPORATED DCN-090, PLACEMENT OF PE STAMP - DRAWING REFERENCED IN BGCAPP'S TSCA PERMIT APPLICATION.

This document was reviewed by RWR and no OPSEC-sensitive information was discovered.

NO.	DATE	DESCRIPTION	DR	CK	DL	PE	APVD
9	9/24/13	(IFD) SEE NOTE 25	PEB	BOT	SA	KMR	KMR
8	9/25/08	(IFD) DCN-00027, -00039	JW	SA	SA	BB	BB
7	10/1/07	(IFD) INCORPORATE REDLINES	JW	JH	SH	JB	BB
6	1/11/07	ISSUED FOR DESIGN (IFD) TREND #00139	RY	JH	SH	JB	BB
5	4/19/06	ISSUED FOR DESIGN (IFD) ADD NOTE 20	FJ	JH	SH	JB	BB
4	4/4/06	ISSUED FOR DESIGN (IFD) INCLUDE RCM	FJ	JH	SH	JB	BB
3	12/1/05	(IFD) MUN. COOLING, LL FROM NECDF, ENS	FJ	JH	SH	JB	PK
2	5/11/05	ISSUED FOR APPROVAL (IFA)	FJ	JH	SH	JB	JU

BECHTEL PARSONS BLUE GRASS
 A joint venture of Bechtel Power Corp., Inc. and Parsons Infrastructure & Technology Group, Inc.

DDO PROGRAM MANAGER FOR ASSEMBLED CHEMICAL WEAPONS ASSESSMENT EDgewood, MARYLAND

US ARMY ENGINEERING AND SUPPORT CENTER, HUNTSVILLE, ALABAMA

BLUE GRASS CHEMICAL AGENT DESTRUCTION PILOT PLANT PROJECT (BGCAPP)
 RICHMOND, KENTUCKY


CONTRACT NO. | DAAA09-03-D-0023

MUNITIONS DEMILITARIZATION BUILDING METAL PARTS TREATMENT PROCESS FLOW DIAGRAM

DRAWING NUMBER: 24915-07-M5-MPT-00001 | SHEET: 1 OF 8 | REV: 9



DESIGN FILE: S:\2009\07-M5-MPT-1-1-1.pfd
 PLOTTED BY: 53497 ON: 9/24/2013 AT 11:46:28 AM

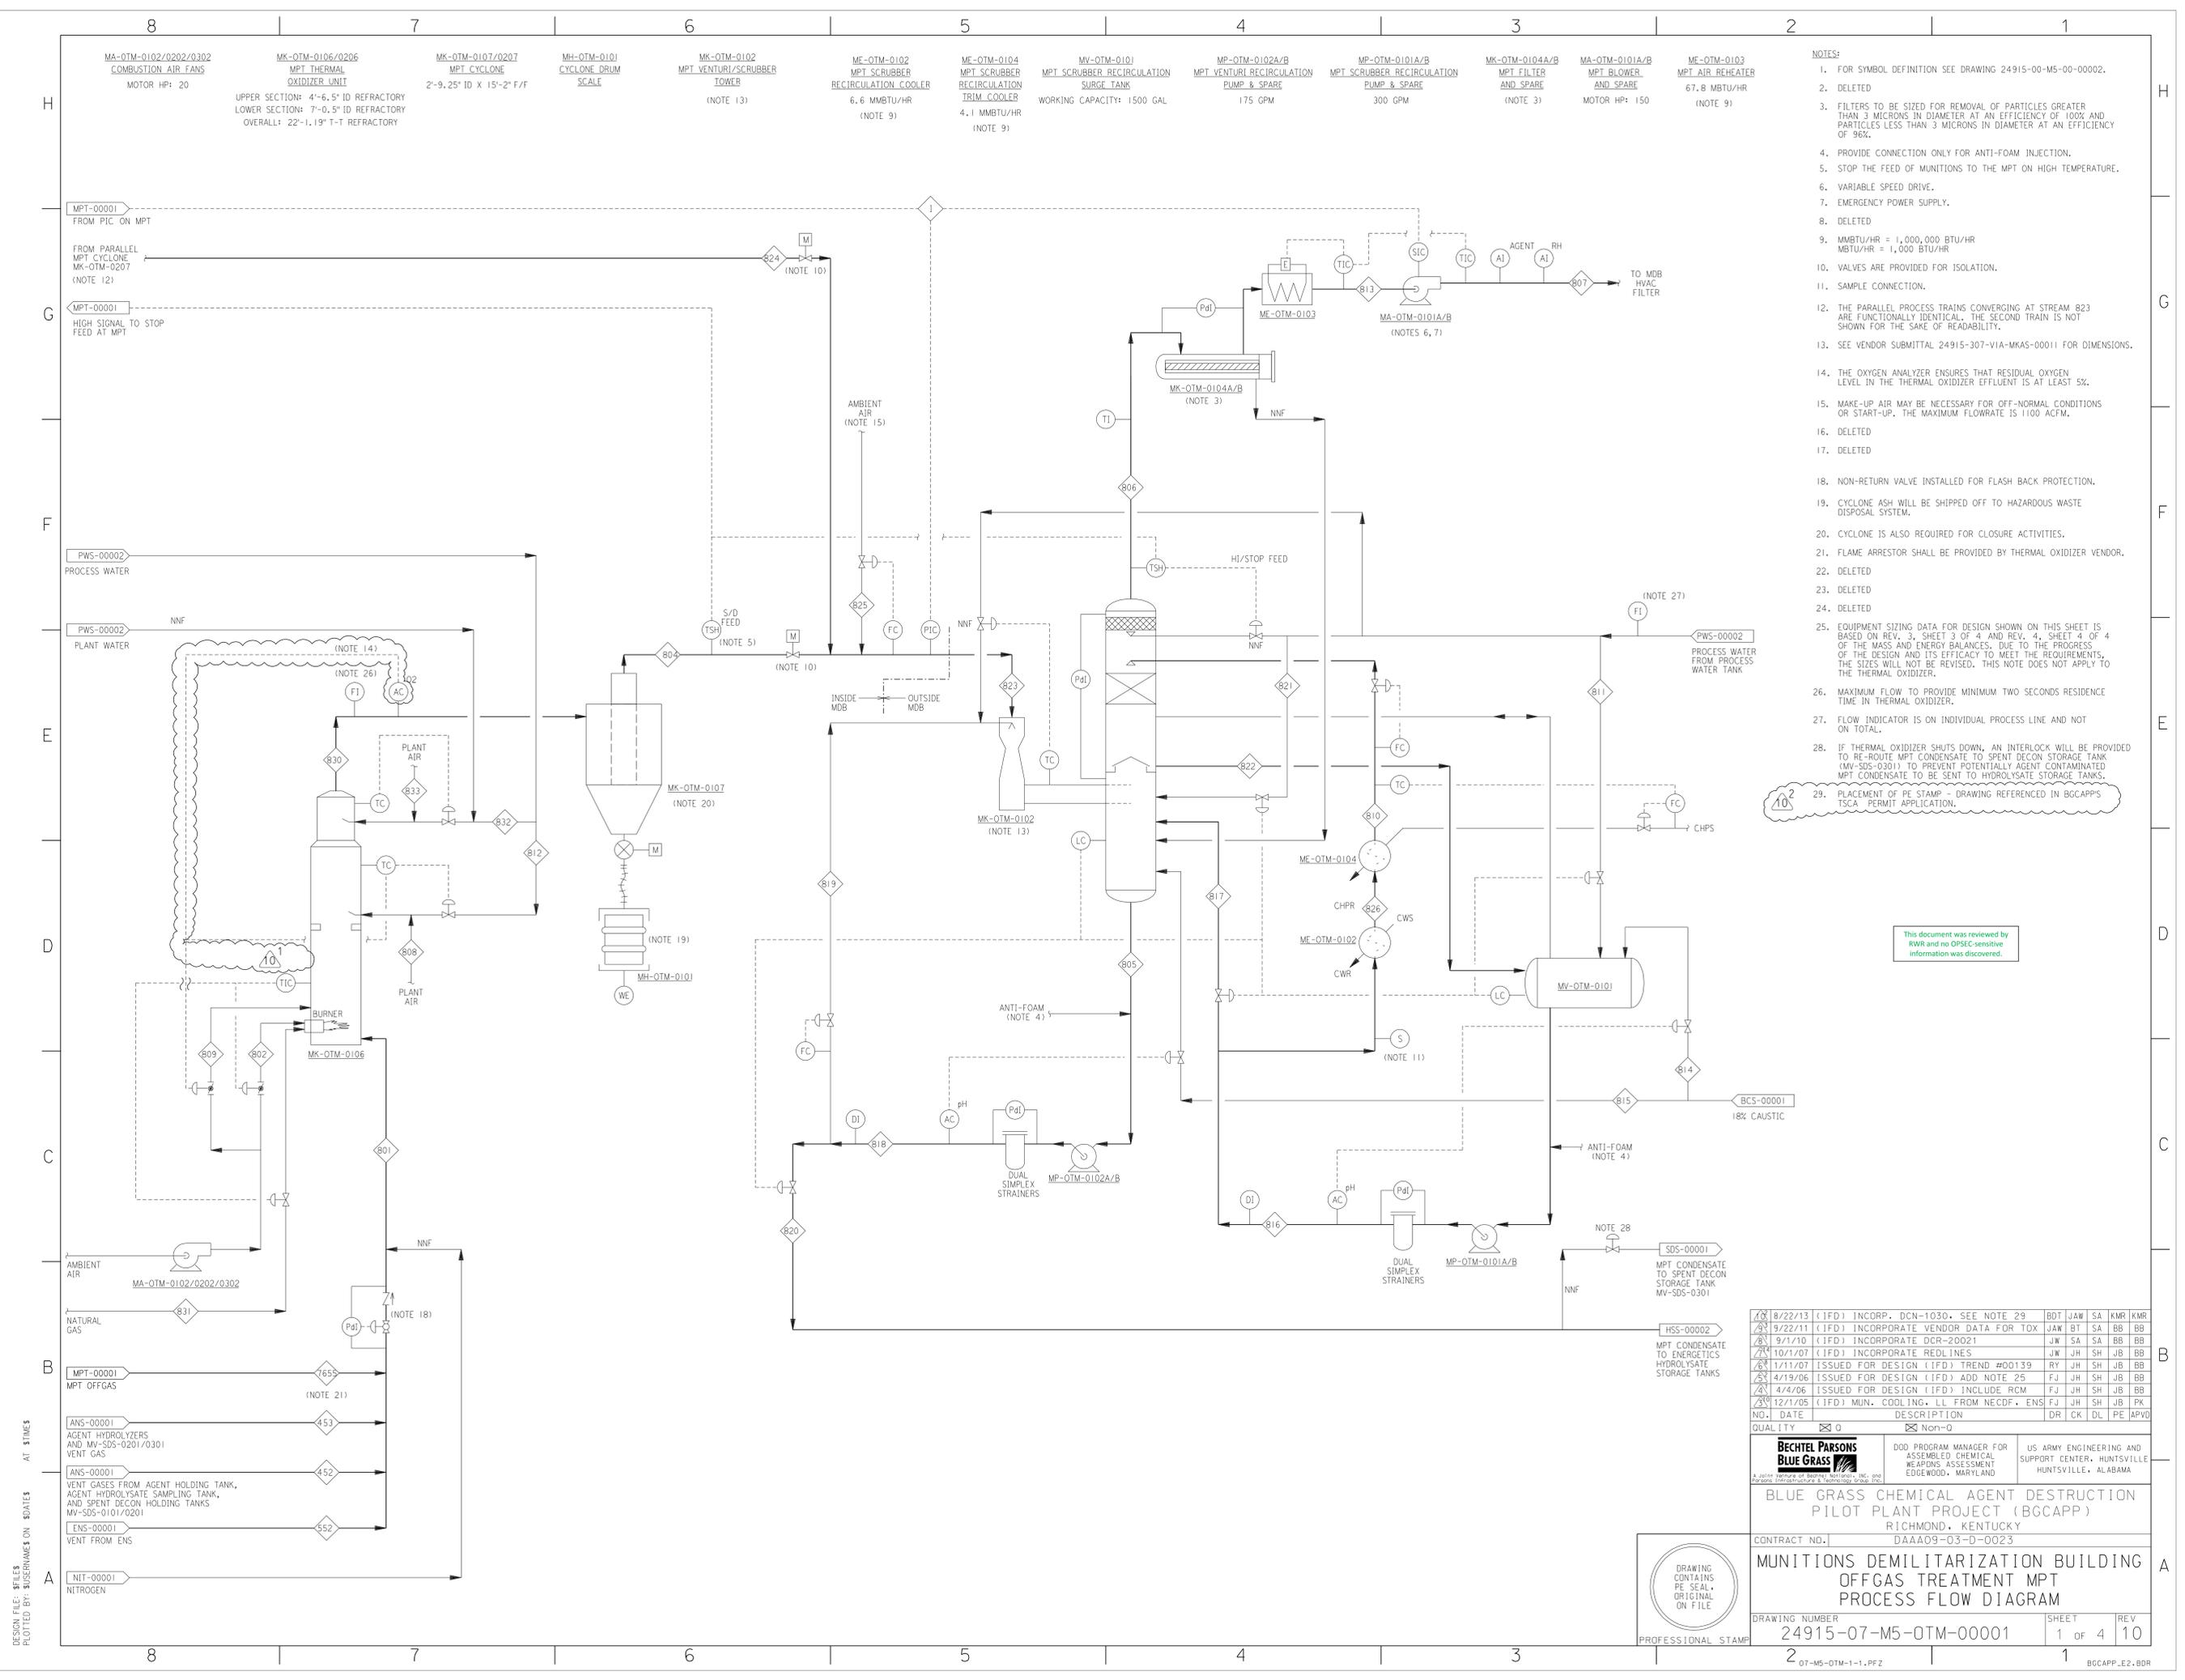

- NOTES:**
- FOR SYMBOL DEFINITION SEE DRAWING 24915-00-M5-00-00002.
 - DELETED
 - FILTERS TO BE SIZED FOR REMOVAL OF PARTICLES GREATER THAN 3 MICRONS IN DIAMETER AT AN EFFICIENCY OF 100% AND PARTICLES LESS THAN 3 MICRONS IN DIAMETER AT AN EFFICIENCY OF 96%.
 - PROVIDE CONNECTION ONLY FOR ANTI-FOAM INJECTION.
 - STOP THE FEED OF MUNITIONS TO THE MPT ON HIGH TEMPERATURE.
 - VARIABLE SPEED DRIVE.
 - EMERGENCY POWER SUPPLY.
 - DELETED
 - MMBTU/HR = 1,000,000 BTU/HR
MBTU/HR = 1,000 BTU/HR
 - VALVES ARE PROVIDED FOR ISOLATION.
 - SAMPLE CONNECTION.
 - THE PARALLEL PROCESS TRAINS CONVERGING AT STREAM 823 ARE FUNCTIONALLY IDENTICAL. THE SECOND TRAIN IS NOT SHOWN FOR THE SAKE OF READABILITY.
 - SEE VENDOR SUBMITTAL 24915-307-VIA-MKAS-00011 FOR DIMENSIONS.
 - THE OXYGEN ANALYZER ENSURES THAT RESIDUAL OXYGEN LEVEL IN THE THERMAL OXIDIZER EFFLUENT IS AT LEAST 5%.
 - MAKE-UP AIR MAY BE NECESSARY FOR OFF-NORMAL CONDITIONS OR START-UP. THE MAXIMUM FLOWRATE IS 1100 ACFM.
 - DELETED
 - DELETED
 - NON-RETURN VALVE INSTALLED FOR FLASH BACK PROTECTION.
 - CYCLONE ASH WILL BE SHIPPED OFF TO HAZARDOUS WASTE DISPOSAL SYSTEM.
 - CYCLONE IS ALSO REQUIRED FOR CLOSURE ACTIVITIES.
 - FLAME ARRESTOR SHALL BE PROVIDED BY THERMAL OXIDIZER VENDOR.
 - DELETED
 - DELETED
 - DELETED
 - EQUIPMENT SIZING DATA FOR DESIGN SHOWN ON THIS SHEET IS BASED ON REV. 3, SHEET 3 OF 4 AND REV. 4, SHEET 4 OF 4 OF THE MASS AND ENERGY BALANCES. DUE TO THE PROGRESS OF THE DESIGN AND ITS EFFICACY TO MEET THE REQUIREMENTS, THE SIZES WILL NOT BE REVISED. THIS NOTE DOES NOT APPLY TO THE THERMAL OXIDIZER.
 - MAXIMUM FLOW TO PROVIDE MINIMUM TWO SECONDS RESIDENCE TIME IN THERMAL OXIDIZER.
 - FLOW INDICATOR IS ON INDIVIDUAL PROCESS LINE AND NOT ON TOTAL.
 - IF THERMAL OXIDIZER SHUTS DOWN, AN INTERLOCK WILL BE PROVIDED TO RE-ROUTE MPT CONDENSATE TO SPENT DECON STORAGE TANK (MV-SDS-0301) TO PREVENT POTENTIALLY AGENT CONTAMINATED MPT CONDENSATE TO BE SENT TO HYDROLYSATE STORAGE TANKS.
 - PLACEMENT OF PE STAMP - DRAWING REFERENCED IN BGCAPP'S TSCA PERMIT APPLICATION.

This document was reviewed by RWR and no OHSOC-sensitive information was discovered.

NO.	DATE	DESCRIPTION	DR	CK	DL	PE	APVD
10	8/22/13	(IFD) INCORP. DCN-1030. SEE NOTE 29	BDT	JAW	SA	KMR	KMR
9	9/22/11	(IFD) INCORPORATE VENDOR DATA FOR TOX	JAW	BT	SA	BB	BB
8	9/1/10	(IFD) INCORPORATE DCR-20021	JW	SA	SA	BB	BB
7	10/1/07	(IFD) INCORPORATE REDLINES	JW	JH	SH	JB	BB
6	1/11/07	ISSUED FOR DESIGN (IFD) TREND #00139	RY	JH	SH	JB	BB
5	4/19/06	ISSUED FOR DESIGN (IFD) ADD NOTE 25	FJ	JH	SH	JB	BB
4	4/4/06	ISSUED FOR DESIGN (IFD) INCLUDE RCM	FJ	JH	SH	JB	BB
3	12/1/05	(IFD) MUN. COOLING. LL FROM NECDF. ENS	FJ	JH	SH	JB	PK

QUALITY Non-0

BECHTEL PARSONS BLUE GRASS	DDO PROGRAM MANAGER FOR ASSEMBLED CHEMICAL WEAPONS ASSESSMENT EDgewOOD, MARYLAND	US ARMY ENGINEERING AND SUPPORT CENTER, HUNTSVILLE HUNTSVILLE, ALABAMA
--------------------------------------	---	---

BLUE GRASS CHEMICAL AGENT DESTRUCTION PILOT PLANT PROJECT (BGCAPP)
RICHMOND, KENTUCKY
DAAA09-03-D-0023


MUNITIONS DEMILITARIZATION BUILDING OFFGAS TREATMENT MPT PROCESS FLOW DIAGRAM

CONTRACT NO. | SHEET | REV
24915-07-M5-OTM-00001 | 1 OF 4 | 10

DRAWING NUMBER | SHEET | REV
24915-07-M5-OTM-00001 | 1 OF 4 | 10

DRAWING CONTAINS PE SEAL. ORIGINAL ON FILE

DESIGN FILE: \$FILES
PLOTTED BY: SUBNAME ON \$DATES AT \$TIMES

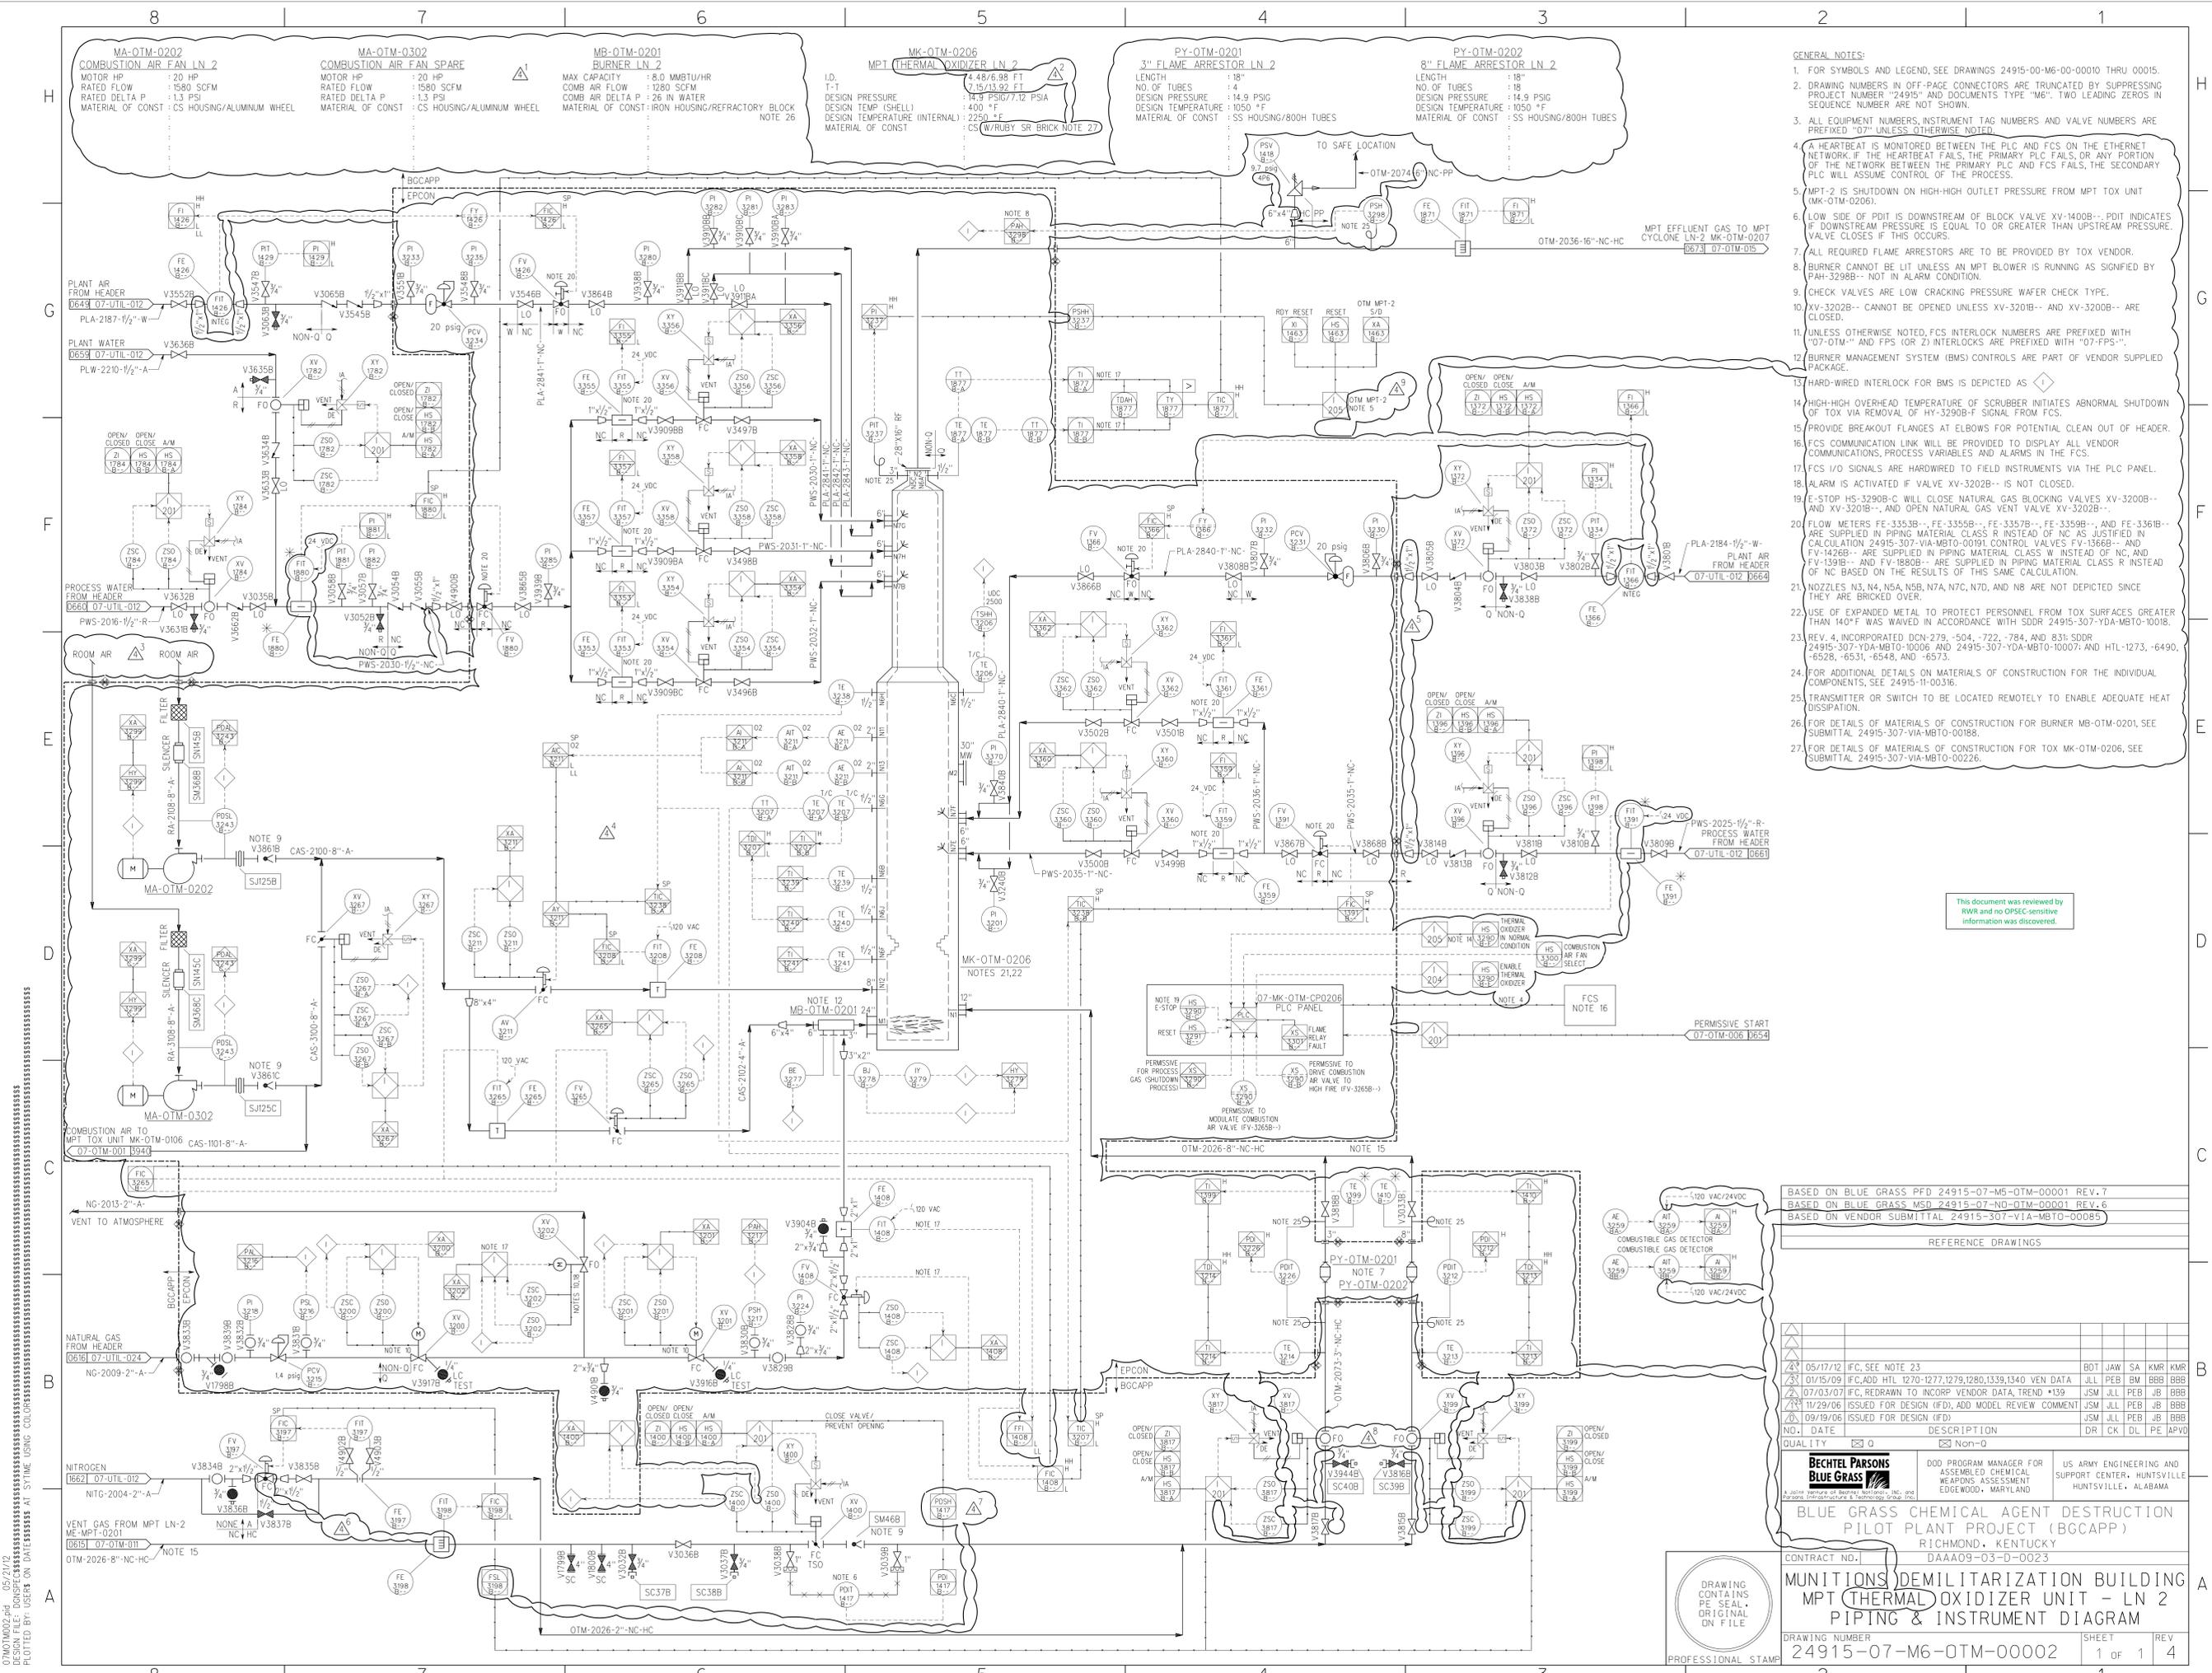

- GENERAL NOTES:
- FOR SYMBOLS AND LEGEND, SEE DRAWINGS 24915-00-M6-00-00010 THRU 00015.
 - DRAWING NUMBERS IN OFF-PAGE CONNECTORS ARE TRUNCATED BY SUPPRESSING PROJECT NUMBER "24915" AND DOCUMENTS TYPE "M6". TWO LEADING ZEROS IN SEQUENCE NUMBER ARE NOT SHOWN.
 - ALL EQUIPMENT NUMBERS, INSTRUMENT TAG NUMBERS AND VALVE NUMBERS ARE PREFIXED "07" UNLESS OTHERWISE NOTED.
 - A HEARTBEAT IS MONITORED BETWEEN THE PLC AND FCS ON THE ETHERNET NETWORK. IF THE HEARTBEAT FAILS, THE PRIMARY PLC FAILS, OR ANY PORTION OF THE NETWORK BETWEEN THE PRIMARY PLC AND FCS FAILS, THE SECONDARY PLC WILL ASSUME CONTROL OF THE PROCESS.
 - MPT-2 IS SHUTDOWN ON HIGH-HIGH OUTLET PRESSURE FROM MPT TOX UNIT (MK-OTM-0206).
 - LOW SIDE OF PDIT IS DOWNSTREAM OF BLOCK VALVE XV-1400B--. PDIT INDICATES IF DOWNSTREAM PRESSURE IS EQUAL TO OR GREATER THAN UPSTREAM PRESSURE. VALVE CLOSURES IF THIS OCCURS.
 - ALL REQUIRED FLAME ARRESTORS ARE TO BE PROVIDED BY TOX VENDOR.
 - BURNER CANNOT BE LIT UNLESS AN MPT BLOWER IS RUNNING AS SIGNIFIED BY PAH-3296B-- NOT IN ALARM CONDITION.
 - CHECK VALVES ARE LOW CRACKING PRESSURE WAFFER CHECK TYPE.
 - XV-3202B-- CANNOT BE OPENED UNLESS XV-3201B-- AND XV-3200B-- ARE CLOSED.
 - UNLESS OTHERWISE NOTED, FCS INTERLOCK NUMBERS ARE PREFIXED WITH "07-OTM-" AND FCS (OR Z) INTERLOCKS ARE PREFIXED WITH "07-FPS-".
 - BURNER MANAGEMENT SYSTEM (BMS) CONTROLS ARE PART OF VENDOR SUPPLIED PACKAGE.
 - HARD-WIRED INTERLOCK FOR BMS IS DEPICTED AS
 - HIGH-HIGH OVERHEAD TEMPERATURE OF SCRUBBER INITIATES ABNORMAL SHUTDOWN OF TOX VIA REMOVAL OF HY-3290B-F SIGNAL FROM FCS.
 - PROVIDE BREAKOUT FLANGES AT ELBOWS FOR POTENTIAL CLEAN OUT OF HEADER.
 - FCS COMMUNICATION LINK WILL BE PROVIDED TO DISPLAY ALL VENDOR COMMUNICATIONS, PROCESS VARIABLES AND ALARMS IN THE FCS.
 - FCS I/O SIGNALS ARE HARDWIRED TO FIELD INSTRUMENTS VIA THE PLC PANEL.
 - ALARM IS ACTIVATED IF VALVE XV-3202B-- IS NOT CLOSED.
 - E-STOP HS-3290B-C WILL CLOSE NATURAL GAS BLOCKING VALVES XV-3200B-- AND XV-3201B-- AND OPEN NATURAL GAS VENT VALVE XV-3202B--.
 - FLOW METERS FE-3353B--, FE-3355B--, FE-3357B--, FE-3359B-- AND FE-3361B-- ARE SUPPLIED IN PIPING MATERIAL CLASS R INSTEAD OF NC AS JUSTIFIED IN CALCULATION 24915-307-VIA-MBTO-0091. CONTROL VALVES FV-1366B-- AND FV-1406B-- ARE SUPPLIED IN PIPING MATERIAL CLASS W INSTEAD OF NC, AND FV-1391B-- AND FV-1880B-- ARE SUPPLIED IN PIPING MATERIAL CLASS R INSTEAD OF NC BASED ON THE RESULTS OF THIS SAME CALCULATION.
 - NOZZLES N3, N4, N5A, N5B, N7A, N7C, N7D, AND N8 ARE NOT DEPICTED SINCE THEY ARE BRICKED OVER.
 - USE OF EXPANDED METAL TO PROTECT PERSONNEL FROM TOX SURFACES GREATER THAN 140°F WAS MAILED IN ACCORDANCE WITH SDDR 24915-307-YDA-MBTO-0018.
 - REV. 4, INCORPORATED DDCN-279--504, -722, -784, AND 831-SDDR 24915-307-YDA-MBTO-10006 AND 24915-307-YDA-MBTO-10007 AND HTL-1273, -6490, -6526, -6531, -6548, AND -6573.
 - FOR ADDITIONAL DETAILS ON MATERIALS OF CONSTRUCTION FOR THE INDIVIDUAL COMPONENTS, SEE 24915-11-00316.
 - TRANSMITTER OR SWITCH TO BE LOCATED REMOTELY TO ENABLE ADEQUATE HEAT DISSIPATION.
 - FOR DETAILS OF MATERIALS OF CONSTRUCTION FOR BURNER MB-OTM-0201, SEE SUBMITTAL 24915-307-VIA-MBTO-00188.
 - FOR DETAILS OF MATERIALS OF CONSTRUCTION FOR TOX MK-OTM-0206, SEE SUBMITTAL 24915-307-VIA-MBTO-00226.

This document was reviewed by RWR and no OPCS-sensitive information was discovered.

BASED ON BLUE GRASS PFD 24915-07-M5-OTM-00001 REV. 7
 BASED ON BLUE GRASS MSD 24915-07-ND-OTM-00001 REV. 6
 BASED ON VENDOR SUBMITTAL 24915-307-VIA-MBTO-00085

REFERENCE DRAWINGS

NO.	DATE	DESCRIPTION	DR	CK	DL	PE	APVD
1	05/17/12	IFC, SEE NOTE 23	BOT	JAW	SA	KMR	KMR
2	01/15/09	IFC, ADD HTL 1270-1277, 1279, 1280, 1339, 1340 VEN DATA	JLL	PEB	BM	BBB	BBB
3	07/03/07	IFC, REDRAWN TO INCORP VENDOR DATA, TREND *139	JSM	JLL	PEB	JB	BBB
4	11/29/06	ISSUED FOR DESIGN (IFD), ADD MODEL REVIEW COMMENT	JSM	JLL	PEB	JB	BBB
5	09/19/06	ISSUED FOR DESIGN (IFD)	JSM	JLL	PEB	JB	BBB

BECHTEL PARSONS
BLUE GRASS
 A joint venture of Bechtel Corporation, Inc. and Parsons Brinckerhoff & Technology Group, Inc.

BLUE GRASS CHEMICAL AGENT DESTRUCTION PILOT PLANT PROJECT (BGCAPP)
 RICHMOND, KENTUCKY
 CONTRACT NO. DAAA09-03-D-0023

MUNITIONS DEMILITARIZATION BUILDING
 MPT THERMAL OXIDIZER UNIT - LN 2
 PIPING & INSTRUMENT DIAGRAM


DRAWING NUMBER	24915-07-M6-OTM-00002	SHEET	1 OF 1	REV	4
----------------	-----------------------	-------	--------	-----	---



07M002.dwg 05/21/12
 DESIGN FILE: DONSPICE
 PLOTTED BY: USER ON DATE: 5/21/2012 9:51:33 AM

ME-OTM-0102 MPT SCRUBBER RECIRCULATION COOLER		ME-OTM-0104 MPT SCRUBBER RECIRC TRIM COOLER	
DUTY	: 6.6 MMBTU/HR	DUTY	: 4.1 MMBTU/HR
DESIGN PRESS (SHELL)	: 150 PSIG	DESIGN PRESS (SHELL)	: 175 PSIG
DESIGN TEMP (SHELL)	: 140 °F	DESIGN PRESS (TUBE)	: 125 °F
DESIGN PRESS (TUBE)	: 150 PSIG	DESIGN TEMP (TUBE)	: 175 °F
DESIGN TEMP (TUBE)	: 175 °F	MATERIAL OF CONST (SHELL)	: CS
MATERIAL OF CONST (SHELL)	: UNS-N10276	MATERIAL OF CONST (TUBE)	: UNS-N10276
TRIM (SHELL)	: TRIM-1028-0"-W-	TRIM (SHELL)	: TRIM-1029-0"-A-
TRIM (TUBE)	: TRIM-1024-0"-LP-	TRIM (TUBE)	: TRIM-1026-0"-LP-

- GENERAL NOTES:
- FOR SYMBOLS AND LEGEND, SEE DRAWINGS 24915-00-M6-00-00010 THRU 00015.
 - DRAWING NUMBERS IN OFF-PAGE CONNECTORS ARE TRUNCATED BY SUPPRESSING PROJECT NUMBER "24915" AND DOCUMENTS TYPE "M6". TWO LEADING ZEROS IN SEQUENCE NUMBER ARE NOT SHOWN.
 - ALL EQUIPMENT NUMBERS, INSTRUMENT TAG NUMBERS AND VALVE NUMBERS ARE PREFIXED "07" UNLESS OTHERWISE NOTED.
 - DELETED.
 - DELETED.
 - ALL EQUIPMENT AND PIPING SHOWN ON THIS DRAWING ARE LOCATED OUTDOORS.
 - DELETED.

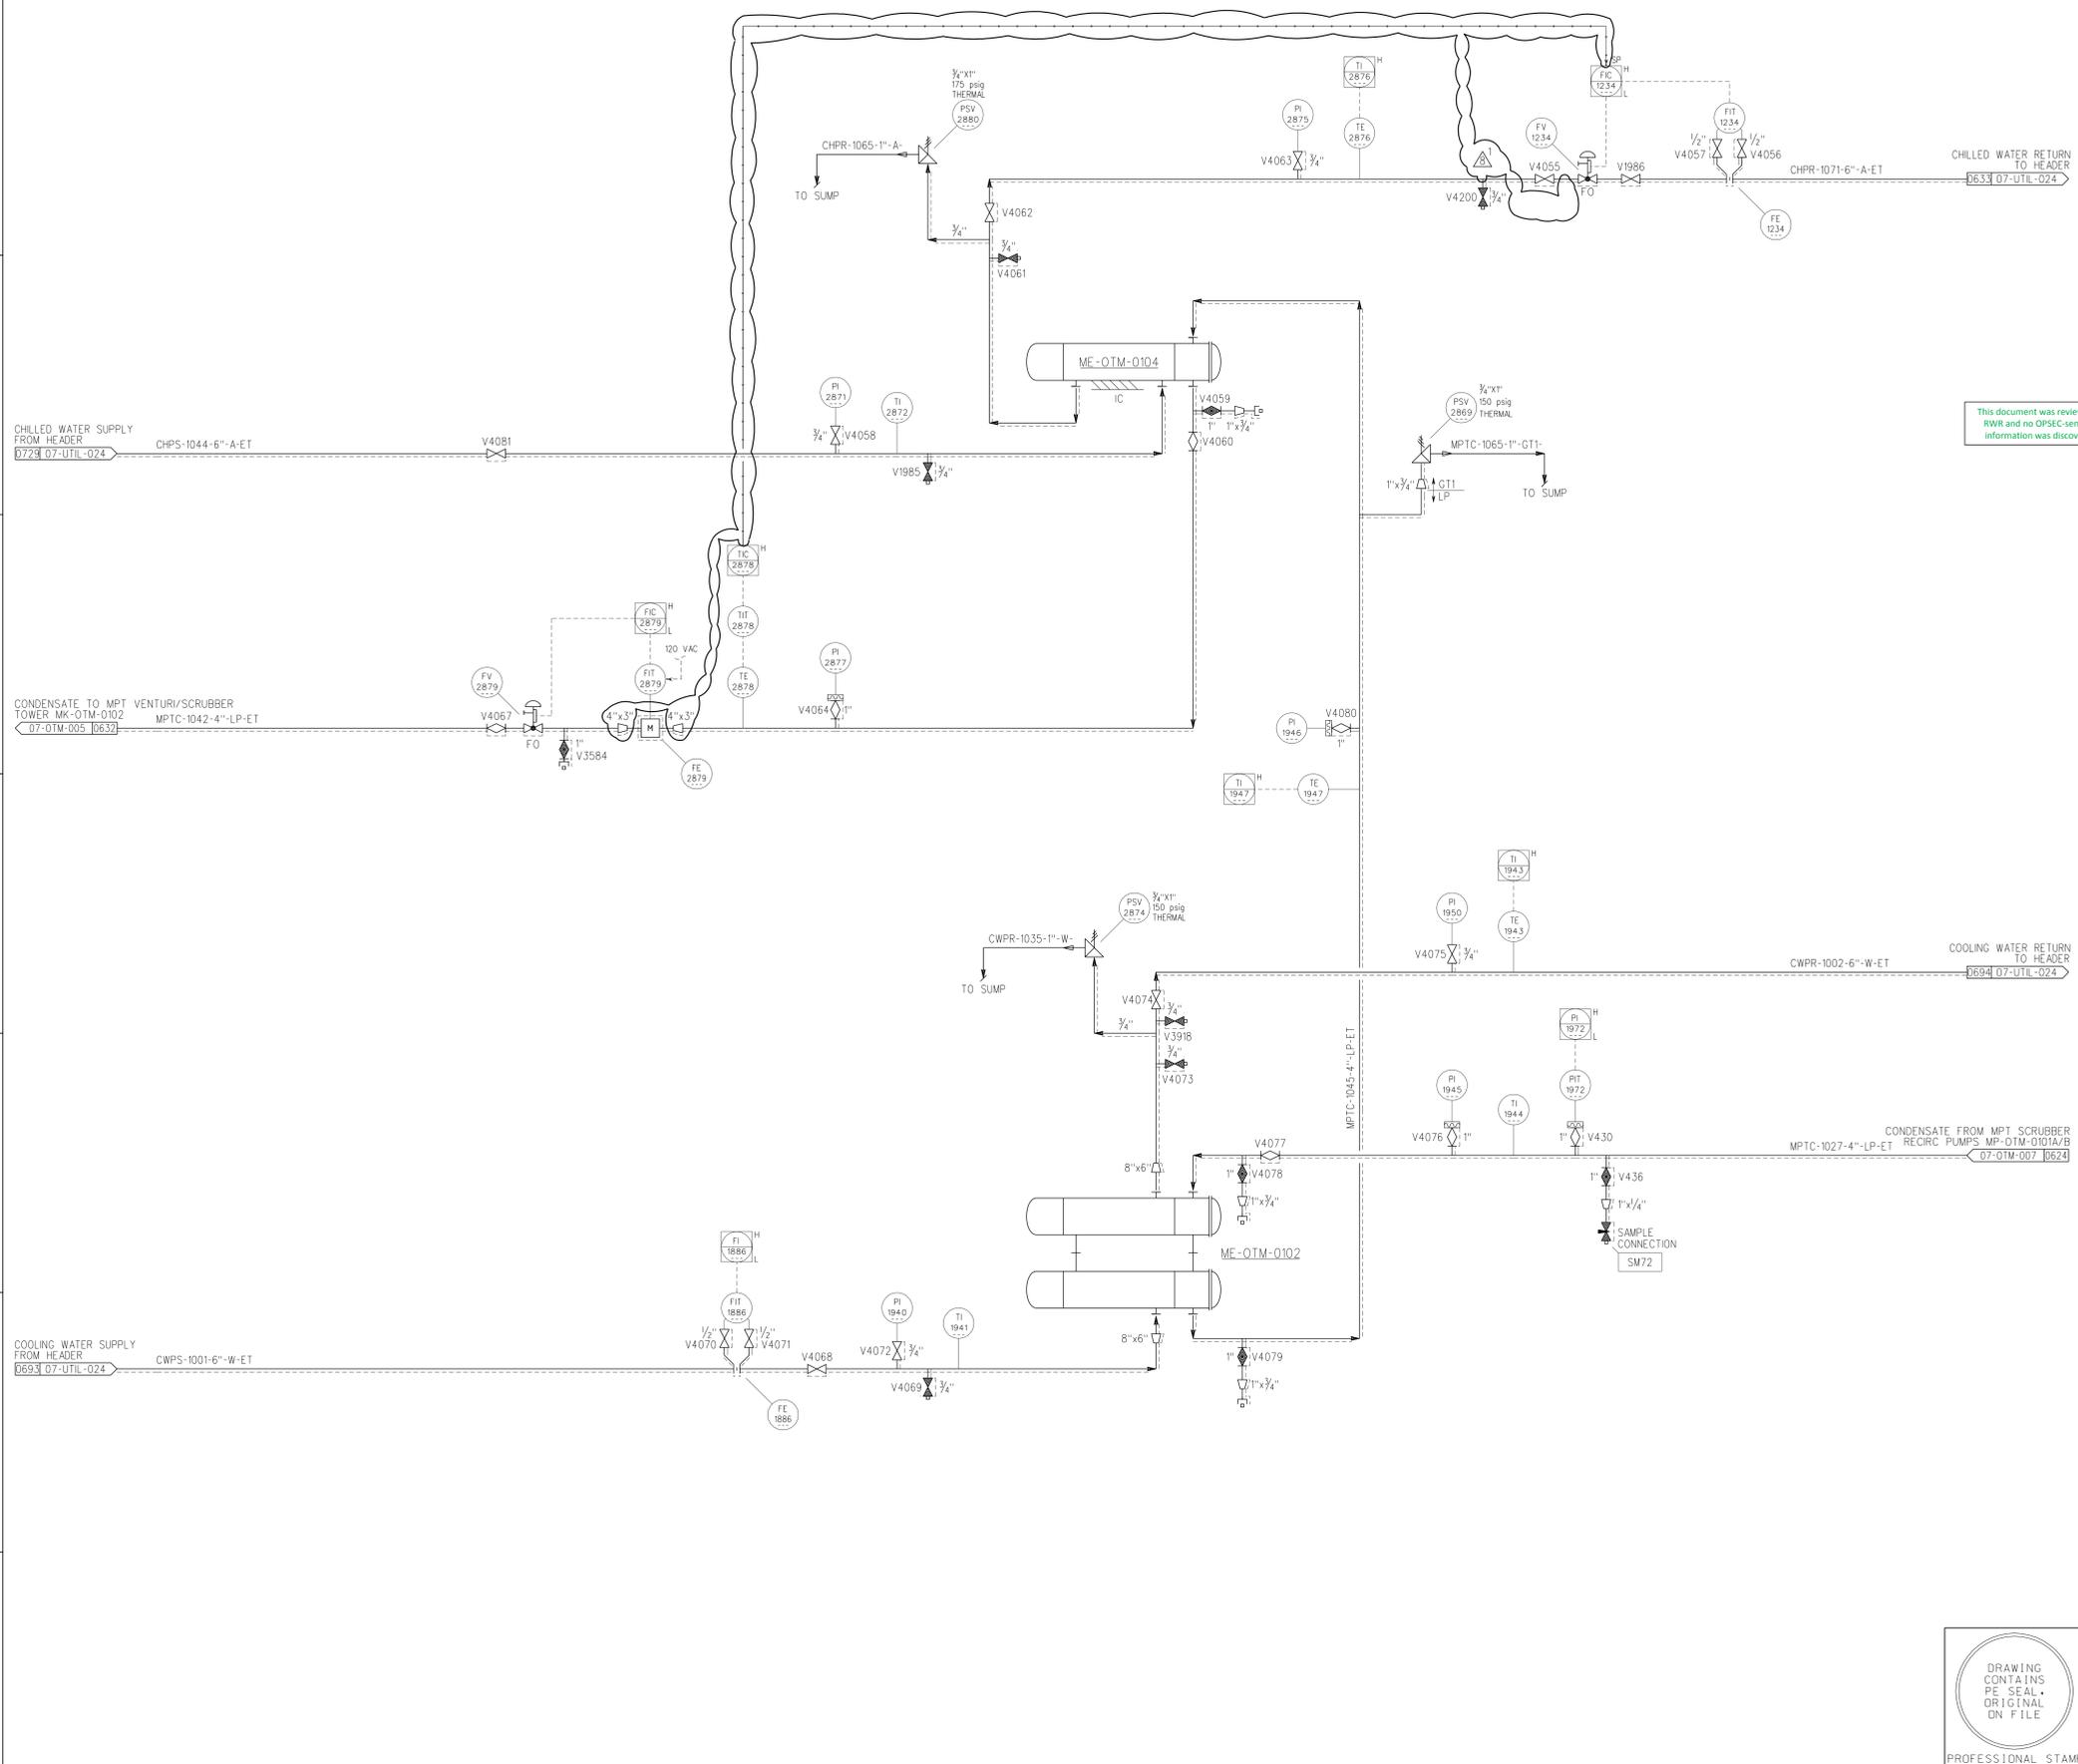

This document was reviewed by RWR and no OPIEC-sensitive information was discovered.

BASED ON BLUE GRASS PFD 24915-07-M6-OTM-00001 REV.7
BASED ON BLUE GRASS MSD 24915-07-NO-OTM-00001 REV.6
REFERENCE DRAWINGS

NO.	DATE	DESCRIPTION	DR	CK	DL	PE	APVD
28	05/17/12	IFC, INCORPORATED DCN-784		BOT	JAW	SA	KMR
27	01/15/09	IFC, INC HTL 1297-1299, ADDED VENDOR DATA, REVISED PSV	JLL	PEB	BM	BBB	BBB
26	07/03/07	IFC, MOVED COOLER NOZZLE AND FIT, TREND *139	JSM	JLL	PEB	JB	BBB
25	11/22/06	IFD, ADDED MODEL REVIEW COMMENTS	JSM	JLL	PEB	JB	BBB
24	09/19/06	ISSUED FOR DESIGN (IFD), ADD DESIGN DEVELOPMENT	JSM	JLL	PEB	JB	BBB
23	05/02/06	ISSUED FOR DESIGN (IFD), ADD DESIGN DEVELOPMENT	JSM	JLL	PEB	JB	BBB
22	02/22/06	ISSUED FOR DESIGN (IFD), ADD DESIGN DEVELOPMENT	JSM	JLL	PEB	JB	BBB
21	01/15/06	IF A, ADD DC-1, DESIGN DEVELOPMENT	JSM	JLL	PEB	JB	PKG

QUALITY 0 Non-0

BECHTEL PARSONS BLUE GRASS
 A joint venture of Bechtel Technology, Inc. and Parsons Infrastructure & Technology Group, Inc.

DDO PROGRAM MANAGER FOR ASSEMBLED CHEMICAL WEAPONS ASSESSMENT EDGEWOOD, MARYLAND

US ARMY ENGINEERING AND SUPPORT CENTER, HUNTSVILLE, ALABAMA

BLUE GRASS CHEMICAL AGENT DESTRUCTION PILOT PLANT PROJECT (BGCAPP)
 RICHMOND, KENTUCKY
 DAAA09-03-D-0023


MUNITIONS DEMILITARIZATION BUILDING SCRUBBER RECIRCULATION COOLERS PIPING & INSTRUMENT DIAGRAM

DRAWING NUMBER	SHEET	REV
24915-07-M6-OTM-00013	1 OF 1	8

DRAWING CONTAINS PE SEAL ORIGINAL ON FILE

PROFESSIONAL STAMP

07MOTM03.pfd 05/21/12
 DESIGN FILE: DONSPEC AT SYTIME USING COLORPLOT
 PLOTTED BY: USER ON DATE: 5/21/12 9:56:10 AM

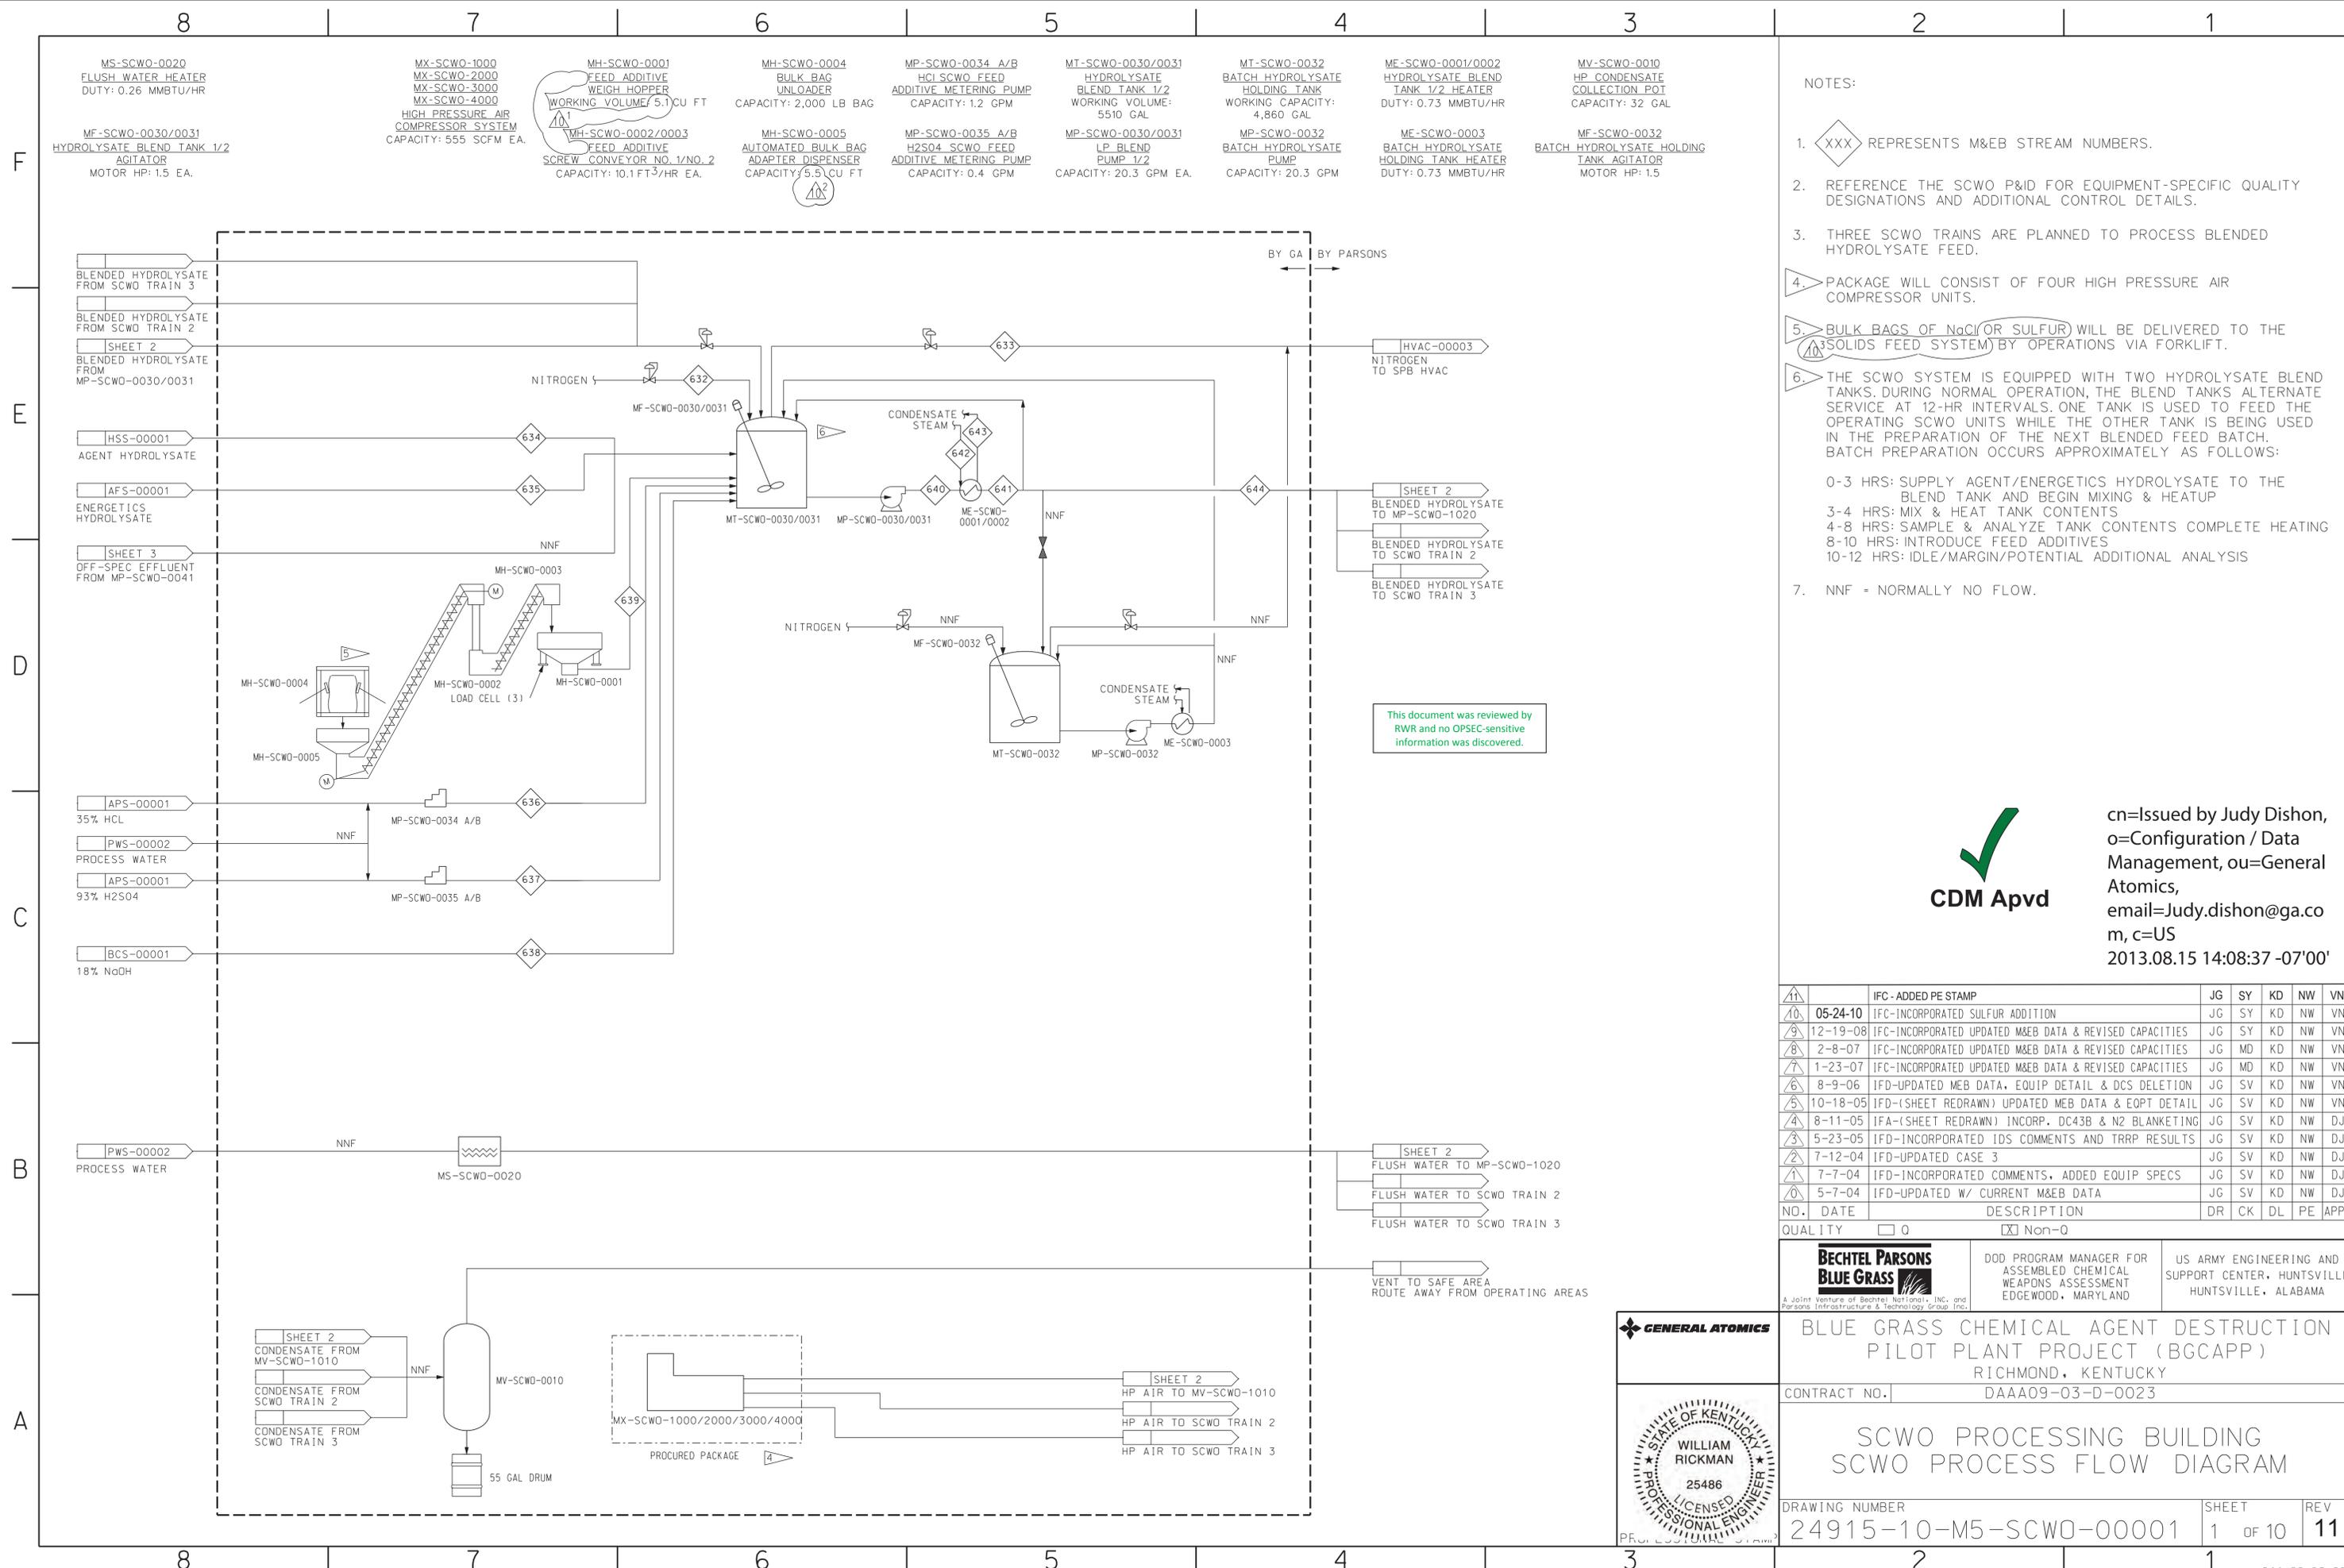


CDM Apvd
 cn=Issued by Judy Dishon,
 o=Configuration / Data
 Management, ou=General
 Atomics,
 email=Judy.dishon@ga.co
 m, c=US
 2013.08.15 14:08:37 -07'00'

NO.	DATE	DESCRIPTION	DR	CK	DL	PE	APPD
11		IFC - ADDED PE STAMP	JG	SY	KD	NW	VN
10	05-24-10	IFC-INCORPORATED SULFUR ADDITION	JG	SY	KD	NW	VN
9	12-19-08	IFC-INCORPORATED UPDATED M&EB DATA & REVISED CAPACITIES	JG	SY	KD	NW	VN
8	2-8-07	IFC-INCORPORATED UPDATED M&EB DATA & REVISED CAPACITIES	JG	MD	KD	NW	VN
7	1-23-07	IFC-INCORPORATED UPDATED M&EB DATA & REVISED CAPACITIES	JG	MD	KD	NW	VN
6	8-9-06	IFD-UPDATED M&EB DATA, EQUIP DETAIL & DCS DELETION	JG	SV	KD	NW	VN
5	10-18-05	IFD-(SHEET REDRAWN) UPDATED M&EB DATA & EQPT DETAIL	JG	SV	KD	NW	VN
4	8-11-05	IFA-(SHEET REDRAWN) INCORP. DC43B & N2 BLANKETING	JG	SV	KD	NW	DJ
3	5-23-05	IFD-INCORPORATED IDS COMMENTS AND TRRP RESULTS	JG	SV	KD	NW	DJ
2	7-12-04	IFD-UPDATED CASE 3	JG	SV	KD	NW	DJ
1	7-7-04	IFD-INCORPORATED COMMENTS, ADDED EQUIP SPECS	JG	SV	KD	NW	DJ
0	5-7-04	IFD-UPDATED W/ CURRENT M&EB DATA	JG	SV	KD	NW	DJ
NO.	DATE	DESCRIPTION	DR	CK	DL	PE	APPD

QUALITY 0 Non-0

BECHTEL PARSONS BLUE GRASS
 A Joint Venture of Bechtel National, Inc. and Parsons Infrastructure & Technology Group, Inc.

DOD PROGRAM MANAGER FOR ASSEMBLED CHEMICAL WEAPONS ASSESSMENT EDGEWOOD, MARYLAND

US ARMY ENGINEERING AND SUPPORT CENTER, HUNTSVILLE HUNTSVILLE, ALABAMA

GENERAL ATOMICS

BLUE GRASS CHEMICAL AGENT DESTRUCTION PILOT PLANT PROJECT (BGCAPP) RICHMOND, KENTUCKY


CONTRACT NO. DAAA09-03-D-0023

SCWO PROCESSING BUILDING SCWO PROCESS FLOW DIAGRAM

DRAWING NUMBER 24915-10-M5-SCWO-00001 SHEET 1 OF 10 REV 11


STATE OF KENTUCKY
 WILLIAM RICKMAN
 25486
 LICENSED PROFESSIONAL ENGINEER

BGCAPP_D3.BDR

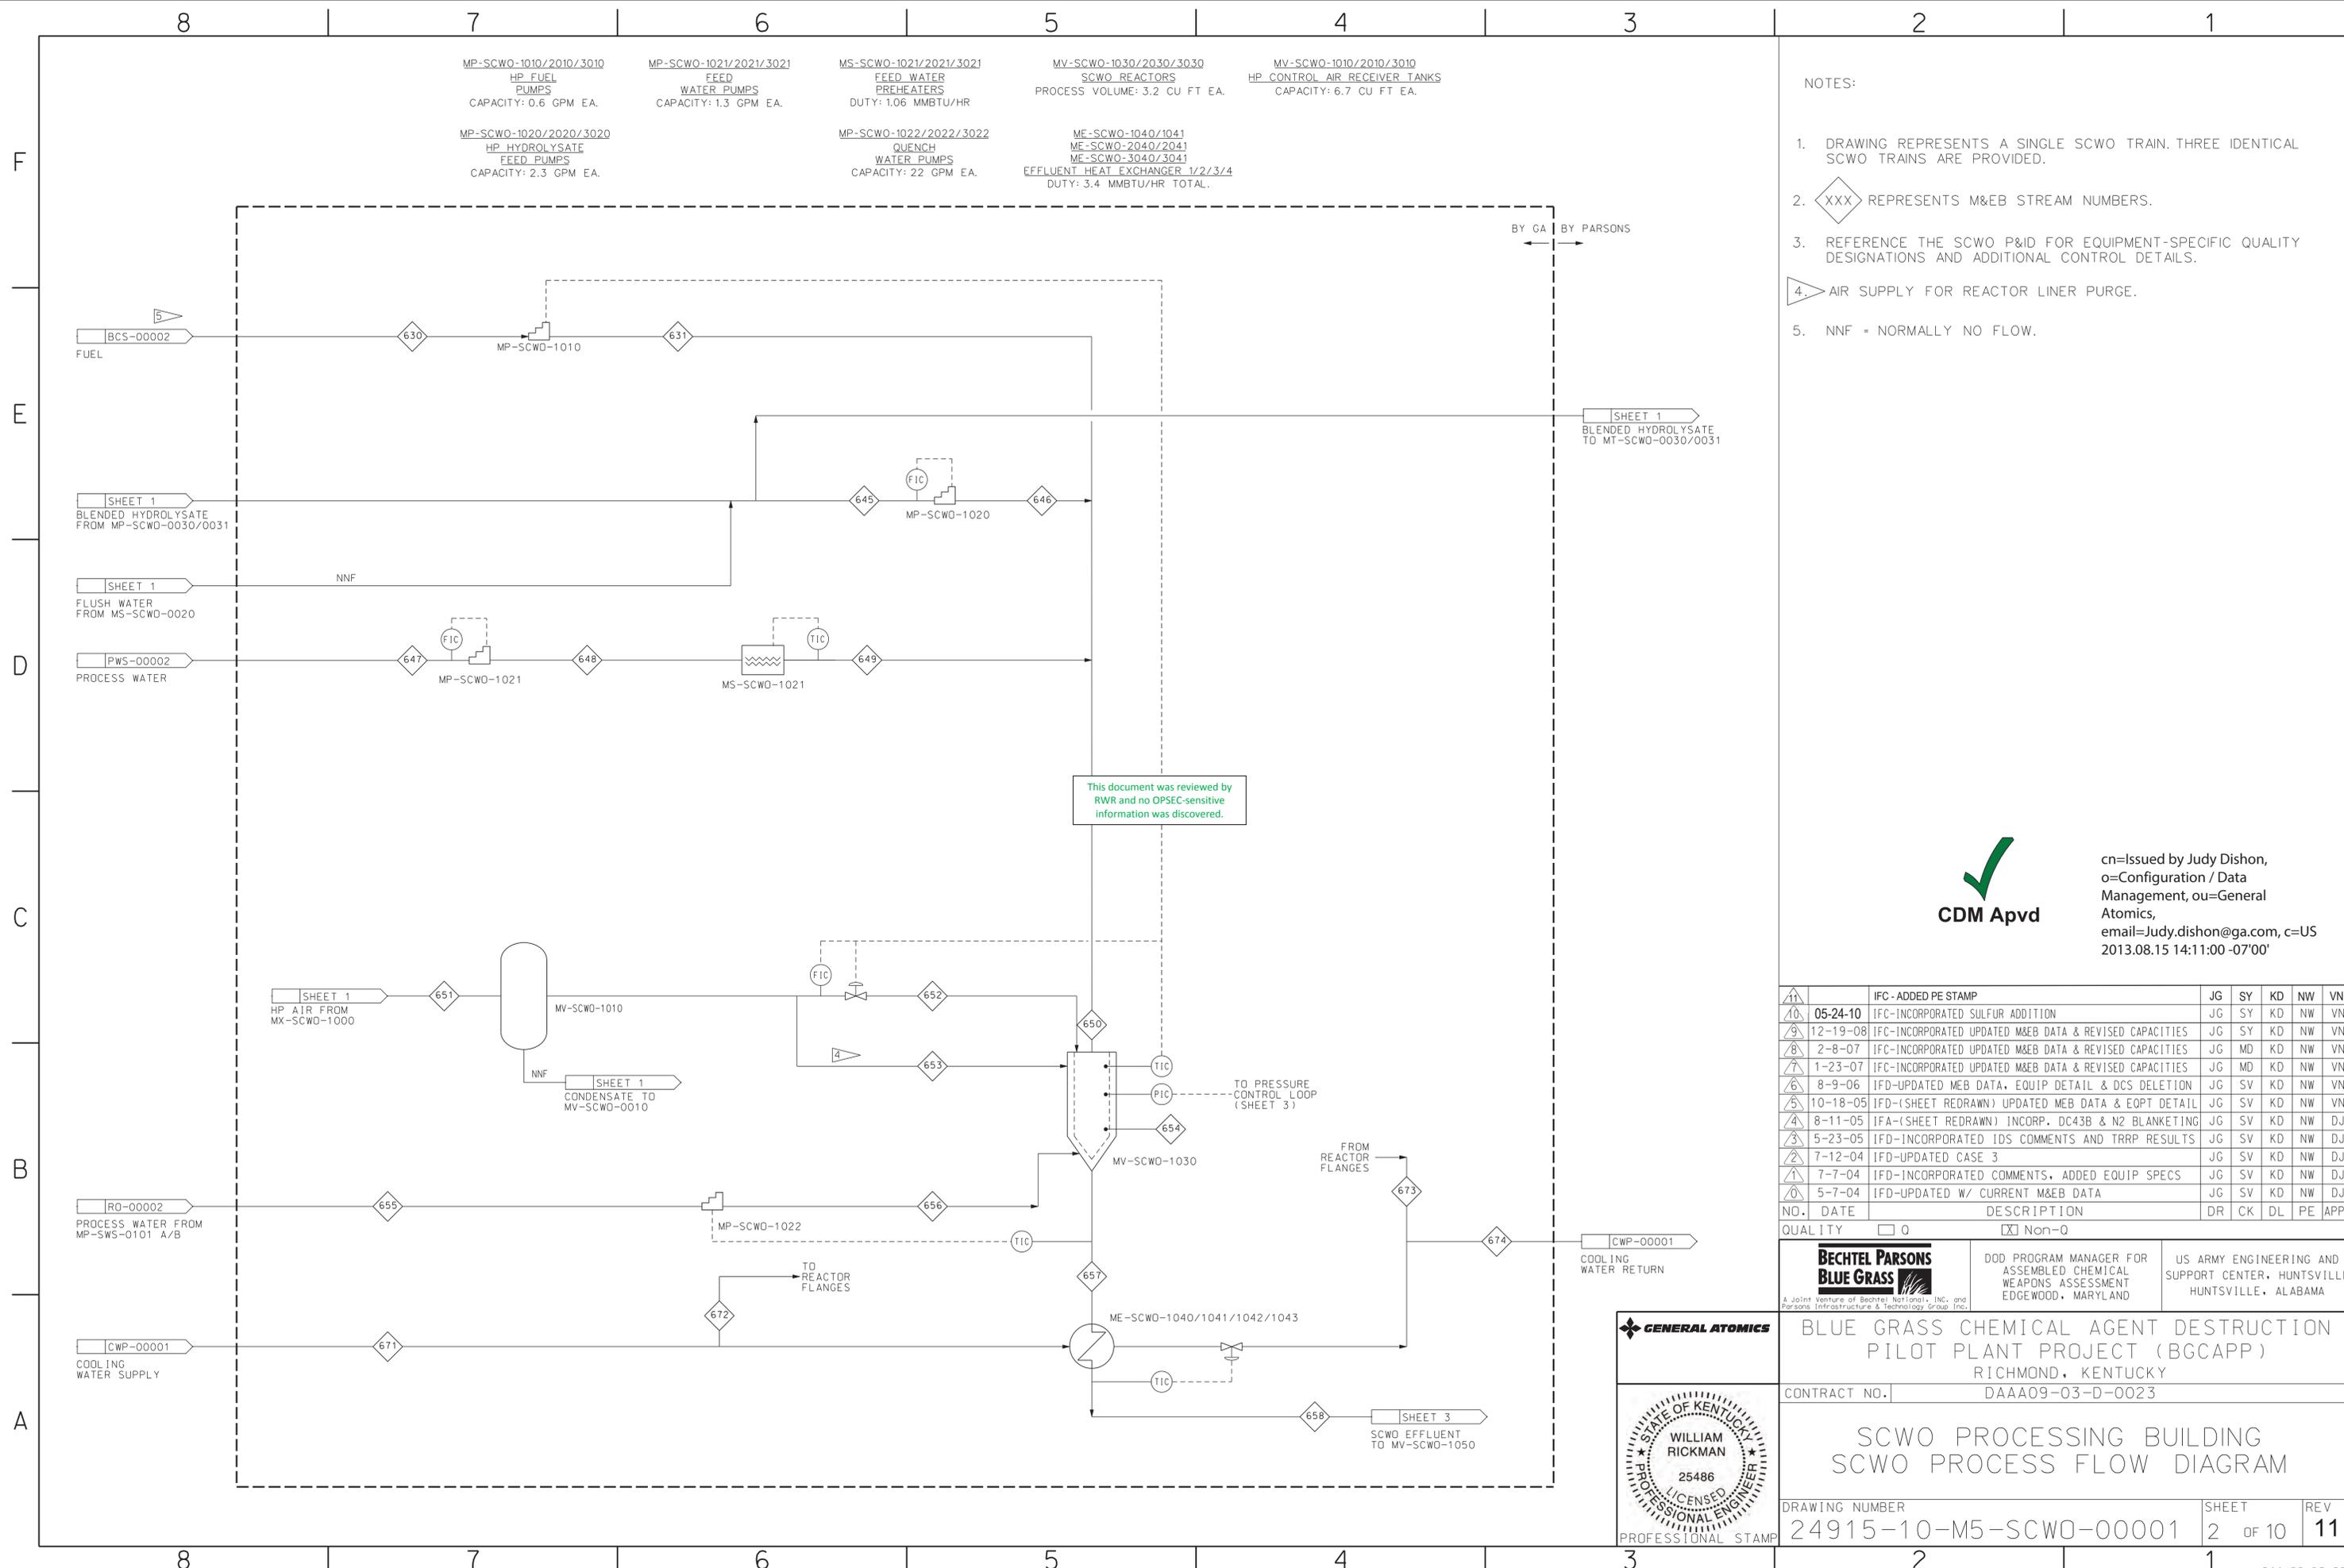

CDM Apvd

cn=Issued by Judy Dishon,
o=Configuration / Data Management, ou=General Atomics,
email=Judy.dishon@ga.com, c=US
2013.08.15 14:11:00 -07'00'

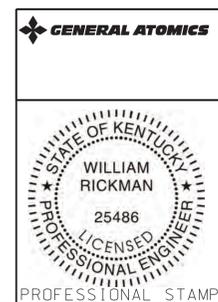

BECHTEL PARSONS BLUE GRASS
A Joint Venture of Bechtel National, Inc. and Parsons Infrastructure & Technology Group, Inc.

DOD PROGRAM MANAGER FOR ASSEMBLED CHEMICAL WEAPONS ASSESSMENT EDGEMOOD, MARYLAND


US ARMY ENGINEERING AND SUPPORT CENTER, HUNTSVILLE, ALABAMA

BLUE GRASS CHEMICAL AGENT DESTRUCTION PILOT PLANT PROJECT (BGCAPP)
RICHMOND, KENTUCKY

CONTRACT NO. DAAA09-03-D-0023

SCWO PROCESSING BUILDING SCWO PROCESS FLOW DIAGRAM

DRAWING NUMBER: 24915-10-M5-SCWO-00001
SHEET: 2 OF 10
REV: 11

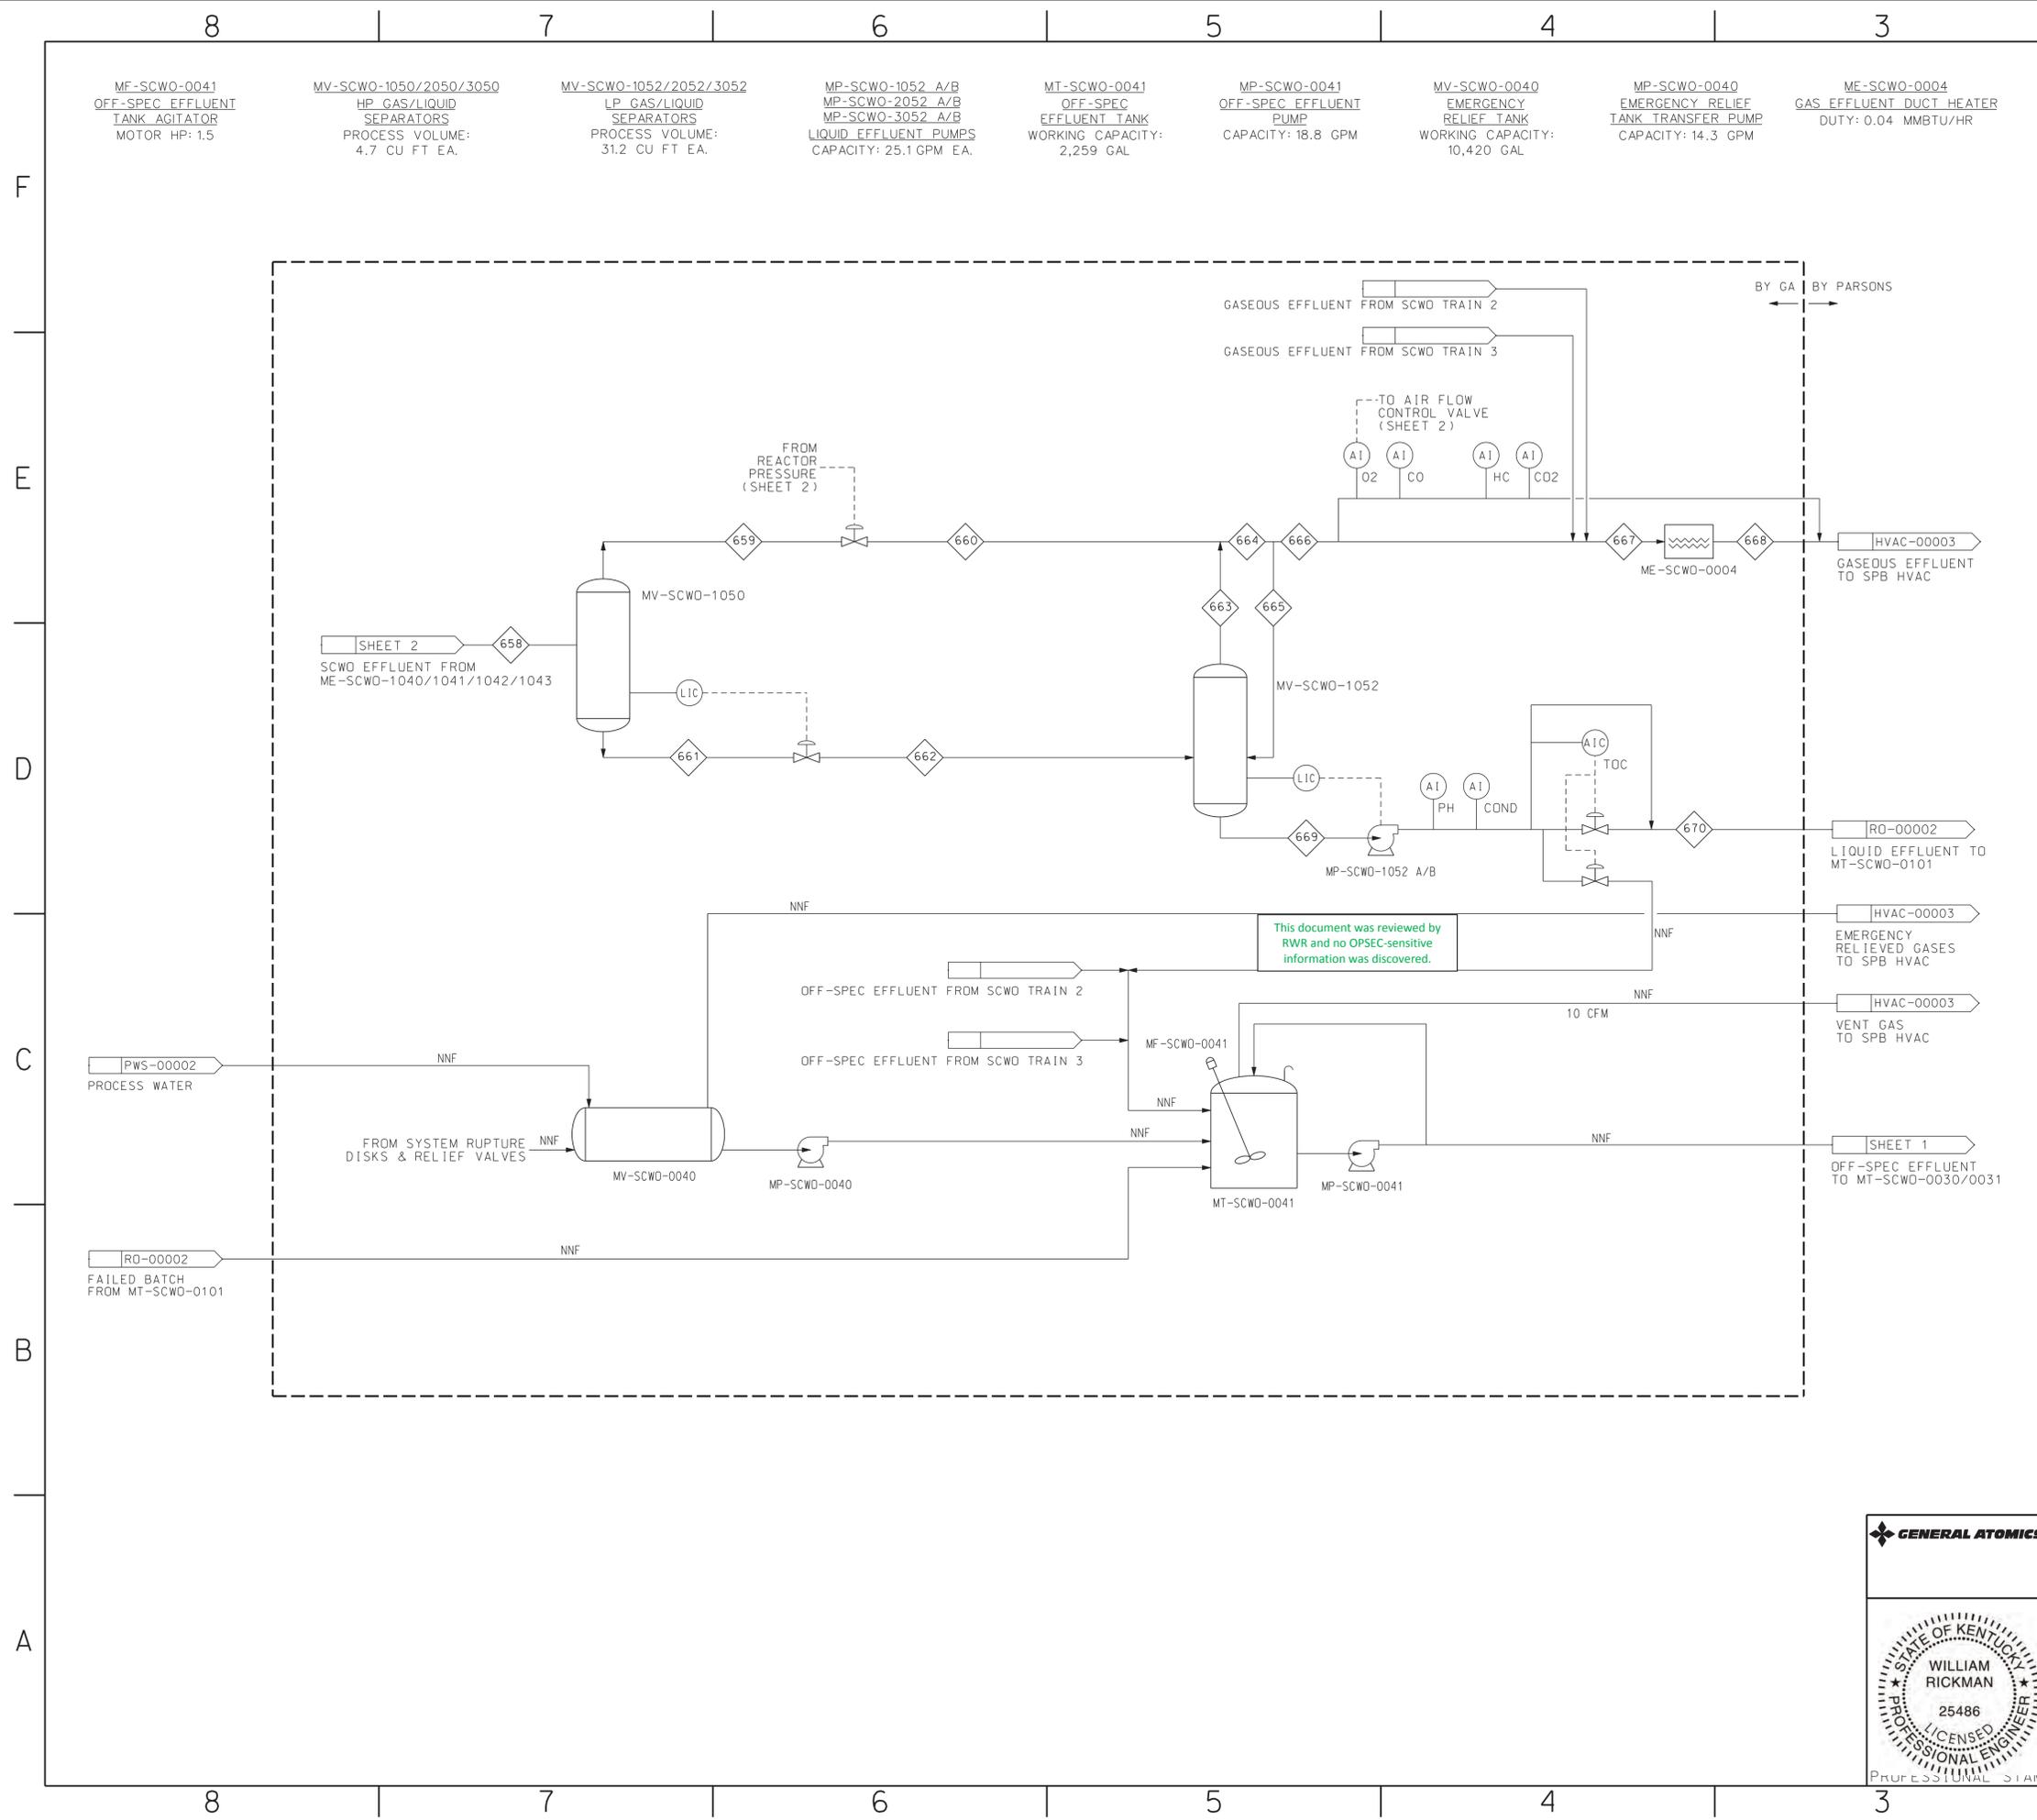

- NOTES:
- DRAWING REPRESENTS A SINGLE SCWO TRAIN. THREE IDENTICAL SCWO TRAINS ARE PROVIDED.
 - XXX REPRESENTS M&EB STREAM NUMBERS.
 - REFERENCE THE SCWO P&ID FOR EQUIPMENT-SPECIFIC QUALITY DESIGNATIONS AND ADDITIONAL CONTROL DETAILS.
 - THE FOLLOWING EQUIPMENT ON THIS SHEET SERVES THE SCWO SYSTEM IN ITS ENTIRETY AND WILL NOT BE PROVIDED ON A PER-TRAIN BASIS:
 - ME-SCWO-0004
 - MV-SCWO-0040
 - MP-SCWO-0040
 - MT-SCWO-0041
 - MP-SCWO-0041
 - MF-SCWO-0041
 - NNF = NORMALLY NO FLOW.

This document was reviewed by RWR and no OPSEC-sensitive information was discovered.



cn=Issued by Judy Dishon,
o=Configuration / Data Management, ou=General Atomics,
email=Judy.dishon@ga.com, c=US
2013.08.15 14:11:22 -07'00'

NO.	DATE	DESCRIPTION	DR	CK	DL	PE	APPD
11		IFC - ADDED PE STAMP	JG	SY	KD	NW	VN
10	05-24-10	IFC-INCORPORATED SULFUR ADDITION	JG	SY	KD	NW	VN
9	12-19-08	IFC-INCORPORATED UPDATED M&EB DATA & REVISED CAPACITIES	JG	SY	KD	NW	VN
8	2-8-07	IFC-INCORPORATED UPDATED M&EB DATA & REVISED CAPACITIES	JG	MD	KD	NW	VN
7	1-23-07	IFC-INCORPORATED UPDATED M&EB DATA & REVISED CAPACITIES	JG	MD	KD	NW	VN
6	8-9-06	IFD-UPDATED M&EB DATA, EQUIP DETAIL & DCS DELETION	JG	SV	KD	NW	VN
5	10-18-05	IFD-(SHEET REDRAWN) UPDATED M&EB DATA & EQPT DETAIL	JG	SV	KD	NW	VN
4	8-11-05	IFD-(SHEET REDRAWN) INCORP. DC43B & N2 BLANKETING	JG	SV	KD	NW	DJ
3	5-23-05	IFD-INCORPORATED IDS COMMENTS AND TRRP RESULTS	JG	SV	KD	NW	DJ
2	7-12-04	IFD-UPDATED CASE 3	JG	SV	KD	NW	DJ
1	7-7-04	IFD-INCORPORATED COMMENTS, ADDED EQUIP SPECS	JG	SV	KD	NW	DJ
0	5-7-04	IFD-UPDATED W/ CURRENT M&EB DATA	JG	SV	KD	NW	DJ

QUALITY 0 Non-0

BECHTEL PARSONS BLUE GRASS
A Joint Venture of Bechtel National, Inc. and Parsons Infrastructure & Technology Group, Inc.


DOD PROGRAM MANAGER FOR ASSEMBLED CHEMICAL WEAPONS ASSESSMENT EDGEWOOD, MARYLAND

US ARMY ENGINEERING AND SUPPORT CENTER, HUNTSVILLE HUNTSVILLE, ALABAMA

GENERAL ATOMICS

BLUE GRASS CHEMICAL AGENT DESTRUCTION PILOT PLANT PROJECT (BGCAPP) RICHMOND, KENTUCKY

CONTRACT NO. DAAA09-03-D-0023

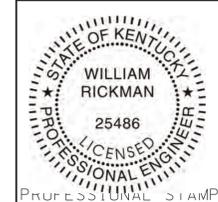

SCWO PROCESSING BUILDING
SCWO PROCESS FLOW DIAGRAM

DRAWING NUMBER	SHEET	REV
24915-10-M5-SCWO-00001	3 OF 10	11

CASE 1: GB BLENDED HYDROLYSATE FEED BASE CASE

Table with columns for Stream Number (600-674) and Line Description. Rows include Temperature, Pressure, Average Volumetric Flow, Viscosity, Density, Molecular Weight, Enthalpy, and Vapor/Liquid flow rates for various chemical species.

- GENERAL NOTES:
1. ALL INFORMATION AND CALCULATIONS USED IN THE DETERMINATION OF STREAM DATA...
2. THE INSTANTANEOUS FLOW RATES FOR STREAMS 634, 635 ASSUME THE DELIVERY OF A 12-HR SUPPLY OF AGENT/ENERGETICS...
3. THE INSTANTANEOUS FLOW RATES OF STREAMS 636, 637 CORRESPOND TO THE DELIVERY OF A 12-HR SUPPLY OF EACH FEED ADDITIVE IN 1-HR.

This document was reviewed by RWR and no OPSEC-sensitive information was discovered.


CDM Apvd
cn=Issued by Judy Dishon, o=Configuration / Data Management, ou=General Atomics, email=Judy.dishon@ga.com, c=US 2013.08.15 14:11:55 -07'00'

Table with columns: NO., DATE, DESCRIPTION, DR, CK, DL, PE, APPD. Contains revision history for IFC (ADDED PE STAMP), IFC-INCORPORATED SULFUR ADDITION, IFC-INCORPORATED UPDATED M&E DATA & REVISED CAPACITIES, etc.

QUALITY [X] Non-Q
BECHTEL PARSONS BLUE GRASS
DOD PROGRAM MANAGER FOR ASSEMBLED CHEMICAL WEAPONS ASSESSMENT EDGEWOOD, MARYLAND
US ARMY ENGINEERING AND SUPPORT CENTER, HUNTSVILLE HUNTSVILLE, ALABAMA

BLUE GRASS CHEMICAL AGENT DESTRUCTION PILOT PLANT PROJECT (BGCAPP) RICHMOND, KENTUCKY
CONTRACT NO. DAAA09-03-D-0023

SCWO PROCESSING BUILDING SCWO PROCESS FLOW DIAGRAM
DRAWING NUMBER 24915-10-M5-SCWO-0001 SHEET 4 of 10 REV 11

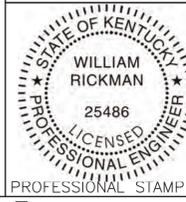

8

7

6

5

4

3

2


1

GENERAL NOTES:

- 1. ALL INFORMATION AND CALCULATIONS USED IN THE DETERMINATION OF STREAM DATA MAY BE FOUND IN THE "MASS AND ENERGY BALANCES FOR THE SCWO SYSTEM", CALC. NO. 24915-10-M4-SCWO-00001, REV. 11, MAY 2010.

CASE 4: PRE-IGNITION CASE

STREAM NUMBER	630	631	632	
LINE DESCRIPTION	LP Fuel	HP Fuel	Nitrogen Blanket In	Nitrogen Blanket Out	Agent Hydrolysate	Energetic Hydrolysate	35% HCl Solution	93% H2SO4 Solution	18% NaOH Solution	NaCl Additive	Blended Hydrolysate to Heater Inlet	Blended Hydrolysate from Heater Outlet	Steam to Blended Hydrolysate Heater	Condensate from Blended Hydrolysate Heater	Blended Hydrolysate to Heater	LP Blended Hydrolysate Feed	HP Blended Hydrolysate Feed	LP Feed Water	HP Feed Water	Feed Water After Preheater	Combined Nozzle Feed	HP Air from Compressor	HP Reaction Air	Liner Purge Air	Pre-Quench Reaction Products	LP Quench Water	HP Quench Water	Quenched Effluent	Cooled Effluent	HP Gas Effluent from HP GLS	LP Gas Effluent from HP GLS	HP Liquid Effluent from HP GLS	LP Liquid Effluent from HP GLS	Gaseous Effluent from LP GLS	Recombined Gaseous Effluent	Liquid Return to LP GLS	Gaseous Effluent	Inlet to Gas Effluent Heater	Outlet from Gas Effluent Heater	Liquid Effluent	Liquid Effluent to RO	Cooling Water Supply	Cooling Water to Reactor Flange	Cooling Water from Reactor Flange	Cooling Water Return	
TEMPERATURE	F																	77	77.9	1000	1000	70	70	70	631.7	77	77.9	383	140	140	45	140	139.6	139.6	94.9	94.9	94.9	110	139.6	139.5	90	90	106	117.5		
PRESSURE	PSIA																		99.23	3665	3665	3665	3415	3415	54.23	3415	3415	3415	3415	14.23	14.23	14.23	14.23	14.23	14.23	14.23	14.23	14.23	104.23	14.23	84.23	84.23				
AVERAGE VOLUMETRIC FLOW	GPM (ACFM)																		1.301	1.288	(2.033)	(2.033)	(0.432)	(0.338)	(0.089)	14.624	3.408	3.374	11.211	8.682	(0.382)	5.752	293.325	(38.581)	883.215	0.006	(118.076)	354.229	(364.963)	4.736	51.446	9.028	9.028	9.058	51.755	
DENSITY	LB/FT3																		5.328	5.328	17.85	17.85	16.826	8.301				10.161	14.588	14.588	0.076	14.588	0.06	0.06	0.068	0.068	0.068	0.068	0.068	0.068	0.068	0.068	0.068	0.068		
VISCOSITY	CP																		0.03	0.03	0.026	0.026	0.026	0.026				0.026	0.02	0.02	0.017	0.02	0.019	0.019	0.019	0.019	0.019	0.019	0.019	0.019	0.019	0.019	0.019	0.019		
DENSITY	LB/FT3																		62.267	62.928					41.305	62.247	62.87	55.007	61.509				61.509	61.376			62.057			61.376	61.379	62.137	62.137	61.933	61.766	
VISCOSITY	CP																		0.913	0.902					0.07	0.913	0.904	0.137	0.468				0.468	0.476			0.741			0.476	0.476	0.783	0.657	0.584		
MOLECULAR WEIGHT																			18.015	18.015	18.015	18.015	28.863	28.863	28.863	20.835	18.022	18.022	19.213	19.213	28.857	28.857	18.372	18.372	26.913	28.252	18.016	28.329	28.329	28.329	18.022	18.015	18.015	18.015		
ENTHALPY	MM BTUHR																		-4.433	-4.427	-3.54	-3.54	-0.039	-0.037	-0.002	-3.684	-11.603	-11.596	-15.238	-15.869	-0.003	-0.006	-15.866	-15.866	-0.11	-0.116	-0.016	-0.101	-0.302	-0.297	-15.771	-15.771	-174.563	-30.635	-30.563	-173.861
VAPOR	
H2O	LB/HR																		650	650	0	0	0	602.197			31.49	0.739	0.554	0.554	0.185	19.368	19.368	19.922		19.922	59.766	59.766								
IPA	LB/HR																		0	0	0	0	0	0	0	0	0	0	0	0	0	0	0	0	0	0	0	0	0	0	0	0	0			
N2	LB/HR																		0	0	349.136	273.631	75.935	273.271			341.888	344.217	258.163	258.163	86.054	90.594	90.594	348.757	348.757	1046.271	1046.271									
CO2	LB/HR																		0	0	107.038	83.898	23.148	83.713			103.823	106.300	19.740	19.740	28.590	27.110	27.110	108.850	108.850	320.650	320.650									
ARGON	LB/HR																		0	0	5.959	4.67	1.289	4.67			5.869	5.867	4.401	4.401	1.467	1.557	1.557	5.958	5.958	17.874	17.874									
CO2	LB/HR																		0	0	0.267	0.209	0.058	0.209			0.267	0	0	0	0	0.264	0.264	0.264	0.264	0.264	0.792	0.792								
NAF	LB/HR																		0	0	0	0	0	0			0	0	0	0	0	0	0	0	0	0	0	0	0	0	0	0	0			
NAHCO3	LB/HR																		0	0	0	0	0	0			0	0	0	0	0	0	0	0	0	0	0	0	0	0	0	0	0			
NaCl	LB/HR																		0	0	0	0	0	0			0	0	0	0	0	0	0	0	0	0	0	0	0	0	0	0	0			
NA2CO3	LB/HR																		0	0	0	0	0	0			0	0	0	0	0	0	0	0	0	0	0	0	0	0	0	0	0			
NA2SO4	LB/HR																		0	0	0	0	0	0			0	0	0	0	0	0	0	0	0	0	0	0	0	0	0	0	0			
NAH2PO4	LB/HR																		0	0	0	0	0	0			0	0	0	0	0	0	0	0	0	0	0	0	0	0	0	0				
NA3HPO4	LB/HR																		0	0	0	0	0	0			0	0	0	0	0	0	0	0	0	0	0	0	0	0	0	0				
NA3PO4	LB/HR																		0	0	0	0	0	0			0	0	0	0	0	0	0	0	0	0	0	0	0	0	0	0				
TOTAL VAPOR	LB/HR	0.0	0.0	0.0	0.0	0.0	0.0	0.0	0.0	0.0	0.0	0.0	0.0	0.0	0.0	0.0	0.0	0.0	650.0	650.0	462.4	362.4	100.0	964.1	0.0	0.0	483.3	457.1	342.9	342.9	114.3	138.9	138.9	481.8	481.8	1445.3	1445.3	0.0	0.0	0.0	0.0	0.0	0.0			
LIQUID (including dissolved gases)	
H2O	LB/HR																		650	650					47.803	1700.76	1700.76	2319.269	2350.02			2350.02	2330.837	2.3	2.3	2.3			2330.837	2330.837	25641.79	4500	4500	25641.79		
IPA	LB/HR																		0	0	0	0	0	0			0	0	0	0	0	0	0	0	0	0	0	0	0	0	0	0	0			
N2	LB/HR																		0	0	0	0	0	0			0	0	0	0	0	0	0	0	0	0	0	0	0	0	0	0	0	0		
CO2	LB/HR																		0	0	0	0	0	0			0	0	0	0	0	0	0	0	0	0	0	0	0	0	0	0	0	0		
ARGON	LB/HR																		0	0	0	0	0	0			0	0	0	0	0	0	0	0	0	0	0	0	0	0	0	0	0	0		
CO2	LB/HR																		0	0	0	0	0	0			0	0	0	0	0	0	0	0	0	0	0	0	0	0	0	0	0			
NAF	LB/HR																		0	0	0	0	0	0			0	0	0	0	0	0	0	0	0	0	0	0	0	0	0	0	0			
NAHCO3	LB/HR																		0	0	0	0	0	0			0	0	0	0	0	0	0	0	0	0	0	0	0	0	0	0	0			
NaCl	LB/HR																		0	0	0	0	0	0			0	0	0	0	0	0	0	0	0	0	0	0	0	0	0	0	0			
NA2CO3	LB/HR																		0	0	0	0	0	0			0																			

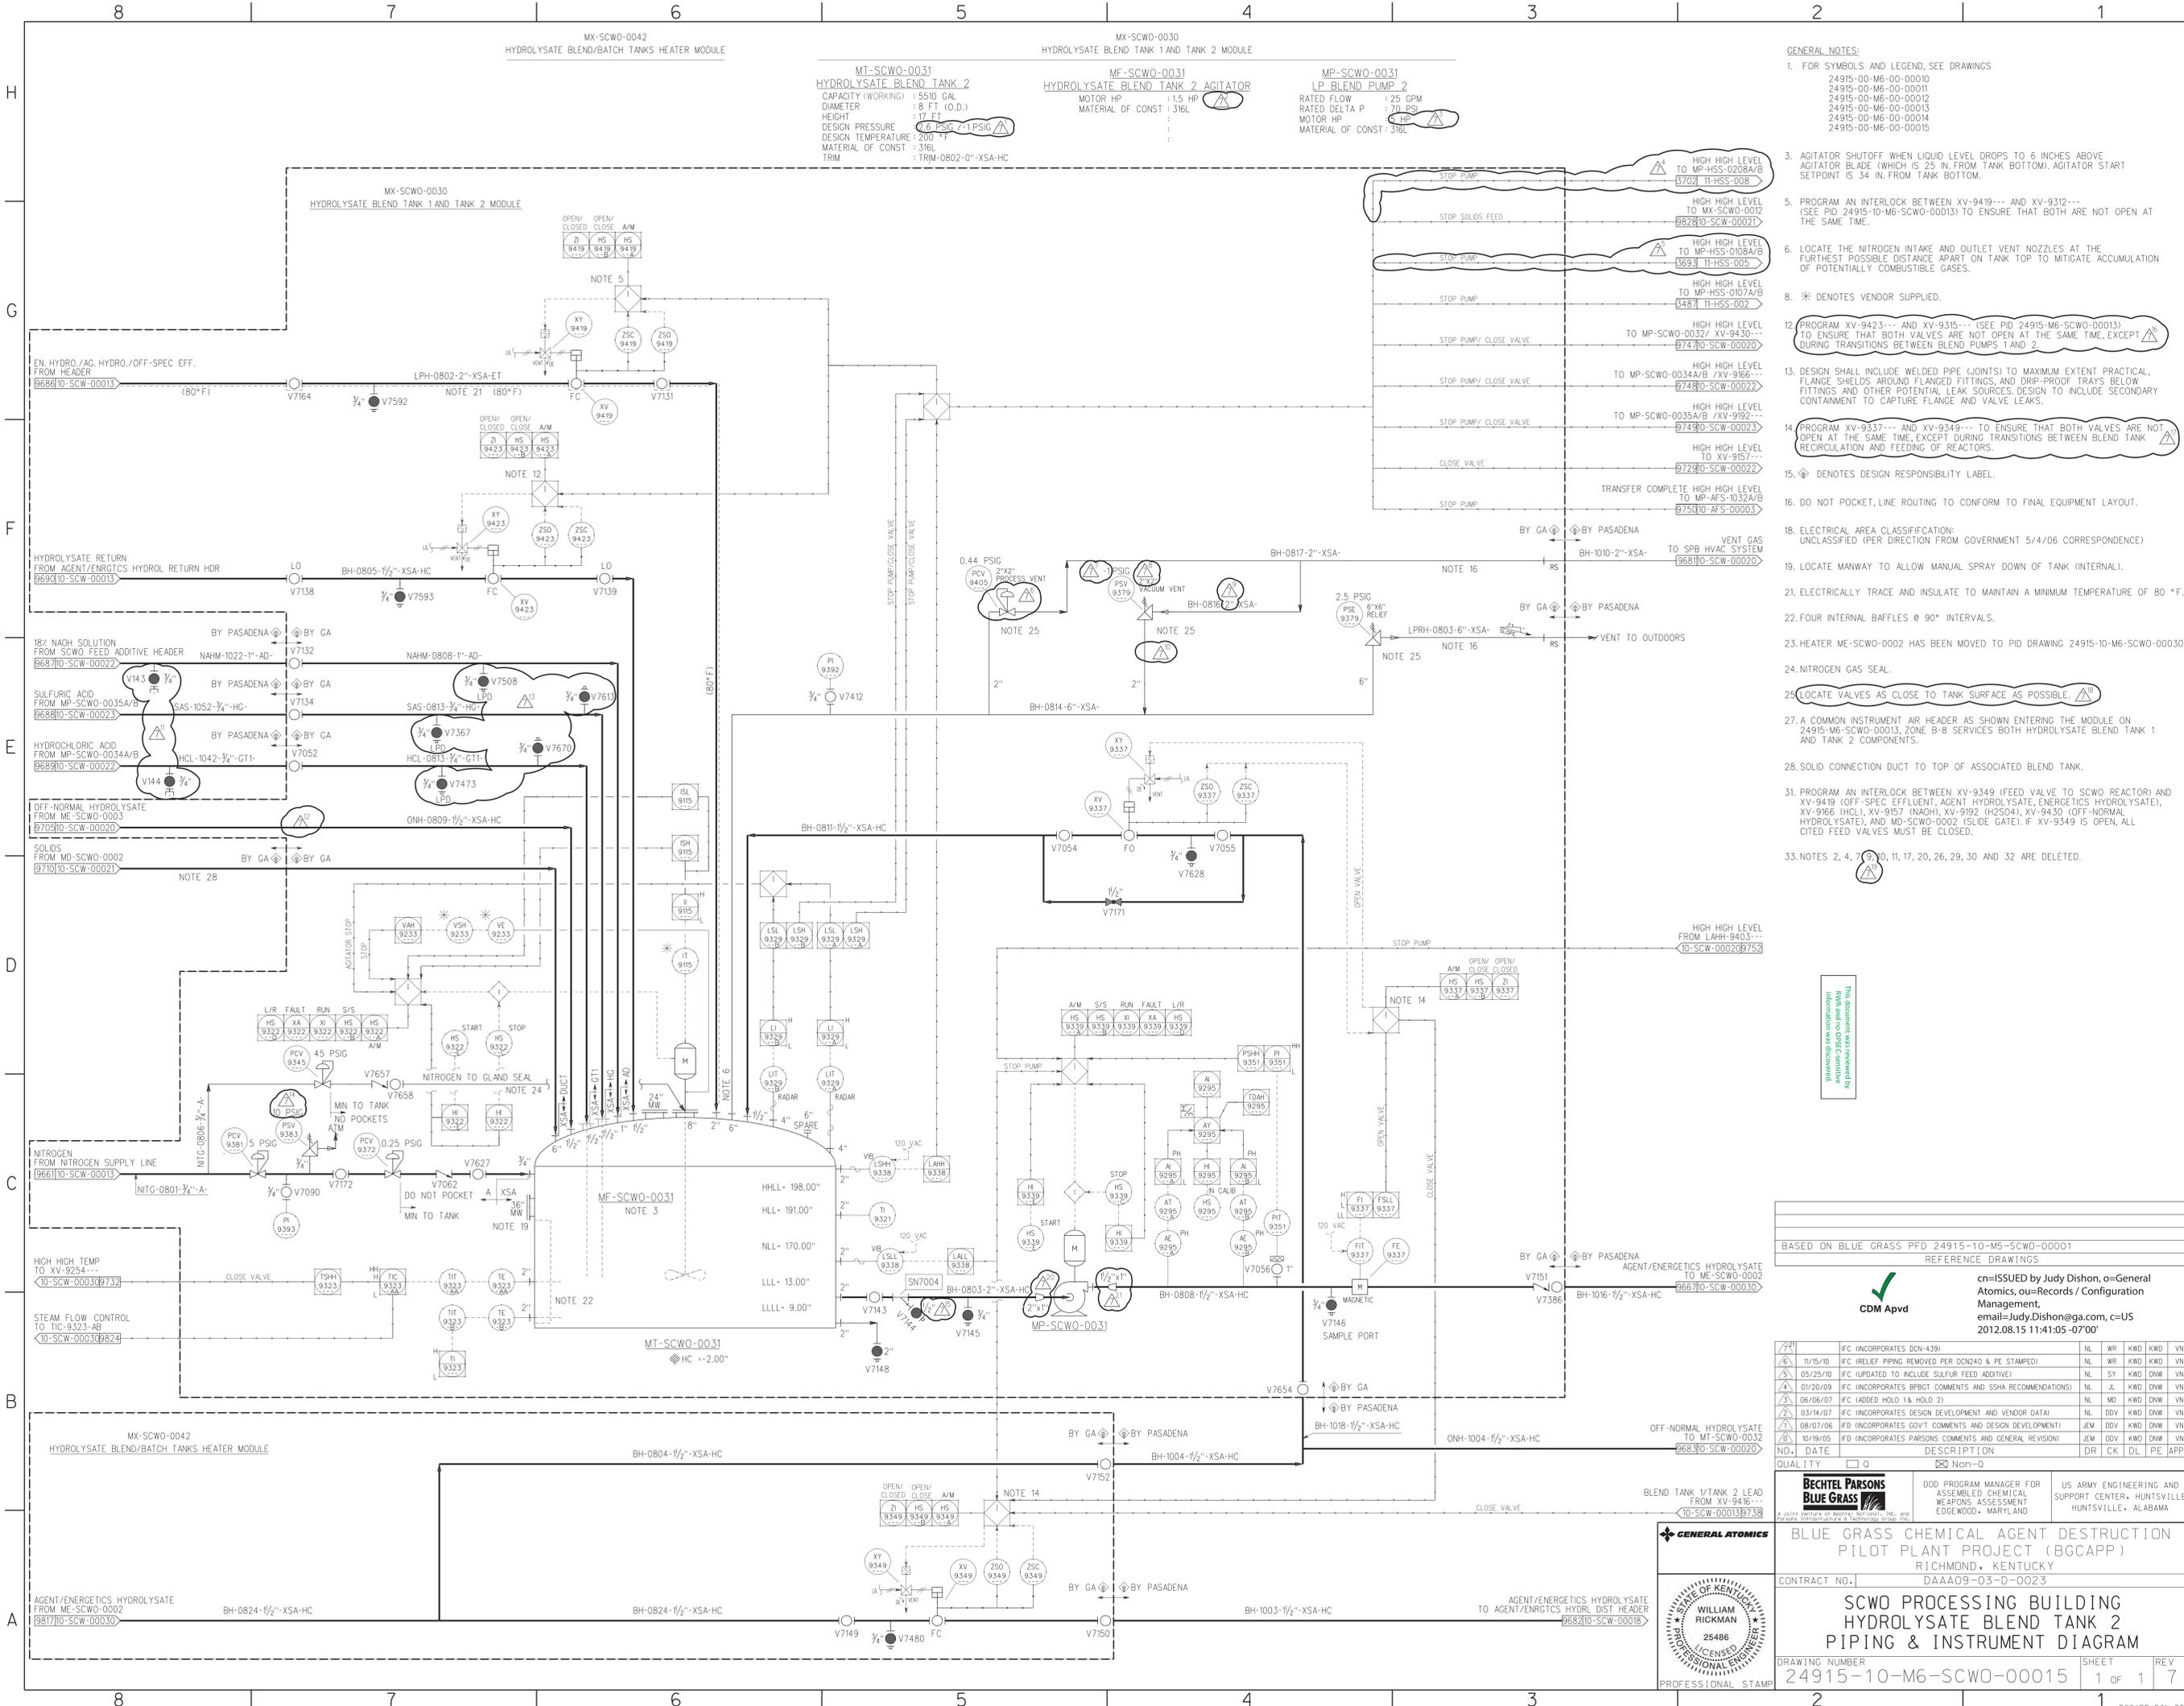

- GENERAL NOTES:**
- FOR SYMBOLS AND LEGEND, SEE DRAWINGS.
24915-00-M6-00-00010
24915-00-M6-00-00011
24915-00-M6-00-00012
24915-00-M6-00-00013
24915-00-M6-00-00014
24915-00-M6-00-00015
 - AGITATOR SHUTOFF WHEN LIQUID LEVEL DROPS TO 6 INCHES ABOVE AGITATOR BLADE (WHICH IS 25 IN. FROM TANK BOTTOM). AGITATOR START SETPOINT IS 34 IN. FROM TANK BOTTOM.
 - PROGRAM AN INTERLOCK BETWEEN XV-9419--- AND XV-9312--- (SEE PID 24915-10-M6-SCWO-00013) TO ENSURE THAT BOTH ARE NOT OPEN AT THE SAME TIME.
 - LOCATE THE NITROGEN INTAKE AND OUTLET VENT NOZZLES AT THE FURTHEST POSSIBLE DISTANCE APART ON TANK TOP TO MITIGATE ACCUMULATION OF POTENTIALLY COMBUSTIBLE GASES.
 - * DENOTES VENDOR SUPPLIED.
 - PROGRAM XV-9423--- AND XV-9315--- (SEE PID 24915-M6-SCWO-00013) TO ENSURE THAT BOTH VALVES ARE NOT OPEN AT THE SAME TIME, EXCEPT DURING TRANSITIONS BETWEEN BLEND PUMPS 1 AND 2.
 - DESIGN SHALL INCLUDE WELDED PIPE (JOINTS) TO MAXIMUM EXTENT PRACTICAL, FLANGE SHIELDS AROUND FLANGED FITTINGS, AND DRIP-PROOF TRAYS BELOW FITTINGS AND OTHER POTENTIAL LEAK SOURCES. DESIGN TO INCLUDE SECONDARY CONTAINMENT TO CAPTURE FLANGE AND VALVE LEAKS.
 - PROGRAM XV-9337--- AND XV-9349--- TO ENSURE THAT BOTH VALVES ARE NOT OPEN AT THE SAME TIME, EXCEPT DURING TRANSITIONS BETWEEN BLEND TANK RECIRCULATION AND FEEDING OF REACTORS.
 - ◇ DENOTES DESIGN RESPONSIBILITY LABEL.
 - DO NOT POCKET, LINE ROUTING TO CONFORM TO FINAL EQUIPMENT LAYOUT.
 - ELECTRICAL AREA CLASSIFICATION: UNCLASSIFIED (PER DIRECTION FROM GOVERNMENT 5/4/06 CORRESPONDENCE)
 - LOCATE MANWAY TO ALLOW MANUAL SPRAY DOWN OF TANK (INTERNAL).
 - ELECTRICALLY TRACE AND INSULATE TO MAINTAIN A MINIMUM TEMPERATURE OF 80 ° F.
 - FOUR INTERNAL Baffles @ 90° INTERVALS.
 - HEATER ME-SCWO-0002 HAS BEEN MOVED TO PID DRAWING 24915-10-M6-SCWO-00030.
 - NITROGEN GAS SEAL.
 - LOCATE VALVES AS CLOSE TO TANK SURFACE AS POSSIBLE.
 - A COMMON INSTRUMENT AIR HEADER AS SHOWN ENTERING THE MODULE ON 24915-M6-SCWO-00013, ZONE B-B SERVICES BOTH HYDROLYSATE BLEND TANK 1 AND TANK 2 COMPONENTS.
 - SOLID CONNECTION DUCT TO TOP OF ASSOCIATED BLEND TANK.
 - PROGRAM AN INTERLOCK BETWEEN XV-9349 (FEED VALVE TO SCWO REACTOR) AND XV-9419 (OFF-SPEC EFFLUENT, AGENT HYDROLYSATE, ENERGETICS HYDROLYSATE), XV-9166 (HCL), XV-9157 (NAOH), XV-9192 (H2SO4), XV-9430 (OFF-NORMAL HYDROLYSATE), AND MD-SCWO-0002 (SLIDE GATE). IF XV-9349 IS OPEN, ALL CITED FEED VALVES MUST BE CLOSED.
 - NOTES 2, 4, 7, 9, 10, 11, 17, 20, 26, 29, 30 AND 32 ARE DELETED.

This document was reviewed by [redacted] and no OPR/CA/HA information was discovered.

BASED ON BLUE GRASS PFD 24915-10-M6-SCWO-00001
REFERENCE DRAWINGS

ISSUED by Judy Dishon, o=General Atomics, ou=Records / Configuration Management, email=Judy.Dishon@ga.com, c=US 2012.08.15 11:41:05 -0700

NO.	DATE	DESCRIPTION	DR	CK	DL	PE	APPD
1							
2							
3							
4							
5							

QUALITY 0 Non-0

BECHTEL PARSONS BLUE GRASS	DOD PROGRAM MANAGER FOR ASSEMBLED CHEMICAL WEAPONS ASSESSMENT EDGEWOOD, MARYLAND	US ARMY ENGINEERING AND SUPPORT CENTER, HUNTSVILLE HUNTSVILLE, ALABAMA
-----------------------------------	--	--


BLUE GRASS CHEMICAL AGENT DESTRUCTION PILOT PLANT PROJECT (BGCAPP)
RICHMOND, KENTUCKY
DAAA09-03-D-0023

SCWO PROCESSING BUILDING HYDROLYSATE BLEND TANK 2 PIPING & INSTRUMENT DIAGRAM

DRAWING NUMBER: 24915-10-M6-SCWO-00015
SHEET: 1 of 1
REV: 7

GENERAL ATOMICS
WILLIAM RICKMAN
25486
LICENSED PROFESSIONAL ENGINEER

10mscwo015.ppt 07/31/12

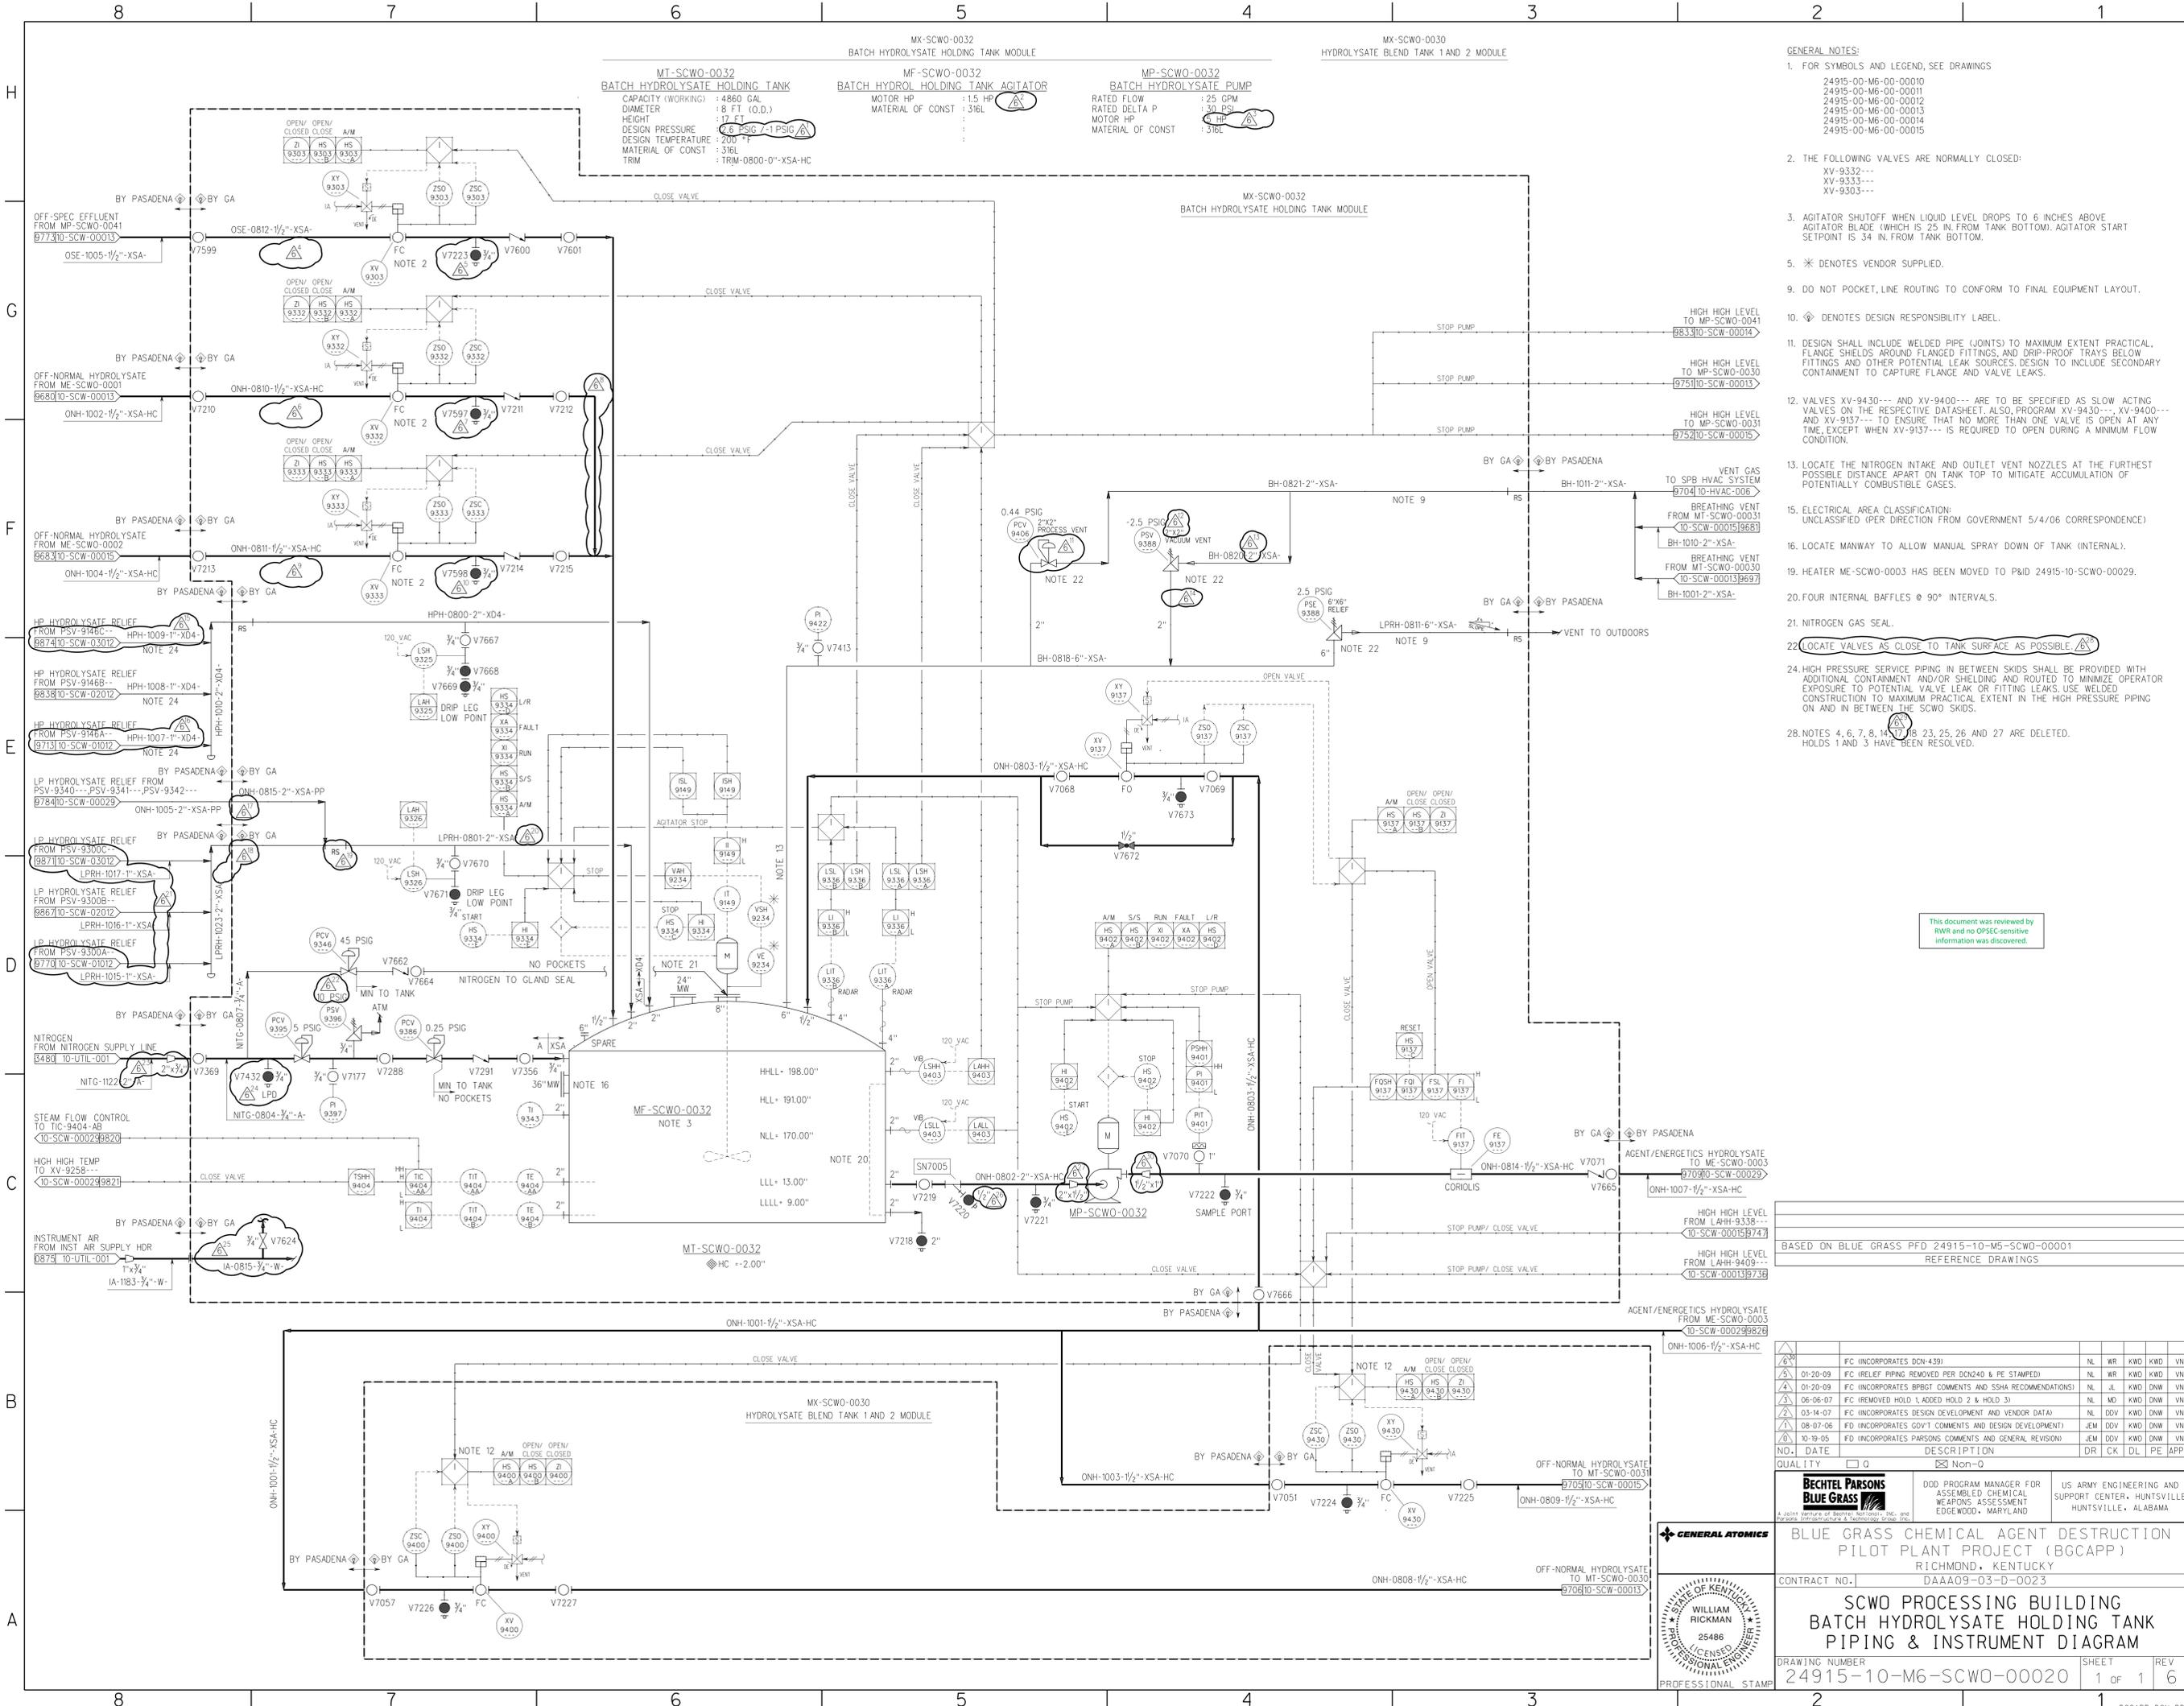

- GENERAL NOTES:**
- FOR SYMBOLS AND LEGEND, SEE DRAWINGS
24915-00-M6-00-00010
24915-00-M6-00-00011
24915-00-M6-00-00012
24915-00-M6-00-00013
24915-00-M6-00-00014
24915-00-M6-00-00015
 - THE FOLLOWING VALVES ARE NORMALLY CLOSED:
XV-9332---
XV-9333---
XV-9303---
 - AGITATOR SHUTOFF WHEN LIQUID LEVEL DROPS TO 6 INCHES ABOVE AGITATOR BLADE (WHICH IS 25 IN FROM TANK BOTTOM). AGITATOR START SETPOINT IS 34 IN FROM TANK BOTTOM.
 - * DENOTES VENDOR SUPPLIED.
 - DO NOT POCKET, LINE ROUTING TO CONFORM TO FINAL EQUIPMENT LAYOUT.
 - ◇ DENOTES DESIGN RESPONSIBILITY LABEL.
 - DESIGN SHALL INCLUDE WELDED PIPE (JOINTS) TO MAXIMUM EXTENT PRACTICAL, FLANGE SHIELDS AROUND FLANGED FITTINGS, AND DRIP-PROOF TRAYS BELOW FITTINGS AND OTHER POTENTIAL LEAK SOURCES. DESIGN TO INCLUDE SECONDARY CONTAINMENT TO CAPTURE FLANGE AND VALVE LEAKS.
 - VALVES XV-9430--- AND XV-9400--- ARE TO BE SPECIFIED AS SLOW ACTING VALVES ON THE RESPECTIVE DATASHEET. ALSO, PROGRAM XV-9430--- XV-9400--- AND XV-9137--- TO ENSURE THAT NO MORE THAN ONE VALVE IS OPEN AT ANY TIME, EXCEPT WHEN XV-9137--- IS REQUIRED TO OPEN DURING A MINIMUM FLOW CONDITION.
 - LOCATE THE NITROGEN INTAKE AND OUTLET VENT NOZZLES AT THE FURTHEST POSSIBLE DISTANCE APART ON TANK TOP TO MITIGATE ACCUMULATION OF POTENTIALLY COMBUSTIBLE GASES.
 - ELECTRICAL AREA CLASSIFICATION: UNCLASSIFIED (PER DIRECTION FROM GOVERNMENT 5/4/06 CORRESPONDENCE)
 - LOCATE MANWAY TO ALLOW MANUAL SPRAY DOWN OF TANK (INTERNAL).
 - HEATER ME-SCWO-0003 HAS BEEN MOVED TO P&ID 24915-10-SCWO-00029.
 - FOUR INTERNAL Baffles @ 90° INTERVALS.
 - NITROGEN GAS SEAL.
 - LOCATE VALVES AS CLOSE TO TANK SURFACE AS POSSIBLE.
 - HIGH PRESSURE SERVICE PIPING IN BETWEEN SKIDS SHALL BE PROVIDED WITH ADDITIONAL CONTAINMENT AND/OR SHIELDING AND ROUTED TO MINIMIZE OPERATOR EXPOSURE TO POTENTIAL VALVE LEAK OR FITTING LEAKS. USE WELDED CONSTRUCTION TO MAXIMUM PRACTICAL EXTENT IN THE HIGH PRESSURE PIPING ON AND IN BETWEEN THE SCWO SKIDS.
 - NOTES 4, 6, 7, 8, 14, 17, 18, 23, 25, 26 AND 27 ARE DELETED. HOLDS 1 AND 3 HAVE BEEN RESOLVED.

This document was reviewed by RWR and no OPSEC-sensitive information was discovered.

BASED ON BLUE GRASS PFD 24915-10-M6-SCWO-00001 REFERENCE DRAWINGS

NO.	DATE	DESCRIPTION	DR	CK	DL	PE	APPD
1	01-20-09	FC (INCORPORATES DCN-4391)	NL	WR	KWD	KWD	VN
2	01-20-09	FC (RELIEF PIPING REMOVED PER DCN240 & PE STAMPED)	NL	WR	KWD	KWD	VN
3	01-20-09	FC (INCORPORATES BPBGT COMMENTS AND SSHA RECOMMENDATIONS)	NL	JL	KWD	DNW	VN
4	06-06-07	FC (REMOVED HOLD 1, ADDED HOLD 2 & HOLD 3)	NL	MD	KWD	DNW	VN
5	03-14-07	FC (INCORPORATES DESIGN DEVELOPMENT AND VENDOR DATA)	NL	DDV	KWD	DNW	VN
6	08-07-06	FD (INCORPORATES GOV'T COMMENTS AND DESIGN DEVELOPMENT)	JEM	DDV	KWD	DNW	VN
7	10-19-05	FD (INCORPORATES PARSONS COMMENTS AND GENERAL REVISIONS)	JEM	DDV	KWD	DNW	VN


QUALITY 0 Non-0

BECHTEL PARSONS BLUE GRASS
A JOINT VENTURE OF BECHTEL CORPORATION, INC. and PARSONS BRINCKERHOFF & TERRY INC.


GENERAL ATOMICS
BLUE GRASS CHEMICAL AGENT DESTRUCTION PILOT PLANT PROJECT (BGCAPP)
RICHMOND, KENTUCKY
DAAA09-03-D-0023

SCWO PROCESSING BUILDING BATCH HYDROLYSATE HOLDING TANK PIPING & INSTRUMENT DIAGRAM

DRAWING NUMBER: 24915-10-M6-SCWO-00020
SHEET: 1 of 1
REV: 6

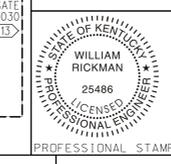


10MSCWO0020.ppt 02/06/12

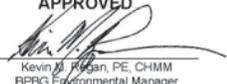		Project Number <p style="text-align: center;">24915</p>	Document Number <p style="text-align: center;">24915-07-MVD-SDS-00001</p>	Rev <p style="text-align: center;">2</p>	Date <p style="text-align: center;">9/2/2010</p>	Sheet of <p style="text-align: center;">1 11</p>		
Project, Client, Location <p style="text-align: center;">Blue Grass Chemical Agent-Destruction Pilot Plant (BGCAPP) Project</p>			Document Title <p style="text-align: center;">SPENT DECON HOLDING/AGENT WASHOUT TREATMENT TANKS MV-SDS-0101/0201/0301</p>					
<input type="checkbox"/> In-House Review <input type="checkbox"/> Client Approval <input type="checkbox"/> Quotation <input checked="" type="checkbox"/> Purchase <input type="checkbox"/> Construction <input type="checkbox"/> Design			<input checked="" type="checkbox"/> All Data Sheets Attached <input type="checkbox"/> Revised Data Sheets Only Attached					
QUALITY: <input checked="" type="checkbox"/> Q <input type="checkbox"/> NON-Q								
TOXIC CATEGORY <input checked="" type="checkbox"/> A <input type="checkbox"/> B <input type="checkbox"/> A/B _____ OTHER								
REV	DATE	BY	CHK	DL	PROJ ENGR	QA	APPR	REMARKS
0	02/25/09	SC	BM	BM	BBB	JW		Issued for Purchase
1	10/14/09	SC	SS	SA	BBB	JW		Issued for Purchase (added page 6 & 7 to include seismic data)
2	09/02/10	SC <i>SC</i>	BM <i>BM</i>	SA <i>SA</i>	BBB <i>BBB</i>	JW <i>JW</i>		Issued for Purchase (changes shown by clouds or bars) (incorporated vendor data and SDDR 24915-000-YDA-MVSC-10008) (included changes associated with RFI-WES-003, RFI-DMP-023, RFI-DMP-024, RFI-DMP-025 and SDDR 24915-000-YDA-MVSC-10001)
								<div style="border: 1px solid black; padding: 5px; text-align: center;"> <p>APPROVED</p>  <p>by: Kevin J. Rogan, PE, CHMM BPBG Environmental Manager</p> <p><small>Design changes must be incorporated into as-built drawings submitted to KDEP at the completion of construction</small></p> </div>
<p>This sheet is a record of each issue or revision to the subject specification. Each time the specification is to be changed, only the new or revised sheets must be issued. The exact sheets changed and the nature of the change should be noted in the Remarks column; however, these remarks are not part of the specification. The revised data sheets shall become part of the original specification and shall be compiled within their entirety.</p>								

DC-

DT-

 BECHTEL PARSONS BLUE GRASS DATA SHEET	TITLE BGCAPP SPENT DECON HOLDING/AGENT WASHOUT TREATMENT TANKS MV-SDS-0101	SHEET	OF	PROJECT NUMBER
		2	11	24915
DOCUMENT NUMBER			REV	
24915-07-MVD-SDS-00001			2	

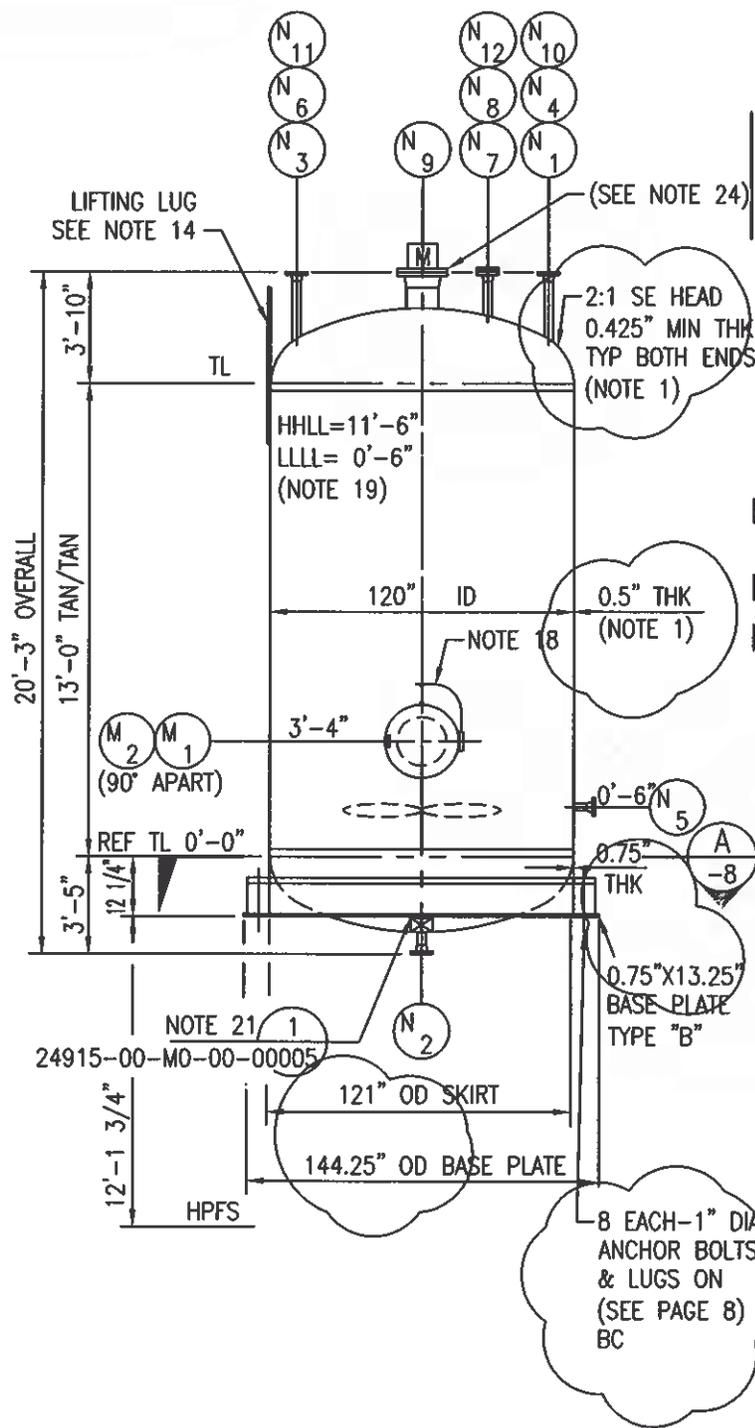

CODE: ASME SECT VIII DIV 1 (CODE CONSTR. ONLY)	
CODE CERT REQD	NO CODE STAMP NO
NATIONAL BOARD REGISTRATION:	NO
OPR PRESS (INT)	0.2-0.4 PSIG AT 108 °F
DES PRESS. (INT)	14.9 PSIG AT 135 °F
DES PRESS. (EXT)	FULL VAC PSIG AT 135 °F
MIN DESIGN METAL TEMP	(-)-1 °F AT 14.9 PSIG
CRSN ALLOW SHELL = 1/16" HEADS = 1/16" NOZZ = 1/16"	
LIQUID LEVEL FOR DESIGN:	FULL AT SP GR 1.07
SEISMIC DESIGN:	SEE NOTE 10
WIND DESIGN:	SEE NOTE 11
MAWP 14.9 & FV	PSIG AT 135 °F LIMITED BY N/A
MAP N&C	108 PSIG AT AMB TEMP LIMITED BY N5
SHOP HYD	19.4 PSIG AT 70 °F MIN HORIZ POSN
FIELD HYD NEW	N/A PSIG AT 70 °F MIN OPR POSN
FIELD HYD CORR	N/A PSIG AT 70 °F MIN OPR POSN
PWHT	(PER CODE) RADIOGRAPHY (FULL)
JOINT EFF: SHELL	(PER CODE) HEADS (PER CODE)
ALLOW STRESS	20,000 PSI AT DESIGN TEMP 135°F
SHELL	SA-516-70 (SEE NOTE 20)
HEADS	SA-516-70 (SEE NOTE 20)
SUPPORTS	SA-36
INTERNALS	CS (NOTE 20) TRAYS N/A
BOLTS (INT)	N/A NUTS N/A
BOLTS (EXT)	SA-193-B7 NUTS SA-194-2H
FLANGES	SA-105
NOZZLE NECKS	SA-106B (A516-70 rolled for manways)
GASKETS	NOTE 23
CAPACITY (WORKING)	5200 GAL
FAB WT 18,400 (NOTE 1 & 15) LB	EMPTY WT 18,400 (NOTE 1 & 15) LB
TRAY WT	N/A LB PACKING WT N/A LB
OPR WT 88,300 (NOTE 1 & 15) LB	TEST WT 99,400 (NOTE 1 & 15) LB
PAINING	SEE NOTE 12
INSULATION	NONE
FIREPROOFING	NONE
ACCESSORIES BY FABRICATOR:	YES NO
VESSEL DAVIT MARK No.	X
LADDER & PLATFORM CLIPS	X
PIPE SUPPORT AND PIPE GUIDE CLIPS	X
INSULATION SUPPORTS	X
FIREPROOFING SUPPORTS	X
VORTEX BREAKER	X
LIFTING AND GROUNDING LUGS	X

NOZZLE SCHEDULE					
ITEM	No.	SIZE	PROJ	RATING	SERVICE
M1,M2	2	36"	6'-0"	150#	MH W/ BF & DAVIT
N1	1	3"	SEE ELEV	150#	INLET, CATEGORY A
N2	1	3"	SEE ELEV	150#	OUTLET
N3	1	8"	SEE ELEV	150#	LEVEL TRANS. (RADAR TYPE)
N4	1	2"	SEE ELEV	150#	LSHH
N5	1	2"	5'-9"	150#	LSLL
N6	1	2"	SEE ELEV	150#	NITROGEN INLET/VENT
N7	1	2"	SEE ELEV	150#	RECYCLE LINE
N8	1	2"	SEE ELEV	150#	SPARE W/ BF (NOTE 26)
N9	1	14"	SEE ELEV	150#	AGITATOR
N10	1	2"	SEE ELEV	150#	INLET, CATEGORY B
N11	1	2"	SEE ELEV	150#	INLET, CATEGORY C
N12	1	4"	SEE ELEV	150#	PSV


ONE REQD MV-SDS-0101
 SEE SHEET 9 FOR TRUE ORIENTATION

FLANGE: RFWN FINISH: 125-250 AARH
 (NOTE #7)



TITLE BGCAPP
 SPENT DECON HOLDING/AGENT
 WASHOUT TREATMENT TANKS
 MV-SDS-0201/0301

SHEET OF PROJECT NUMBER
 3 11 24915
 DOCUMENT NUMBER REV
 24915-07-MVD-SDS-00001 2

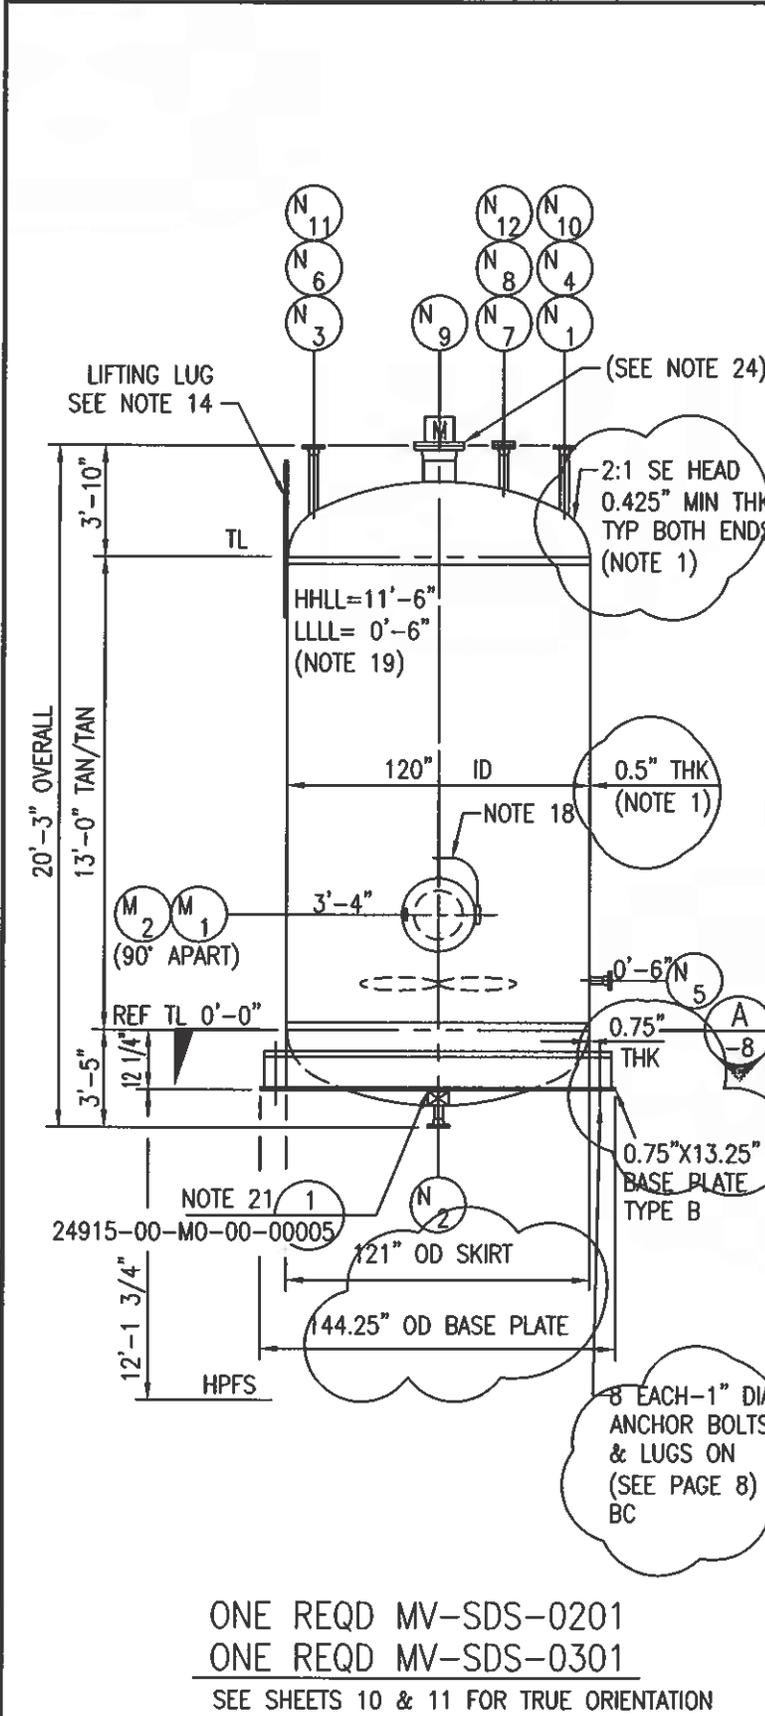

CODE: ASME SECT VIII DIV 1 (CODE CONSTR. ONLY)			
CODE CERT REQD	NO	CODE STAMP	NO
NATIONAL BOARD REGISTRATION: NO			
OPR PRESS (INT)	0.2-0.4 PSIG AT	77-145 °F	
DES PRESS. (INT)	14.9 PSIG AT	170 °F	
DES PRESS. (EXT)	FULL VAC PSIG AT	170 °F	
MIN DESIGN METAL TEMP	(-)1 °F AT	14.9 PSIG	
CRSN ALLOW SHELL = 1/16" HEADS = 1/16" NOZZ = 1/16"			
LIQUID LEVEL FOR DESIGN: FULL AT SP GR 1.07			
SEISMIC DESIGN: SEE NOTE 10			
WIND DESIGN: SEE NOTE 11			
MAWP	14.9 & FV	PSIG AT	170 °F LIMITED BY N/A
MAP N&C	108 PSIG AT	AMB TEMP LIMITED BY N5	
SHOP HYD	19.4 PSIG AT	70 °F MIN HORIZ POSN	
FIELD HYD NEW	N/A PSIG AT	70 °F MIN OPR POSN	
FIELD HYD CORR	N/A PSIG AT	70 °F MIN OPR POSN	
PWHT	(PER CODE)	RADIOGRAPHY (FULL)	
JOINT EFF: SHELL (PER CODE) HEADS (PER CODE)			
ALLOW STRESS	20,000 PSI AT DESIGN TEMP 170°F		
SHELL	SA-516-70 (SEE NOTE 20)		
HEADS	SA-516-70 (SEE NOTE 20)		
SUPPORTS	SA-36		
INTERNALS	CS (NOTE 20)	TRAYS	N/A
BOLTS (INT)	N/A	NUTS	N/A
BOLTS (EXT)	SA-193-B7	NUTS	SA-194-2H
FLANGES	SA-105		
NOZZLE NECKS	SA-106B (A516-70 rolled for manways)		
GASKETS	NOTE 23		
CAPACITY (WORKING)	5200 GAL		
FAB WT	18,400 (NOTE 1 & 15) LB	EMPTY WT	18,400 (NOTE 1 & 15) LB
TRAY WT	N/A LB	PACKING WT	N/A LB
OPR WT	88,300 (NOTE 1 & 15) LB	TEST WT	99,400 (NOTE 1 & 15) LB
PAINING	SEE NOTE 12		
INSULATION 2" PERSONNEL PROTECTION BY OTHERS			
FIREPROOFING NONE			
ACCESSORIES BY FABRICATOR:			
VESSEL DAVIT MARK No.		YES	NO
LADDER & PLATFORM CLIPS			X
PIPE SUPPORT AND PIPE GUIDE CLIPS			X
INSULATION SUPPORTS		X	
FIREPROOFING SUPPORTS			X
VORTEX BREAKER		X	
LIFTING AND GROUNDING LUGS		X	

NOZZLE SCHEDULE					
ITEM	No.	SIZE	PROJ	RATING	SERVICE
M1,M2	2	36"	6'-0"	150#	MH W/ BF & DAVIT
N1	1	3"	SEE ELEV	150#	INLET, CATEGORY A
N2	1	3"	SEE ELEV	150#	OUTLET
N3	1	8"	SEE ELEV	150#	LEVEL TRANS. (RADAR TYPE)
N4	1	2"	SEE ELEV	150#	LSHH
N5	1	2"	5'-9"	150#	LSLL
N6	1	2"	SEE ELEV	150#	NITROGEN INLET/VENT
N7	1	2"	SEE ELEV	150#	RECYCLE LINE
N8	1	2"	SEE ELEV	150#	AGENT WASHOUT
N9	1	14"	SEE ELEV	150#	AGITATOR
N10	1	2"	SEE ELEV	150#	INLET, CATEGORY B
N11	1	2"	SEE ELEV	150#	INLET, CATEGORY C
N12	1	4"	SEE ELEV	150#	PSV

ONE REQD MV-SDS-0201
 ONE REQD MV-SDS-0301
 SEE SHEETS 10 & 11 FOR TRUE ORIENTATION

FLANGE: RFWN FINISH: 125-250 AARH
 (NOTE #7)



DATA SHEET

TITLE BGCAPP
 SPENT DECON HOLDING/AGENT
 WASHOUT TREATMENT TANKS
 MV-SDS-0101/0201/0301

SHEET OF PROJECT NUMBER
 4 11 24915

DOCUMENT NUMBER REV
 24915-07-MVD-SDS-00001 2

NOTES

1. THE VESSEL SUPPLIER SHALL DESIGN, FURNISH, FABRICATE, INSPECT, TEST AND DELIVER THE VESSEL IN ACCORDANCE WITH THIS DATA SHEET, ATTACHED SPECIFICATIONS, AND STANDARDS. VESSEL SHALL BE DESIGNED IN ACCORDANCE WITH SPECIFIED DESIGN REQUIREMENTS, SEE NOTE 10 AND 11.
2. ALL DIMENSIONS ARE FROM REF LINE, EXCEPT AS SHOWN.
3. NOZZLES AND MANHOLES SHALL HAVE SAME DESIGNATION AS SHOWN ON THIS DRAWING.
4. BOLT HOLES SHALL STRADDLE THE VERTICAL CENTERLINES OF THE VESSEL FOR NOZZLES ON THE SHELL AND PLANT NORTH-SOUTH, EAST-WEST CENTERLINES FOR NOZZLES ON THE HEADS.
5. ALL ATTACHMENTS WELDED TO VESSEL PRESSURE PARTS SHALL BE SAME MATERIAL AS PRESSURE PART, UNLESS OTHERWISE NOTED.
6. VESSEL SHALL BE THOROUGHLY CLEANED INSIDE AND OUTSIDE, SHALL BE FREE FROM RUST, LOOSE SCALE, SLAG, WELD SPLATTER AND FOREIGN MATTER PRIOR TO SHOP HYDROTEST, AND SHALL BE THOROUGHLY DRIED AFTER HYDROTEST.
7. PROJECTION OF RADIAL NOZZLES ARE FROM VESSEL CENTER LINE TO EXTREME FACE OF FLANGE.
8. ALL VESSEL COMPONENTS SHALL BE FURNISHED IN ACCORDANCE WITH STANDARDS LISTED BELOW.
9. ITEMS WITH (*) ARE VESSEL FABRICATOR RESPONSIBILITY.
10. SEISMIC FORCES SHALL BE PER SPECIFICATION 24915-000-3PS-SV00-00001, SPECIFICATION FOR SEISMIC PROTECTION OF EQUIPMENT. THE VESSEL IS LOCATED INSIDE THE MDB BUILDING (ANS ROOM 123). PER TABLE 1, APPLICABLE CODES AND IMPORTANCE FACTORS, SEISMIC PROTECTION SHALL BE IN ACCORDANCE WITH ICC INTERNATIONAL BUILDING CODE (IBC) 2000, SEISMIC DESIGN FOR BUILDINGS (SEISMIC GROUPS IIIE AND IIIE).
11. THE GENERAL PROJECT SPECIFICATION, 24915-000-3PS-G000-00001, PROVIDES PROJECT DETAILS AND DESIGN CONDITIONS FOR THE SITE. THIS VESSEL IS PART OF THE MUNITIONS DEMILITARIZATION BUILDING (MDB) AND IS INSTALLED INSIDE THE BUILDING (ROOM 123) AND WILL NOT BE SUBJECT TO SITE CONDITIONS SUCH AS WIND, PRECIPITATION, SNOW, ETC. OTHER GENERAL REQUIREMENTS FOR EQUIPMENT, MATERIAL, AND/OR SERVICES REQUIRED AS DEFINED IN THE SPECIFICATION APPLY.
12. ALL EXTERIOR BARE CARBON STEEL SURFACES SHALL BE PAINTED IN ACCORDANCE WITH SPECIFICATION 24915-000-3PS-AFPS-00001, SPECIAL COATINGS - METAL.
13. VESSEL SUPPLIER SHALL SUPPLY GROUNDING LUGS IN ACCORDANCE WITH STANDARD 24915-00-M0-00-00006. GROUNDING LUGS WITH DIMENSIONS SHALL BE CLEARLY CALLED OUT ON SUPPLIER DRAWINGS.
14. VESSEL SUPPLIER SHALL DESIGN AND INSTALL A MINIMUM OF TWO LIFTING LUGS FOR USE DURING LOADING, UNLOADING AND PLACING EQUIPMENT ON ITS FOUNDATION. DESIGN SHALL INCLUDE REQUIRED PIN, SHACKLE SIZE AND MAXIMUM SLOPE OF LIFTING CABLE AND LIFTING LUG PLANE. HOLE IN LIFTING LUG SHALL BE DRILLED OR MACHINED, DO NOT FLAME CUT. LIFTING LUG (AND PAD IF REQUIRED) SHALL BE THE SAME MATERIAL AS THE SHELL. LIFTING LUG SHALL NOT BE REMOVED AFTER INSTALLATION. EQUIPMENT SUPPLIER SHALL PERMANENTLY MARK ON THE LIFTING LUG WITH 1" MINIMUM HIGH LETTERS - "DO NOT REMOVE". SUPPLIER'S DRAWINGS SHALL PROVIDE LIFTING LUG DESIGN AND LOAD AND ANNOTATE EACH LUG WITH ITS LOAD CAPACITY.
15. VESSEL SUPPLIER SHALL PROVIDE FABRICATION, EMPTY, OPERATING, TEST AND INDIVIDUAL WEIGHTS OF HEAD, SHELL AND EQUIPMENT CENTER OF GRAVITY.
16. VESSEL SUPPLIER SHALL IDENTIFY ALL MATERIALS OF CONSTRUCTION (INCLUDING GASKETS) BY WEIGHT OR VOLUME.

STD NO.	DESCRIPTION	SPEC NO.	DESCRIPTION
24915-00-M0-00-00001	PRESSURE VESSEL TOLERANCES	24915-000-3PS-AFPS-00001	SPECIAL COATINGS - METAL
24915-00-M0-00-00002	STD BOLT HOLE ORIENT	24915-000-3PS-G000-00001	GENERAL PROJECT REQUIREMENTS
24915-00-M0-00-00003	INSULATION & FP SUPPORTS	24915-000-3PS-HXYQ-00001	QUALITY ASSURANCE
24915-00-M0-00-00004	VESSEL ABBREVIATIONS & SYMBOLS	24915-000-3PS-MV00-00001	PRESSURE VESSELS
24915-00-M0-00-00005	VORTEX BREAKERS	24915-000-3PS-NLLG-00001	INTERNAL TANK LINING
24915-00-M0-00-00006	GROUNDING CONN FOR VESSELS & TKS	24915-000-3PS-SV00-00001	SEISMIC PROTECTION OF EQUIPMENT
24915-00-M0-00-00008	SKIRT AND BASE DETAILS		

REFERENCES





Bechtel Parsons
Blue Grass

DATA SHEET

TITLE
BGCAPP
SPENT DECON HOLDING/AGENT
WASHOUT TREATMENT TANKS
MV-SDS-0101/0201/0301

SHEET OF PROJECT NUMBER
5 11 24915

DOCUMENT NUMBER REV
24915-07-MVD-SDS-00001 2

NOTES CONTINUED

17. ALL EXTERNAL BOLTS AND STUDS SHALL BE ASSEMBLED WITH ANTI-SEIZE LUBRICANT. SEE PRESSURE VESSEL SPECIFICATION.
18. VESSEL SUPPLIER SHALL DESIGN AND FABRICATE MANHOLE DAVIT FOR REMOVAL OF MANHOLE COVER.
19. LIQUID LEVELS ARE FROM BOTTOM TANGENT LINE UNLESS OTHERWISE NOTED.
10. VESSEL FABRICATOR SHALL SPRAY OR LAMINATE LINE VESSEL IN ACCORDANCE WITH SPECIFICATION 24915-000-3PS-NLLG-00001, INTERNAL TANK LINING.
21. VESSEL FABRICATOR SHALL PREPARE ALL INTERNAL CARBON STEEL SURFACES FOR LINING PER NACE RP0178, FABRICATION DETAILS, SURFACE FINISH REQUIREMENTS, AND PROPER DESIGN CONSIDERATIONS FOR TANKS AND VESSELS TO BE LINED FOR IMMERSION SERVICE. LINING MATERIAL SHALL BE HEAT RESISTANT POLY-VINYLDENE DIFLUORIDE (PVDF) FOR 250°F SERVICE.
22. NOZZLES SMALLER THAN 2" SHALL BE 304/304L STAINLESS STEEL. NOZZLES SMALLER THAN 2" CANNOT BE LINED. ISOLATION KIT REQUIRED.
23. THREE SETS OF SPARE GASKETS FOR NOZZLES WITH BLIND FLANGES SHALL BE SUPPLIED BY VESSEL FABRICATOR. GASKETS SHALL BE FLAT RING, PTFE, 1/8" THK, CL 150.
24. AGITATOR SHALL BE PROVIDED BY VESSEL VENDOR. REFER TO DATASHEET 24915-07-M5D-SDS-00001, SPENT DECON HOLDING/AGENT WASHOUT TREATMENT TANK AGITATORS.
25. THE VESSEL DATA SHEET IS FOR THREE VESSELS. SPARE NOZZLE N8 IS PROVIDED FOR MV-SDS-0101. HOWEVER, THE SPARE NOZZLE FOR MV-SDS-0201/0301 IS USED FOR AGENT WASHOUT FROM MP-MWS-0102A/B OR MP-RHS-0104/0106.
26. ALL BOLTS, NUTS AND WASHERS USED FOR EQUIPMENT IN TOXIC CATEGORIES "A" & "B" SHALL HAVE BOLTS NO SMALLER THAN 1/4". BOLTS ARE SIZED SO THAT PPE WEARERS CAN HANDLE THEM.
27. SPENT DECON HOLDING/WASHOUT TREATMENT TANKS, MV-SDS-0101/0201/0301, ARE REFERENCED ON P&ID 24915-07-M6-SDS-00001, 00002, AND 00003 RESPECTIVELY.
28. INSULATE DOWN TO THE BASE-PLATE KEEPING CLEARANCE AROUND THE ANCHOR BOLTS.
29. VESSEL MAWP IS THE DESIGN PRESSURE.



DATA SHEET

TITLE
 BGCAPP
 SPENT DECON HOLDING/AGENT
 WASHOUT TREATMENT TANKS
 MV-SDS-0101/0201/0301

SHEET OF PROJECT NUMBER
 6 11 24915
 DOCUMENT NUMBER REV
 24915-07-MVD-SDS-00001 2

SEISMIC STRESSES IN SDS VESSELS SUPPORTED ON/FROM PLATFORMS

TABLE 1 SHOWS THE SEISMIC STRESSES (S11 AND S22) IN THE TWO ORTHOGONAL DIRECTIONS AT THE LOCATIONS SHOWN IN FIGURE 1 BASED OFF VESSEL INFORMATION PROVIDED BY THE VENDOR. THESE STRESSES ACT IN BOTH TENSION AND COMPRESSION. THE SEISMIC STRESSES SHOWN IN TABLE 1 WERE COMBINED WITH THE ASME OPERATIONAL STRESSES BY THE VENDOR AND TABLE 3 SHOWS THE NECESSARY DESIGN CHANGE TO THE VESSELS FROM THE VENDOR TO ACCOUNT FOR THE SEISMIC STRESSES. THE BUYER HAS PERFORMED SEISMIC ANALYSIS ON THE UPDATED VESSEL INFORMATION (TABLE 3), AND DETERMINED THERE ARE NO INCREASES TO THE ACCELERATION OF THE CENTER OF GRAVITY OF THE VESSELS. THEREFORE, THE SEISMIC STRESSES IN TABLE 1 ARE A BOUNDING CONDITION PROVIDED THE VESSELS ARE FABRICATED AS DESCRIBED IN TABLE 3.

TABLE 1: S11 AND S22 SEISMIC STRESSES FOR MV-SDS-0101/0201/0301

LOCATION	S11 (KSI)	S22 (KSI)
TOP TANGENT LINE	0.5	0.5
BOTTOM TANGENT LINE	2.5	1.5
SKIRT LINE	4.0	1.0
AT TOP OF LUG	8.75	7.5

Table 2: ACCELERATION OF COG FOR MV-SDS-0101/0201/0301

Vessel	Acceleration at COG (%g)		
	X	Y	Z
MV-SDS-0101	0.226	0.17	0.251
MV-SDS-0201	0.226	0.17	0.251
MV-SDS-0301	0.226	0.17	0.251
General Note:			
The 'X' direction is East-West			
The 'Y' direction is North-South			
The 'Z' direction is vertical			

* PLEASE NOTE THAT WHERE THESE ACCELERATIONS WILL PRODUCE LOWER LOADS THAN THOSE DERIVED FROM THE SEISMIC PROTECTION OF EQUIPMENT SPECIFICATION, THE VALUE FROM THE SEISMIC PROTECTION SPEC. IS TO BE USED FOR THE DESIGN OF THE VESSELS' INTERNALS AND ANCHORAGES OF THE VESSELS TO THE STEEL FRAME.

FIGURE 1: LOCATION & ORIENTATION OF STRESSES

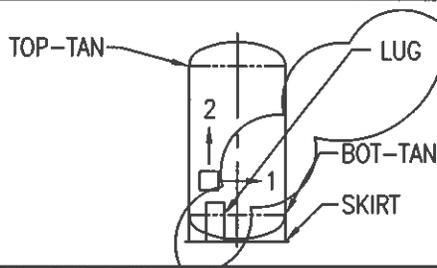
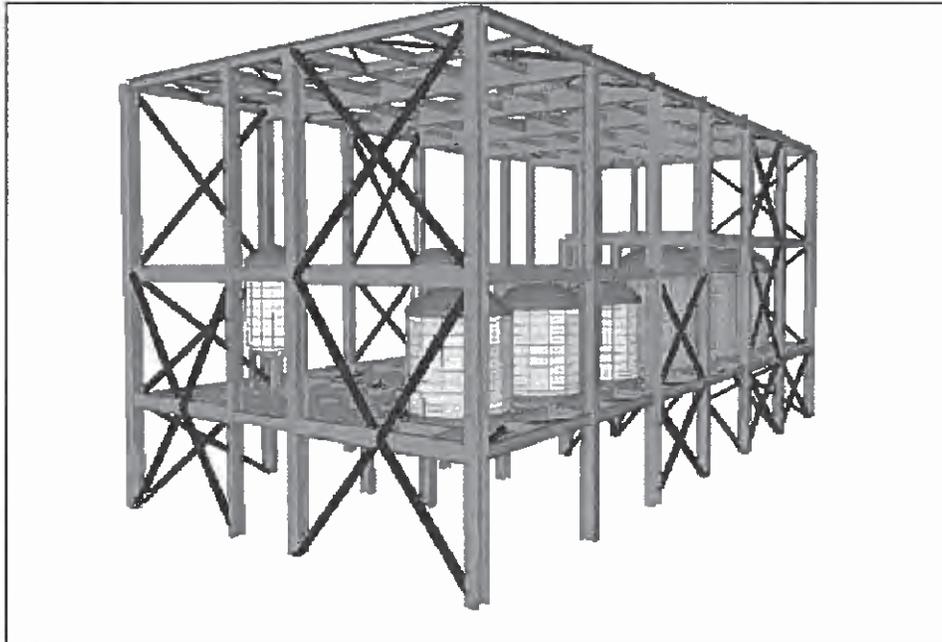


TABLE 3: UPDATED VESSEL INFORMATION FROM VENDOR

VESSEL TAG NO.	CENTER OF GRAVITY (IN) *			OPERATING WEIGHT (LBS)	SHELL THICKNESS (IN)	HEAD THICKNESS (IN)	SKIRT THICKNESS (IN)
	X	Y	Z				
MV-SDS-0101	-1.96	-0.03	61.55	88,300	0.5	.5	.75
MV-SDS-0201	-1.96	-0.03	61.55	88,300	0.5	.5	.75
MV-SDS-0301	-1.96	-0.03	61.55	88,300	0.5	.5	.75

* THE CENTER OF GRAVITY IS BASED ON A STANDARD COORDINATE SYSTEM. THE POSITIVE X,Y,Z DIRECTIONS ARE EAST, NORTH, AND UP THE VESSEL (OUT OF THE PAGE), RESPECTIVELY. THE ORIGIN IS AT THE INTERSECTION OF THE VESSEL CENTERLINE AND REFERENCE PLANE (LOWER TANGENT LINE).

FIGURE 2: MODEL SHOWING THE ANS PLATFORM





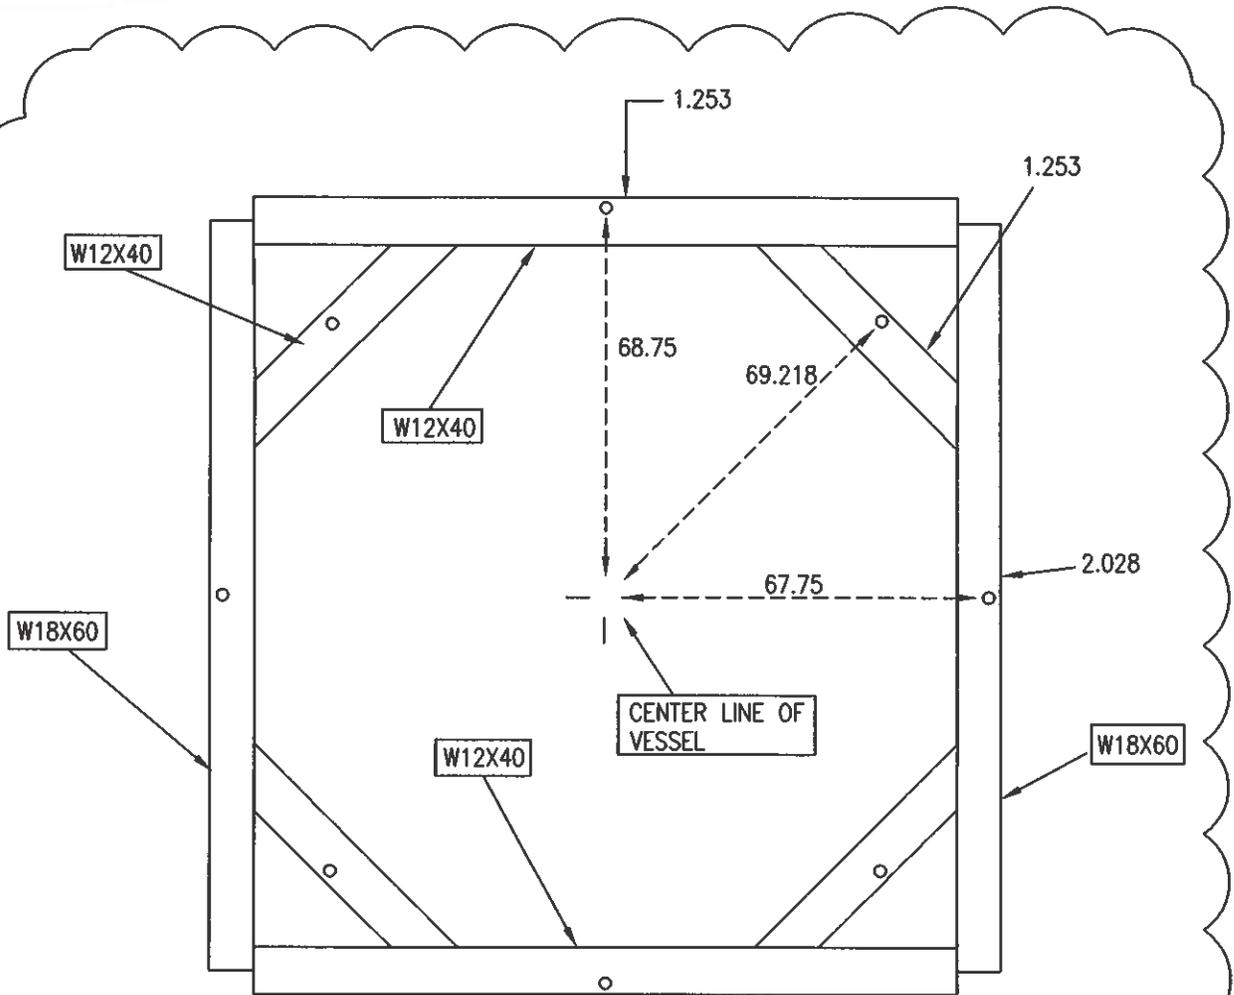




FIGURE 3: PLAN VIEW OF VESSEL SUPPORT FRAMING WITH BOLT PATTERN (TYP.)

NOTE: ALL UNITS USED ARE IN INCHES



DATA SHEET	TITLE	BGCAPP SPENT DECON HOLDING/AGENT WASHOUT TREATMENT TANKS 07-MV-SDS-0101	SHEET OF	9 11	PROJECT NUMBER	24915
			DOCUMENT NUMBER	24915-07-MVD-SDS-00001	REV	2

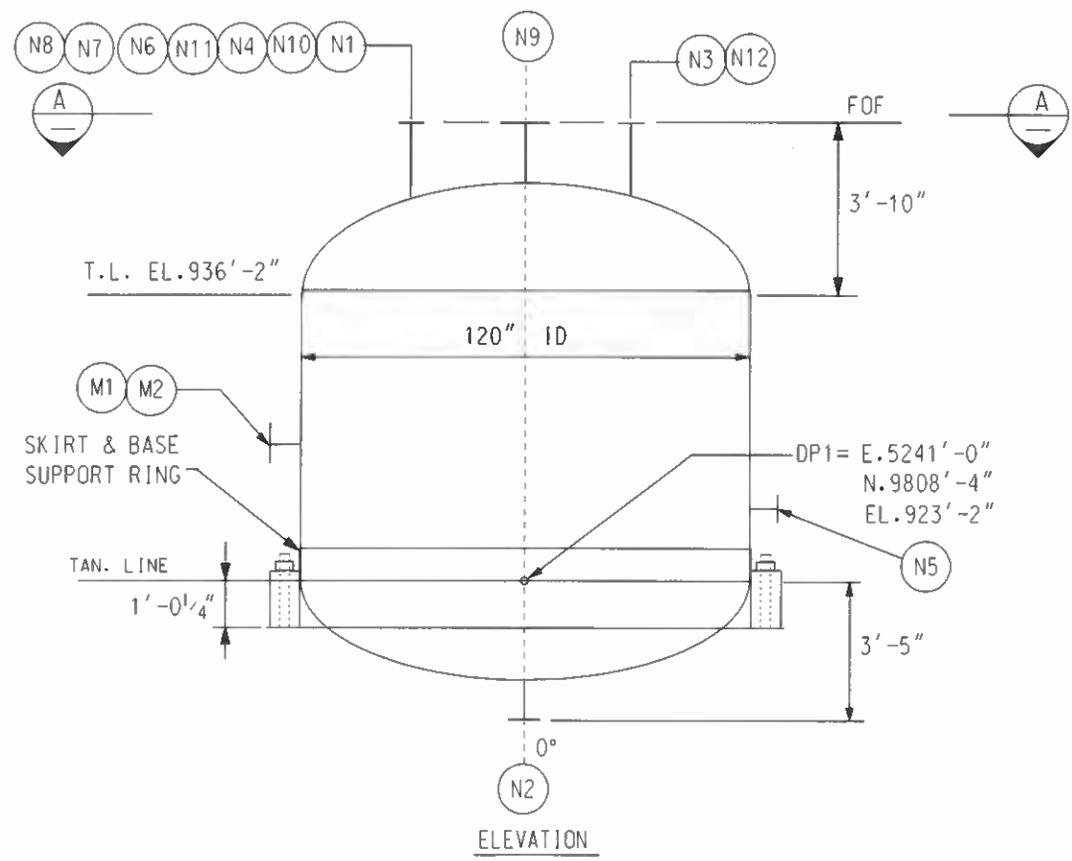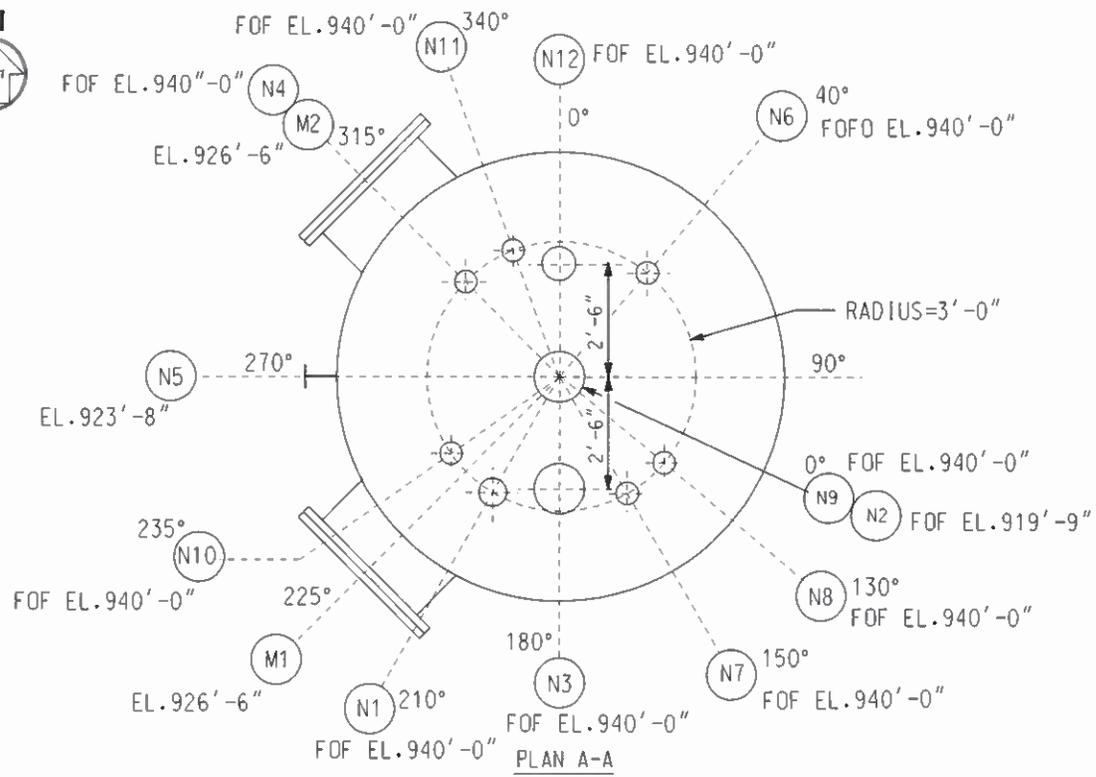

DATA SHEET	TITLE	BGCAPP SPENT DECON HOLDING/AGENT WASHOUT TREATMENT TANKS 07-MV-SDS-0201	SHEET OF	10 11	PROJECT NUMBER	24915
			DOCUMENT NUMBER	24915-07-MVD-SDS-00001		REV

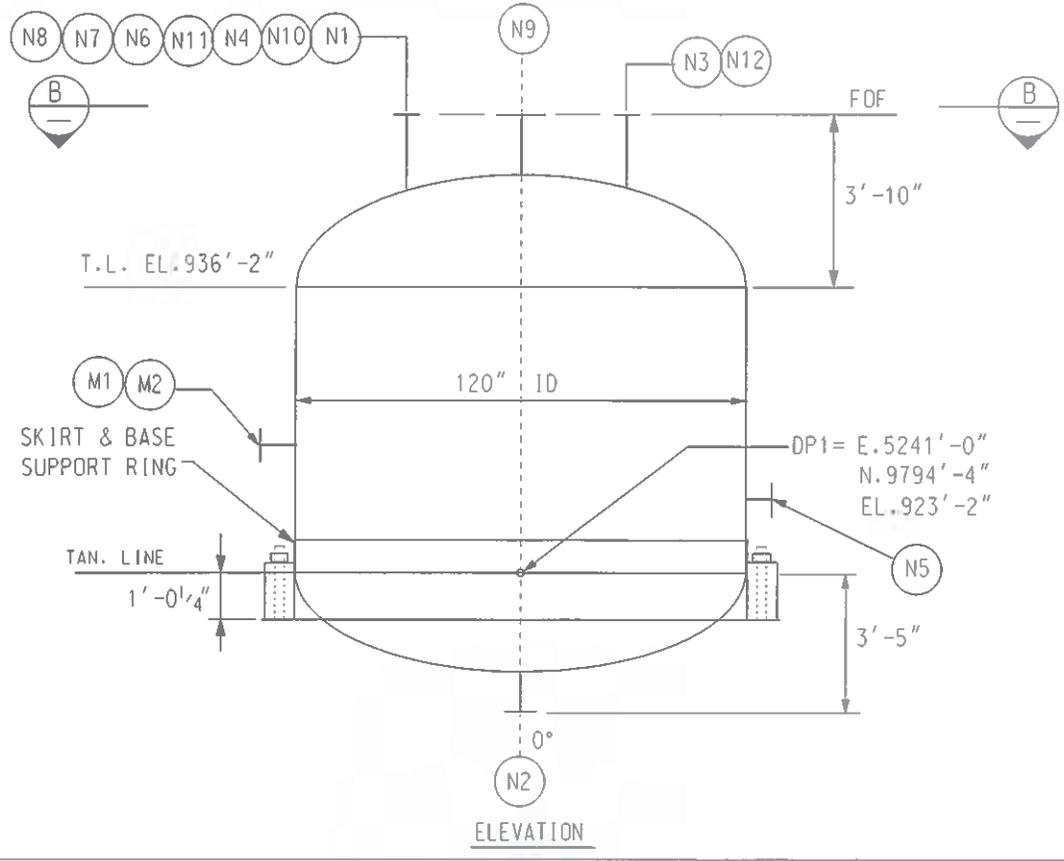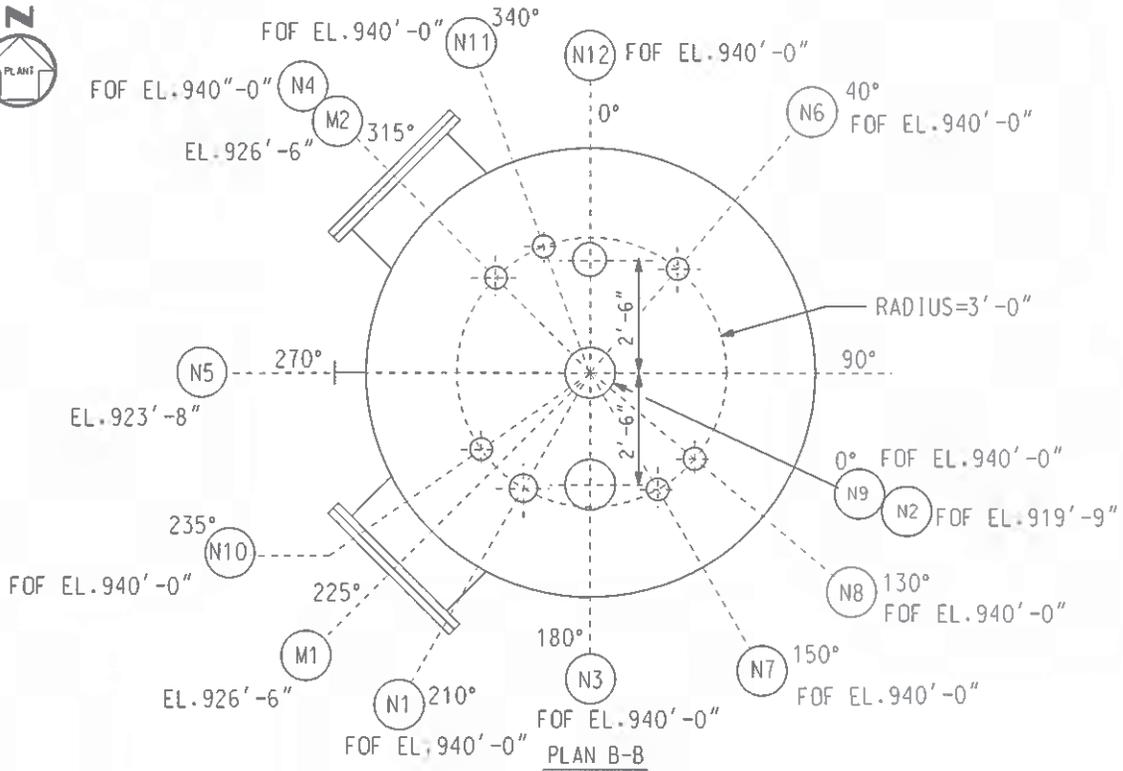


DATA SHEET	TITLE	BGAPP SPENT DECON HOLDING/AGENT WASHOUT TREATMENT TANKS 07-MV-SDS-0301	SHEET OF	PROJECT NUMBER
			11 11	24915
			DOCUMENT NUMBER	REV
			24915-07-MVD-SDS-00001	2

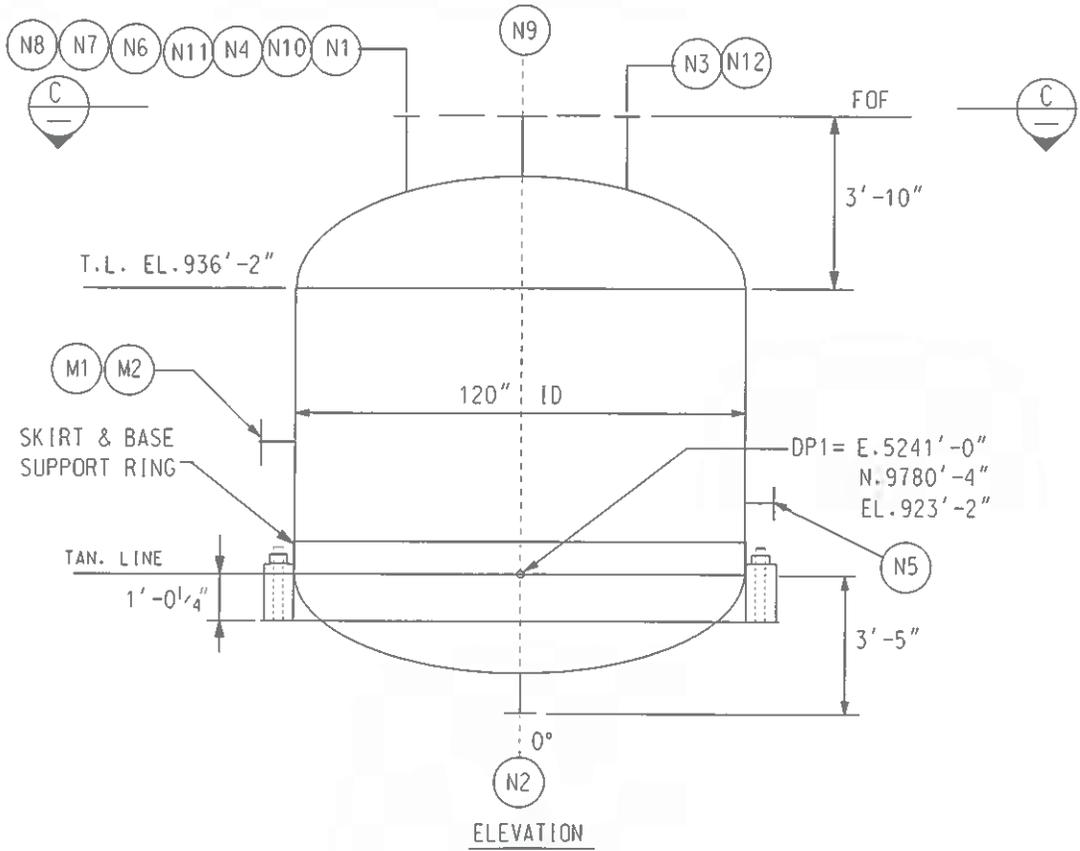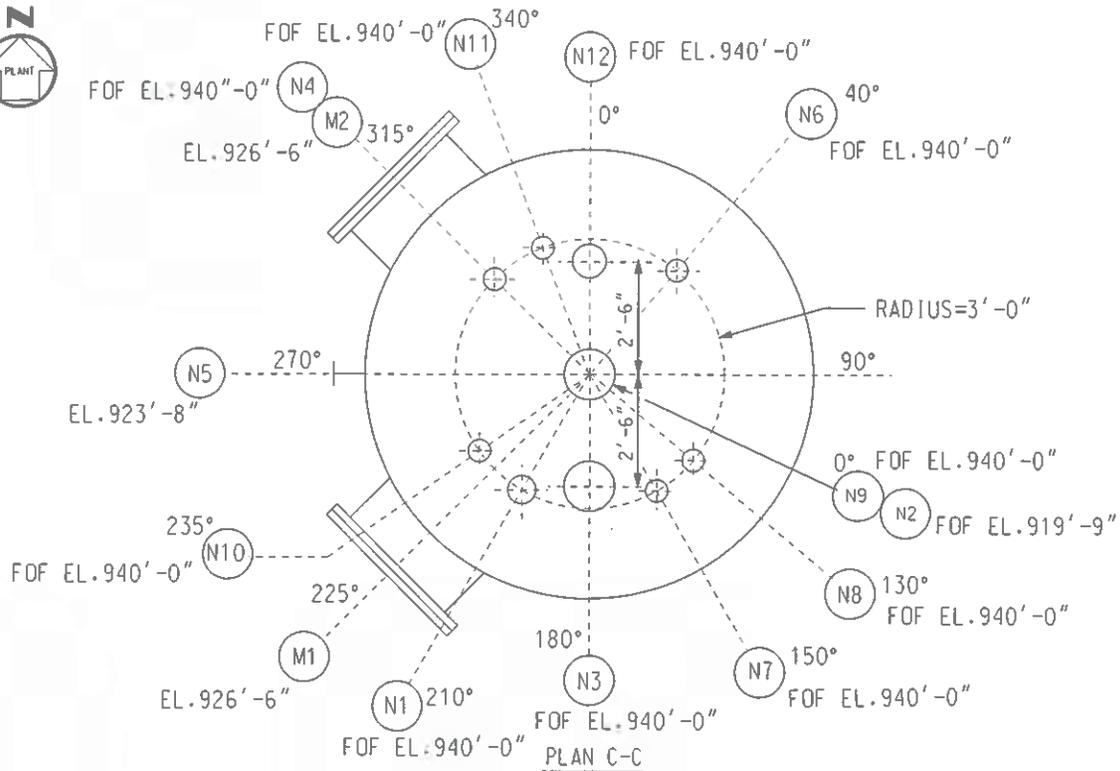

This document has been reviewed for ITAR/EAR and no ITAR/EAR sensitive information was found. 17 Dec 2013

This document has been reviewed for OPSEC material, and none was found. 17 Dec 2013

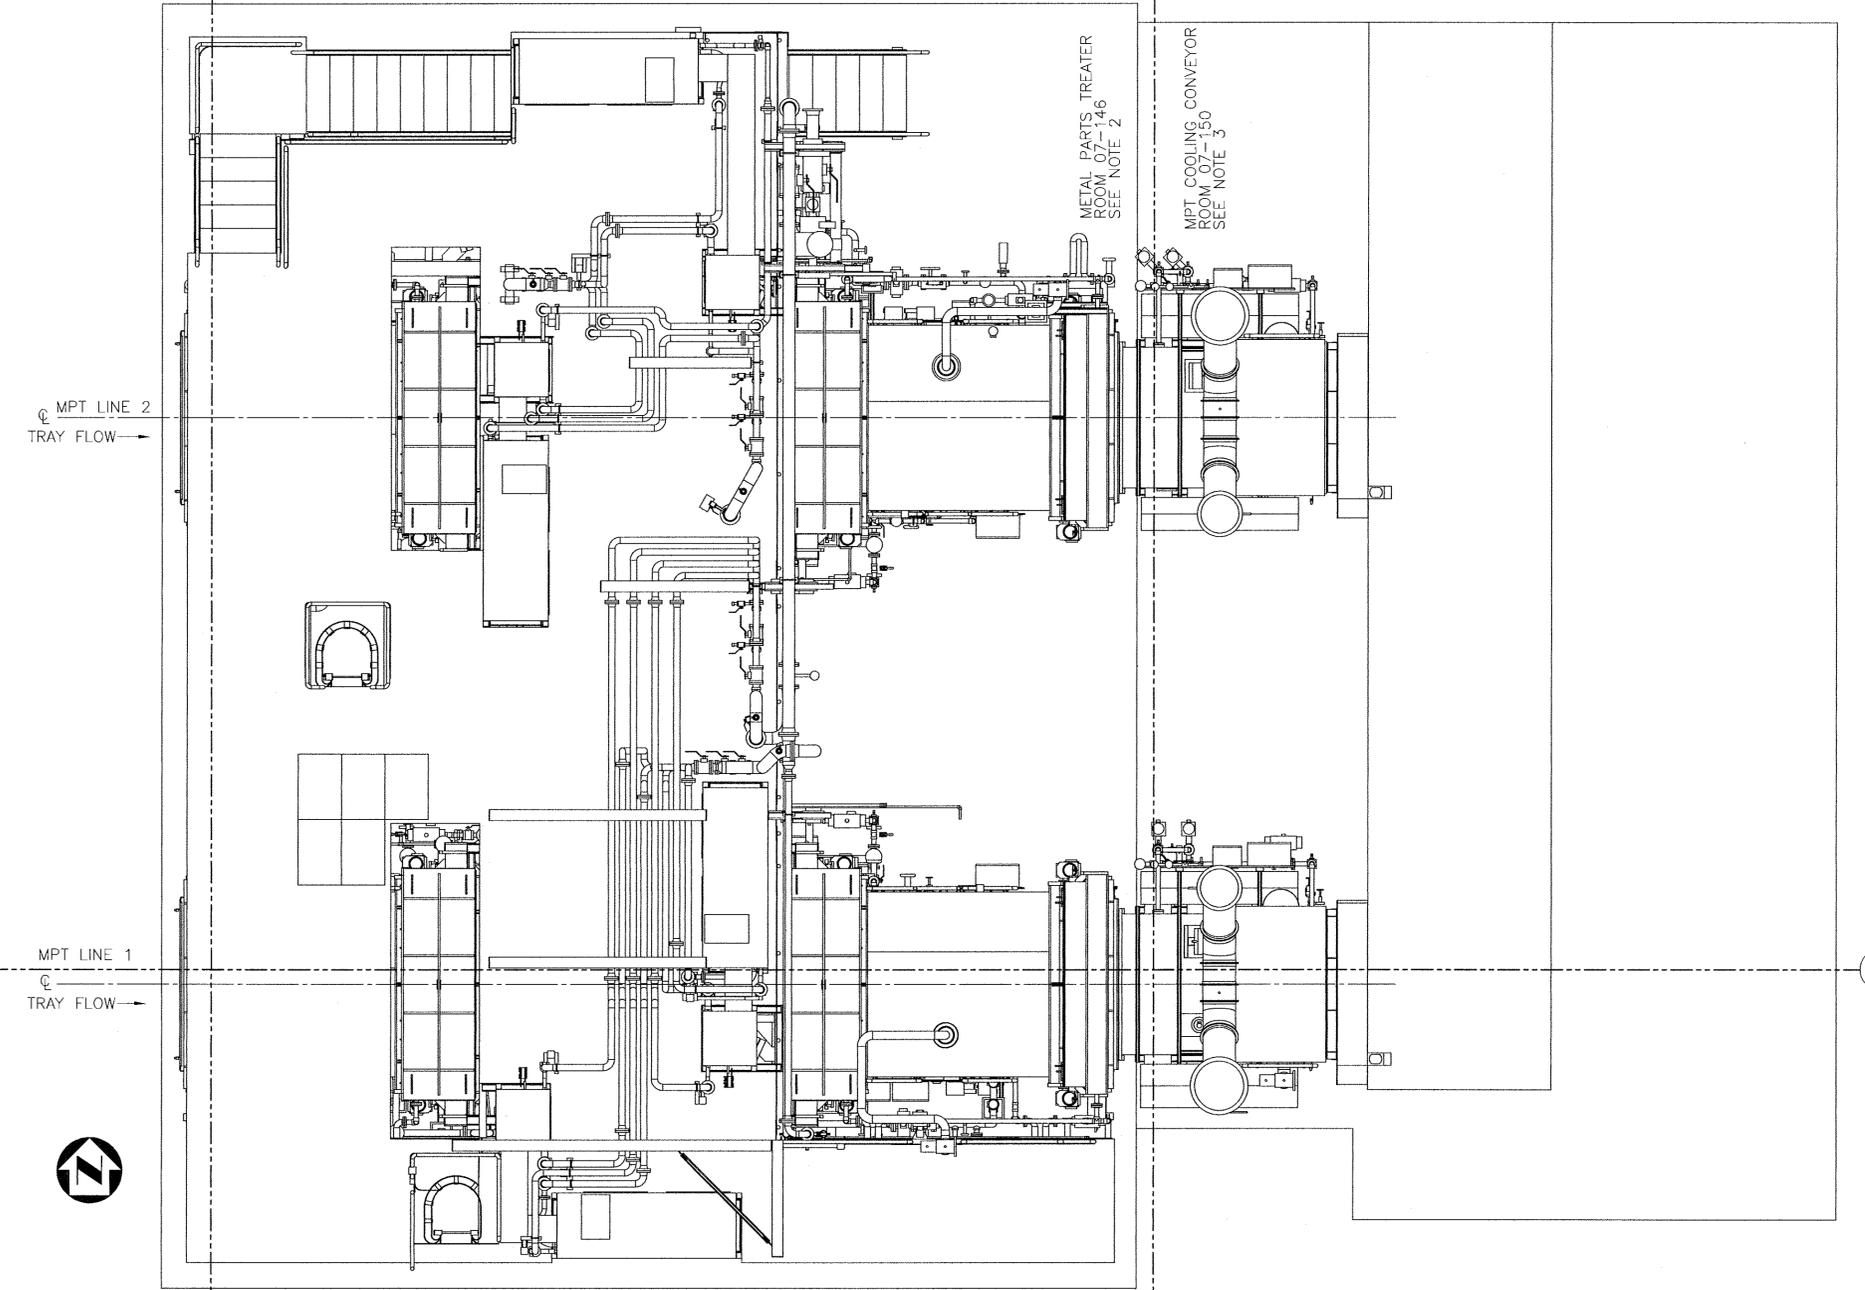

GENERAL NOTES: (UNLESS OTHERWISE NOTED)

- THE MPT CHAMBER DIMENSIONS SHOWN ARE AT COLD STATE (ROOM TEMPERATURE). AT 1500°F, THE CHAMBER WILL GROW APPROXIMATELY 2" IN LENGTH AND 1" IN DIAMETER. EACH CHAMBER LINE (CHAMBER AND OUTLET CONVEYOR) WILL GROW APPROXIMATELY 4" IN LENGTH.
- REFER TO 24915-07-B2-MPT-00001 SHEET 2 FOR DETAILS ON METAL PARTS TREATER ROOM (07-146).
- REFER TO 24915-07-B2-MPT-00001 SHEET 11 FOR DETAILS ON MPT COOLING CONVEYOR ROOM (07-150).
- REFER TO 24915-07-B2-MPT-00001 SHEET 12 FOR DETAILS ON STEAM SUPERHEATER SKID ASSY (LOCATED IN ROOM 07-148).
- REFER TO 24915-07-B2-MPT-00001 SHEET SHEET 15, 16 & 17 FOR INTERFACE DATA.
- REFER TO 24915-07-B2-MPT-00001 SHEET 18 FOR BLOCK FLOW DIAGRAM.
- REFER TO 24915-07-B2-MPT-00001 SHEET 19 FOR MPT SYSTEM DESCRIPTION.
- EXTERNAL INTERFACES ARE DENOTED WITH A DIAMOND.
 - X X.X
- E 7 E 17 C 9 C 18

THESE JUNCTION BOXES ARE LOCATED IN RM 07-148.
- E 8.1 E 9.1 E 18.1 E 19.1 C 23 C 24 C 25 C 26 C 27 C 29
 - P 2.17 P 2.18 P 2.19 P 2.20 P 6.17 P 6.18 P 6.19 P 6.20

THESE JUNCTION BOXES AND PIPE ICD'S ARE LOCATED IN RM 07-150.
- C 28 C 30

THESE JUNCTION BOXES ARE LOCATED IN RM 07-135.
- REFER TO DRAWING 24915-07-B2-MPT-00001 SHEET 20 FOR GROUND PIPE SUPPORT LOCATIONS.
- THESE ICD'S ARE TO BE FIELD LOCATED.
 - P 1.7 P 3.9 P 5.7 P 7.9
- REASON FOR DRAWING REVISION IS AS FOLLOWS: REVISED TO INCORPORATE DCN-087, DCN-088, DCN-089, DCN-097, DCN-114 AND TO INCORPORATE ECR BGCAPP-MPT-959.

MPT ICD LAYOUT

NO.	DATE	DESCRIPTION	DR	CK	DL	PE	AP/VD
△	6/29/10	IFC (SEE NOTE 14)	JPM	JXB	TF	MAR	TC
△	4/17/08	IFD (ECR NO. BGCAPP-MPT-135)	JPM	JXB	TF	MAR	TC
△	2/19/07	ISSUED FOR DESIGN					
△	10/31/06	ISSUED FOR DESIGN					
△	8/25/06	ISSUED FOR DESIGN					


<input checked="" type="checkbox"/> Q	<input checked="" type="checkbox"/> NON-Q
BECHTEL PARSONS BLUE GRASS <small>A Joint Venture of Bechtel National, Inc. and Parsons Infrastructure & Technology Group Inc.</small>	DOD PROGRAM MANAGER FOR ASSEMBLED CHEMICAL WEAPONS ASSESSMENT EDGEWOOD, MARYLAND
	US ARMY ENGINEERING AND SUPPORT CENTER, HUNTSVILLE HUNTSVILLE, ALABAMA

BLUE GRASS CHEMICAL AGENT DESTRUCTION PILOT PLANT PROJECT (BGCAPP)
RICHMOND, KENTUCKY

CONTRACT NO. DAAA09-03-D-0023



PARSONS PASCO FABRICATION SHOP
METAL PARTS TREATER
INTERFACE CONNECTION DRAWING

DRAWING NUMBER 24915-07-B2-MPT-00001 SHEET 1 OF 20 REV 4


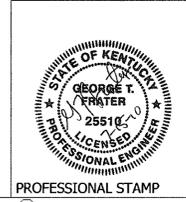


This document has been reviewed for ITAR/EAR and no ITAR/EAR sensitive information was found. 17 Dec 2013


This document has been reviewed for OPSEC material, and none was found. 17 Dec 2013

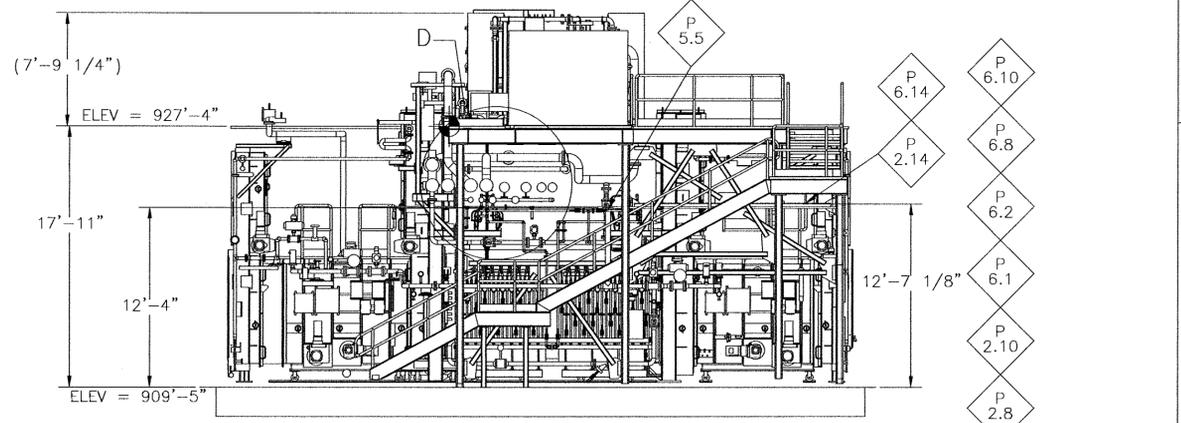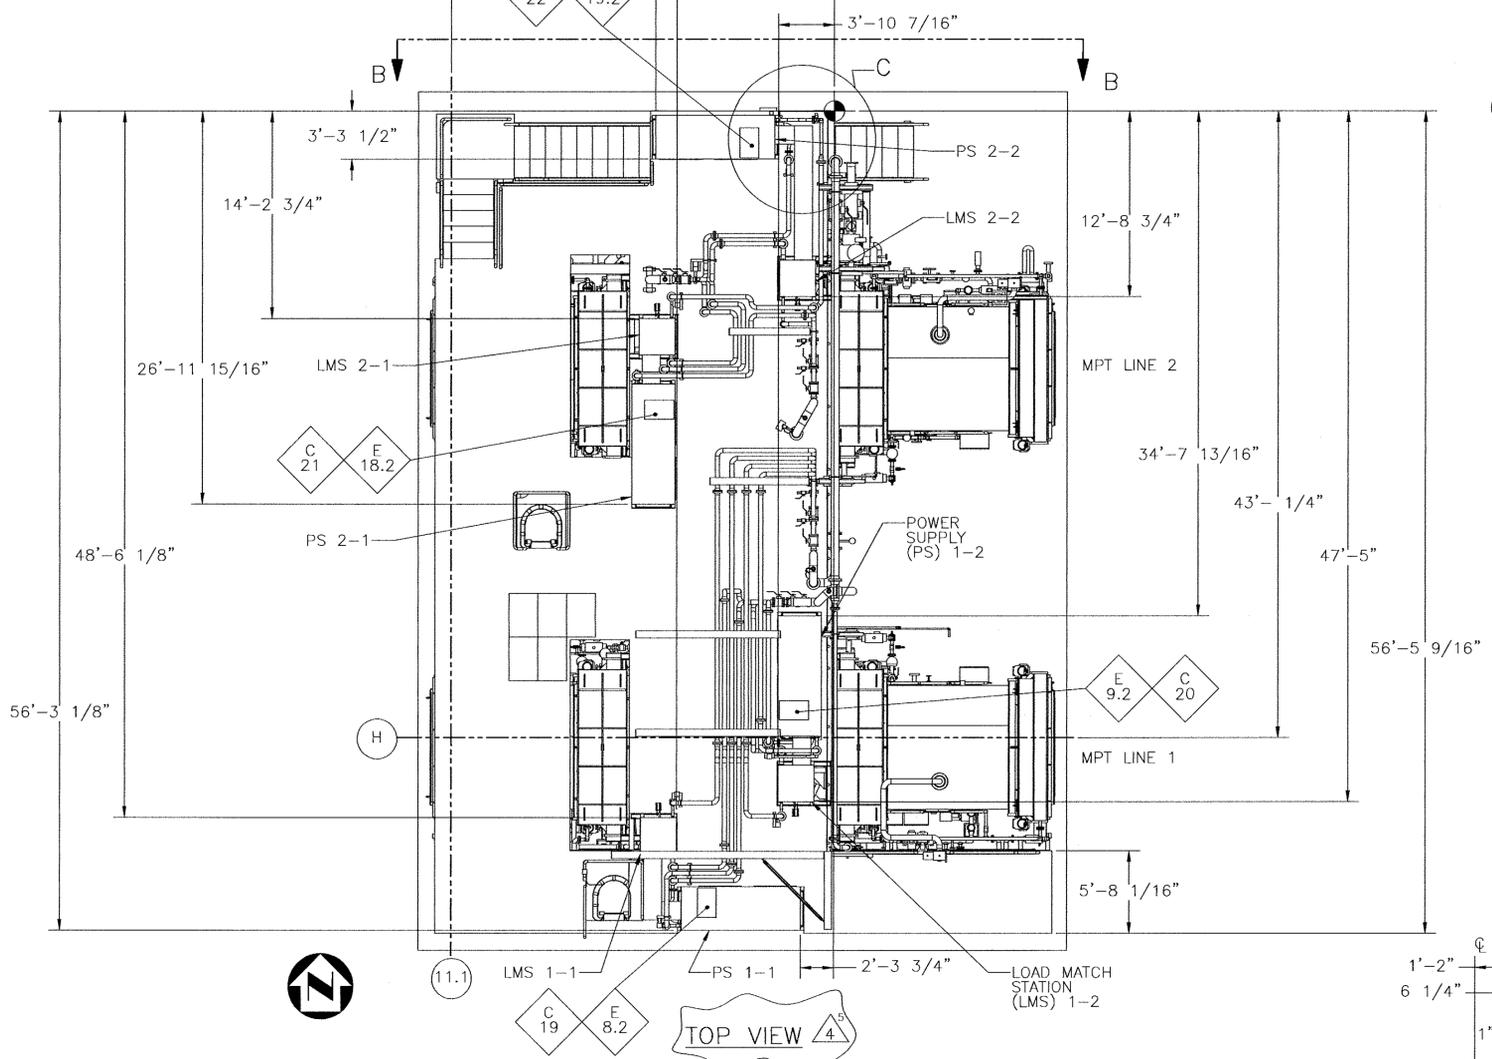

SECTION B-B

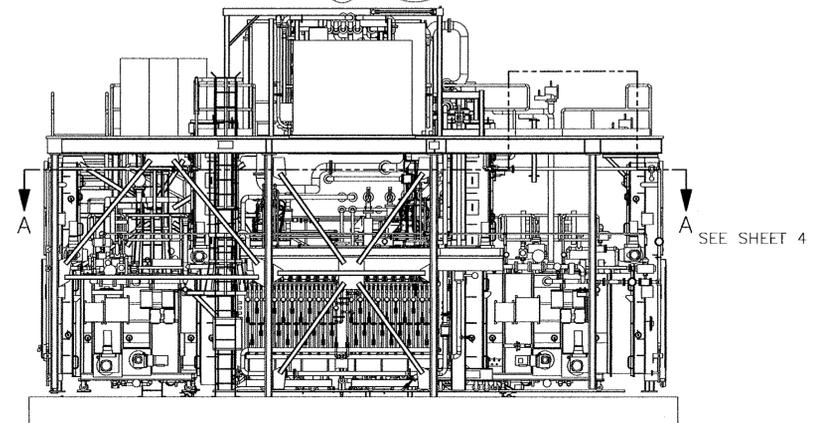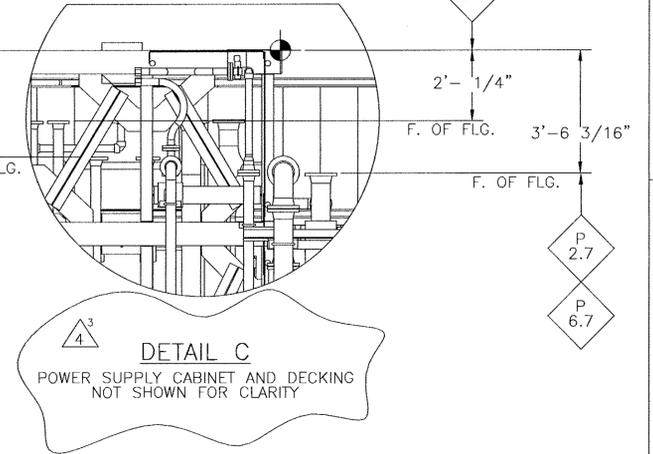

FRONT VIEW
METAL PARTS TREATER ROOM
RM 07-146
REFER TO SHEET 24915-07-B2-MPT-00001 SHT 3 FOR MORE MEZZANINE DETAILS

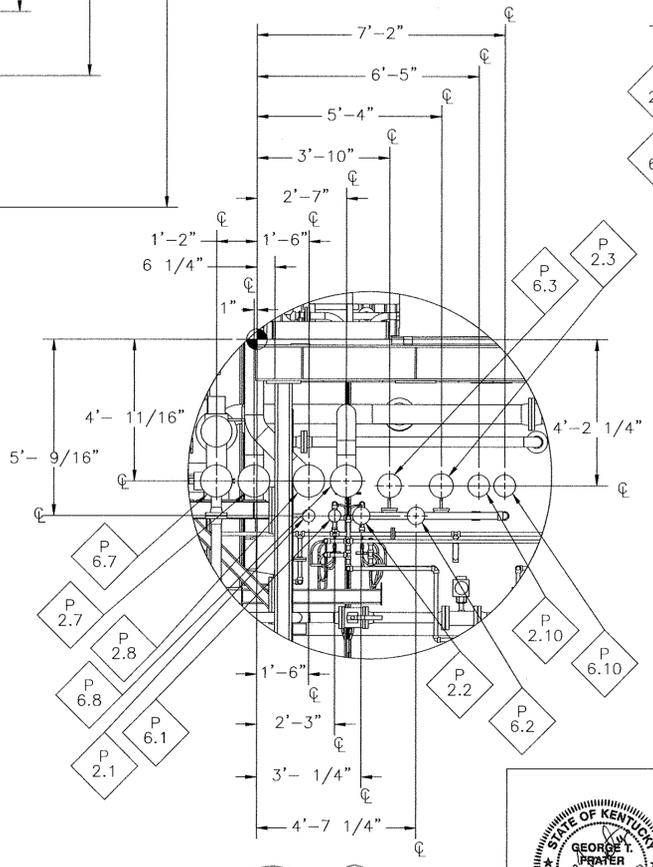

NO.	DATE	DESCRIPTION	DR	CK	DL	PE	APVD
1	6/29/10	IFC (SEE NOTE 14)	JPM	JXB	TF	MAR	TC
2	4/17/08	IFD (ECR NO. BGCAPP-MPT-135)	JPM	JXB	TF	MAR	TC
3	2/19/07	ISSUED FOR DESIGN					
4	10/31/06	ISSUED FOR DESIGN					
5	8/25/06	ISSUED FOR DESIGN					

BECHTEL PARSONS BLUE GRASS
A Joint Venture of Bechtel National, Inc. and Parsons Infrastructure & Technology Group Inc.

DOD PROGRAM MANAGER FOR ASSEMBLED CHEMICAL WEAPONS ASSESSMENT EDGEWOOD, MARYLAND


US ARMY ENGINEERING AND SUPPORT CENTER, HUNTSVILLE HUNTSVILLE, ALABAMA

BLUE GRASS CHEMICAL AGENT DESTRUCTION PILOT PLANT PROJECT (BGCAPP)
RICHMOND, KENTUCKY

CONTRACT NO. DAAA09-03-D-0023

PARSONS PASCO FABRICATION SHOP
METAL PARTS TREATER
INTERFACE CONNECTION DRAWING


DRAWING NUMBER 24915-07-B2-MPT-00001	SHEET 2 OF 20	REV 4
---	------------------	----------

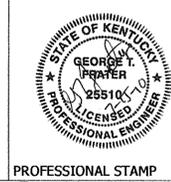




This document has been reviewed for ITAR/EAR and no ITAR/EAR sensitive information was found. 17 Dec 2013

This document has been reviewed for OPSEC material, and none was found. 17 Dec 2013

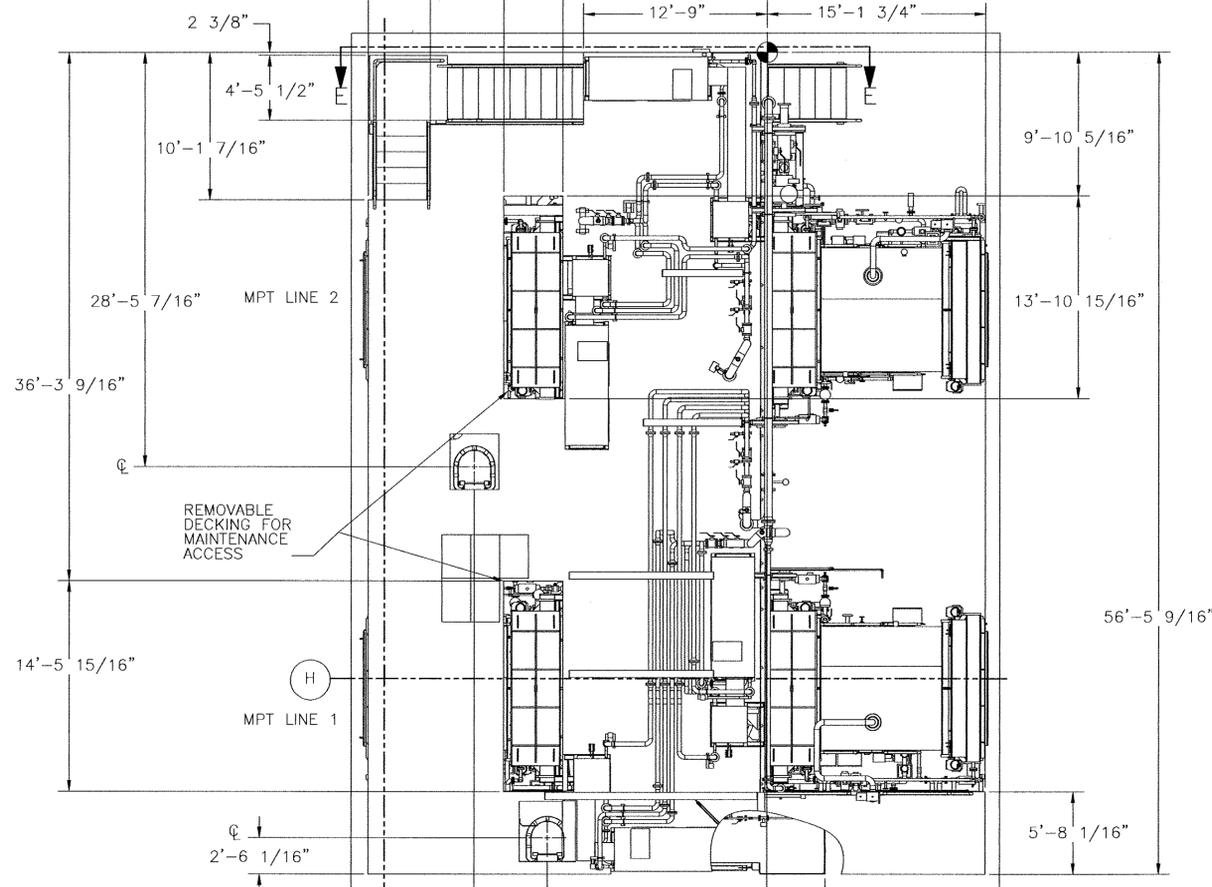


TOP VIEW

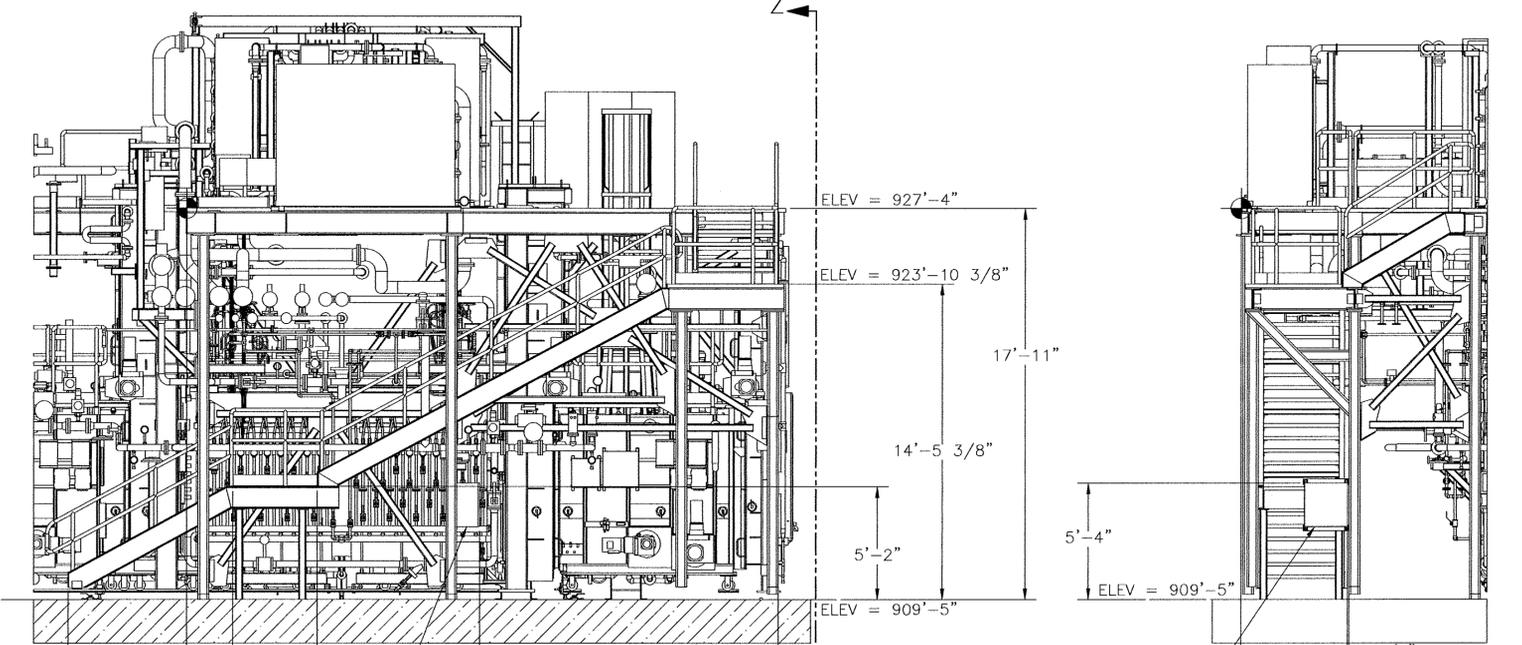


SECTION E-E

SECTION Z-Z

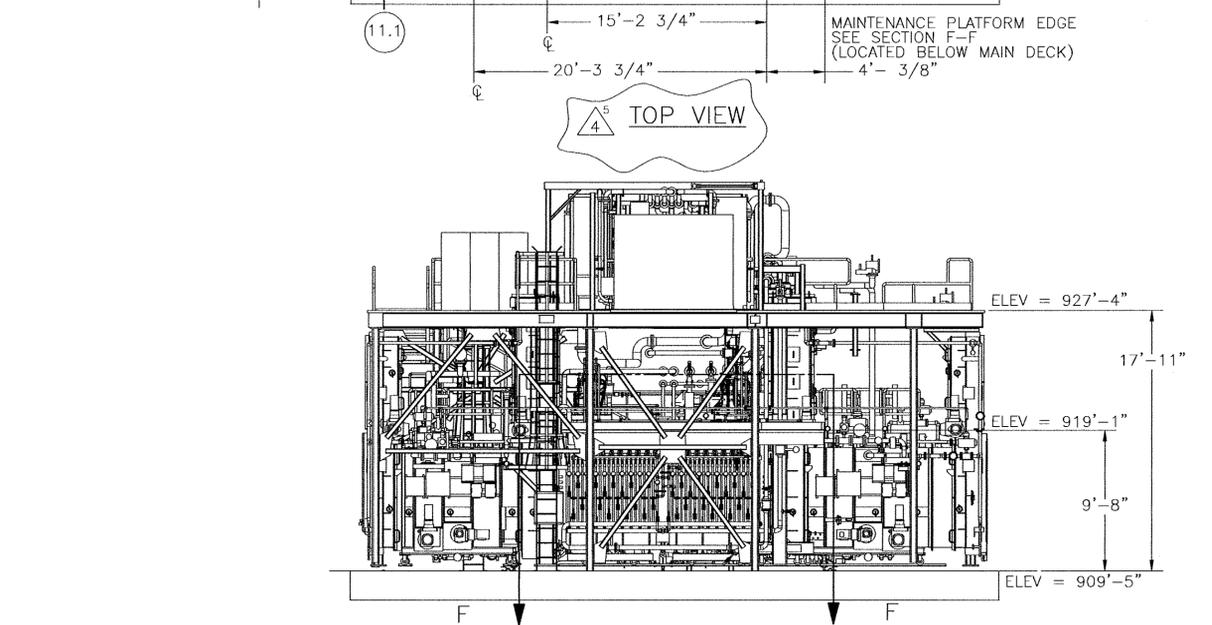

FRONT VIEW METAL PARTS TREATER ROOM

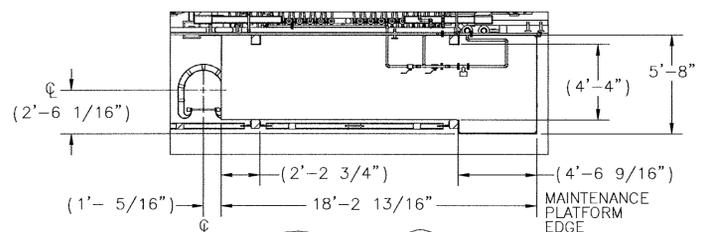

SECTION F-F MAINTENANCE PLATFORM


NO.	DATE	DESCRIPTION	DR	CK	DL	PE	APVD	
△								
△	6/29/10	IFC (SEE NOTE 14)	JPM	SM	AS	CR		
△	4/17/08	IFD (ECR NO. BGCAPP-MPT-135)	JPM	JXB	TF	MAR	TC	
△	2/19/07	ISSUED FOR DESIGN	SIGNATURES ON FILE					
△	10/31/06	ISSUED FOR DESIGN	SIGNATURES ON FILE					
△	8/25/06	ISSUED FOR DESIGN	SIGNATURES ON FILE					

<input checked="" type="checkbox"/> Q	<input type="checkbox"/> NON-Q
BECHTEL PARSONS BLUE GRASS <small>A Joint Venture of Bechtel National, Inc., and Parsons Infrastructure & Technology Group Inc.</small>	DOD PROGRAM MANAGER FOR ASSEMBLED CHEMICAL WEAPONS ASSESSMENT EDGEWOOD, MARYLAND
	US ARMY ENGINEERING AND SUPPORT CENTER, HUNTSVILLE HUNTSVILLE, ALABAMA

BLUE GRASS CHEMICAL AGENT DESTRUCTION PILOT PLANT PROJECT (BGCAPP)
RICHMOND, KENTUCKY

CONTRACT NO. DAAA09-03-D-0023

PARSONS PASCO FABRICATION SHOP
METAL PARTS TREATER
INTERFACE CONNECTION DRAWING

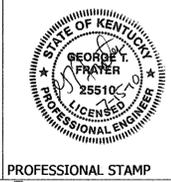


DRAWING NUMBER 24915-07-B2-MPT-00001

SHEET 3 OF 20	REV 4
---------------	-------

This document has been reviewed for ITAR/EAR and no ITAR/EAR sensitive information was found. 17 Dec 2013

This document has been reviewed for OPSEC material, and none was found. 17 Dec 2013

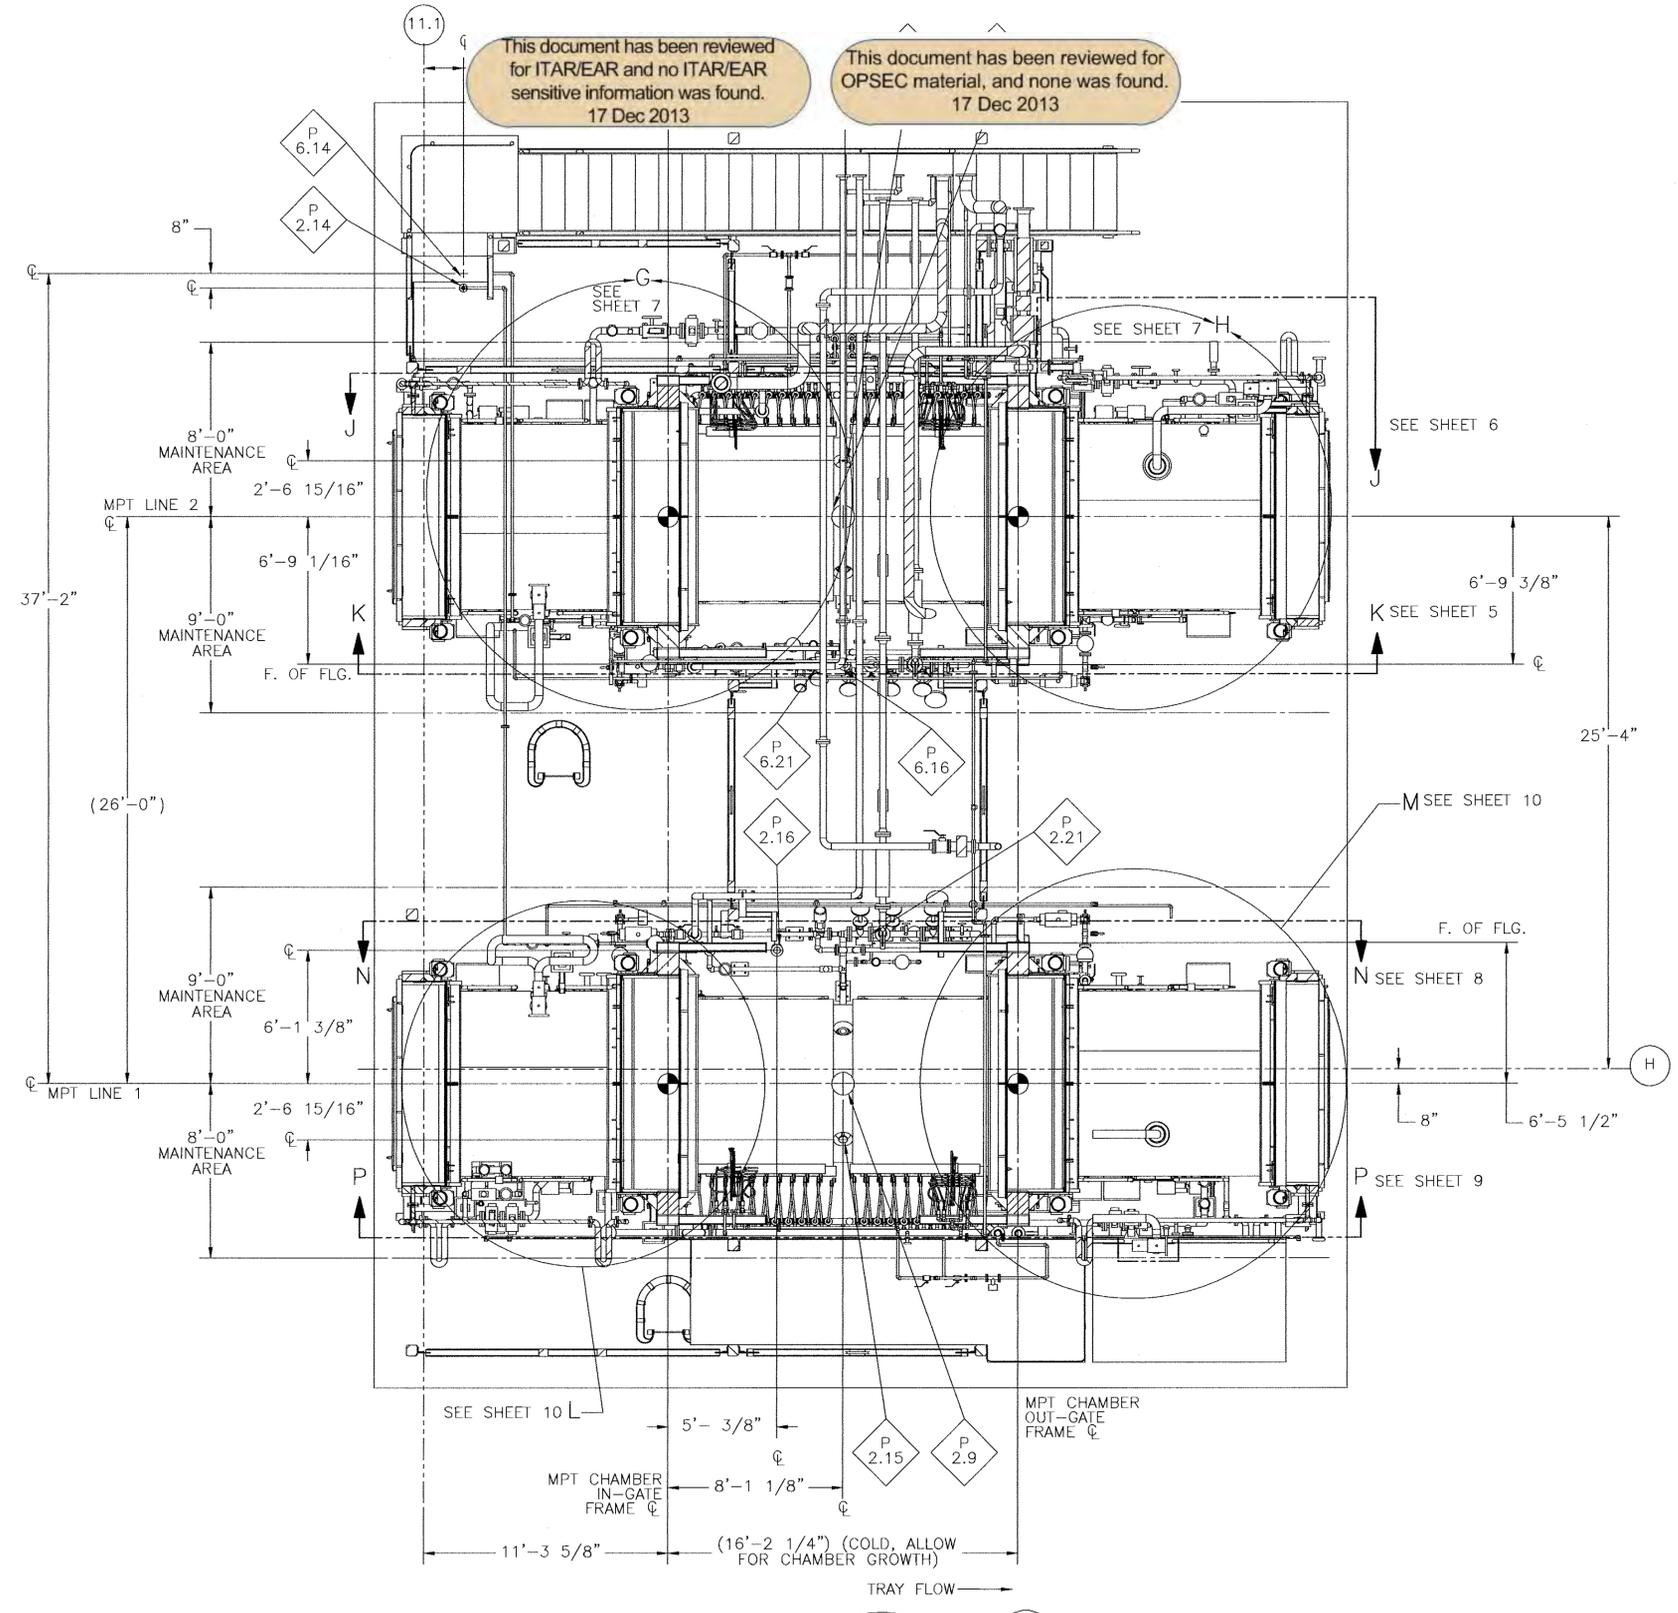

SECTION A-A FROM SHEET 2

NO.	DATE	DESCRIPTION	DR	CK	DL	PE	APVD
△							
△	6/29/10	IFC (SEE NOTE 14)					
△	4/17/08	IFD (ECR NO. BGCAPP-MPT-135)	JPM	JXB	TF	MARTC	
△	2/19/07	ISSUED FOR DESIGN	SIGNATURES ON FILE				
△	10/31/06	ISSUED FOR DESIGN	SIGNATURES ON FILE				
△	8/25/06	ISSUED FOR DESIGN	SIGNATURES ON FILE				

[X] Q		[X] NON-Q	
BECHTEL PARSONS BLUE GRASS	DOD PROGRAM MANAGER FOR ASSEMBLED CHEMICAL WEAPONS ASSESSMENT EDGEWOOD, MARYLAND	US ARMY ENGINEERING AND SUPPORT CENTER, HUNTSVILLE HUNTSVILLE, ALABAMA	

BLUE GRASS CHEMICAL AGENT DESTRUCTION
PILOT PLANT PROJECT (BGCAPP)
RICHMOND, KENTUCKY

CONTRACT NO. DAAA09-03-D-0023

PARSONS PASCO FABRICATION SHOP
METAL PARTS TREATER
INTERFACE CONNECTION DRAWING


DRAWING NUMBER 24915-07-B2-MPT-00001	SHEET 4 OF 20	REV 4
---	------------------	----------



PROFESSIONAL STAMP

This document has been reviewed for ITAR/EAR and no ITAR/EAR sensitive information was found. 17 Dec 2013

This document has been reviewed for OPSEC material, and none was found. 17 Dec 2013

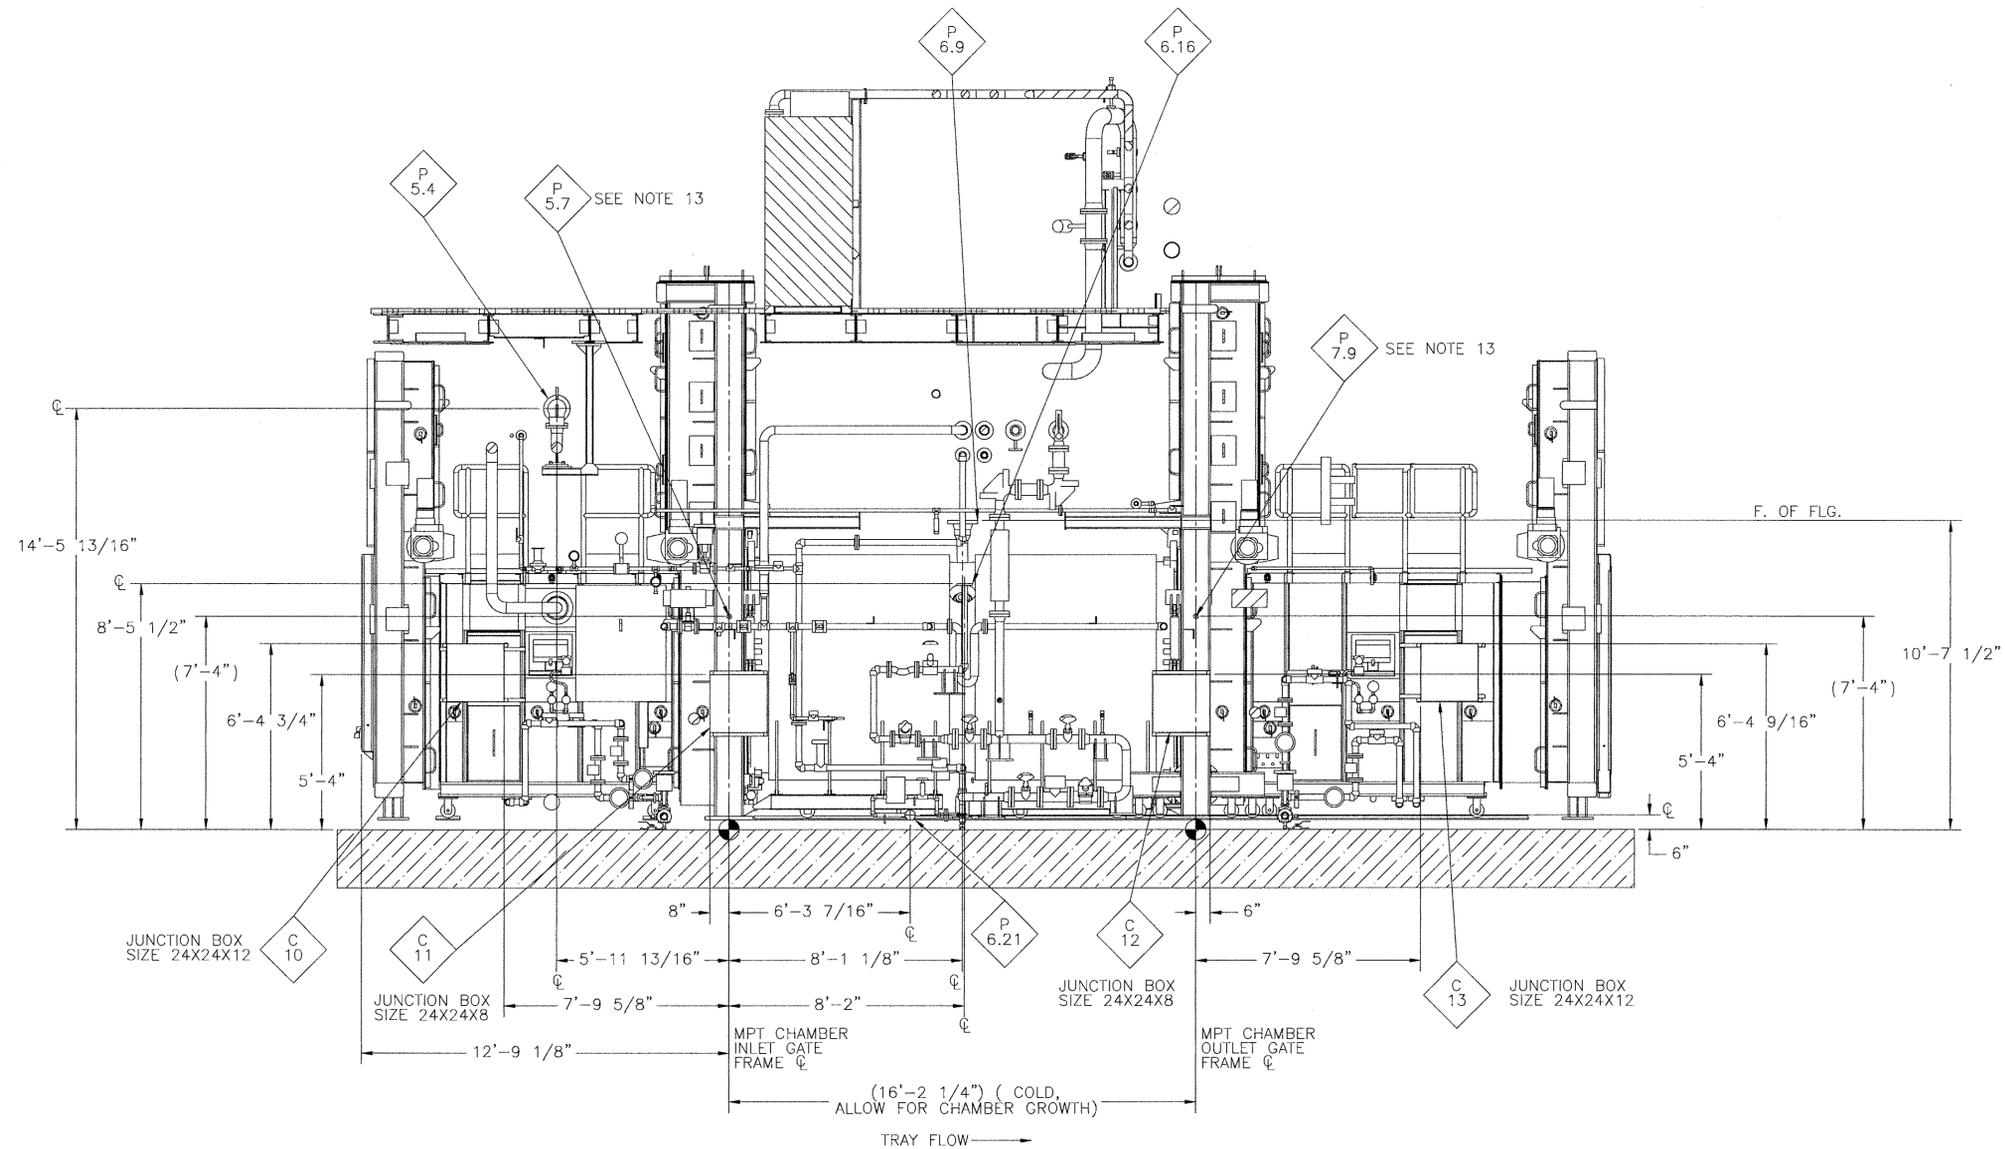

SECTION K-K
SECTION DEPTH EXTENDS TO CHAMBER CL FOR CLARITY
LINE 2 LOOKING NORTH
FROM SHEET 4

NO.	DATE	DESCRIPTION	DR	CK	DL	PE	APVD
△	6/29/10	IFC (SEE NOTE 14)					
△	4/17/08	IFD (ECR NO. BGCAPP-MPT-135)	JPM	JXB	TF	MARTC	
△	2/19/07	ISSUED FOR DESIGN	SIGNATURES ON FILE				
△	10/31/06	ISSUED FOR DESIGN	SIGNATURES ON FILE				
△	8/25/06	ISSUED FOR DESIGN	SIGNATURES ON FILE				

BECHTEL PARSONS BLUE GRASS <small>A Joint Venture of Bechtel National, Inc. and Parsons Infrastructure & Technology Group Inc.</small>	DOD PROGRAM MANAGER FOR ASSEMBLED CHEMICAL WEAPONS ASSESSMENT EDGEWOOD, MARYLAND	US ARMY ENGINEERING AND SUPPORT CENTER, HUNTSVILLE HUNTSVILLE, ALABAMA
--	---	---

**BLUE GRASS CHEMICAL AGENT DESTRUCTION
PILOT PLANT PROJECT (BGCAPP)
RICHMOND, KENTUCKY**

CONTRACT NO. DAAA09-03-D-0023


**PARSONS PASCO FABRICATION SHOP
METAL PARTS TREATER
INTERFACE CONNECTION DRAWING**



DRAWING NUMBER 24915-07-B2-MPT-00001	SHEET 5 OF 20	REV 4
---	------------------	----------

This document has been reviewed for ITAR/EAR and no ITAR/EAR sensitive information was found. 17 Dec 2013

This document has been reviewed for OPSEC material, and none was found. 17 Dec 2013

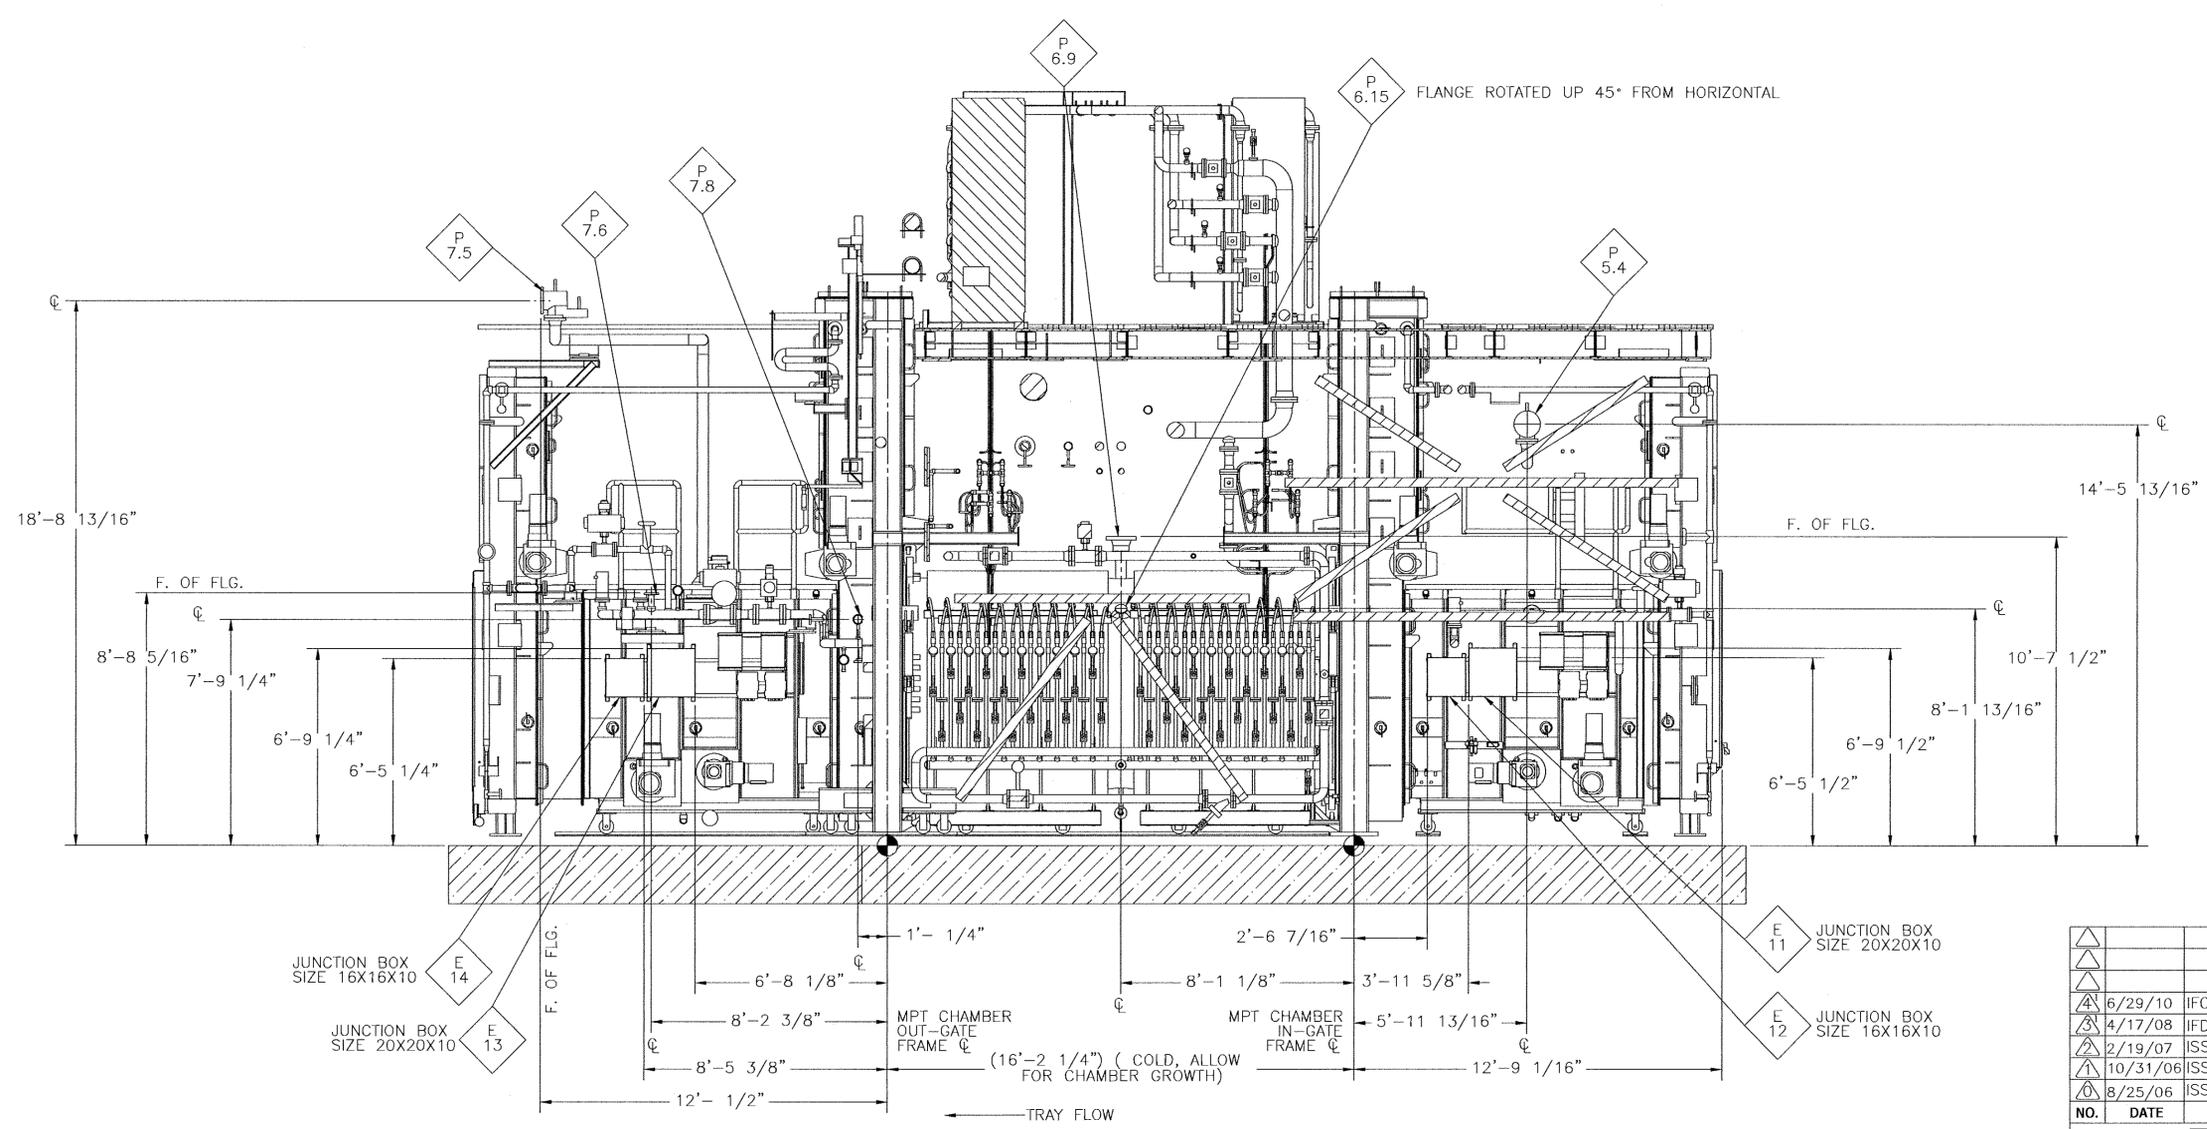

JUNCTION BOX SIZE 16X16X10
E 14

JUNCTION BOX SIZE 20X20X10
E 13

E 11 JUNCTION BOX SIZE 20X20X10

E 12 JUNCTION BOX SIZE 16X16X10

SECTION J-J
SECTION DEPTH EXTENDS TO CHAMBER CL FOR CLARITY
LINE 2 LOOKING SOUTH FROM SHEET 4


NO.	DATE	DESCRIPTION	DR	CK	DL	PE	APVD	
△	6/29/10	IFC (SEE NOTE 14)						
△	4/17/08	IFD (ECR NO. BGCAPP--MPT-135)	JPM	JXB	TF	MAR	TC	
△	2/19/07	ISSUED FOR DESIGN	SIGNATURES ON FILE					
△	10/31/06	ISSUED FOR DESIGN	SIGNATURES ON FILE					
△	8/25/06	ISSUED FOR DESIGN	SIGNATURES ON FILE					

[X] Q		[X] NON-Q			
BECHTEL PARSONS BLUE GRASS		DOD PROGRAM MANAGER FOR ASSEMBLED CHEMICAL WEAPONS ASSESSMENT EDGEWOOD, MARYLAND		US ARMY ENGINEERING AND SUPPORT CENTER, HUNTSVILLE HUNTSVILLE, ALABAMA	

BLUE GRASS CHEMICAL AGENT DESTRUCTION PILOT PLANT PROJECT (BGCAPP)
RICHMOND, KENTUCKY

CONTRACT NO. DAAA09-03-D-0023


PARSONS PASCO FABRICATION SHOP
METAL PARTS TREATER
INTERFACE CONNECTION DRAWING

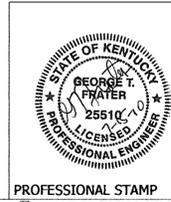

DRAWING NUMBER 24915-07-B2-MPT-00001
SHEET 6 OF 20
REV 4

This document has been reviewed for ITAR/EAR and no ITAR/EAR sensitive information was found. 17 Dec 2013

This document has been reviewed for OPSEC material, and none was found. 17 Dec 2013

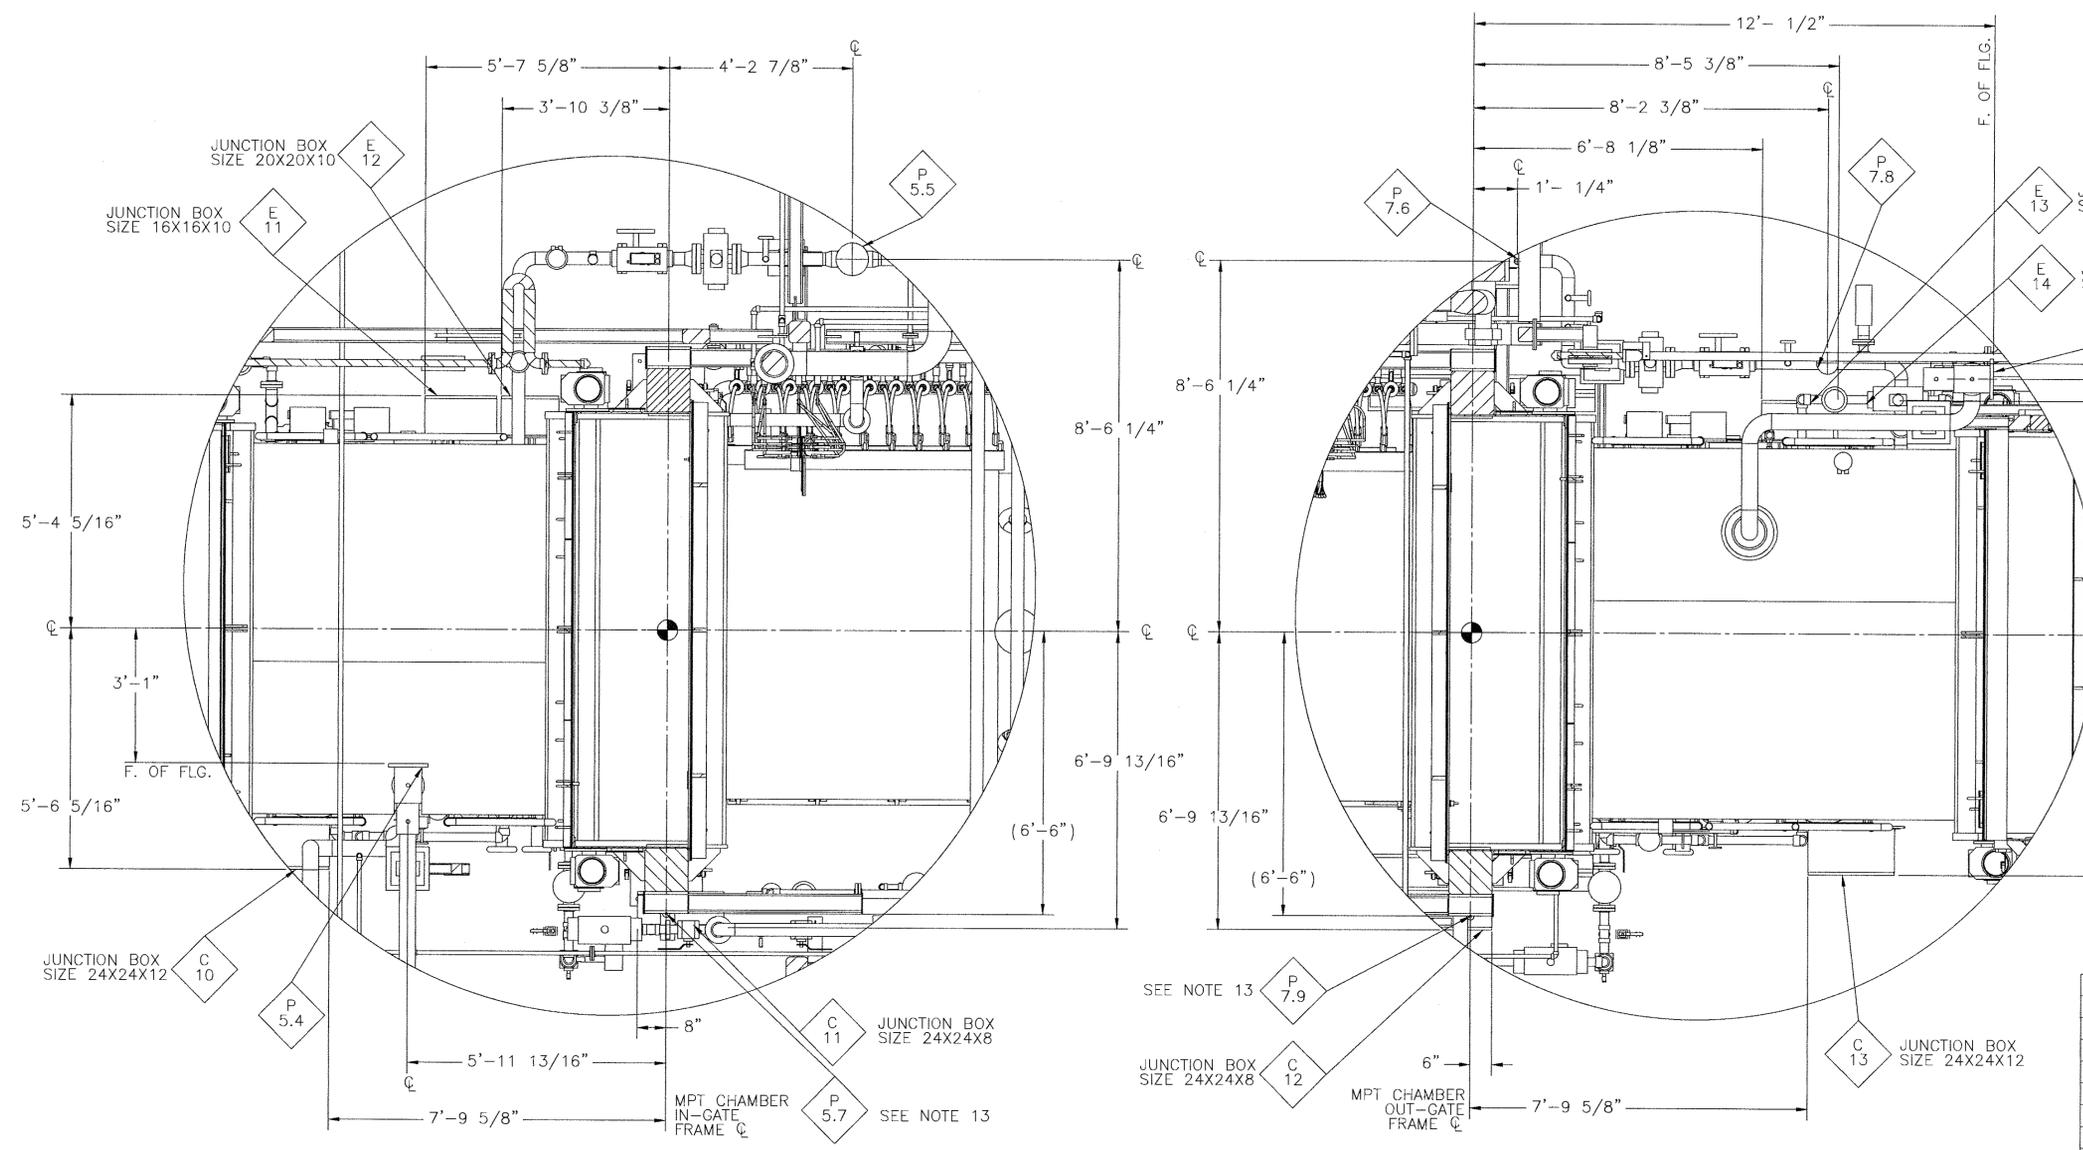

DETAIL G
INLET AIRLOCK LINE 2 FROM SHEET 4

DETAIL H
OUTLET AIRLOCK LINE 2 FROM SHEET 4

NO.	DATE	DESCRIPTION	DR	CK	DL	PE	APVD	
4	6/29/10	IFC (SEE NOTE 14)						
3	4/17/08	IFD (ECR NO. BGCAPP-MPT-135)	JPM	JXB	TF	WAR	TC	
2	2/19/07	ISSUED FOR DESIGN	SIGNATURES ON FILE					
1	10/31/06	ISSUED FOR DESIGN	SIGNATURES ON FILE					
0	8/25/06	ISSUED FOR DESIGN	SIGNATURES ON FILE					

	DOD PROGRAM MANAGER FOR ASSEMBLED CHEMICAL WEAPONS ASSESSMENT EDGEWOOD, MARYLAND	US ARMY ENGINEERING AND SUPPORT CENTER, HUNTSVILLE HUNTSVILLE, ALABAMA
	BLUE GRASS CHEMICAL AGENT DESTRUCTION PILOT PLANT PROJECT (BGCAPP) RICHMOND, KENTUCKY	

CONTRACT NO. DAAA09-03-D-0023


PARSONS PASCO FABRICATION SHOP
METAL PARTS TREATER
INTERFACE CONNECTION DRAWING



DRAWING NUMBER 24915-07-B2-MPT-00001 SHEET 7 OF 20 REV 4

This document has been reviewed for ITAR/EAR and no ITAR/EAR sensitive information was found. 17 Dec 2013

This document has been reviewed for OPSEC material, and none was found. 17 Dec 2013

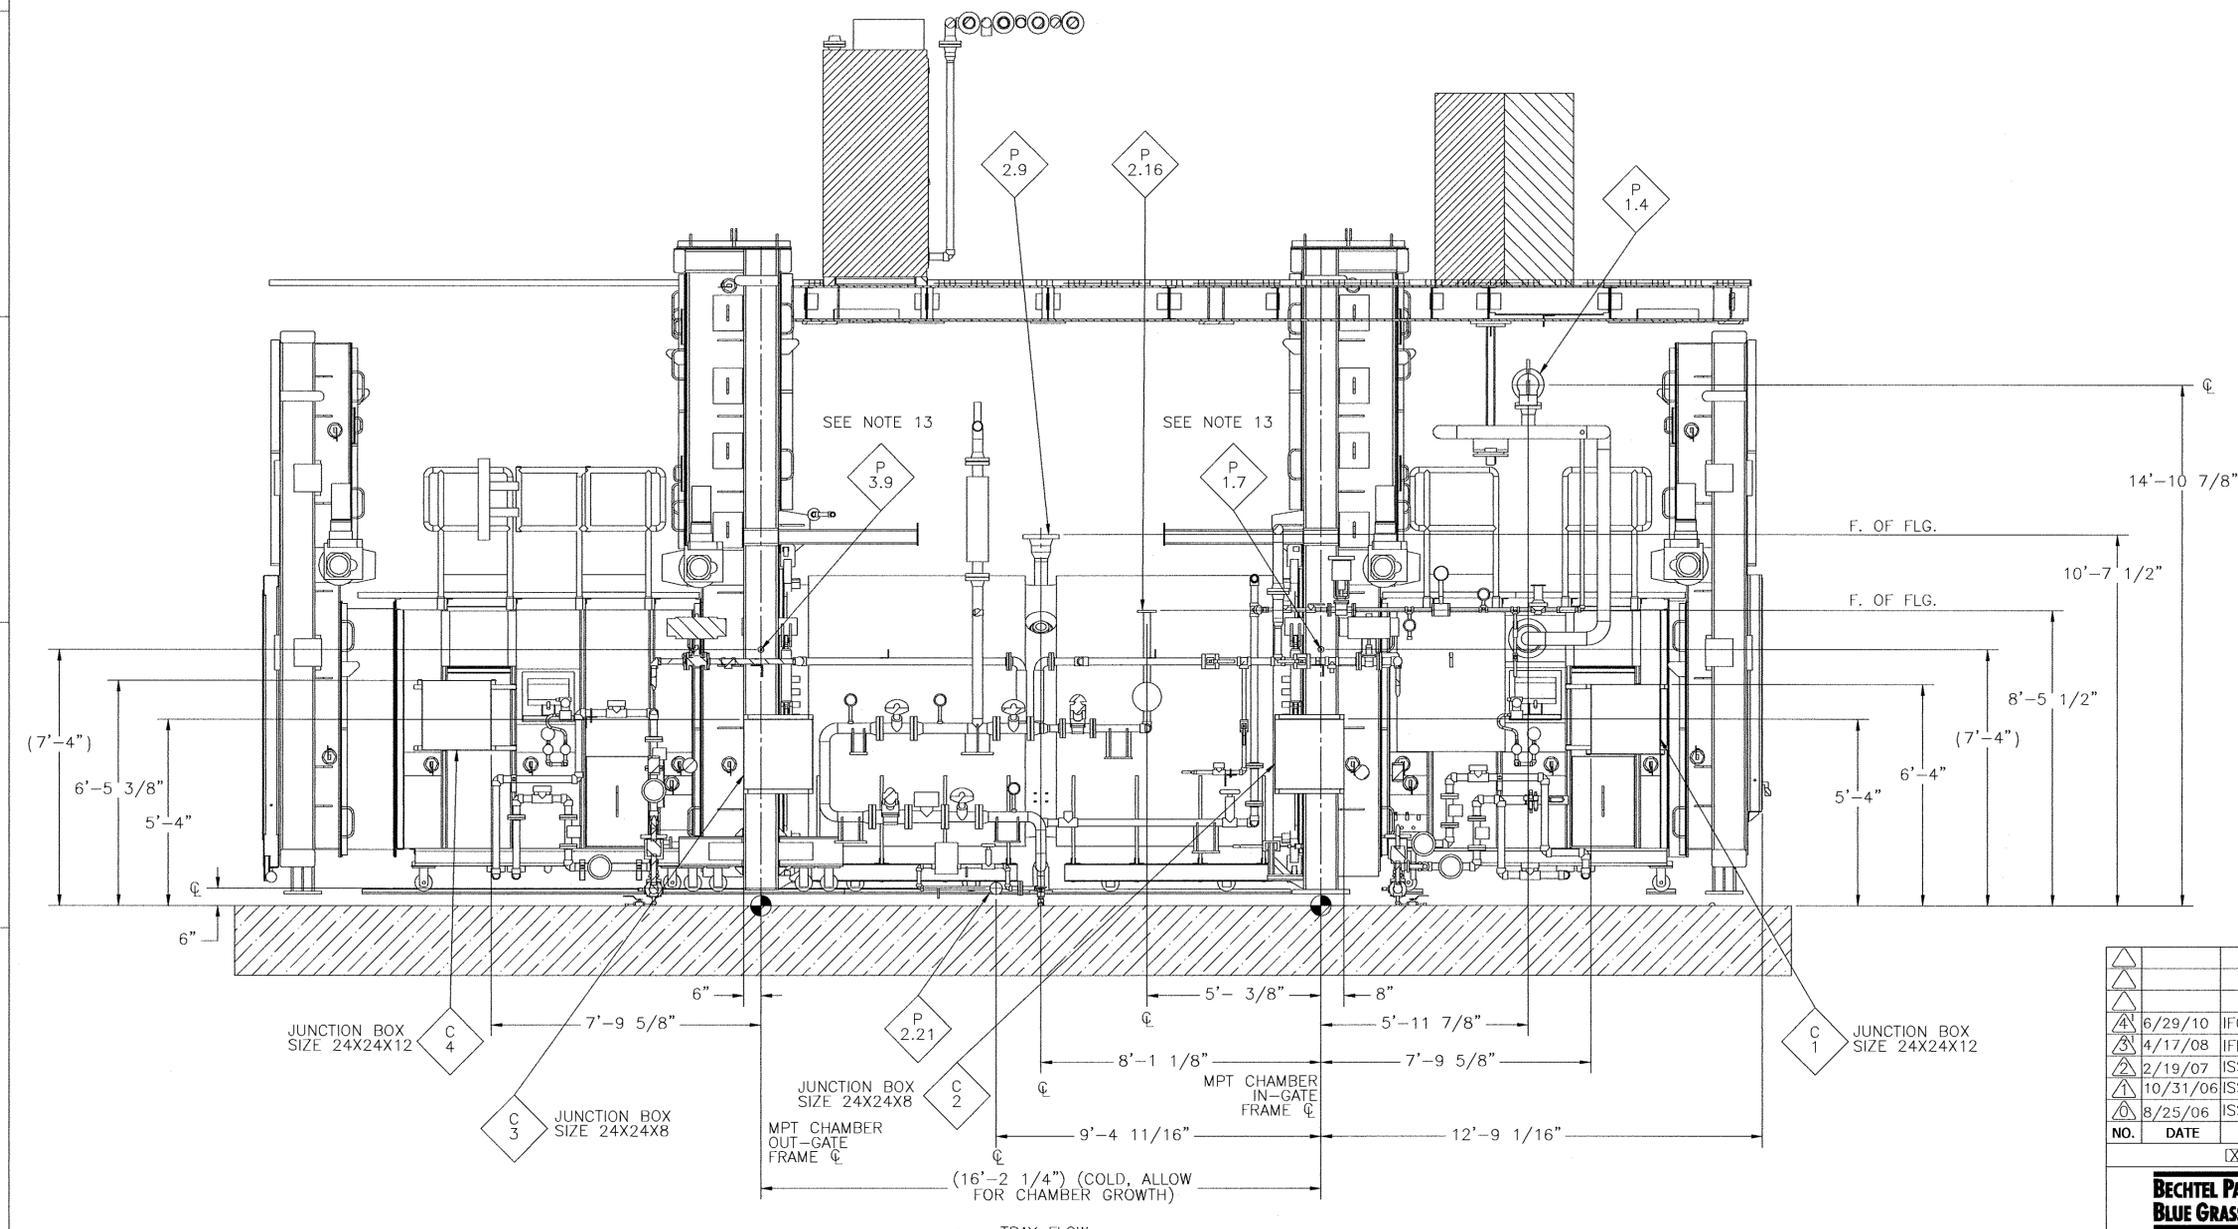

SECTION N-N
SECTION DEPTH EXTENDS TO CHAMBER CL FOR CLARITY
LINE 1 LOOKING SOUTH
FROM SHEET 4

NO.	DATE	DESCRIPTION	DR	CK	DL	PE	APVD
△	6/29/10	IFC (SEE NOTE 14)					
△	4/17/08	IFD (ECR NO. BGCAPP-MPT-135)	JPM	JXB	TF	MAR	TC
△	2/19/07	ISSUED FOR DESIGN	SIGNATURES ON FILE				
△	10/31/06	ISSUED FOR DESIGN	SIGNATURES ON FILE				
△	8/25/06	ISSUED FOR DESIGN	SIGNATURES ON FILE				


	DOD PROGRAM MANAGER FOR ASSEMBLED CHEMICAL WEAPONS ASSESSMENT EDGWOOD, MARYLAND	US ARMY ENGINEERING AND SUPPORT CENTER, HUNTSVILLE HUNTSVILLE, ALABAMA
	BLUE GRASS CHEMICAL AGENT DESTRUCTION PILOT PLANT PROJECT (BGCAPP) RICHMOND, KENTUCKY	



CONTRACT NO.	DAAA09-03-D-0023		
PARSONS PASCO FABRICATION SHOP METAL PARTS TREATER INTERFACE CONNECTION DRAWING			
DRAWING NUMBER	SHEET	REV	
24915-07-B2-MPT-00001	8 OF 20	4	

This document has been reviewed for ITAR/EAR and no ITAR/EAR sensitive information was found. 17 Dec 2013

This document has been reviewed for OPSEC material, and none was found. 17 Dec 2013

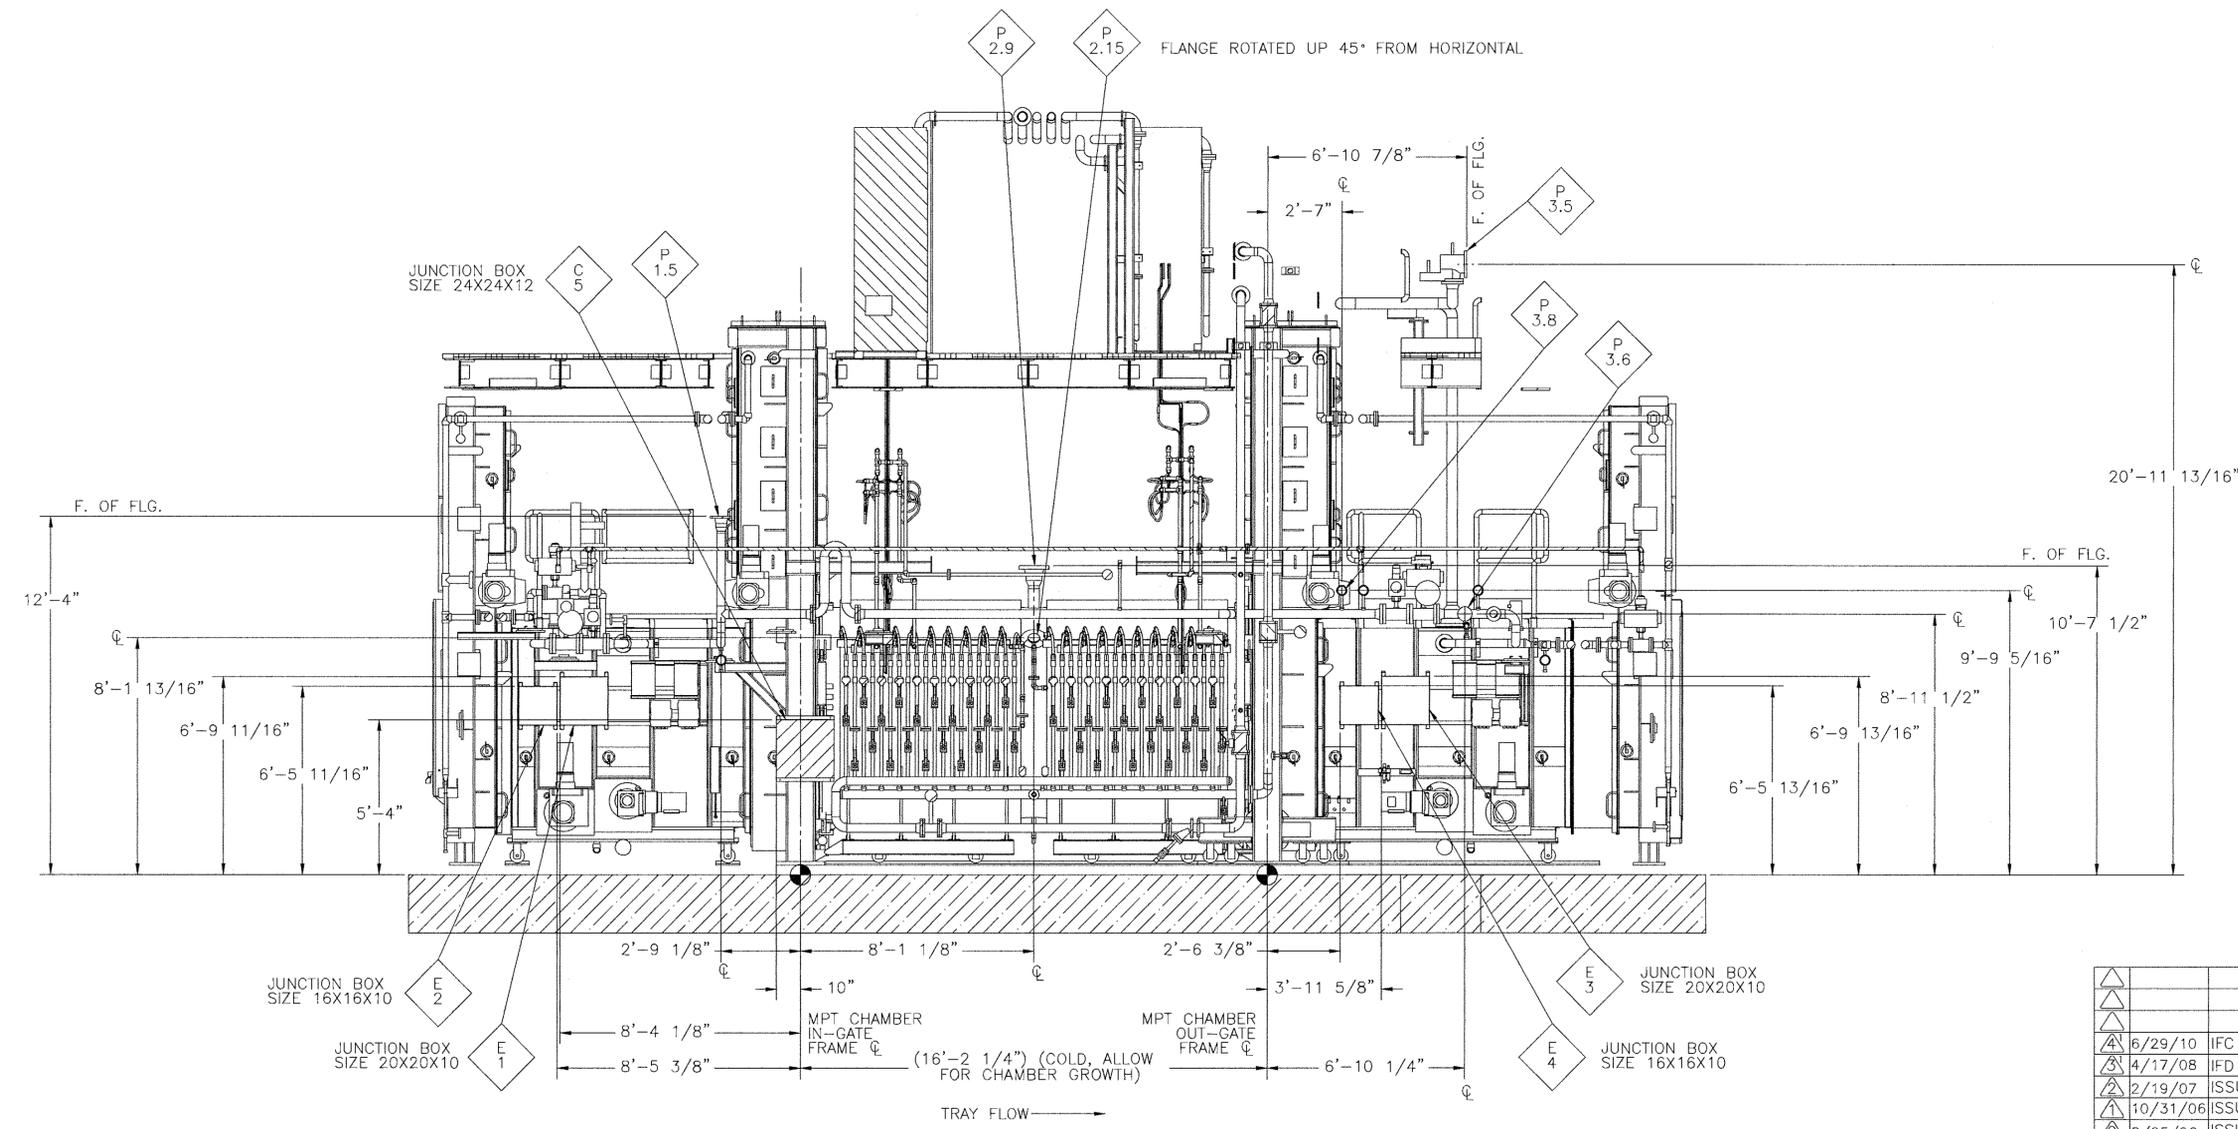

JUNCTION BOX SIZE 24X24X12

JUNCTION BOX SIZE 16X16X10

JUNCTION BOX SIZE 20X20X10

JUNCTION BOX SIZE 20X20X10

JUNCTION BOX SIZE 20X20X10

JUNCTION BOX SIZE 16X16X10

JUNCTION BOX SIZE 20X20X10

MPT CHAMBER IN-GATE FRAME

MPT CHAMBER OUT-GATE FRAME

(16'-2 1/4") (COLD, ALLOW FOR CHAMBER GROWTH)

TRAY FLOW

SECTION P-P
SECTION DEPTH EXTENDS TO CHAMBER CL FOR CLARITY
LINE 1, LOOKING NORTH
FROM SHEET 4

NO.	DATE	DESCRIPTION	DR	CK	DL	PE	APVD
△							
△	6/29/10	IFC (SEE NOTE 14)					
△	4/17/08	IFD (ECR NO. BGCAPP-MPT-135)	JPM	JXB	TF		MAR TC
△	2/19/07	ISSUED FOR DESIGN	SIGNATURES ON FILE				
△	10/31/06	ISSUED FOR DESIGN	SIGNATURES ON FILE				
△	8/25/06	ISSUED FOR DESIGN	SIGNATURES ON FILE				

<input checked="" type="checkbox"/> Q	<input checked="" type="checkbox"/> NON-Q
BECHTEL PARSONS BLUE GRASS <small>A Joint Venture of Bechtel National, Inc. and Parsons Infrastructure & Technology Group Inc.</small>	DOD PROGRAM MANAGER FOR ASSEMBLED CHEMICAL WEAPONS ASSESSMENT EDGEWOOD, MARYLAND
	US ARMY ENGINEERING AND SUPPORT CENTER, HUNTSVILLE HUNTSVILLE, ALABAMA

**BLUE GRASS CHEMICAL AGENT DESTRUCTION
PILOT PLANT PROJECT (BGCAPP)
RICHMOND, KENTUCKY**

CONTRACT NO. DAAA09-03-D-0023

**PARSONS PASCO FABRICATION SHOP
METAL PARTS TREATER
INTERFACE CONNECTION DRAWING**






DRAWING NUMBER 24915-07-B2-MPT-00001


SHEET	REV
9 OF 20	4

This document has been reviewed for ITAR/EAR and no ITAR/EAR sensitive information was found. 17 Dec 2013


This document has been reviewed for OPSEC material, and none was found. 17 Dec 2013

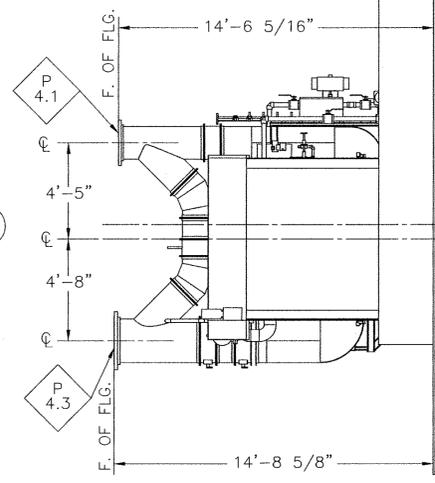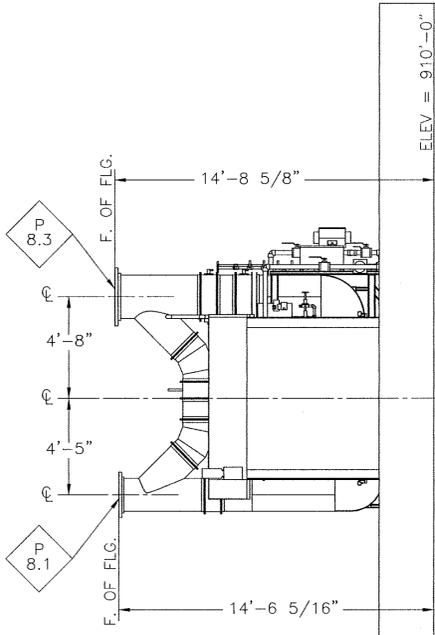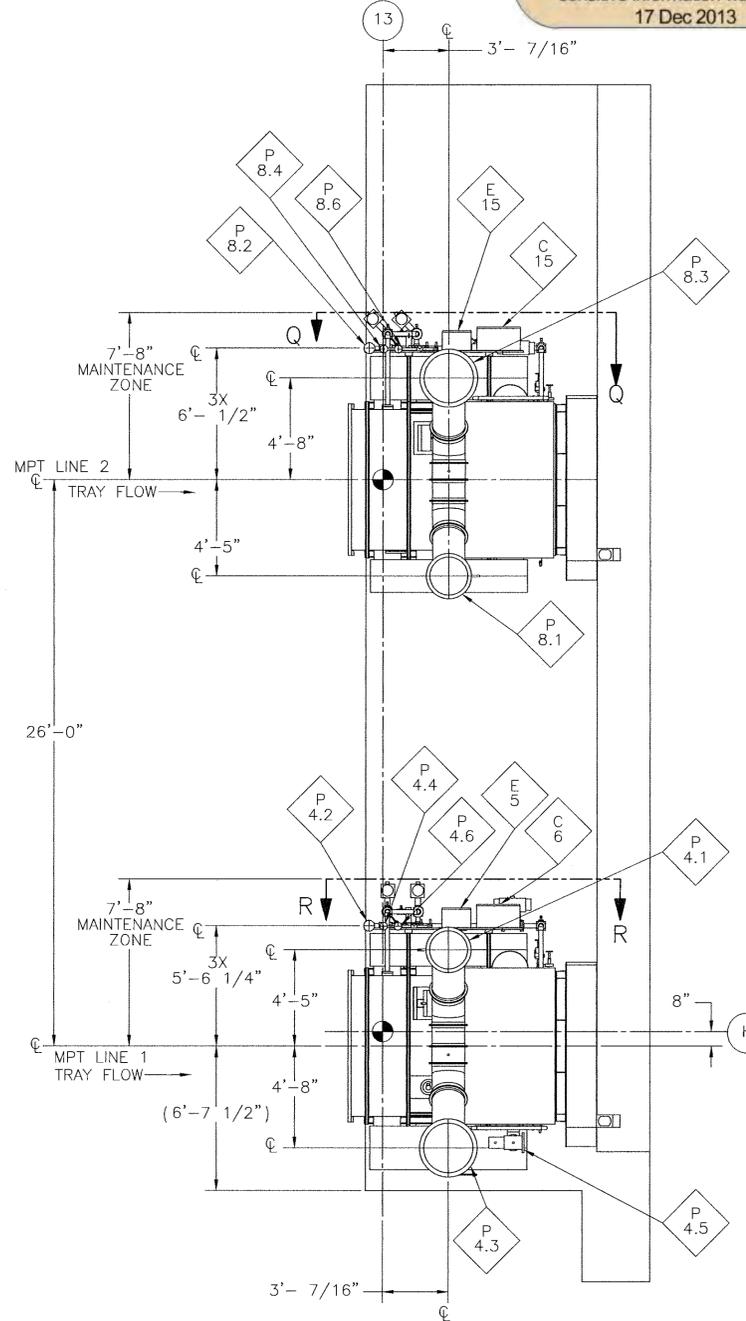


4⁶ SIDE VIEW

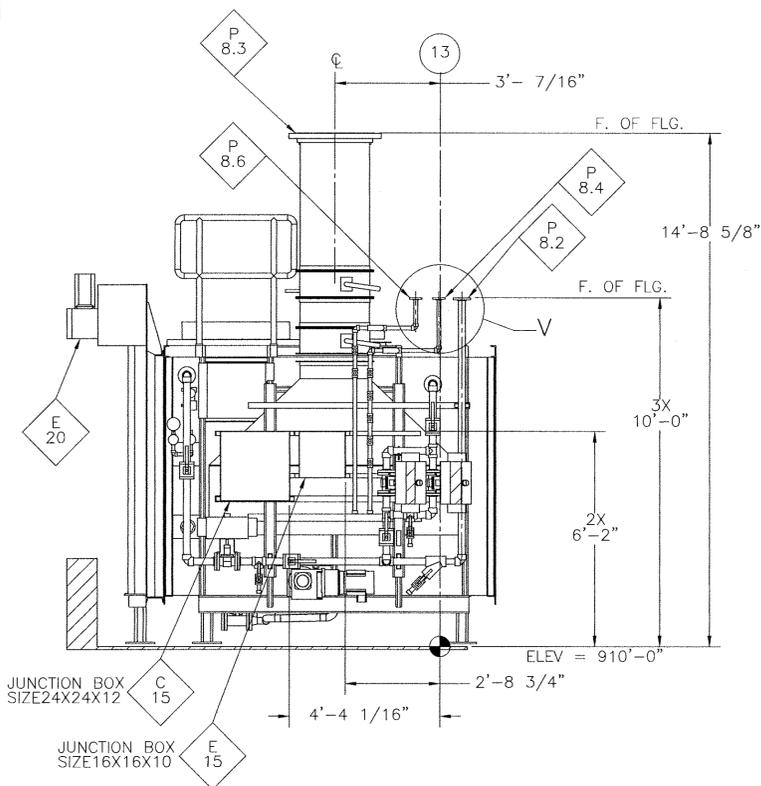


4² SECTION Q-Q LINE 2

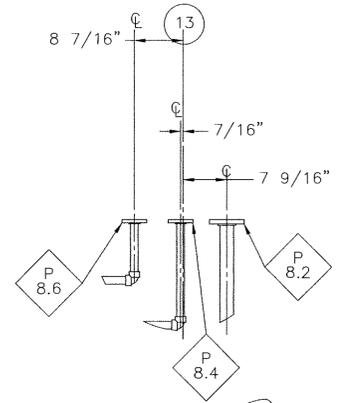

4⁴ DETAIL V

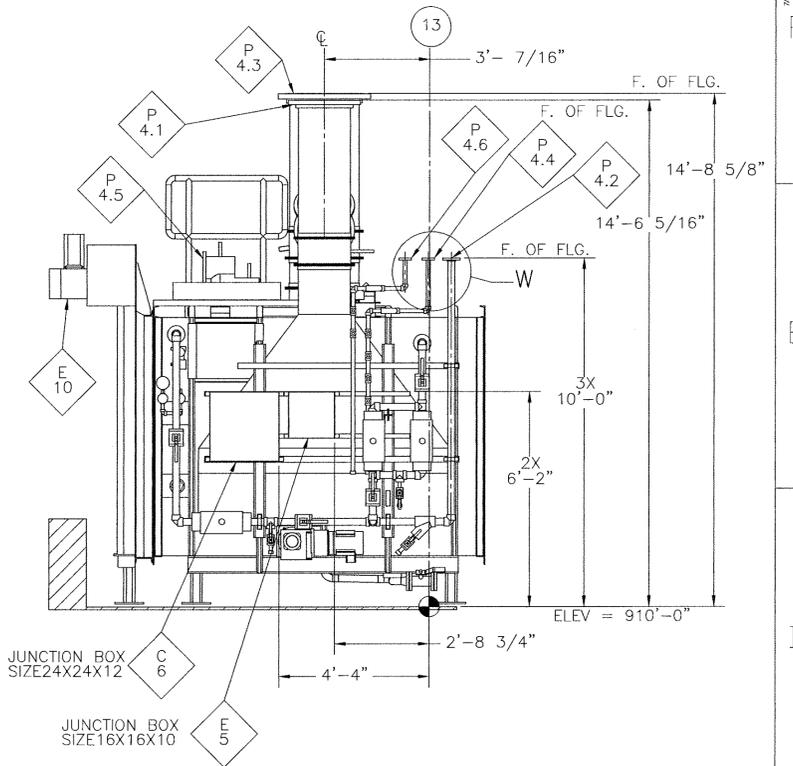

4³ SECTION R-R LINE 1

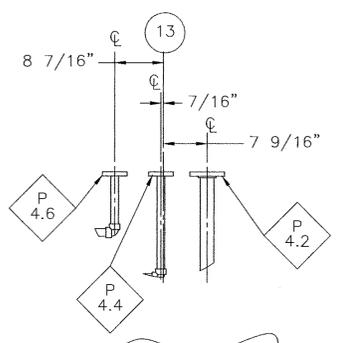

4⁵ DETAIL W

NO.	DATE	DESCRIPTION	DR	CK	DL	PE	APVD
1	6/29/10	IFC (SEE NOTE 14)					
2	4/17/08	IFD (ECR NO. BGCAPP-MPT-135)	JPM	JXB	TF	MARTC	
3	2/19/07	ISSUED FOR DESIGN					
4	10/31/06	ISSUED FOR DESIGN					
5	8/25/06	ISSUED FOR DESIGN					

BECHTEL PARSONS A Joint Venture of Bechtel National, Inc. and Parsons Infrastructure & Technology Group, Inc.	DOD PROGRAM MANAGER FOR ASSEMBLED CHEMICAL WEAPONS ASSESSMENT EDGEWOOD, MARYLAND	US ARMY ENGINEERING AND SUPPORT CENTER, HUNTSVILLE HUNTSVILLE, ALABAMA
---	--	--

BLUE GRASS CHEMICAL AGENT DESTRUCTION PILOT PLANT PROJECT (BGCAPP)
RICHMOND, KENTUCKY

CONTRACT NO. DAAA09-03-D-0023

PARSONS PASCO FABRICATION SHOP METAL PARTS TREATER INTERFACE CONNECTION DRAWING


DRAWING NUMBER 24915-07-B2-MPT-00001 SHEET 11 OF 20 REV 4




4¹ TOP VIEW MPT COOLING CONVEYOR ROOM RM 07-150

This document has been reviewed for ITAR/EAR and no ITAR/EAR sensitive information was found. 17 Dec 2013


This document has been reviewed for OPSEC material, and none was found. 17 Dec 2013

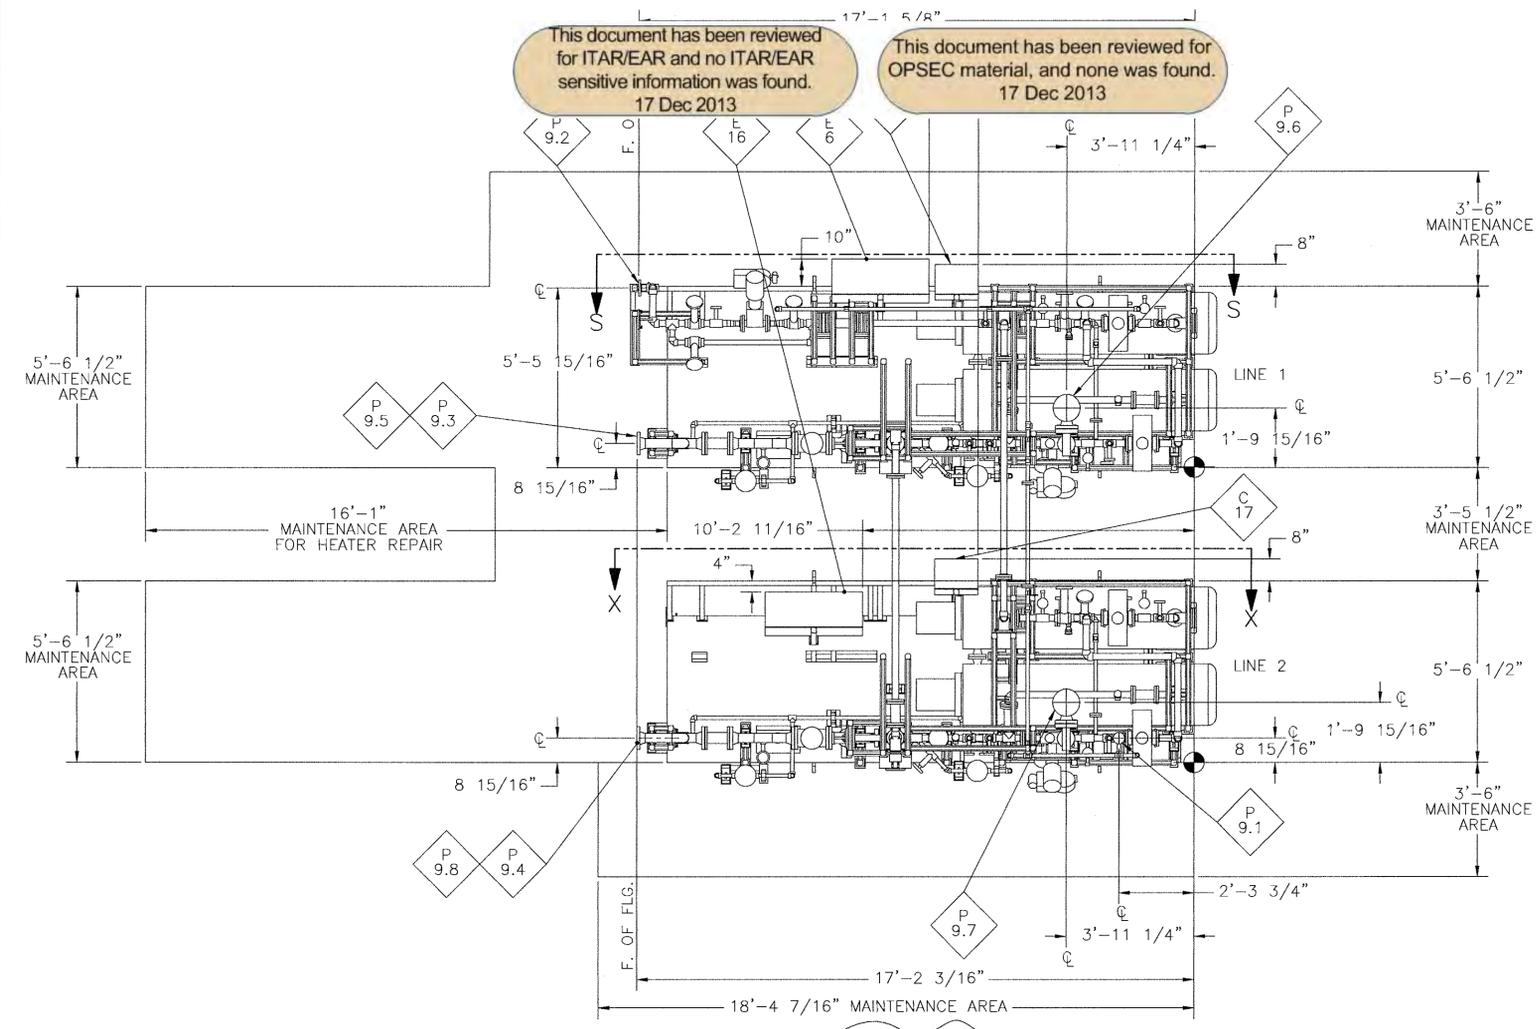


TOP VIEW

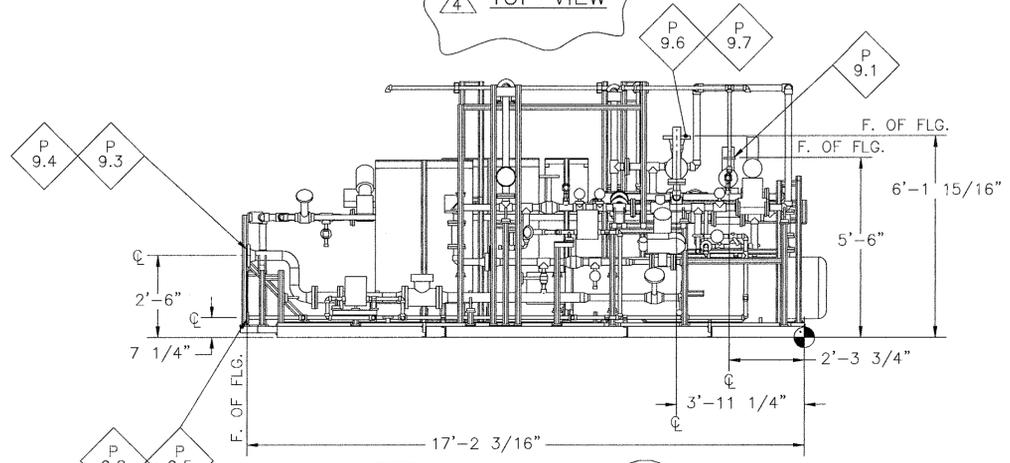


FRONT VIEW
STEAM SUPERHEATER SKID ASSY
LOCATED IN RM 07-148

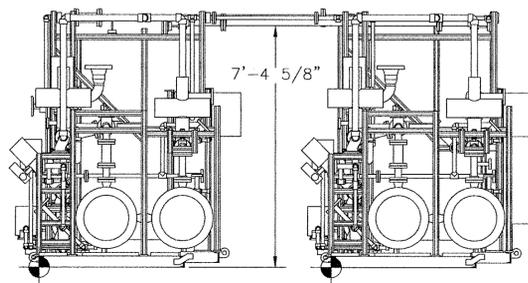

SIDE VIEW

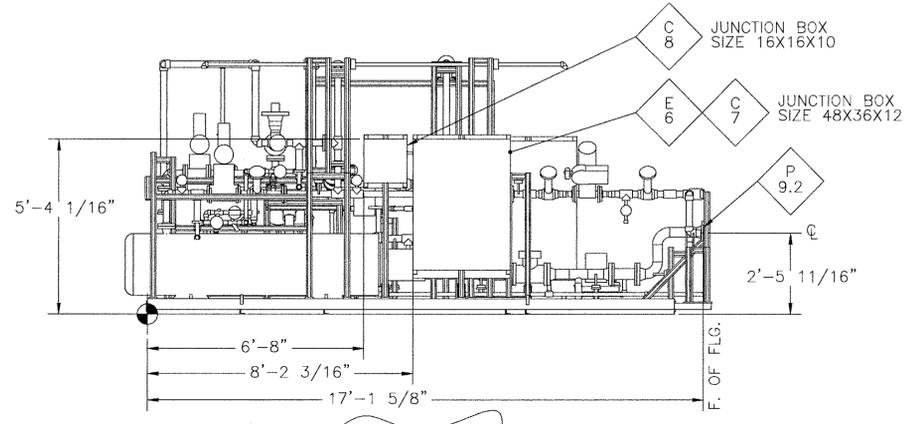

SECTION S-S
LINE 1

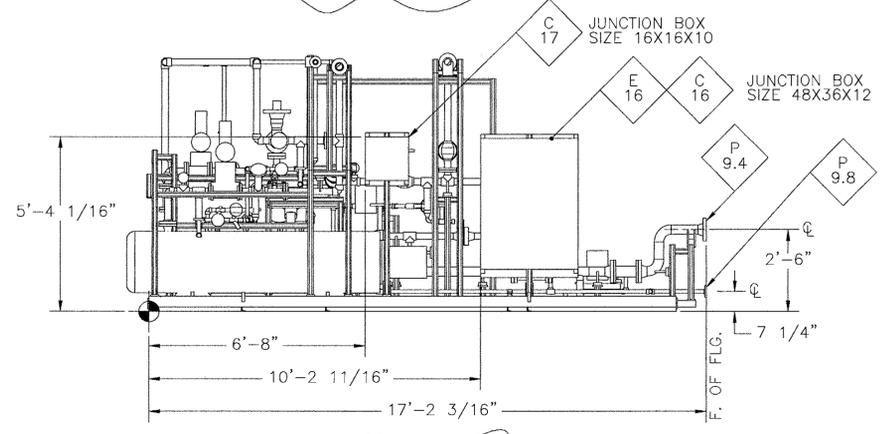

SECTION X-X
LINE 2


NO.	DATE	DESCRIPTION	DR	CK	DL	PE	APVD	
△	6/29/10	IFC (SEE NOTE 14)						
△	4/17/08	IFD (ECR NO. BGCAPP-MPT-135)	JPM	JXB	TF	WAR	TC	
△	2/19/07	ISSUED FOR DESIGN	SIGNATURES ON FILE					
△	10/31/06	ISSUED FOR DESIGN	SIGNATURES ON FILE					
△	8/25/06	ISSUED FOR DESIGN	SIGNATURES ON FILE					

[X] Q		[X] NON-Q	
BECHTEL PARSONS BLUE GRASS <small>A Joint Venture of Bechtel National, Inc. and Parsons Infrastructure & Technology Group Inc.</small>	DOD PROGRAM MANAGER FOR ASSEMBLED CHEMICAL WEAPONS ASSESSMENT EDGEWOOD, MARYLAND	US ARMY ENGINEERING AND SUPPORT CENTER, HUNTSVILLE HUNTSVILLE, ALABAMA	

BLUE GRASS CHEMICAL AGENT DESTRUCTION PILOT PLANT PROJECT (BGCAPP)
RICHMOND, KENTUCKY

CONTRACT NO. DAAA09-03-D-0023

PARSONS PASCO FABRICATION SHOP
METAL PARTS TREATER
INTERFACE CONNECTION DRAWING

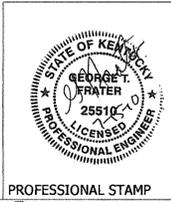

DRAWING NUMBER	SHEET	REV
24915-07-B2-MPT-00001	12 OF 20	4

COLUMN NO.	AXIAL FORCE (KIPS)			SHEAR FORCE (KIPS)		MOMENT (KIP-FT)		AXIAL MOMENT (KIP-FT)		COLUMN FOOTING ELEV.				
	DEAD LOAD	LIVE LOAD	VERTICAL SEISMIC LOAD	N	S	N	S	N	S					
1	-5.326	-5.430	-0.213	-0.437	0.437	-	-	-	-	910'-0"				
2	-6.452	-4.990	-0.258	-0.578	0.578	-	-	-	-	909'-5"				
3	-5.552	-4.678	-0.222	-0.209	0.209	6.137	-6.137	0.216	2.974	-0.020	-0.081	-0.010	0.036	909'-5"
4	-2.901	-2.750	-0.116	-0.030	0.030	0.010	-0.010	0.113	0.043	0.001	-0.274	-0.057	0.003	910'-0"
5	-13.642	-14.105	-0.546	0.555	-0.555	0.186	-0.186	0.189	0.180	-0.048	0.038	-0.006	0.011	909'-5"
6	-7.876	-7.760	-0.315	-0.037	0.037	0.219	-0.219	0.213	0.180	-0.043	-0.082	-0.006	0.003	909'-5"
7	-2.969	-2.799	-0.119	0.028	-0.028	0.023	-0.023	0.113	0.049	-0.002	-0.274	-0.057	0.005	910'-0"
8	-9.821	-11.515	-0.393	0.143	-0.143	-0.539	0.539	0.096	0.075	0.009	0.116	0.000	0.000	909'-8"
9	-13.923	-16.789	-0.557	-0.696	0.696	0.105	-0.105	0.437	0.092	0.011	0.043	0.014	0.000	909'-8"
10	-7.583	-6.164	-0.303	-3.538	3.538	0.322	-0.322	1.650	0.098	0.010	-0.361	-0.014	0.000	909'-8"
11	-16.788	-17.740	-0.672	0.509	-0.509	0.252	-0.252	0.436	0.091	0.010	0.043	-0.004	0.000	909'-8"
12	-4.411	-4.950	-0.176	3.682	-3.682	-0.094	0.094	1.654	0.085	0.014	-0.406	0.029	0.001	909'-8"
13	-8.540	-9.676	-0.342	-6.293	6.293	-3.597	3.597	1.436	0.167	-0.114	0.402	0.145	0.009	909'-8"
14	-12.458	-12.152	-0.498	-4.446	4.446	-0.067	0.067	1.087	2.267	-0.091	-0.021	-0.012	0.155	909'-8"
15	-5.700	-5.420	-0.228	-4.957	4.957	3.147	-3.147	1.118	2.048	-0.106	-0.227	-0.011	0.015	909'-5"
16	-0.097	0.364	-0.004	5.799	-5.799	0.223	-0.223	1.651	0.065	0.045	0.454	0.096	0.013	910'-0"
17	-2.661	-4.282	-0.106	0.987	-0.987	-1.302	1.302	0.509	0.326	0.155	0.515	0.042	0.010	910'-0"
18	-5.491	-5.210	-0.220	4.097	-4.097	0.675	-0.675	1.102	0.199	0.130	0.199	-0.014	-0.088	909'-8"
19	-3.040	-2.608	-0.122	4.756	-4.756	-0.136	0.136	1.201	0.050	0.040	-0.213	0.028	-0.004	909'-8"
20	-0.928	-2.172	-0.037	0.225	-0.225	-0.076	0.076	0.188	0.024	0.346	0.242	0.051	0.025	910'-0"
21	-3.468	-1.513	-0.139	0.215	-0.215	-0.105	0.105	0.109	0.049	0.064	0.021	-0.034	0.002	909'-8"
22	-2.700	-1.506	-0.108	0.122	-0.122	0.105	-0.105	0.106	0.049	0.064	-0.039	-0.003	-0.016	909'-8"
23	-0.092	-0.316	-0.004	0.104	-0.104	0.098	-0.098	0.027	-0.003	-0.014	-0.013	-0.010	-0.018	909'-3 11/16" SEE NOTE 2
24	-0.590	-2.820	-0.024	-0.112	0.112	-0.139	0.139	0.039	-0.006	-0.018	0.016	-0.009	-0.028	909'-3 11/16" SEE NOTE 2
25	-0.450	-2.305	-0.018	0.255	-0.255	1.506	-1.506	0.037	0.105	0.035	-0.011	-0.009	-0.028	909'-2 11/16" SEE NOTE 2
26	-0.225	-0.808	-0.009	-0.238	0.238	-1.454	1.454	0.029	0.076	0.027	0.013	-0.010	-0.018	909'-2 11/16" SEE NOTE 2



This document has been reviewed for ITAR/EAR and no ITAR/EAR sensitive information was found. 17 Dec 2013

This document has been reviewed for OPSEC material, and none was found. 17 Dec 2013

NOTES:

- NUMBER IN SYMBOL DENOTES COLUMN NUMBER. LETTER DENOTES BASEPLATE NAME.
- COLUMNS 23, 24, 25 AND 26 ARE FOR STAIR REST PLATFORM. GIVEN COLUMN FOOTING ELEVATIONS ARE FOR BOTTOM OF STEEL (BOS).

BASEPLATE DETAILS										
NAME	X	XA	XB	XC	Y	YA	YB	YC	THK	HSS
A										6X6X1/2
B	12"	2"	8"	6"	12"	2"	8"	6"	1/2"	4X4X1/2

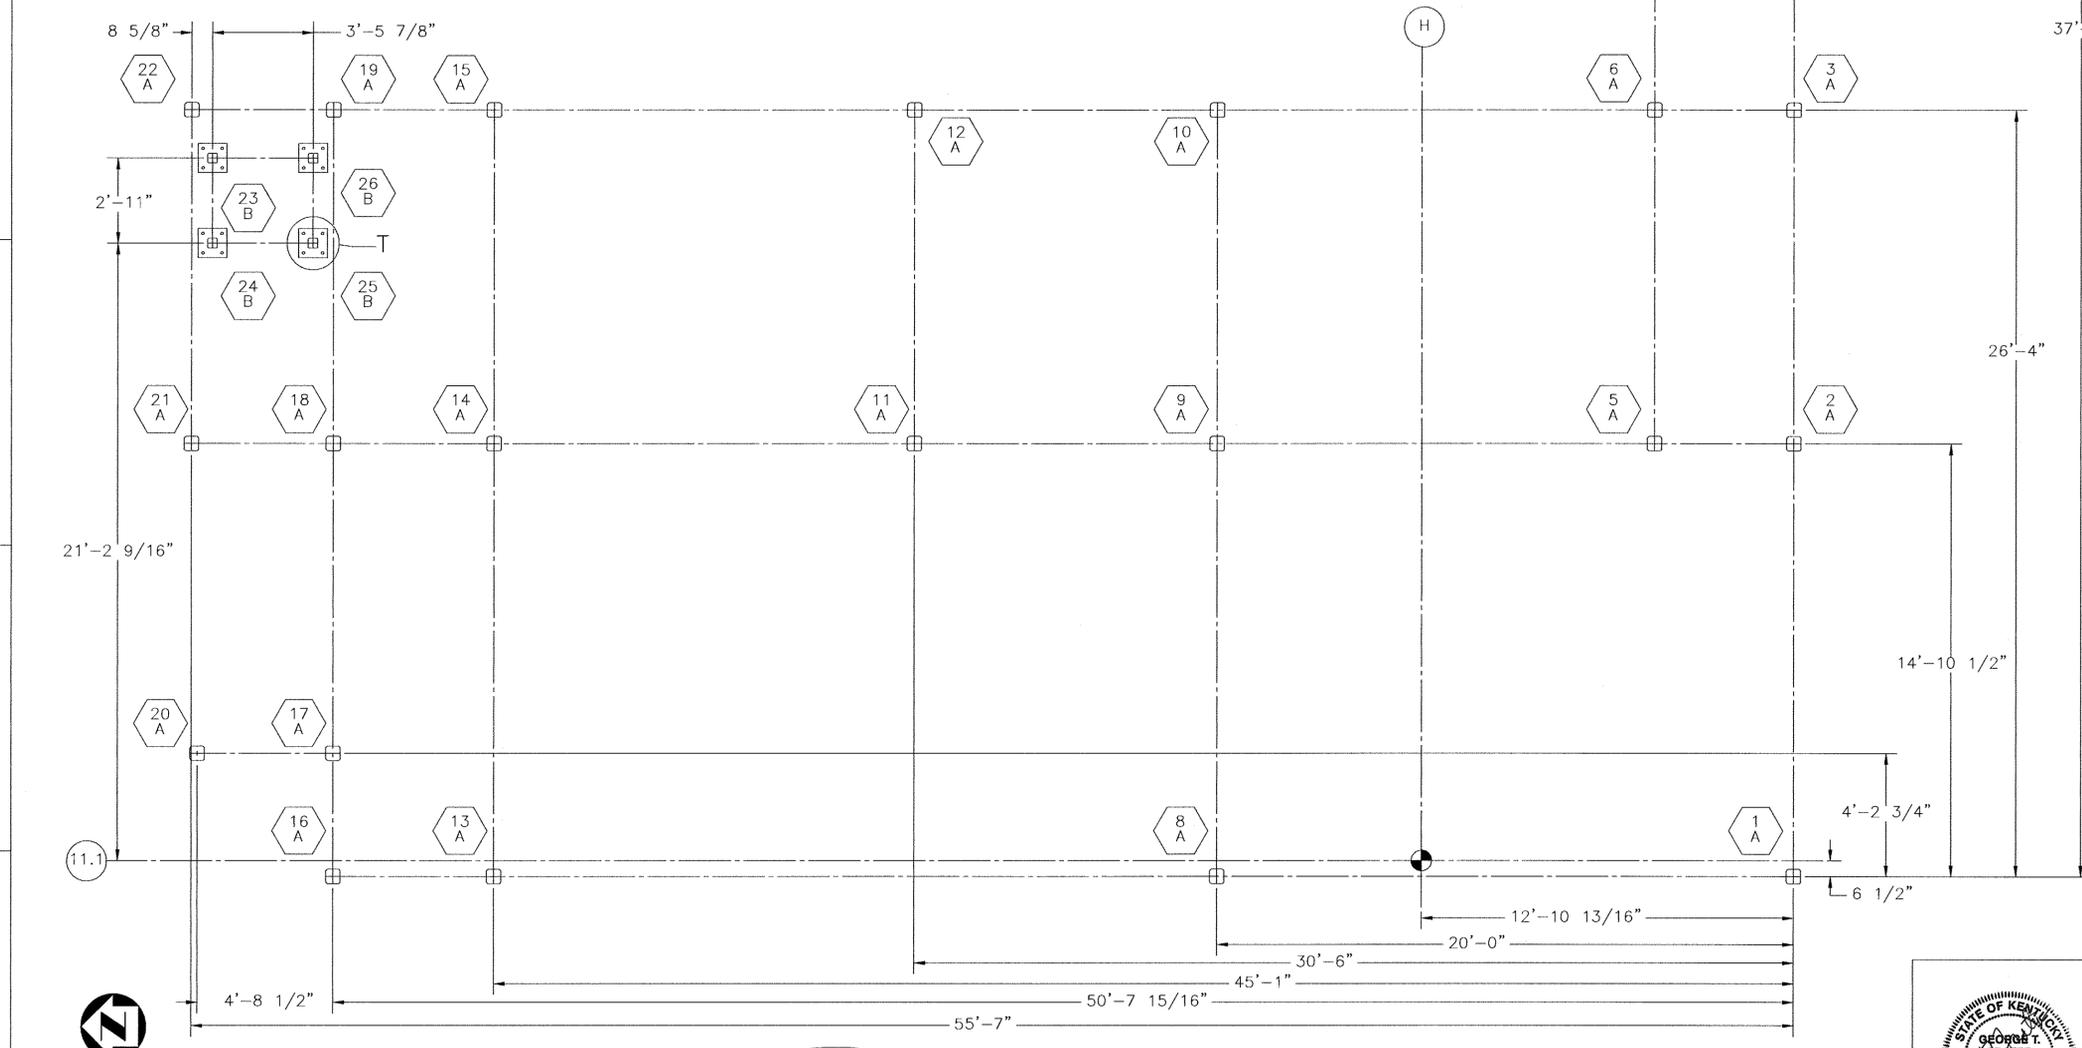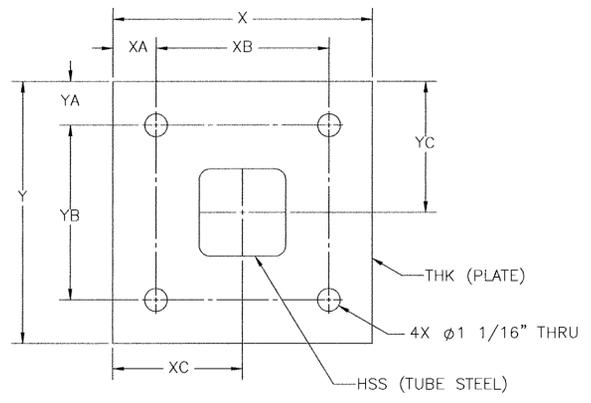

4' MPT MEZZANINE COLUMN LOCATIONS

NO.	DATE	DESCRIPTION	DR	CK	DL	PE	APVD	
△	6/29/10	IFC (SEE NOTE 14)						
△	4/17/08	IFD (ECR NO. BGCAPP-MPT-135)	JPM	JXB	TF	MAR	TC	
△	2/19/07	ISSUED FOR DESIGN	SIGNATURES ON FILE					
△	10/31/06	ISSUED FOR DESIGN	SIGNATURES ON FILE					
△	8/25/06	ISSUED FOR DESIGN	SIGNATURES ON FILE					

BECHTEL PARSONS BLUE GRASS
 A Joint Venture of Bechtel National, Inc. and Parsons Infrastructure & Technology Group Inc.

DOD PROGRAM MANAGER FOR ASSEMBLED CHEMICAL WEAPONS ASSESSMENT EDGEWOOD, MARYLAND


US ARMY ENGINEERING AND SUPPORT CENTER, HUNTSVILLE HUNTSVILLE, ALABAMA

BLUE GRASS CHEMICAL AGENT DESTRUCTION PILOT PLANT PROJECT (BGCAPP)
 RICHMOND, KENTUCKY

CONTRACT NO. DAAA09-03-D-0023

PARSONS PASCO FABRICATION SHOP METAL PARTS TREATER INTERFACE CONNECTION DRAWING

DRAWING NUMBER 24915-07-B2-MPT-00001	SHEET 13 OF 20	REV 4
---	-------------------	----------

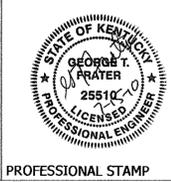

BGCAPP MPT EQUIPMENT LOADING


EQUIPMENT NAME	BASE PLATE NUMBER	DEAD WEIGHT (LBF)	SE	Notes
INLET AIRLOCK IN-GATE	1	10630		<p>This document has been reviewed for ITAR/EAR and no ITAR/EAR sensitive information was found. 17 Dec 2013</p> <p>This document has been reviewed for OPSEC material, and none was found. 17 Dec 2013</p>
	2	10630		
	INLET AIRLOCK	3	5766	
4		5766	321	
5		5766	321	
6		5766	321	
MAIN CHAMBER & IN-GATE	7	18858	792	
	8	18858	792	
MAIN CHAMBER & OUT-GATE	9	18858	792	
	10	18858	792	
OUTLET AIRLOCK	11	6100	335	
	12	6100	335	
	13	6100	335	
	14	6100	335	
OUTLET AIRLOCK-OUTGATE	15	10630	447	
	16	10630	447	
COOLING CHAMBER	17	3403	143	
	18	3403	143	
	19	3403	143	
	20	3403	143	
COOLING CHAMBER OUT-GATE	21	1818	62	
	22	1818	62	
COIL CART RAILS (PER WHEEL)	-	630	<630	

BASEPLATES 3 THRU 6 ARE LOCATED ON RAILS TO ALLOW FOR APPROX. 1" OF CHAMBER EXPANSION


BASEPLATES 9 THRU 14 ARE LOCATED ON RAILS TO ALLOW FOR APPROX. 4" OF CHAMBER EXPANSION

BASEPLATE DETAILS

STYLE	THK	HSS	H	X	XA	XB	XC	Y	YA	YB	YC
A	1/2"	4X4X3/8	ø15/16"	10"	1 1/2"	7"	5"	10"	1 1/2"	7"	5"
B	1 1/2"	12X12X3/8	ø7/8"	1'-8"	2"	1'-4"	10"	1'-8"	2"	1'-4"	10"
C	1"	8X8X3/8	ø13/16"	1'-1"	1 1/2"	10"	6 1/2"	1'-1"	1 1/2"	10"	6 1/2"

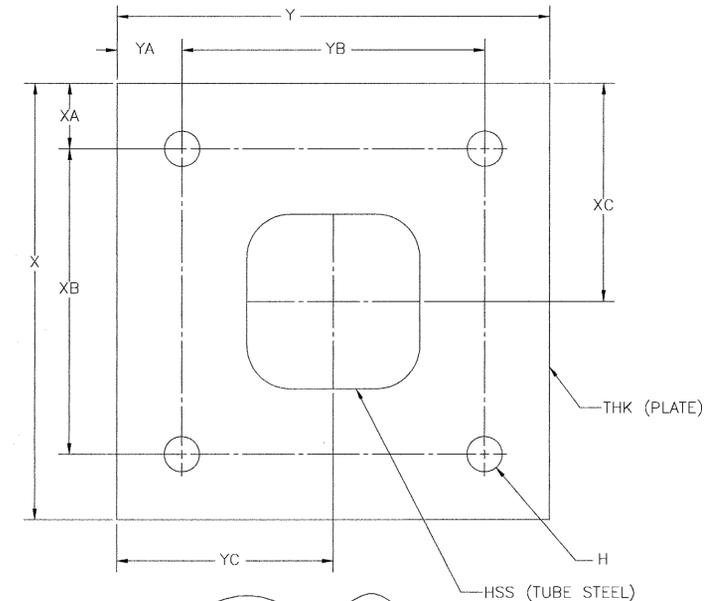

DETAIL U
BASEPLATE DETAIL

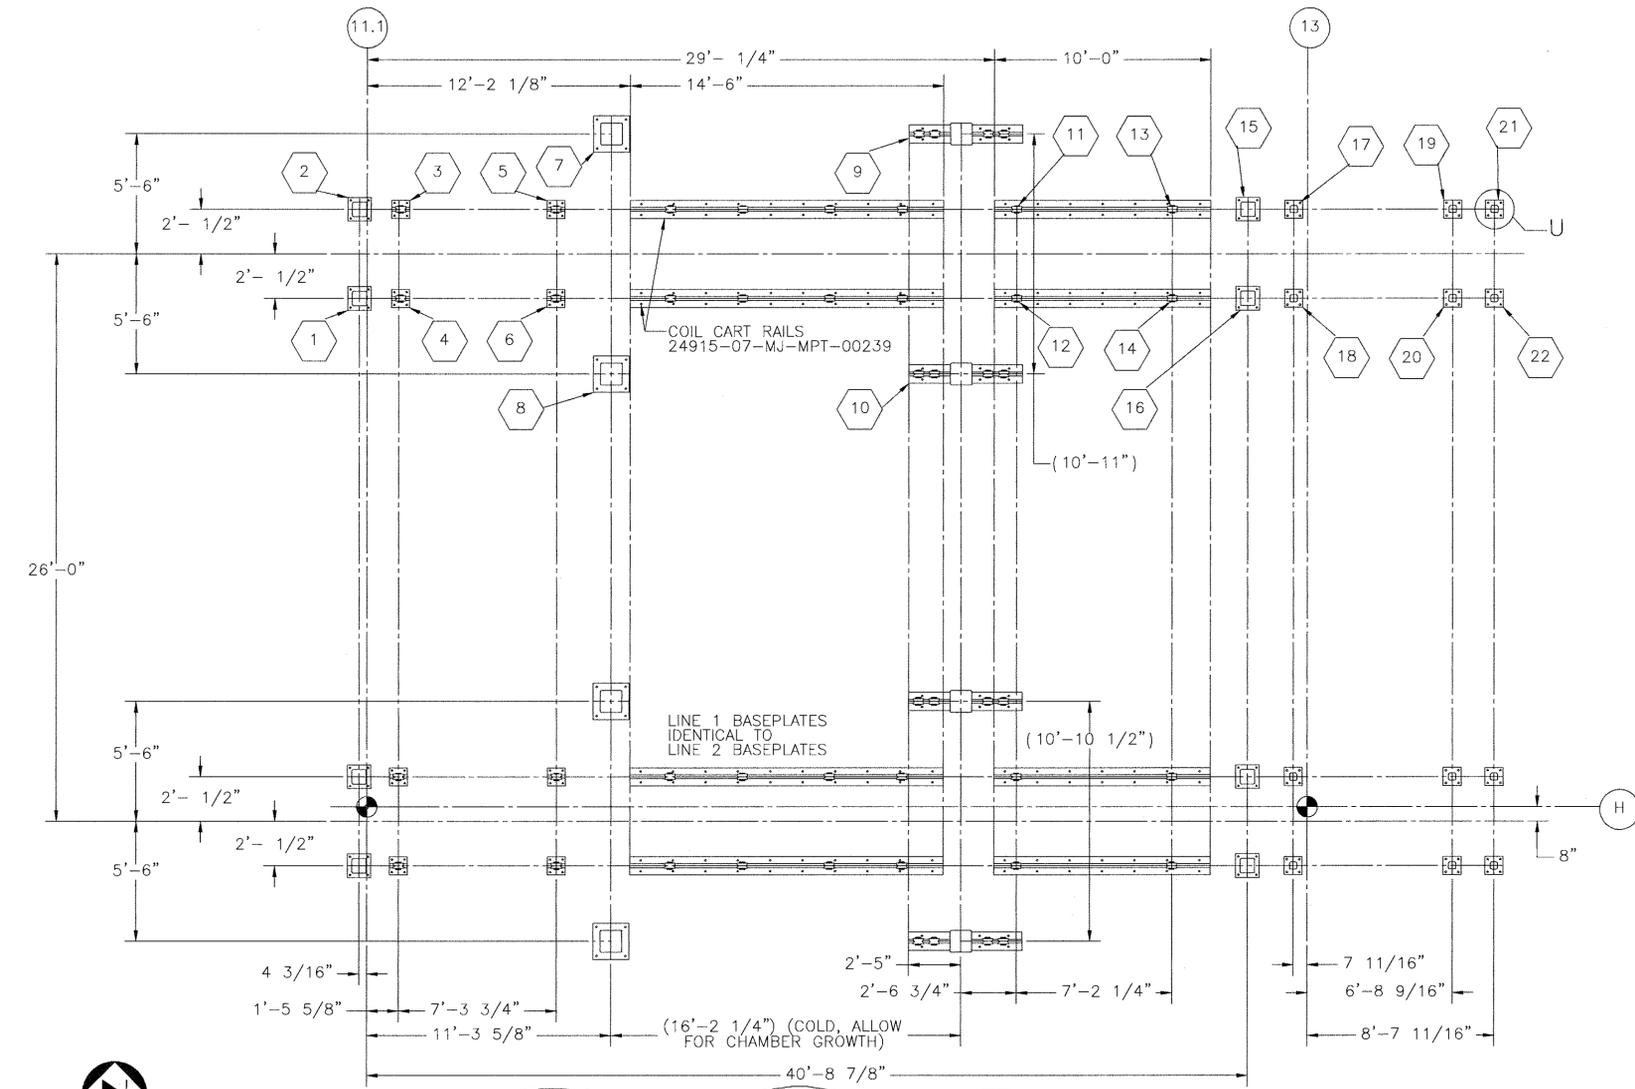

MPT EQUIPMENT FOOTING LOCATIONS
BASEPLATE DETAIL
BASEPLATES 1-16 BOS ELEV = 909'-9"
BASEPLATES 17-22 BOS ELEV = 910'-1"
ALLOWING FOR 1" OF GROUT UPON INSTALLATION

NO.	DATE	DESCRIPTION	DR	CK	DL	PE	APVD
△	6/29/10	IFC (SEE NOTE 14)					
△	4/17/08	IFD (ECR NO. BGCAPP-MPT-135)	JPM	JXB	TF	MAR	TC
△	2/19/07	ISSUED FOR DESIGN	SIGNATURES ON FILE				
△	10/31/06	ISSUED FOR DESIGN	SIGNATURES ON FILE				
△	8/25/06	ISSUED FOR DESIGN	SIGNATURES ON FILE				

Q NON-Q

BECHTEL PARSONS BLUE GRASS <small>A Joint Venture of Bechtel National, Inc. and Parsons Infrastructure & Technology Group Inc.</small>	DOD PROGRAM MANAGER FOR ASSEMBLED CHEMICAL WEAPONS ASSESSMENT EDGEWOOD, MARYLAND	US ARMY ENGINEERING AND SUPPORT CENTER, HUNTSVILLE HUNTSVILLE, ALABAMA
---	---	---

**BLUE GRASS CHEMICAL AGENT DESTRUCTION
PILOT PLANT PROJECT (BGCAPP)
RICHMOND, KENTUCKY**

CONTRACT NO. DAAA09-03-D-0023

**PARSONS PASCO FABRICATION SHOP
METAL PARTS TREATER
INTERFACE CONNECTION DRAWING**

DRAWING NUMBER: 24915-07-B2-MPT-00001 SHEET: 14 OF 20 REV: 4



INTERFACE CONTROL DOCUMENT - MPT PIPING INTERFACE DATA (100% submittal)

MDB ROOM LOCATION: rm. # 07-146, top of floor elev. 910'-0"
SHIPPING WEIGHT:

This document has been reviewed for ITAR/EAR and no ITAR/EAR sensitive information was found. 17 Dec 2013

This document has been reviewed for OPSEC material, and none was found. 17 Dec 2013

TO ROOM: (BTUHR):

Main data table with columns: IP, Int-Ext, Description, ICD DR#, Line In/Connection, Piping Line No Note 4, Flow (Normal, Maximum, I/C), Pressure (PSIG) Oper, Design, Temperature (F) Oper, Design, Ref. Includes rows P1-P21 and P3-P7.

* In-Internal, Ex-External, EST-ESTIMATED, TBD=TO BE DETERMINED, NA=NOT APPLICABLE I/C=INTERMITTENT/CONTINUOUS
NOTE 1. Plant Air to ME-MPT-0101 and -0201 are used for secondary waste operation. Air flow rate will be defined at job site by the operating team.
2. Process data of Demin Water Supply to MPT shall be finalized by Process & Mechanical process group in Richmond, KY.
3. ICD point of the Demin water to/from MPT inline filters will be designed by BGCAPP piping group.
4. Piping Line no. and Material Class: () indicates piping interface data at outlet side of pressure relief valve.
5. Compression Fitting.

Revision table with columns: NO., DATE, DESCRIPTION, DR, CK, DL, PE, APVD. Includes entries for 6/29/10, 4/17/08, 2/19/07, 10/31/06, and 8/25/06.

Project information block including BECHTEL PARSONS logo, DOD PROGRAM MANAGER FOR ASSEMBLED CHEMICAL WEAPONS ASSESSMENT EDGEWOOD, MARYLAND, and US ARMY ENGINEERING AND SUPPORT CENTER, HUNTSVILLE, ALABAMA.

BLUE GRASS CHEMICAL AGENT DESTRUCTION PILOT PLANT PROJECT (BGCAPP) RICHMOND, KENTUCKY

CONTRACT NO. DAAA09-03-D-0023

PARSONS PASCO FABRICATION SHOP METAL PARTS TREATER INTERFACE CONNECTION DRAWING

DRAWING NUMBER 24915-07-B2-MPT-00001 SHEET 15 OF 20 REV 4



PROFESSIONAL STAMP

INTERFACE CONTROL DOCUMENT - MPT ELECTRICAL INTERFACE DATA (100% submittal)

MDB ROOM LOCATION: rm. # 07-146, top of floor elev. 910'-0"

This document has been reviewed for ITAR/EAR and no ITAR/EAR sensitive information was found. 17 Dec 2013

This document has been reviewed for OPSEC material, and none was found. 17 Dec 2013

IP	Int = I Ext = E	DESCRIP				
E1 MPT Line 1 Power FJB-Inlet, 07-MX-MPT-TBP-0101B						
E1.1	E	Motor & Brake Power from Servo Control Panel	480	3	60	
E1.2	E	Motor Power from MCC VFD	480	3	60	3
E2 MPT Line 1 Feedback FJB-Inlet, 07-MX-MPT-TBF-0101B						
E2.1	E	Motor Feedback from Servo Control Panel	24VDC			
E3 MPT Line 1 Power FJB-Outlet, 07-MX-MPT-TBP-0101C						
E3.1	E	Motor & Brake Power from Servo Control Panel	480	3	60	
E3.2	E	Motor Power from MCC VFD	480	3	60	3
E4 MPT Line 1 Feedback FJB-Outlet, 07-MX-MPT-TBF-0101C						
E4.1	E	Motor Feedback from Servo Control Panel	24VDC			
E5 MPT Line 1 Cooling Chamber Power FJB, 07-MX-MCS-TBP-0101						
E5.1	E	Motor Power From MCC VFD	480	3	60	3
E6 Steam Super Htr Control Panel Line-1, 07-ME-MPT-CP0105						
E6.1	E	Power Feed	480	3	60	(100)
E7 MPT Line 1 Servo Drive Control Panel ME-MPT-CP0109 (Installed in room 07-148)						
E7.1	E	480 VAC Power Feed	480	3	60	200A
E7.2	E	120V UPS Power Feed	120	1	60	15A
E7.3	E	Motor & Brake Power to MPT Line 1 Power FJB-Inlet	480	3	60	
E7.4	E	Motor & Brake Power to MPT Line 1 Power FJB-Outlet	480	3	60	
E7.5	E	Feedback to Line 1 Feedback FJB-Inlet	24VDC			
E7.6	E	Feedback to Line 1 Feedback FJB-Outlet	24VDC			
E8 MPT Line 1 Heater Power Supply Zone 1						
E8.1	E	Power Feed from Facility to line Filter Cabinet ME-MPT-CP0107 (Installed in room 07-150)	480	3	60	540 KVA
E8.2	E	Power Feed From line Filter Cabinet to Power Supply, ME-MPT-CP0101	480	3	60	540 KVA
E9 MPT Line 1 Heater Power Supply Zone 2						
E9.1	E	Power Feed from Facility to line Filter Cabinet ME-MPT-CP0108 (Installed in room 07-150)	480	3	60	540 KVA
E9.2	E	Power Feed From line Filter Cabinet to Power Supply, ME-MPT-CP0103	480	3	60	540 KVA
E10 MPT Line 1 Cooling Chamber Out-gate Power						
E10.1	E	Motor Power From Servo Control Panel	120	1	60	

* I= Internal, E= External, EST=ESTIMATED, TBD=TO BE DETERMINED, NA=NOT APPLICABLE I/C*=INTERMITTENT/CONTINUOUS

IP	Int = I Ext = E	SERVICE	VOLTS	PH	HZ	KVA OR (KW)
E11 MPT Line 2 Power FJB-Inlet, 07-MX-MPT-TBP-0201B						
E11.1	E	Motor & Brake Power from Servo Control Panel	480	3	60	
E11.2	E	Motor Power from MCC VFD	480	3	60	3
E12 MPT Line 2 Feedback FJB-Inlet, 07-MX-MPT-TBF-0201B						
E12.1	E	Motor Feedback from Servo Control Panel	24VDC			
E13 MPT Line 2 Power FJB-Outlet, 07-MX-MPT-TBP-0201C						
E13.1	E	Motor & Brake Power from Servo Control Panel	480	3	60	
E13.2	E	Motor Power from MCC VFD	480	3	60	3
E14 MPT Line 2 Feedback FJB-Outlet, 07-MX-MPT-TBF-0201C						
E14.1	E	Motor Feedback from Servo Control Panel	24VDC			
E15 MPT Line 2 Cooling Chamber Power FJB, 07-MX-MCS-TBP-0201						
E15.1	E	Motor Power From MCC VFD	480	3	60	3
E16 Steam Super Htr Control Panel Line-2, 07-ME-MPT-CP0205						
E16.1	E	Power Feed	480	3	60	(100)
E17 MPT Line 2 Servo Drives Control Panel ME-MPT-CP0209 (Installed in room 07-148)						
E17.1	E	480 VAC Power Feed	480	3	60	200A
E17.2	E	120V UPS Power Feed	120	1	60	15A
E17.3	E	Motor & Brake Power to MPT Line 2 Power FJB-Inlet	480	3	60	
E17.4	E	Motor & Brake Power to MPT Line 2 Power FJB-Outlet	480	3	60	
E17.5	E	Feedback to Line 1 Feedback FJB-Inlet	24VDC			
E17.6	E	Feedback to Line 1 Feedback FJB-Outlet	24VDC			
E18 MPT Line 2 Heater Power Supply Zone 1						
E18.1	E	Power Feed from Facility to line Filter Cabinet ME-MPT-CP0207 (Installed in room 07-150)	480	3	60	540 KVA
E18.2	E	Power Feed From line Filter Cabinet to Power Supply, ME-MPT-CP0201	480	3	60	540 KVA
E19 MPT Line 2 Heater Power Supply Zone 2						
E19.1	E	Power Feed from Facility to line Filter Cabinet ME-MPT-CP0208 (Installed in room 07-150)	480	3	60	540 KVA
E19.2	E	Power Feed From line Filter Cabinet to Power Supply, ME-MPT-CP0203	480	3	60	540 KVA
E20 MPT Line 2 Cooling Chamber Out-gate Power						
E20.1	E	Motor Power From Servo Control Panel	120	1	60	

4

NO.	DATE	DESCRIPTION	DR	CK	DL	PE	APVD
6/29/10	IFC (SEE NOTE 14)						
4/17/08	IFD (ECR NO. BGCAPP-MPT-135)		JPM	JXB	TF	MART	TC
2/19/07	ISSUED FOR DESIGN		SIGNATURES ON FILE				
10/31/06	ISSUED FOR DESIGN		SIGNATURES ON FILE				
8/25/06	ISSUED FOR DESIGN		SIGNATURES ON FILE				

Q NON-Q

BECHTEL PARSONS
BLUE GRASS

DOD PROGRAM MANAGER FOR ASSEMBLED CHEMICAL WEAPONS ASSESSMENT EDGEWOOD, MARYLAND

US ARMY ENGINEERING AND SUPPORT CENTER, HUNTSVILLE HUNTSVILLE, ALABAMA

BLUE GRASS CHEMICAL AGENT DESTRUCTION PILOT PLANT PROJECT (BGCAPP)
RICHMOND, KENTUCKY

CONTRACT NO. DAAA09-03-D-0023



PARSONS PASCO FABRICATION SHOP
METAL PARTS TREATER
INTERFACE CONNECTION DRAWING

DRAWING NUMBER: 24915-07-B2-MPT-00001

SHEET: 16 OF 20

REV: 4

INTERFACE CONTROL DOCUMENT - MPT CONTROL INTERFACE DATA (100% submittal)

MDB ROOM LOCATION: m. # 07-146, top of floor elev. 910'-0"

This document has been reviewed for ITAR/EAR and no ITAR/EAR sensitive information was found. 17 Dec 2013

This document has been reviewed for OPSEC material, and none was found. 17 Dec 2013

IP	Int = I Ext = E	DESCRIPTION	SERVICE	VOLTS	PH	HZ	KVA OR (KW)
C1 MPT Line-1 Inlet Airlock I&C FJB, 07-EJ-FCS-TBF-6111							
C2.4	E	Controls - To Servo Control Panel (E-Stop Circuit)		24 VDC			
C3 MPT Line-1 Main Chamber I&C FJB #2, 07-EJ-FCS-TBF-6116							
C3.1	E	Controls - To FCS (AI, DI, DO, TC)		24VDC			
C3.2	E	Controls - To Servo Control Panel (AI)		24 VDC			
C3.3	I	Controls - To Device Power Panel (Field Instrument Power, 24 VDC)		24 VDC			
C3.4	E	Controls - To Servo Control Panel (E-Stop Circuit)		24 VDC			
C4 MPT Line-1 Outlet Airlock I&C FJB, 07-EJ-FCS-TBF-6113							
C4.1	E	Controls - To FCS (AI, AO, DI, DO, TC)		24VDC			
C4.2	E	Controls - To Servo Control Panel (AI)		24 VDC			
C4.3	I	Controls - To Device Power Panel (Field Instrument Power, 24 VDC)		24 VDC			
C4.4	I	Controls - To Device Power Panel (Field Instrument Power, 120VAC)		120VAC	1	60	
C4.5	E	Controls - To Servo Control Panel (E-Stop)		24 VDC			
C5 MPT Line-1 Mezzanine I&C FJB, 07-EJ-FCS-TBF-6115							
C5.1	E	Controls - To FCS (AI, AO, DI, DO, TC)		24VDC			
C5.2	E	Controls - To Device Power Panel (Field Instrument Power, 24 VDC)		24 VDC			
C6 MPT Line-1 Cooling Chamber I&C FJB, 07-EJ-FCS-TBF-6114							
C6.1	E	Controls - To FCS (AI, DI, DO)		24 VDC			
C6.2	I	Controls - To Device Power Panel (Field Instrument Power, 24 VDC)		24 VDC			
C6.3	E	Controls - To Servo Control Panel (E-Stop Circuit)		24 VDC			
C7 Steam Super Htr Control Panel Line-1, 07-ME-MPT-CP0105							
C7.1	E	Controls - To FCS (AO, DI, DO)		24VDC			
C8 Steam Superheater Line 1 I&C FJB, 07-EJ-FCS-TBF-6117							
C8.1	E	Controls - To FCS (AI, AO, DI, DO)		24VDC			
C9 MPT Servo Drives Control Panel Line 1 ME-MPT-CP0109 (Installed in room 07-148)							
C9.1	E	Controls - To Inlet Airlock I&C FJB (AI)		24VDC			
C9.2	E	Controls - To Inlet Airlock I&C FJB (Instrument Power, 24 VDC)		24VDC			
C9.3	E	Controls - To Inlet Airlock I&C FJB (Instrument Power, 120 VAC)		120VAC	1	60	
C9.4	E	Controls - To Inlet Airlock I&C FJB (E-Stop Circuit)		24VDC			
C9.5	E	Controls - To Main Chamber I&C FJB # 1 (AI)		24VDC			
C9.6	E	Controls - To Main Chamber I&C FJB # 1 (Instrument Power, 24 VDC)		24VDC			
C9.7	E	Controls - To Main Chamber I&C FJB # 1 (E-Stop Circuit)		24VDC			
C9.8	E	Controls - To Main Chamber I&C FJB # 2 (AI)		24VDC			
C9.9	E	Controls - To Main Chamber I&C FJB # 2 (Instrument Power, 24 VDC)		24VDC			
C9.10	E	Controls - To Main Chamber I&C FJB # 2 (E-Stop Circuit)		24VDC			
C9.11	E	Controls - To Outlet Airlock I&C FJB (AI)		24VDC			
C9.12	E	Controls - To Outlet Airlock I&C FJB (Instrument Power, 24 VDC)		24VDC			
C9.13	E	Controls - To Outlet Airlock I&C FJB (Instrument Power, 120 VAC)		120VAC	1	60	
C9.14	E	Controls - To Outlet Airlock I&C FJB (E-Stop Circuit)		24VDC			
C9.15	E	Controls - To Mezzanine I&C FJB (Instrument Power, 24 VDC)		24VDC			
C9.16	E	Controls - To Cooling Chamber I&C FJB # 1 (Instrument Power, 24 VDC)		24VDC			
C9.17	E	Controls - To Cooling Chamber I&C FJB # 1 (E-Stop Circuit)		24VDC			
C9.18	E	Controls - To FCS		24VDC			
C19 MPT Htr Zone 1, Control Panel Line-1, 07-ME-MPT-CP0101							
C19.1	E	Controls - To FCS (AI, AO, DI, DO)		24VDC			
C20 MPT Htr Zone 2 Control Panel Line-1, 07-ME-MPT-CP0103							
C20.1	E	Controls - To FCS (AI, AO, DI, DO)		24VDC			
C23 MPT Line Filter Instrumentation Line 1 - Zone 1 ME-MPT-CP0107 (Installed in room 07-150)							
C23.1	E	Controls - To FCS (AI, TC)		24VDC			
C24 MPT Line Filter Instrumentation Line 1 - Zone 2 ME-MPT-CP0108 (Installed in room 07-150)							
C24.1	E	Controls - To FCS (AI, TC)		24VDC			
C27 MPT Line 1 Instrument Power Panel 07-EJ-MPT-TBC-6100							
C27.1	E	Power		120VAC	1	60	
C27.2	E	Controls - To Inlet Airlock I&C FJB (24VDC) (C1.3)		24VDC			
C27.3	E	Controls - To Inlet Airlock I&C FJB (120VAC) (C1.4)		120VAC	1	60	
C27.4	E	Controls - To Main Chamber I&C FJB #1 (24VDC) (C2.3)		24VDC			
C27.5	E	Controls - To Main Chamber I&C FJB #2 (24VDC) (C3.3)		24VDC			
C27.6	E	Controls - To Outlet Airlock I&C FJB (24VDC) (C4.3)		24VDC			
C27.7	E	Controls - To Outlet Airlock I&C FJB (120VAC) (C4.4)		120VAC	1	60	
C27.8	E	Controls - To Mezzanine I&C FJB (24VDC) (C5.2)		24VDC			
C27.9	E	Controls - To Cooling Chamber I&C FJB (24VDC) (C6.2)		24VDC			
C27.10	E	Controls - To In-Gate I&C FJB (24VDC) (C28.2) in MWS room 07-135		24VDC			
C28 MPT Line 1 Inlet In-Gate FJB 07-EJ-FCS-TBC-6118 (Installed in MWS room 07-135)							
C28.1	E	Controls - To FCS (DI)		24VDC			
C28.2	I	Instrument Power Controls - To Servo Panel (AI)		24VDC			
C28.3	I	E-Stop to the Servo Drive Control Panel ME-MPT-CP0109 (Installed in room 07-148)		24VDC			
C10 Inlet Airlock I&C FJB, 07-EJ-FCS-TBF-6121							
C10.2	E	Controls - To Servo Control Panel (AI)		24 VDC			
C10.3	I	Controls - To Device Power Panel (Field Instrument Power, 24 VDC)		24 VDC			
C10.4	I	Controls - To Device Power Panel (Field Instrument Power, 120VAC)		120VAC	1	60	
C10.5	E	Controls - To Servo Control Panel (E-Stop)		24 VDC			
C11 MPT Line-2 Main Chamber I&C FJB #1, 07-EJ-FCS-TBF-6122							
C11.1	E	Controls - To FCS (AI, DI, DO, TC)		24VDC			
C11.2	E	Controls - To Servo Control Panel (AI)		24 VDC			
C11.3	I	Controls - To Device Power Panel (Field Instrument Power, 24 VDC)		24 VDC			
C11.4	E	Controls - To Servo Control Panel (E-Stop Circuit)		24 VDC			
C12 MPT Line-2 Main Chamber I&C FJB #2, 07-EJ-FCS-TBF-6126							
C12.1	E	Controls - To FCS (AI, DI, DO, TC)		24VDC			
C12.2	E	Controls - To Servo Control Panel (AI)		24 VDC			
C12.3	I	Controls - To Device Power Panel (Field Instrument Power, 24 VDC)		24 VDC			
C12.4	E	Controls - To Servo Control Panel (E-Stop Circuit)		24 VDC			
C13 MPT Line-2 Outlet Airlock I&C FJB, 07-EJ-FCS-TBF-6123							
C13.1	E	Controls - To FCS (AI, AO, DI, DO, TC)		24VDC			
C13.2	E	Controls - To Servo Control Panel (AI)		24 VDC			
C13.3	I	Controls - To Device Power Panel (Field Instrument Power, 24 VDC)		24 VDC			
C13.4	I	Controls - To Device Power Panel (Field Instrument Power, 120VAC)		120VAC	1	60	
C13.5	E	Controls - To Servo Control Panel (E-Stop)		24 VDC			
C14 MPT Line-2 Mezzanine I&C FJB, 07-EJ-FCS-TBF-6125							
C14.1	E	Controls - To FCS (AI, AO, DI, DO, TC)		24VDC			
C14.3	E	Controls - To Device Power Panel (Field Instrument Power, 24 VDC)		24 VDC			
C15 MPT Line-2 Cooling Chamber I&C FJB, 07-EJ-FCS-TBF-6124							
C15.1	E	Controls - To FCS (AI, DI, DO)		24 VDC			
C15.2	I	Controls - To Device Power Panel (Field Instrument Power, 24 VDC)		24 VDC			
C15.3	E	Controls - To Servo Control Panel (E-Stop Circuit)		24 VDC			
C16 Steam Super Htr Control Panel Line-2, 07-ME-MPT-CP0205							
C16.1	E	Controls - To FCS (AO, DI, DO)		24VDC			
C17 Steam Superheater Line 2 I&C FJB, 07-EJ-FCS-TBF-6127							
C17.1	E	Controls - To FCS (AI, AO, DI, DO)		24VDC			
C18 MPT Servo Drives Control Panel Line 2 ME-MPT-CP0209 (Installed in room 07-148)							
C18.1	E	Controls - To Inlet Airlock I&C FJB (AI)		24VDC			
C18.2	E	Controls - To Inlet Airlock I&C FJB (Instrument Power, 24 VDC)		24VDC			
C18.3	E	Controls - To Inlet Airlock I&C FJB (Instrument Power, 120 VAC)		120VAC	1	60	
C18.4	E	Controls - To Inlet Airlock I&C FJB (E-Stop Circuit)		24VDC			
C18.5	E	Controls - To Main Chamber I&C FJB # 1 (AI)		24VDC			
C18.6	E	Controls - To Main Chamber I&C FJB # 1 (Instrument Power, 24 VDC)		24VDC			
C18.7	E	Controls - To Main Chamber I&C FJB # 1 (E-Stop Circuit)		24VDC			
C18.8	E	Controls - To Main Chamber I&C FJB # 2 (AI)		24VDC			
C18.9	E	Controls - To Main Chamber I&C FJB # 2 (Instrument Power, 24 VDC)		24VDC			
C18.10	E	Controls - To Main Chamber I&C FJB # 2 (E-Stop Circuit)		24VDC			
C18.11	E	Controls - To Outlet Airlock I&C FJB (AI)		24VDC			
C18.12	E	Controls - To Outlet Airlock I&C FJB (Instrument Power, 24 VDC)		24VDC			
C18.13	E	Controls - To Outlet Airlock I&C FJB (Instrument Power, 120 VAC)		120VAC	1	60	
C18.14	E	Controls - To Outlet Airlock I&C FJB (E-Stop Circuit)		24VDC			
C18.15	E	Controls - To Mezzanine I&C FJB (Instrument Power, 24 VDC)		24VDC			
C18.16	E	Controls - To Cooling Chamber I&C FJB # 1 (Instrument Power, 24 VDC)		24VDC			
C18.17	E	Controls - To Cooling Chamber I&C FJB # 1 (E-Stop Circuit)		24VDC			
C18.18	E	Controls - To FCS		24VDC			
C21 MPT Htr Zone 1, Control Panel Line-2, 07-ME-MPT-CP0201							
C21.1	E	Controls - To FCS (AI, AO, DI, DO)		24VDC			
C22 MPT Htr Zone 2 Control Panel Line-2, 07-ME-MPT-CP0203							
C22.1	E	Controls - To FCS (AI, AO, DI, DO)		24VDC			
C25 MPT Line Filter Instrumentation Line 2 - Zone 1 ME-MPT-CP0207 (Installed in room 07-150)							
C25.1	E	Controls - To FCS (AI, TC)		24VDC			
C26 MPT Line Filter Instrumentation Line 2 - Zone 2 ME-MPT-CP0208 (Installed in room 07-150)							
C26.1	E	Controls - To FCS (AI, TC)		24VDC			
C29 MPT Line 2 Instrument Power Panel 07-EJ-MPT-TBC-6101							
C29.1	E	Power		120VAC	1	60	
C29.2	E	Controls - To Inlet Airlock I&C FJB (24VDC) (C10.3)		24VDC			
C29.3	E	Controls - To Inlet Airlock I&C FJB (120VAC) (C10.4)		120VAC	1	60	
C29.4	E	Controls - To Main Chamber I&C FJB #1 (24VDC) (C11.3)		24VDC			
C29.5	E	Controls - To Main Chamber I&C FJB #2 (24VDC) (C12.3)		24VDC			
C29.6	E	Controls - To Outlet Airlock I&C FJB (24VDC) (C13.3)		24VDC			
C29.7	E	Controls - To Outlet Airlock I&C FJB (120VAC) (C13.4)		120VAC	1	60	
C29.8	E	Controls - To Mezzanine I&C FJB (24VDC) (C14.2)		24VDC			
C29.9	E	Controls - To Cooling Chamber I&C FJB (24VDC) (C15.2)		24VDC			
C27.10	E	Controls - To In-Gate I&C FJB (24VDC) (C30.2) in MWS room 07-135		24VDC			
C30 MPT Line 2 Inlet In-Gate FJB 07-EJ-FCS-TBC-6128 (Installed in MWS room 07-135)							
C30.1	E	Controls - To FCS (DI)		24VDC			
C30.2	E	Instrument Power Controls - Servo Panel (AI)		24VDC			
C30.3	E	E-Stop to the Servo Drive Control Panel ME-MPT-CP0209 (Installed in room 07-148)		24VDC			

I= Internal, E= External, EST=ESTIMATED, TBD=TO BE DETERMINED, NA=NOT APPLICABLE I/C=INTERMITTENT/CONTINUOUS

NO.	DATE	DESCRIPTION	DR	CK	DL	PE	APVD
	6/29/10	IFC (SEE NOTE 14)					
	4/17/08	IFD (ECR NO. BGCAPP-MPT-135)	JPM	JXB	TF	MAR	TC
	2/19/07	ISSUED FOR DESIGN	SIGNATURES ON FILE				
	10/31/06	ISSUED FOR DESIGN	SIGNATURES ON FILE				
	8/25/06	ISSUED FOR DESIGN	SIGNATURES ON FILE				

<input checked="" type="checkbox"/> Q	<input checked="" type="checkbox"/> NON-Q
BECHTEL PARSONS BLUE GRASS	DOD PROGRAM MANAGER FOR ASSEMBLED CHEMICAL WEAPONS ASSESSMENT EDGWOOD, MARYLAND
	US ARMY ENGINEERING AND SUPPORT CENTER, HUNTSVILLE HUNTSVILLE, ALABAMA

**BLUE GRASS CHEMICAL AGENT DESTRUCTION
PILOT PLANT PROJECT (BGCAPP)**
RICHMOND, KENTUCKY

CONTRACT NO. DAAA09-03-D-0023

**PARSONS PASCO FABRICATION SHOP
METAL PARTS TREATER
INTERFACE CONNECTION DRAWING**

DRAWING NUMBER: 24915-07-B2-MPT-00001
SHEET: 17 OF 20
REV: 4




PROFESSIONAL STAMP

MPT ICD Block Diagram

This document has been reviewed for ITAR/EAR and no ITAR/EAR sensitive information was found. 17 Dec 2013

This document has been reviewed for OPSEC material, and none was found. 17 Dec 2013

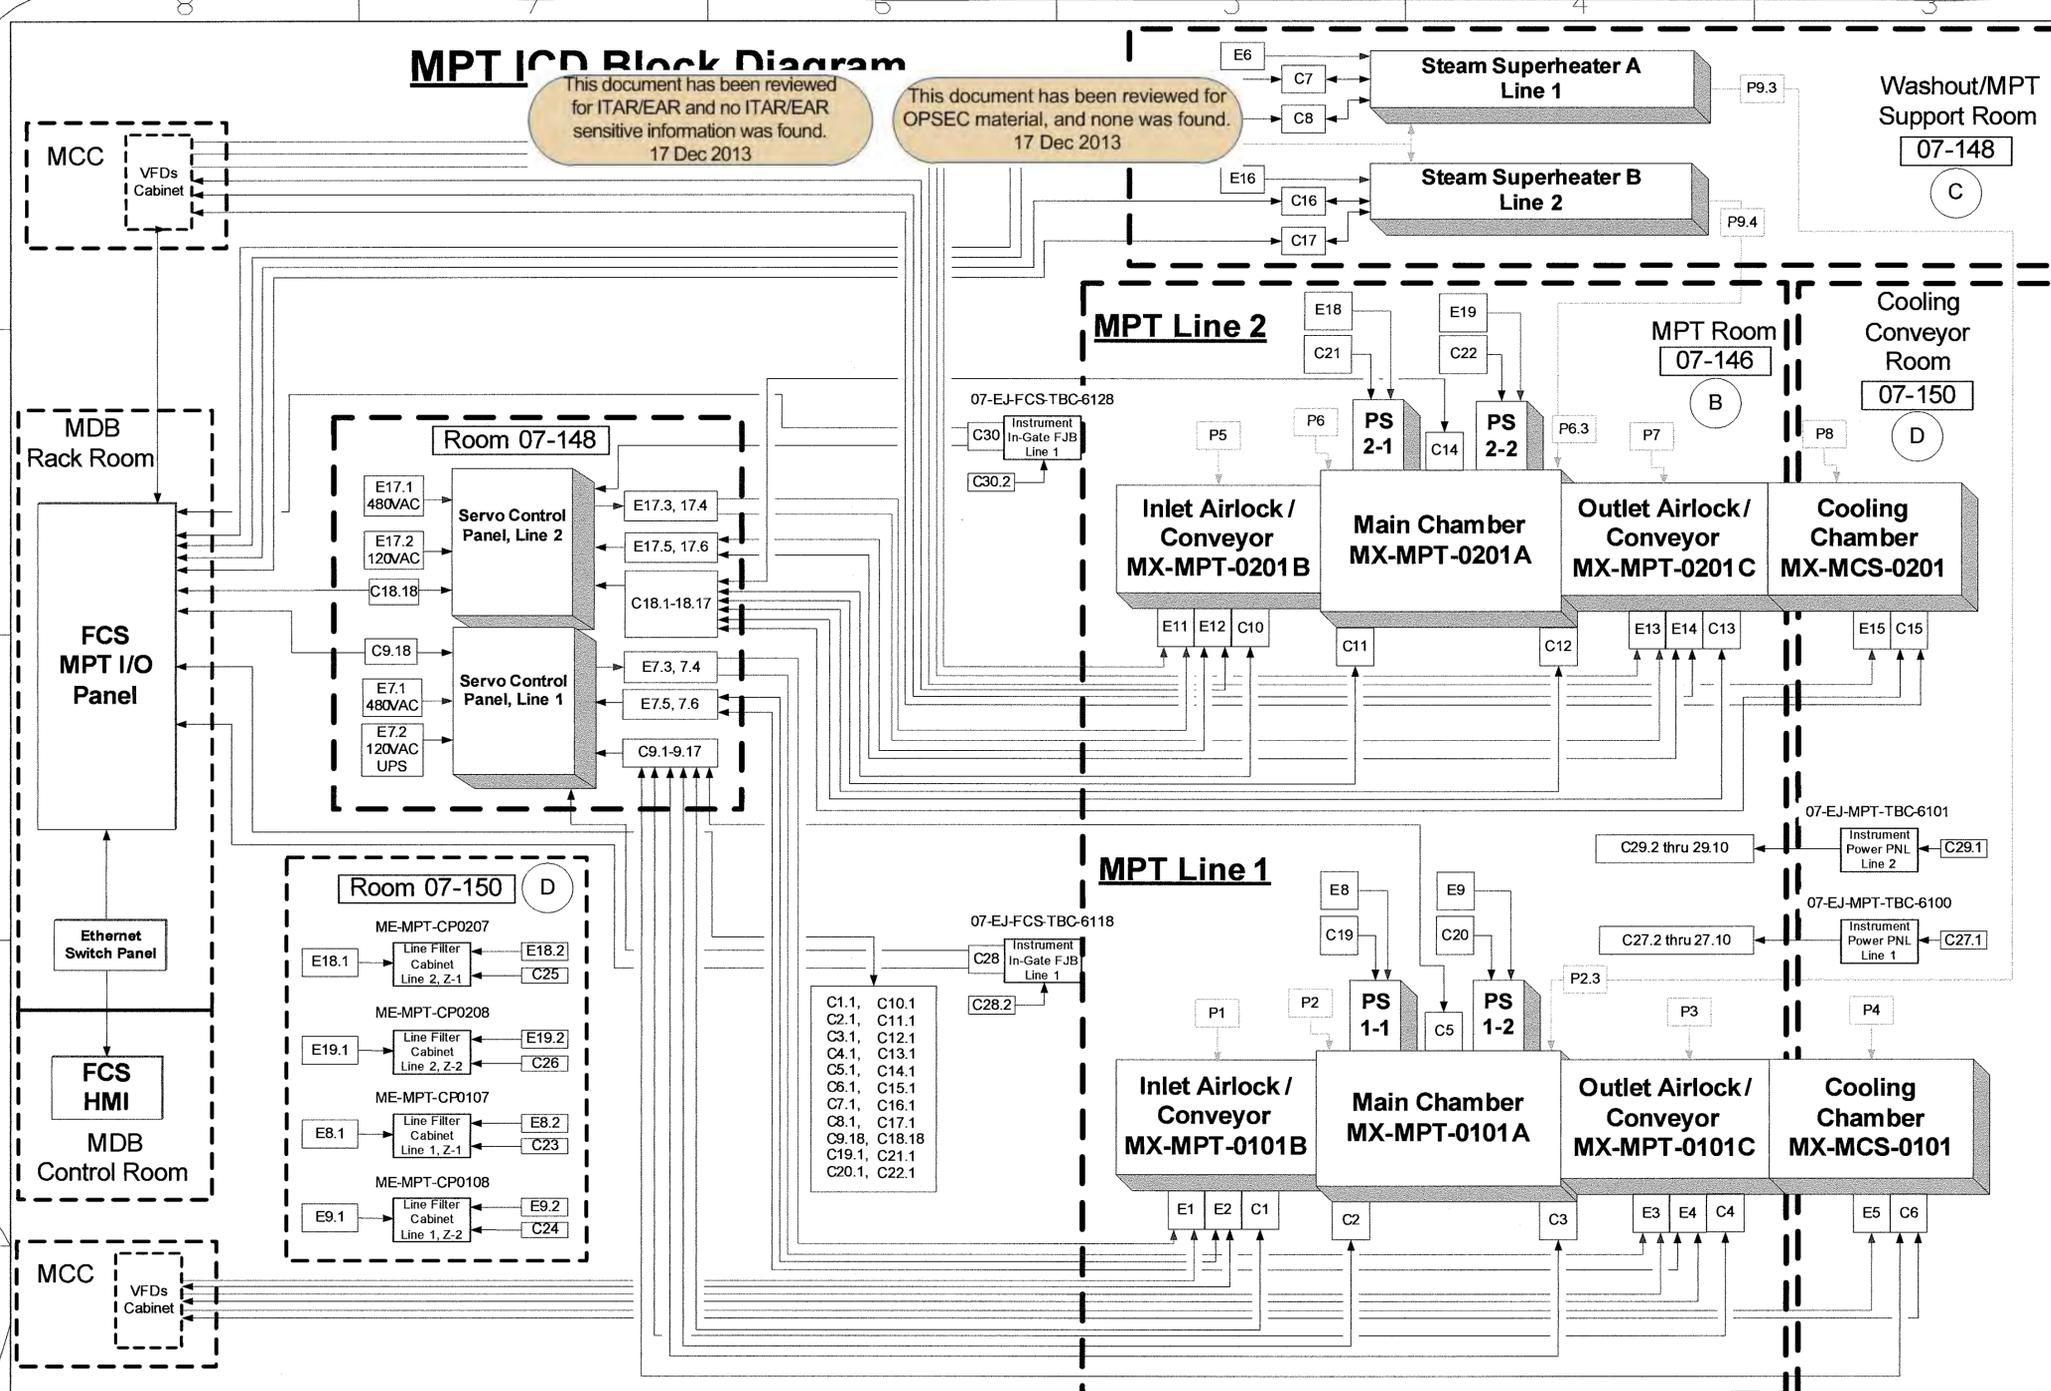

NO.	DATE	DESCRIPTION	DR	CK	DL	PE	APVD
△	6/29/10	IFC (SEE NOTE 14)					
△	4/17/08	IFD (ECR NO. BGCAPP-MPT-135)	JPM	JXB	TF	WARTC	
△	2/19/07	ISSUED FOR DESIGN					SIGNATURES ON FILE
△	10/31/06	ISSUED FOR DESIGN					SIGNATURES ON FILE
△	8/25/06	ISSUED FOR DESIGN					SIGNATURES ON FILE

Q NON-Q


BECHTEL PARSONS BLUE GRASS
A Joint Venture of Bechtel National, Inc. and Parsons Infrastructure & Technology Group Inc.

DOD PROGRAM MANAGER FOR ASSEMBLED CHEMICAL WEAPONS ASSESSMENT EDGWOOD, MARYLAND

US ARMY ENGINEERING AND SUPPORT CENTER, HUNTSVILLE HUNTSVILLE, ALABAMA

BLUE GRASS CHEMICAL AGENT DESTRUCTION PILOT PLANT PROJECT (BGCAPP) RICHMOND, KENTUCKY

CONTRACT NO. DAAA09-03-D-0023

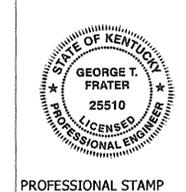

PARSONS PASCO FABRICATION SHOP
METAL PARTS TREATER
INTERFACE CONNECTION DRAWING

DRAWING NUMBER: 24915-07-B2-MPT-00001

SHEET: 18 OF 20


REV: 4

AD-EBH-0106
 EBH BLAST DOOR NO.2
 MOTOR HP (A) : 1HP
 MOTOR HP (B) : 3.2 HP
 MOTOR HP (C) : 3.2 HP

- GENERAL NOTES:
- FOR SYMBOLS AND LEGEND, SEE DRAWINGS 24915-00-M6-00-00010 THRU 00015.
 - DRAWING NUMBERS IN OFF-PAGE CONNECTORS ARE TRUNCATED BY SUPPRESSING PROJECT NUMBER "24915" AND DOCUMENTS TYPE "M6". TWO LEADING ZEROS IN SEQUENCE NUMBER ARE NOT SHOWN.
 - ALL EQUIPMENT NUMBERS, INSTRUMENT TAG NUMBERS AND VALVE NUMBERS ARE PREFIXED "07" UNLESS OTHERWISE NOTED.
 - SERVO DRIVE CONTROLLER SHALL BE LOCATED OUTSIDE OF CATEGORY A AND A/B AREA.
 - WHEN DOOR AND LATCHES ARE IN AUTO MODE, OPEN COMMAND SHALL UNLATCH AND OPEN THE DOOR AND CLOSE COMMAND SHALL CLOSE AND LATCH THE DOOR.
 - UNLESS OTHERWISE NOTED, FCS INTERLOCK NUMBERS ARE PREFIXED WITH "07-EBH-" AND FPS (OR Z) INTERLOCKS ARE PREFIXED WITH "07-FPS-".
 - EMERGENCY STOP SWITCH TO BE PROVIDED LOOSE BY BLAST DOOR SUPPLIER. IT SHALL BE MOUNTED IN A CONTROL BOX.
 - OPENING OF ANY EBH DOORS SHOULD PLACE THE ROBOTS IN MAINTENANCE MODE.

This document has been reviewed for ITAR/EAR and no ITAR/EAR sensitive information was found.
 17 Dec 2013

This document has been reviewed for OPSEC material, and none was found.
 17 Dec 2013

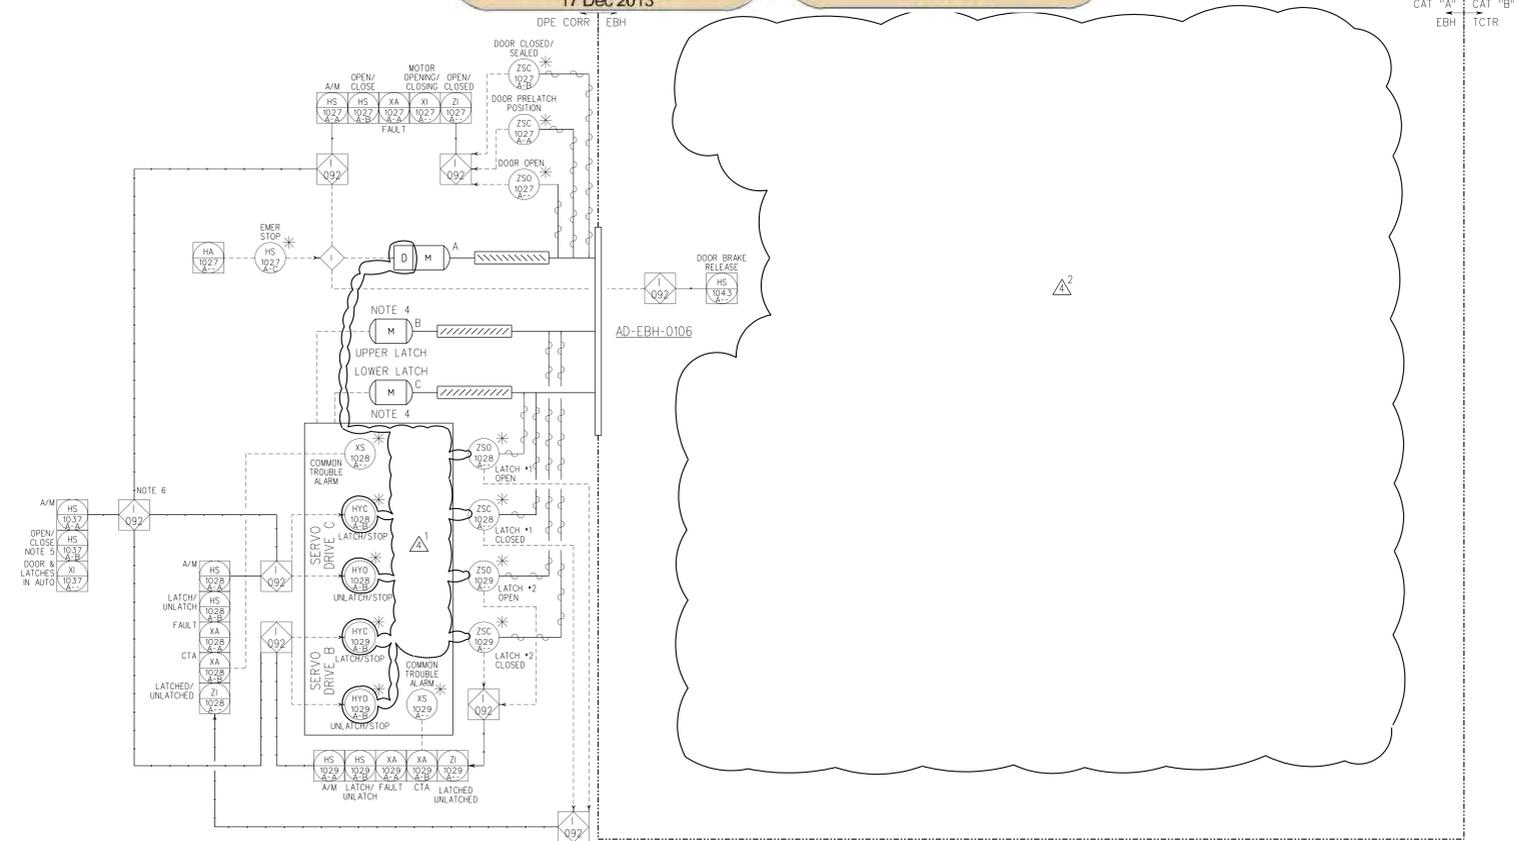

NO.	DATE	DESCRIPTION	DR	CK	DL	PE	APVD
43	01/30/12	IFC, INCORPORATED DCN-549, -676, YDA-ADDH-10031	MDV	GM	SA	BBB	BBB
33	02/13/09	IFC, ADDED INSTRUMENTATION AND DCN-73	PEB	JLL	BM	BBB	BBB
24	03/09/07	IFC, ADDED INTERLOCK TAG NO., HOME POSITION	RZ	JLL	PEB	JB	BBB
14	05/03/06	ISSUED FOR DESIGN (IFD), ADD DESIGN DEVELOPMENT	RZ	JLL	PEB	JB	BBB
6	10/31/05	ISSUED FOR DESIGN (IFD)	RZ	JLL	PEB	JB	PKG

BECHTEL PARSONS BLUE GRASS
 DOD PROGRAM MANAGER FOR ASSEMBLED CHEMICAL WEAPONS ASSESSMENT EDGEWOOD, MARYLAND
 US ARMY ENGINEERING AND SUPPORT CENTER, HUNTSVILLE, ALABAMA


BLUE GRASS CHEMICAL AGENT DESTRUCTION PILOT PLANT PROJECT (BGCAPP)
 RICHMOND, KENTUCKY
 DAAA09-03-D-0023

MUNITIONS DEMILITARIZATION BUILDING
 EBH BLAST DOORS (SECOND LEVEL)
 PIPING & INSTRUMENT DIAGRAM

CONTRACT NO. | DRAWING NUMBER | SHEET | REV
 DAAA09-03-D-0023 | 24915-07-M6-EBH-00002 | 1 OF 1 | 4



07MEBH002.plt 01/30/12
 DESIGN FILE: DONSPEC
 PLOTTED BY: USER4 ON DATE: 1/30/12 3:35:43 PM

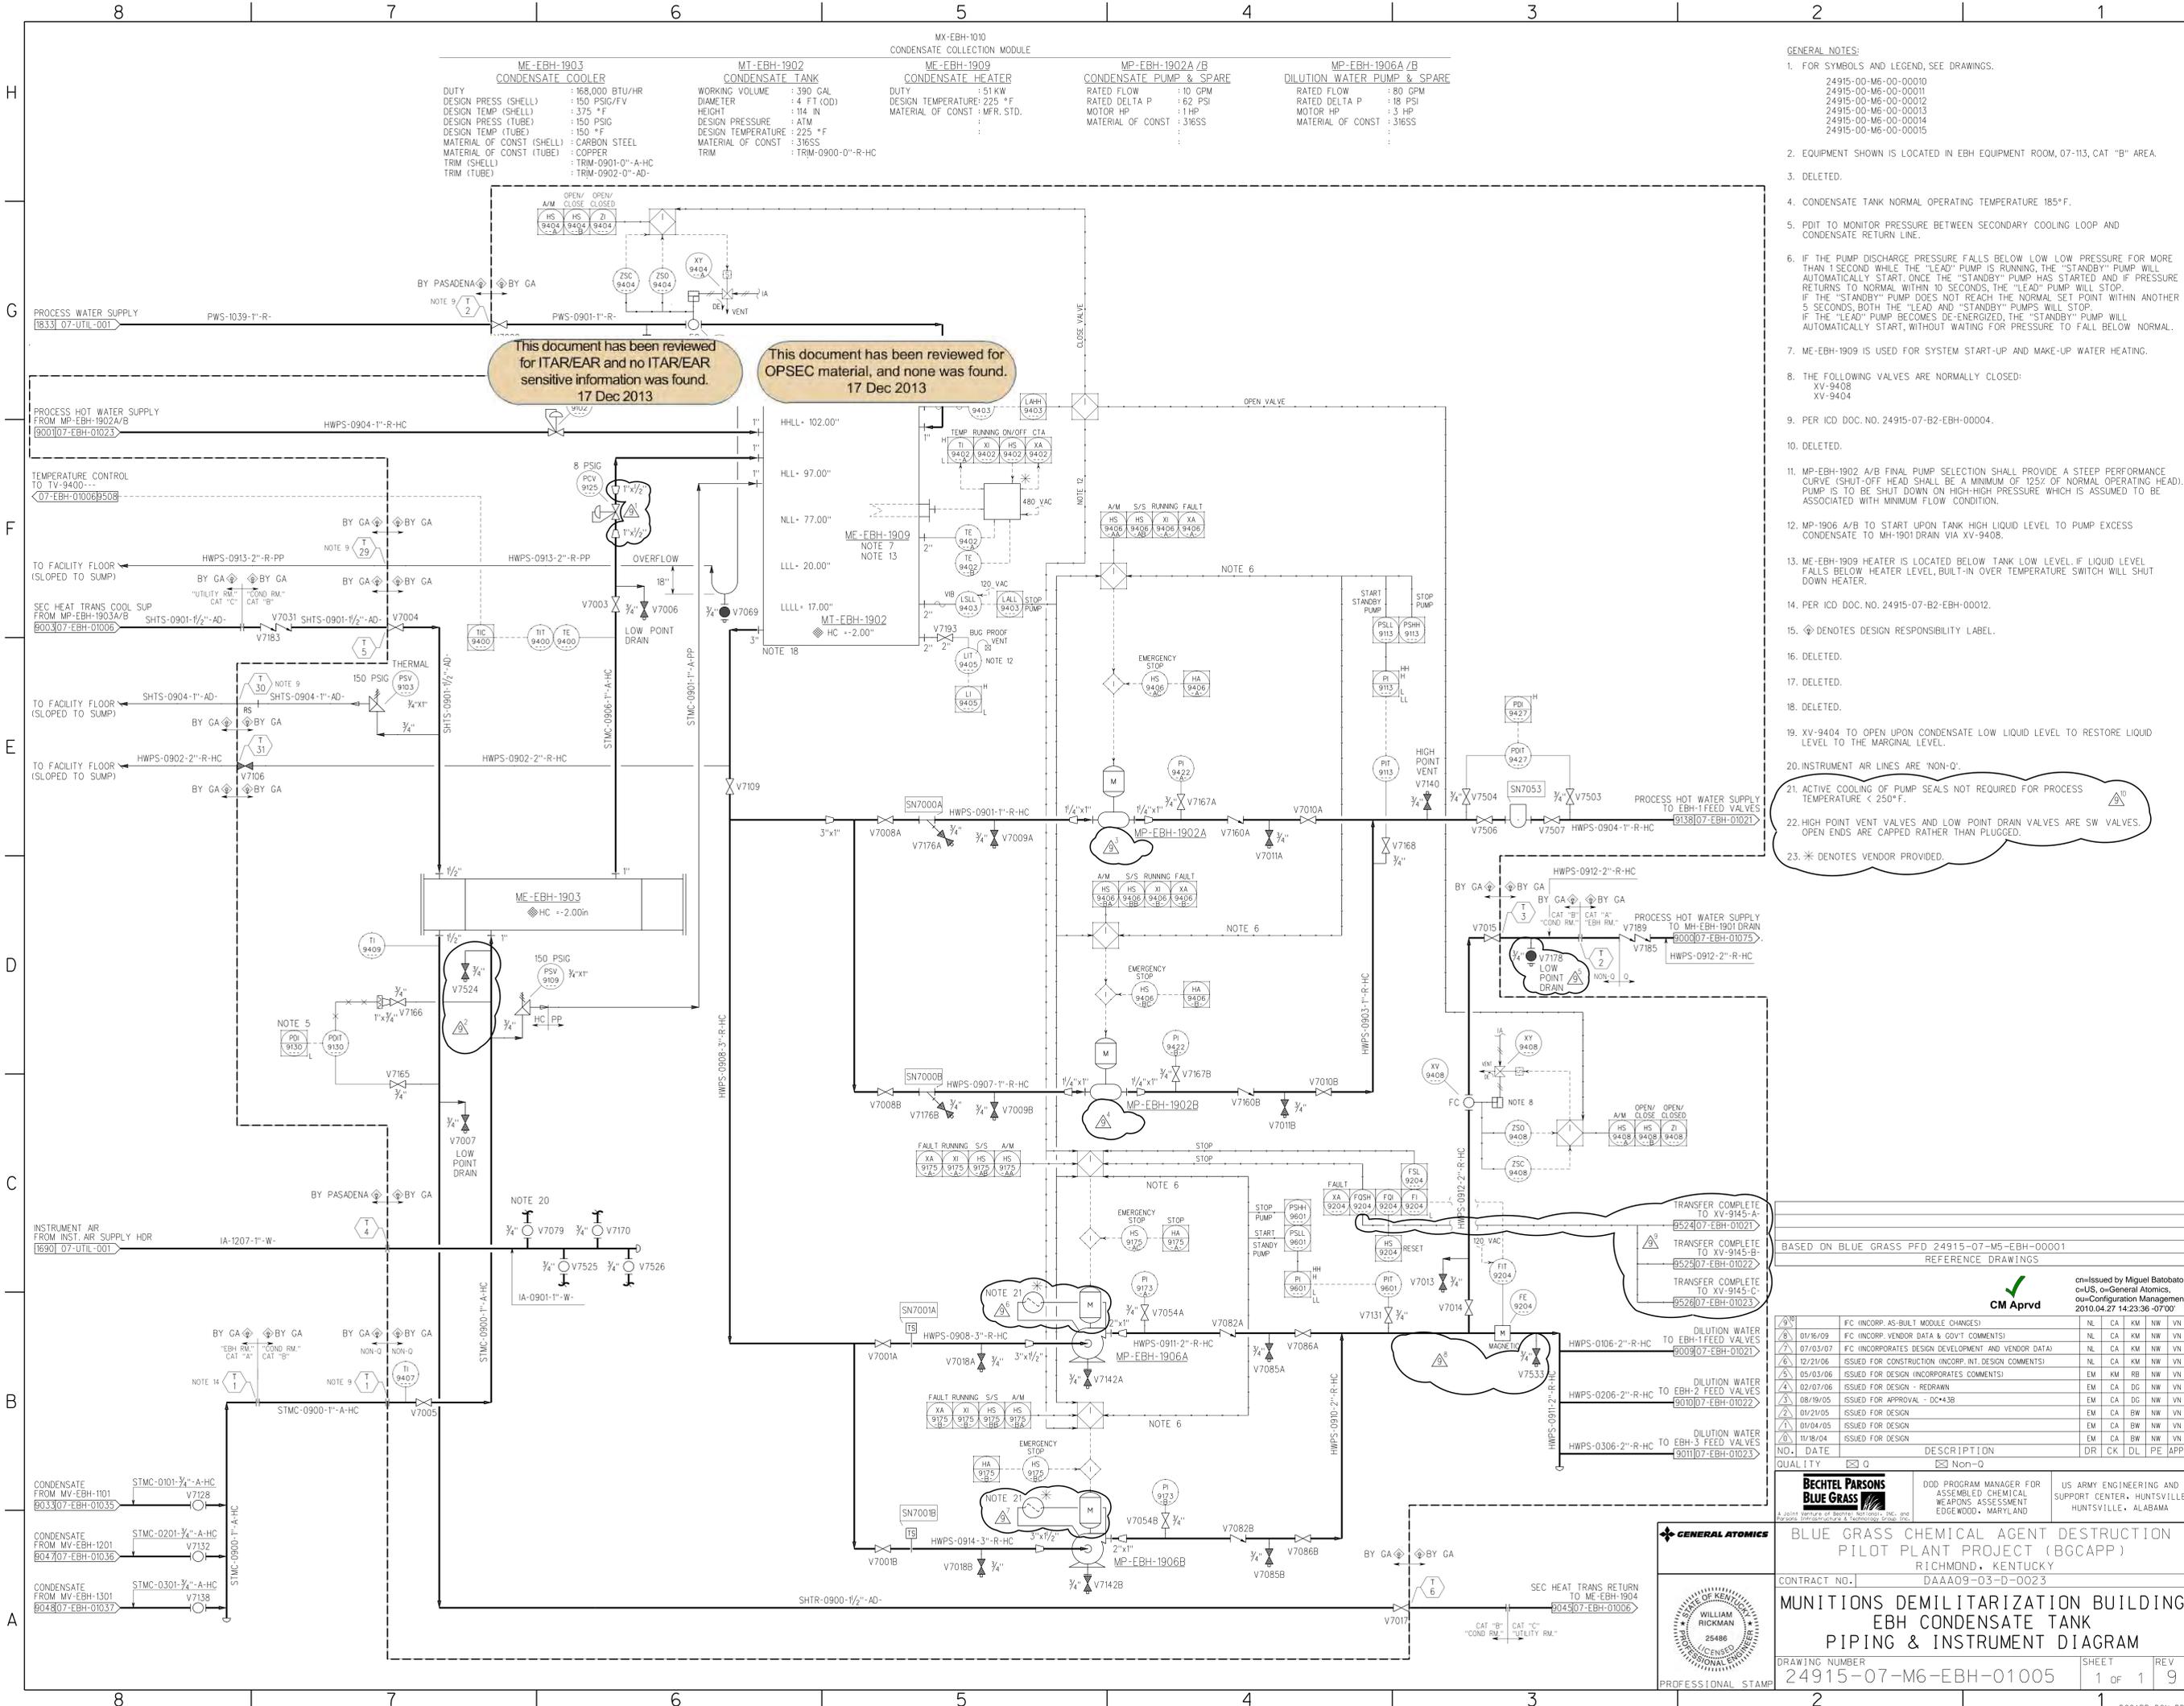

- GENERAL NOTES:**
- FOR SYMBOLS AND LEGEND, SEE DRAWINGS.
24915-00-M6-00-00010
24915-00-M6-00-00011
24915-00-M6-00-00012
24915-00-M6-00-00013
24915-00-M6-00-00014
24915-00-M6-00-00015
 - EQUIPMENT SHOWN IS LOCATED IN EBH EQUIPMENT ROOM, 07-113, CAT "B" AREA.
 - DELETED.
 - CONDENSATE TANK NORMAL OPERATING TEMPERATURE 185°F.
 - PDIIT TO MONITOR PRESSURE BETWEEN SECONDARY COOLING LOOP AND CONDENSATE RETURN LINE.
 - IF THE PUMP DISCHARGE PRESSURE FALLS BELOW LOW LOW PRESSURE FOR MORE THAN 15 SECONDS WHILE THE "LEAD" PUMP IS RUNNING, THE "STANDBY" PUMP WILL AUTOMATICALLY START. ONCE THE "STANDBY" PUMP HAS STARTED AND IF PRESSURE RETURNS TO NORMAL WITHIN 10 SECONDS, THE "LEAD" PUMP WILL STOP. IF THE "STANDBY" PUMP DOES NOT REACH THE NORMAL SET POINT WITHIN ANOTHER 5 SECONDS, BOTH THE "LEAD" AND "STANDBY" PUMPS WILL STOP. IF THE "LEAD" PUMP BECOMES DE-ENERGIZED, THE "STANDBY" PUMP WILL AUTOMATICALLY START, WITHOUT WAITING FOR PRESSURE TO FALL BELOW NORMAL.
 - ME-FBH-1909 IS USED FOR SYSTEM START-UP AND MAKE-UP WATER HEATING.
 - THE FOLLOWING VALVES ARE NORMALLY CLOSED:
XV-9408
XV-9404
 - PER ICD DOC. NO. 24915-07-B2-EBH-00004.
 - DELETED.
 - MP-FBH-1902 A/B FINAL PUMP SELECTION SHALL PROVIDE A STEEP PERFORMANCE CURVE (SHUT-OFF HEAD SHALL BE A MINIMUM OF 125% OF NORMAL OPERATING HEAD). PUMP IS TO BE SHUT DOWN ON HIGH-HIGH PRESSURE WHICH IS ASSUMED TO BE ASSOCIATED WITH MINIMUM FLOW CONDITION.
 - MP-1906 A/B TO START UPON TANK HIGH LIQUID LEVEL TO PUMP EXCESS CONDENSATE TO MH-1901 DRAIN VIA XV-9408.
 - ME-FBH-1909 HEATER IS LOCATED BELOW TANK LOW LEVEL. IF LIQUID LEVEL FALLS BELOW HEATER LEVEL, BUILT-IN OVER TEMPERATURE SWITCH WILL SHUT DOWN HEATER.
 - PER ICD DOC. NO. 24915-07-B2-EBH-00012.
 - ◇ DENOTES DESIGN RESPONSIBILITY LABEL.
 - DELETED.
 - DELETED.
 - DELETED.
 - XV-9404 TO OPEN UPON CONDENSATE LOW LIQUID LEVEL TO RESTORE LIQUID LEVEL TO THE MARGINAL LEVEL.
 - INSTRUMENT AIR LINES ARE "NON-O".
 - ACTIVE COOLING OF PUMP SEALS NOT REQUIRED FOR PROCESS TEMPERATURE < 250°F.
 - HIGH POINT VENT VALVES AND LOW POINT DRAIN VALVES ARE SW VALVES. OPEN ENDS ARE CAPPED RATHER THAN PLUGGED.
 - * DENOTES VENDOR PROVIDED.

TRANSFER COMPLETE TO XV-9145-A-
B52407-EBH-01021

TRANSFER COMPLETE TO XV-9145-B-
B52307-EBH-01022

TRANSFER COMPLETE TO XV-9145-C-
B52807-EBH-01023

BASED ON BLUE GRASS PFD 24915-07-M5-EBH-00001
REFERENCE DRAWINGS

CM Aprvd

Issued by Miguel Batobato,
c-4US, c-General Atomics,
ou-Configuration Management
2010.04.27 14:23:36 -0700

NO.	DATE	DESCRIPTION	DR	CK	DL	PE	APPD
9/0		FC (INCORP. AS-BUILT MODULE CHANGES)	NL	CA	KM	NW	VN
8/1	01/16/09	FC (INCORP. VENDOR DATA & GOVT COMMENTS)	NL	CA	KM	NW	VN
7/2	07/03/07	FC (INCORPORATES DESIGN DEVELOPMENT AND VENDOR DATA)	NL	CA	KM	NW	VN
6/3	12/21/06	ISSUED FOR CONSTRUCTION (INCORP. INT. DESIGN COMMENTS)	NL	CA	KM	NW	VN
5/4	05/03/06	ISSUED FOR DESIGN (INCORPORATES COMMENTS)	EM	KM	RB	NW	VN
4/5	02/07/06	ISSUED FOR DESIGN - REDRAWN	EM	CA	DC	NW	VN
3/6	08/19/05	ISSUED FOR APPROVAL - DC*43B	EM	CA	DC	NW	VN
2/7	01/21/05	ISSUED FOR DESIGN	EM	CA	BW	NW	VN
1/8	01/04/05	ISSUED FOR DESIGN	EM	CA	BW	NW	VN
0/9	11/18/04	ISSUED FOR DESIGN	EM	CA	BW	NW	VN

QUALITY Q Non-Q

BECHTEL PARSONS BLUE GRASS

DOD PROGRAM MANAGER FOR ASSEMBLED CHEMICAL WEAPONS ASSESSMENT EDGEWOOD, MARYLAND

US ARMY ENGINEERING AND SUPPORT CENTER, HUNTSVILLE HUNTSVILLE, ALABAMA

BLUE GRASS CHEMICAL AGENT DESTRUCTION PILOT PLANT PROJECT (BGCAPP)
RICHMOND, KENTUCKY


CONTRACT NO. DAAA09-03-D-0023

MUNITIONS DEMILITARIZATION BUILDING EBH CONDENSATE TANK PIPING & INSTRUMENT DIAGRAM

DRAWING NUMBER 24915-07-M6-EBH-01005 SHEET 1 of 1 REV 9

GENERAL ATOMICS
WILLIAM RICKMAN
25486
PROFESSIONAL STAMP

07MEBH01005.ppt 03/16/10

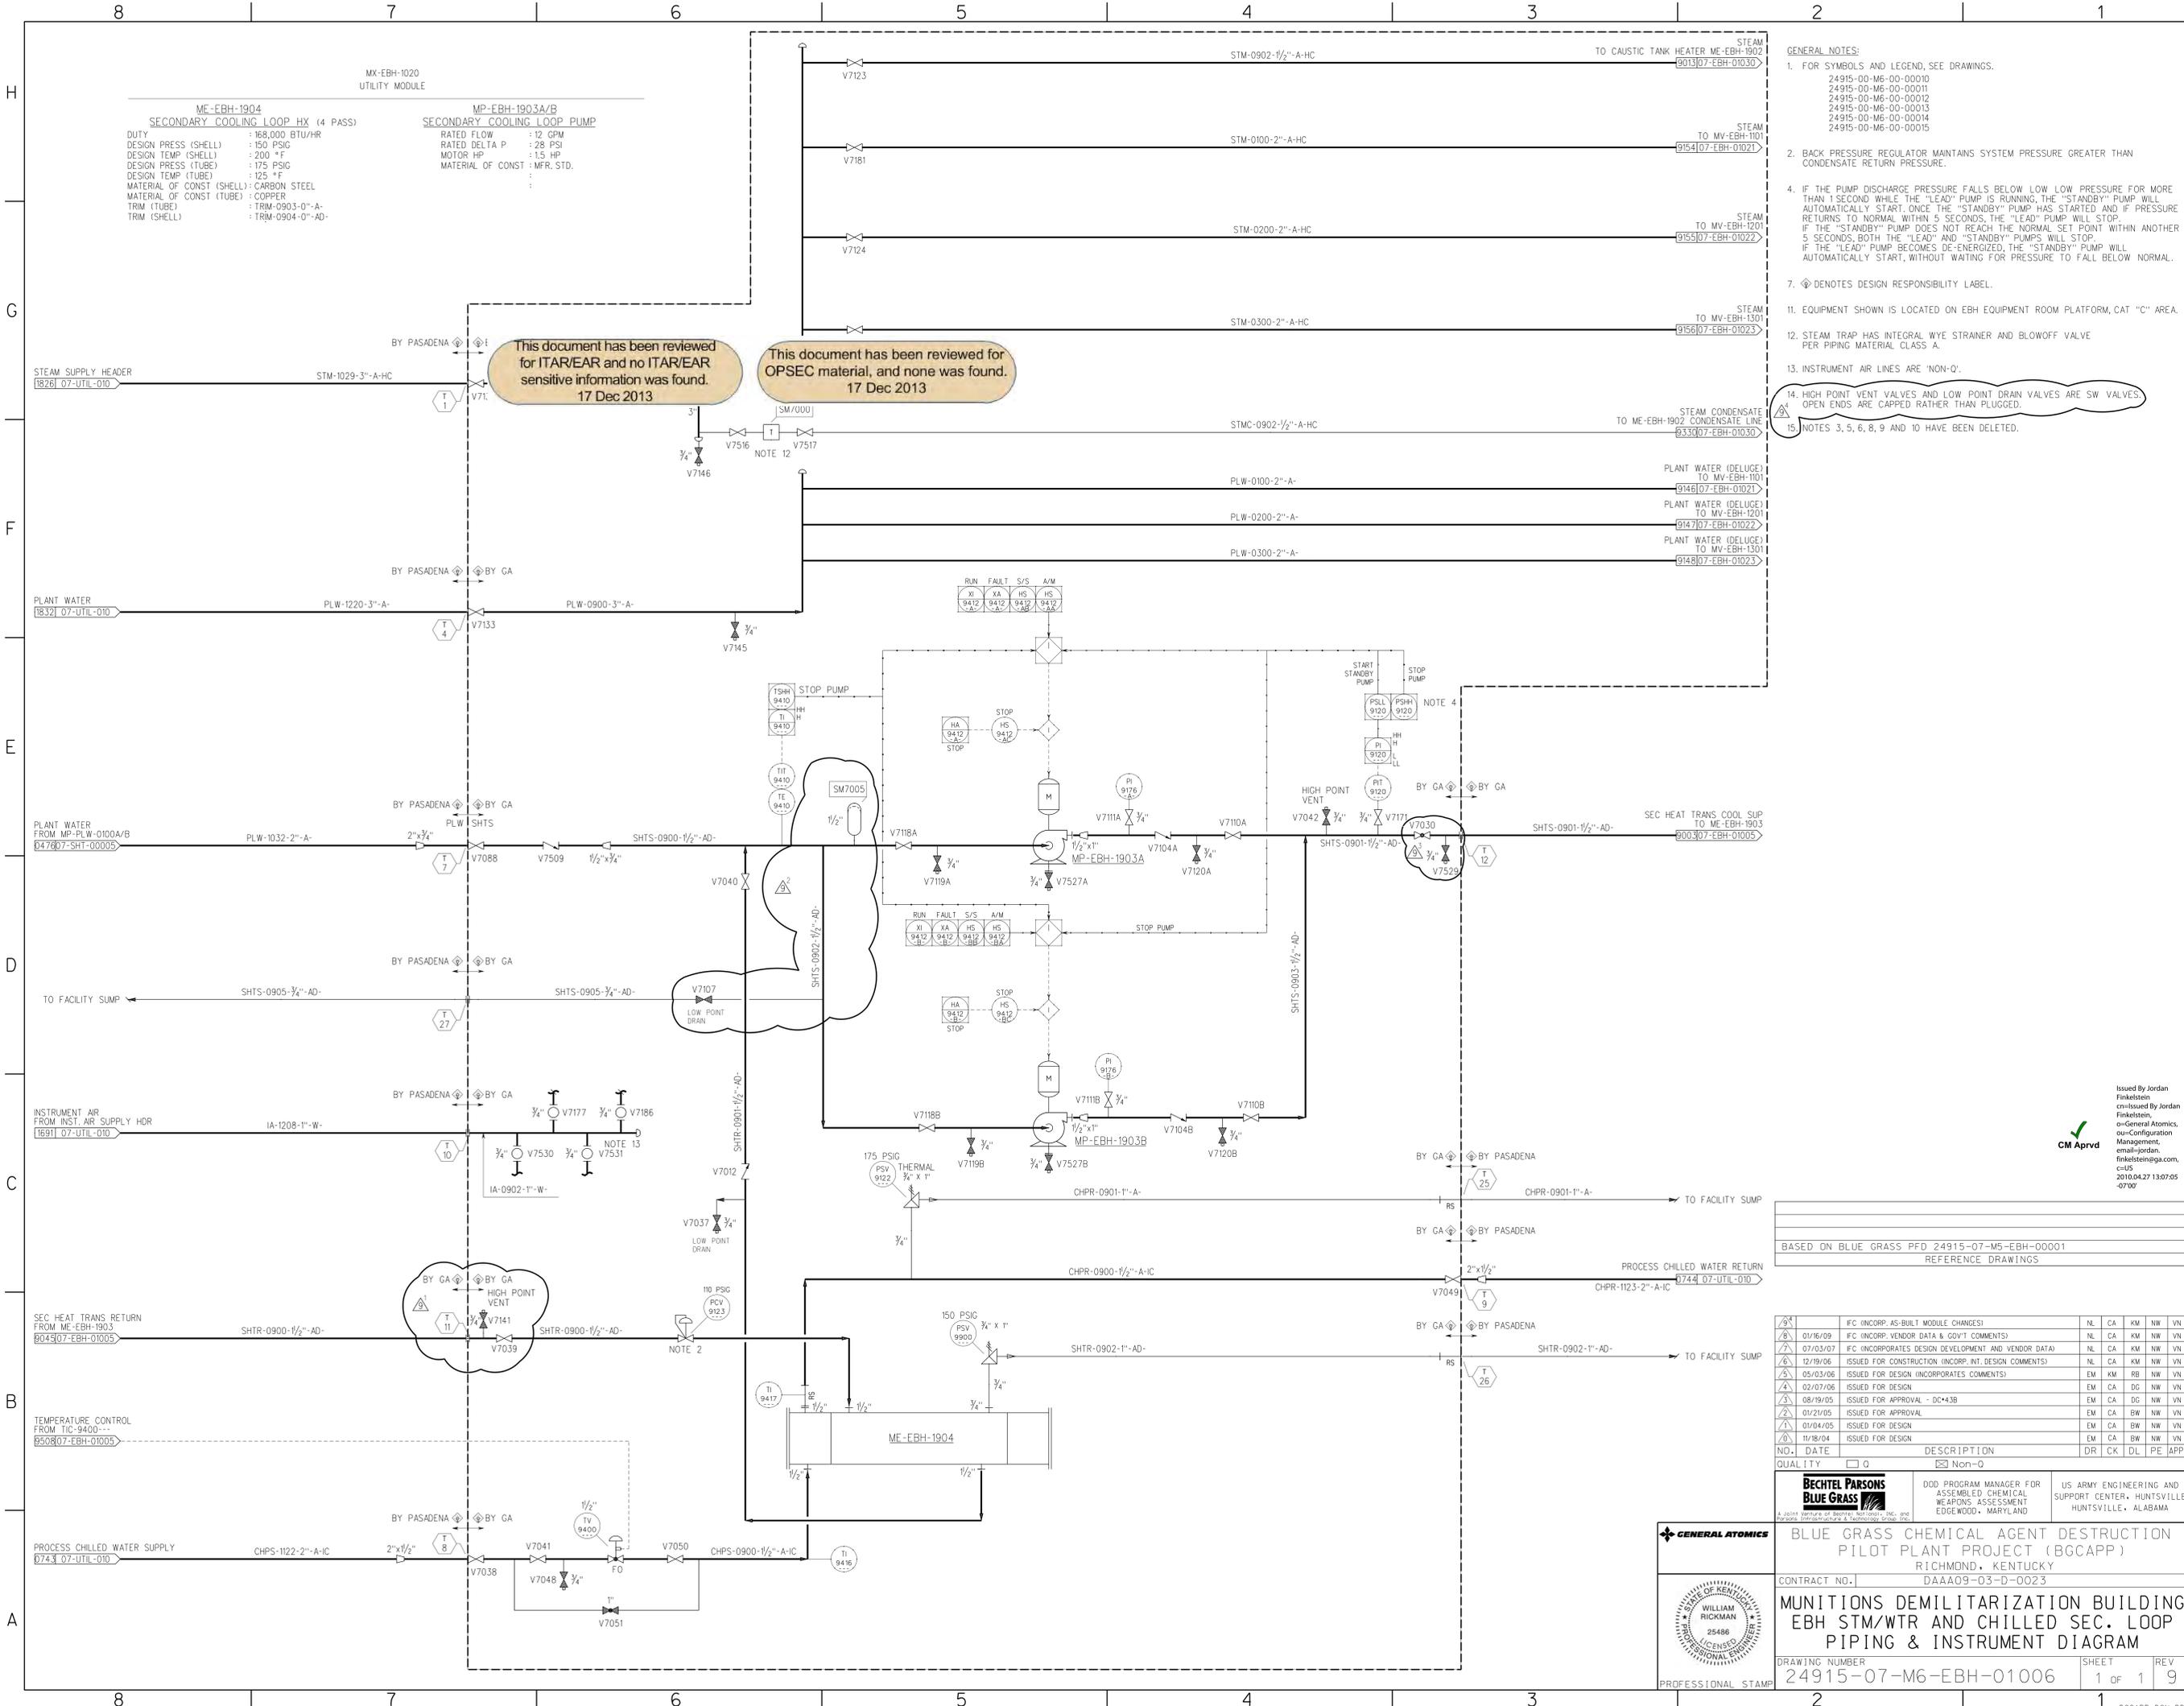

- GENERAL NOTES:**
- FOR SYMBOLS AND LEGEND, SEE DRAWINGS.
24915-00-M6-00-00010
24915-00-M6-00-00011
24915-00-M6-00-00012
24915-00-M6-00-00013
24915-00-M6-00-00014
24915-00-M6-00-00015
 - BACK PRESSURE REGULATOR MAINTAINS SYSTEM PRESSURE GREATER THAN CONDENSATE RETURN PRESSURE.
 - IF THE PUMP DISCHARGE PRESSURE FALLS BELOW LOW LOW PRESSURE FOR MORE THAN 1 SECOND WHILE THE "LEAD" PUMP IS RUNNING, THE "STANDBY" PUMP WILL AUTOMATICALLY START. ONCE THE "STANDBY" PUMP HAS STARTED AND IF PRESSURE RETURNS TO NORMAL WITHIN 5 SECONDS, THE "LEAD" PUMP WILL STOP. IF THE "STANDBY" PUMP DOES NOT REACH THE NORMAL SET POINT WITHIN ANOTHER 5 SECONDS, BOTH THE "LEAD" AND "STANDBY" PUMPS WILL STOP. IF THE "LEAD" PUMP BECOMES DE-ENERGIZED, THE "STANDBY" PUMP WILL AUTOMATICALLY START, WITHOUT WAITING FOR PRESSURE TO FALL BELOW NORMAL.
 - Ⓢ DENOTES DESIGN RESPONSIBILITY LABEL.
 - EQUIPMENT SHOWN IS LOCATED ON EBH EQUIPMENT ROOM PLATFORM, CAT "C" AREA.
 - STEAM TRAP HAS INTEGRAL WYE STRAINER AND BLOWOFF VALVE PER PIPING MATERIAL CLASS A.
 - INSTRUMENT AIR LINES ARE "NON-O".
 - HIGH POINT VENT VALVES AND LOW POINT DRAIN VALVES ARE SW VALVES. OPEN ENDS ARE CAPPED RATHER THAN PLUGGED.
 - NOTES 3, 5, 6, 8, 9 AND 10 HAVE BEEN DELETED.

This document has been reviewed for ITAR/EAR and no ITAR/EAR sensitive information was found. 17 Dec 2013

This document has been reviewed for OPSEC material, and none was found. 17 Dec 2013

Issued By Jordan Finkelstein
 Reviewed By Jordan Finkelstein
 General Atomics, Inc. Configuration Management
 email: jordan.finkelstein@ga.com
 c:US 2010.04.27 13:07:05
 0700

BASED ON BLUE GRASS PFD 24915-07-M5-EBH-00001
 REFERENCE DRAWINGS

NO.	DATE	DESCRIPTION	DR	CK	DL	PE	APPD
8	01/16/09	FC (INCORP. AS-BUILT MODULE CHANGES)	NL	CA	KM	NW	VN
7	07/03/07	FC (INCORP. VENDOR DATA & GOVT. COMMENTS)	NL	CA	KM	NW	VN
6	12/19/06	ISSUED FOR CONSTRUCTION (INCORP. INT. DESIGN COMMENTS)	NL	CA	KM	NW	VN
5	05/03/06	ISSUED FOR DESIGN (INCORP. COMMENTS)	EM	KM	RB	NW	VN
4	02/07/06	ISSUED FOR DESIGN	EM	CA	DC	NW	VN
3	08/19/05	ISSUED FOR APPROVAL - DC+3B	EM	CA	DC	NW	VN
2	01/21/05	ISSUED FOR APPROVAL	EM	CA	BW	NW	VN
1	01/04/05	ISSUED FOR DESIGN	EM	CA	BW	NW	VN
0	11/18/04	ISSUED FOR DESIGN	EM	CA	BW	NW	VN


QUALITY Q Non-Q

BECHTEL PARSONS BLUE GRASS
 DOD PROGRAM MANAGER FOR ASSEMBLED CHEMICAL WEAPONS ASSESSMENT EDGEWOOD, MARYLAND
 US ARMY ENGINEERING AND SUPPORT CENTER, HUNTSVILLE HUNTSVILLE, ALABAMA

GENERAL ATOMICS
 BLUE GRASS CHEMICAL AGENT DESTRUCTION PILOT PLANT PROJECT (BGCAPP)
 RICHMOND, KENTUCKY
 CONTRACT NO. DAAA09-03-D-0023

MUNITIONS DEMILITARIZATION BUILDING EBH STM/WTR AND CHILLED SEC. LOOP PIPING & INSTRUMENT DIAGRAM

DRAWING NUMBER: 24915-07-M6-EBH-01006
 SHEET: 1 of 1
 REV: 9

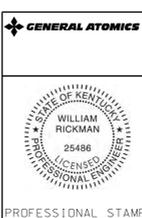

07MEBH01006.ppt 03/16/10


MX-EBH-1010
CONDENSATE COLLECTION MODULE

GENERAL NOTES:

- FOR SYMBOLS AND LEGEND, SEE DRAWINGS.
24915-00-M6-00-00010
24915-00-M6-00-00011
24915-00-M6-00-00012
24915-00-M6-00-00013
24915-00-M6-00-00014
24915-00-M6-00-00015
- DELETED.
- FO-9107-A, FO-9107-B, AND FO-9107-C- SIZED FOR 3000 SCFM.
FO-9189-A, FO-9189-B, AND FO-9189-C- SIZED FOR 50 SCFM.
- SEE 24915-07-M6-EBH-01035 FOR NITROGEN PURGE OPERATION.
- PER ICD DOC. NO. 24915-07-B2-EBH-00012.
- SOLENOID VALVES:
XV-9186-A
XV-9185-A
XV-9186-B
XV-9185-B
XV-9186-C
XV-9185-C
TO BE SPECIFIED AS FAIL OPEN.
- Ⓢ DENOTES DESIGN RESPONSIBILITY LABEL.
- THE FOLLOWING VALVES ARE NORMALLY CLOSED:
XV-9186-A
XV-9185-A
XV-9186-B
XV-9185-B
XV-9186-C
XV-9185-C
XV-9180-A
XV-9181-A
XV-9180-B
XV-9181-B
XV-9180-C
XV-9181-C
- ONLY THE VALVES OF THE TWO OPERATING EBH'S WILL OPEN ON THE PURGE SIGNAL INITIATED BY THE FCS OR FPS.
- EQUIPMENT SHOWN IS LOCATED IN THE EBH EQUIPMENT ROOM, 07-113, CAT "B" AREA.
- FCS AND FPS VALVE STATUS TO BE WIRED IN SERIES AND USED TO CONTROL HVAC DAMPERS HD8741A-- AND HD8741B-- IN THE EVENT OF NITROGEN PURGING.
- PILOT VALVE CONNECTION FOR PRESSURE REDUCING REGULATOR.
- FOR SAFETY, BLOCK VALVES SHALL BE LOCKED CLOSED DURING MAINTENANCE, AND LOCKED OPEN AFTER MAINTENANCE TO ENSURE AVAILABILITY OF EBH PURGE.

This document has been reviewed for ITAR/EAR and no ITAR/EAR sensitive information was found. 17 Dec 2013

This document has been reviewed for OPSEC material, and none was found. 17 Dec 2013

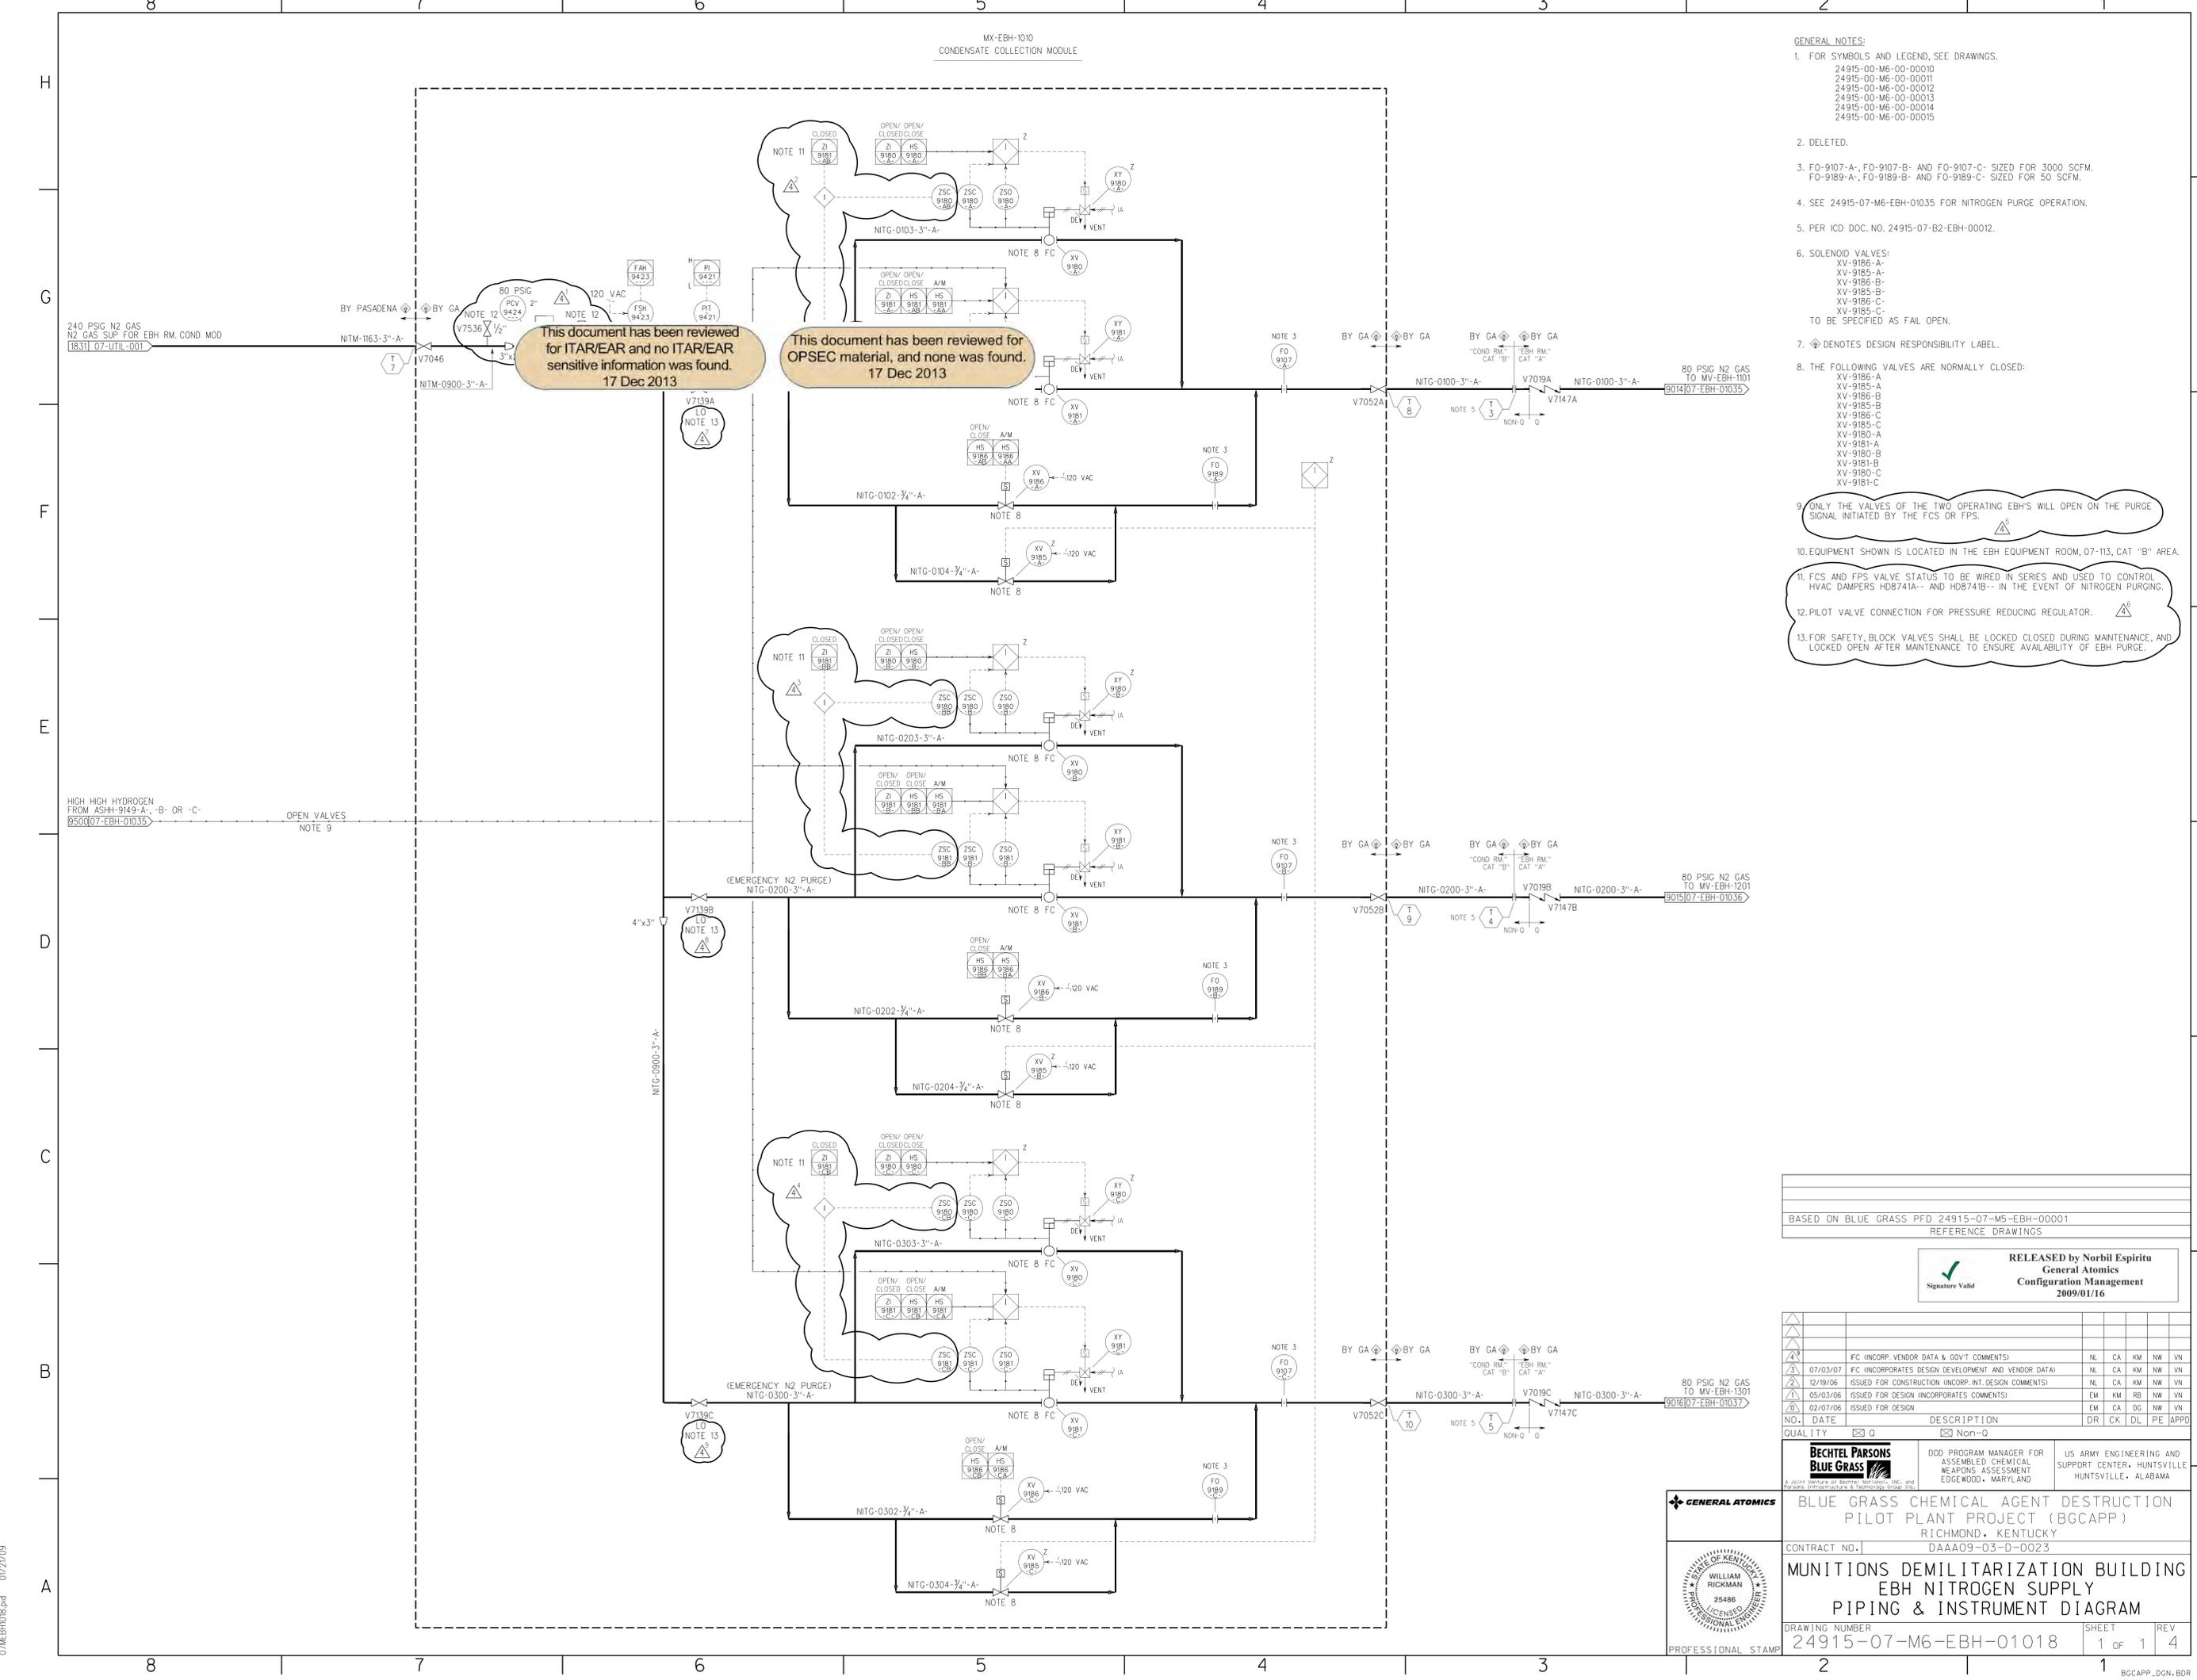

RELEASED by Norbil Espiritu
General Atomics
Configuration Management
2009/01/16

NO.	DATE	DESCRIPTION	DR	CK	DL	PE	APPD

QUALITY Q Non-Q

BECHTEL PARSONS
DOD PROGRAM MANAGER FOR ASSEMBLED CHEMICAL WEAPONS ASSESSMENT EDGEWOOD, MARYLAND

GENERAL ATOMICS
US ARMY ENGINEERING AND SUPPORT CENTER, HUNTSVILLE, ALABAMA

BLUE GRASS CHEMICAL AGENT DESTRUCTION PILOT PLANT PROJECT (BGCAPP)
RICHMOND, KENTUCKY
DAAA09-03-D-0023

MUNITIONS DEMILITARIZATION BUILDING EBH NITROGEN SUPPLY PIPING & INSTRUMENT DIAGRAM

CONTRACT NO. [] SHEET 1 OF 1 REV 4
DRAWING NUMBER 24915-07-M6-EBH-01018

GENERAL ATOMICS
WILLIAM RICKMAN
25486
PROFESSIONAL STAMP


07MEBH1018.pid 07/27/09

MX-EBH-1010 CONDENSATE COLLECTION MODULE
 MX-EBH-1020 UTILITY MODULE

- GENERAL NOTES:**
- FOR SYMBOLS AND LEGEND, SEE DRAWINGS
 - 24915-00-M6-00-00010
24915-00-M6-00-00011
24915-00-M6-00-00012
24915-00-M6-00-00013
24915-00-M6-00-00014
24915-00-M6-00-00015
 - PER ICD DOC. NO. 24915-07-B2-EBH-00005.
 - PER ICD DOC. NO. 34915-07-B2-EBH-00004.
 - PER ICD DOC. NO. 24915-07-B2-EBH-00012.
 - PER ICD DOC. NO. 24915-07-B2-EBH-00010.
 - ⊕ DENOTES DESIGN RESPONSIBILITY LABEL.
 - STEAM TRAP HAS INTEGRAL WYE STRAINER AND BLOWOFF VALVE PER PIPING MATERIAL CLASS A.
 - PAL IS TIED TO SOLENOID VALVE POSITION AND WILL ONLY ALARM IF SOLENOID VALVE IS OPEN AND LINE PRESSURE REMAINS LOW OR IF SOLENOID VALVE IS CLOSED AND PRESSURE REMAINS HIGH.
 - HIGH POINT VENT VALVES AND LOW POINT DRAIN VALVES ARE SW VALVES. OPEN ENDS ARE CAPPED RATHER THAN PLUGGED.
 - NOTES 2 AND 3 HAVE BEEN DELETED.

This document has been reviewed for ITAR/EAR and no ITAR/EAR sensitive information was found. 17 Dec 2013

This document has been reviewed for OPSEC material, and none was found. 17 Dec 2013

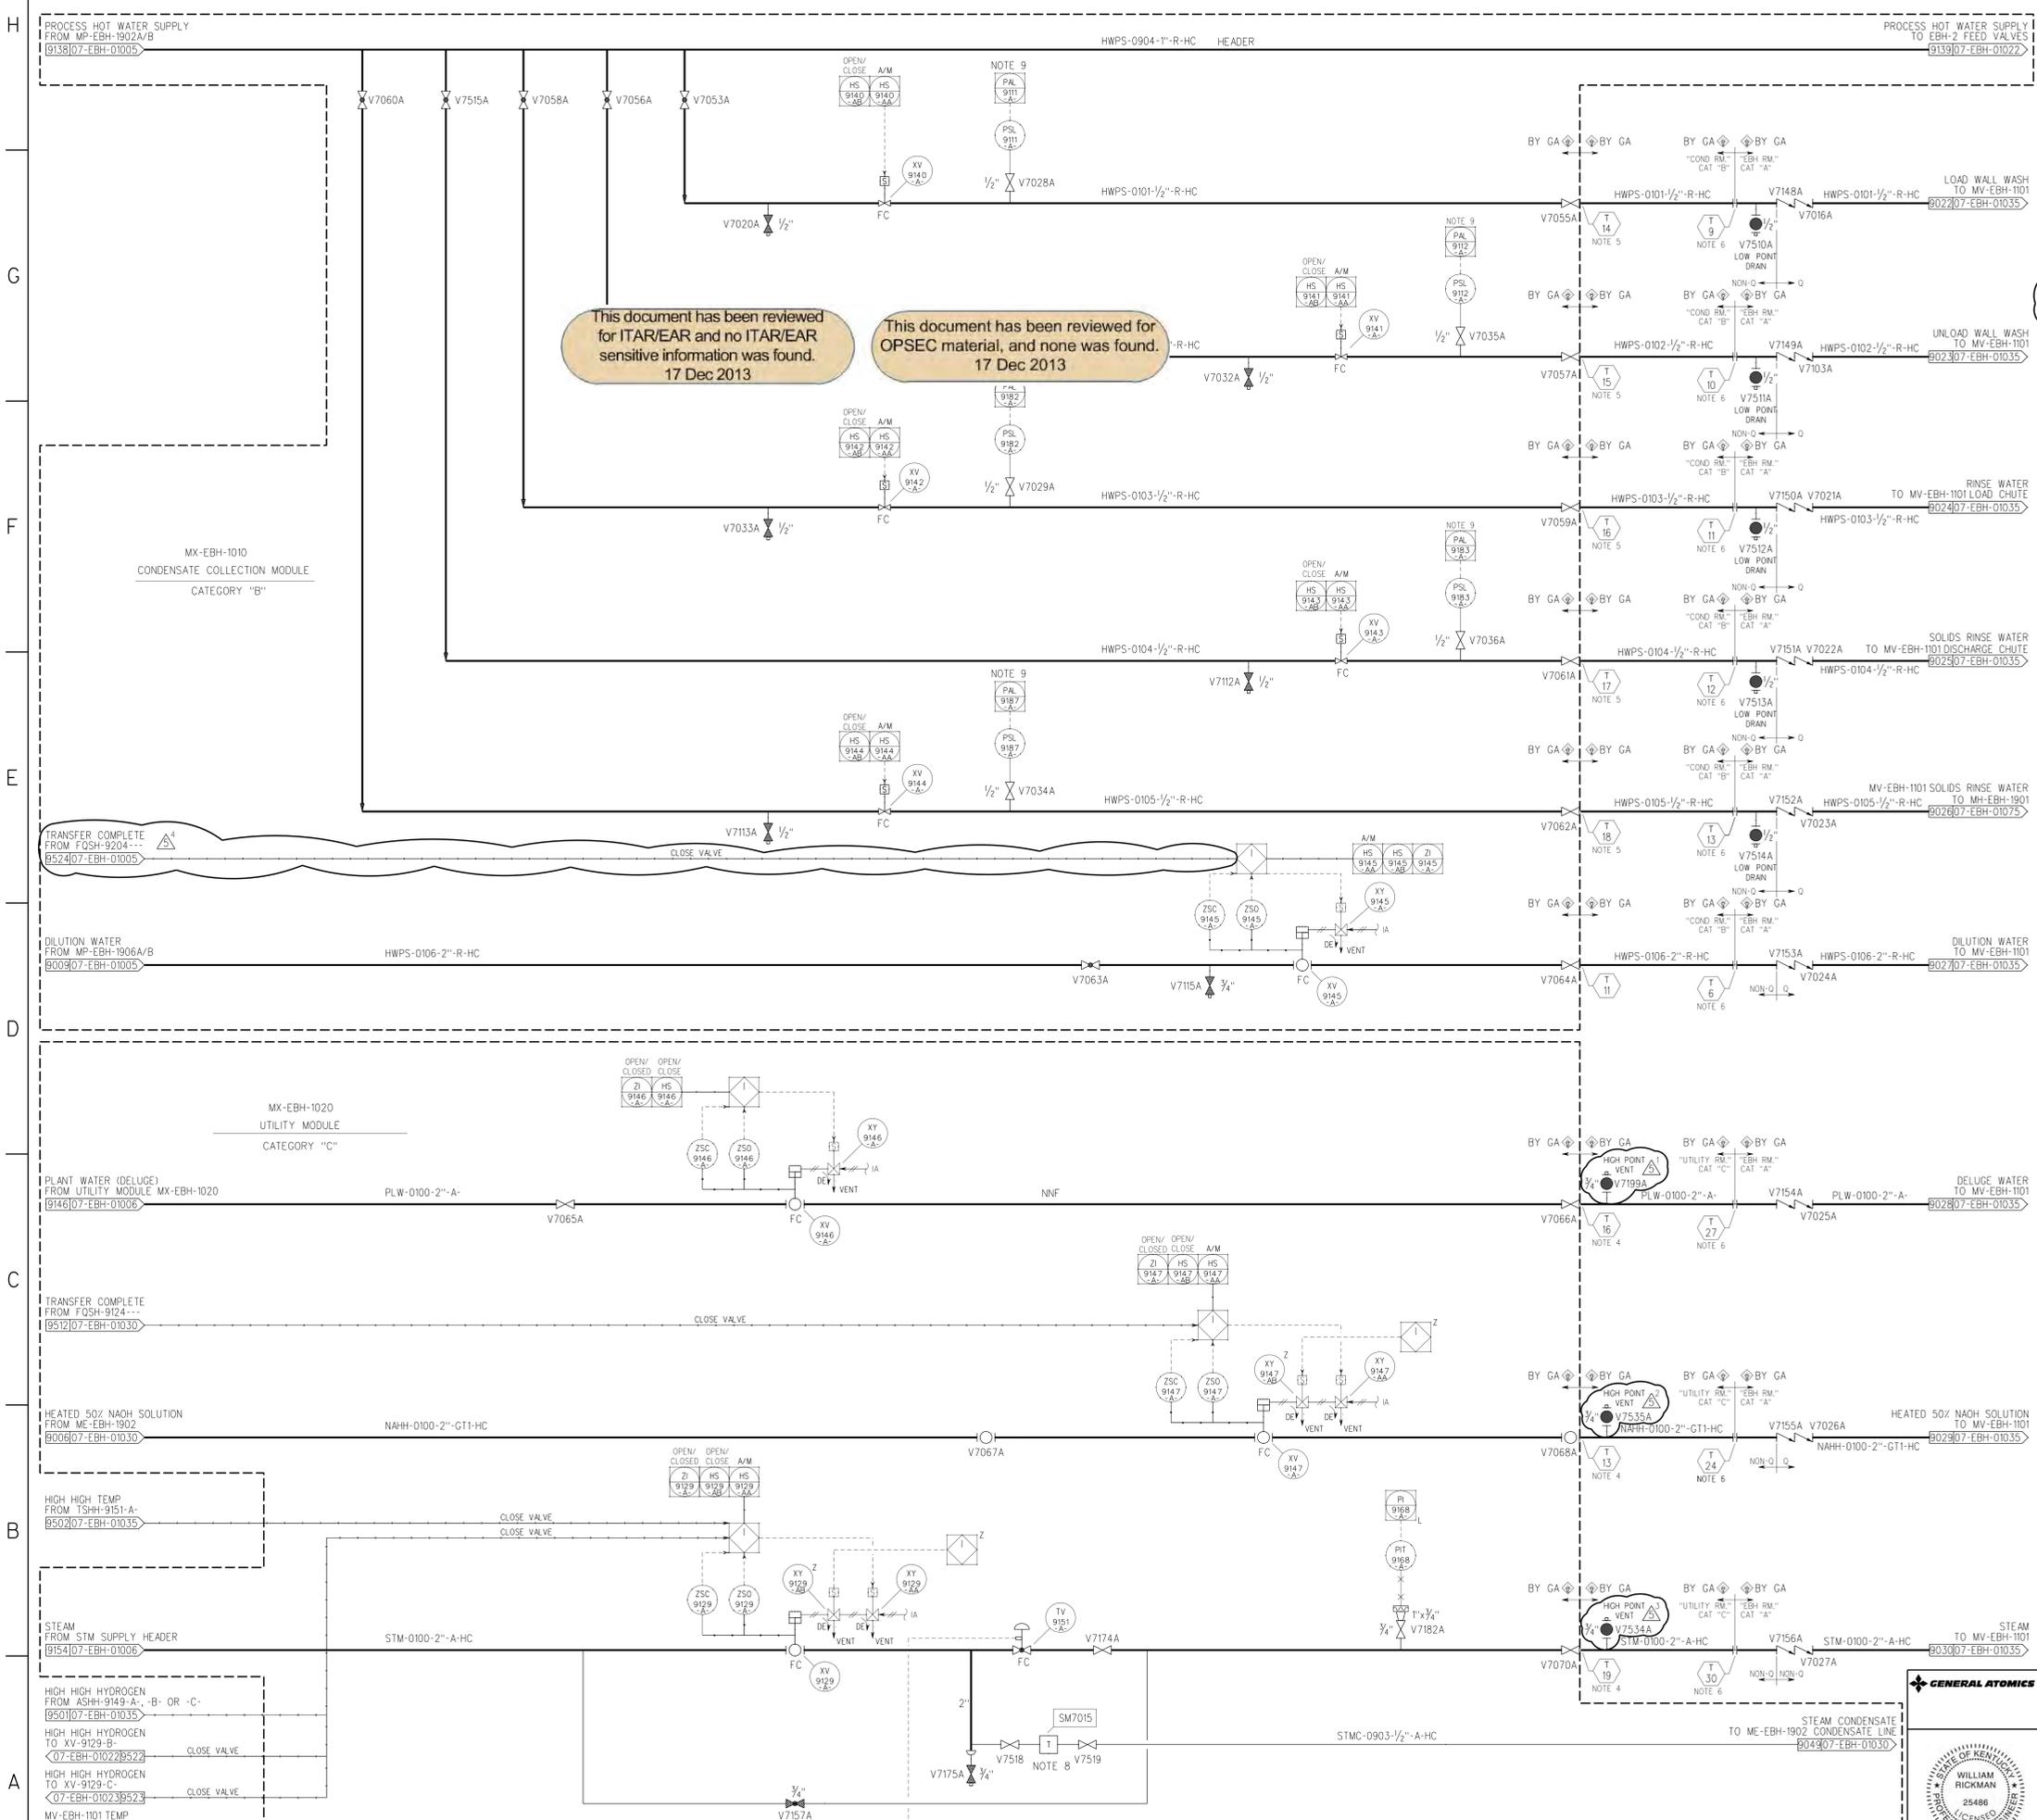

BASED ON BLUE GRASS PFD 24915-07-M5-EBH-00001
 REFERENCE DRAWINGS

CM Aprvd

Issued by Miguel Barabato, G-15, G-General Atomics, Gou-Configuration Management 2010.05.04 14:28:28 -0700

NO.	DATE	DESCRIPTION	DR	CK	DL	PE	IAPPD
1	02/07/06	ISSUED FOR DESIGN	EM	KM	RB	NW	VN
2	05/03/06	ISSUED FOR DESIGN (INCORPORATES COMMENTS)	EM	KM	RB	NW	VN
3	12/19/06	ISSUED FOR CONSTRUCTION (INCORPORATES COMMENTS)	NL	CA	KM	NW	VN
4	07/03/07	FC (INCORPORATES DESIGN DEVELOPMENT AND VENDOR DATA)	NL	CA	KM	NW	VN
5	01/15/09	FC (INCORP. HIGH POINT VENTS)	NL	CA	KM	NW	VN

BECHTEL PARSONS BLUE GRASS

DOD PROGRAM MANAGER FOR ASSEMBLED CHEMICAL WEAPONS ASSESSMENT EDGEWOOD, MARYLAND

US ARMY ENGINEERING AND SUPPORT CENTER, HUNTSVILLE, ALABAMA

BLUE GRASS CHEMICAL AGENT DESTRUCTION PILOT PLANT PROJECT (BGCAPP)

RICHMOND, KENTUCKY

CONTRACT NO. DAAA09-03-D-0023

MUNITIONS DEMILITARIZATION BUILDING EBH UNIT 1 FEED VALVES PIPING & INSTRUMENT DIAGRAM


DRAWING NUMBER: 24915-07-M6-EBH-01021

SHEET: 1 of 1

REV: 5

PROFESSIONAL STAMP: WILLIAM RICKMAN, 25486, LICENSED PROFESSIONAL ENGINEER

07MEBH01021.ppt 05/03/10

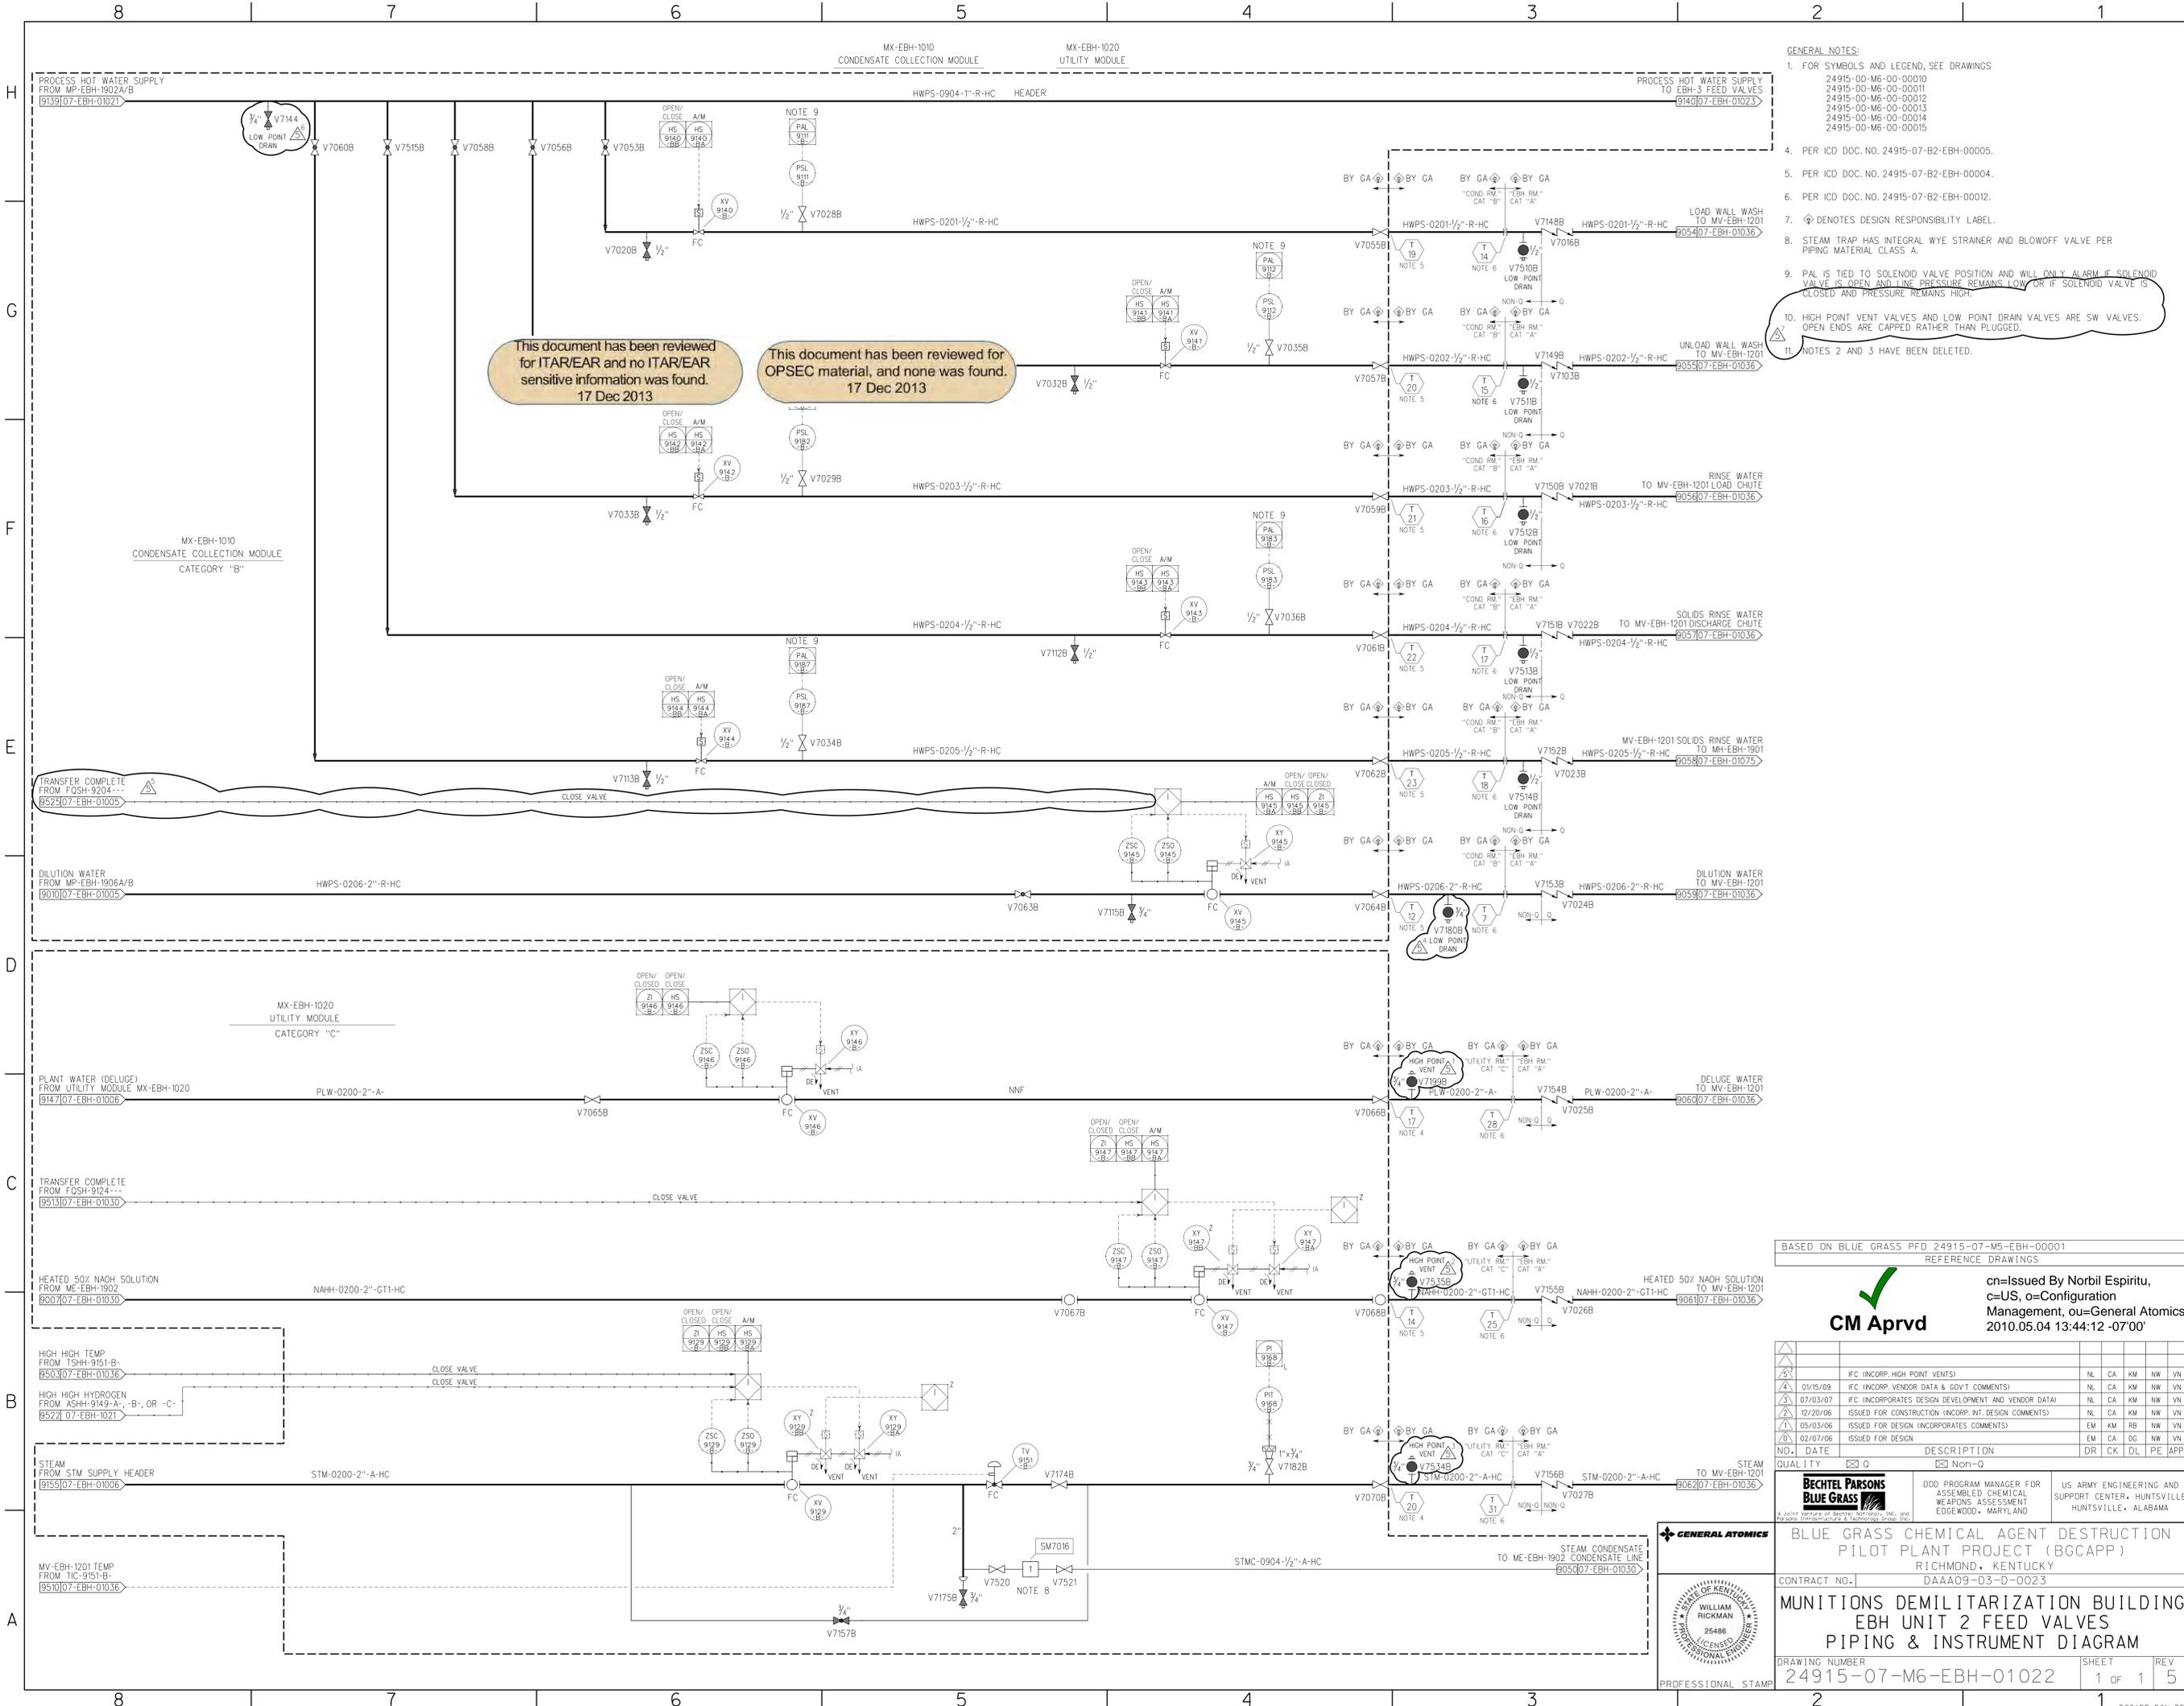

- GENERAL NOTES:**
- FOR SYMBOLS AND LEGEND, SEE DRAWINGS
 - 24915-00-M6-00-00010
24915-00-M6-00-00011
24915-00-M6-00-00012
24915-00-M6-00-00013
24915-00-M6-00-00014
24915-00-M6-00-00015
 - PER ICD DOC. NO. 24915-07-B2-EBH-00005.
 - PER ICD DOC. NO. 24915-07-B2-EBH-00004.
 - PER ICD DOC. NO. 24915-07-B2-EBH-00012.
 - ⊕ DENOTES DESIGN RESPONSIBILITY LABEL.
 - STEAM TRAP HAS INTEGRAL WYE STRAINER AND BLOWOFF VALVE PER PIPING MATERIAL CLASS A.
 - PAL IS TIED TO SOLENOID VALVE POSITION AND WILL ONLY ALARM IF SOLENOID VALVE IS OPEN AND LINE PRESSURE REMAINS LOW OR IF SOLENOID VALVE IS CLOSED AND PRESSURE REMAINS HIGH.
 - HIGH POINT VENT VALVES AND LOW POINT DRAIN VALVES ARE SW VALVES. OPEN ENDS ARE CAPPED RATHER THAN PLUGGED.
 - NOTES 2 AND 3 HAVE BEEN DELETED.

This document has been reviewed for ITAR/EAR and no ITAR/EAR sensitive information was found. 17 Dec 2013

This document has been reviewed for OPSEC material, and none was found. 17 Dec 2013

BASED ON BLUE GRASS PFD 24915-07-M5-EBH-00001
REFERENCE DRAWINGS

CM Aprvd

cn=Issued By Norbil Espiritu,
c=US, o=Configuration Management, ou=General Atomics
2010.05.04 13:44:12 -0700'

NO.	DATE	DESCRIPTION	DR	CK	DL	PE	APPD
1	02/07/06	ISSUED FOR DESIGN					
2	05/03/06	ISSUED FOR DESIGN (INCORPORATES COMMENTS)	EM	KM	RB	NW	VN
3	12/20/06	ISSUED FOR CONSTRUCTION (INCORP. INT. DESIGN COMMENTS)	NL	CA	KM	NW	VN
4	07/03/07	IFC (INCORPORATES DESIGN DEVELOPMENT AND VENDOR DATA)	NL	CA	KM	NW	VN
5	01/15/09	IFC (INCORP. HIGH POINT VENTS)	NL	CA	KM	NW	VN

BECHTEL PARSONS BLUE GRASS

DOD PROGRAM MANAGER FOR ASSEMBLED CHEMICAL WEAPONS ASSESSMENT EDGEWOOD, MARYLAND

US ARMY ENGINEERING AND SUPPORT CENTER, HUNTSVILLE HUNTSVILLE, ALABAMA

GENERAL ATOMICS

BLUE GRASS CHEMICAL AGENT DESTRUCTION PILOT PLANT PROJECT (BGCAPP)
RICHMOND, KENTUCKY


CONTRACT NO. DAAA09-03-D-0023

MUNITIONS DEMILITARIZATION BUILDING EBH UNIT 2 FEED VALVES PIPING & INSTRUMENT DIAGRAM

DRAWING NUMBER: 24915-07-M6-EBH-01022
SHEET: 1 of 1
REV: 5

PROFESSIONAL STAMP: WILLIAM RICKMAN, 25486, LICENSED PROFESSIONAL ENGINEER, STATE OF KENTUCKY

07MEBH1022.ppt 05/03/10

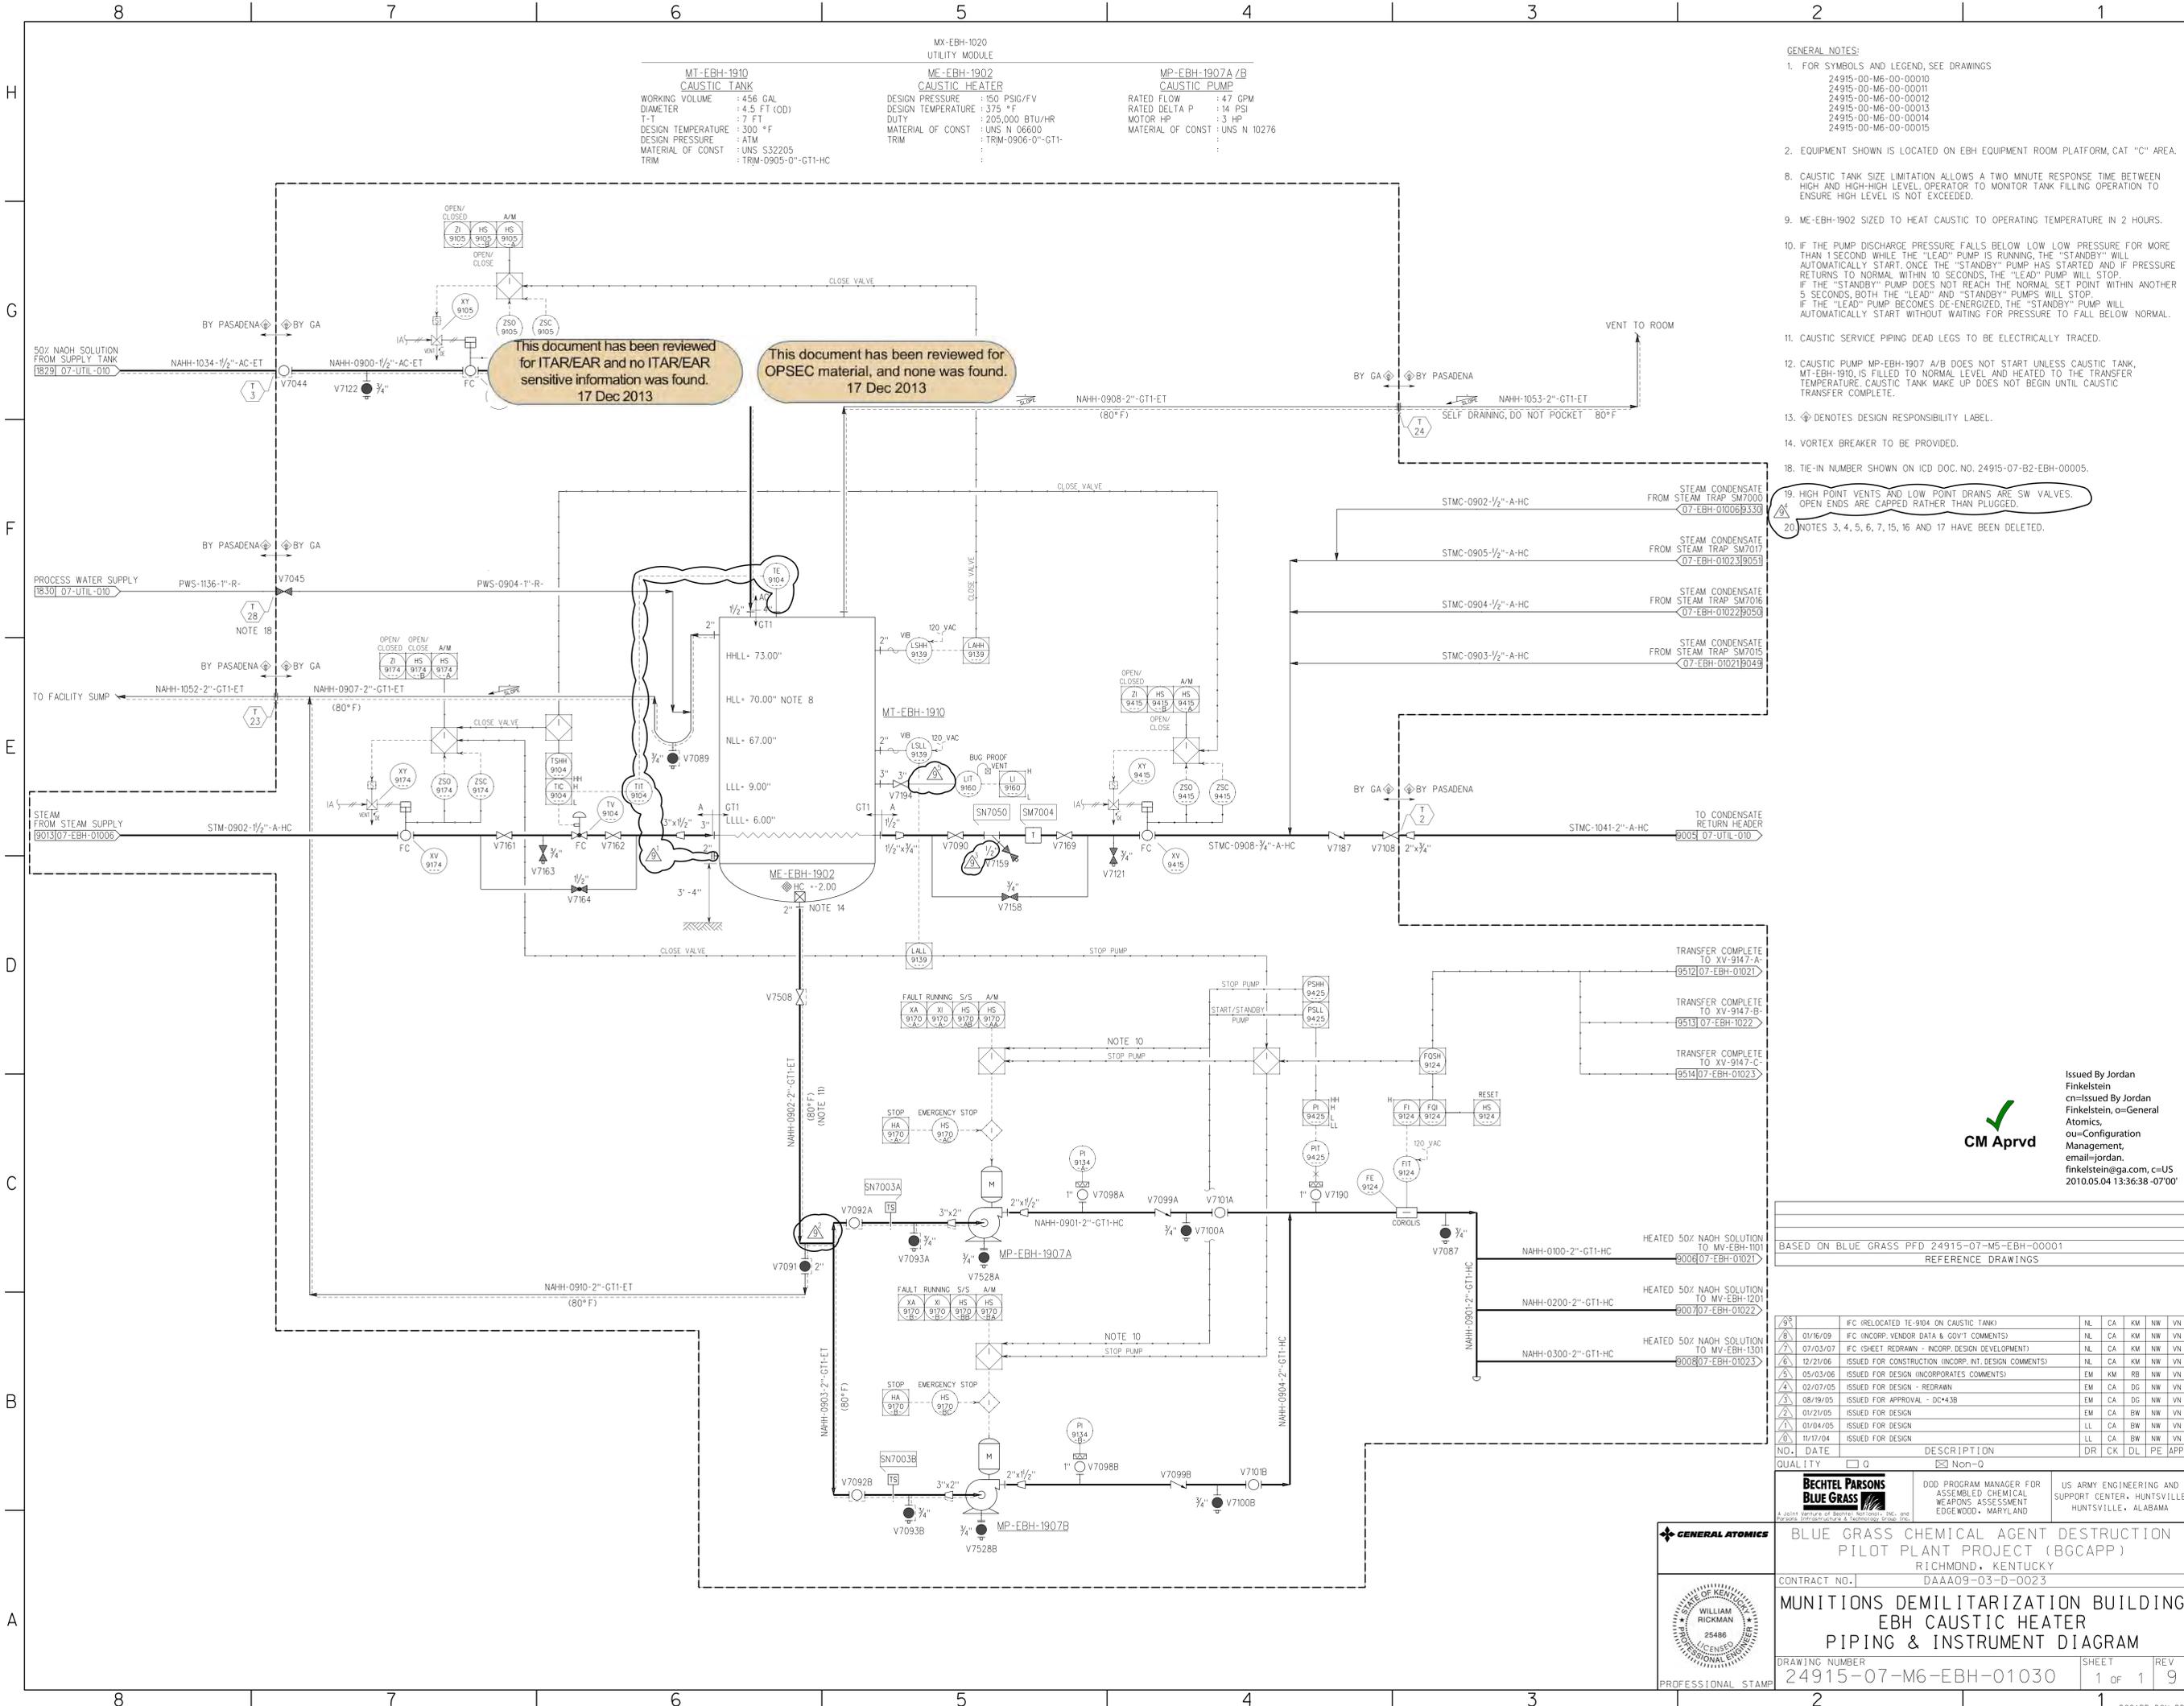

- GENERAL NOTES:**
- FOR SYMBOLS AND LEGEND, SEE DRAWINGS
24915-00-M6-00-00010
24915-00-M6-00-00011
24915-00-M6-00-00012
24915-00-M6-00-00013
24915-00-M6-00-00014
24915-00-M6-00-00015
 - EQUIPMENT SHOWN IS LOCATED ON EBH EQUIPMENT ROOM PLATFORM, CAT "C" AREA.
 - CAUSTIC TANK SIZE LIMITATION ALLOWS A TWO MINUTE RESPONSE TIME BETWEEN HIGH AND HIGH-HIGH LEVEL, OPERATOR TO MONITOR TANK FILLING OPERATION TO ENSURE HIGH LEVEL IS NOT EXCEEDED.
 - ME-EBH-1902 SIZED TO HEAT CAUSTIC TO OPERATING TEMPERATURE IN 2 HOURS.
 - IF THE PUMP DISCHARGE PRESSURE FALLS BELOW LOW LOW PRESSURE FOR MORE THAN 1 SECOND WHILE THE "LEAD" PUMP IS RUNNING, THE "STANDBY" PUMP WILL AUTOMATICALLY START, ONCE THE "STANDBY" PUMP HAS STARTED AND IF PRESSURE RETURNS TO NORMAL WITHIN 10 SECONDS, THE "LEAD" PUMP WILL STOP. IF THE "STANDBY" PUMP DOES NOT REACH THE NORMAL SET POINT WITHIN ANOTHER 5 SECONDS, BOTH THE "LEAD" AND "STANDBY" PUMPS WILL STOP. IF THE "LEAD" PUMP BECOMES DE-ENERGIZED, THE "STANDBY" PUMP WILL AUTOMATICALLY START WITHOUT WAITING FOR PRESSURE TO FALL BELOW NORMAL.
 - CAUSTIC SERVICE PIPING DEAD LEGS TO BE ELECTRICALLY TRACED.
 - CAUSTIC PUMP MP-EBH-1907 A/B DOES NOT START UNLESS CAUSTIC TANK, MT-EBH-1910, IS FILLED TO NORMAL LEVEL AND HEATED TO THE TRANSFER TEMPERATURE. CAUSTIC TANK MAKE UP DOES NOT BEGIN UNTIL CAUSTIC TRANSFER COMPLETE.
 - ◇ DENOTES DESIGN RESPONSIBILITY LABEL.
 - VORTEX BREAKER TO BE PROVIDED.
 - TIE-IN NUMBER SHOWN ON ICD DOC. NO. 24915-07-B2-EBH-00005.
 - HIGH POINT VENTS AND LOW POINT DRAINS ARE SW VALVES. OPEN ENDS ARE CAPPED RATHER THAN PLUGGED.
 - NOTES 3, 4, 5, 6, 7, 15, 16 AND 17 HAVE BEEN DELETED.

Issued By Jordan Finkelstein
 cn=Issued By Jordan Finkelstein, o=General Atomics, ou=Configuration Management, email=jordan.finkelstein@ga.com, c=US 2010.05.04 13:36:38 -0700

CM Aprvd

BASED ON BLUE GRASS PFD 24915-07-M5-EBH-00001
 REFERENCE DRAWINGS

NO.	DATE	DESCRIPTION	DR	CK	DL	PE	APPD
8	01/16/09	FC (RELOCATED TE-9104 ON CAUSTIC TANK)	NL	CA	KM	NW	VN
7	07/03/07	FC (INCORP. VENDOR DATA & GOVT. COMMENTS)	NL	CA	KM	NW	VN
6	12/21/06	FC (SHEET REDRAWN - INCORP. DESIGN DEVELOPMENT)	NL	CA	KM	NW	VN
5	05/03/06	ISSUED FOR CONSTRUCTION (INCORP. INT. DESIGN COMMENTS)	NL	CA	KM	NW	VN
4	02/07/05	ISSUED FOR DESIGN - REDRAWN	EM	CA	DC	NW	VN
3	08/19/05	ISSUED FOR APPROVAL - DC+3B	EM	CA	DC	NW	VN
2	01/21/05	ISSUED FOR DESIGN	EM	CA	BW	NW	VN
1	01/04/05	ISSUED FOR DESIGN	LL	CA	BW	NW	VN
0	11/17/04	ISSUED FOR DESIGN	LL	CA	BW	NW	VN

QUALITY 0 Non-0

BECHTEL PARSONS BLUE GRASS

DOD PROGRAM MANAGER FOR ASSEMBLED CHEMICAL WEAPONS ASSESSMENT EDGEWOOD, MARYLAND


US ARMY ENGINEERING AND SUPPORT CENTER, HUNTSVILLE HUNTSVILLE, ALABAMA

BLUE GRASS CHEMICAL AGENT DESTRUCTION PILOT PLANT PROJECT (BGCAPP)
 RICHMOND, KENTUCKY
 DAAA09-03-D-0023

MUNITIONS DEMILITARIZATION BUILDING EBH CAUSTIC HEATER PIPING & INSTRUMENT DIAGRAM

CONTRACT NO. 24915-07-M6-EBH-01030

DRAWING NUMBER 24915-07-M6-EBH-01030 SHEET 1 of 1 REV 9

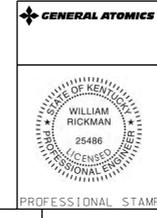


07MEBH1030.ppt 05/03/10

MV-EBH-1101 ENERGETICS BATCH HYDROLYZER DRUM	MD-EBH-1101 EBH DISCHARGE GATE	MD-EBH-1110 EBH INLET GATE
WORKING VOLUME : 754 GAL	MATERIAL OF CONST : 316/316L SS	MATERIAL OF CONST : 316/316L SS
DIAMETER : 90 IN (OD)		
LENGTH : 124.5 IN		
DESIGN TEMPERATURE : 375 °F		
DESIGN PRESSURE : 1 ATM		
DESIGN TEMP (JACKET) : 375 °F		
DESIGN PRESS (JACKET) : 150 PSIG/FV		
MOTOR HP : 5 HP		
MATERIAL OF CONST : UNS S32205		

- GENERAL NOTES:**
- FOR SYMBOLS AND LEGEND, SEE DRAWINGS
 - EQUIPMENT SHOWN IS LOCATED IN EBH ROOM, CAT "A" AREA
 - BN-IN-POSITION SWITCH.
 - MUNITION LOADING FROM TRANSFER ROBOT.
 - STOP MUNITIONS FEED ON HIGH H2 ALARM (AE-9149-A) AND PURGE EBH ON HIGH-HIGH H2 ALARM (AE-9149-A, WITH BACKUP AE-9132-A AT HIGHER SETPOINT).
 - EBH CONTROLS LOCATED OUTSIDE OF EBH ROOM.
 - LINE HAS TWO FLOW RATES DEPENDING ON MUNITIONS CAMPAIGN, AS ROCKET WARHEADS REQUIRE HIGHER VENTILATION RATE THAN H PROJECTILES.
 - EBH WEIGHT SIGNAL USED FOR BATCH LEVEL CONTROL VIA WALL WASH SPRAY.
 - UPON LOSS OF EBH REACTOR VENTILATION FLOW DURING LOADING OR PROCESSING OF WHs:
 - MUNITION FEED HALTS.
 - VENTILATION DAMPER (XV-9152-A) CLOSES AND XV-9178A-- OPENS.
 - OXYGEN (FROM ROOM AIR) IS PURGED FROM REACTOR BY INTRODUCTION OF NITROGEN GAS AT HIGH FLOW RATE (3000 SCFM FOR ONE MINUTE).
 - FOLLOWING OXYGEN PURGE, EBH INLET GATE (MD-EBH-1101) CLOSES AND NITROGEN FLOW RATE IS REDUCED TO TRICKLE FLOW (50 SCFM) UNTIL OTE IS RESTORED TO MAINTAIN INERT, OXYGEN-FREE ATMOSPHERE WITHIN THE REACTOR.
 - UPON RESTORATION OF THE OFF-GAS TREATMENT SYSTEM AND PRIOR TO VENTILATION DAMPER OPENING, HYDROGEN WILL BE PURGED FROM THE REACTOR WITH AN INCREASE IN FLOW OF NITROGEN GAS (3000 SCFM FOR ONE MINUTE) FOR SIX VOLUME CHANGES.
 - DRIVE MOTOR PURGE PANEL, TYPE Z.
 - IF THE HYDROLYSATE COLLECTION TANK REACHES HIGH-HIGH LEVEL AND THE EBH IS UNLOADING (DRAINING HYDROLYSATE), THE FCS SHALL STOP THE EBH MOTOR.
 - * DENOTES VENDOR SUPPLIED.
 - VFD IS BY PASADENA.
 - INCLUDE FLANGED CONNECTIONS IN OTE VENT PIPING FOR EASE OF ASSEMBLY AND DISASSEMBLY.
 - ELECTRICAL AREA CLASSIFICATION:
 - DIVISION 1, GROUP B, INSIDE EBH DRUM
 - DIVISION 2, GROUP B, OUTSIDE EBH DRUM
 - PER ICD DDC NO. 24915-07-B2-EBH-00001.
 - XV-9178-A TO OPEN WHEN XV-9152-A CLOSES TO PREVENT THE BUILD-UP OF HYDROGEN IN THE EBH VENT LINE.
 - ☐ DENOTES DESIGN RESPONSIBILITY LABEL.
 - NITROGEN PURGE SIGNAL IS PROVIDED TO HVAC TO CONTROL ROOM AIR FLOW TO MAINTAIN NEGATIVE PRESSURE IN EBH ROOM DURING PURGE.
 - QUALITY LEVEL BOUNDARY FROM Q TO NON-Q REQUIRED AT THE END USER DEVICE WHEN THE END USER DEVICE IS Q.
 - DISCHARGE GATE TO BE INTERLOCKED CLOSED DURING LOADING AND PROCESSING TO MAINTAIN AIR CIRCULATION THROUGH EBH DRUM.
 - V7136A POSITION SHALL BE ADJUSTED AS NEEDED TO BALANCE THE VENT FLOW BETWEEN THE EBHS AND TO REDUCE THE TOTAL VENT FLOW RATE DURING THE H CAMPAIGN.
 - UPON EMERGENCY SHUTDOWN SIGNAL FROM OPERATOR, ALL EBH OPERATIONS CEASE EXCEPT FOR DRUM ROTATION, AND NITROGEN PURGE IS INITIATED FOR EBHS PROCESSING ROCKETS AND TURNING IN FORWARD DIRECTION.
 - STEAM TRAP HAS INTEGRAL WYE STRAINER AND BLOWOFF VALVE PER PIPING MATERIAL CLASS A.
 - SEE HVAC PIDS 24915-07-M6-HVAC-00131 AND 24915-07-M6-HVAC-00132.
 - INSTRUMENT AIR LINES ARE "NON-Q".
 - EBH MUST BE ABOVE LOW TEMPERATURE ALARM SETPOINT TO INITIATE MUNITIONS FEED. STOP MUNITIONS FEED BELOW LOW-LOW TEMPERATURE SETPOINT. EBH MUST OPERATE AT NORMAL SETPOINT FOR SPECIFIED TIME BEFORE DISCHARGE OF RESIDUES AND HYDROLYSATE. TEMPERATURE BELOW NORMAL SETPOINT DEAD BAND STOPS HYDROLYSIS TIMER UNTIL TEMPERATURE IS RESTORED.
 - HIGH POINT VENT VALVES AND LOW POINT DRAIN VALVES ARE SW VALVES. OPEN ENDS ARE CAPPED RATHER THAN PLUGGED.
 - LOADING OF AN EBH IS PROHIBITED IF A FULL BATCH HAS ALREADY BEEN LOADED.
 - LOADING OF EBH DURING LEAKER AND CONTAMINATED PROTECTION SHALL ONLY BE DONE UNDER SUPERVISORY CONTROL AS AN ADDITIONAL PROTECTION TO PREVENT MIXING OF ROCKET MOTORS AND WARHEADS IN AN EBH.
 - "EBH ACTIVE" IDENTIFIER FOR FPS SHUTDOWNS IN NITROGEN PURGE.
 - NOTES 3, 4, 6, 7, 15, 16, 23, 25, 26, 28, 29, 30, 31 AND 35 HAVE BEEN DELETED.

This document has been reviewed for ITAR/EAR and no ITAR/EAR sensitive information was found. 17 Dec 2013

This document has been reviewed for OPSEC material, and none was found. 17 Dec 2013

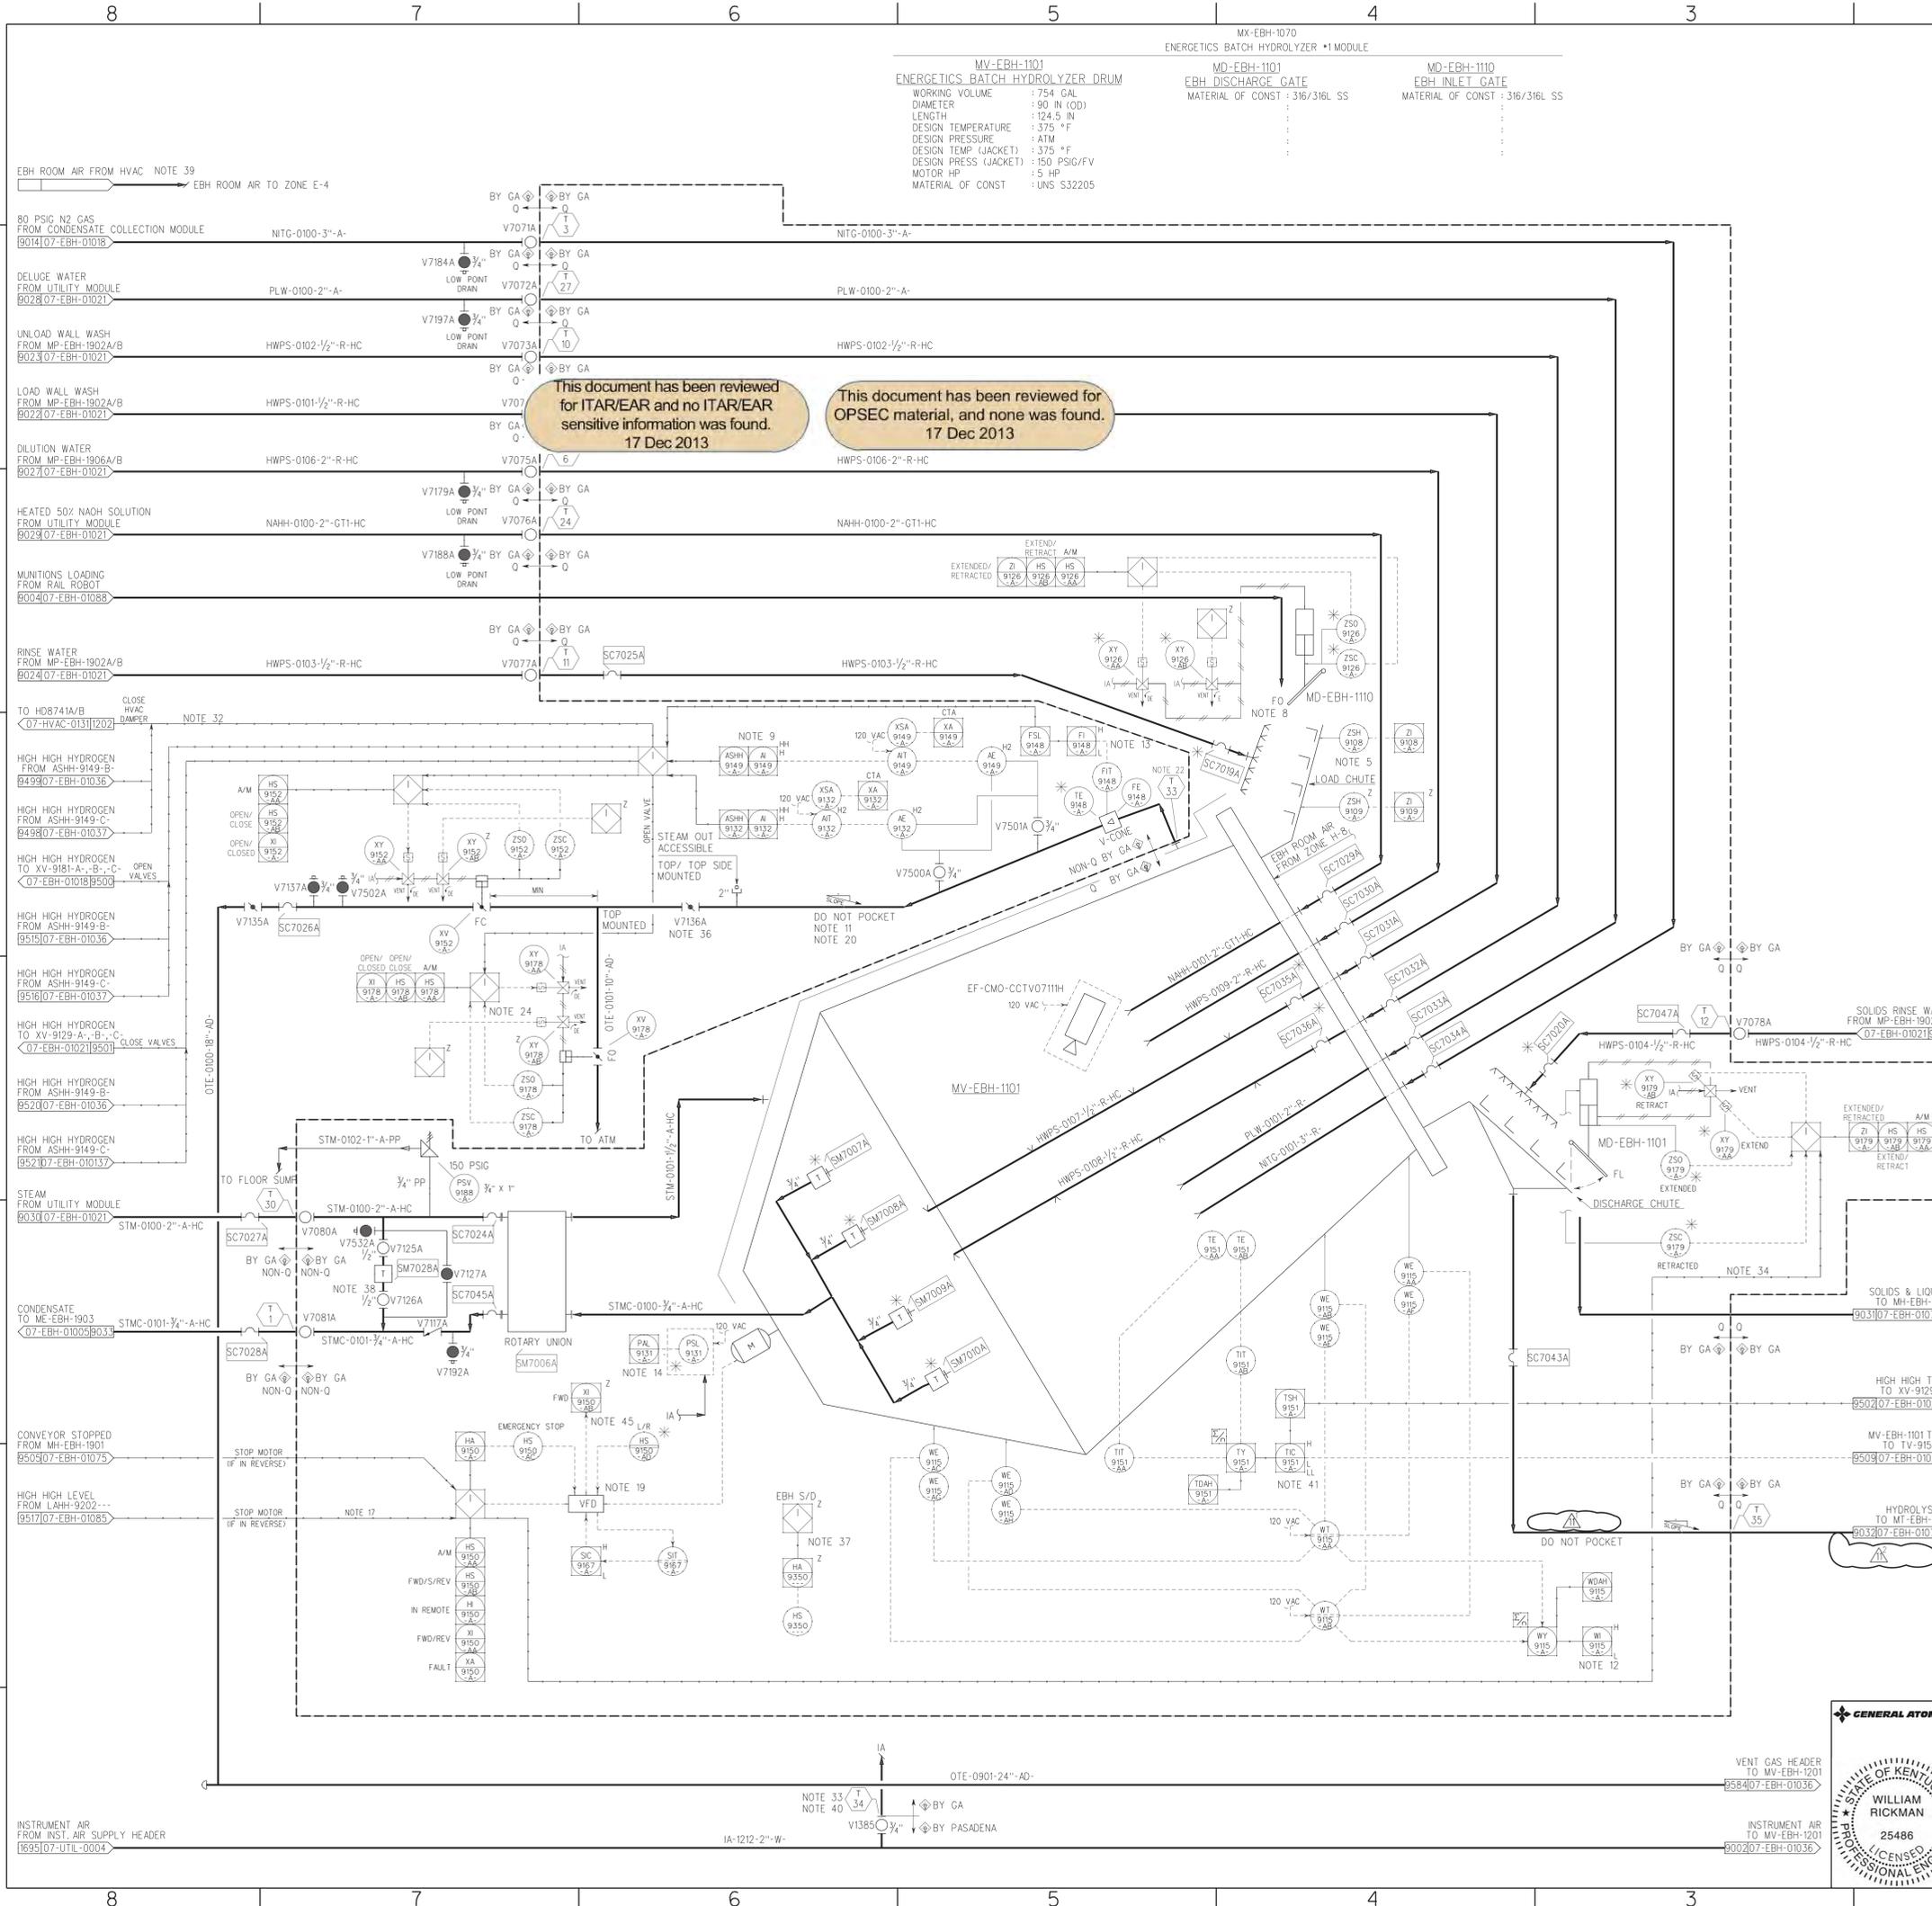

BASED ON BLUE GRASS PFD 24915-07-M5-EBH-00001

REFERENCE DRAWINGS

NO.	DATE	DESCRIPTION	DR	CK	DL	PE	APPD
1	11/18/04	ISSUED FOR DESIGN					
2	01/04/05	ISSUED FOR DESIGN					
3	01/21/05	ISSUED FOR DESIGN					
4	08/19/05	ISSUED FOR APPROVAL - DC-43B					
5	05/03/06	ISSUED FOR DESIGN (INCORPORATES COMMENTS)					
6	12/20/06	ISSUED FOR CONSTRUCTION (INCORP. INT. DESIGN COMMENTS)					
7	07/03/07	FC (SHEET REDRAWN - INCORP. DESIGN DEVELOPMENT)					
8	01/15/09	FC (INCORP. VENDOR DATA & GOVT. COMMENTS)					
9	05/04/10	FC (INCORP. AS-BUILT MODULE CHANGES)					
10	03/18/11	FC (INCORP. FCR-1393)					
11	03/18/11	FC (INCORP. DCN-217)					

BECHTEL PARSONS BLUE GRASS

DOD PROGRAM MANAGER FOR ASSEMBLED CHEMICAL WEAPONS ASSESSMENT EDGEWOOD, MARYLAND

US ARMY ENGINEERING AND SUPPORT CENTER, HUNTSVILLE HUNTSVILLE, ALABAMA

BLUE GRASS CHEMICAL AGENT DESTRUCTION PILOT PLANT PROJECT (BGCAPP)

RICHMOND, KENTUCKY

CONTRACT NO. DAAA09-03-D-0023

MUNITIONS DEMILITARIZATION BUILDING EBH UNIT 1 PIPING & INSTRUMENT DIAGRAM

DRAWING NUMBER: 24915-07-M6-EBH-01035

SHEET: 1 of 1


REV: 11

WILLIAM RICKMAN 25486 LICENSED PROFESSIONAL ENGINEER

GENERAL ATOMICS

07MEBH0135.ppt 07/07/13

MV-EBH-1201 ENERGETICS BATCH HYDROLYZER DRUM	MD-EBH-1201 EBH DISCHARGE GATE	MD-EBH-1210 EBH INLET GATE
WORKING VOLUME : 754 GAL	MATERIAL OF CONST : 316/316L SS	MATERIAL OF CONST : 316/316L SS
DIAMETER : 90 IN (OD)		
LENGTH : 124.5 IN		
DESIGN TEMPERATURE : 375 °F		
DESIGN PRESSURE : ATM		
DESIGN TEMP (JACKET) : 375 °F		
DESIGN PRESS (JACKET) : 150 PSIG/FV		
MOTOR HP : 5 HP		
MATERIAL OF CONST : UNS S32205		

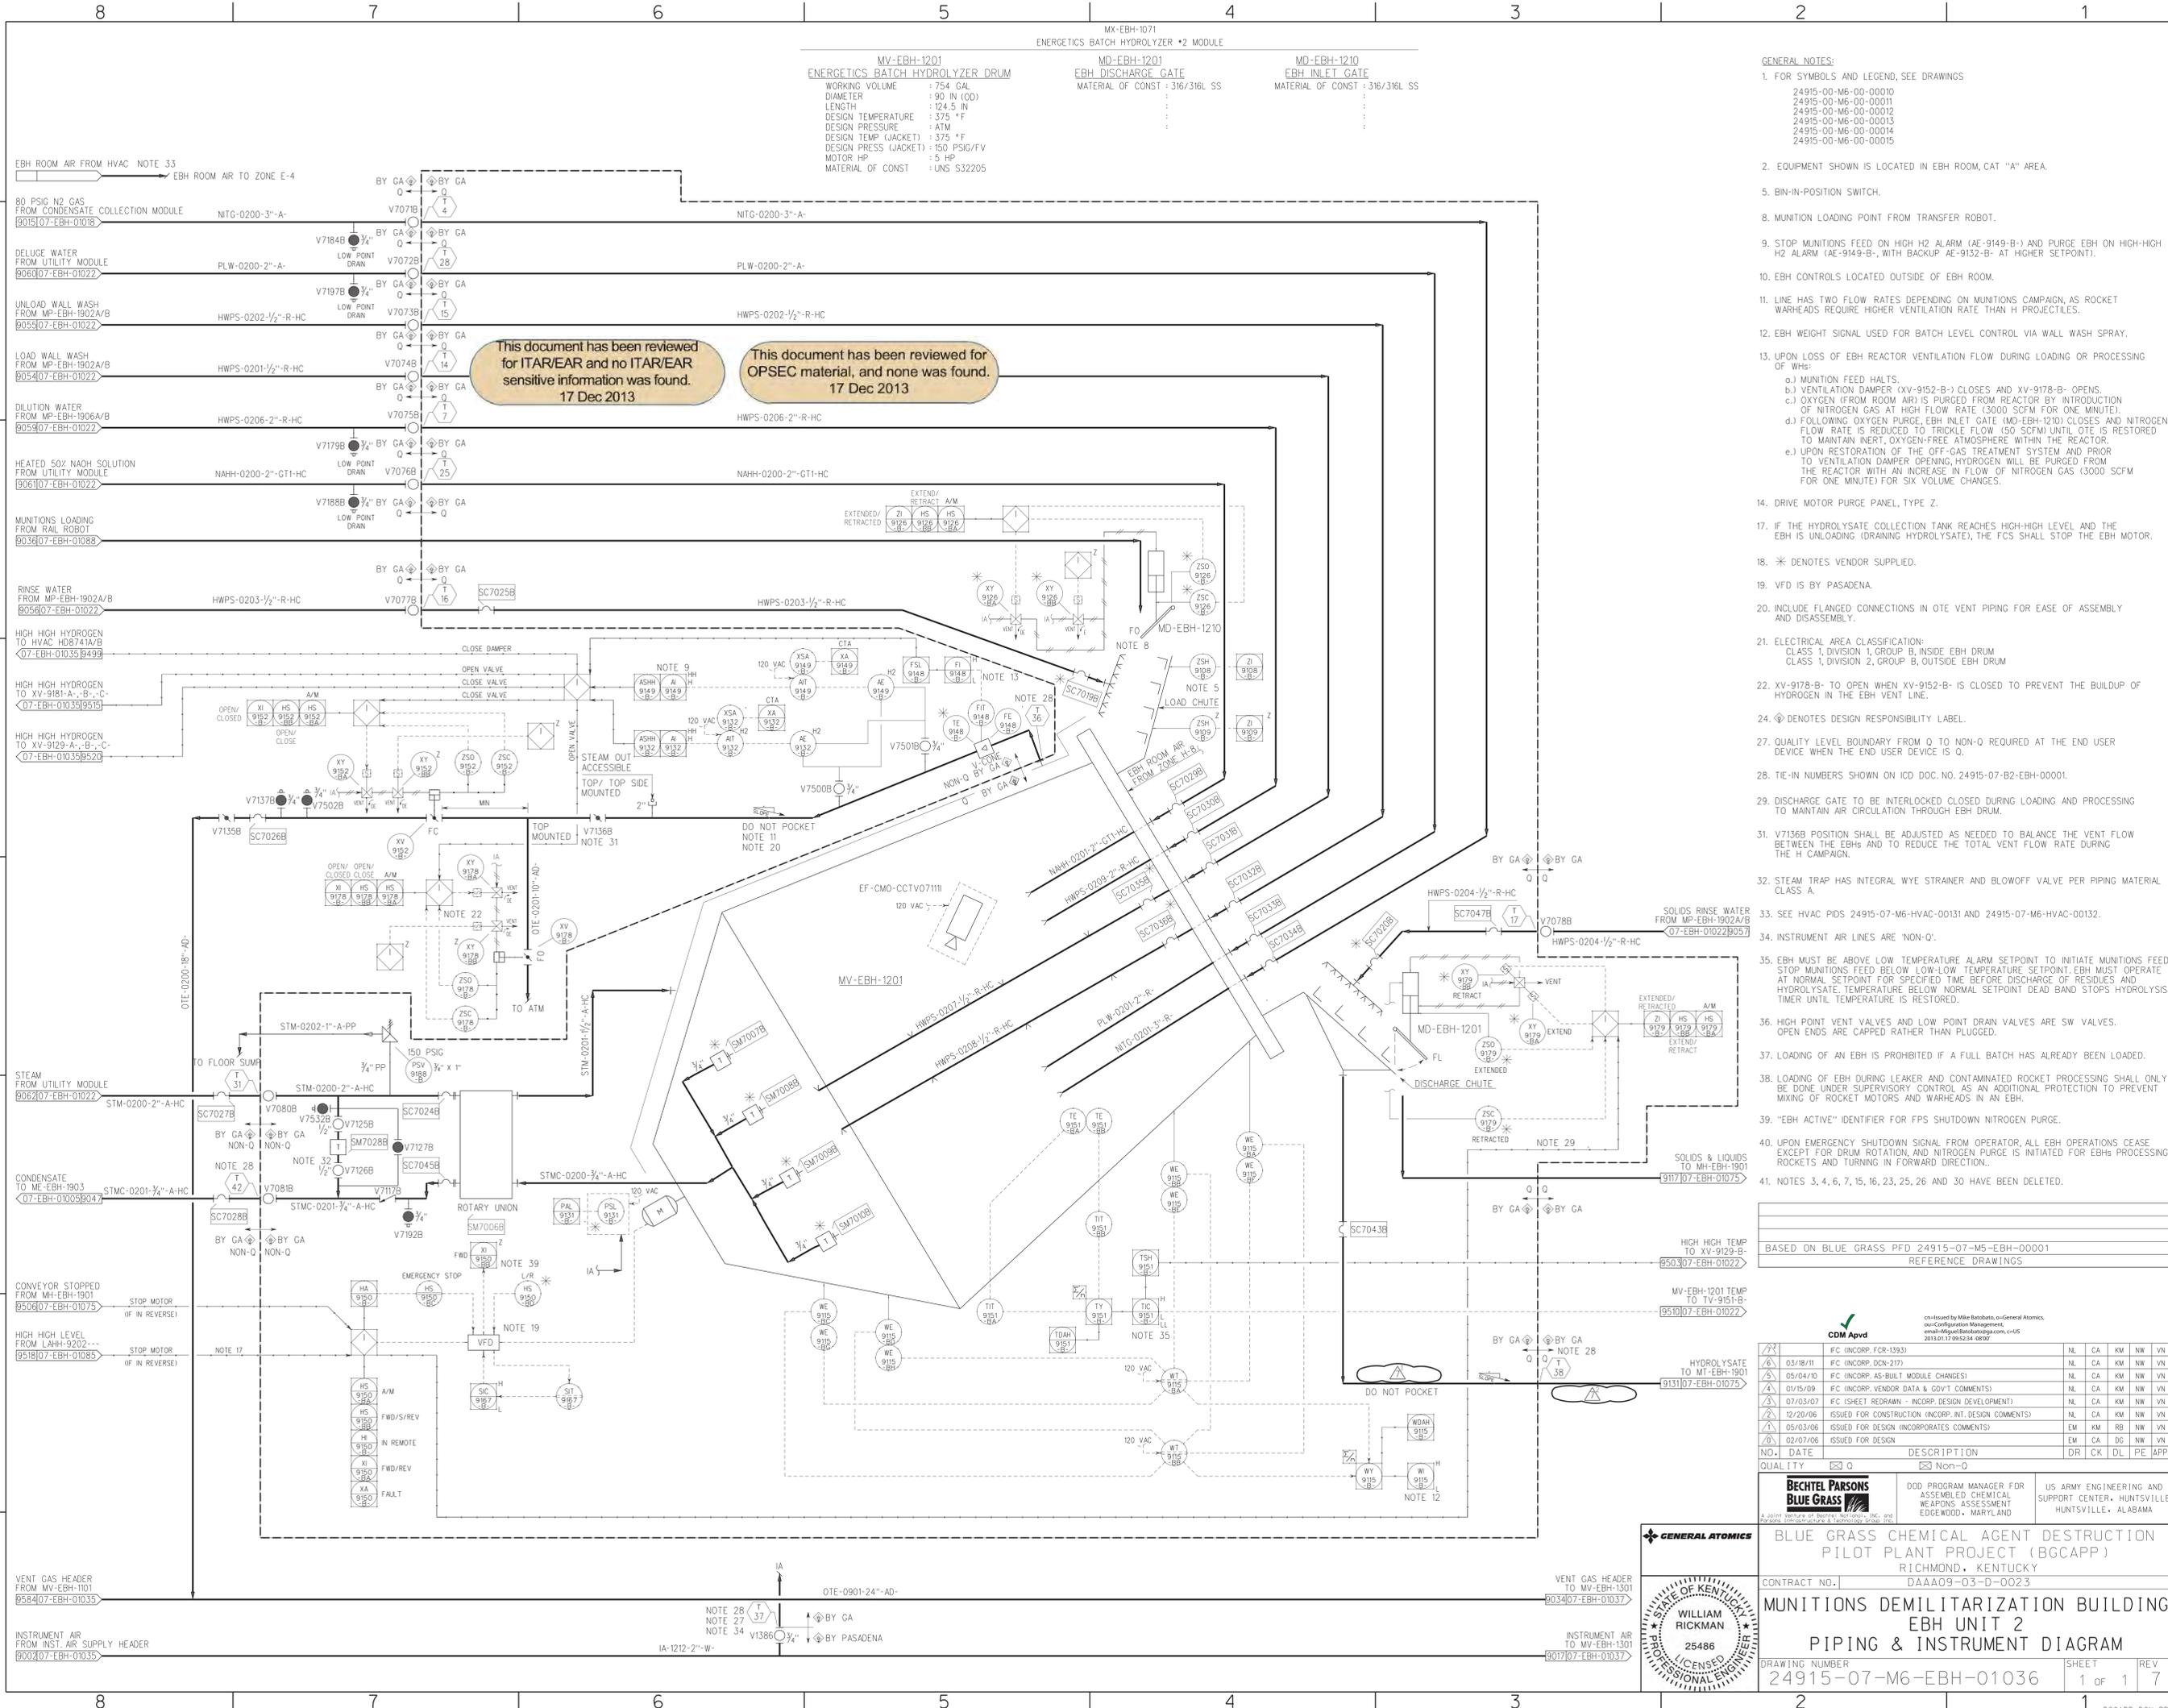

This document has been reviewed for ITAR/EAR and no ITAR/EAR sensitive information was found. 17 Dec 2013

This document has been reviewed for OPSEC material, and none was found. 17 Dec 2013

- GENERAL NOTES:**
- FOR SYMBOLS AND LEGEND, SEE DRAWINGS
 - EQUIPMENT SHOWN IS LOCATED IN EBH ROOM, CAT "A" AREA.
 - BIN-IN-POSITION SWITCH.
 - MUNITION LOADING POINT FROM TRANSFER ROBOT.
 - STOP MUNITIONS FEED ON HIGH H2 ALARM (AE-9149-B) AND PURGE EBH ON HIGH-HIGH H2 ALARM (AE-9149-B, WITH BACKUP AE-9132-B AT HIGHER SETPOINT).
 - EBH CONTROLS LOCATED OUTSIDE OF EBH ROOM.
 - LINE HAS TWO FLOW RATES DEPENDING ON MUNITIONS CAMPAIGN, AS ROCKET WARHEADS REQUIRE HIGHER VENTILATION RATE THAN H PROJECTILES.
 - EBH WEIGHT SIGNAL USED FOR BATCH LEVEL CONTROL VIA WALL WASH SPRAY.
 - UPON LOSS OF EBH REACTOR VENTILATION FLOW DURING LOADING OR PROCESSING OF WHS:
 - MUNITION FEED HALTS.
 - VENTILATION DAMPER (XV-9152-B) CLOSES AND XV-9178-B OPENS.
 - OXYGEN (FROM ROOM AIR) IS PURGED FROM REACTOR BY INTRODUCTION OF NITROGEN GAS AT HIGH FLOW RATE (3000 SCFM FOR ONE MINUTE).
 - FOLLOWING OXYGEN PURGE, EBH INLET GATE (MD-EBH-1210) CLOSES AND NITROGEN FLOW RATE IS REDUCED TO TRICKLE FLOW (50 SCFM) UNTIL OTE IS RESTORED TO MAINTAIN INERT, OXYGEN-FREE ATMOSPHERE WITHIN THE REACTOR.
 - UPON RESTORATION OF THE OFF-GAS TREATMENT SYSTEM AND PRIOR TO VENTILATION DAMPER OPENING, HYDROGEN WILL BE PURGED FROM THE REACTOR WITH AN INCREASE IN FLOW OF NITROGEN GAS (3000 SCFM FOR ONE MINUTE) FOR SIX VOLUME CHANGES.
 - DRIVE MOTOR PURGE PANEL, TYPE Z.
 - IF THE HYDROLYSATE COLLECTION TANK REACHES HIGH-HIGH LEVEL AND THE EBH IS UNLOADING (DRAINING HYDROLYSATE), THE FCS SHALL STOP THE EBH MOTOR.
 - * DENOTES VENDOR SUPPLIED.
 - VFD IS BY PASADENA.
 - INCLUDE FLANGED CONNECTIONS IN OTE VENT PIPING FOR EASE OF ASSEMBLY AND DISASSEMBLY.
 - ELECTRICAL AREA CLASSIFICATION:
 - CLASS 1, DIVISION 1, GROUP B, INSIDE EBH DRUM
 - CLASS 1, DIVISION 2, GROUP B, OUTSIDE EBH DRUM
 - XV-9178-B TO OPEN WHEN XV-9152-B IS CLOSED TO PREVENT THE BUILDUP OF HYDROGEN IN THE EBH VENT LINE.
 - ◇ DENOTES DESIGN RESPONSIBILITY LABEL.
 - QUALITY LEVEL BOUNDARY FROM Q TO NON-Q REQUIRED AT THE END USER DEVICE WHEN THE END USER DEVICE IS Q.
 - TI-NUMBERS SHOWN ON ICD DOC. NO. 24915-07-B2-EBH-00001.
 - DISCHARGE GATE TO BE INTERLOCKED CLOSED DURING LOADING AND PROCESSING TO MAINTAIN AIR CIRCULATION THROUGH EBH DRUM.
 - V7136B POSITION SHALL BE ADJUSTED AS NEEDED TO BALANCE THE VENT FLOW BETWEEN THE EBHs AND TO REDUCE THE TOTAL VENT FLOW RATE DURING THE H CAMPAIGN.
 - STEAM TRAP HAS INTEGRAL WYE STRAINER AND BLOWOFF VALVE PER PIPING MATERIAL CLASS A.
 - SEE HVAC PIDS 24915-07-M6-HVAC-00131 AND 24915-07-M6-HVAC-00132.
 - INSTRUMENT AIR LINES ARE NON-Q.
 - EBH MUST BE ABOVE LOW TEMPERATURE ALARM SETPOINT TO INITIATE MUNITIONS FEED. STOP MUNITIONS FEED BELOW LOW-LOW TEMPERATURE SETPOINT. EBH MUST OPERATE AT NORMAL SETPOINT FOR SPECIFIED TIME BEFORE DISCHARGE OF RESIDUES AND HYDROLYSATE. TEMPERATURE BELOW NORMAL SETPOINT DEAD BAND STOPS HYDROLYSIS TIMER UNTIL TEMPERATURE IS RESTORED.
 - HIGH POINT VENT VALVES AND LOW POINT DRAIN VALVES ARE SW VALVES. OPEN ENDS ARE CAPPED RATHER THAN PLUGGED.
 - LOADING OF AN EBH IS PROHIBITED IF A FULL BATCH HAS ALREADY BEEN LOADED.
 - LOADING OF EBH DURING LEAKER AND CONTAMINATED ROCKET PROCESSING SHALL ONLY BE DONE UNDER SUPERVISORY CONTROL AS AN ADDITIONAL PROTECTION TO PREVENT MIXING OF ROCKETS AND WARHEADS IN AN EBH.
 - "EBH ACTIVE" IDENTIFIER FOR FPS SHUTDOWN NITROGEN PURGE.
 - UPON EMERGENCY SHUTDOWN SIGNAL FROM OPERATOR, ALL EBH OPERATIONS CEASE EXCEPT FOR DRUM ROTATION, AND NITROGEN PURGE IS INITIATED FOR EBHs PROCESSING ROCKETS AND TURNING IN FORWARD DIRECTION.
 - NOTES 3, 4, 6, 7, 15, 16, 23, 25, 26 AND 30 HAVE BEEN DELETED.

BASED ON BLUE GRASS PFD 24915-07-M6-EBH-00001
REFERENCE DRAWINGS

NO.	DATE	DESCRIPTION	DR	CK	DL	PE	APPD
1	02/07/06	ISSUED FOR DESIGN	EM	CA	DG	NW	VN
2	05/03/06	ISSUED FOR DESIGN (INCORPORATES COMMENTS)	EM	KM	RB	NW	VN
3	12/20/06	ISSUED FOR CONSTRUCTION (INCORP. INT. DESIGN COMMENTS)	NL	CA	KM	NW	VN
4	07/03/07	FC (SHEET REDRAWN - INCORP. DESIGN DEVELOPMENT)	NL	CA	KM	NW	VN
5	01/15/09	FC (INCORP. VENDOR DATA & GOVT. COMMENTS)	NL	CA	KM	NW	VN
6	05/04/10	FC (INCORP. AS-BUILT MODULE CHANGES)	NL	CA	KM	NW	VN
7	03/18/11	FC (INCORP. FCR-1393)	NL	CA	KM	NW	VN

QUALITY Q Non-Q

BECHTEL PARSONS BLUE GRASS

DOD PROGRAM MANAGER FOR ASSEMBLED CHEMICAL WEAPONS ASSESSMENT EDGEWOOD, MARYLAND

US ARMY ENGINEERING AND SUPPORT CENTER, HUNTSVILLE HUNTSVILLE, ALABAMA

BLUE GRASS CHEMICAL AGENT DESTRUCTION PILOT PLANT PROJECT (BGCAPP)

RICHMOND, KENTUCKY


CONTRACT NO. DAAA09-03-D-0023

MUNITIONS DEMILITARIZATION BUILDING EBH UNIT 2 PIPING & INSTRUMENT DIAGRAM

DRAWING NUMBER: 24915-07-M6-EBH-01036

SHEET: 1 of 1

REV: 7

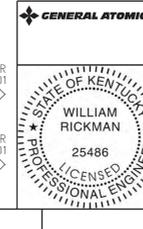

07MEBH0136.ppt 07/07/13

MX-EBH-1140
HYDROLYSATE COLLECTION MODULE

MF-EBH-1901
HYDROLYSATE TANK AGITATOR
MOTOR HP : 7.5 HP
MATERIAL OF CONST : UNS N 10276
: UNS S 32205

MT-EBH-1901
HYDROLYSATE COLLECTION TANK
WORKING VOLUME : 889 GAL
DIAMETER : 82 IN
HEIGHT : 76 IN
DESIGN PRESSURE : ATM
DESIGN TEMPERATURE : 275 °F
MATERIAL OF CONST : UNS S32205
TRIM : TRM-0903-0"-AD-PP


MP-EBH-1901A/B
HYDROLYSATE TRANSFER PUMP
RATED FLOW : 40 GPM
MOTOR HP : 7.5 HP
RATED DELTA P : 64 PSI
MATERIAL OF CONST : UNS N 10276

GENERAL NOTES:

- FOR SYMBOLS AND LEGEND, SEE DRAWINGS
- 24915-00-M6-00-00010
24915-00-M6-00-00011
24915-00-M6-00-00012
24915-00-M6-00-00013
24915-00-M6-00-00014
24915-00-M6-00-00015
- MOTOR PURGE PANEL, TYPE Z.
- HALT EBH DRAIN ON HIGH-HIGH TANK LEVEL.
- EBH-1/2/3 DRUM UNLOAD CANNOT BEGIN UNLESS MT-EBH-1901 LIQUID LEVEL IS BELOW LOW LIQUID LEVEL SETPOINT.
- PER ICD DOC. NO. 24915-07-B2-EBH-00012.
- AGITATOR SHUTOFF WHEN LIQUID LEVEL DROPS TO 6 INCHES ABOVE AGITATOR BLADE.
- IF THE PUMP DISCHARGE PRESSURE FALLS BELOW LOW LOW PRESSURE FOR MORE THAN 1 SECOND WHILE THE "LEAD" PUMP IS RUNNING, THE "STANDBY" PUMP WILL AUTOMATICALLY START. ONCE THE "STANDBY" PUMP HAS STARTED AND IF PRESSURE RETURNS TO NORMAL WITHIN 10 SECONDS, THE "LEAD" PUMP WILL STOP. IF THE "STANDBY" PUMP DOES NOT REACH THE NORMAL SET POINT WITHIN ANOTHER 5 SECONDS, BOTH THE "LEAD" AND "STANDBY" PUMPS WILL STOP. IF THE "LEAD" PUMP BECOMES DE-ENERGIZED, THE "STANDBY" PUMP WILL AUTOMATICALLY START, WITHOUT WAITING FOR PRESSURE TO FALL BELOW NORMAL.
- Ⓢ DENOTES DESIGN RESPONSIBILITY LABEL.
- ELECTRICAL AREA CLASSIFICATION:
CLASS 1
DIVISION 2
GROUP B
- QUALITY LEVEL BOUNDARY FROM Q TO NON-Q REQUIRED AT THE END USER DEVICE WHEN THE END USER DEVICE IS Q.
- REFER TO 24915-07-J3-FPS-00002, SHEET 1 FOR FPS SHUTDOWN LOGIC.
- EQUIPMENT SHOWN IS LOCATED IN THE EBH ROOM, CATEGORY "A" AREA.
- MINIMUM FLOW VALVES TO BE LOCKED TO PREVENT FULL OPENING.
- INSTRUMENT AIR LINES ARE "NON-Q".
- HIGH POINT VENT VALVES AND LOW POINT DRAIN VALVES ARE SW VALVES. OPEN ENDS ARE CAPPED RATHER THAN PLUGGED.
- CURRENT TRANSMITTER LOCATED IN MCC.
- NOTES 4, 5, 9, 12 AND 15 HAVE BEEN DELETED.

This document has been reviewed for ITAR/EAR and no ITAR/EAR sensitive information was found. 17 Dec 2013

This document has been reviewed for OPSEC material, and none was found. 17 Dec 2013

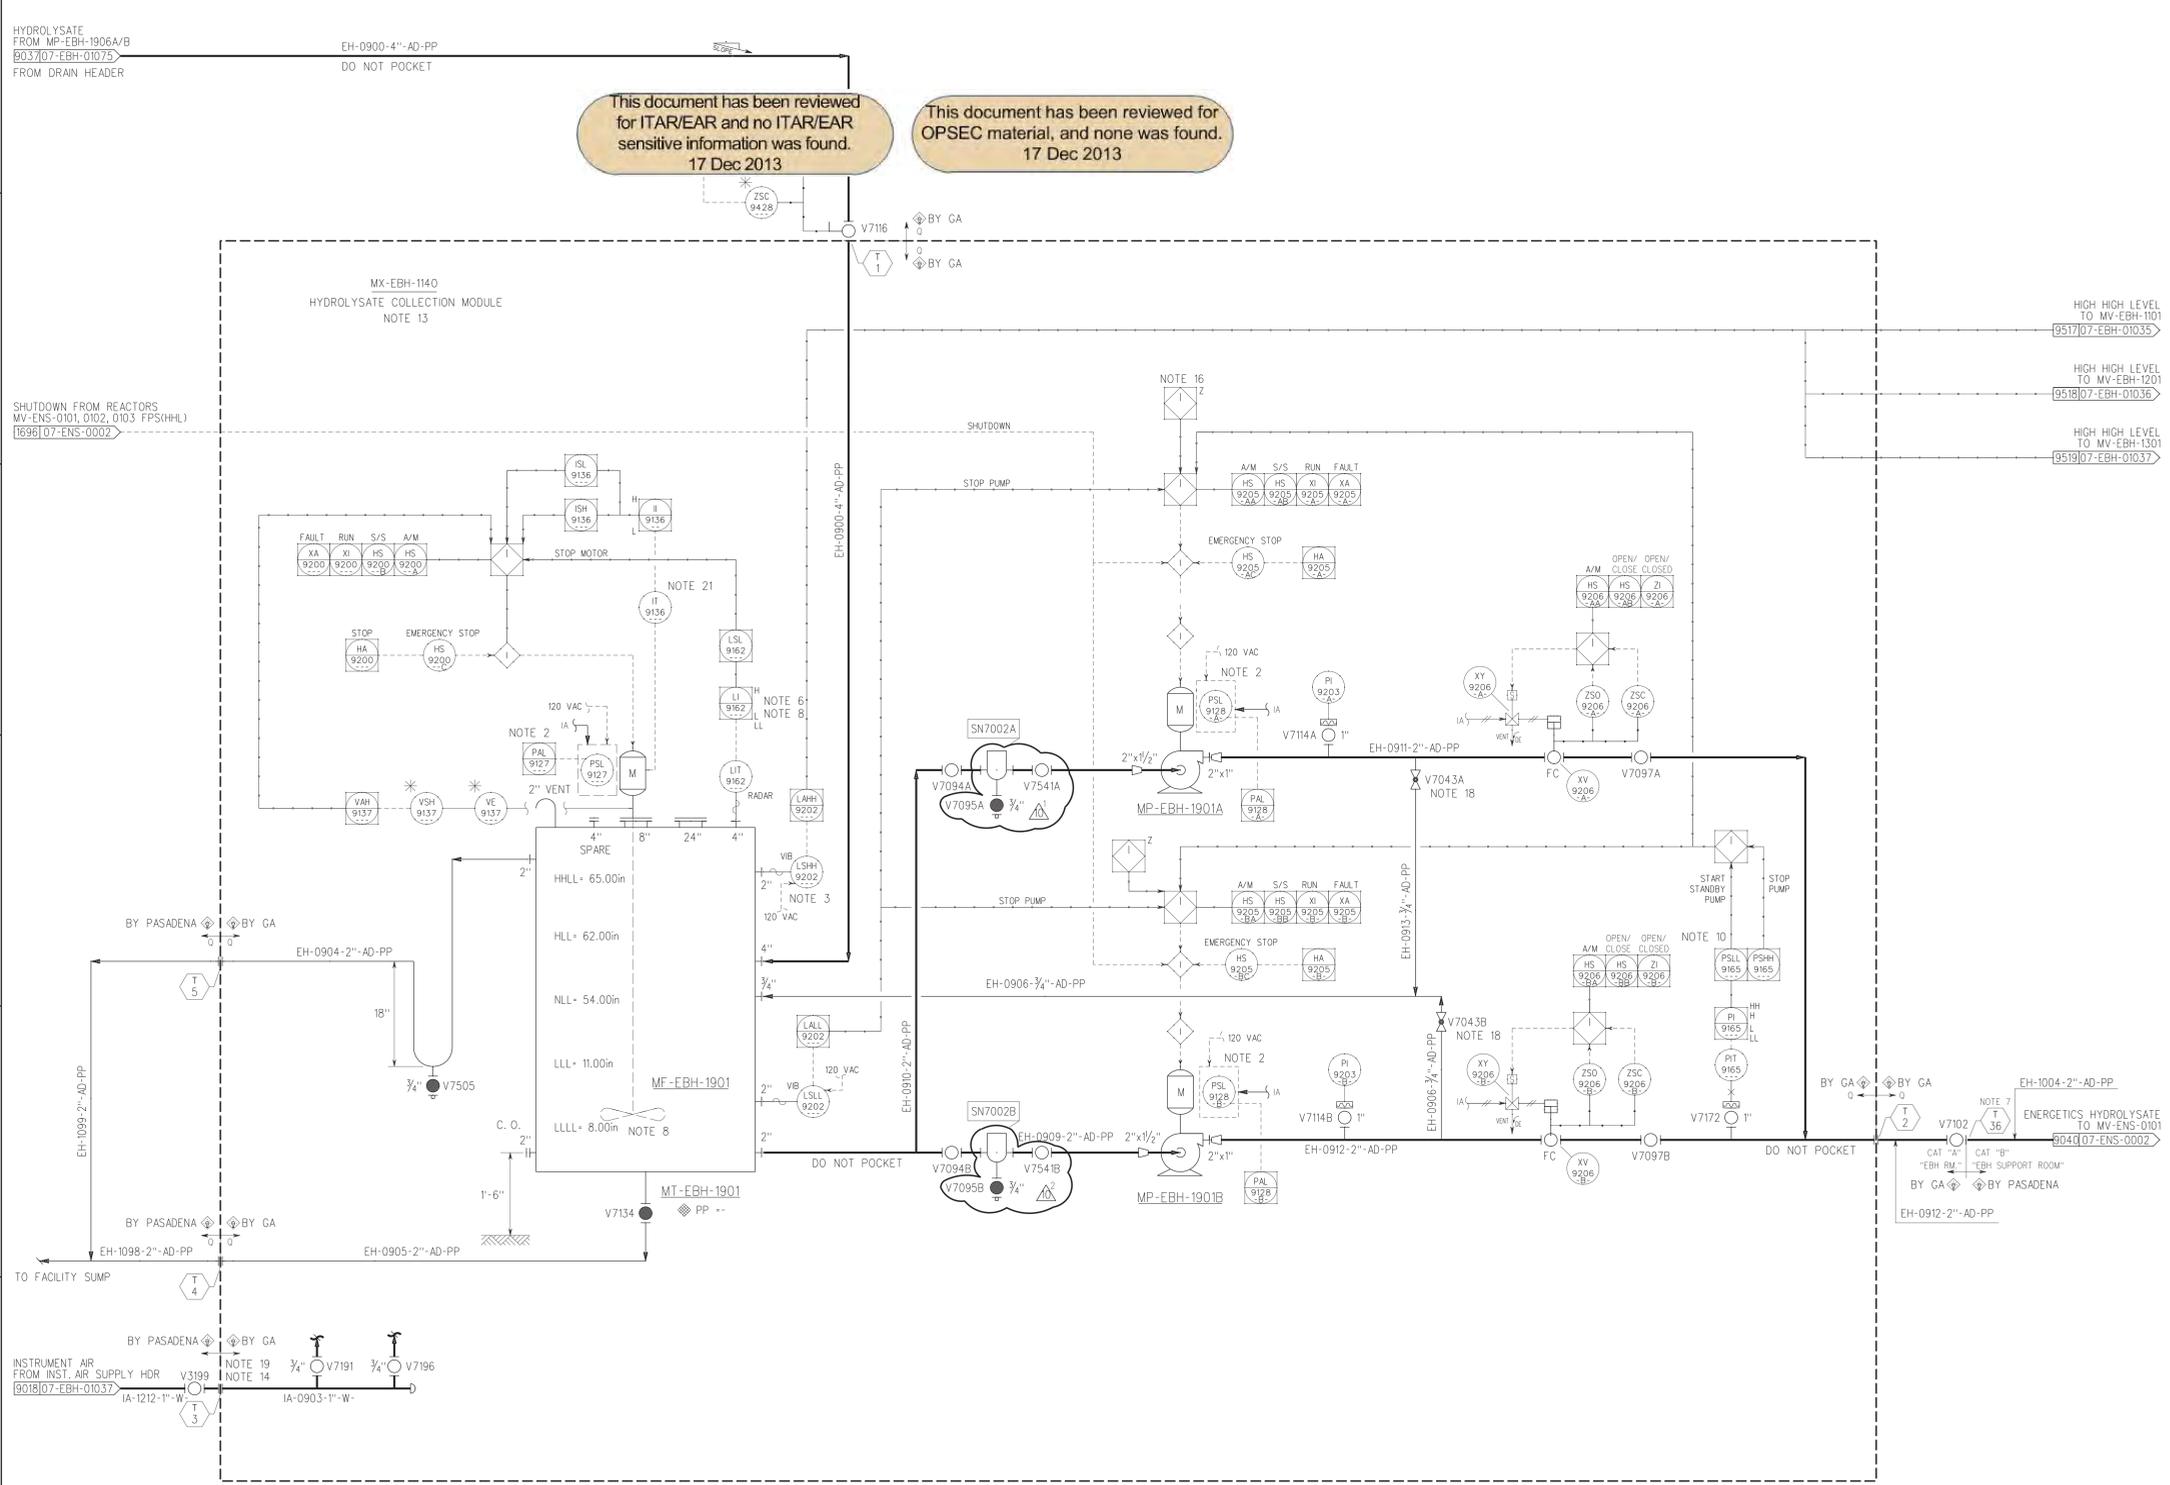

BASED ON BLUE GRASS PFD 24915-07-M5-EBH-00001
REFERENCE DRAWINGS

NO.	DATE	DESCRIPTION	DR	CK	DL	PE	APPD
1	01/03/05	ISSUED FOR DESIGN	EM	CA	BW	NW	VN
2	01/21/05	ISSUED FOR DESIGN	EM	CA	BW	NW	VN
3	08/19/05	ISSUED FOR APPROVAL - DC-43B	EM	CA	DC	NW	VN
4	02/07/06	ISSUED FOR DESIGN	EM	CA	DC	NW	VN
5	05/03/06	ISSUED FOR DESIGN (INCORPORATES COMMENTS)	EM	KM	RB	NW	VN
6	12/20/06	ISSUED FOR CONSTRUCTION (INCORP. INT. DESIGN COMMENTS)	NL	CA	KM	NW	VN
7	07/03/07	FC (SHEET REDRAWN - INCORP. DESIGN DEVELOPMENT)	NL	CA	KM	NW	VN
8	01/15/09	FC (INCORP. VENDOR DATA & GOVT. COMMENTS)	NL	CA	KM	NW	VN
9	04/27/10	FC (INCORP. AS-BUILT MODULE CHANGES)	NL	CA	KM	NW	VN
10	04/27/10	FC (INCORP. DCN-216)	NL	CA	KM	NW	VN

QUALITY Q Non-Q

BECHTEL PARSONS BLUE GRASS
DOD PROGRAM MANAGER FOR ASSEMBLED CHEMICAL WEAPONS ASSESSMENT EDGEWOOD, MARYLAND

US ARMY ENGINEERING AND SUPPORT CENTER, HUNTSVILLE HUNTSVILLE, ALABAMA

BLUE GRASS CHEMICAL AGENT DESTRUCTION PILOT PLANT PROJECT (BGCAPP)
RICHMOND, KENTUCKY
DAAA09-03-D-0023

MUNITIONS DEMILITARIZATION BUILDING EBH HYDROLYSATE COLLECTION PIPING & INSTRUMENT DIAGRAM

DRAWING NUMBER: 24915-07-M6-EBH-01085
SHEET: 1 of 1
REV: 10

GENERAL ATOMICS

WILLIAM RICKMAN
25486
LICENSED PROFESSIONAL ENGINEER

cn=Issued By Norbil Espiritu, o=General Atomics, ou=Configuration Management, email=norbil.espiritu@ga.com, c=US
2011.03.24 09:17:26 -07'00'


RCM Apvd

07MEBH085.ppt 03/16/11

- GENERAL NOTES:
- FOR SYMBOLS AND LEGEND, SEE DRAWINGS 24915-00-M6-00-00010 THRU 00015.
 - DRAWING NUMBERS IN OFF-PAGE CONNECTORS ARE TRUNCATED BY SUPPRESSING PROJECT NUMBER "24915" AND DOCUMENTS TYPE "M6". TWO LEADING ZEROS IN SEQUENCE NUMBER ARE NOT SHOWN.
 - ALL EQUIPMENT NUMBERS, INSTRUMENT TAG NUMBERS AND VALVE NUMBERS ARE PREFIXED "07" UNLESS OTHERWISE NOTED.
 - DELETED.
 - THERE ARE THREE ENERGETICS NEUTRALIZATION REACTORS, ONLY ONE ENR IS FILLING AT A TIME OR ONLY ONE ENR IS DRAINING AT A TIME.
 - PIPING TO BE STRESS RELIEVED.
 - ON ENERGETICS NEUTRALIZATION REACTOR HIGH-HIGH LEVEL OR HIGH-HIGH TEMPERATURE, OR ENERGETICS NEUTRALIZATION REACTOR RECIRCULATION LOW FLOW, OR ENR AGITATOR SHUTDOWN CAUSTIC FEED VALVES XV-2324-A/-B/-C WILL BE CLOSED.
 - 50% NaOH IS ADDED IN THE EVENT OF TWO POSITIVE TEST RESULTS FOR AGENT OR ENERGETICS FROM THE SAMPLING SYSTEM.
 - 50% CAUSTIC LINE TO BE ELECTRIC TRACED TO MAINTAIN THE TEMPERATURE AT 80°F (INDEPENDENT DUAL HEAT TRACE TAPE AND CONTROLS REQUIRED FOR 50% CAUSTIC LINES (NAHH)).
 - UNLESS OTHERWISE NOTED, FCS INTERLOCK NUMBERS ARE PREFIXED WITH "07-ENS-" AND FPS (OR Z) INTERLOCKS ARE PREFIXED WITH "07-FPS-".

This document has been reviewed for ITAR/EAR and no ITAR/EAR sensitive information was found. 17 Dec 2013

This document has been reviewed for OPSEC material, and none was found. 17 Dec 2013

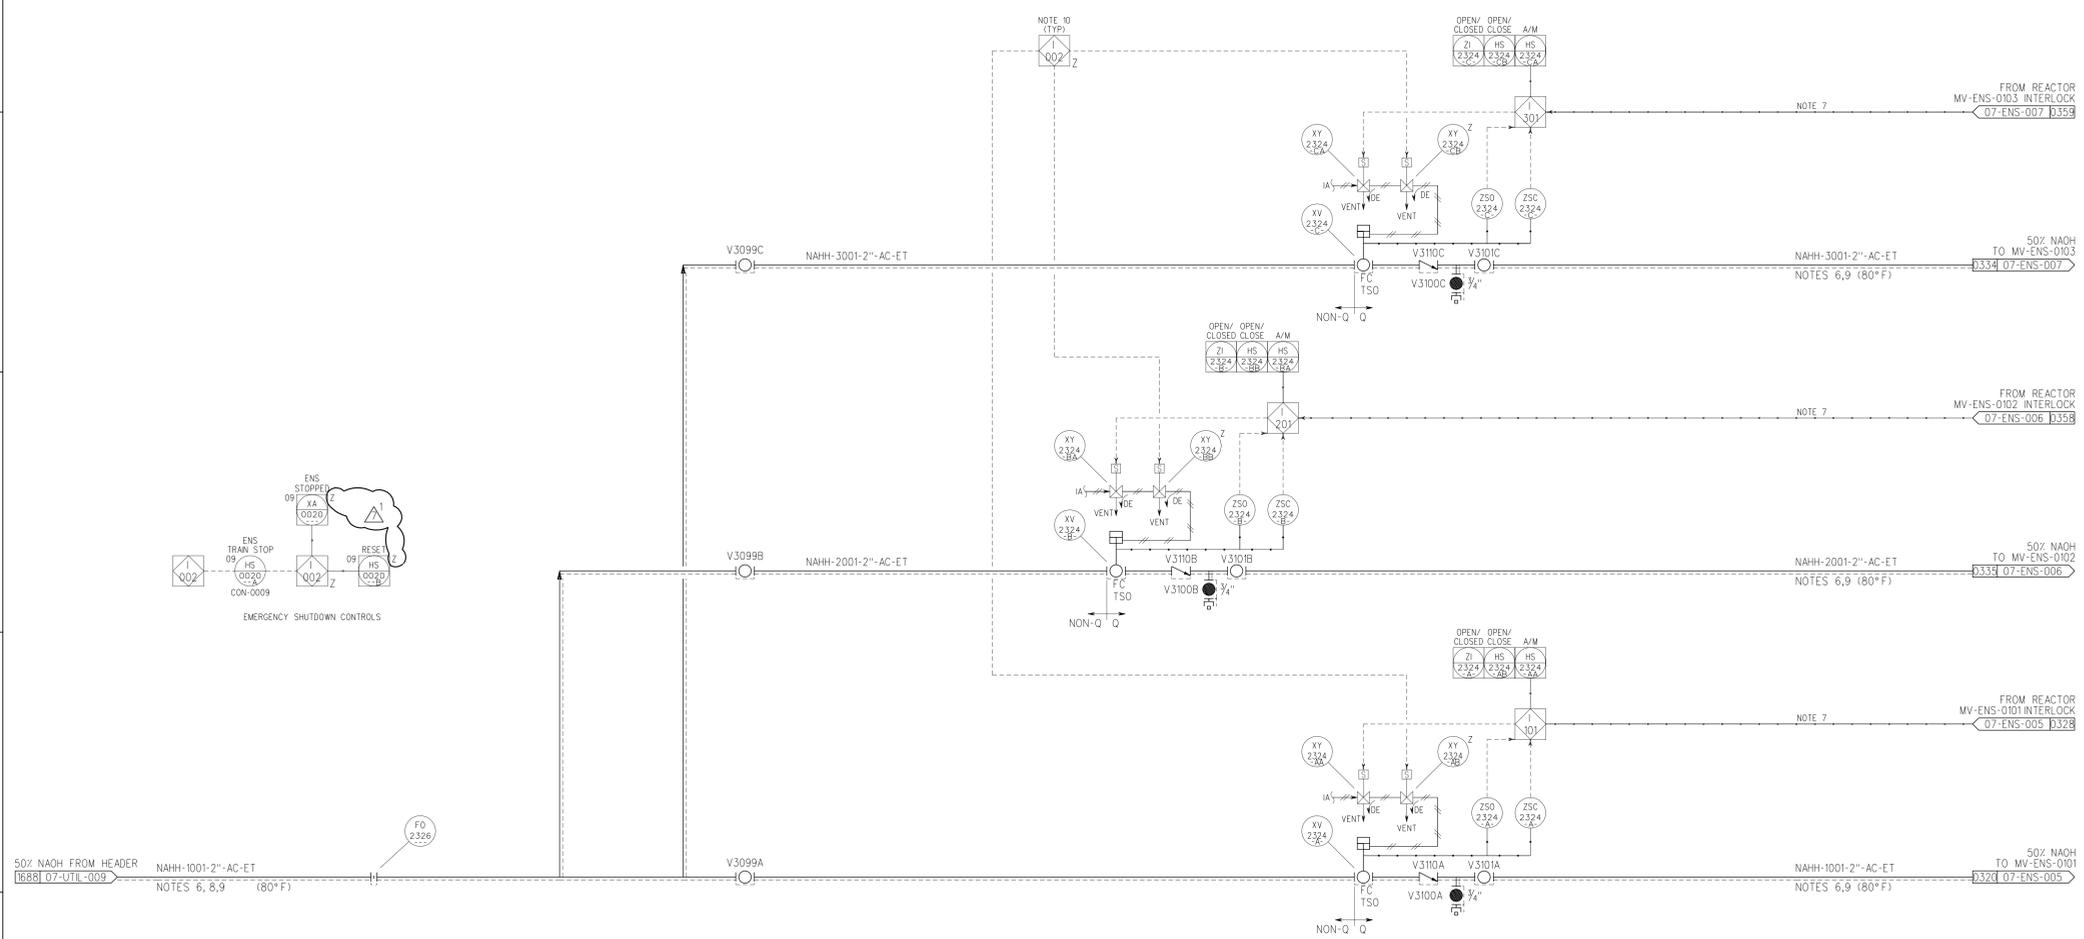

BASED ON BLUE GRASS MSD 24915-07-NO-ENS-00001 REV. 5
BASED ON BLUE GRASS PFD 24915-07-M5-ENS-00001 REV. 6
REFERENCE DRAWINGS

NO.	DATE	DESCRIPTION	DR	CK	DL	PE	APVD
7	06/22/11	IFC, INCORPORATED DCR-200, HTL-6124, & C COMMENTS	JDC	PEB	SA	BBB	BBB
6	01/23/09	IFC, GOV. COMMENT 7691, ADD INST. INTERLOCK	PEB	JLL	BM	BBB	BBB
5	05/08/07	IFC, ADD INSTRUMENTATION ACTION	SF	JLL	PEB	JB	BBB
4	09/21/06	ISSUED FOR DESIGN (IFD), ADD DESIGN DEVELOPMENT	SF	JLL	PEB	JB	BBB
3	05/02/06	ISSUED FOR DESIGN (IFD), ADD DESIGN DEVELOPMENT	SF	JLL	PEB	JB	BBB
2	10/31/05	IFD ADD DESIGN DEVELOPMENT	HT	JLL	PEB	JB	PKG
1	10/03/05	ISSUED FOR APPROVAL (IFA)	HT	JLL	PEB	JB	JU
0	11/29/04	ISSUED FOR DESIGN (IFD)	FA	JLL	PEB	JB	JU

QUALITY Non-Q

BECHTEL PARSONS
BLUE GRASS
A joint venture of Bechtel Technology, Inc. and Parsons Infrastructure & Technology Group, Inc.

DDO PROGRAM MANAGER FOR ASSEMBLED CHEMICAL WEAPONS ASSESSMENT EDGEMOOD, MARYLAND

US ARMY ENGINEERING AND SUPPORT CENTER, HUNTSVILLE, ALABAMA

BLUE GRASS CHEMICAL AGENT DESTRUCTION PILOT PLANT PROJECT (BGCAPP)
 RICHMOND, KENTUCKY
 DAAA09-03-D-0023

MUNITIONS DEMILITARIZATION BUILDING ENR FEED 50% CAUSTIC PIPING & INSTRUMENT DIAGRAM

DRAWING NUMBER	SHEET	REV
24915-07-M6-ENS-00001	1 OF 1	7




07MENS001.dwg 06/23/11
 DESIGN FILE: DONSPEC
 PLOTTED BY: USER ON DATE: 6/23/2011 2:03:20 PM


This document has been reviewed for ITAR/EAR and no ITAR/EAR sensitive information was found. 17 Dec 2013

This document has been reviewed for OPSEC material, and none was found. 17 Dec 2013

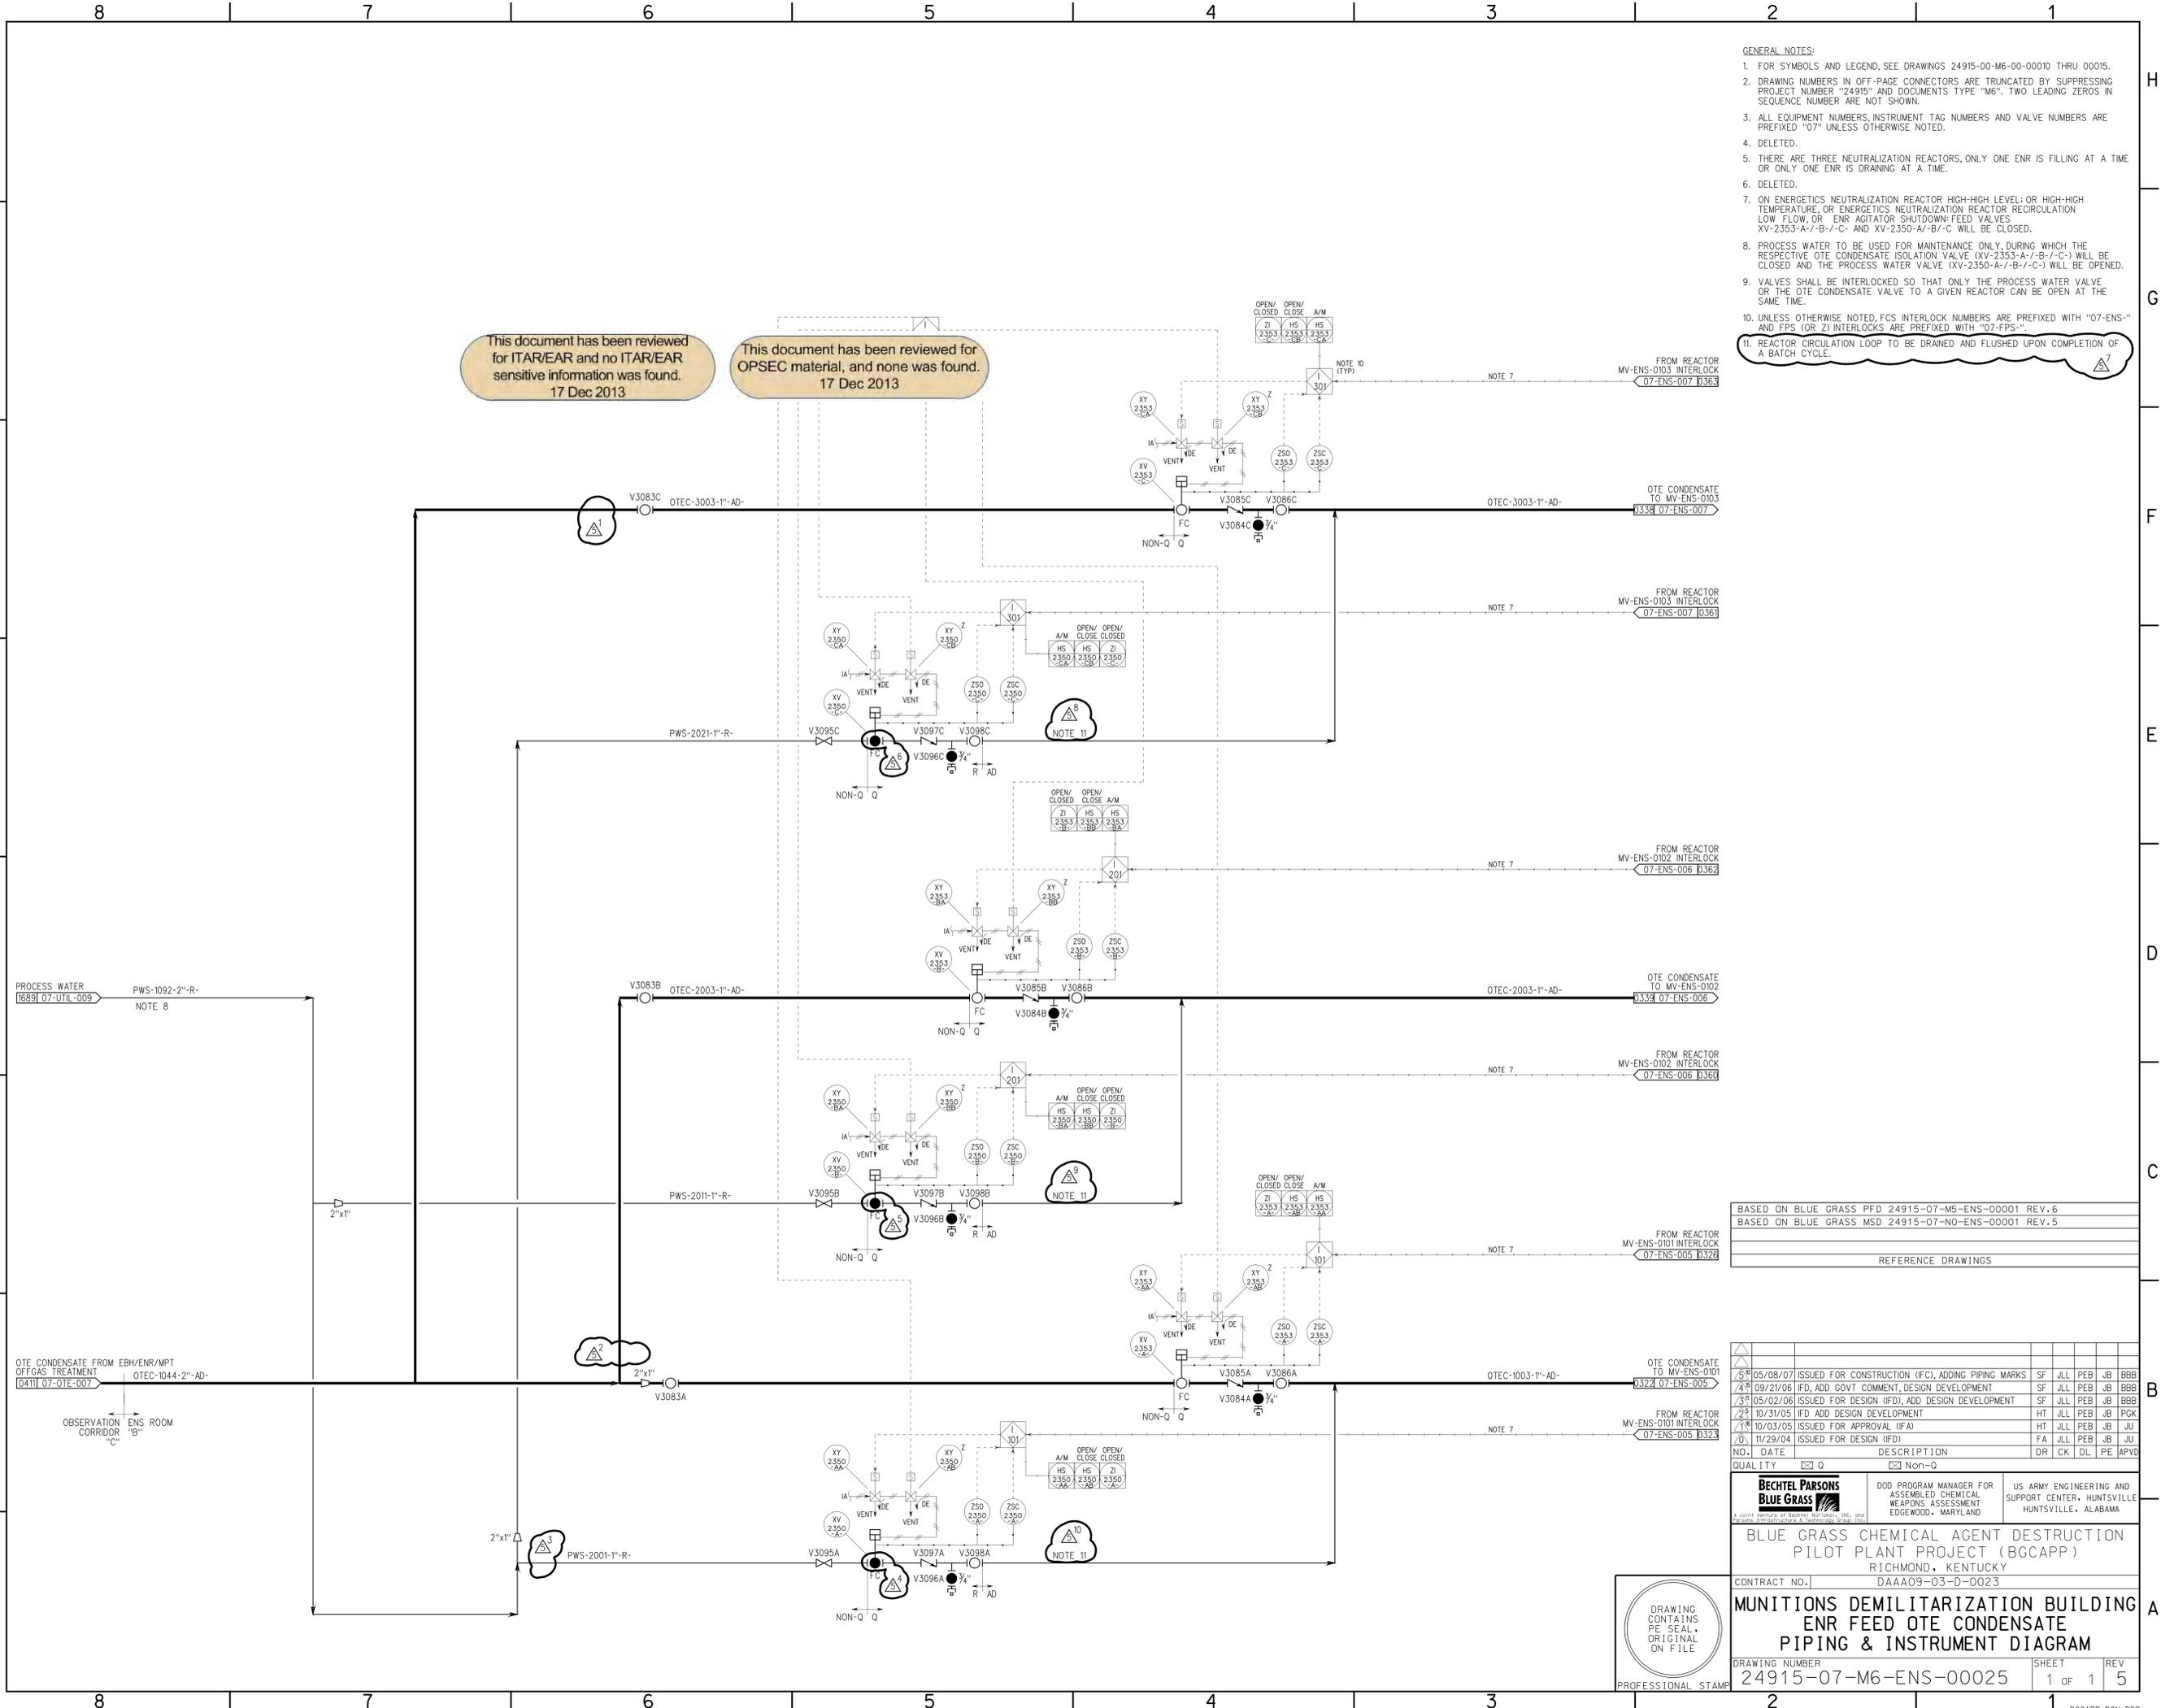

BASED ON BLUE GRASS PFD 24915-07-M5-ENS-00001 REV. 6
 BASED ON BLUE GRASS MSD 24915-07-N0-ENS-00001 REV. 5

REFERENCE DRAWINGS

NO.	DATE	ISSUED FOR DESIGN (IFD)	DESCRIPTION	DR	CK	DL	PE	APVD
5	05/08/07	ISSUED FOR CONSTRUCTION (FC), ADDING PIPING MARKS		SF	JLL	PEB	JB	BBB
4	09/21/06	IFD, ADD GOVT COMMENT, DESIGN DEVELOPMENT		SF	JLL	PEB	JB	BBB
3	05/02/06	ISSUED FOR DESIGN (IFD), ADD DESIGN DEVELOPMENT		SF	JLL	PEB	JB	BBB
2	10/31/05	IFD ADD DESIGN DEVELOPMENT		HT	JLL	PEB	JB	PKC
1	10/03/05	ISSUED FOR APPROVAL (IFA)		HT	JLL	PEB	JB	JU
0	11/29/04	ISSUED FOR DESIGN (IFD)		FA	JLL	PEB	JB	JU

BECHTEL PARSONS BLUE GRASS

DOD PROGRAM MANAGER FOR ASSEMBLED CHEMICAL WEAPONS ASSESSMENT EDGEWOOD, MARYLAND

US ARMY ENGINEERING AND SUPPORT CENTER, HUNTSVILLE HUNTSVILLE, ALABAMA

BLUE GRASS CHEMICAL AGENT DESTRUCTION PILOT PLANT PROJECT (BGCAPP)
 RICHMOND, KENTUCKY


CONTRACT NO. DAAA09-03-D-0023

MUNITIONS DEMILITARIZATION BUILDING ENR FEED OTE CONDENSATE PIPING & INSTRUMENT DIAGRAM

DRAWING NUMBER: 24915-07-M6-ENS-00025
 SHEET: 1 OF 1
 REV: 5

05/16/07
 DESIGNED BY: S. J. DODD
 PLOTTED BY: p0072338 15-MAY-2007 AT 16:04
 USING Color Table: S:\3051d4s\p\vedploc10r\bw.ctb & Pen Table: S:\3051d4s\p\vedploc10r\Bluegrass.F.tbl



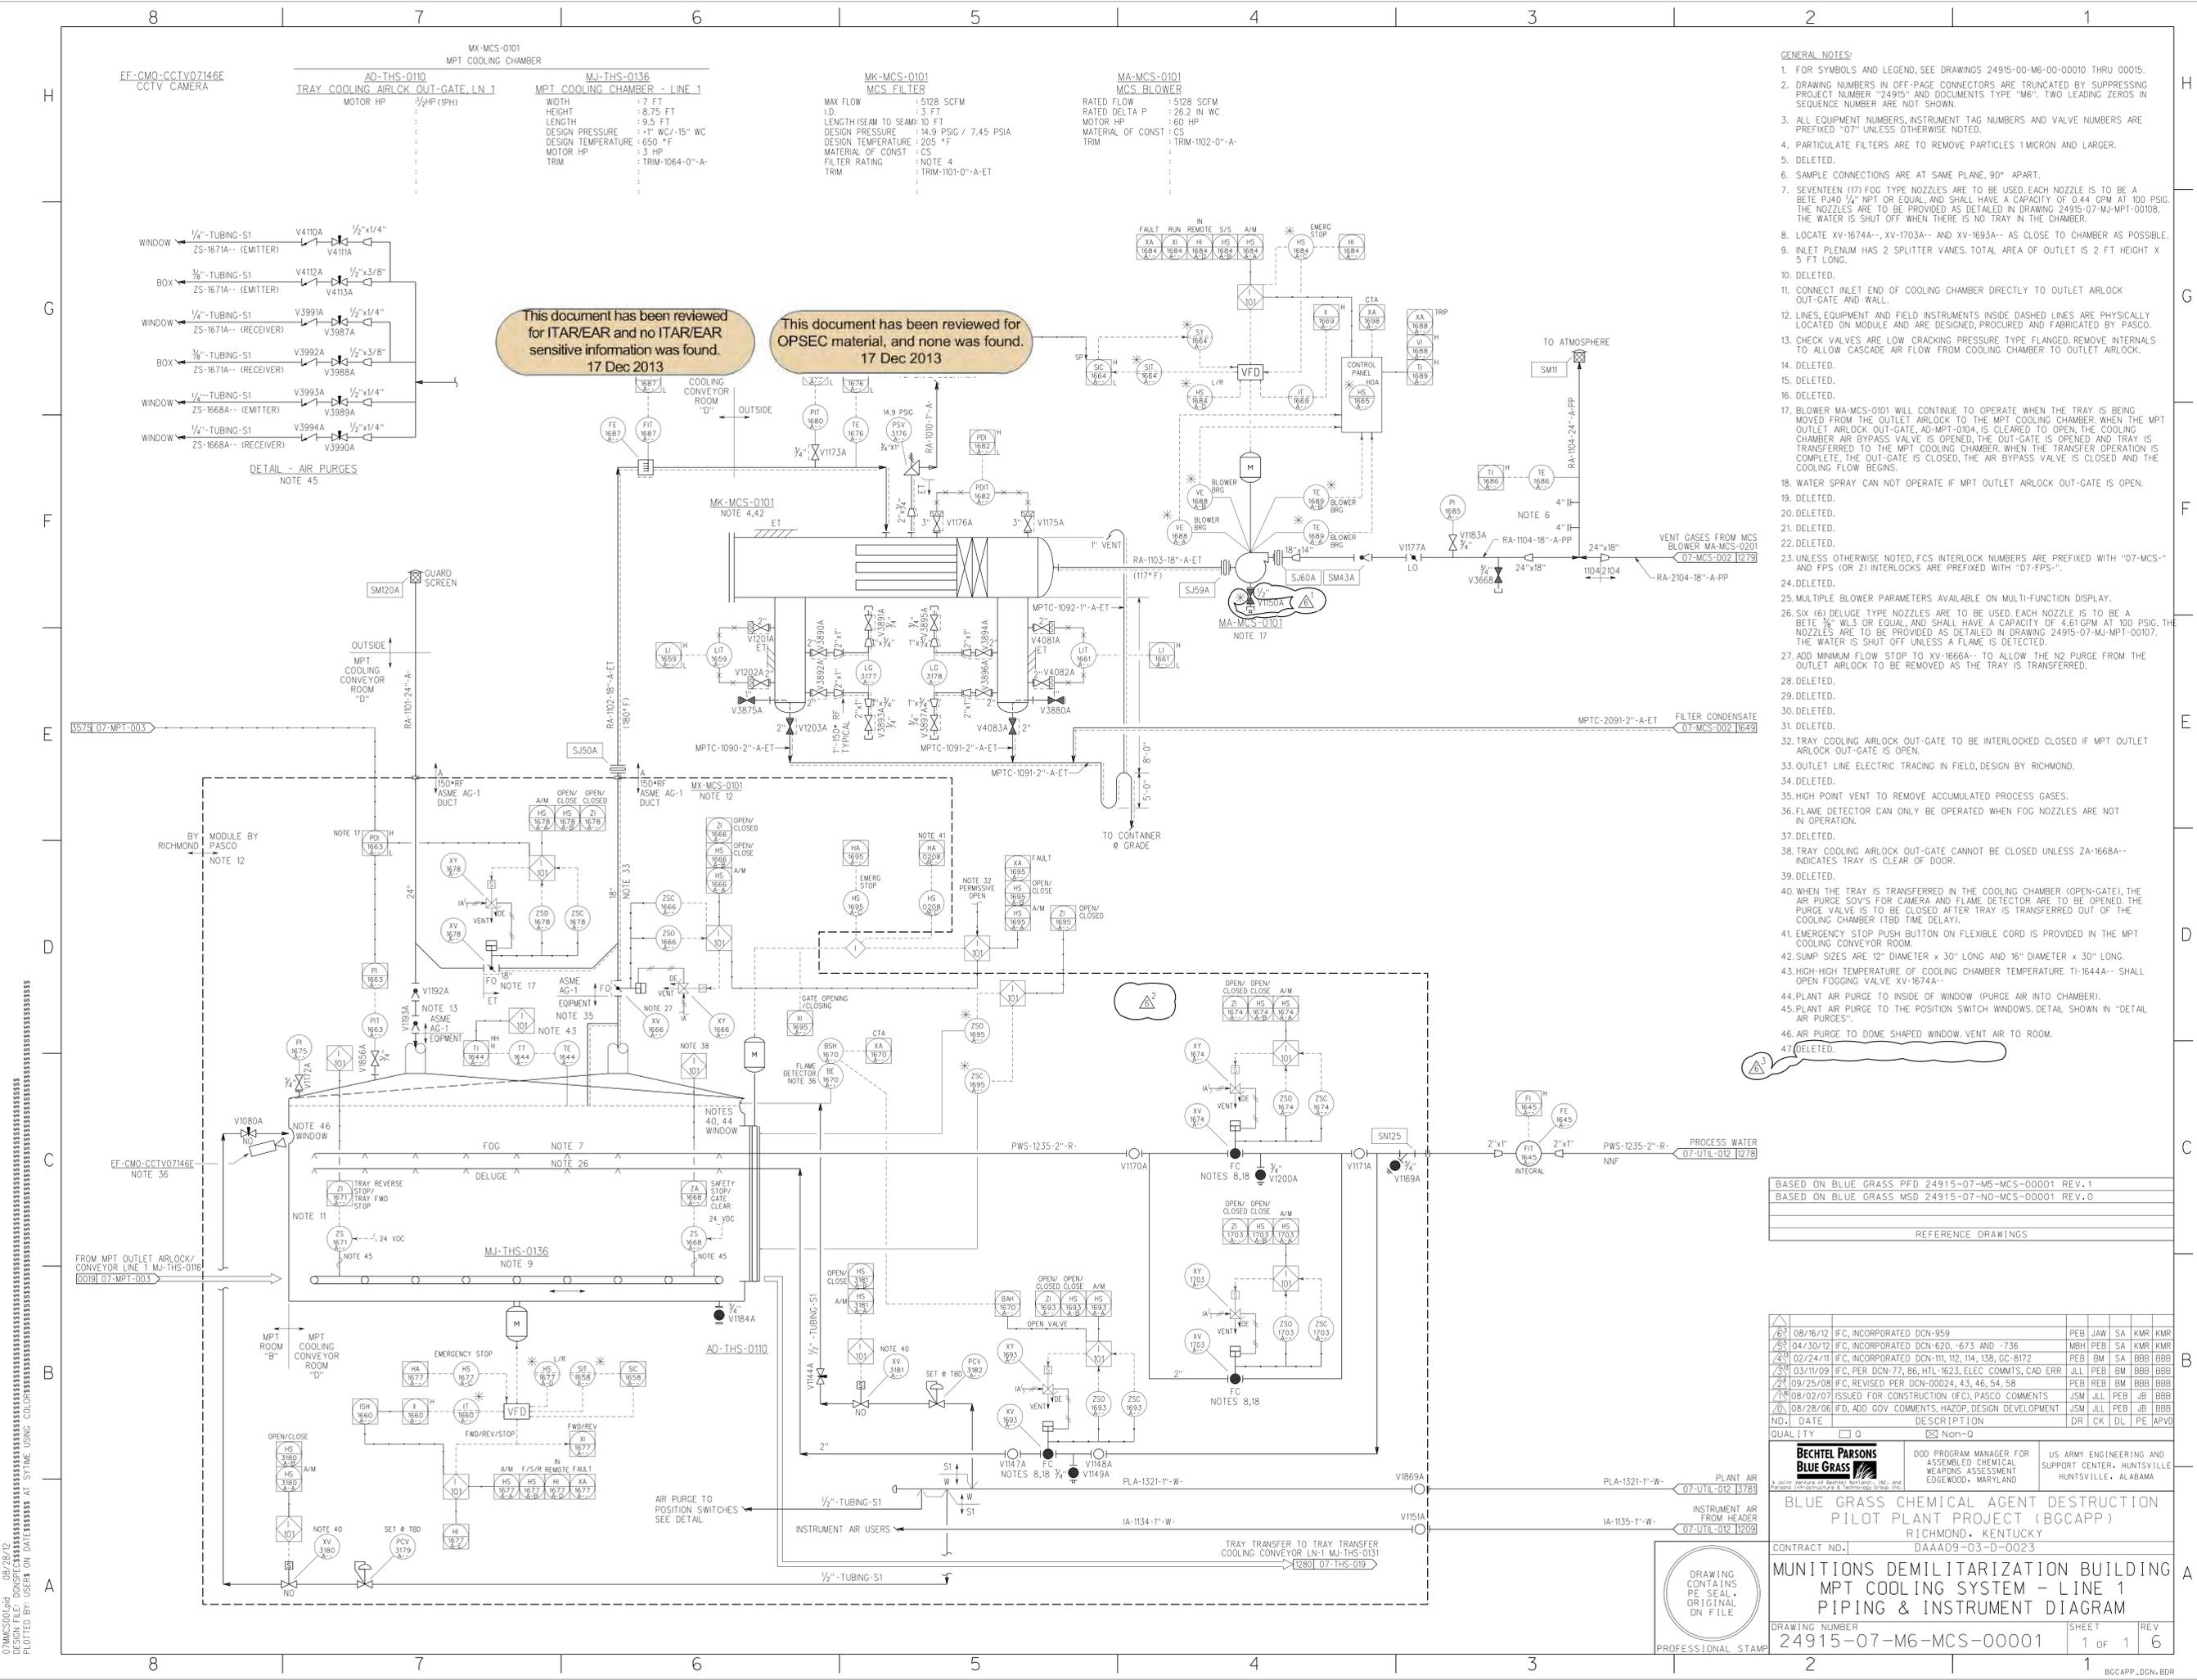

This document has been reviewed for ITAR/EAR and no ITAR/EAR sensitive information was found. 17 Dec 2013

This document has been reviewed for OPSEC material, and none was found. 17 Dec 2013

- GENERAL NOTES:
- FOR SYMBOLS AND LEGEND, SEE DRAWINGS 24915-00-M6-00-00010 THRU 00015.
 - DRAWING NUMBERS IN OFF-PAGE CONNECTORS ARE TRUNCATED BY SUPPRESSING PROJECT NUMBER "24915" AND DOCUMENTS TYPE "M6". TWO LEADING ZEROS IN SEQUENCE NUMBER ARE NOT SHOWN.
 - ALL EQUIPMENT NUMBERS, INSTRUMENT TAG NUMBERS AND VALVE NUMBERS ARE PREFIXED "07" UNLESS OTHERWISE NOTED.
 - PARTICULATE FILTERS ARE TO REMOVE PARTICLES 1 MICRON AND LARGER.
 - DELETED.
 - SAMPLE CONNECTIONS ARE AT SAME PLANE, 90° APART.
 - SEVENTEEN (17) FOG TYPE NOZZLES ARE TO BE USED. EACH NOZZLE IS TO BE A BETE PJ40 1/2" NPT OR EQUAL, AND SHALL HAVE A CAPACITY OF 0.44 GPM AT 100 PSIG. THE NOZZLES ARE TO BE PROVIDED AS DETAILED IN DRAWING 24915-07-MJ-MPT-00108. THE WATER IS SHUT OFF WHEN THERE IS NO TRAY IN THE CHAMBER.
 - LOCATE XV-1674A-- AND XV-1703A-- AND XV-1693A-- AS CLOSE TO CHAMBER AS POSSIBLE.
 - INLET PLENUM HAS 2 SPLITTER VANES. TOTAL AREA OF OUTLET IS 2 FT HEIGHT X 5 FT LONG.
 - DELETED.
 - CONNECT INLET END OF COOLING CHAMBER DIRECTLY TO OUTLET AIRLOCK OUT-GATE AND WALL.
 - INES, EQUIPMENT AND FIELD INSTRUMENTS INSIDE DASHED LINES ARE PHYSICALLY LOCATED ON MODULE AND ARE DESIGNING, PROCURED AND FABRICATED BY PASCO.
 - CHECK VALVES ARE LOW CRACKING PRESSURE TYPE FLANGED. REMOVE INTERNALS TO ALLOW CASCADE AIR FLOW FROM COOLING CHAMBER TO OUTLET AIRLOCK.
 - DELETED.
 - DELETED.
 - DELETED.
 - DELETED.
 - BLOWER MA-MCS-0101 WILL CONTINUE TO OPERATE WHEN THE TRAY IS BEING MOVED FROM THE OUTLET AIRLOCK TO THE MPT COOLING CHAMBER WHEN THE MPT OUTLET AIRLOCK OUT-GATE, AD-MPT-0104, IS CLEARED TO OPEN. THE COOLING CHAMBER AIR BYPASS VALVE IS OPENED, THE OUT-GATE IS OPENED AND TRAY IS TRANSFERRED TO THE MPT COOLING CHAMBER. WHEN THE TRANSFER OPERATION IS COMPLETE, THE OUT-GATE IS CLOSED, THE AIR BYPASS VALVE IS CLOSED AND THE COOLING FLOW BEGINS.
 - WATER SPRAY CAN NOT OPERATE IF MPT OUTLET AIRLOCK OUT-GATE IS OPEN.
 - DELETED.
 - DELETED.
 - DELETED.
 - DELETED.
 - UNLESS OTHERWISE NOTED, FCS INTERLOCK NUMBERS ARE PREFIXED WITH "07-MCS-" AND FPS (OR Z) INTERLOCKS ARE PREFIXED WITH "07-FPS-".
 - DELETED.
 - MULTIPLE BLOWER PARAMETERS AVAILABLE ON MULTI-FUNCTION DISPLAY.
 - SIX (6) DELUGE TYPE NOZZLES ARE TO BE USED. EACH NOZZLE IS TO BE A BETE W3/4 OR EQUAL, AND SHALL HAVE A CAPACITY OF 4.61 GPM AT 100 PSIG. THE NOZZLES ARE TO BE PROVIDED AS DETAILED IN DRAWING 24915-07-MJ-MPT-00107. THE WATER IS SHUT OFF UNLESS A FLAME IS DETECTED.
 - ADD MINIMUM FLOW STOP TO XV-1666A-- TO ALLOW THE N2 PURGE FROM THE OUTLET AIRLOCK TO BE REMOVED AS THE TRAY IS TRANSFERRED.
 - DELETED.
 - DELETED.
 - DELETED.
 - DELETED.
 - DELETED.
 - TRAY COOLING AIRLOCK OUT-GATE TO BE INTERLOCKED CLOSED IF MPT OUTLET AIRLOCK OUT-GATE IS OPEN.
 - OUTLET LINE ELECTRIC TRACING IN FIELD, DESIGN BY RICHMOND.
 - DELETED.
 - HIGH POINT VENT TO REMOVE ACCUMULATED PROCESS GASES.
 - FLAME DETECTOR CAN ONLY BE OPERATED WHEN FOG NOZZLES ARE NOT IN OPERATION.
 - DELETED.
 - TRAY COOLING AIRLOCK OUT-GATE CANNOT BE CLOSED UNLESS ZA-1668A-- INDICATES TRAY IS CLEAR OF DOOR.
 - DELETED.
 - WHEN THE TRAY IS TRANSFERRED IN THE COOLING CHAMBER (OPEN-GATE), THE AIR PURGE SOV'S FOR CAMERA AND FLAME DETECTOR ARE TO BE OPENED. THE PURGE VALVE IS TO BE CLOSED AFTER TRAY IS TRANSFERRED OUT OF THE COOLING CHAMBER (BBD TIME DELAY).
 - EMERGENCY STOP PUSH BUTTON ON FLEXIBLE CORD IS PROVIDED IN THE MPT COOLING CONVEYOR ROOM.
 - SUMP SIZES ARE 12" DIAMETER x 30" LONG AND 16" DIAMETER x 30" LONG.
 - HIGH-HIGH TEMPERATURE OF COOLING CHAMBER TEMPERATURE TI-1644A-- SHALL OPEN FOGGING VALVE XV-1674A--.
 - PLANT AIR PURGE TO INSIDE OF WINDOW (PURGE AIR INTO CHAMBER).
 - PLANT AIR PURGE TO THE POSITION SWITCH WINDOWS. DETAIL SHOWN IN "DETAIL AIR PURGES".
 - AIR PURGE TO DOME SHAPED WINDOW. VENT AIR TO ROOM.
 - DELETED.

BASED ON BLUE GRASS PFD 24915-07-M6-MCS-00001 REV. 1
 BASED ON BLUE GRASS MSD 24915-07-N0-MCS-00001 REV. 0

REFERENCE DRAWINGS

NO.	DATE	DESCRIPTION	DR	CK	DL	PE	APPV
1	08/16/12	IFC, INCORPORATED DCN-959	PEB	JAW	SA	KMR	KMR
2	04/30/12	IFC, INCORPORATED DCN-620, -673 AND -736	MBH	PEB	SA	KMR	KMR
3	02/24/11	IFC, INCORPORATED DCN-111, 112, 114, 138, GC-8172	PEB	BM	SA	BBB	BBB
4	03/11/09	IFC, PER DCN-77, 86, HTL-1623, ELEC COMMENTS, CAD ERR	JLL	PEB	BM	BBB	BBB
5	09/25/08	IFC, REVISED PER DCN-00024, 43, 46, 54, 58	PEB	REB	BM	BBB	BBB
6	08/02/07	ISSUED FOR CONSTRUCTION (IFC), PASCO COMMENTS	JSM	JLL	PEB	JB	BBB
7	08/28/06	IFD, ADD GOV COMMENTS, HAZOP, DESIGN DEVELOPMENT	JSM	JLL	PEB	JB	BBB

QUALITY	0	Non-0
DOD PROGRAM MANAGER FOR ASSEMBLED CHEMICAL WEAPONS ASSESSMENT EDGEWOOD, MARYLAND		US ARMY ENGINEERING AND SUPPORT CENTER, HUNTSVILLE, ALABAMA


BLUE GRASS CHEMICAL AGENT DESTRUCTION PILOT PLANT PROJECT (BCAPP) RICHMOND, KENTUCKY
 CONTRACT NO. DAAA09-03-D-0023

MUNITIONS DEMILITARIZATION BUILDING MPT COOLING SYSTEM - LINE 1 PIPING & INSTRUMENT DIAGRAM

DRAWING NUMBER	SHEET	REV
24915-07-M6-MCS-00001	1 OF 1	6



07M6MCS001.dwg 08/28/12
 DESIGN FILE: DONSPEC4 ON DATE: 08/28/12
 PLOTTED BY: USER ON DATE: 08/28/12

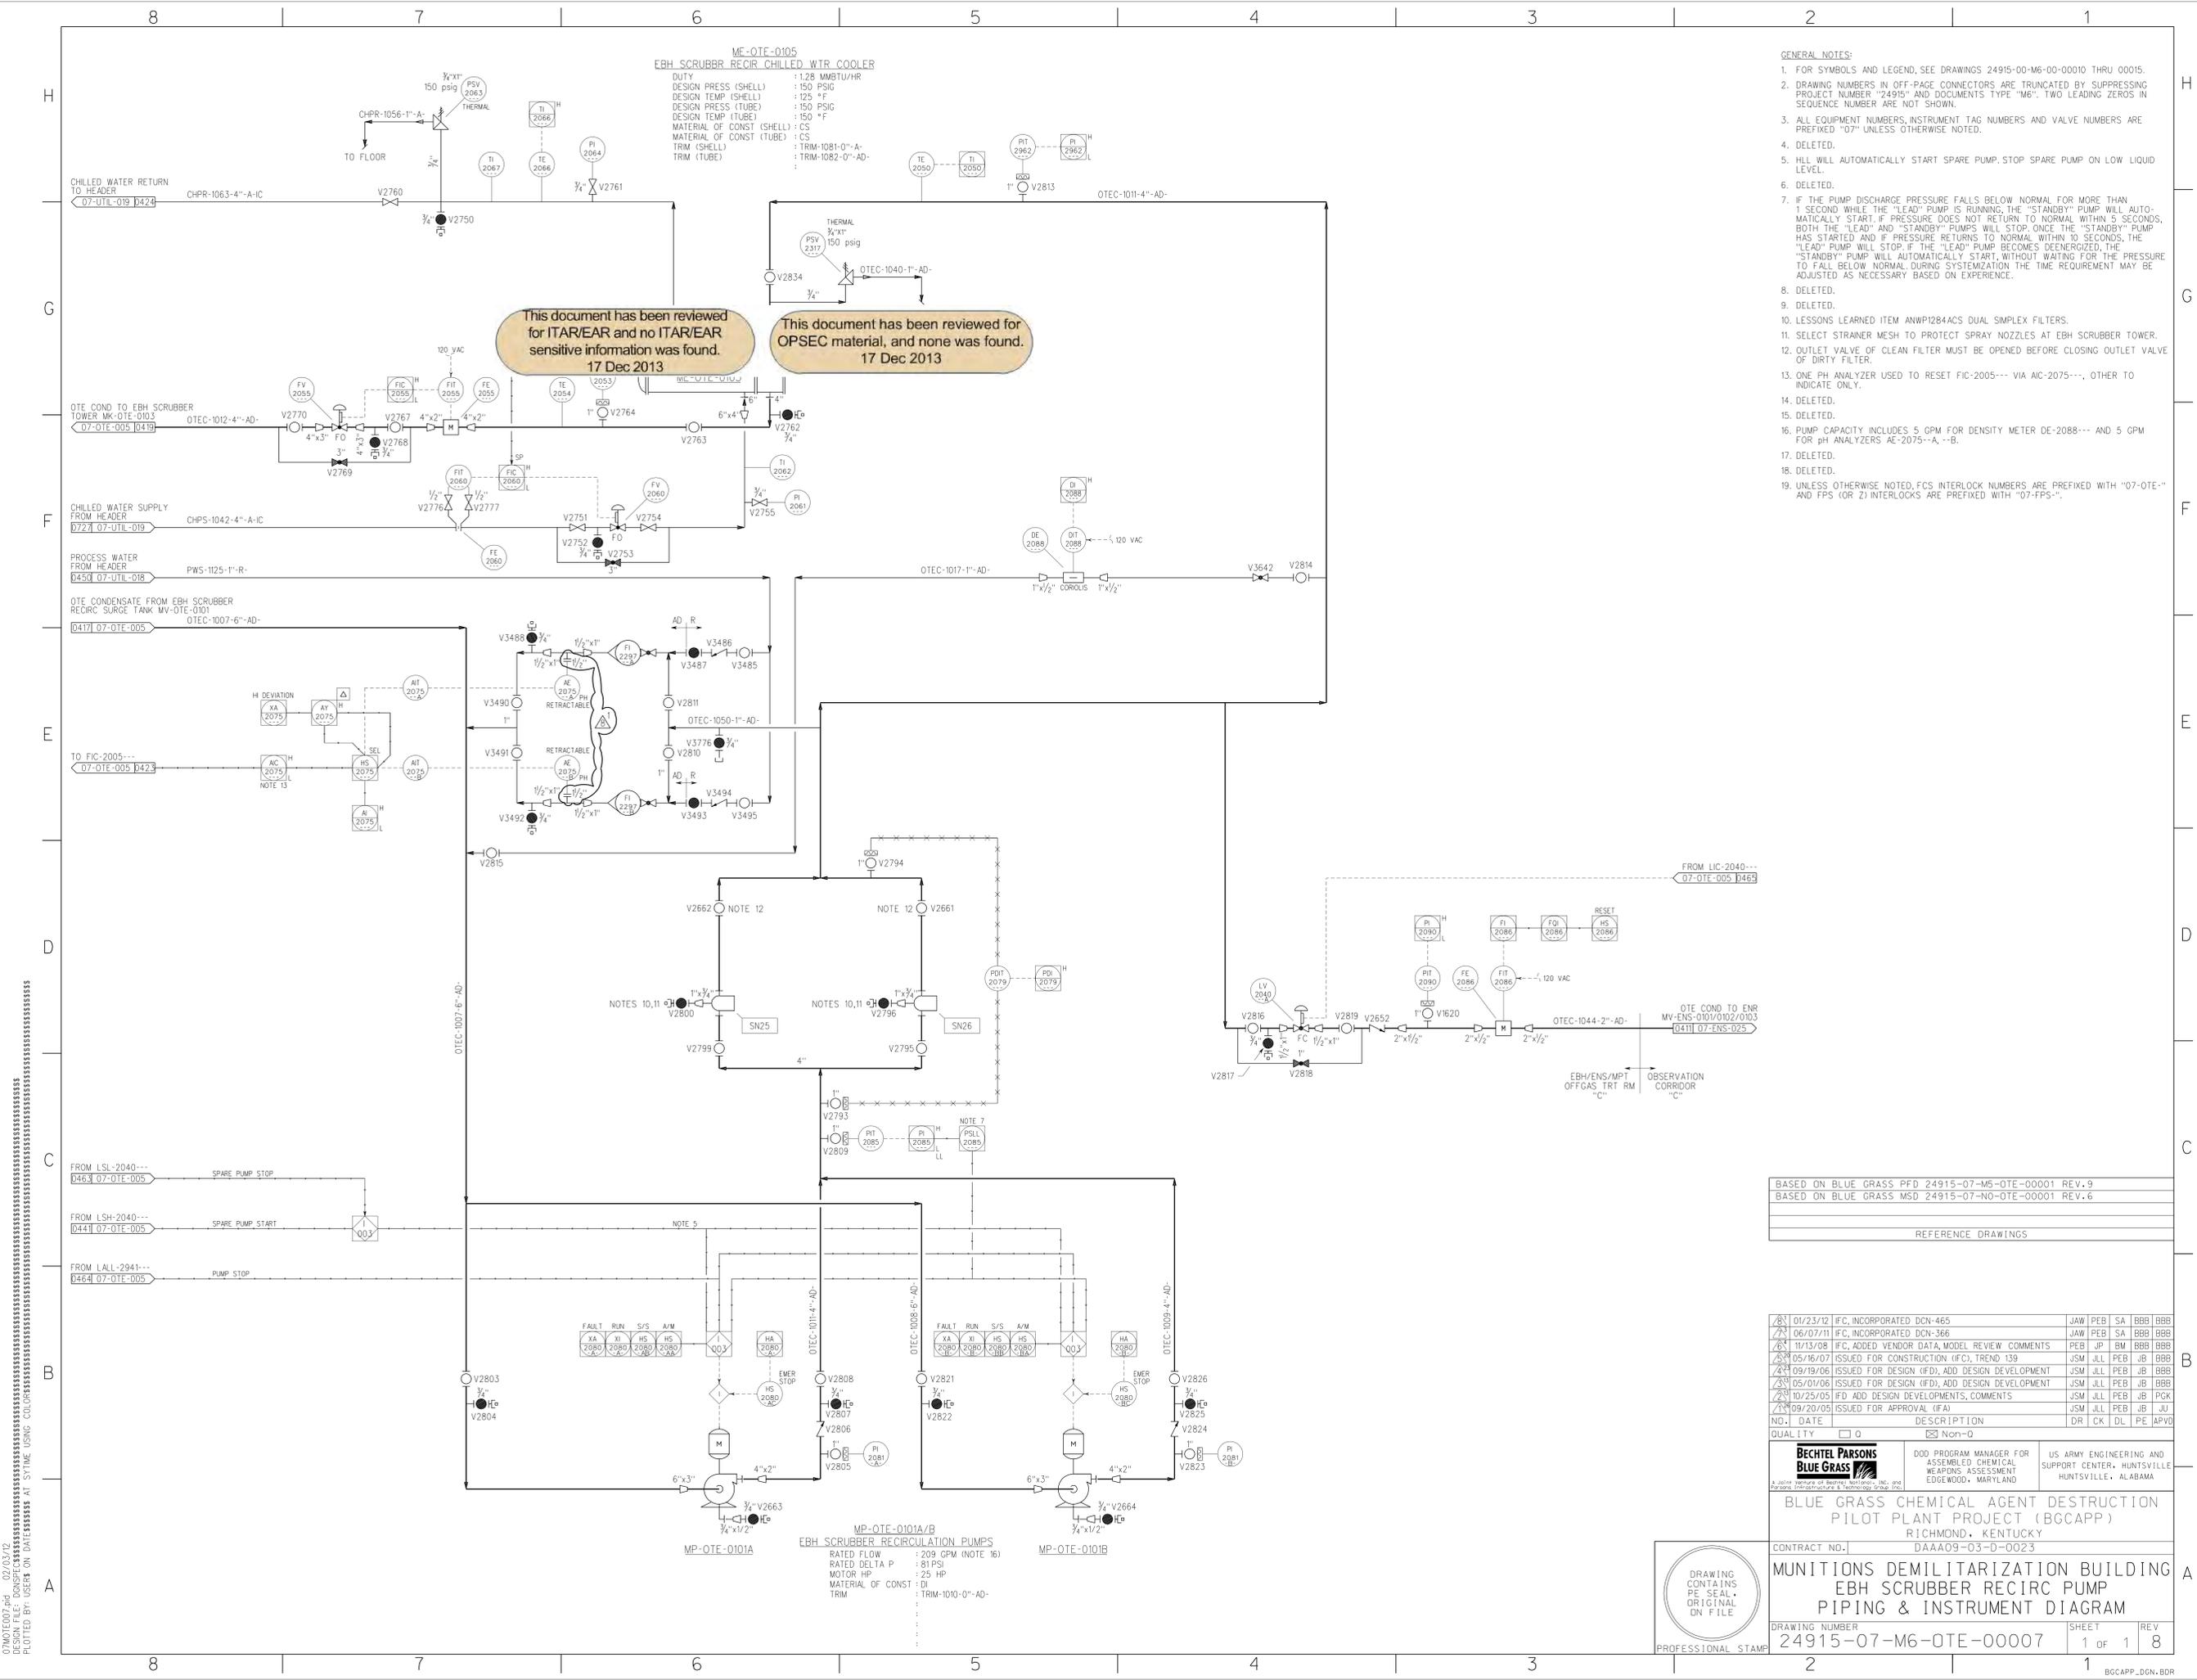

ME-OTE-0105
EBH SCRUBBER RECIRC CHILLED WTR COOLER

DUTY : 1.28 MMBTU/HR
DESIGN PRESS (SHELL) : 150 PSIG
DESIGN TEMP (SHELL) : 125 °F
DESIGN PRESS (TUBE) : 150 PSIG
DESIGN TEMP (TUBE) : 150 °F
MATERIAL OF CONST (SHELL) : CS
MATERIAL OF CONST (TUBE) : CS
TRIM (SHELL) : TRIM-1081-0"-A-
TRIM (TUBE) : TRIM-1082-0"-AD-

This document has been reviewed for ITAR/EAR and no ITAR/EAR sensitive information was found. 17 Dec 2013

This document has been reviewed for OPSEC material, and none was found. 17 Dec 2013

- GENERAL NOTES:
- FOR SYMBOLS AND LEGEND, SEE DRAWINGS 24915-00-M6-00-00010 THRU 00015.
 - DRAWING NUMBERS IN OFF-PAGE CONNECTORS ARE TRUNCATED BY SUPPRESSING PROJECT NUMBER "24915" AND DOCUMENTS TYPE "M6". TWO LEADING ZEROS IN SEQUENCE NUMBER ARE NOT SHOWN.
 - ALL EQUIPMENT NUMBERS, INSTRUMENT TAG NUMBERS AND VALVE NUMBERS ARE PREFIXED "07" UNLESS OTHERWISE NOTED.
 - DELETED.
 - HLL WILL AUTOMATICALLY START SPARE PUMP. STOP SPARE PUMP ON LOW LIQUID LEVEL.
 - DELETED.
 - IF THE PUMP DISCHARGE PRESSURE FALLS BELOW NORMAL FOR MORE THAN 1 SECOND WHILE THE "LEAD" PUMP IS RUNNING, THE "STANDBY" PUMP WILL AUTOMATICALLY START. IF PRESSURE DOES NOT RETURN TO NORMAL WITHIN 5 SECONDS, BOTH THE "LEAD" AND "STANDBY" PUMPS WILL STOP. ONCE THE "STANDBY" PUMP HAS STARTED AND IF PRESSURE RETURNS TO NORMAL WITHIN 10 SECONDS, THE "LEAD" PUMP WILL STOP. IF THE "LEAD" PUMP BECOMES DEENERGIZED, THE "STANDBY" PUMP WILL AUTOMATICALLY START, WITHOUT WAITING FOR THE PRESSURE TO FALL BELOW NORMAL. DURING SYSTEMIZATION THE TIME REQUIREMENT MAY BE ADJUSTED AS NECESSARY BASED ON EXPERIENCE.
 - DELETED.
 - DELETED.
 - LESSONS LEARNED ITEM ANWP1284ACS DUAL SIMPLEX FILTERS.
 - SELECT STRAINER MESH TO PROTECT SPRAY NOZZLES AT EBH SCRUBBER TOWER.
 - OUTLET VALVE OF CLEAN FILTER MUST BE OPENED BEFORE CLOSING OUTLET VALVE OF DIRTY FILTER.
 - ONE PH ANALYZER USED TO RESET FIC-2005--- VIA AIC-2075---, OTHER TO INDICATE ONLY.
 - DELETED.
 - DELETED.
 - PUMP CAPACITY INCLUDES 5 GPM FOR DENSITY METER DE-2088--- AND 5 GPM FOR PH ANALYZERS AE-2075--A, --B.
 - DELETED.
 - DELETED.
 - UNLESS OTHERWISE NOTED, FCS INTERLOCK NUMBERS ARE PREFIXED WITH "07-OTE-" AND FPS (OR Z) INTERLOCKS ARE PREFIXED WITH "07-FPS-".

BASED ON BLUE GRASS PFD 24915-07-M6-OTE-00001 REV.9
BASED ON BLUE GRASS MSD 24915-07-NO-OTE-00001 REV.6

REFERENCE DRAWINGS

NO.	DATE	DESCRIPTION	DR	CK	DL	PE	APVD
8	01/23/12	IFC, INCORPORATED DCN-465	JAW	PEB	SA	BBB	BBB
7	06/07/11	IFC, INCORPORATED DCN-366	JAW	PEB	SA	BBB	BBB
6	11/13/08	IFC, ADDED VENDOR DATA, MODEL REVIEW COMMENTS	PEB	JP	BM	BBB	BBB
5	05/16/07	ISSUED FOR CONSTRUCTION (IFC), TREND 139	JSM	JLL	PEB	JB	BBB
4	09/19/06	ISSUED FOR DESIGN (IFD), ADD DESIGN DEVELOPMENT	JSM	JLL	PEB	JB	BBB
3	05/01/06	ISSUED FOR DESIGN (IFD), ADD DESIGN DEVELOPMENT	JSM	JLL	PEB	JB	BBB
2	10/25/05	IFD ADD DESIGN DEVELOPMENTS, COMMENTS	JSM	JLL	PEB	JB	PCK
1	09/20/05	ISSUED FOR APPROVAL (IFA)	JSM	JLL	PEB	JB	JU

QUALITY Non-Q

BECHTEL PARSONS
A joint venture of Bechtel Corporation, Inc. and Parsons Infrastructure & Technology Group, Inc.

DDO PROGRAM MANAGER FOR ASSEMBLED CHEMICAL WEAPONS ASSESSMENT EDgewood, MARYLAND

US ARMY ENGINEERING AND SUPPORT CENTER, HUNTSVILLE, ALABAMA

BLUE GRASS CHEMICAL AGENT DESTRUCTION PILOT PLANT PROJECT (BCAPP)
RICHMOND, KENTUCKY
DAAA09-03-D-0023

MUNITIONS DEMILITARIZATION BUILDING EBH SCRUBBER RECIRC PUMP PIPING & INSTRUMENT DIAGRAM

CONTRACT NO. | DRAWING NUMBER | SHEET | REV
24915-07-M6-OTE-00007 | 1 OF 1 | 8




07MTE007.rvt 02/03/12
 DESIGN FILE: DONSPEC... AT SYTIME USING COLOR...
 PLOTTED BY: USER ON DATE...

This document has been reviewed for ITAR/EAR and no ITAR/EAR sensitive information was found. 17 Dec 2013

This document has been reviewed for OPSEC material, and none was found. 17 Dec 2013

- GENERAL NOTES:
- FOR SYMBOLS AND LEGEND, SEE DRAWINGS 24915-00-M6-00-0010 THRU 00015.
 - DRAWING NUMBERS IN OFF-PAGE CONNECTORS ARE TRUNCATED BY SUPPRESSING PROJECT NUMBER "24915" AND DOCUMENTS TYPE "M6". TWO LEADING ZEROS IN SEQUENCE NUMBER ARE NOT SHOWN.
 - ALL EQUIPMENT NUMBERS, INSTRUMENT TAG NUMBERS AND VALVE NUMBERS ARE PREFIXED "07" UNLESS OTHERWISE NOTED.
 - FOR CONVEYOR LAYOUT/LOCATION SEE MATERIALS HANDLING EQUIPMENT GENERAL ARRANGEMENT DRAWING 24915-07-MJ-00-0002.
 - SEE P&ID 24915-07-M6-RHS-00051 FOR INSTRUMENT DETAILS.
 - EQUIPMENT SHOWN DOTTED AND ASSOCIATED INSTRUMENTS ARE ALSO SHOWN ON DRAWING 24915-07-M6-RHS-00051.
 - INSTRUMENTATION AND VALVING SHOWN ON HVAC DRAWING NUMBER 24915-07-M6-HVAC-00129.
 - INLET GATE AD-RHS-0118 SHALL BE INTERLOCKED WITH OUTLET GATE AD-RHS-0107. A TIMER PREVENTS INLET GATE FROM OPENING AFTER OUTLET GATE AD-RHS-0107 CLOSES UNTIL THE AIRLOCK HAS GONE THROUGH PROPER AIR CHANGES.
 - NOT USED DURING PROJECTILE CAMPAIGN.
 - PROJECTILE ORIENTATION SWITCH TO BE ENABLED DURING PROJECTILE CAMPAIGN.
 - REVISIONS TO THIS DRAWING BY OPERATIONS AFTER IFC ISSUE SHOULD ALSO BE REFLECTED ON DRAWING 24915-07-M6-RHS-00051.
 - WARNING LIGHT IS INTERLOCKED TO TURN ON 10 SECONDS BEFORE CONVEYOR MOTOR STARTS AND TURN OFF WHEN MOTOR STOPS.
 - UNLESS OTHERWISE NOTED, FCS INTERLOCK NUMBERS ARE PREFIXED WITH "07-PHS-" AND FPS (OR Z) INTERLOCKS ARE PREFIXED WITH "07-FPS-".
 - GATE CLEAR SWITCHES SHOWN ON AIRLOCK GATE ARE PHYSICALLY LOCATED ON ADJACENT CONVEYORS.
 - BOTH ZSO SHALL BE WIRED IN SERIES. BOTH ZSO NEED TO BE ACTIVATED TO SHOW GATE OPENED POSITION.

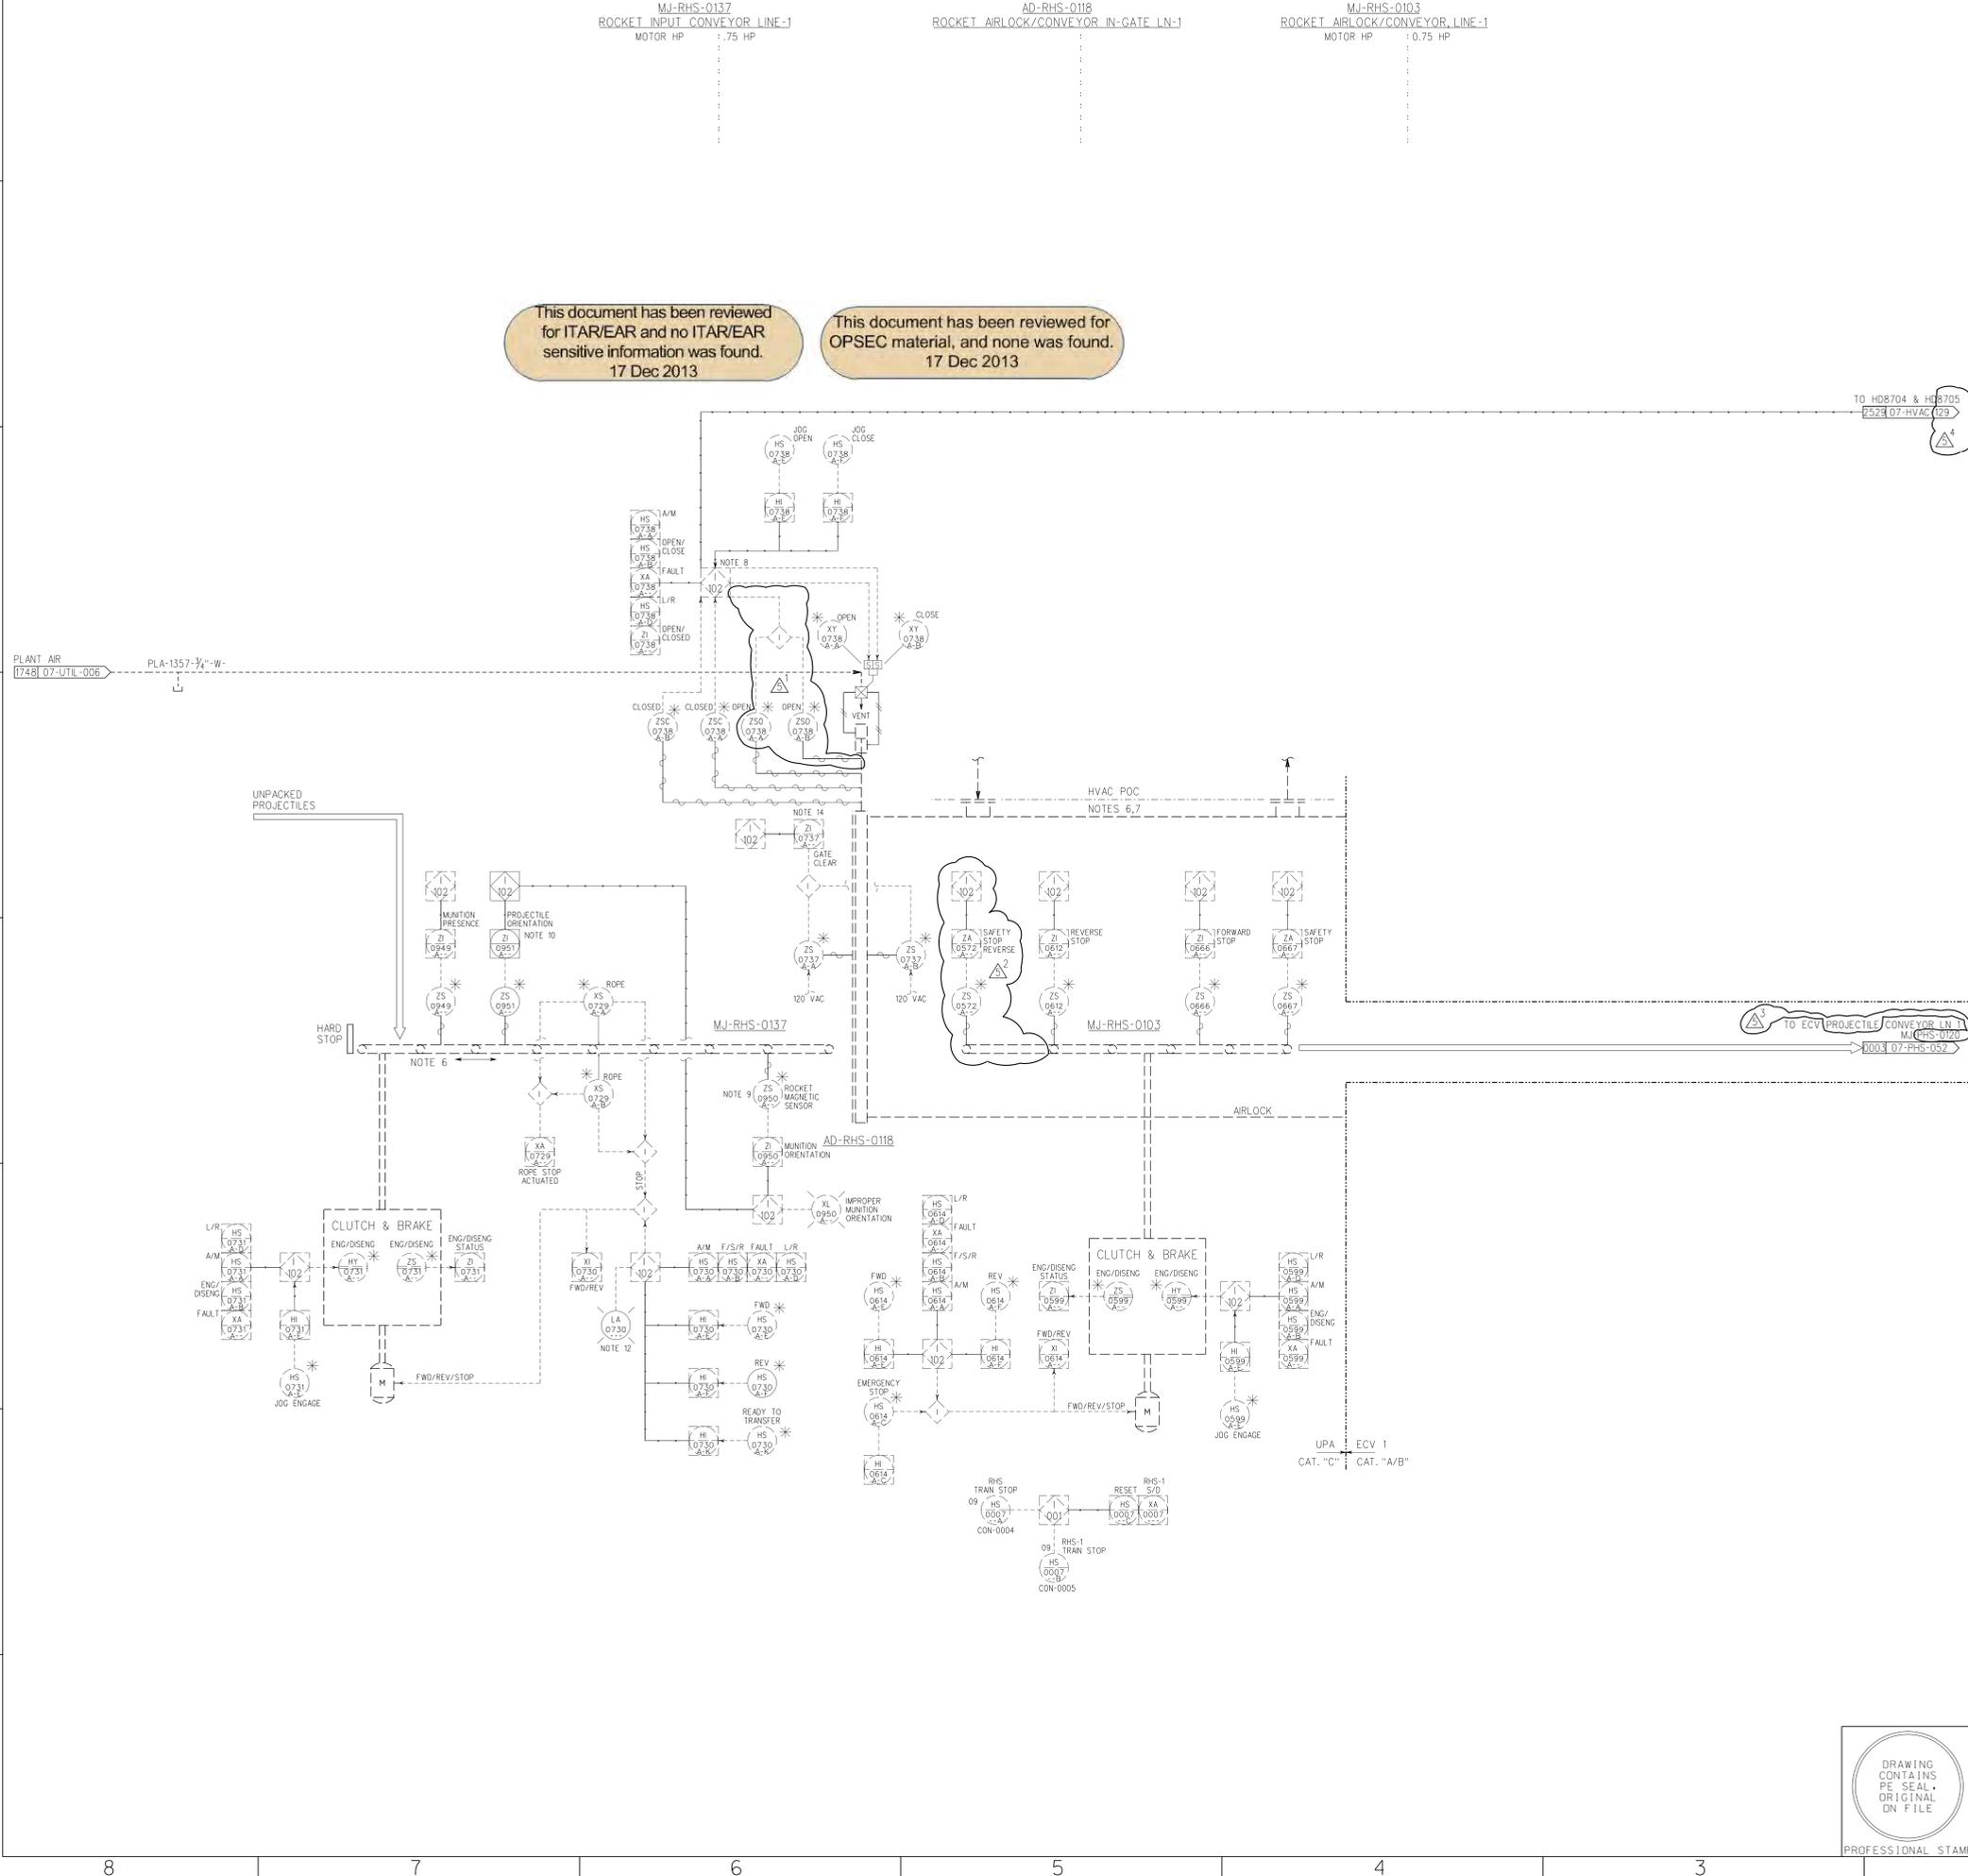

BASED ON BLUE GRASS P&ID 24915-07-M6-PHS-00001 REV. 0

REFERENCE DRAWINGS

NO.	DATE	DESCRIPTION	DR	CK	DL	PE	APVD
1	03/07/06	ISSUED FOR DESIGN (IFD)	RZ	JLL	PEB	JB	BBB
2	04/19/06	ISSUED FOR DESIGN (IFD), ADD DESIGN DEVELOPMENT	RZ	JLL	PEB	JB	BBB
3	05/05/06	ISSUED FOR DESIGN (IFD), ADD DESIGN DEVELOPMENT	RZ	JLL	PEB	JB	BBB
4	11/02/06	IFD, ADDED GOV COMMENTS AND INTERLOCK TAG NO.	RZ	JLL	PEB	JB	BBB
5	02/14/07	IFC, CLARIFIED INSTR SUPP W/EQUIP, ADDED NOTE 14	RZ	JLL	PEB	JB	BBB
6	06/30/09	IFC, REVISED PER HTL-879-881, CORRECTED DESTINATION	JLL	PEB	BM	BBB	BBB

BECHTEL PARSONS BLUE GRASS
 DOD PROGRAM MANAGER FOR ASSEMBLED CHEMICAL WEAPONS ASSESSMENT EDGEWOOD, MARYLAND
 US ARMY ENGINEERING AND SUPPORT CENTER, HUNTSVILLE, ALABAMA

BLUE GRASS CHEMICAL AGENT DESTRUCTION PILOT PLANT PROJECT (BCAPP)
 RICHMOND, KENTUCKY
 DAAA09-03-D-0023

MUNITIONS DEMILITARIZATION BUILDING PROJECTILE INPUT CONVEYOR PIPING & INSTRUMENT DIAGRAM

DRAWING NUMBER: 24915-07-M6-PHS-00051
 SHEET: 1 OF 1
 REV: 5

DRAWING CONTAINS PE SEAL ORIGINAL ON FILE
 PROFESSIONAL STAMP


07M6PHS0051.dwg 07/02/09
 DESIGN FILE: DONSPEC
 PLOTTED BY: USER ON DATE: 07/02/09

MJ-RHS-0101 ROCKET INPUT ASSEMBLY LINE-1
 MJ-RHS-0137 ROCKET INPUT CONVEYOR LINE-1 MOTOR HP : 0.75 HP
 AD-RHS-0118 ROCKET AIRLOCK/CONVEYOR IN-GATE LN-1
 MJ-RHS-0103 ROCKET AIRLOCK/CONVEYOR LINE-1 MOTOR HP : 0.75 HP

- GENERAL NOTES:
- FOR SYMBOLS AND LEGEND, SEE DRAWINGS 24915-00-M6-00-00010 THRU 00015.
 - DRAWING NUMBERS IN OFF-PAGE CONNECTORS ARE TRUNCATED BY SUPPRESSING PROJECT NUMBER "24915" AND DOCUMENTS TYPE "M6". TWO LEADING ZEROS IN SEQUENCE NUMBER ARE NOT SHOWN.
 - ALL EQUIPMENT NUMBERS, INSTRUMENT TAG NUMBERS AND VALVE NUMBERS ARE PREFIXED "07" UNLESS OTHERWISE NOTED.
 - DELAY START WARNING DEVICES ARE PROVIDED ON ALL REMOTELY CONTROLLED CONVEYOR LINES AS SHOWN ON THE CONTROL SYSTEM INPUT/OUTPUT REPORT.
 - FOR CONVEYOR LAYOUT/LOCATION, SEE MATERIALS HANDLING EQUIPMENT GENERAL ARRANGEMENT DRAWING 24915-07-MJ-00-00002.
 - TRAIN STOP EMERGENCY PUSH BUTTONS DETAILS TO BE PROVIDED LATER.
 - INSTRUMENTATION AND VALVING SHOWN ON HVAC DRAWING NUMBER 24915-07-M6-HVAC-00129.
 - INLET GATE AD-RHS-0118 SHALL BE INTERLOCKED WITH OUTLET GATE AD-RHS-0107. A TIMER PREVENTS INLET GATE FROM OPENING AFTER OUTLET GATE AD-RHS-0107 CLOSES UNTIL THE AIRLOCK HAS GONE THROUGH PROPER AIR CHANGES.
 - PROJECTILE PRESENCE SWITCH ZS-0951A- ALSO SHOWN ON DWG 24915-07-M6-PHS-00051 WILL BE INOPERABLE DURING ROCKET CAMPAIGN.
 - DURING THE ROCKET CAMPAIGN THE ROPE SWITCH ON THE WEST SIDE OF THE CONVEYOR SHALL BE DEACTIVATED.
 - DELETED.
 - UNLESS OTHERWISE NOTED, FCS INTERLOCK NUMBERS ARE PREFIXED WITH "07-RHS-" AND FPS (OR Z) INTERLOCKS ARE PREFIXED WITH "07-FPS-".
 - WARNING LIGHT SHALL BE OPERATIONAL DURING PROJECTILE PROCESSING ONLY.
 - GATE CLEAR SWITCHES SHOWN ON AIRLOCK GATE ARE PHYSICALLY LOCATED ON ADJACENT CONVEYORS.
 - 4-WAY DIRECTIONAL PNEUMATIC CONTROL VALVE, 3 POSITIONS, SOLENOID OPERATED, SPRING CENTERED, CENTER BLOCKED.

This document has been reviewed for ITAR/EAR and no ITAR/EAR sensitive information was found. 17 Dec 2013

This document has been reviewed for OPSEC material, and none was found. 17 Dec 2013

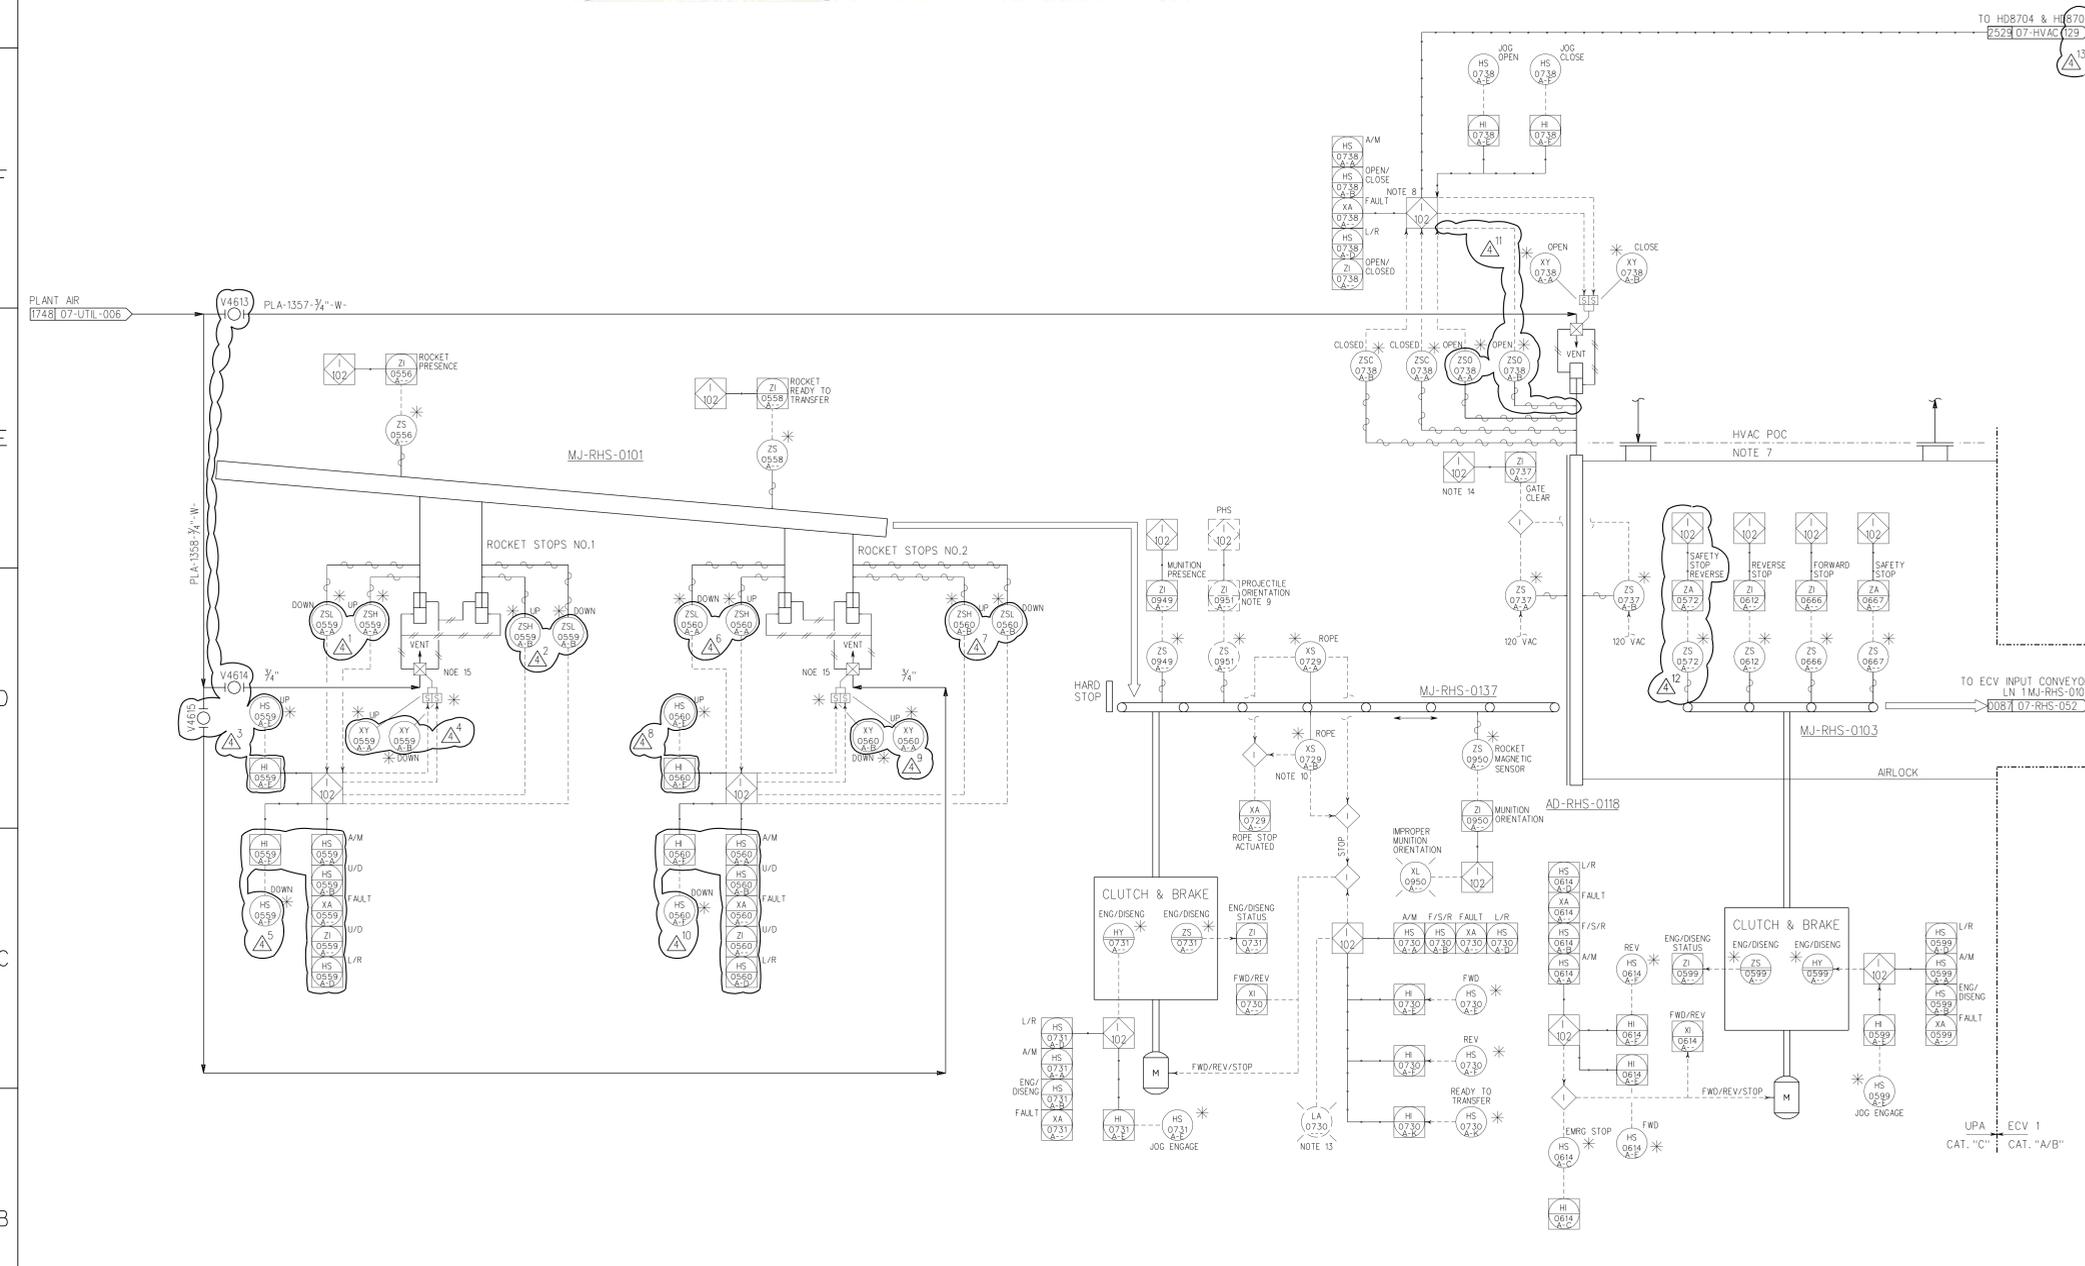

BASED ON BLUE GRASS PFD 24915-07-M6-RHS-00001 REV. 0
 BASED ON BLUE GRASS P&ID 24915-07-M6-RHS-00001 REV. 0

NO.	DATE	DESCRIPTION	DR	CK	DL	PE	APVD
24	08/11/09	IFC, ADD HTL-879/881, REVISED DESIGN REQUIREMENTS	JLL	PEB	BM	BBB	BBB
34	02/14/07	IFC, CLAR INSTR SUPP W/EQUIP, REVISED ROCKET STOP	RZ	JLL	PEB	JB	BBB
28	11/07/06	IFD, ADDED GOV. COMMENTS AND ROCKET STOPS	RZ	JLL	PEB	JB	BBB
13	05/04/06	ISSUED FOR DESIGN (IFD), ADD DESIGN DEVELOPMENT	RZ	JLL	PEB	JB	BBB
6	03/13/06	ISSUED FOR DESIGN (IFD)	RZ	JLL	PEB	JB	BBB

QUALITY Non-0

BECHTEL PARSONS BLUE GRASS

DOD PROGRAM MANAGER FOR ASSEMBLED CHEMICAL WEAPONS ASSESSMENT EDgewood, MARYLAND

US ARMY ENGINEERING AND SUPPORT CENTER, HUNTSVILLE, ALABAMA

BLUE GRASS CHEMICAL AGENT DESTRUCTION PILOT PLANT PROJECT (BCAPP) RICHMOND, KENTUCKY

CONTRACT NO. DAAA09-03-D-0023

MUNITIONS DEMILITARIZATION BUILDING ROCKET PROCESSING SYSTEM DWG-1LN1 PIPING & INSTRUMENT DIAGRAM

DRAWING NUMBER 24915-07-M6-RHS-00051 SHEET 1 OF 1 REV 4

DRAWING CONTAINS PE SEAL. ORIGINAL ON FILE

PROFESSIONAL STAMP

07MRHS0051.dwg 08/11/09
 DESIGN FILE: DONSPEC
 PLOTTED BY: USER ON DATE: 08/11/09

AD-RHS-0107 NOTE 11
UPA BLAST GATE - LINE 1
MOTOR HP : 8.2 HP

AD-RHS-0113 NOTE 11
ECV FONC ACCESS BLAST DOOR, ECV-1
MOTOR HP (A) : 1 HP
MOTOR HP (B) : 3 HP
MOTOR HP (C) : 3 HP
MOTOR HP (D) : 3 HP

MJ-RHS-0105
RCM INLET CONVEYOR, LINE 1
MOTOR HP : 0.25 HP DC

- GENERAL NOTES:
- FOR SYMBOLS AND LEGEND, SEE DRAWINGS 24915-00-M6-00-00010 THRU 00015.
 - DRAWING NUMBERS IN OFF-PAGE CONNECTORS ARE TRUNCATED BY SUPPRESSING PROJECT NUMBER "24915" AND DOCUMENTS TYPE "M6". TWO LEADING ZEROS IN SEQUENCE NUMBER ARE NOT SHOWN.
 - ALL EQUIPMENT NUMBERS, INSTRUMENT TAG NUMBERS AND VALVE NUMBERS ARE PREFIXED "07" UNLESS OTHERWISE NOTED.
 - FOR CONVEYOR LAYOUT/LOCATION SEE MATERIALS HANDLING EQUIPMENT GENERAL ARRANGEMENT DRAWING 24915-07-MJ-00-00002.
 - WHEN DOOR AND LATCHES ARE IN AUTO MODE, OPEN COMMAND SHALL UNLATCH AND OPEN THE DOOR AND CLOSE COMMAND SHALL CLOSE AND LATCH THE DOOR.
 - UNLESS OTHERWISE NOTED, FCS INTERLOCK NUMBERS ARE PREFIXED WITH "07-RHS-" AND FPS (OR Z) INTERLOCKS ARE PREFIXED WITH "07-FPS-".
 - ALL COMPONENTS INSIDE DASHED LINE WILL BE DESIGNED, PROCURED AND FABRICATED BY PASCO.
 - GATE CLEAR SWITCHES SHOWN ON BLAST GATE ARE PHYSICALLY LOCATED ON THE ADJACENT CONVEYORS.
 - EMERGENCY STOP SWITCHES SHALL BE PROVIDED BY THE GATE/DOOR VENDOR MOUNTED SEPARATELY IN A CONTROL BOX AND SHIPPED LOOSE TO BE INSTALLED IN THE FIELD.
 - ONE PANEL MOUNT EMERGENCY STOP PUSH BUTTON AND ONE REMOTE HANDHELD CONTROL WITH UMBILICAL CABLE ARE INSTALLED AT FIELD JUNCTION BOX EJ-FCS-TBF-6214.
 - BLAST GATE AD-RHS-0107 AND BLAST DOOR AD-RHS-0113 AND ALL ASSOCIATED INSTRUMENTS, MOTORS AND COMPONENTS ARE "Q".
 - EXPLOSION DETECTORS IN SERIES.

This document has been reviewed for ITAR/EAR and no ITAR/EAR sensitive information was found. 17 Dec 2013

This document has been reviewed for OPSEC material, and none was found. 17 Dec 2013


FOR CONTINUATION SEE DWG 24915-07-M6-RHS-00053

EXPLOSIVE CONTAINMENT VESTIBULE
ECV-1

AD-RHS-0113

AD-RHS-0107

MJ-RHS-0105

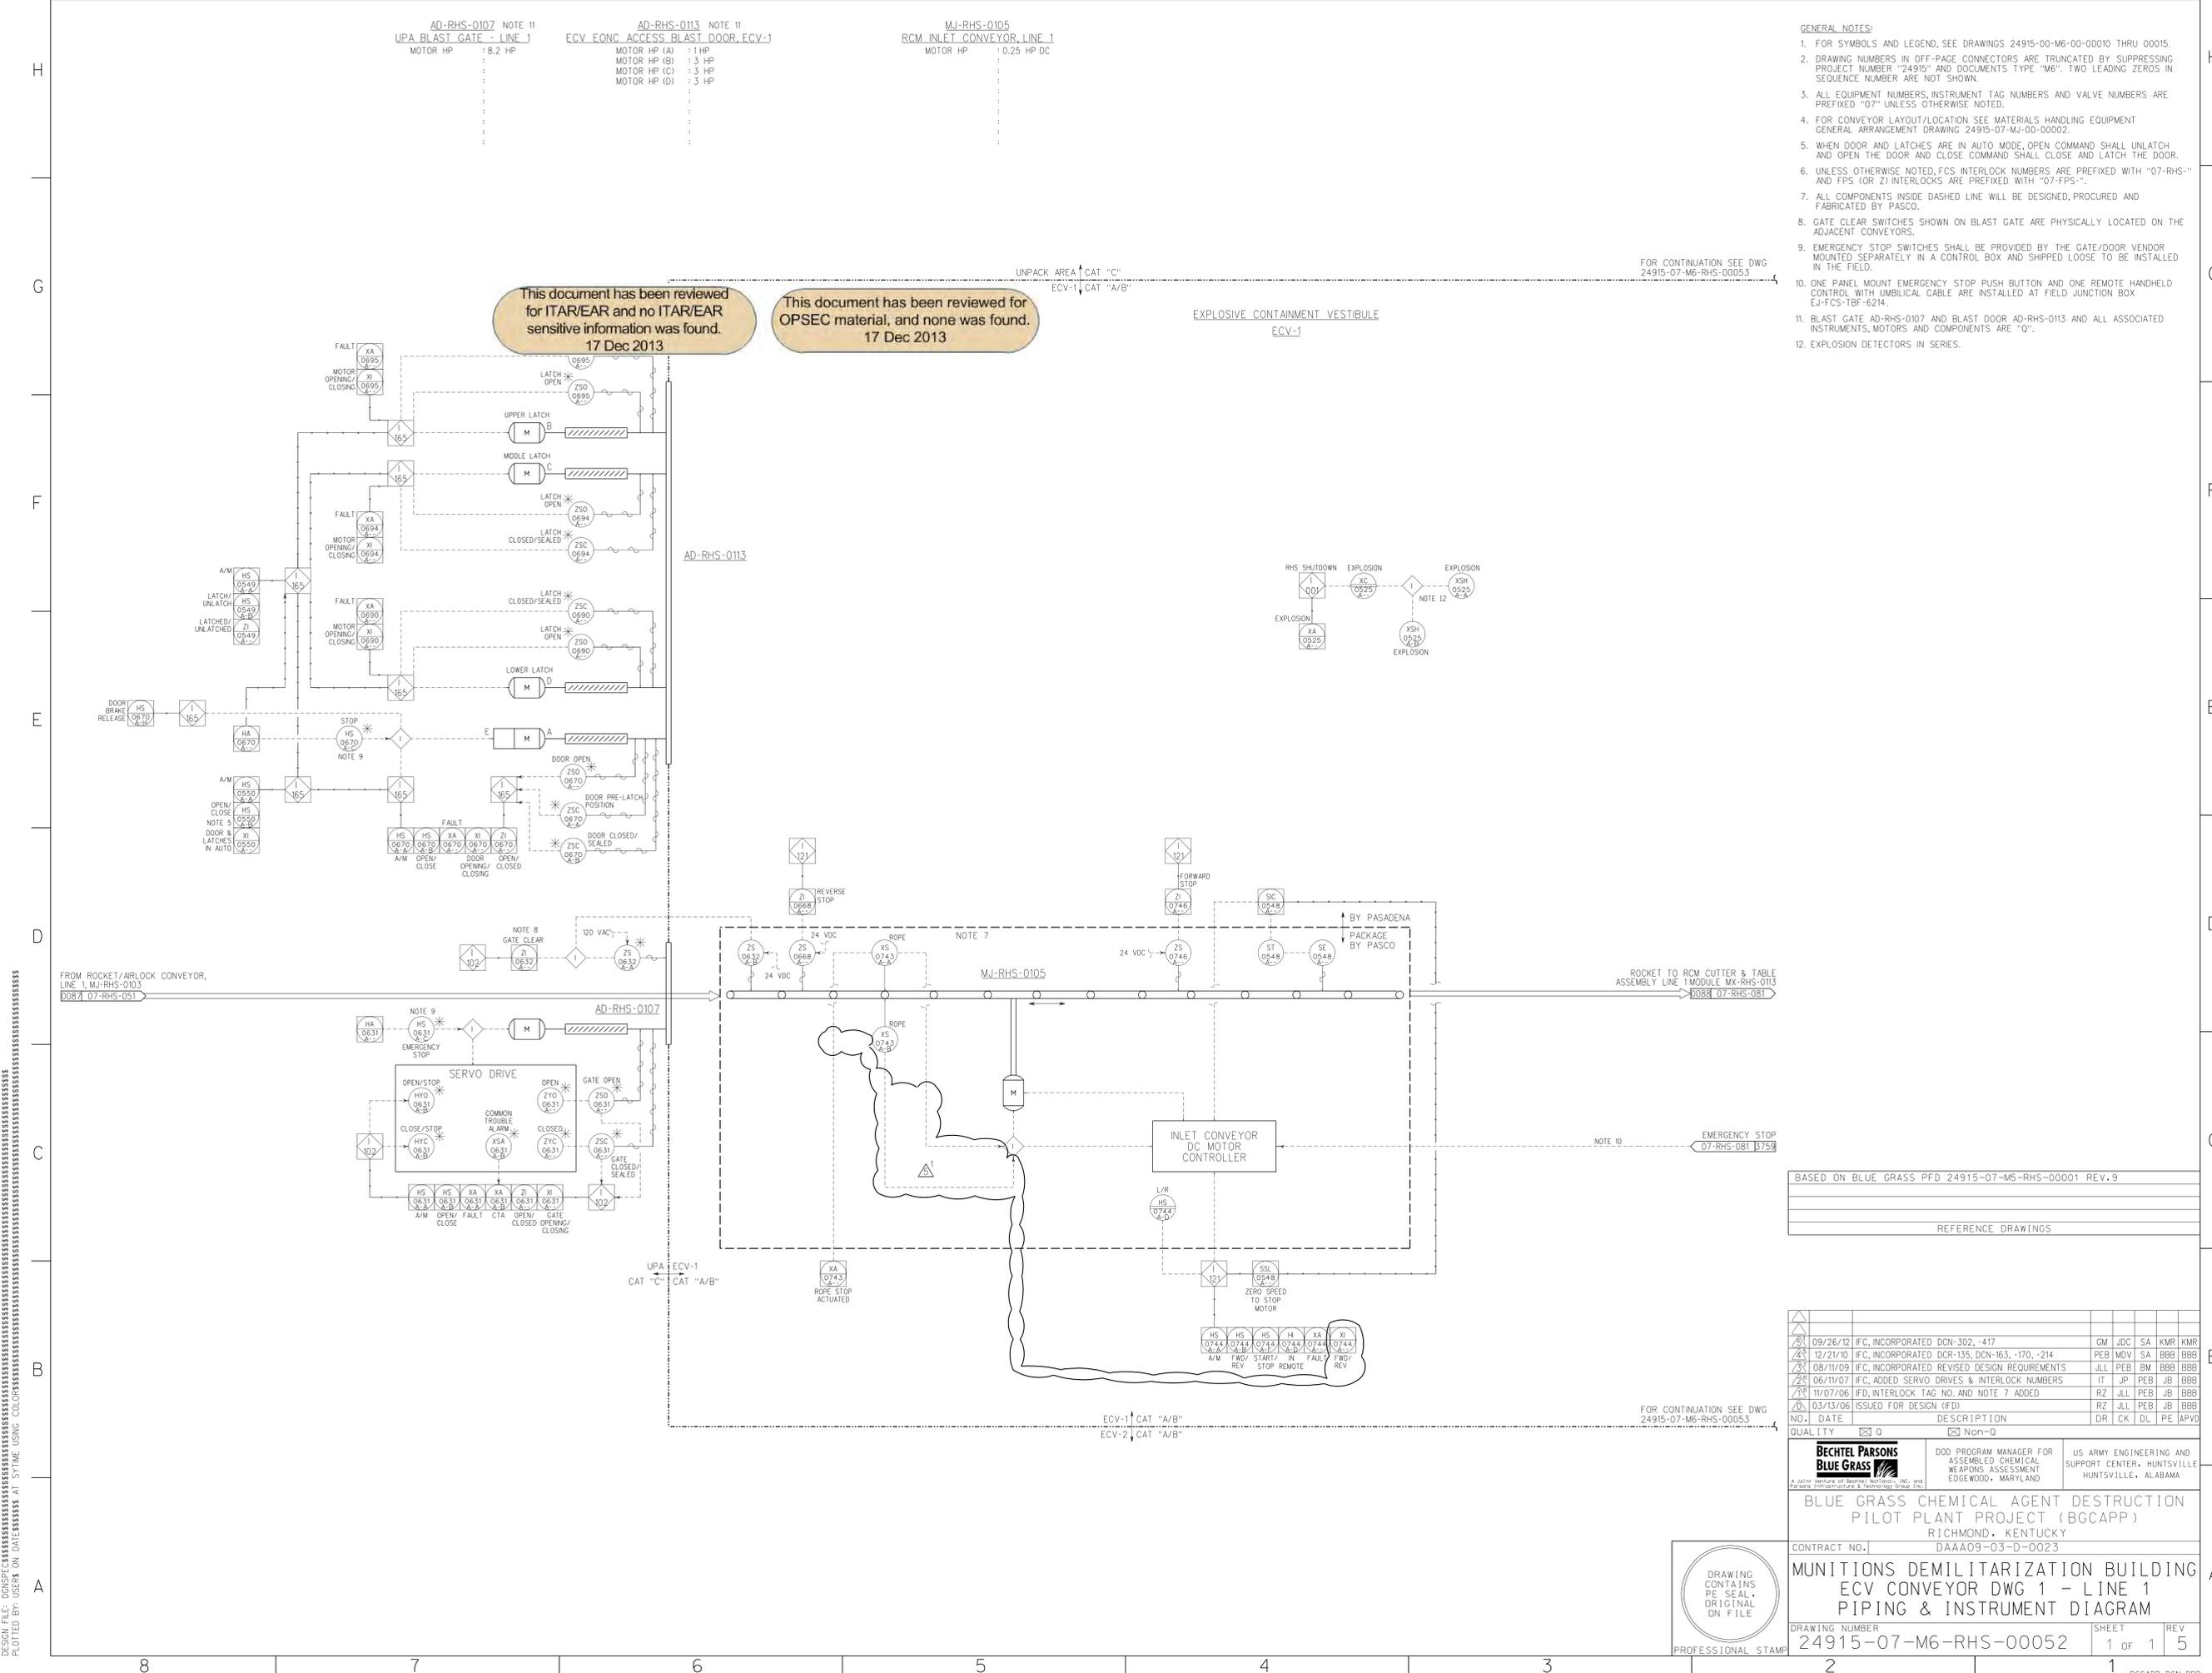

BASED ON BLUE GRASS PFD 24915-07-M6-RHS-00001 REV.9

REFERENCE DRAWINGS

NO.	DATE	DESCRIPTION	DR	CK	DL	PE	APVD
1	09/26/12	IFC, INCORPORATED DCN-302, -417	GM	JDC	SA	KMR	KMR
2	12/21/10	IFC, INCORPORATED DCR-135, DCN-163, -170, -214	PEB	MDV	SA	BBB	BBB
3	08/11/09	IFC, INCORPORATED REVISED DESIGN REQUIREMENTS	JLL	PEB	BM	BBB	BBB
4	06/11/07	IFC, ADDED SERVO DRIVES & INTERLOCK NUMBERS	IT	JP	PEB	JB	BBB
5	11/07/06	IFC, INTERLOCK TAG NO. AND NOTE 7 ADDED	RZ	JLL	PEB	JB	BBB
6	03/13/06	ISSUED FOR DESIGN (IFD)	RZ	JLL	PEB	JB	BBB

BECHTEL PARSONS BLUE GRASS
DOD PROGRAM MANAGER FOR ASSEMBLED CHEMICAL WEAPONS ASSESSMENT EDGEWOOD, MARYLAND
US ARMY ENGINEERING AND SUPPORT CENTER, HUNTSVILLE, ALABAMA


BLUE GRASS CHEMICAL AGENT DESTRUCTION PILOT PLANT PROJECT (BCAPP)
RICHMOND, KENTUCKY
DAAA09-03-D-0023

MUNITIONS DEMILITARIZATION BUILDING
ECV CONVEYOR DWG 1 - LINE 1
PIPING & INSTRUMENT DIAGRAM

DRAWING NUMBER: 24915-07-M6-RHS-00052
SHEET: 1 OF 1
REV: 5



07MRHS002.dwg 09/26/12 DESIGN FILE: DONSPEC AT SYTIME USING COLORPLOT PLOTTED BY USER ON DATE: 09/26/12

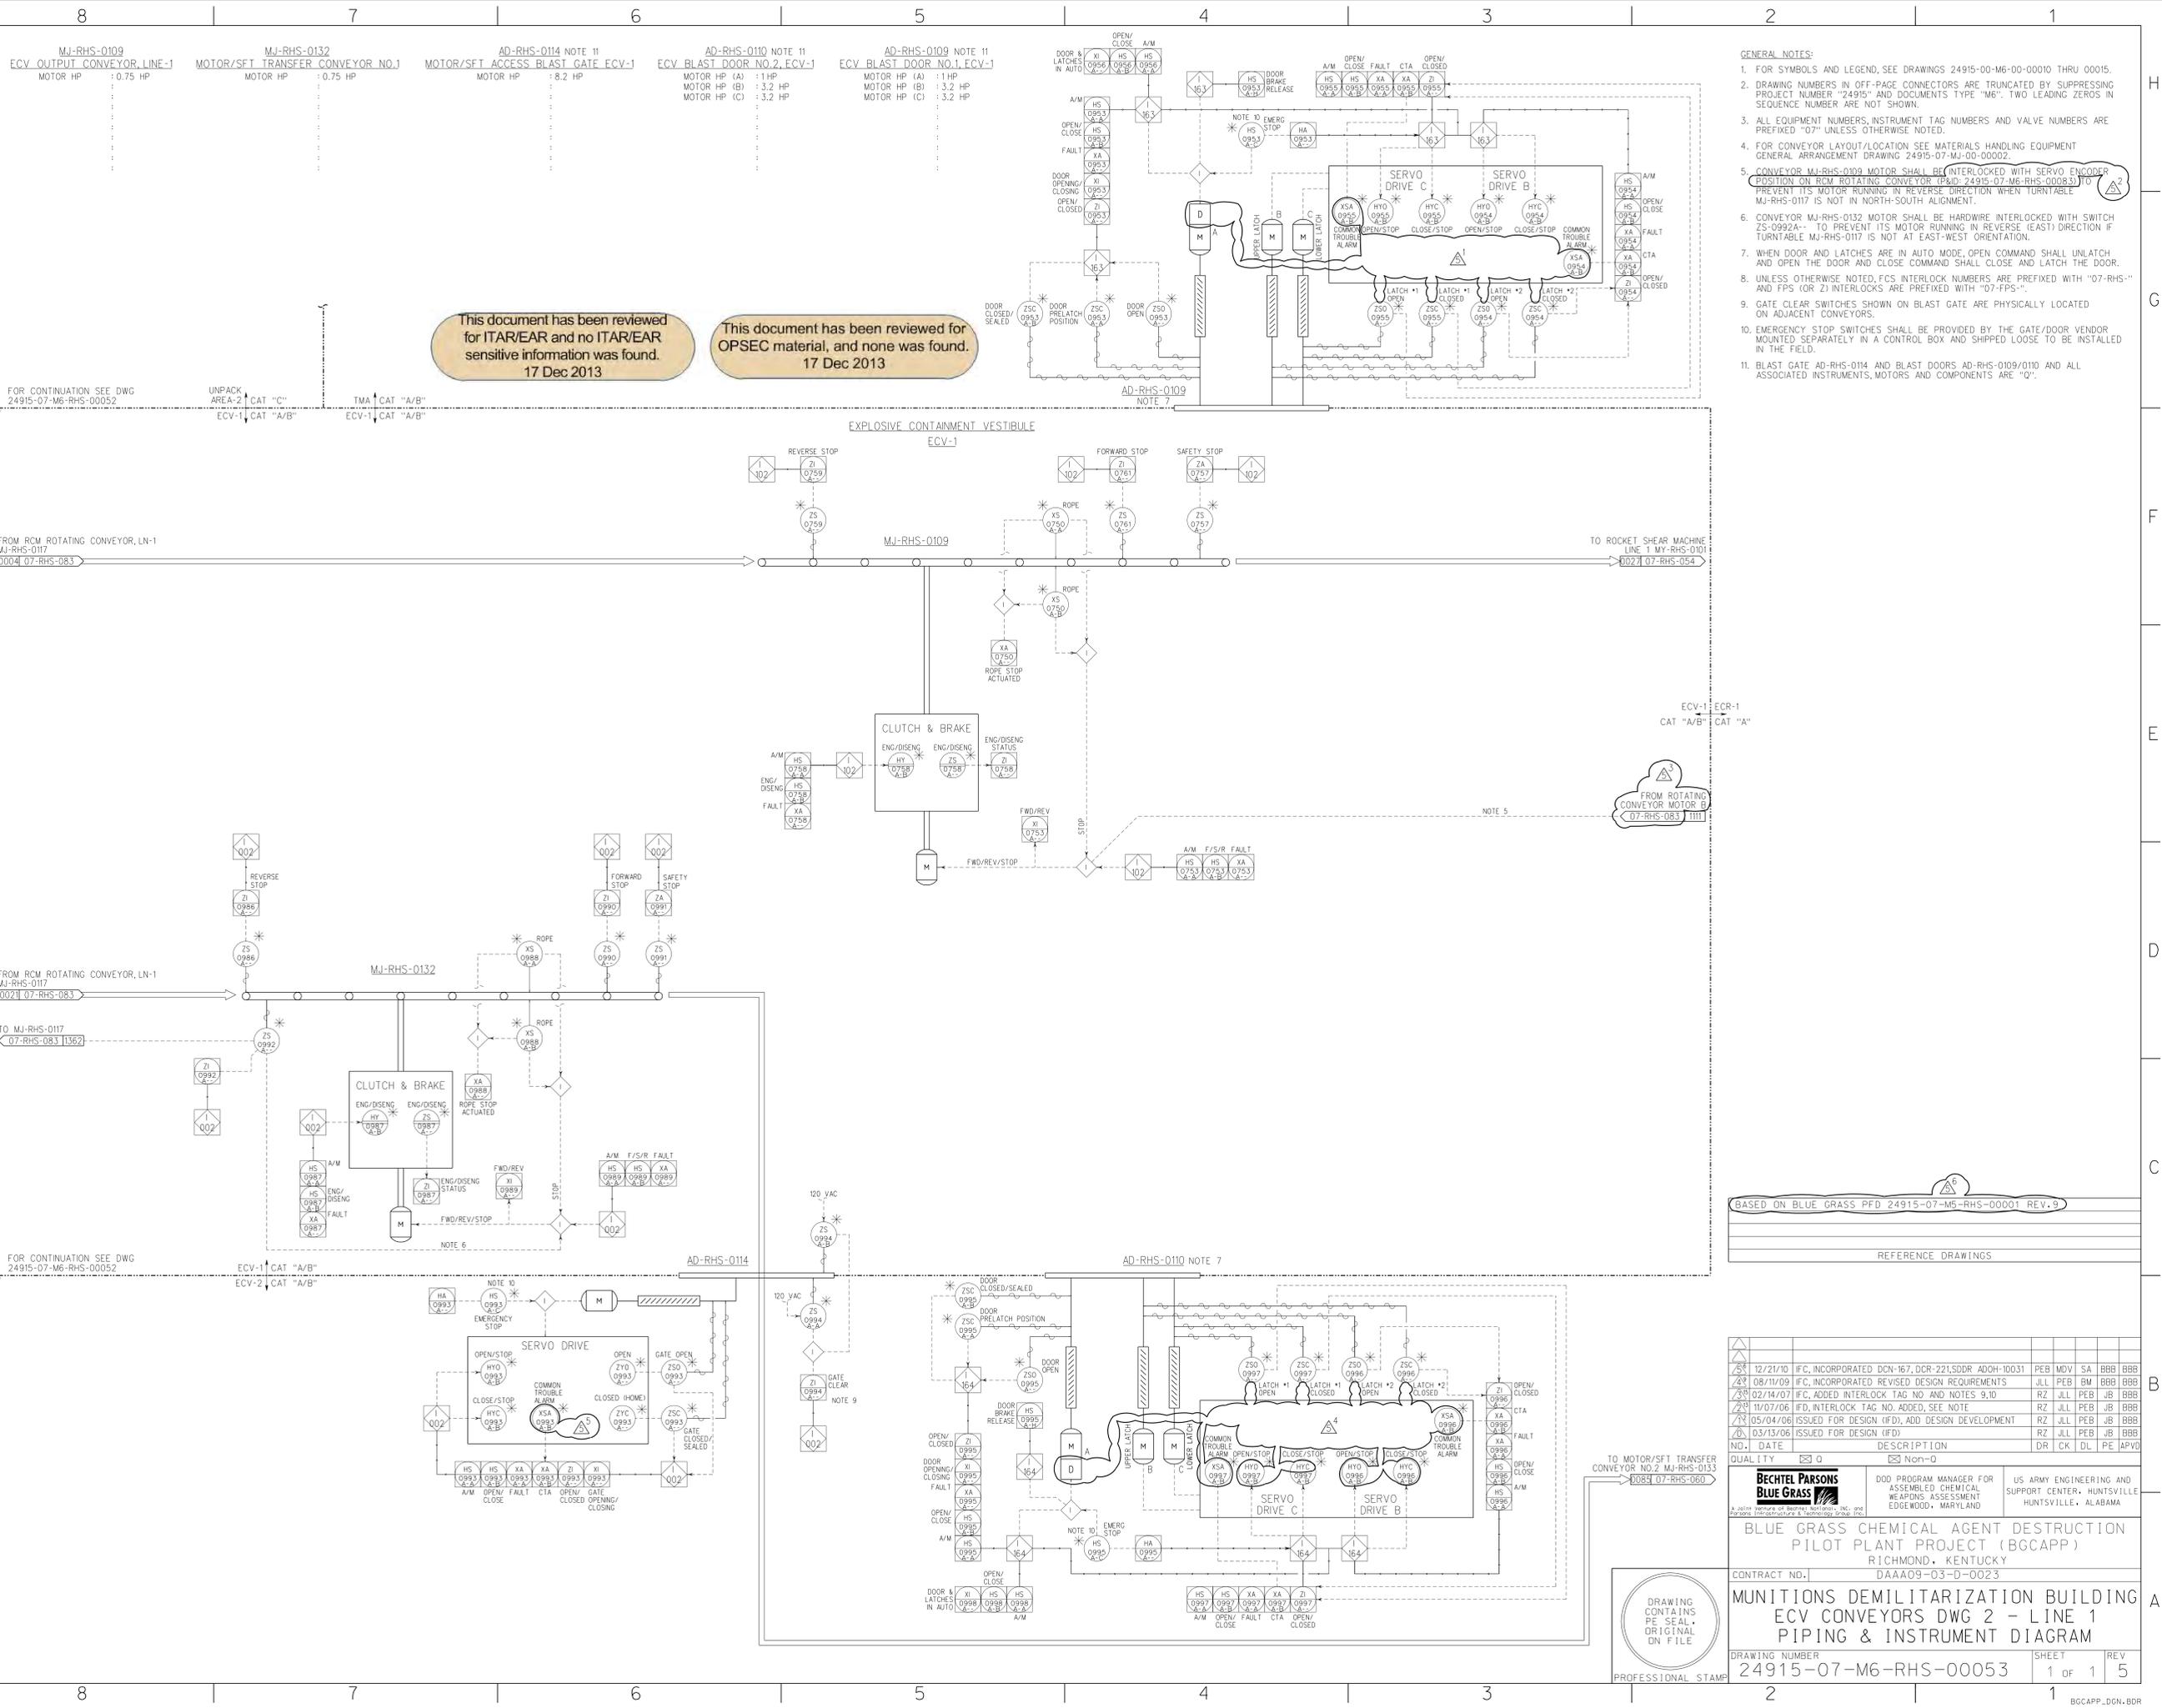

- GENERAL NOTES:
- FOR SYMBOLS AND LEGEND, SEE DRAWINGS 24915-00-M6-00-00010 THRU 00015.
 - DRAWING NUMBERS IN OFF-PAGE CONNECTORS ARE TRUNCATED BY SUPPRESSING PROJECT NUMBER "24915" AND DOCUMENTS TYPE "M6". TWO LEADING ZEROS IN SEQUENCE NUMBER ARE NOT SHOWN.
 - ALL EQUIPMENT NUMBERS, INSTRUMENT TAG NUMBERS AND VALVE NUMBERS ARE PREFIXED "07" UNLESS OTHERWISE NOTED.
 - FOR CONVEYOR LAYOUT/LOCATION SEE MATERIALS HANDLING EQUIPMENT GENERAL ARRANGEMENT DRAWING 24915-07-MJ-00-00002.
 - CONVEYOR MJ-RHS-0109 MOTOR SHALL BE INTERLOCKED WITH SERVO ENCODER POSITION ON RCM ROTATING CONVEYOR (P&ID: 24915-07-M6-RHS-00083) TO PREVENT ITS MOTOR RUNNING IN REVERSE DIRECTION WHEN TURNABLE MJ-RHS-0117 IS NOT IN NORTH-SOUTH ALIGNMENT.
 - CONVEYOR MJ-RHS-0132 MOTOR SHALL BE HARDWIRE INTERLOCKED WITH SWITCH ZS-0992A-- TO PREVENT ITS MOTOR RUNNING IN REVERSE (EAST) DIRECTION IF TURNABLE MJ-RHS-0117 IS NOT AT EAST-WEST ORIENTATION.
 - WHEN DOOR AND LATCHES ARE IN AUTO MODE, OPEN COMMAND SHALL UNLATCH AND OPEN THE DOOR AND CLOSE COMMAND SHALL CLOSE AND LATCH THE DOOR.
 - UNLESS OTHERWISE NOTED, FCS INTERLOCK NUMBERS ARE PREFIXED WITH "07-RHS-" AND FPS (OR Z) INTERLOCKS ARE PREFIXED WITH "07-FPS-".
 - GATE CLEAR SWITCHES SHOWN ON BLAST GATE ARE PHYSICALLY LOCATED ON ADJACENT CONVEYORS.
 - EMERGENCY STOP SWITCHES SHALL BE PROVIDED BY THE GATE/DOOR VENDOR MOUNTED SEPARATELY IN A CONTROL BOX AND SHIPPED LOOSE TO BE INSTALLED IN THE FIELD.
 - BLAST GATE AD-RHS-0114 AND BLAST DOORS AD-RHS-0109/0110 AND ALL ASSOCIATED INSTRUMENTS, MOTORS AND COMPONENTS ARE "07".

BASED ON BLUE GRASS PFD 24915-07-M5-RHS-00001 REV.9

REFERENCE DRAWINGS

NO.	DATE	DESCRIPTION	DR	CK	DL	PE	APVD
25	12/21/10	IFC, INCORPORATED DCN-167, DCR-221, SDDR ADOH-10031	PEB	MDV	SA	BBB	BBB
24	08/11/09	IFC, INCORPORATED REVISED DESIGN REQUIREMENTS	JLL	PEB	BM	BBB	BBB
23	02/14/07	IFC, ADDED INTERLOCK TAG NO. ADDED AND NOTES 9,10	RZ	JLL	PEB	JB	BBB
22	11/07/06	IFD, INTERLOCK TAG NO. ADDED, SEE NOTE	RZ	JLL	PEB	JB	BBB
21	05/04/06	ISSUED FOR DESIGN (IFD), ADD DESIGN DEVELOPMENT	RZ	JLL	PEB	JB	BBB
20	03/13/06	ISSUED FOR DESIGN (IFD)	RZ	JLL	PEB	JB	BBB

QUALITY 0 Non-0

BECHTEL PARSONS BLUE GRASS

DDO PROGRAM MANAGER FOR ASSEMBLED CHEMICAL WEAPONS ASSESSMENT EDGEWOOD, MARYLAND

US ARMY ENGINEERING AND SUPPORT CENTER, HUNTSVILLE HUNTSVILLE, ALABAMA

BLUE GRASS CHEMICAL AGENT DESTRUCTION PILOT PLANT PROJECT (BCAPP)
RICHMOND, KENTUCKY
DAAA09-03-D-0023


CONTRACT NO. |
MUNITIONS DEMILITARIZATION BUILDING ECV CONVEYORS DWG 2 - LINE 1 PIPING & INSTRUMENT DIAGRAM

DRAWING NUMBER: 24915-07-M6-RHS-00053 | SHEET: 1 OF 1 | REV: 5

DRAWING CONTAINS PE SEAL, ORIGINAL ON FILE

PROFESSIONAL STAMP

07MRHS053.plt 12/21/10
 DESIGN FILE: DONSPEC
 PLOTTED BY: USER ON DATE: 12/21/10 12:56:34 PM

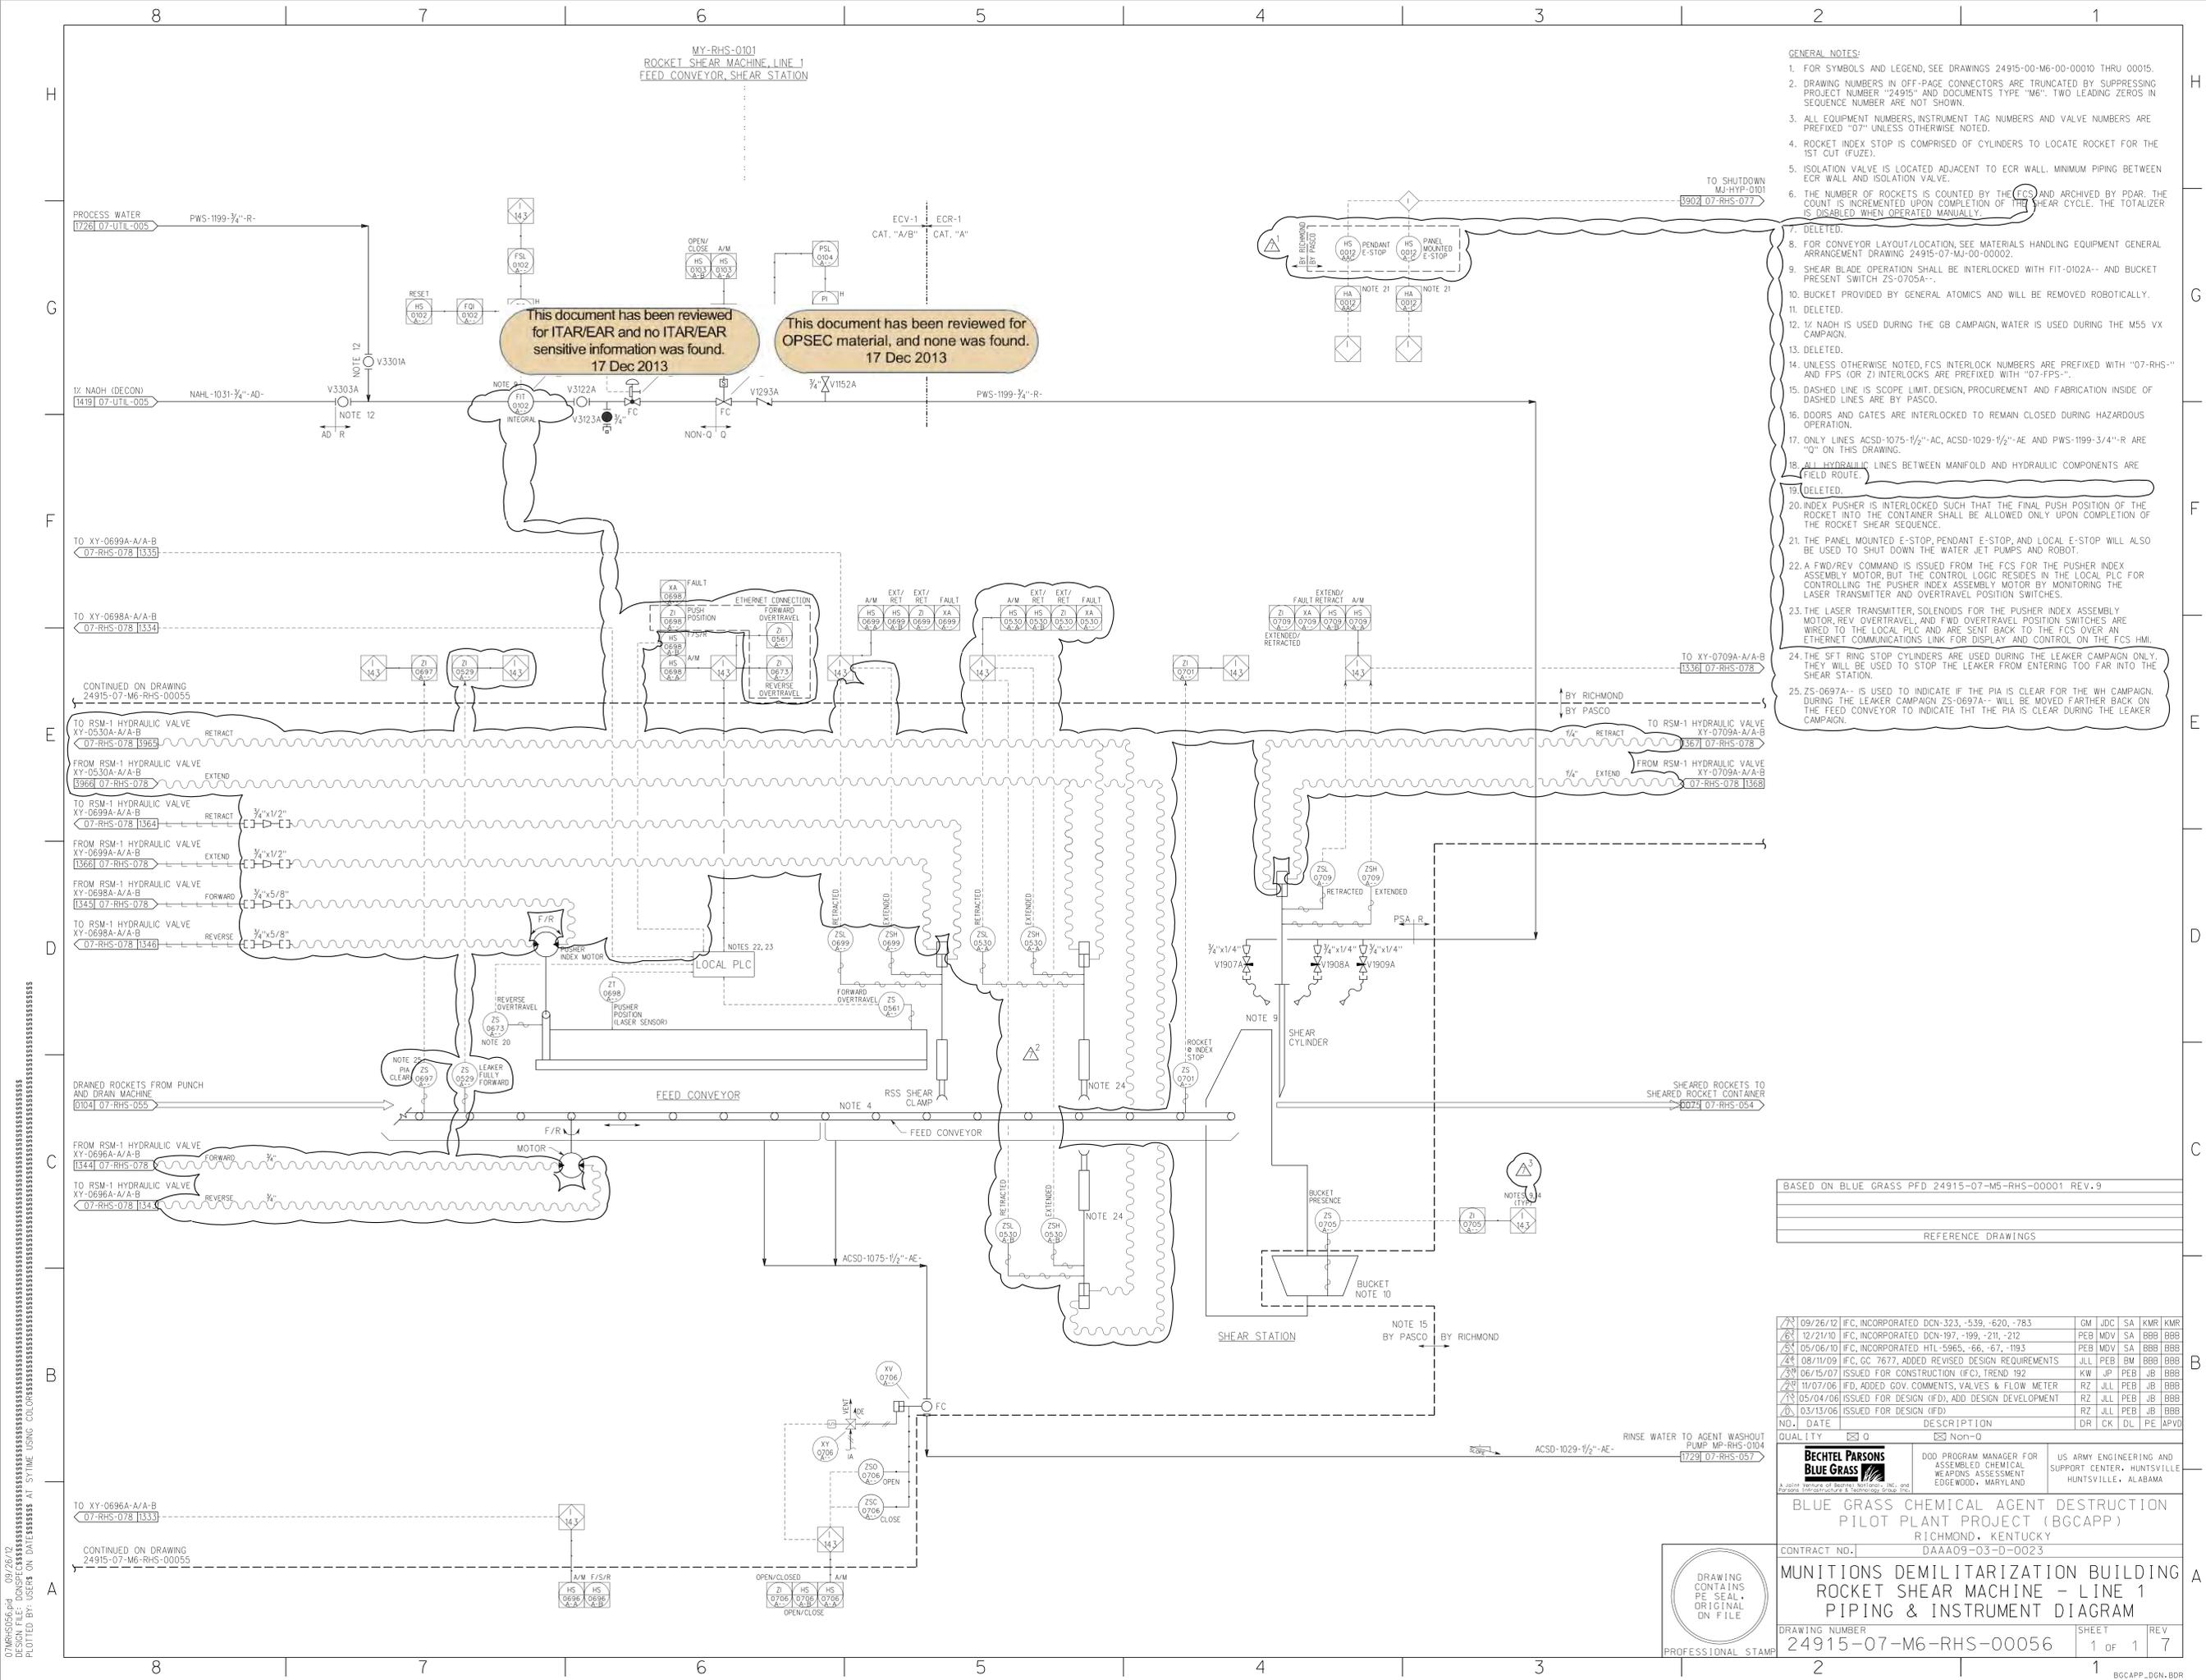

This document has been reviewed for ITAR/EAR and no ITAR/EAR sensitive information was found. 17 Dec 2013

This document has been reviewed for OPSEC material, and none was found. 17 Dec 2013

- GENERAL NOTES:
- FOR SYMBOLS AND LEGEND, SEE DRAWINGS 24915-00-M6-00-00010 THRU 00015.
 - DRAWING NUMBERS IN OFF-PAGE CONNECTORS ARE TRUNCATED BY SUPPRESSING PROJECT NUMBER "24915" AND DOCUMENTS TYPE "M6". TWO LEADING ZEROS IN SEQUENCE NUMBER ARE NOT SHOWN.
 - ALL EQUIPMENT NUMBERS, INSTRUMENT TAG NUMBERS AND VALVE NUMBERS ARE PREFIXED "07" UNLESS OTHERWISE NOTED.
 - ROCKET INDEX STOP IS COMPRISED OF CYLINDERS TO LOCATE ROCKET FOR THE 1ST CUT (FUZE).
 - ISOLATION VALVE IS LOCATED ADJACENT TO ECR WALL. MINIMUM PIPING BETWEEN ECR WALL AND ISOLATION VALVE.
 - THE NUMBER OF ROCKETS IS COUNTED BY THE FCS AND ARCHIVED BY PDR. THE COUNT IS INCREMENTED UPON COMPLETION OF THE SHEAR CYCLE. THE TOTALIZER IS DISABLED WHEN OPERATED MANUALLY.
 - DELETED.
 - FOR CONVEYOR LAYOUT/LOCATION, SEE MATERIALS HANDLING EQUIPMENT GENERAL ARRANGEMENT DRAWING 24915-07-MJ-00-0002.
 - SHEAR BLADE OPERATION SHALL BE INTERLOCKED WITH FIT-0102A-- AND BUCKET PRESENT SWITCH ZS-0705A--.
 - DELETED.
 - DELETED.
 - 1/2" NADH IS USED DURING THE GB CAMPAIGN, WATER IS USED DURING THE M55 VX CAMPAIGN.
 - DELETED.
 - UNLESS OTHERWISE NOTED, FCS INTERLOCK NUMBERS ARE PREFIXED WITH "07-RHS-" AND FPS (OR Z) INTERLOCKS ARE PREFIXED WITH "07-FPS-".
 - DASHED LINE IS SCOPE LIMIT, DESIGN, PROCUREMENT AND FABRICATION INSIDE OF DASHED LINES ARE BY PASCO.
 - DOORS AND GATES ARE INTERLOCKED TO REMAIN CLOSED DURING HAZARDOUS OPERATION.
 - ONLY LINES ACSD-1075-1/2"-AC, ACSD-1029-1/2"-AE AND PWS-1199-3/4"-R ARE "Q" ON THIS DRAWING.
 - ALL HYDRAULIC LINES BETWEEN MANIFOLD AND HYDRAULIC COMPONENTS ARE FIELD ROUTE.
 - DELETED.
 - INDEX PUSHER IS INTERLOCKED SUCH THAT THE FINAL PUSH POSITION OF THE ROCKET INTO THE CONTAINER SHALL BE ALLOWED ONLY UPON COMPLETION OF THE ROCKET SHEAR SEQUENCE.
 - THE PANEL MOUNTED E-STOP, PENDANT E-STOP AND LOCAL E-STOP WILL ALSO BE USED TO SHUT DOWN THE WATER JET PUMPS AND ROBOT.
 - A FWD/REV COMMAND IS ISSUED FROM THE FCS FOR THE PUSHER INDEX ASSEMBLY MOTOR, BUT THE CONTROL LOGIC RESIDES IN THE LOCAL PLC FOR CONTROLLING THE PUSHER INDEX ASSEMBLY MOTOR BY MONITORING THE LASER TRANSMITTER AND OVERTRAVEL POSITION SWITCHES.
 - THE LASER TRANSMITTER, SOLENOIDS FOR THE PUSHER INDEX ASSEMBLY MOTOR, REV OVERTRAVEL, AND FWD OVERTRAVEL POSITION SWITCHES ARE WIRED TO THE LOCAL PLC AND ARE SENT BACK TO THE FCS OVER AN ETHERNET COMMUNICATIONS LINK FOR DISPLAY AND CONTROL ON THE FCS HMI.
 - THE SFT RING STOP CYLINDERS ARE USED DURING THE LEAKER CAMPAIGN ONLY. THEY WILL BE USED TO STOP THE LEAKER FROM ENTERING TOO FAR INTO THE SHEAR STATION.
 - ZS-0697A-- IS USED TO INDICATE IF THE PIA IS CLEAR FOR THE WH CAMPAIGN. DURING THE LEAKER CAMPAIGN ZS-0697A-- WILL BE MOVED FARTHER BACK ON THE FEED CONVEYOR TO INDICATE THAT THE PIA IS CLEAR DURING THE LEAKER CAMPAIGN.

BASED ON BLUE GRASS PFD 24915-07-M5-RHS-00001 REV. 9

REFERENCE DRAWINGS

NO.	DATE	DESCRIPTION	DR	CK	DL	PE	APVD
73	09/26/12	IFC, INCORPORATED DCN-323, -539, -620, -783	GM	JDC	SA	KMR	KMR
63	12/21/10	IFC, INCORPORATED DCN-197, -199, -211, -212	PEB	MDV	SA	BBB	BBB
53	05/06/10	IFC, INCORPORATED HTL-5965, -66, -67, -193	PEB	MDV	SA	BBB	BBB
43	08/11/09	IFC, GC 7677, ADDED REVISED DESIGN REQUIREMENTS	JLL	PEB	BM	BBB	BBB
33	06/15/07	ISSUED FOR CONSTRUCTION (IFC), TREND 192	KW	JP	PEB	JB	BBB
23	11/07/06	IFD, ADDED GOV. COMMENTS, VALVES & FLOW METER	RZ	JLL	PEB	JB	BBB
13	05/04/06	ISSUED FOR DESIGN (IFD), ADD DESIGN DEVELOPMENT	RZ	JLL	PEB	JB	BBB
03	03/13/06	ISSUED FOR DESIGN (IFD)	RZ	JLL	PEB	JB	BBB

BECHTEL PARSONS
 BLUE GRASS
 A joint venture of Bechtel Corporation, Inc. and Parsons Infrastructure & Technology Group, Inc.

000 PROGRAM MANAGER FOR ASSEMBLED CHEMICAL WEAPONS ASSESSMENT EDgewood, MARYLAND

US ARMY ENGINEERING AND SUPPORT CENTER, HUNTSVILLE HUNTSVILLE, ALABAMA

BLUE GRASS CHEMICAL AGENT DESTRUCTION PILOT PLANT PROJECT (BGCAPP)
 RICHMOND, KENTUCKY
 DAAA09-03-D-0023

MUNITIONS DEMILITARIZATION BUILDING
 ROCKET SHEAR MACHINE - LINE 1
 PIPING & INSTRUMENT DIAGRAM

DRAWING NUMBER: 24915-07-M6-RHS-00056
 SHEET: 1 OF 1
 REV: 7



07MHS056.plt 09/26/12
 DESIGN FILE: DONSPEC
 PLOTTED BY: USER ON DATE: 9/26/12 4:39:18 PM

MJ-RHS-0102
ROCKET INPUT ASSEMBLY LINE-2

MJ-RHS-0138
ROCKET INPUT CONVEYOR LINE-2
MOTOR HP : .75 HP

AD-RHS-0119
ROCKET AIRLOCK/CONVEYOR IN-GATE LN-2


MJ-RHS-0104
ROCKET AIRLOCK/CONVEYOR LINE-2
MOTOR HP : 0.75 HP

- GENERAL NOTES:
- FOR SYMBOLS AND LEGEND, SEE DRAWINGS 24915-00-M6-00-00010 THRU 00015.
 - DRAWING NUMBERS IN OFF-PAGE CONNECTORS ARE TRUNCATED BY SUPPRESSING PROJECT NUMBER "24915" AND DOCUMENTS TYPE "M6". TWO LEADING ZEROS IN SEQUENCE NUMBER ARE NOT SHOWN.
 - ALL EQUIPMENT NUMBERS, INSTRUMENT TAG NUMBERS AND VALVE NUMBERS ARE PREFIXED "07" UNLESS OTHERWISE NOTED.
 - DELAY START WARNING DEVICES ARE PROVIDED ON ALL REMOTELY CONTROLLED CONVEYOR LINES AS SHOWN ON THE CONTROL SYSTEM INPUT/OUTPUT REPORT.
 - FOR CONVEYOR LAYOUT/LOCATION, SEE MATERIALS HANDLING EQUIPMENT GENERAL ARRANGEMENT DRAWING 24915-07-MJ-00-00002.
 - TRAIN STOP EMERGENCY PUSH BUTTONS DETAILS TO BE PROVIDED LATER.
 - INSTRUMENTATION AND VALVING SHOWN ON HVAC DRAWING NUMBER 24915-07-M6-HVAC-00121.
 - INLET GATE AD-RHS-0119 SHALL BE INTERLOCKED WITH OUTLET GATE AD-RHS-0108. A TIMER PREVENTS INLET GATE FROM OPENING AFTER OUTLET GATE AD-RHS-0108 CLOSES UNTIL THE AIRLOCK HAS CAME THROUGH PROPER AIR CHANGES.
 - DELETED.
 - UNLESS OTHERWISE NOTED, FCS INTERLOCK NUMBERS ARE PREFIXED WITH "07-RHS-" AND FPS (OR Z) INTERLOCKS ARE PREFIXED WITH "07-FPS-".
 - GATE CLEAR SWITCHES SHOWN ON AIRLOCK GATE ARE PHYSICALLY LOCATED ON ADJACENT CONVEYORS.
 - 4-WAY DIRECTIONAL PNEUMATIC CONTROL VALVE, 3 POSITIONS, SOLENOID OPERATED, SPRING CENTERED, CENTER BLOCKED.

This document has been reviewed for ITAR/EAR and no ITAR/EAR sensitive information was found. 17 Dec 2013

This document has been reviewed for OPSEC material, and none was found. 17 Dec 2013

TO HD8541 & HD8542
25301 07-HVAC-121

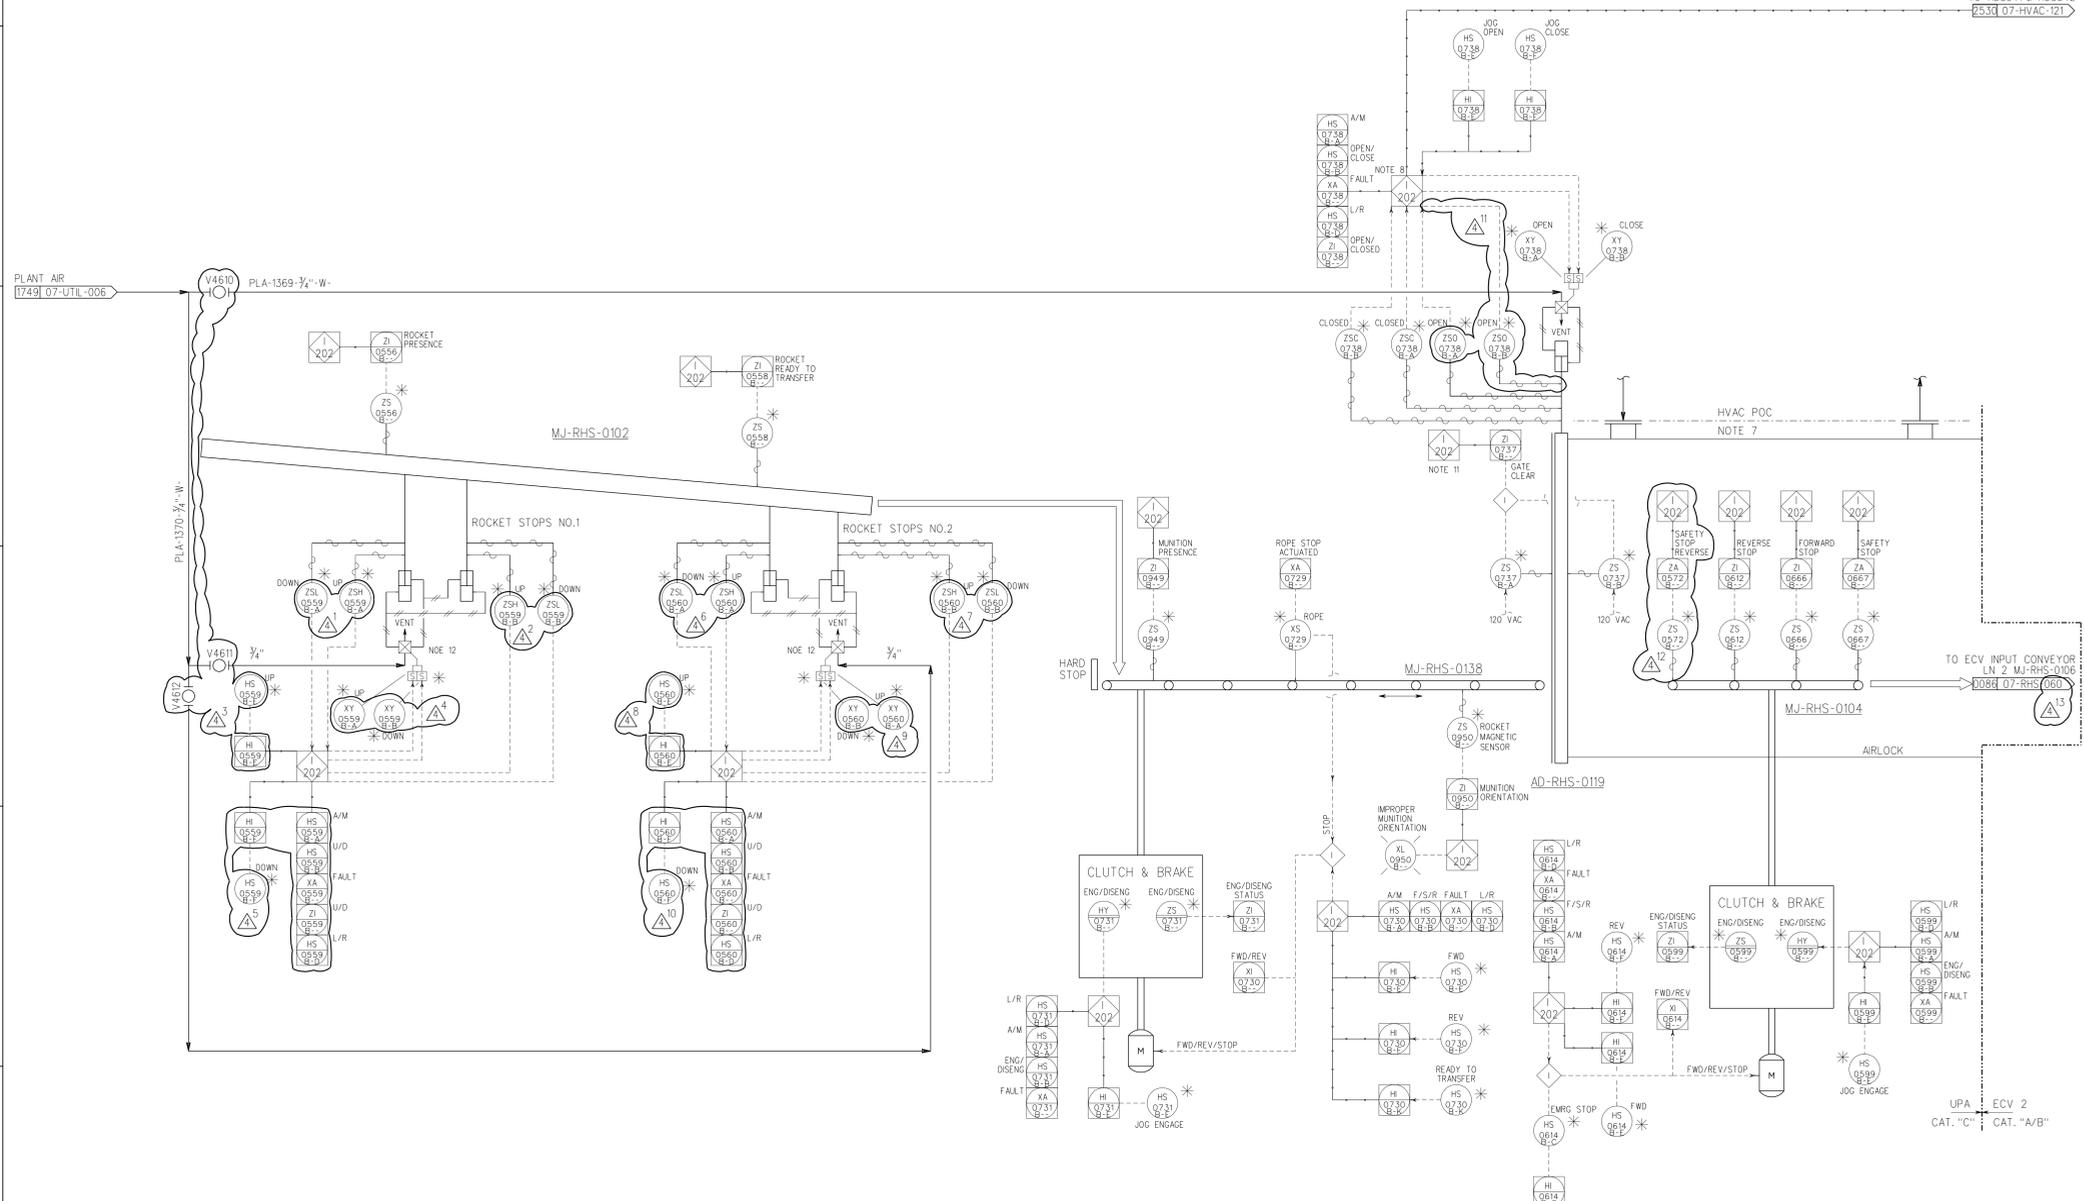

BASED ON BLUE GRASS P&ID 24915-07-M6-RHS-00007 REV. 0

REFERENCE DRAWINGS

NO.	DATE	DESCRIPTION	DR	CK	DL	PE	APVD
49	08/11/09	IFC, GC 7723, HTL-879/881, ADD REVISED DESIGN REQ.	JLL	PEB	BM	BBB	BBB
33	02/14/07	IFC, CLAR INSTR SUPP W/EQUIP, REVISED ROCKET STOP	RZ	JLL	PEB	JB	BBB
28	11/07/06	IFD, ADDED GOV. COMMENTS AND ROCKET STOPS	RZ	JLL	PEB	JB	BBB
19	05/05/06	ISSUED FOR DESIGN (IFD), ADD DESIGN DEVELOPMENT	RZ	JLL	PEB	JB	BBB
16	03/13/06	ISSUED FOR DESIGN (IFD)	RZ	JLL	PEB	JB	BBB

QUALITY 0 Non-0

BECHTEL PARSONS BLUE GRASS
A joint venture of Bechtel Technology, LLC and Parsons Infrastructure & Technology Group, Inc.

DDO PROGRAM MANAGER FOR ASSEMBLED CHEMICAL WEAPONS ASSESSMENT EDgewood, MARYLAND

US ARMY ENGINEERING AND SUPPORT CENTER, HUNTSVILLE, ALABAMA

BLUE GRASS CHEMICAL AGENT DESTRUCTION PILOT PLANT PROJECT (BCAPP)
RICHMOND, KENTUCKY
DAAA09-03-D-0023


MUNITIONS DEMILITARIZATION BUILDING ROCKET PROCESSING SYSTEM DWG1-LN2 PIPING & INSTRUMENT DIAGRAM

DRAWING NUMBER 24915-07-M6-RHS-00059 SHEET 1 OF 1 REV 4

DRAWING CONTAINS PE SEAL ORIGINAL ON FILE

PROFESSIONAL STAMP

07MRHS009.pid 08/11/09
 DESIGN FILE: DONSPEC AT SYTIME USING COLOR...
 PLOTTED BY USER ON DATE...

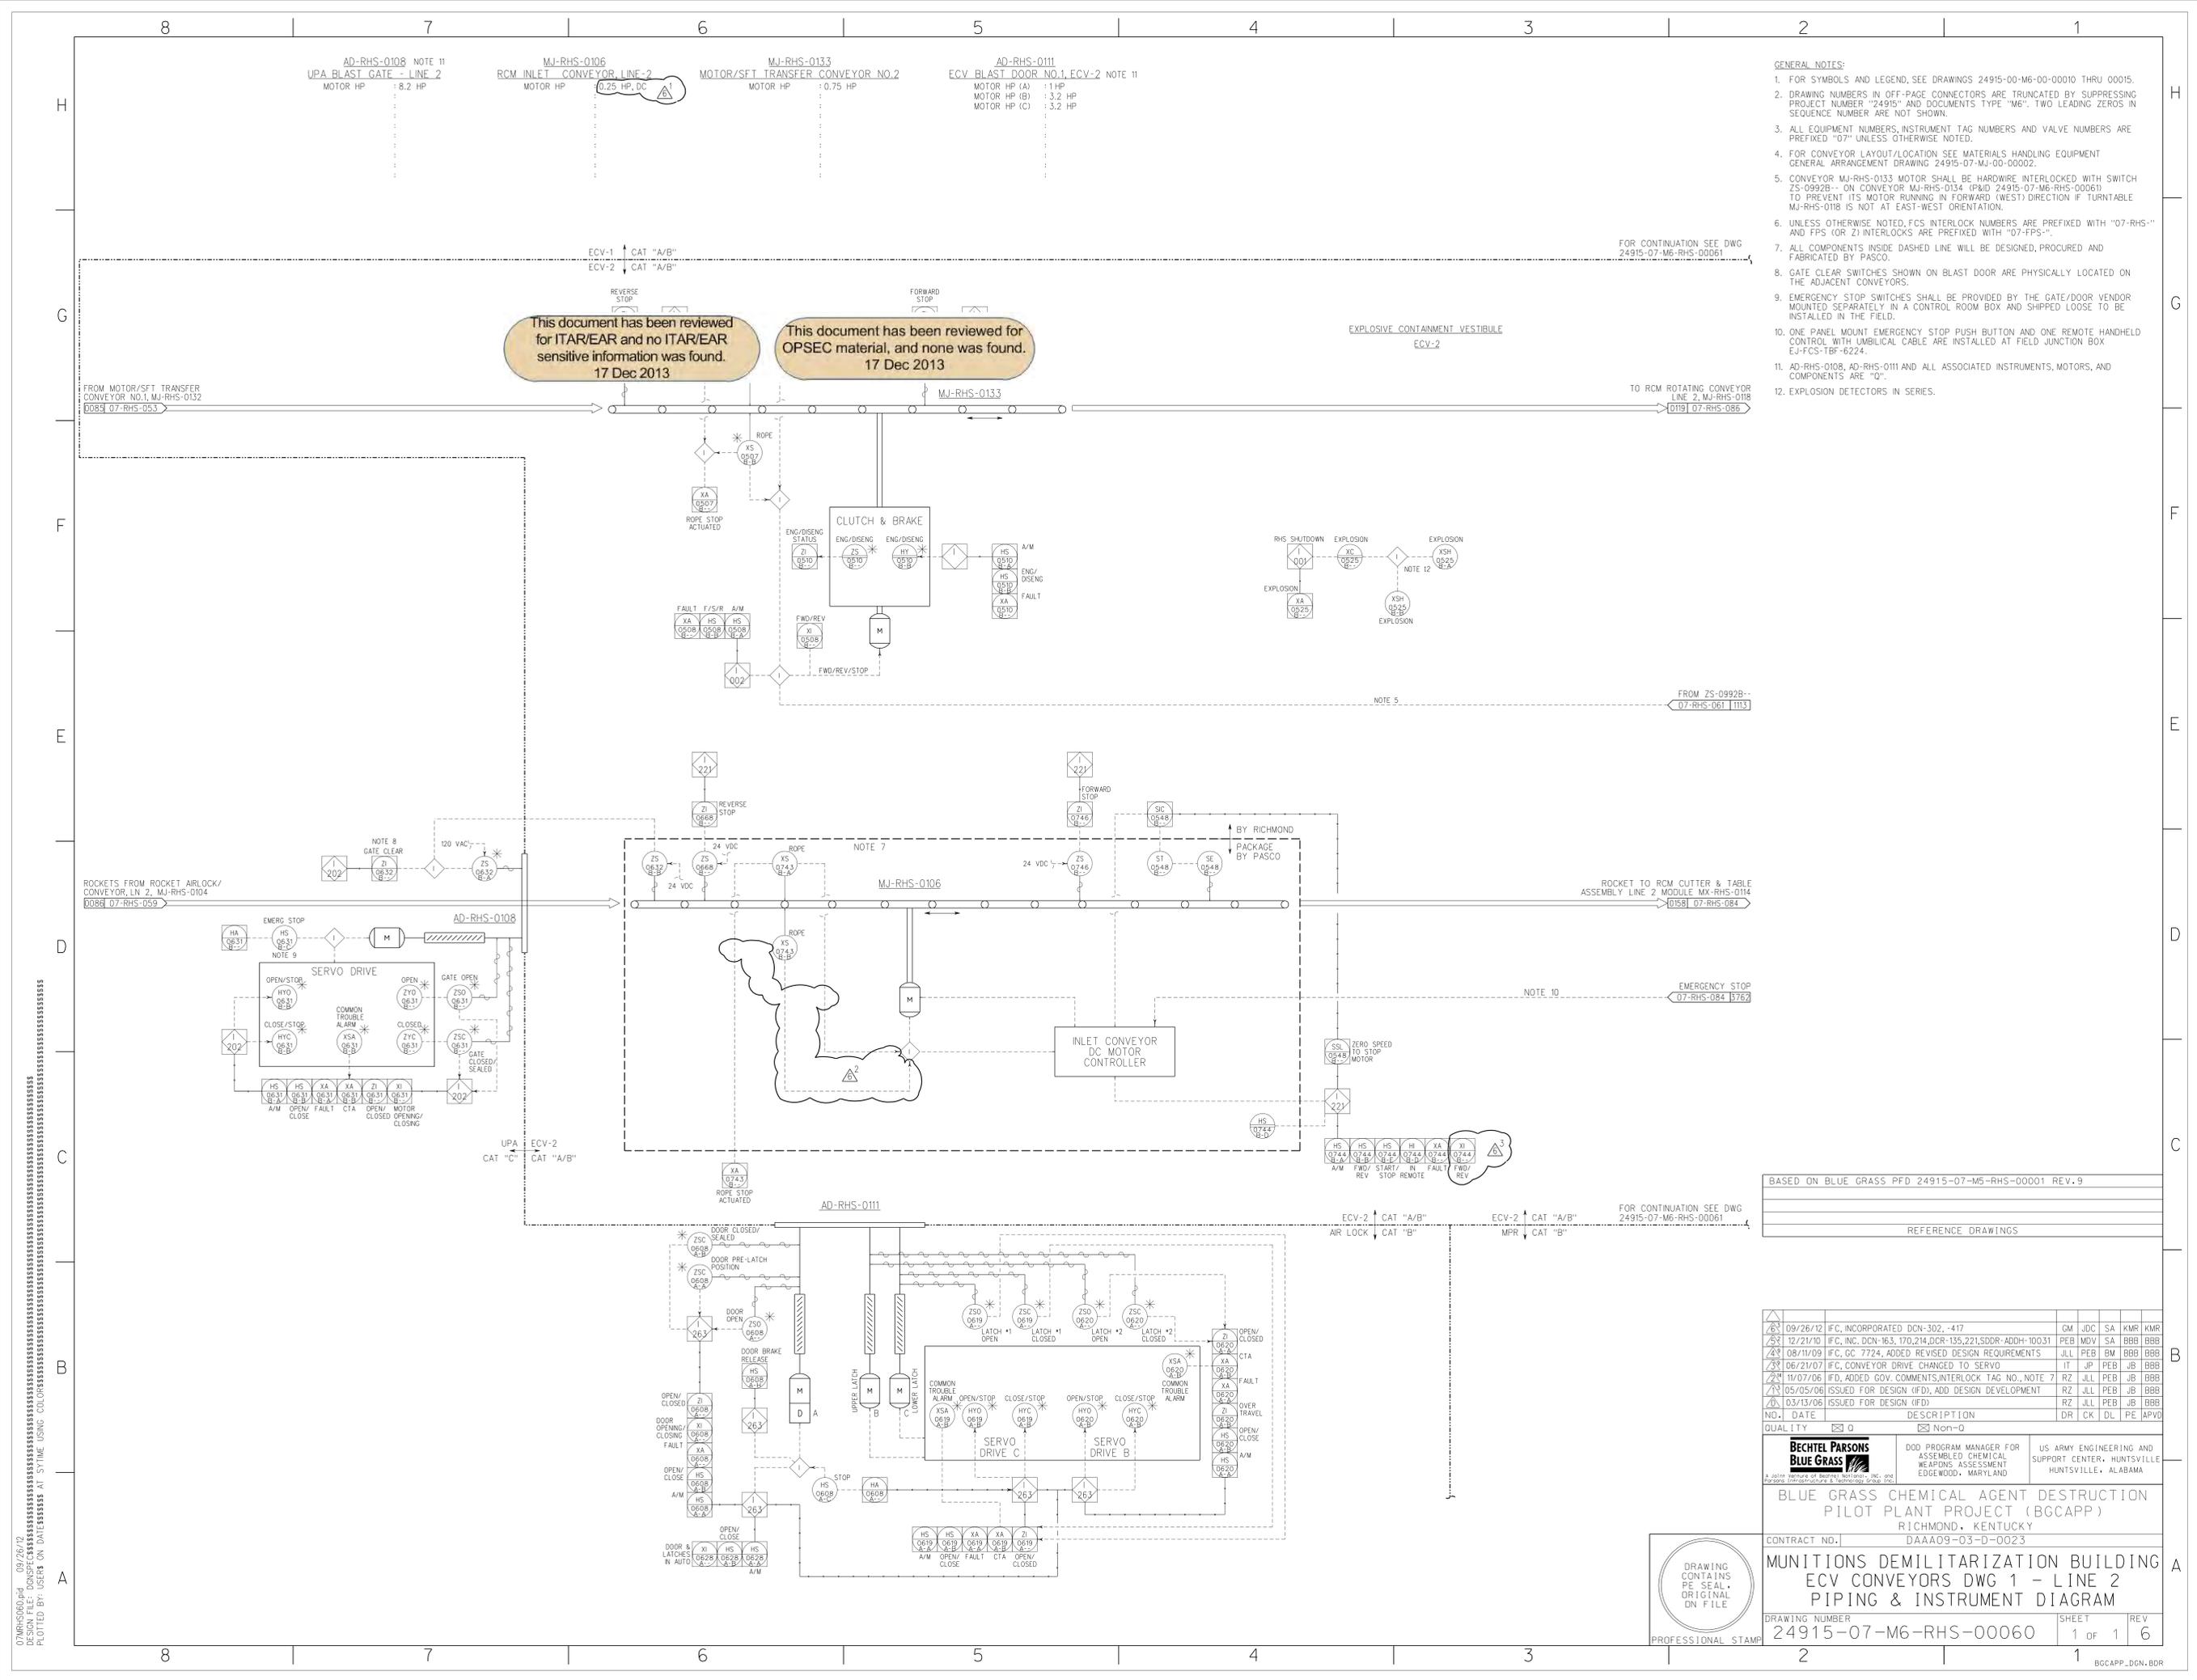

- GENERAL NOTES:
- FOR SYMBOLS AND LEGEND, SEE DRAWINGS 24915-00-M6-00-00010 THRU 00015.
 - DRAWING NUMBERS IN OFF-PAGE CONNECTORS ARE TRUNCATED BY SUPPRESSING PROJECT NUMBER "24915" AND DOCUMENTS TYPE "M6". TWO LEADING ZEROS IN SEQUENCE NUMBER ARE NOT SHOWN.
 - ALL EQUIPMENT NUMBERS, INSTRUMENT TAG NUMBERS AND VALVE NUMBERS ARE PREFIXED "07" UNLESS OTHERWISE NOTED.
 - FOR CONVEYOR LAYOUT/LOCATION SEE MATERIALS HANDLING EQUIPMENT GENERAL ARRANGEMENT DRAWING 24915-07-MJ-00-00002.
 - CONVEYOR MJ-RHS-0133 MOTOR SHALL BE HARDWARE INTERLOCKED WITH SWITCH ZS-0928-- ON CONVEYOR MJ-RHS-D134 (P&ID 24915-07-M6-RHS-00061) TO PREVENT ITS MOTOR RUNNING IN FORWARD (WEST) DIRECTION IF TURNTABLE MJ-RHS-0118 IS NOT AT EAST-WEST ORIENTATION.
 - UNLESS OTHERWISE NOTED, FCS INTERLOCK NUMBERS ARE PREFIXED WITH "07-RHS-" AND FPS (OR Z) INTERLOCKS ARE PREFIXED WITH "07-FPS-".
 - ALL COMPONENTS INSIDE DASHED LINE WILL BE DESIGNED, PROCURED AND FABRICATED BY PASCO.
 - GATE CLEAR SWITCHES SHOWN ON BLAST DOOR ARE PHYSICALLY LOCATED ON THE ADJACENT CONVEYORS.
 - EMERGENCY STOP SWITCHES SHALL BE PROVIDED BY THE GATE/DOOR VENDOR MOUNTED SEPARATELY IN A CONTROL ROOM BOX AND SHIPPED LOOSE TO BE INSTALLED IN THE FIELD.
 - ONE PANEL MOUNT EMERGENCY STOP PUSH BUTTON AND ONE REMOTE HANDHELD CONTROL WITH UMBILICAL CABLE ARE INSTALLED AT FIELD JUNCTION BOX EJ-FCS-TBF-6224.
 - AD-RHS-0108, AD-RHS-0111 AND ALL ASSOCIATED INSTRUMENTS, MOTORS, AND COMPONENTS ARE "07".
 - EXPLOSION DETECTORS IN SERIES.

This document has been reviewed for ITAR/EAR and no ITAR/EAR sensitive information was found. 17 Dec 2013

This document has been reviewed for OPSEC material, and none was found. 17 Dec 2013

BASED ON BLUE GRASS PFD 24915-07-M6-RHS-00001 REV. 9

REFERENCE DRAWINGS

NO.	DATE	DESCRIPTION	DR	CK	DL	PE	APVD
1	09/26/12	I/C, INCORPORATED DCN-302, -417	GM	JDC	SA	KMR	KMR
2	12/21/10	I/C, INC. DCN-163, 170, 214, DCR-135, 221, SDDR-ADDH-100.31	PEB	MDV	SA	BBB	BBB
3	08/11/09	I/C, GC 7724, ADDED REVISED DESIGN REQUIREMENTS	JLL	PEB	BM	BBB	BBB
4	06/21/07	I/C, CONVEYOR DRIVE CHANGED TO SERVO	IT	JP	PEB	JB	BBB
5	11/07/06	I/FD, ADDED GOV. COMMENTS, INTERLOCK TAG NO., NOTE 7	RZ	JLL	PEB	JB	BBB
6	05/05/06	I/FD, ADDED DESIGN DEVELOPMENT	RZ	JLL	PEB	JB	BBB
7	03/13/06	ISSUED FOR DESIGN (IFD)	RZ	JLL	PEB	JB	BBB

QUALITY Non-0

BECHTEL PARSONS BLUE GRASS	DOD PROGRAM MANAGER FOR ASSEMBLED CHEMICAL WEAPONS ASSESSMENT EDgewood, MARYLAND	US ARMY ENGINEERING AND SUPPORT CENTER, HUNTSVILLE HUNTSVILLE, ALABAMA
-----------------------------------	--	--

BLUE GRASS CHEMICAL AGENT DESTRUCTION PILOT PLANT PROJECT (BCAPP) RICHMOND, KENTUCKY

CONTRACT NO. DAAA09-03-D-0023

MUNITIONS DEMILITARIZATION BUILDING ECV CONVEYORS DWG 1 - LINE 2 PIPING & INSTRUMENT DIAGRAM

DRAWING NUMBER 24915-07-M6-RHS-00060 SHEET 1 OF 1 REV 6

DRAWING CONTAINS PE SEAL ORIGINAL ON FILE

PROFESSIONAL STAMP

07MRHS0108.dwg 09/26/12
 DESIGN FILE: DONSPENCER AT SYTIME USING COLORPLOT
 PLOTTED BY: USER ON DATE: 09/26/12



MJ-RHS-0134 MOTOR/SFT TRANSFER CONVEYOR NO.3 MOTOR HP : 0.75 HP
 MJ-RHS-0110 ECV OUTPUT CONVEYOR LINE-2 MOTOR HP : 0.75 HP
 MJ-RHS-0140 MOTOR/SFT TRANSFER CONVEYOR NO.4 MOTOR HP : 0.75 HP
 AD-RHS-0115 NOTE 11 MOTOR/SFT ACCESS BLAST GATE ECV-2 MOTOR HP (A) : 1HP MOTOR HP (B) : 3.2 HP MOTOR HP (C) : 3.2 HP
 AD-RHS-0112 NOTE 11 ECV BLAST DOOR NO.2 ECV-2 MOTOR HP (A) : 1HP MOTOR HP (B) : 3.2 HP MOTOR HP (C) : 3.2 HP

- GENERAL NOTES:
- FOR SYMBOLS AND LEGEND, SEE DRAWINGS 24915-00-M6-00-00010 THRU 00015.
 - DRAWING NUMBERS IN OFF-PAGE CONNECTORS ARE TRUNCATED BY SUPPRESSING PROJECT NUMBER "24915" AND DOCUMENTS TYPE "M6". TWO LEADING ZEROS IN SEQUENCE NUMBER ARE NOT SHOWN.
 - ALL EQUIPMENT NUMBERS, INSTRUMENT TAG NUMBERS AND VALVE NUMBERS ARE PREFIXED "07" UNLESS OTHERWISE NOTED.
 - FOR CONVEYOR LAYOUT/LOCATION, SEE MATERIALS HANDLING EQUIPMENT GENERAL ARRANGEMENT DRAWING 24915-07-MJ-00-00002.
 - WHEN DOOR AND LATCHES ARE IN AUTO MODE, OPEN COMMAND SHALL UNLATCH AND OPEN THE DOOR AND CLOSE COMMAND SHALL CLOSE AND LATCH THE DOOR.
 - CONVEYOR MJ-RHS-0134 MOTOR SHALL BE HARDWARE INTERLOCKED WITH SWITCH ZS-0928-- TO PREVENT ITS MOTOR RUNNING IN REVERSE DIRECTION (EAST) IF TURNTABLE MJ-RHS-0118 IS NOT AT EAST-WEST ORIENTATION.
 - CONVEYOR MJ-RHS-0110 MOTOR SHALL BE INTERLOCKED WITH SERVO ENCODER POSITION ON RCM ROTATING CONVEYOR (P#ID: 24915-07-M6-RHS-00086) TO PREVENT ITS MOTOR RUNNING IN REVERSE DIRECTION WHEN TURNTABLE MJ-RHS-0118 IS NOT IN NORTH-SOUTH ALIGNMENT.
 - UNLESS OTHERWISE NOTED, FCS INTERLOCK NUMBERS ARE PREFIXED WITH "07-RHS-".
 - GATE CLEAR SWITCHES SHOWN ON BLAST GATE ARE PHYSICALLY LOCATED ON ADJACENT CONVEYORS.
 - EMERGENCY STOP SWITCHES SHALL BE PROVIDED BY THE GATE/DOOR VENDOR MOUNTED SEPARATELY IN A CONTROL BOX AND SHIPPED LOOSE TO BE INSTALLED IN THE FIELD.
 - BLAST GATE AD-RHS-0115 AND BLAST DOOR AD-RHS-0112 AND ALL ASSOCIATED INSTRUMENTS, MOTORS AND COMPONENTS ARE "Q".
 - FIRE CONTROL PANEL WILL SEND SIGNAL TO RHS S/D AND MPR S/D.
 - DELETED.
 - HOLLOW DETECTION SENSOR SHALL BE A LASER TYPE AND SHALL BE AS SPECIFIED ON 07-MJ-RHS-00036.
 - LENGTH SENSOR PROVIDED BY VENDOR SHALL FAIL TO FALSE POSITION (i.e. LENGTH NOT DETECTED).
 - SENSOR TRUTH TABLE FOR MUNITIONS IS SHOWN IN MATRIX BELOW.

SENSOR MUNITIONS	PRESENCE (FWD STP)	LENGTH	METAL	HOLLOW
MOTOR	X	X	X	-
SFT	X	-	-	X
UNEXPECTED OBJECT	X	-	X	-

This document has been reviewed for ITAR/EAR and no ITAR/EAR sensitive information was found. 17 Dec 2013

This document has been reviewed for OPSEC material, and none was found. 17 Dec 2013

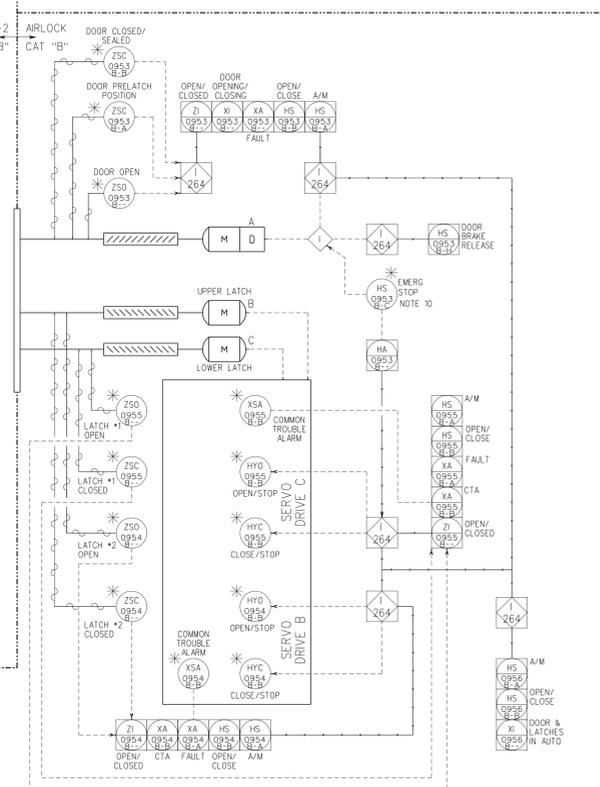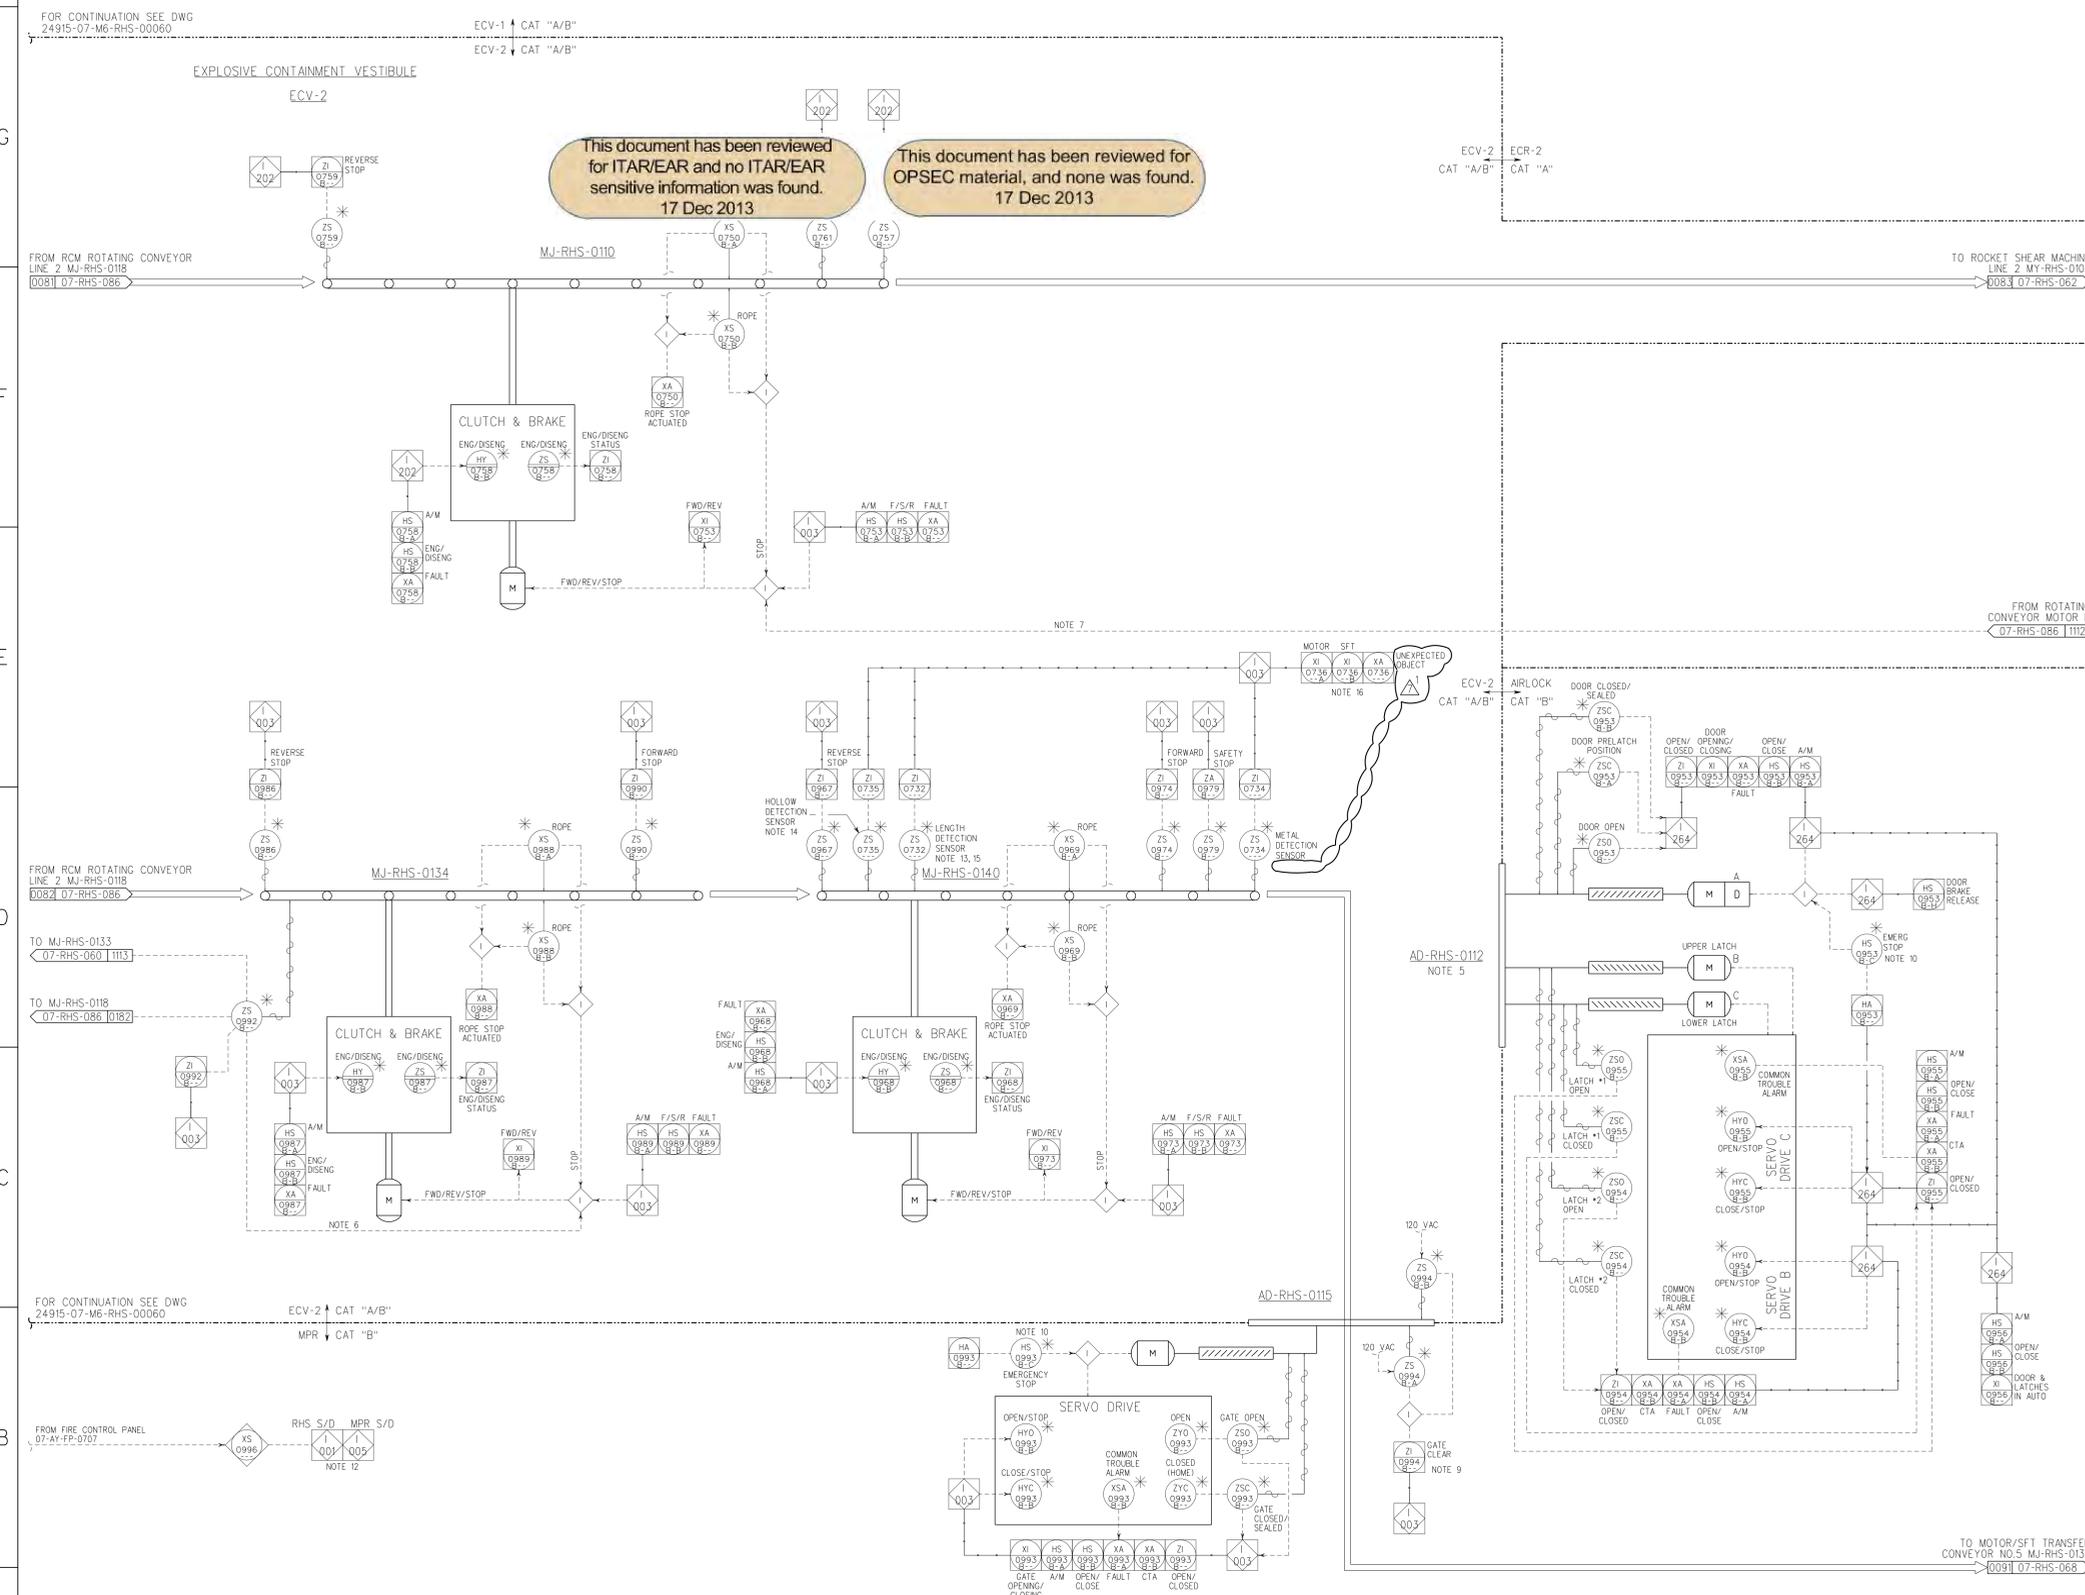

BASED ON BLUE GRASS PFD 24915-07-M6-RHS-00001 REV.9

REFERENCE DRAWINGS

NO.	DATE	DESCRIPTION	DR	CK	DL	PE	APVD
73	09/26/12	IFC, INCORPORATED DCN-287	GM	JDC	SA	KMR	KMR
63	12/21/10	IFC, INCORPORATED DCN-167 & DCR-221	PEB	MDV	SA	BBB	BBB
53	05/06/10	IFC, DCR-51, HTL-1035, -1220 & -1063, SDDR-31	PEB	GM	SA	BBB	BBB
43	08/11/09	IFC, HTL-1661, ADDED REVISED DESIGN REQUIREMENTS	JLL	PEB	BM	BBB	BBB
33	02/14/07	IFC, ADDED INTERLOCK TAG NO AND NOTES 9,10	RZ	JLL	PEB	JB	BBB
23	11/07/06	IFD, INTERLOCK TAG NO. ADDED, ROPE SWITCH CHANGED	RZ	JLL	PEB	JB	BBB
13	05/05/06	ISSUED FOR DESIGN (IFD), ADD DESIGN DEVELOPMENT	RZ	JLL	PEB	JB	BBB
03	03/13/06	ISSUED FOR DESIGN (IFD)	RZ	JLL	PEB	JB	BBB

QUALITY 0 Non-0

BECHTEL PARSONS
Blue Grass
 A joint venture of Bechtel Technology, Inc. and Parsons Infrastructure & Technology Group, Inc.

000 PROGRAM MANAGER FOR ASSEMBLED CHEMICAL WEAPONS ASSESSMENT EDgewood, MARYLAND

US ARMY ENGINEERING AND SUPPORT CENTER, HUNTSVILLE HUNTSVILLE, ALABAMA

BLUE GRASS CHEMICAL AGENT DESTRUCTION PILOT PLANT PROJECT (BCAPP) RICHMOND, KENTUCKY

CONTRACT NO. DAAA09-03-D-0023

MUNITIONS DEMILITARIZATION BUILDING ECV CONVEYORS DWG 2 - LINE 2 PIPING & INSTRUMENT DIAGRAM

DRAWING NUMBER 24915-07-M6-RHS-00061 SHEET 1 OF 1 REV 7




07MRHS001.dwg 09/26/12
 DESIGN FILE: DONSPEC AT SYTIME USING COLORPLOT
 PLOTTED BY: USER4 ON DATE: 09/26/12

MY-RHS-0102
ROCKET SHEAR MACHINE, LINE 2
FEED CONVEYOR, SHEAR STATION

- GENERAL NOTES:
- FOR SYMBOLS AND LEGEND, SEE DRAWINGS 24915-00-M6-00-00010 THRU 00015.
 - DRAWING NUMBERS IN OFF-PAGE CONNECTORS ARE TRUNCATED BY SUPPRESSING PROJECT NUMBER "24915" AND DOCUMENTS TYPE "M6". TWO LEADING ZEROS IN SEQUENCE NUMBER ARE NOT SHOWN.
 - ALL EQUIPMENT NUMBERS, INSTRUMENT TAG NUMBERS AND VALVE NUMBERS ARE PREFIXED "07" UNLESS OTHERWISE NOTED.
 - ROCKET INDEX STOP IS COMPRISED OF CYLINDERS TO LOCATE ROCKET FOR THE 1ST CUT (FUZE).
 - ISOLATION VALVE IS LOCATED ADJACENT TO ECR WALL. MINIMUM PIPING BETWEEN ECR WALL AND ISOLATION VALVE.
 - THE NUMBER OF ROCKETS IS COUNTED BY THE ECS AND ARCHIVED BY PDMR. THE COUNT IS INCREMENTED UPON COMPLETION OF THE SHEAR CYCLE. THE TOTALIZER IS DISABLED WHEN OPERATED MANUALLY.
 - DELETED.
 - FOR CONVEYOR LAYOUT/LOCATION, SEE MATERIALS HANDLING EQUIPMENT GENERAL ARRANGEMENT DRAWING 24915-07-MJ-00-00002.
 - SHEAR BLADE OPERATION SHALL BE INTERLOCKED WITH FIT-0102B-- AND BUCKET PRESENT SWITCH ZS-0705B--.
 - BUCKET PROVIDED BY GENERAL ATOMICS AND WILL BE REMOVED ROBOTICALLY.
 - DELETED.
 - 1/2 NAAH IS USED DURING THE GB CAMPAIGN, WATER IS USED DURING THE M55 VX CAMPAIGN.
 - DELETED.
 - UNLESS OTHERWISE NOTED, FCS INTERLOCK NUMBERS ARE PREFIXED WITH "07-RHS--" AND FPS (OR Z) INTERLOCKS ARE PREFIXED WITH "07-FPS--".
 - DASHED LINE IS SCOPE LIMIT. DESIGN, PROCUREMENT AND FABRICATION INSIDE OF DASHED LINES ARE BY PASCO.
 - DOORS AND GATES ARE INTERLOCKED TO REMAIN CLOSED DURING HAZARDOUS OPERATION.
 - DELETED.
 - ALL HYDRAULIC LINES BETWEEN MANIFOLD AND HYDRAULIC COMPONENTS ARE FIELD ROUTE.
 - DELETED.
 - INDEX PUSHER IS INTERLOCKED SUCH THAT THE FINAL PUSH POSITION OF THE ROCKET INTO THE CONTAINER SHALL BE ALLOWED ONLY UPON COMPLETION OF THE ROCKET SHEAR SEQUENCE.
 - THE PANEL MOUNTED E-STOP, PENDANT E-STOP, AND LOCAL E-STOP WILL ALSO BE USED TO SHUT DOWN THE WATER JET PUMPS AND ROBOT.
 - THE LASER TRANSMITTER, SOLENOIDS FOR THE PUSHER INDEX ASSEMBLY MOTOR, REV OVERTRAVEL, AND FWD OVERTRAVEL POSITION SWITCHES ARE WIRED TO THE LOCAL PLC AND ARE SENT BACK TO THE FCS OVER AN ETHERNET COMMUNICATIONS LINK FOR DISPLAY AND CONTROL ON THE FCS HMI.
 - THE SFT RING STOP CYLINDERS ARE USED DURING THE LEAKER CAMPAIGN ONLY. THEY WILL BE USED TO STOP THE LEAKER FROM ENTERING TOO FAR INTO THE SHEAR STATION.
 - ZS-0697B-- IS USED TO INDICATE IF THE PIA IS CLEAR FOR THE WH CAMPAIGN. DURING THE LEAKER CAMPAIGN ZS-0697B-- WILL BE MOVED FARTHER BACK ON THE FEED CONVEYOR TO INDICATE THAT THE PIA IS CLEAR DURING THE LEAKER CAMPAIGN.

This document has been reviewed for ITAR/EAR and no ITAR/EAR sensitive information was found. 17 Dec 2013

This document has been reviewed for OPSEC material, and none was found. 17 Dec 2013

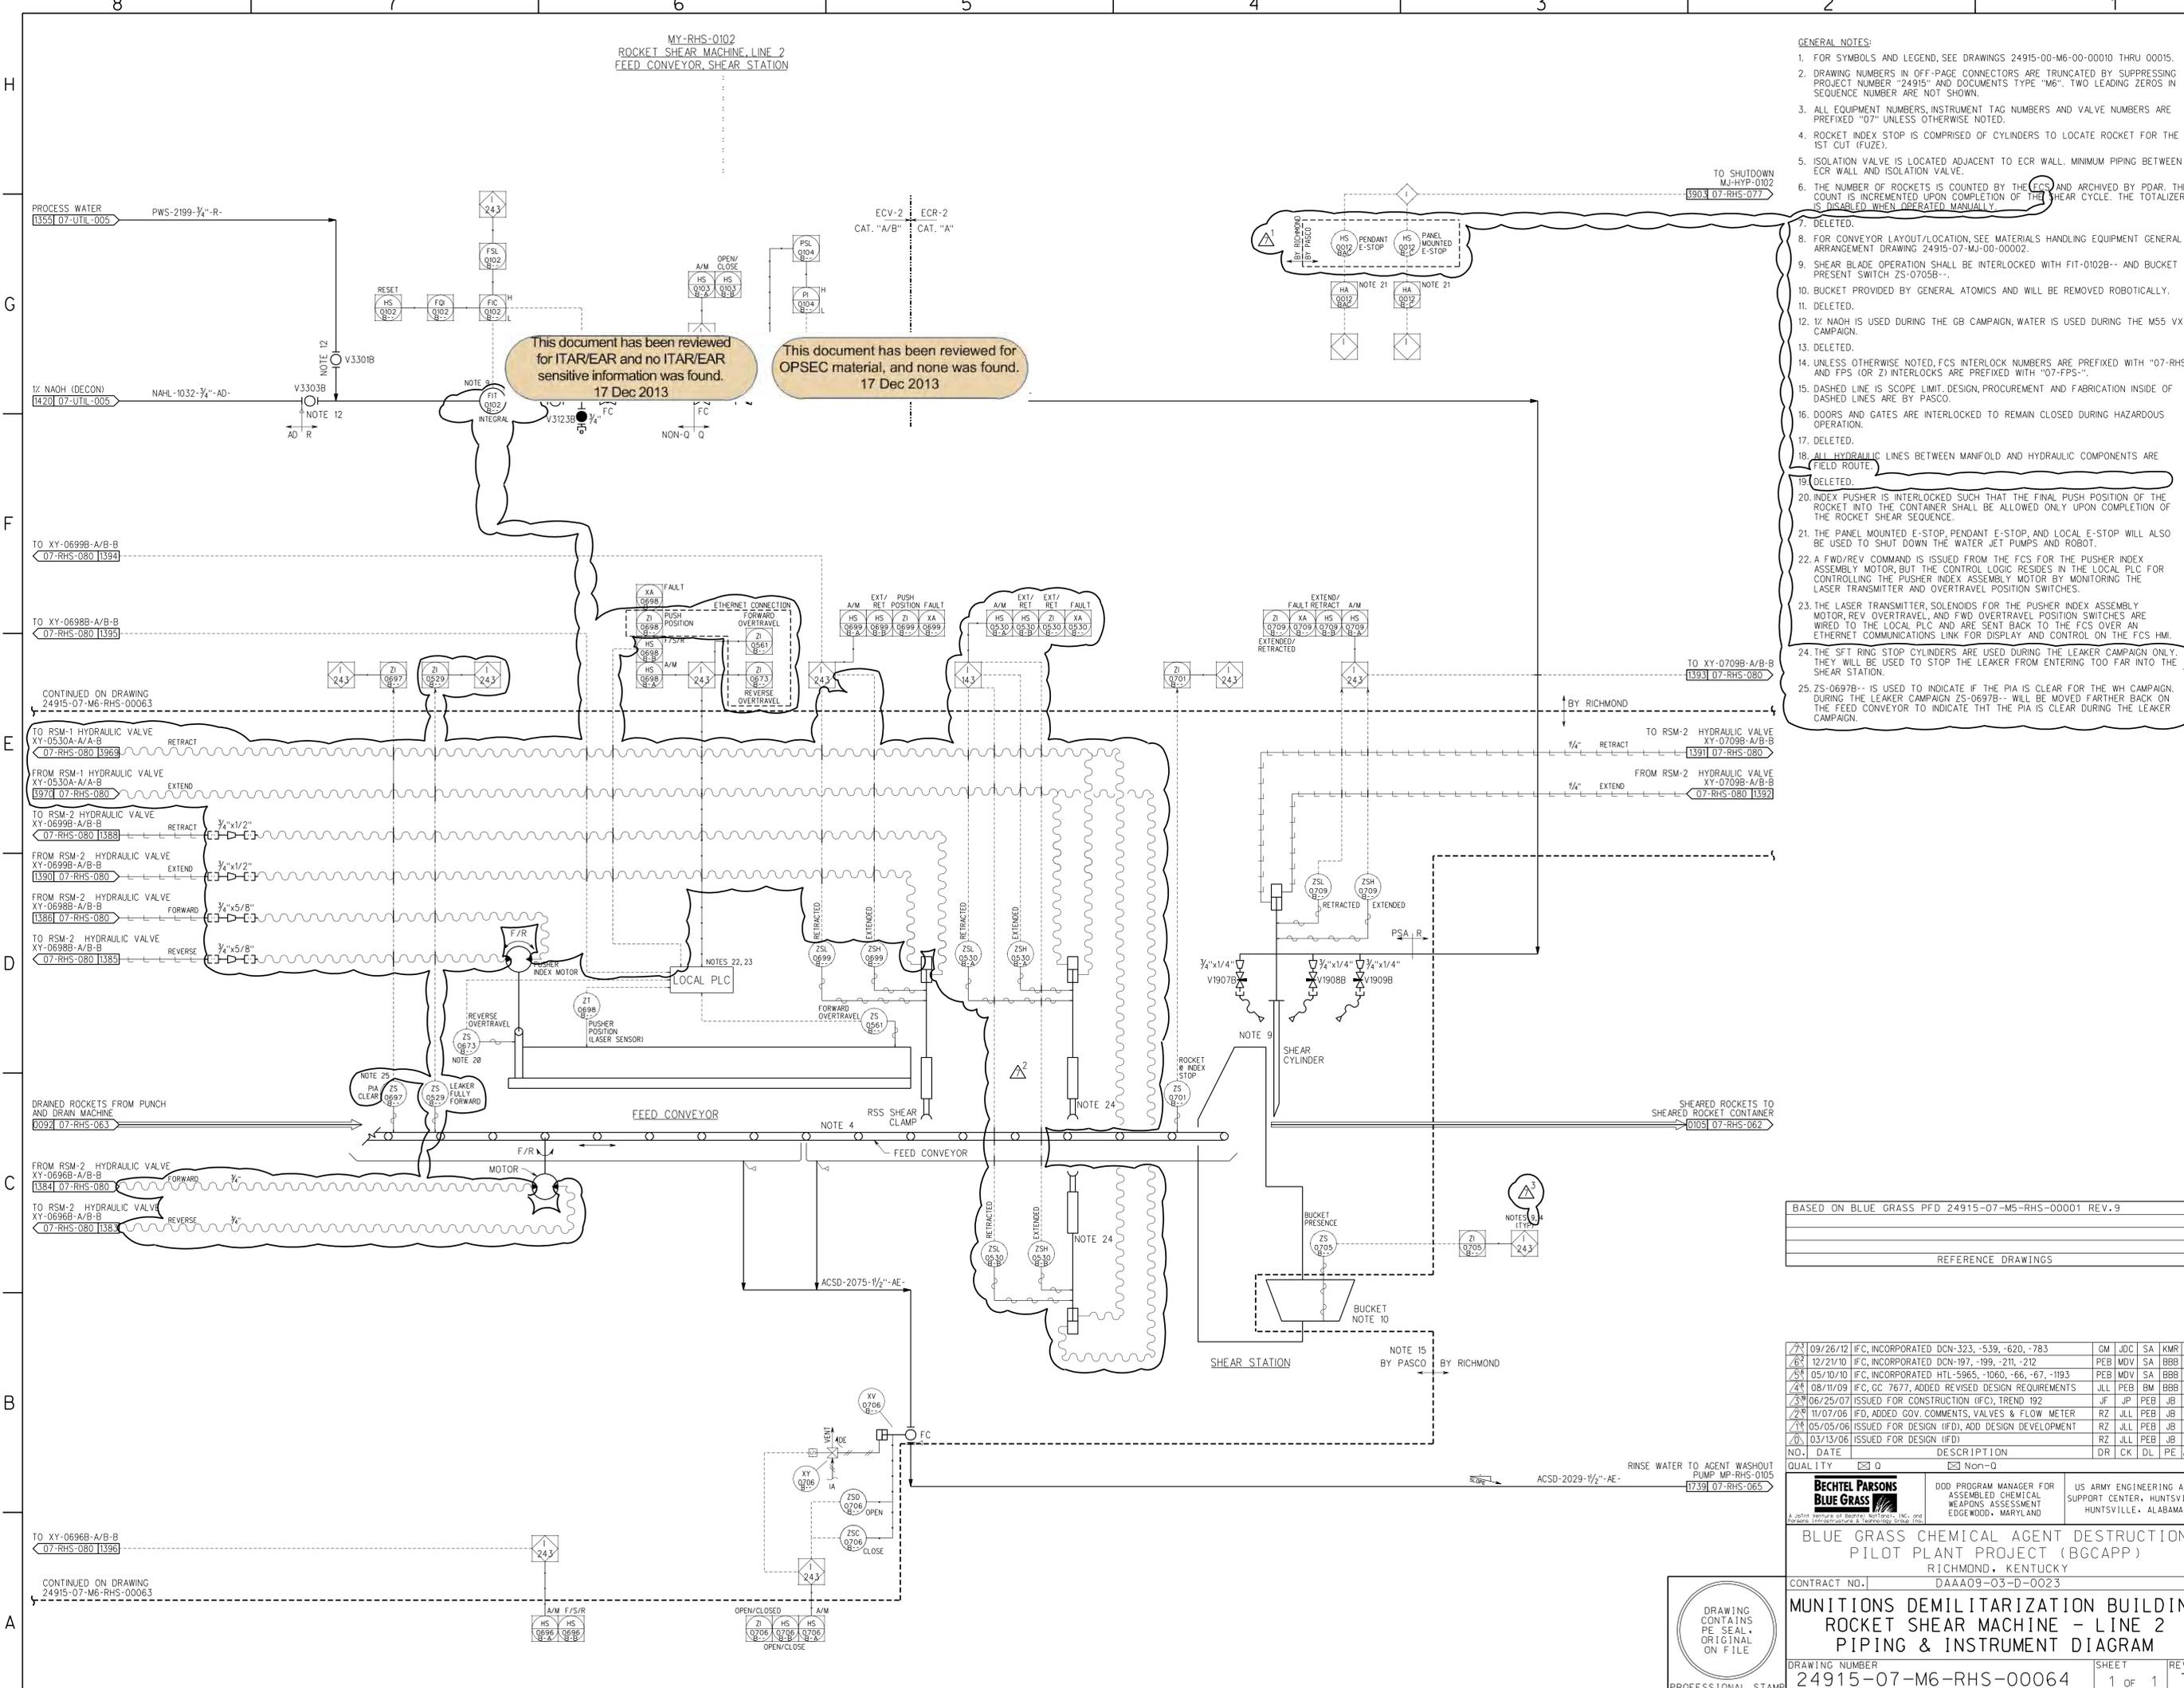

BASED ON BLUE GRASS PFD 24915-07-M6-RHS-00001 REV. 9

REFERENCE DRAWINGS

NO.	DATE	DESCRIPTION	DR	CK	DL	PE	APRV
1	09/26/12	IFC, INCORPORATED DCN-323, -539, -620, -783	GM	JDC	SA	KMR	KMR
2	12/21/10	IFC, INCORPORATED DCN-197, -199, -211, -212	PEB	MDV	SA	BBB	BBB
3	05/10/10	IFC, INCORPORATED HTL-5965, -1060, -66, -67, -1193	PEB	MDV	SA	BBB	BBB
4	08/11/09	IFC, GC 7677, ADDED REVISED DESIGN REQUIREMENTS	JLL	PEB	BM	BBB	BBB
5	06/25/07	ISSUED FOR CONSTRUCTION (IFC), TREND 192	JF	JP	PEB	JB	BBB
6	11/07/06	IFD, ADDED GOV. COMMENTS, VALVES & FLOW METER	RZ	JLL	PEB	JB	BBB
7	05/05/06	ISSUED FOR DESIGN (IFD), ADD DESIGN DEVELOPMENT	RZ	JLL	PEB	JB	BBB
8	03/13/06	ISSUED FOR DESIGN (IFD)	RZ	JLL	PEB	JB	BBB

QUALITY Q Non-Q

BECHTEL PARSONS BLUE GRASS

DDO PROGRAM MANAGER FOR ASSEMBLED CHEMICAL WEAPONS ASSESSMENT EDgewood, MARYLAND

US ARMY ENGINEERING AND SUPPORT CENTER, HUNTSVILLE, ALABAMA

BLUE GRASS CHEMICAL AGENT DESTRUCTION PILOT PLANT PROJECT (BGCAPP) RICHMOND, KENTUCKY


CONTRACT NO. DAAA09-03-D-0023

MUNITIONS DEMILITARIZATION BUILDING ROCKET SHEAR MACHINE - LINE 2 PIPING & INSTRUMENT DIAGRAM

DRAWING NUMBER 24915-07-M6-RHS-00064 SHEET 1 OF 1 REV 7



07MHS06A.dwg 09/27/10
 DESIGN FILE: D:\SPR\24915-07-M6-RHS-00063
 PLOTTED BY: USER ON DATE 09/27/10

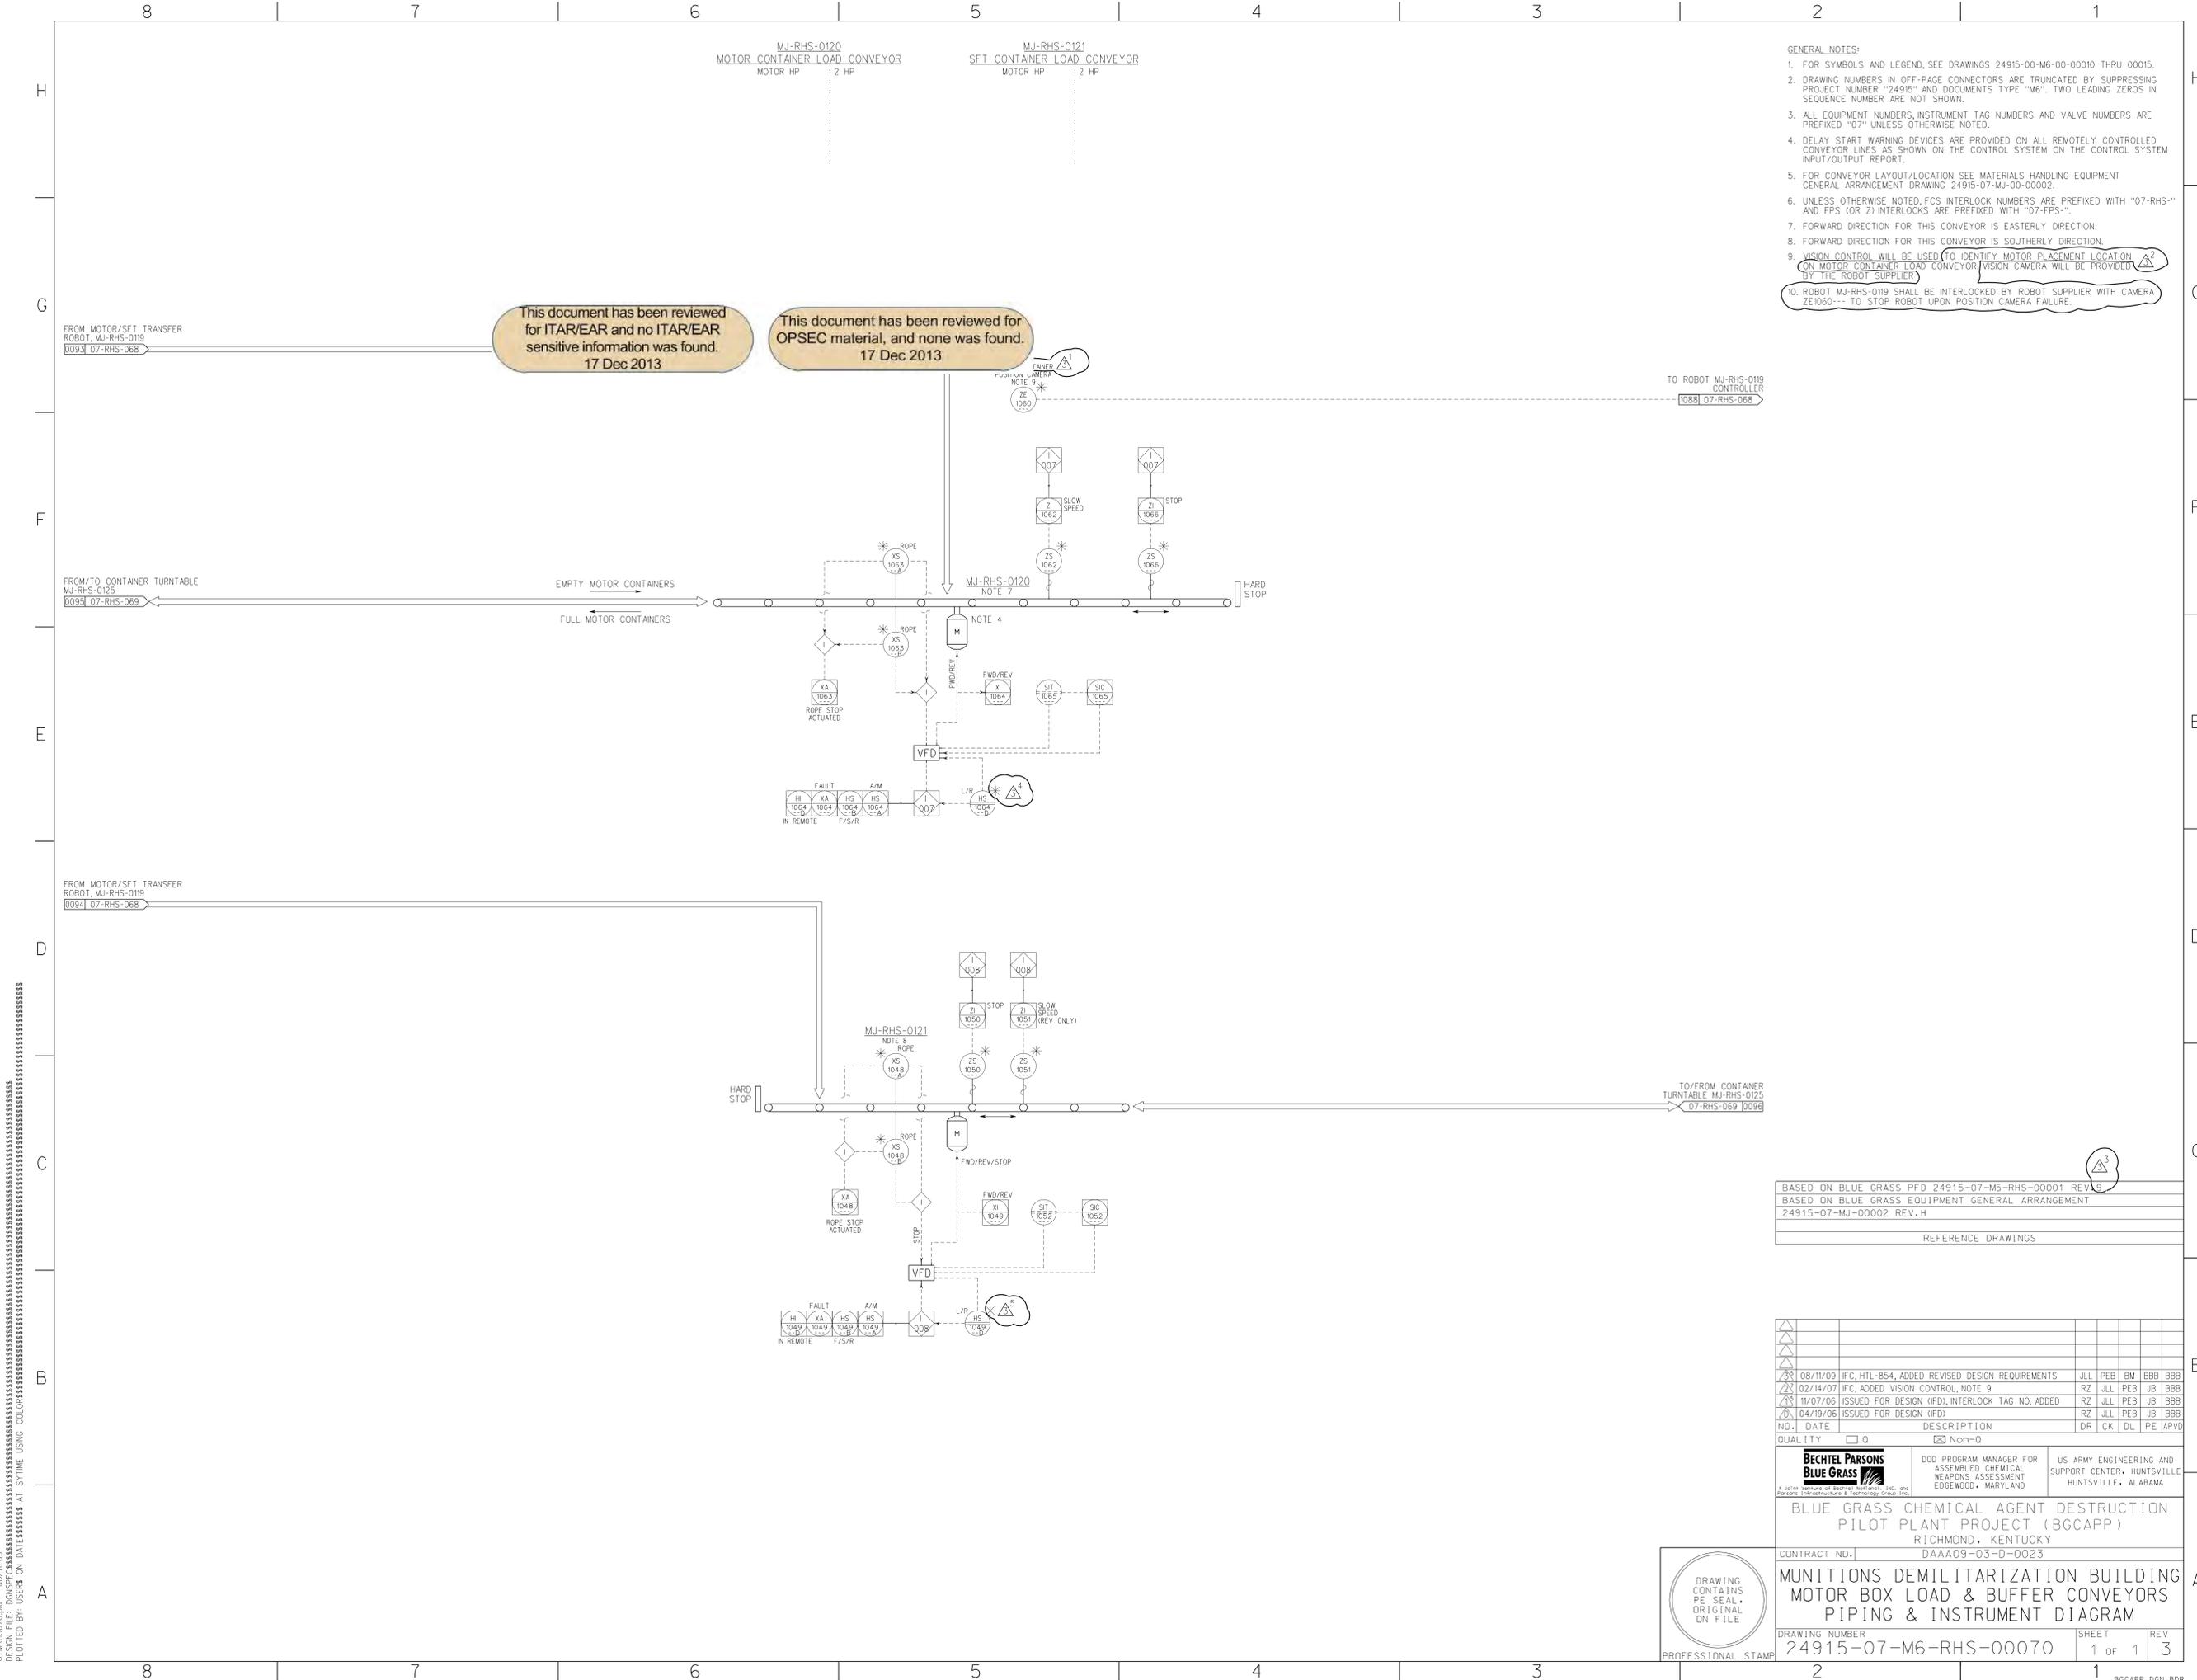

This document has been reviewed for ITAR/EAR and no ITAR/EAR sensitive information was found. 17 Dec 2013

This document has been reviewed for OPSEC material, and none was found. 17 Dec 2013

- GENERAL NOTES:
- FOR SYMBOLS AND LEGEND, SEE DRAWINGS 24915-00-M6-00-00010 THRU 00015.
 - DRAWING NUMBERS IN OFF-PAGE CONNECTORS ARE TRUNCATED BY SUPPRESSING PROJECT NUMBER "24915" AND DOCUMENTS TYPE "M6". TWO LEADING ZEROS IN SEQUENCE NUMBER ARE NOT SHOWN.
 - ALL EQUIPMENT NUMBERS, INSTRUMENT TAG NUMBERS AND VALVE NUMBERS ARE PREFIXED "07" UNLESS OTHERWISE NOTED.
 - DELAY START WARNING DEVICES ARE PROVIDED ON ALL REMOTELY CONTROLLED CONVEYOR LINES AS SHOWN ON THE CONTROL SYSTEM ON THE CONTROL SYSTEM INPUT/OUTPUT REPORT.
 - FOR CONVEYOR LAYOUT/LOCATION SEE MATERIALS HANDLING EQUIPMENT GENERAL ARRANGEMENT DRAWING 24915-07-MJ-00-00002.
 - UNLESS OTHERWISE NOTED, FCS INTERLOCK NUMBERS ARE PREFIXED WITH "07-RHS-" AND FPS (OR Z) INTERLOCKS ARE PREFIXED WITH "07-FPS-".
 - FORWARD DIRECTION FOR THIS CONVEYOR IS SOUTHERLY DIRECTION.
 - VISION CONTROL WILL BE USED TO IDENTIFY MOTOR PLACEMENT LOCATION ON MOTOR CONTAINER LOAD CONVEYOR. VISION CAMERA WILL BE PROVIDED BY THE ROBOT SUPPLIER.
 - ROBOT MJ-RHS-0119 SHALL BE INTERLOCKED BY ROBOT SUPPLIER WITH CAMERA ZE1060--- TO STOP ROBOT UPON POSITION CAMERA FAILURE.

BASED ON BLUE GRASS PFD 24915-07-M6-RHS-00001 REV. 9
 BASED ON BLUE GRASS EQUIPMENT GENERAL ARRANGEMENT 24915-07-MJ-00002 REV. H
 REFERENCE DRAWINGS

NO.	DATE	DESCRIPTION	DR	CK	DL	PE	APVD
33	08/11/09	IFC, HTL-854, ADDED REVISED DESIGN REQUIREMENTS	JLL	PEB	BM	BBB	BBB
32	02/14/07	IFC, ADDED VISION CONTROL, NOTE 9	RZ	JLL	PEB	JB	BBB
31	11/07/06	ISSUED FOR DESIGN (IFD), INTERLOCK TAG NO. ADDED	RZ	JLL	PEB	JB	BBB
30	04/19/06	ISSUED FOR DESIGN (IFD)	RZ	JLL	PEB	JB	BBB

QUALITY 0 Non-0

BECHTEL PARSONS BLUE GRASS
 A joint venture of Bechtel Technology, Inc. and Parsons Infrastructure & Technology Group, Inc.

DDO PROGRAM MANAGER FOR ASSEMBLED CHEMICAL WEAPONS ASSESSMENT EDGEWOOD, MARYLAND

US ARMY ENGINEERING AND SUPPORT CENTER, HUNTSVILLE HUNTSVILLE, ALABAMA

BLUE GRASS CHEMICAL AGENT DESTRUCTION PILOT PLANT PROJECT (BGCAPP)
 RICHMOND, KENTUCKY
 CONTRACT NO. DAAA09-03-D-0023

MUNITIONS DEMILITARIZATION BUILDING MOTOR BOX LOAD & BUFFER CONVEYORS PIPING & INSTRUMENT DIAGRAM

DRAWING NUMBER 24915-07-M6-RHS-00070 SHEET 1 OF 1 REV 3




07MRHS0700.pfd 08/11/09
 DESIGN FILE: DONSPEC AT SYTIME USING COLORPLOT
 PLOTTED BY USER ON DATE 08/11/09

AD-RHS-0116 CONTAINER MONITORING AIRLOCK IN-GATE MOTOR HP : 2 HP
 MJ-RHS-0128 CONTAINER MONITORING AIRLOCK CONVEY MOTOR HP : 2 HP
 MJ-RHS-0127 CONTAINER MONITORING AIRLOCK TRIM : TRIM-1108-0"-A-
 AD-RHS-0117 CONTAINER MONITORING AIRLOCK OUTGATE MOTOR HP : 2 HP

- GENERAL NOTES:
- FOR SYMBOLS AND LEGEND, SEE DRAWINGS 24915-00-M6-00-00010 THRU 00015.
 - DRAWING NUMBERS IN OFF-PAGE CONNECTORS ARE TRUNCATED BY SUPPRESSING PROJECT NUMBER "24915" AND DOCUMENTS TYPE "M6". TWO LEADING ZEROS IN SEQUENCE NUMBER ARE NOT SHOWN.
 - ALL EQUIPMENT NUMBERS, INSTRUMENT TAG NUMBERS AND VALVE NUMBERS ARE PREFIXED "07" UNLESS OTHERWISE NOTED.
 - FOR CONVEYOR LAYOUT/LOCATION SEE MATERIALS HANDLING EQUIPMENT GENERAL ARRANGEMENT DRAWING 24915-07-MJ-00-00002.
 - INLET GATE AD-RHS-0116 SHALL BE INTERLOCKED WITH OUTLET GATE AD-RHS-0117 TO PREVENT THEM FROM OPENING SIMULTANEOUSLY. AIRLOCK GATES ARE INTERLOCKED WITH A TIMER.
 - INSTRUMENTATION AND VALVING SHOWN ON HVAC DRAWING NUMBER 24915-07-M6-HVAC-00266. STOP BOTH THE VENTILATION INFLOW AND OUTFLOW DURING MONITORING, BY CLOSING BOTH THE AIR INLET DAMPER AND THE AIR OUTLET PRESSURE CONTROL DAMPER.
 - AIRLOCK IN-GATE AD-RHS-0116 SHALL BE INTERLOCKED WITH MPR INLET AIRLOCK OUT-GATE AD-RHS-0121 OF MPR INLET AIRLOCK (MJ-RHS-0123) ON PAID 24915-07-M6-RHS-00076 TO PREVENT ONE GATE FROM OPENING WHILE THE OTHER GATE IS OPEN.
 - UNLESS OTHERWISE NOTED, FCS INTERLOCK NUMBERS ARE PREFIXED WITH "07-RHS-" AND FPS (OR Z) INTERLOCKS ARE PREFIXED WITH "07-FPS-".
 - CONTAINER MONITORING AIRLOCK OUT-GATE (AD-RHS-0117) IS INTERLOCKED CLOSED IF AGENT HIGH ALARM IS ACTIVATED.
 - GATE CLEAR SWITCHES SHOWN ON AIRLOCK GATE ARE PHYSICALLY LOCATED ON ADJACENT CONVEYORS.
 - CONTAINER MONITORING AIRLOCK OUTLET GATE AD-RHS-0117 SHALL BE INTERLOCKED CLOSED UNTIL CLEARED BY AGENT MONITORING.
 - AGENT MONITOR SHALL BE CONFIGURED TO MEASURE H, GB OR VX DEPENDING ON CAMPAIGN.
 - DELETED.
 - SOLENOID VALVE SHALL VENT INTO AIRLOCK.
 - THROUGH BEAM SENSOR TO ENSURE RM'S ARE BELOW HOOD ELEVATION.
 - CONVEYOR MOTOR SHALL BE INTERLOCKED WITH THE MONITORING HOOD POSITION SUCH THAT THE CONVEYOR CANNOT MOVE UNLESS THE HOOD IS IN THE UP POSITION.
 - FEEDBACK STATUS OF THE HOOD IN EITHER UP OR DOWN POSITION SHALL BE PROVIDED TO THE FCS AT ALL TIMES.
 - HOLDS 1 AND 2 FOR INTERLOCK TAG NUMBERS.
 - SAMPLE RETURNS FROM MINICAMS ARE INCLUDED IN SAMPLE HEAT TRACE BUNDLES, BY I&C.

This document has been reviewed for ITAR/EAR and no ITAR/EAR sensitive information was found. 17 Dec 2013

This document has been reviewed for OPSEC material, and none was found. 17 Dec 2013

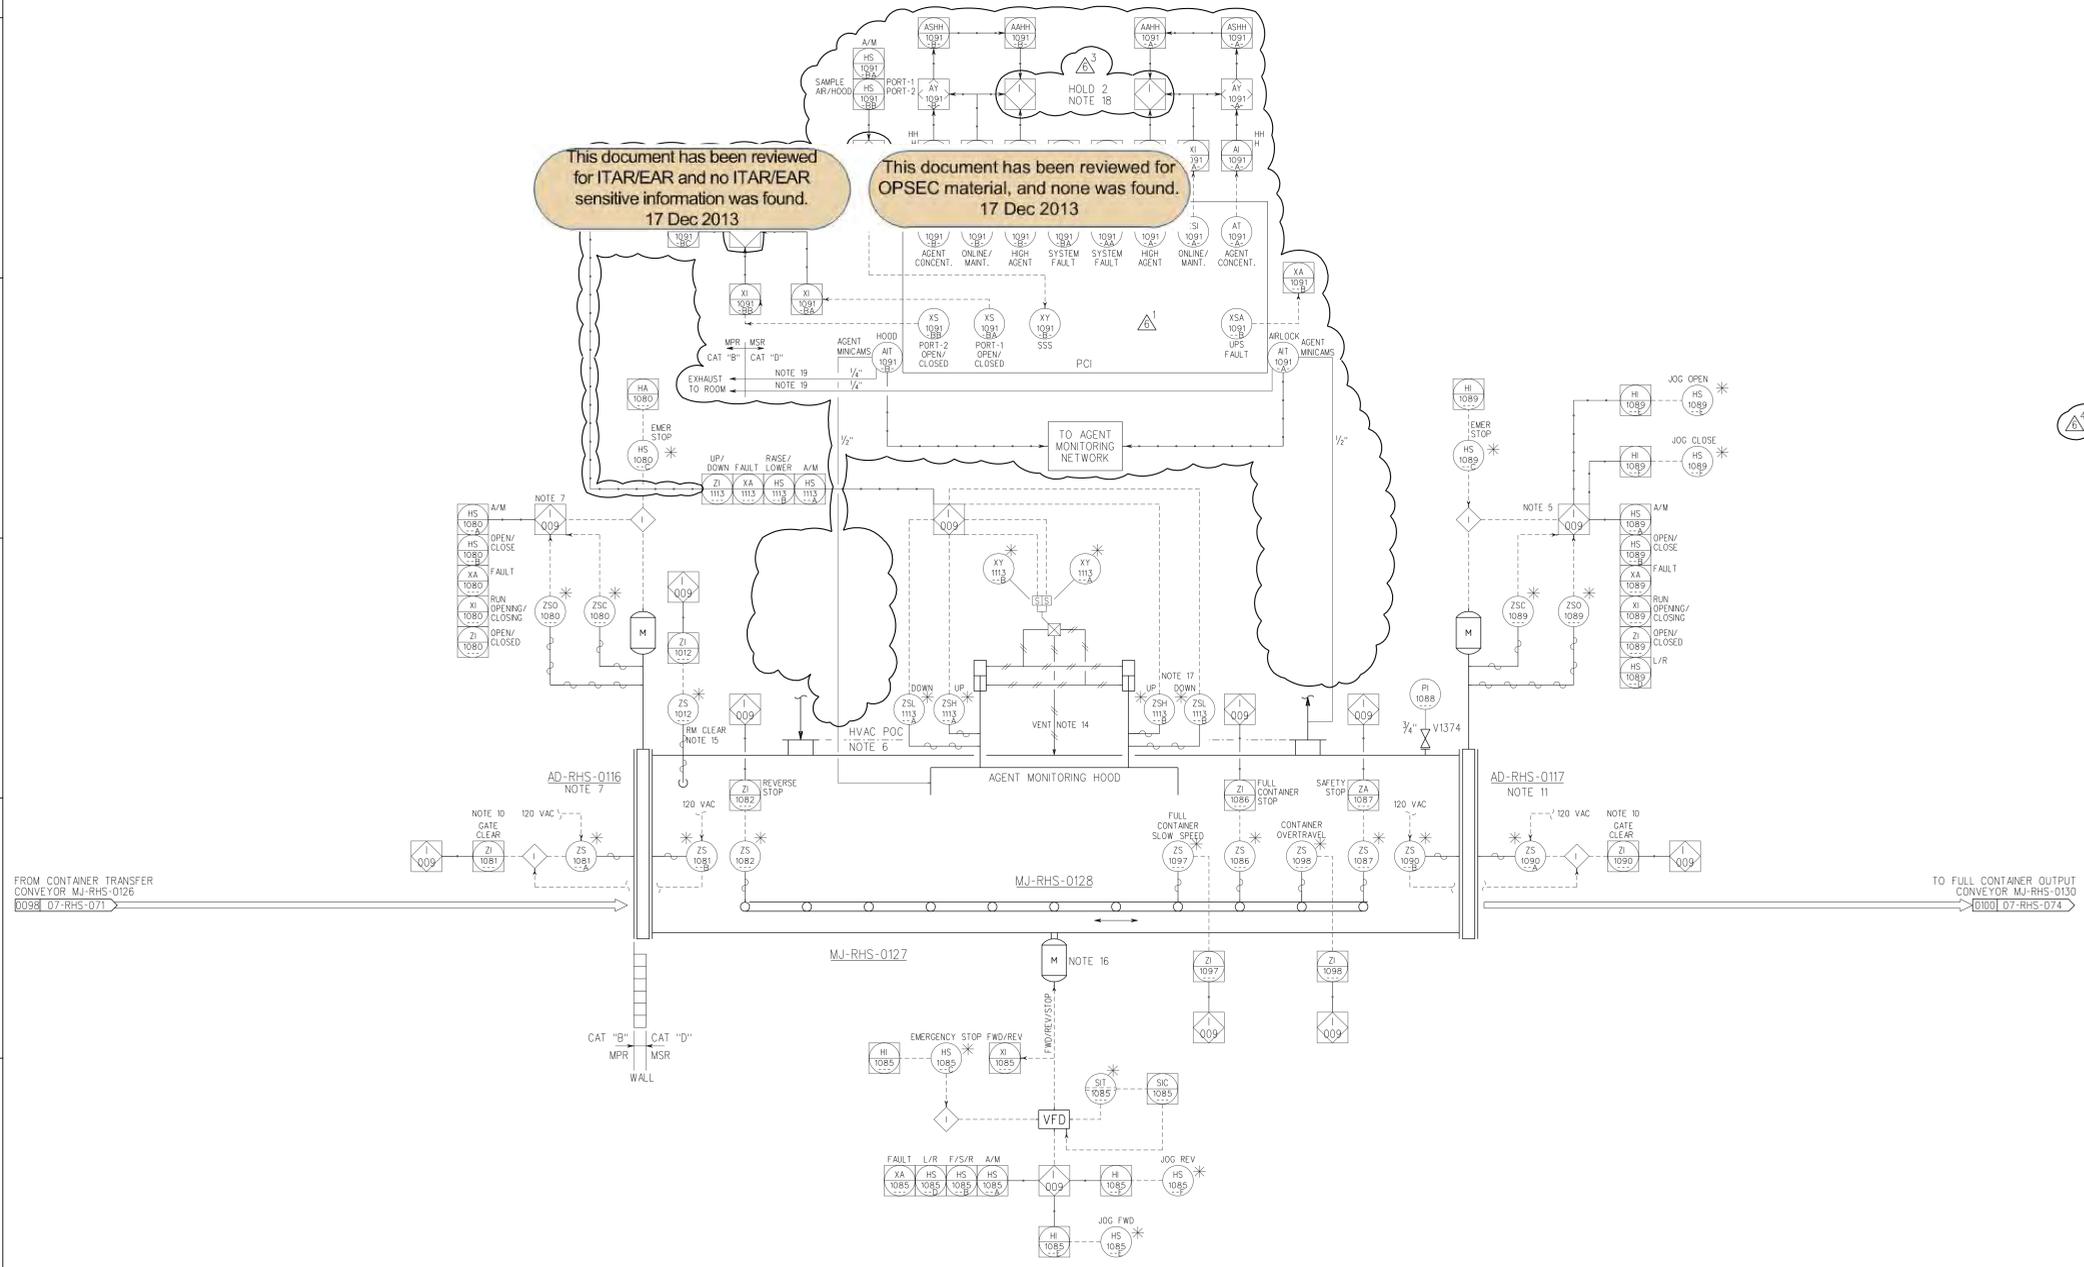

BASED ON BLUE GRASS PFD 24915-07-M6-RHS-00001 REV. 9

REFERENCE DRAWINGS

NO.	DATE	DESCRIPTION	DR	CK	DL	PE	APVD
64	09/26/12	IFC, INCORPORATED DCN-813	GM	JDC	SA	KMR	KMR
63	08/02/11	IFC, INCORPORATED DCN-271, 405 & HLT-1211	PEB	GM	SA	BBB	BBB
62	08/11/09	IFC, HLT-846, ADDED REVISED DESIGN REQUIREMENTS	JLL	PEB	BM	BBB	BBB
61	06/25/07	IFC, ADDED DOOR/AGENT MONITOR INTERLOCK	JF	JP	PEB	JB	BBB
60	11/07/06	ISSUED FOR DESIGN (IFD), INTERLOCK TAG NO. ADDED	RZ	JLL	PEB	JB	BBB
59	05/05/06	ISSUED FOR DESIGN (IFD), ADD DESIGN DEVELOPMENT	RZ	JLL	PEB	JB	BBB
58	04/19/06	ISSUED FOR DESIGN (IFD)	RZ	JLL	PEB	JB	BBB

BECHTEL PARSONS BLUE GRASS
 DOD PROGRAM MANAGER FOR ASSEMBLED CHEMICAL WEAPONS ASSESSMENT EDgewood, MARYLAND
 US ARMY ENGINEERING AND SUPPORT CENTER, HUNTSVILLE, ALABAMA

BLUE GRASS CHEMICAL AGENT DESTRUCTION PILOT PLANT PROJECT (BCAPP)
 RICHMOND, KENTUCKY
 DAAA09-03-D-0023

MUNITIONS DEMILITARIZATION BUILDING MONITORING AIRLOCK AND CONVEYOR PIPING & INSTRUMENT DIAGRAM

DRAWING NUMBER 24915-07-M6-RHS-00072 SHEET 1 OF 1 REV 6




07MHS072.pfd 09/26/12
 DESIGN FILE: DONSPEC
 PLOTTED BY: USER ON DATE: 9/26/2012 4:51:45 PM

This document has been reviewed for ITAR/EAR and no ITAR/EAR sensitive information was found. 17 Dec 2013

This document has been reviewed for OPSEC material, and none was found. 17 Dec 2013

- GENERAL NOTES:
- FOR SYMBOLS AND LEGEND, SEE DRAWINGS 24915-00-M6-00-0010 THRU 00015.
 - DRAWING NUMBERS IN OFF-PAGE CONNECTORS ARE TRUNCATED BY SUPPRESSING PROJECT NUMBER "24915" AND DOCUMENTS TYPE "M6". TWO LEADING ZEROS IN SEQUENCE NUMBER ARE NOT SHOWN.
 - ALL EQUIPMENT NUMBERS, INSTRUMENT TAG NUMBERS AND VALVE NUMBERS ARE PREFIXED "07" UNLESS OTHERWISE NOTED.
 - FOR CONVEYOR LAYOUT/LOCATION SEE MATERIALS HANDLING EQUIPMENT GENERAL ARRANGEMENT DRAWING 24915-07-MJ-00-00002.
 - MPR INLET AIRLOCK IN-GATE AD-RHS-0120 SHALL BE INTERLOCKED WITH MPR INLET AIRLOCK OUT-GATE AD-RHS-0121 TO PREVENT THEM FROM OPENING SIMULTANEOUSLY. AIRLOCK GATES ARE INTERLOCKED WITH A TIMER.
 - INSTRUMENTATION AND VALVES SHOWN ON HVAC DRAWING NUMBER 24915-07-M6-HVAC-00126.
 - MPR INLET AIRLOCK OUT-GATE AD-RHS-0121 SHALL BE INTERLOCKED WITH CONTAINER MONITORING AIRLOCK IN-GATE AD-RHS-0116 OF CONTAINER MONITORING AIRLOCK (MJ-RHS-0127) ON P&ID 24915-07-M6-RHS-00072 TO PREVENT ONE GATE TO OPEN WHILE THE OTHER GATE IS OPEN.
 - UNLESS OTHERWISE NOTED, FCS INTERLOCK NUMBERS ARE PREFIXED WITH "07-RHS-" AND FPS (OR Z) INTERLOCKS ARE PREFIXED WITH "07-FPS-".
 - MPR INLET AIRLOCK OUT-GATE (AD-RHS-0121) IS INTERLOCKED CLOSED IF AGENT IS DETECTED IN MOTOR PACKING ROOM 07-163.
 - GATE CLEAR SWITCHES SHOWN ON AIRLOCK GATE ARE PHYSICALLY LOCATED ON ADJACENT CONVEYORS.
 - MPR INLET AIRLOCK INLET GATE AD-RHS-0120 SHALL BE INTERLOCKED CLOSED UNTIL CLEARED BY AGENT MONITORING.
 - SWITCHES ZS-1284--- AND ZS-1287--- ON MPR INLET AIRLOCK CONVEYOR ARE USED FOR TRAY TRACKING.
 - MPR INLET AIRLOCK INLET GATE AD-RHS-0120 SHALL BE INTERLOCKED CLOSED WITH TRAY TRACKING WHEN IT INDICATES TRAY IS PRESENT.
 - AGENT MONITOR SHALL BE CONFIGURED TO MEASURE H, GB OR VX DEPENDING ON CAMPAIGN.

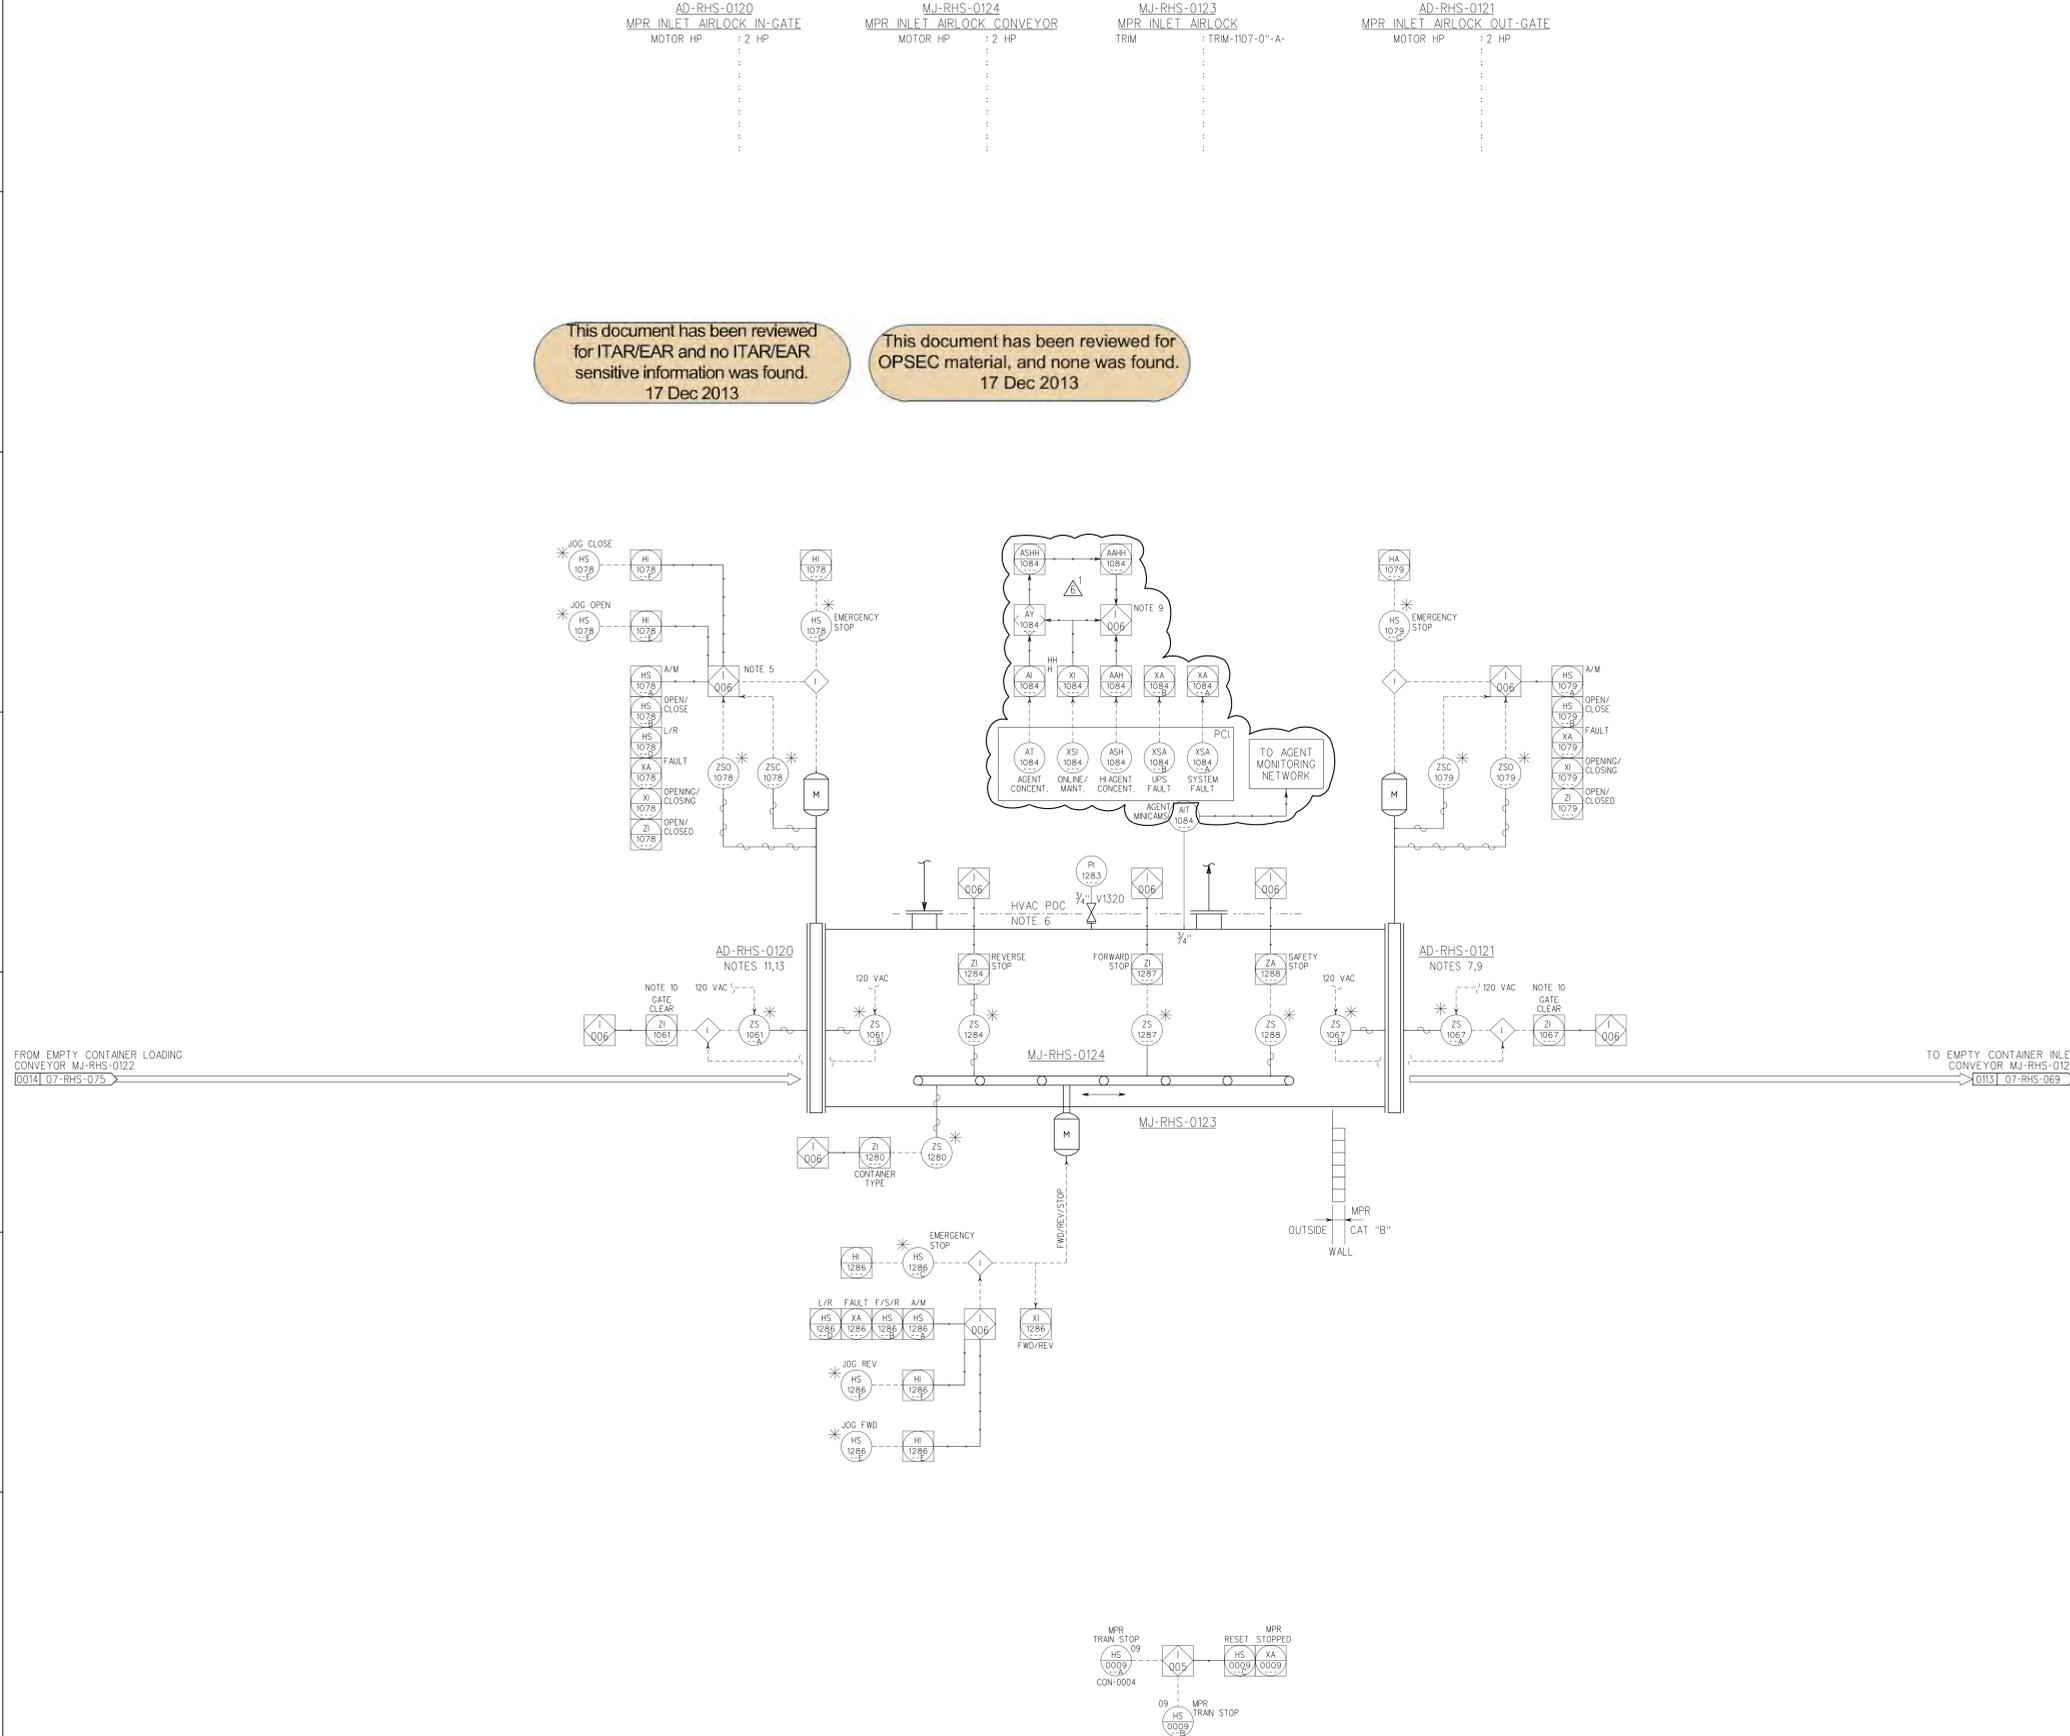

BASED ON BLUE GRASS PFD 24915-07-M6-RHS-00001 REV.9

REFERENCE DRAWINGS

NO.	DATE	DESCRIPTION	DR	CK	DL	PE	APVD
63	09/26/12	IFC, INCORPORATED DCN-813	GM	JDC	SA	KMR	KMR
62	10/05/10	IFC, INCORPORATED DCR-200, HTL-5972	PEB	MDV	SA	BBB	BBB
42	08/11/09	IFC, INCORPORATED REVISED DESIGN REQUIREMENTS	JLL	PEB	BM	BBB	BBB
34	06/25/07	IFC, ADDED DOOR/AGENT MONITOR INTERLOCK	JF	JP	PEB	JB	BBB
28	11/07/06	IFD, INTERLOCK TAG NO. AND AGENT MONITORING ADDED	RZ	JLL	PEB	JB	BBB
17	05/05/06	IFD, INTERLOCK TAG NO. AND AGENT MONITORING ADDED	RZ	JLL	PEB	JB	BBB
16	04/19/06	ISSUED FOR REVIEW (IFD)	RZ	JLL	PEB	JB	BBB

QUALITY Non-0

BECHTEL PARSONS BLUE GRASS

DOO PROGRAM MANAGER FOR ASSEMBLED CHEMICAL WEAPONS ASSESSMENT EDGEMOOD, MARYLAND

US ARMY ENGINEERING AND SUPPORT CENTER, HUNTSVILLE, ALABAMA

BLUE GRASS CHEMICAL AGENT DESTRUCTION PILOT PLANT PROJECT (BGCAPP) RICHMOND, KENTUCKY


CONTRACT NO. DAAA09-03-D-0023

MUNITIONS DEMILITARIZATION BUILDING MPR INLET AIRLOCK AND CONVEYOR PIPING & INSTRUMENT DIAGRAM

DRAWING NUMBER 24915-07-M6-RHS-00076 SHEET 1 OF 1 REV 6



07MRHS076.pfd 09/26/12 DESIGN FILE: DONSPEC AT SYTIME USING COLORPLOT PLOTTED BY USER ON DATE: 09/26/12

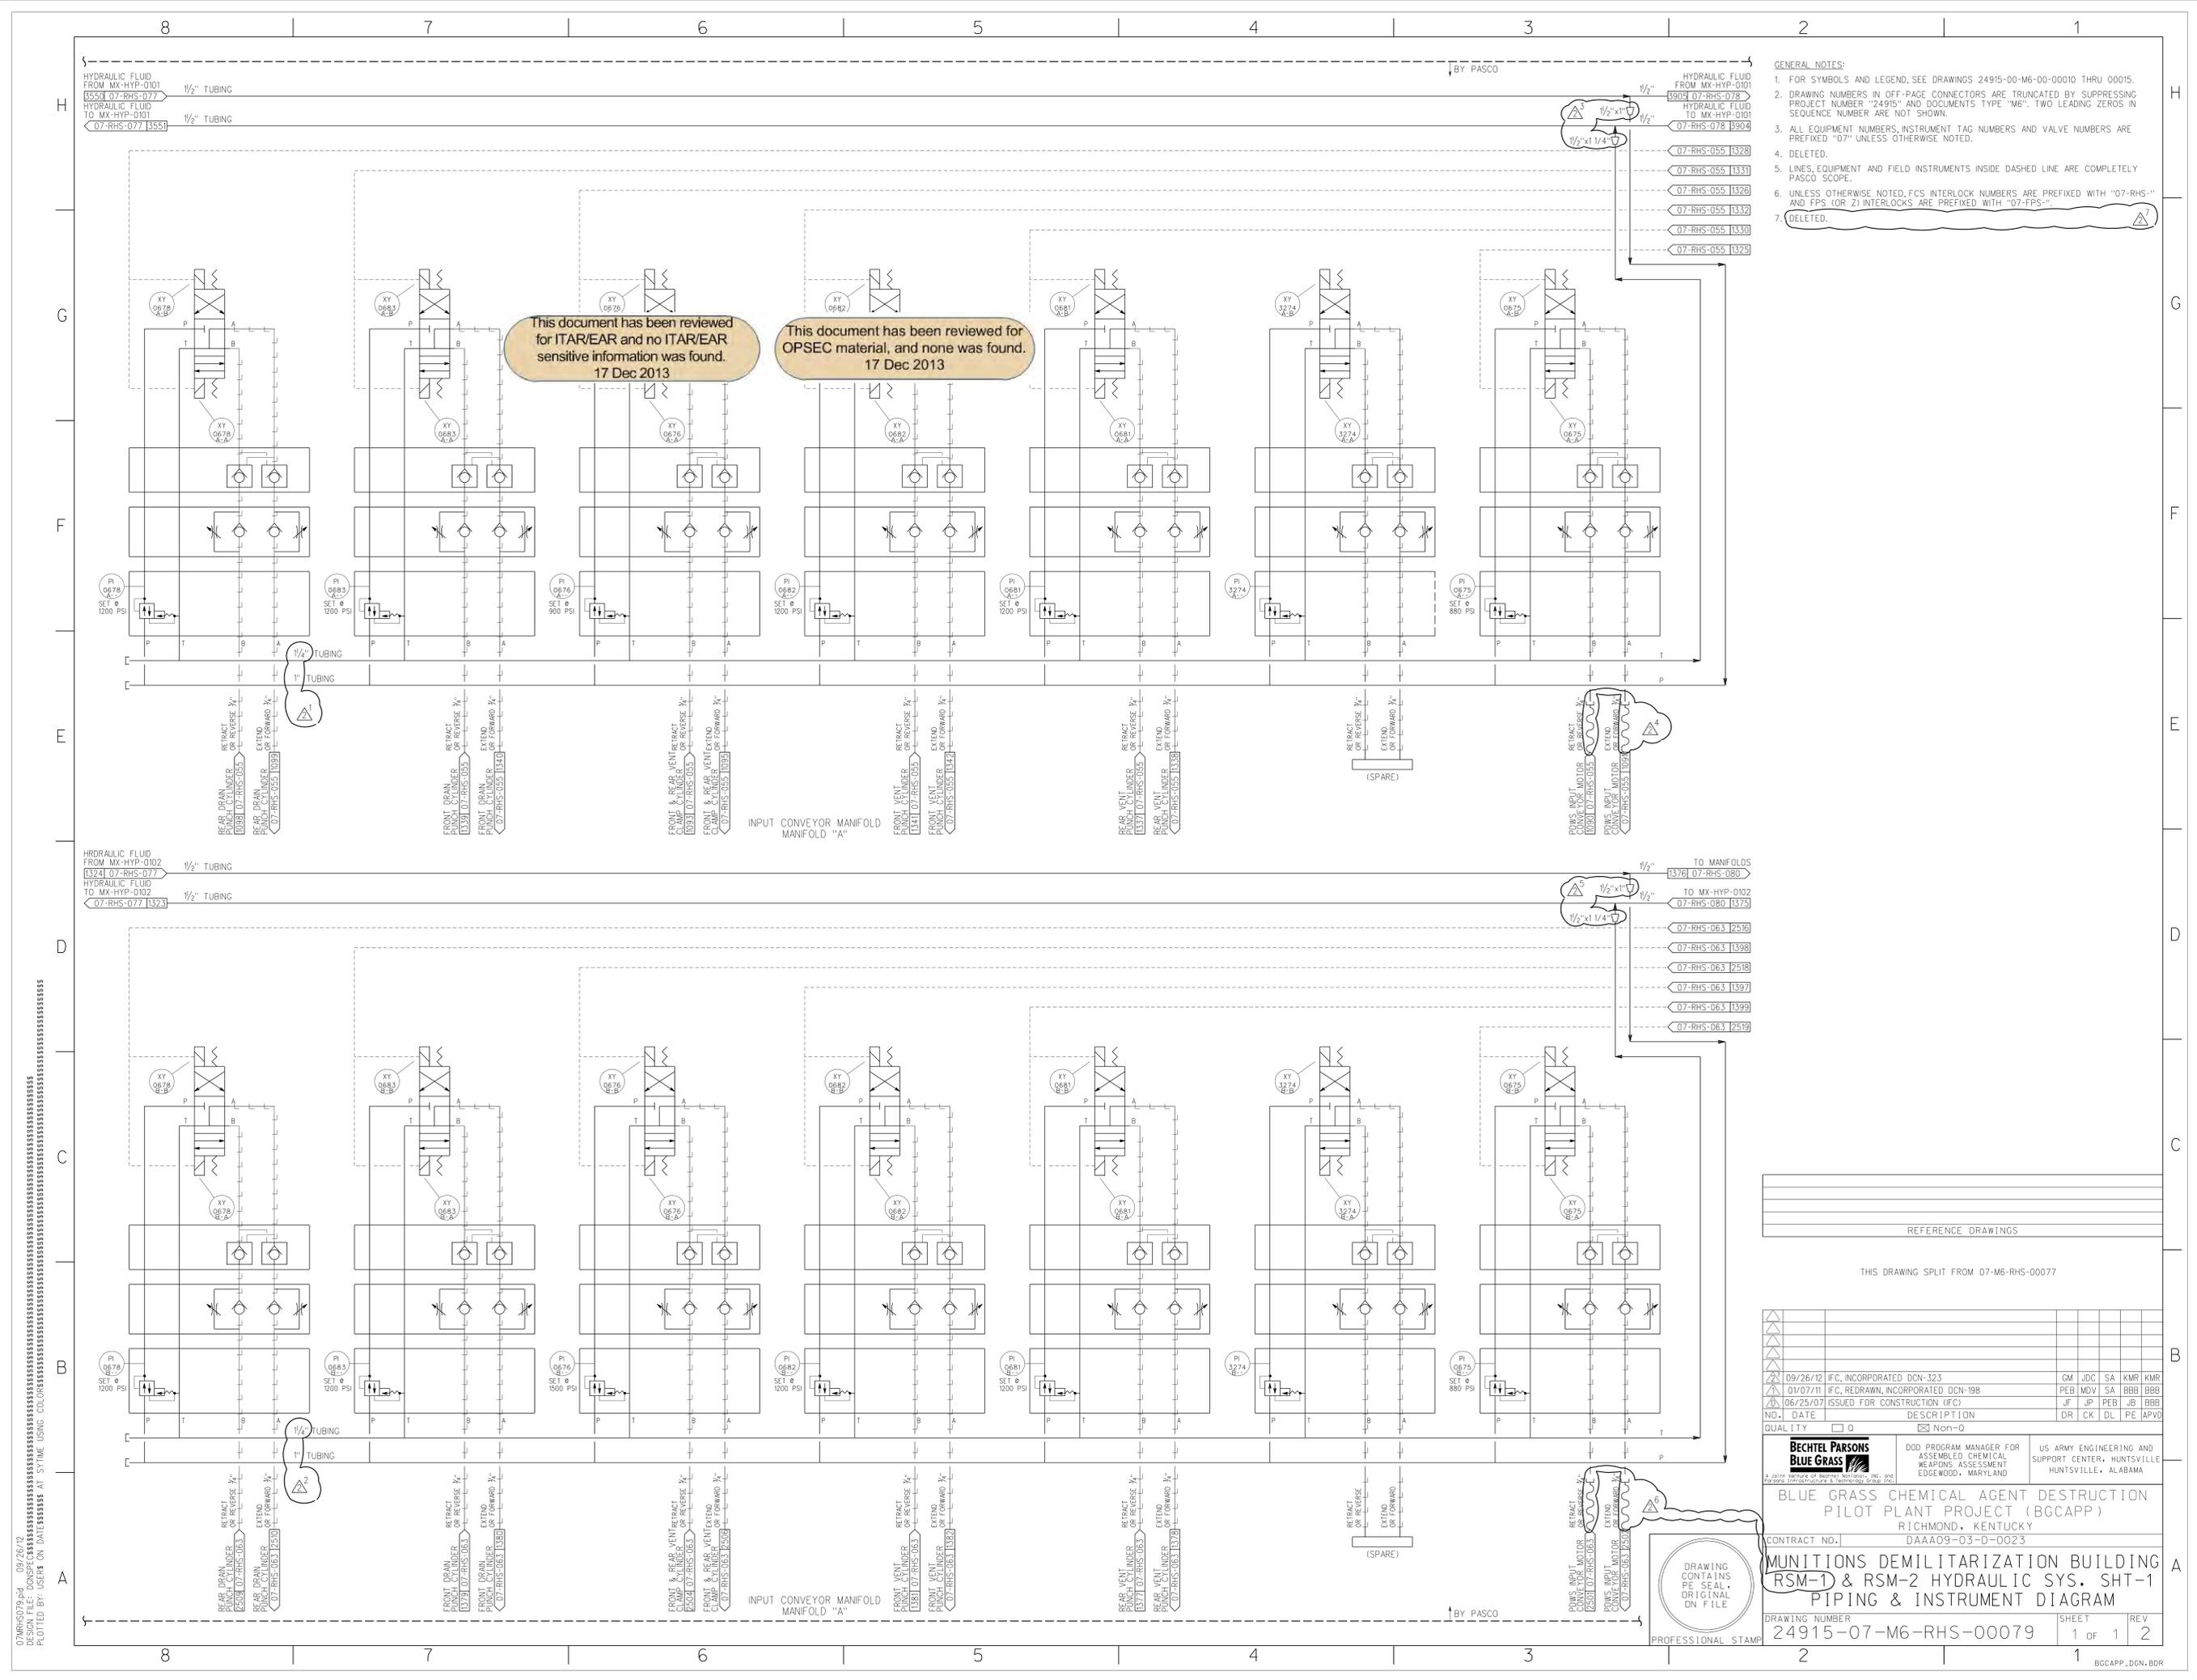

- GENERAL NOTES:
1. FOR SYMBOLS AND LEGEND, SEE DRAWINGS 24915-00-M6-00-00010 THRU 00015.
 2. DRAWING NUMBERS IN OFF-PAGE CONNECTORS ARE TRUNCATED BY SUPPRESSING PROJECT NUMBER "24915" AND DOCUMENTS TYPE "M6". TWO LEADING ZEROS IN SEQUENCE NUMBER ARE NOT SHOWN.
 3. ALL EQUIPMENT NUMBERS, INSTRUMENT TAG NUMBERS AND VALVE NUMBERS ARE PREFIXED "07" UNLESS OTHERWISE NOTED.
 4. DELETED.
 5. LINES, EQUIPMENT AND FIELD INSTRUMENTS INSIDE DASHED LINE ARE COMPLETELY PASCO SCOPE.
 6. UNLESS OTHERWISE NOTED, FCS INTERLOCK NUMBERS ARE PREFIXED WITH "07-RHS-" AND FPS (OR F) INTERLOCKS ARE PREFIXED WITH "07-FPS-".
 7. DELETED.

- TO MANIFOLDS
- 1376 07-RHS-080
 - TO MX-HYP-0102
 - 07-RHS-080 1375

REFERENCE DRAWINGS

--	--	--	--	--	--

THIS DRAWING SPLIT FROM 07-M6-RHS-00077

09/26/12	IFC, INCORPORATED DCN-323	GM	JDC	SA	KMR	KMR
01/07/11	IFC, REDRAWN, INCORPORATED DCN-198	PEB	MDV	SA	BBB	BBB
06/25/07	ISSUED FOR CONSTRUCTION (IFC)	JF	JP	PEB	JB	BBB
NO. DATE	DESCRIPTION	DR	CK	DL	PE	APVD

QUALITY Non-0

BECHTEL PARSONS
BLUE GRASS

DOD PROGRAM MANAGER FOR ASSEMBLED CHEMICAL WEAPONS ASSESSMENT EDgewood, MARYLAND

US ARMY ENGINEERING AND SUPPORT CENTER, HUNTSVILLE HUNTSVILLE, ALABAMA

BLUE GRASS CHEMICAL AGENT DESTRUCTION PILOT PLANT PROJECT (BCAPP)
 RICHMOND, KENTUCKY
 CONTRACT NO. DAAA09-03-D-0023


MUNITIONS DEMILITARIZATION BUILDING RSM-1 & RSM-2 HYDRAULIC SYS. SHT-1 PIPING & INSTRUMENT DIAGRAM

DRAWING NUMBER	SHEET	REV
24915-07-M6-RHS-00079	1 OF 1	2

DRAWING CONTAINS PE SEAL. ORIGINAL ON FILE

PROFESSIONAL STAMP

07M6-RHS-0079.rvt 09/26/12
 DESIGN FILE: DONSPEC

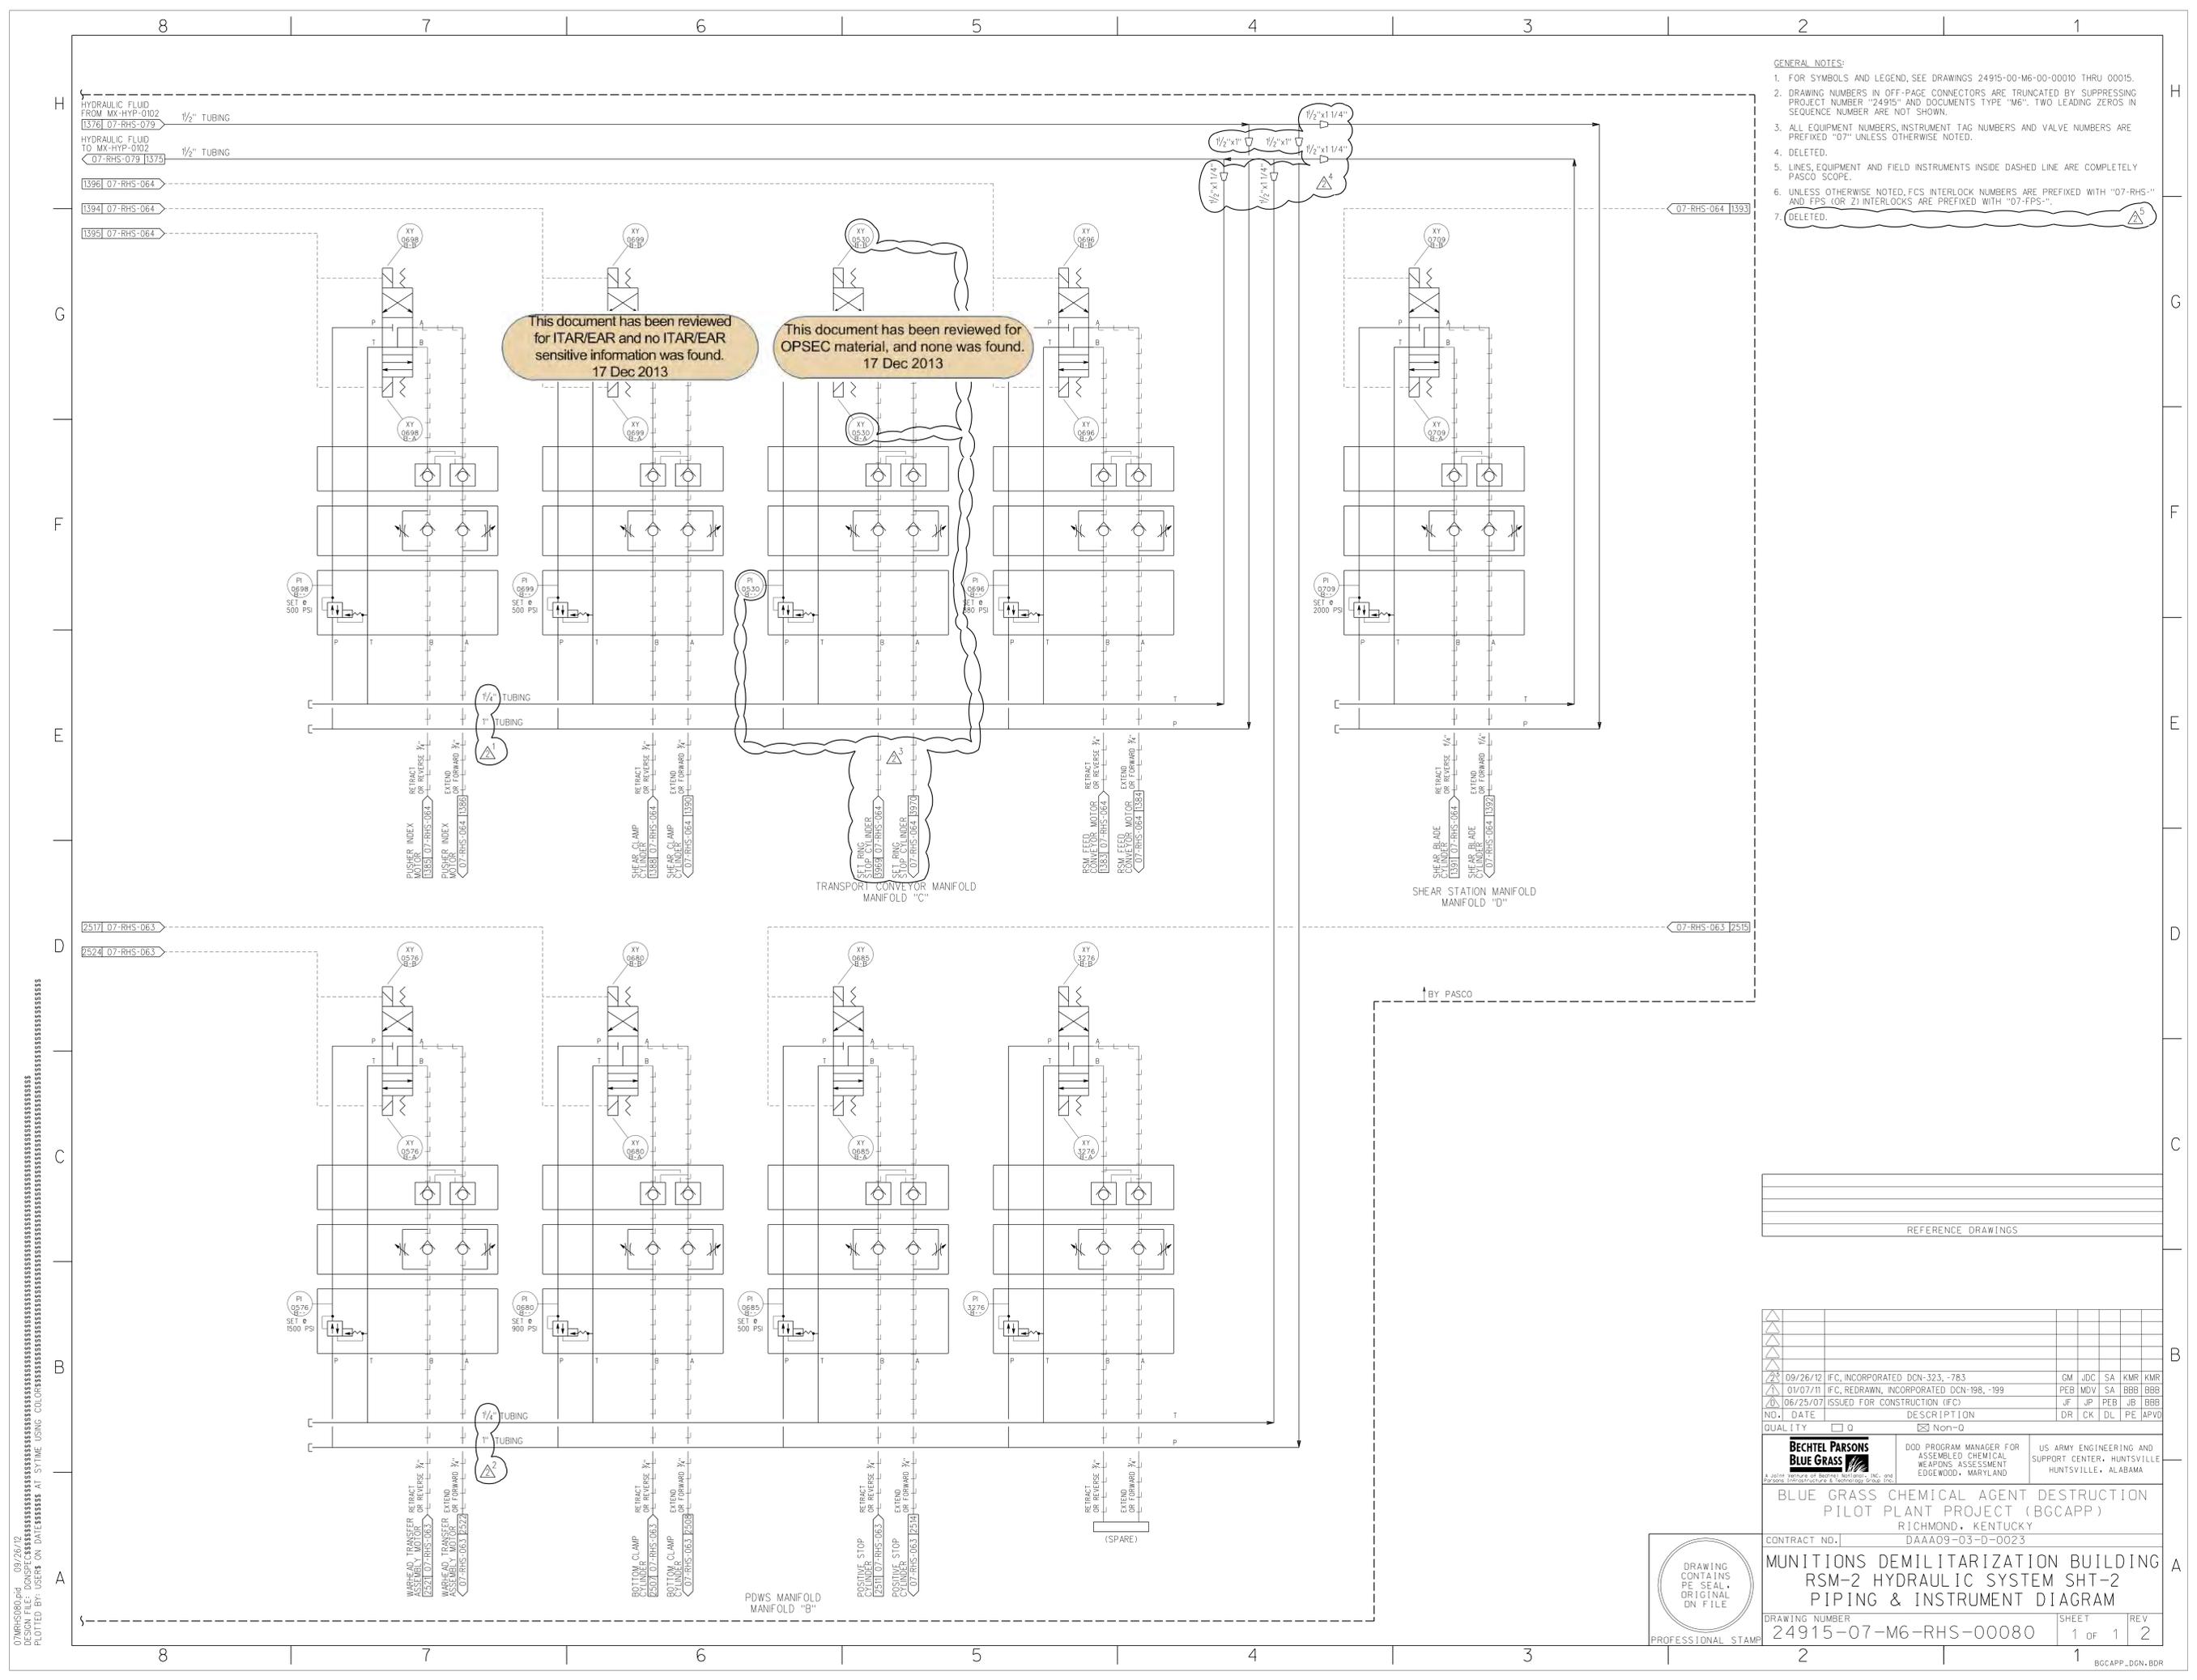

- GENERAL NOTES:
- FOR SYMBOLS AND LEGEND, SEE DRAWINGS 24915-00-M6-00-00010 THRU 00015.
 - DRAWING NUMBERS IN OFF-PAGE CONNECTORS ARE TRUNCATED BY SUPPRESSING PROJECT NUMBER "24915" AND DOCUMENTS TYPE "M6". TWO LEADING ZEROS IN SEQUENCE NUMBER ARE NOT SHOWN.
 - ALL EQUIPMENT NUMBERS, INSTRUMENT TAG NUMBERS AND VALVE NUMBERS ARE PREFIXED "07" UNLESS OTHERWISE NOTED.
 - DELETED.
 - LINE, EQUIPMENT AND FIELD INSTRUMENTS INSIDE DASHED LINE ARE COMPLETELY PASCO SCOPE.
 - UNLESS OTHERWISE NOTED, FCS INTERLOCK NUMBERS ARE PREFIXED WITH "07-RHS-" AND EPS (OR Z) INTERLOCKS ARE PREFIXED WITH "07-FPS-".
 - DELETED.

This document has been reviewed for ITAR/EAR and no ITAR/EAR sensitive information was found. 17 Dec 2013

This document has been reviewed for OPSEC material, and none was found. 17 Dec 2013

07RHS000.dwg 09/26/12
 DESIGN FILE: DOWNSPEC AT SYTIME USING COLOR...
 PLOTTED BY: USER ON DATE...

NO.	DATE	DESCRIPTION	DR	CK	DL	PE	APVD
REFERENCE DRAWINGS							

09/26/12	IFC, INCORPORATED DCN-323, -783	GM	JDC	SA	KMR	KMR	
01/07/11	IFC, REDRAWN, INCORPORATED DCN-198, -199	PEB	MDV	SA	BBB	BBB	
06/25/07	ISSUED FOR CONSTRUCTION (IFC)	JF	JP	PEB	JB	BBB	


BECHTEL PARSONS
BLUE GRASS
 A joint venture of Bechtel Technology, Inc. and Parsons Infrastructure & Technology Group, Inc.

BLUE GRASS CHEMICAL AGENT DESTRUCTION
 PILOT PLANT PROJECT (BCAPP)
 RICHMOND, KENTUCKY
 DAAA09-03-D-0023

MUNITIONS DEMILITARIZATION BUILDING
 RSM-2 HYDRAULIC SYSTEM SHT-2
 PIPING & INSTRUMENT DIAGRAM

CONTRACT NO. | SHEET | REV
 24915-07-M6-RHS-00080 | 1 OF 1 | 2

DRAWING
 CONTAINS
 PE SEAL
 ORIGINAL
 ON FILE
 PROFESSIONAL STAMP

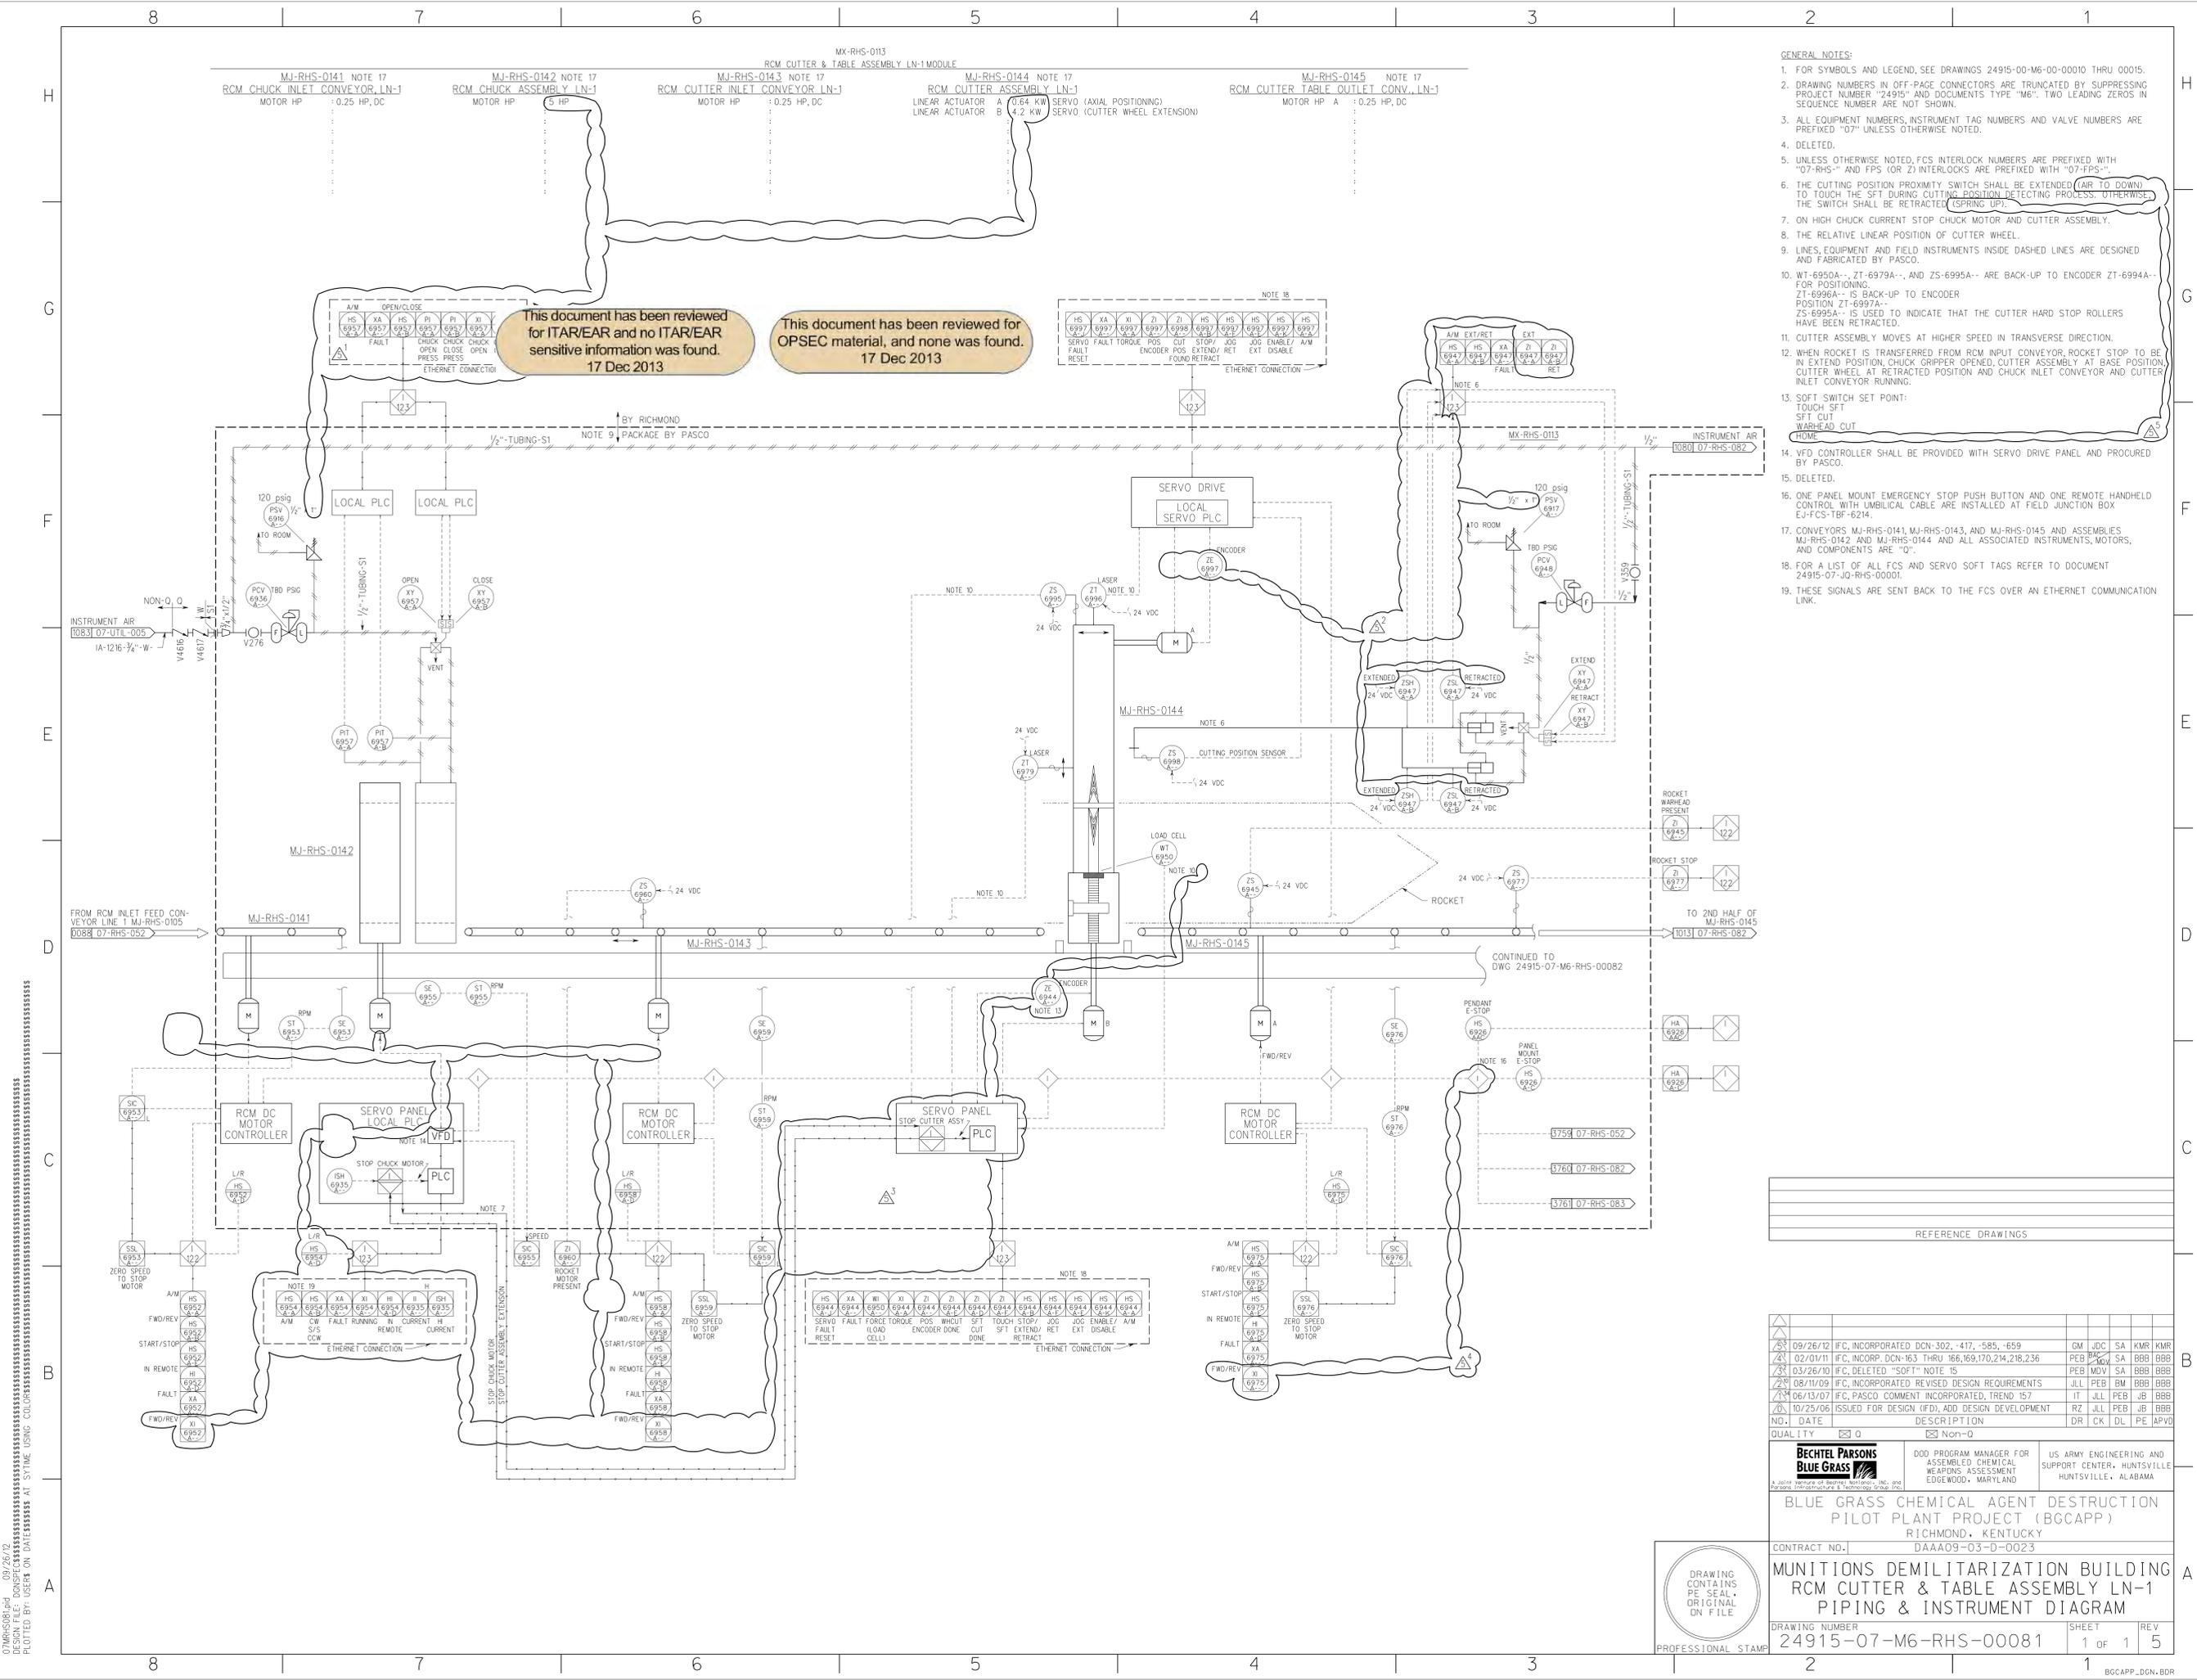

- GENERAL NOTES:**
- FOR SYMBOLS AND LEGEND, SEE DRAWINGS 24915-00-M6-00-00010 THRU 00015.
 - DRAWING NUMBERS IN OFF-PAGE CONNECTORS ARE TRUNCATED BY SUPPRESSING PROJECT NUMBER "24915" AND DOCUMENTS TYPE "M6". TWO LEADING ZEROS IN SEQUENCE NUMBER ARE NOT SHOWN.
 - ALL EQUIPMENT NUMBERS, INSTRUMENT TAG NUMBERS AND VALVE NUMBERS ARE PREFIXED "07" UNLESS OTHERWISE NOTED.
 - DELETED.
 - UNLESS OTHERWISE NOTED, FCS INTERLOCK NUMBERS ARE PREFIXED WITH "07-RHS-" AND FFS (OR Z) INTERLOCKS ARE PREFIXED WITH "07-FFS-".
 - THE CUTTING POSITION PROXIMITY SWITCH SHALL BE EXTENDED (AIR TO DOWN) TO TOUCH THE SFT DURING CUTTING POSITION DETECTING PROCESS. OTHERWISE, THE SWITCH SHALL BE RETRACTED (SPRING UP).
 - ON HIGH CHUCK CURRENT STOP CHUCK MOTOR AND CUTTER ASSEMBLY.
 - THE RELATIVE LINEAR POSITION OF CUTTER WHEEL.
 - LINE, EQUIPMENT AND FIELD INSTRUMENTS INSIDE DASHED LINES ARE DESIGNED AND FABRICATED BY PASCO.
 - WT-6950A--, ZT-6979A--, AND ZS-6995A-- ARE BACK-UP TO ENCODER ZT-6994A-- FOR POSITIONING.
 - ZT-6996A-- IS BACK-UP TO ENCODER POSITION ZT-6997A--.
 - ZS-6995A-- IS USED TO INDICATE THAT THE CUTTER HARD STOP ROLLERS HAVE BEEN RETRACTED.
 - CUTTER ASSEMBLY MOVES AT HIGHER SPEED IN TRANSVERSE DIRECTION.
 - WHEN ROCKET IS TRANSFERRED FROM RCM INPUT CONVEYOR, ROCKET STOP TO BE IN EXTEND POSITION, CHUCK GRIPPER OPENED, CUTTER ASSEMBLY AT BASE POSITION, CUTTER WHEEL AT RETRACTED POSITION AND CHUCK INLET CONVEYOR AND CUTTER INLET CONVEYOR RUNNING.
 - SOFT SWITCH SET POINT:
TOUCH SFT
SFT CUT
WARHEAD CUT
HOME
 - VFD CONTROLLER SHALL BE PROVIDED WITH SERVO DRIVE PANEL AND PROCURED BY PASCO.
 - DELETED.
 - ONE PANEL MOUNT EMERGENCY STOP PUSH BUTTON AND ONE REMOTE HANDHELD CONTROL WITH UMBILICAL CABLE ARE INSTALLED AT FIELD JUNCTION BOX EJ-FCS-1BF-6214.
 - CONVEYORS MJ-RHS-0141, MJ-RHS-0143, AND MJ-RHS-0145 AND ASSEMBLIES MJ-RHS-0142 AND MJ-RHS-0144 AND ALL ASSOCIATED INSTRUMENTS, MOTORS, AND COMPONENTS ARE "0".
 - FOR A LIST OF ALL FCS AND SERVO SOFT TAGS REFER TO DOCUMENT 24915-07-J0-RHS-00001.
 - THESE SIGNALS ARE SENT BACK TO THE FCS OVER AN ETHERNET COMMUNICATION LINK.

This document has been reviewed for ITAR/EAR and no ITAR/EAR sensitive information was found. 17 Dec 2013

This document has been reviewed for OPSEC material, and none was found. 17 Dec 2013

REFERENCE DRAWINGS

3759	07-RHS-052
3760	07-RHS-082
3761	07-RHS-083

NO.	DATE	DESCRIPTION	DR	CK	DL	PE	APVQ
1	09/26/12	I/C, INCORPORATED DCN-302, -417, -585, -659	GM	JDC	SA	KMR	
2	02/01/11	I/C, INCORP. DCN-163 THRU 166, 169, 170, 214, 218, 236	PEB	BAV	SA	BBB	BBB
3	03/26/10	I/C, DELETED "SOFT" NOTE 15	PEB	MDV	SA	BBB	BBB
4	08/11/09	I/C, INCORPORATED REVISED DESIGN REQUIREMENTS	JLL	PEB	BM	BBB	BBB
5	06/13/07	I/C, PASCO COMMENT INCORPORATED, TREND 157	IT	JLL	PEB	JB	BBB
6	10/25/06	ISSUED FOR DESIGN (IFD), ADD DESIGN DEVELOPMENT	RZ	JLL	PEB	JB	BBB

BECHTEL PARSONS BLUE GRASS	DOD PROGRAM MANAGER FOR ASSEMBLED CHEMICAL WEAPONS ASSESSMENT EDGEWOOD, MARYLAND	US ARMY ENGINEERING AND SUPPORT CENTER, HUNTSVILLE HUNTSVILLE, ALABAMA
---	--	--

BLUE GRASS CHEMICAL AGENT DESTRUCTION PILOT PLANT PROJECT (BCAPP)
RICHMOND, KENTUCKY
DAAA09-03-D-0023

MUNITIONS DEMILITARIZATION BUILDING RCM CUTTER & TABLE ASSEMBLY LN-1 PIPING & INSTRUMENT DIAGRAM

DRAWING NUMBER: 24915-07-M6-RHS-00081 SHEET: 1 OF 1 REV: 5



07MHS0081.dwg 09/26/12
DESIGN FILE: DONSPEC
PLOTTED BY: USER ON DATE: 9/26/12 4:57:43 PM

MX-RHS-0113 NOTE 12
 RCM CUTTER & TABLE ASSEMBLY LN-1 MODULE
 MJ-RHS-0145 RCM CUTTER TABLE CONVEYOR LN-1 MOTOR HP B : 0.25 HP, DC
 MJ-RHS-0146 RCM SFT REMOVAL ASSEMBLY LN-1 MOTOR HP : 1.3 KW SERVO


- GENERAL NOTES:
- FOR SYMBOLS AND LEGEND, SEE DRAWINGS 24915-00-M6-00-00010 THRU 00015.
 - DRAWING NUMBERS IN OFF-PAGE CONNECTORS ARE TRUNCATED BY SUPPRESSING PROJECT NUMBER "24915" AND DOCUMENTS TYPE "M6". TWO LEADING ZEROS IN SEQUENCE NUMBER ARE NOT SHOWN.
 - ALL EQUIPMENT NUMBERS, INSTRUMENT TAG NUMBERS AND VALVE NUMBERS ARE PREFIXED "07" UNLESS OTHERWISE NOTED.
 - DELETED.
 - UNLESS OTHERWISE NOTED, FCS INTERLOCK NUMBERS ARE PREFIXED WITH "07-RHS-" AND FPS (OR Z) INTERLOCKS ARE PREFIXED WITH "07-FPS-".
 - SFT REMOVAL GRIPPER TRAVEL POSITION:

POSITION	GRIPPER	SWITCH
A: BASE POSITION	OPEN	ZS-6938A--
B: SFT GRIPPING POSITION FOR SFT REMOVAL	CLOSE	ZS-6939A--
C: SFT REMOVED FROM WARHEAD	OPEN	ZS-6938A--
D: NO SFT/WARHEAD CUTTING GUIDE	CLOSE	ZS-6940A--

- SFT REMOVAL POSITION AND GRIPPER OPERATION TO BE INTERLOCKED.
- ON HIGH TORQUE FROM THE SFT REMOVAL ASSEMBLY SERVO MOTOR THE GRIPPER FINGERS WILL BE OPENED AND THE SFT REMOVAL ASSEMBLY WILL BE STOPPED.
 - LINES, EQUIPMENT AND FIELD INSTRUMENTS INSIDE DASHED LINES ARE DESIGNED AND FABRICATED BY PASCO.
 - RCM CUTTER TABLE CONVEYOR LN-1 MOTOR "B" SHALL BE INTERLOCKED WITH ROTATING SERVO ENCODER POSITION TO PREVENT ITS MOTOR TO RUN IN FORWARD DIRECTION.
 - DELETED.
 - DELETED.
 - MJ-RHS-0145 AND MJ-RHS-0146 AND ALL ASSOCIATED INSTRUMENTS, MOTOR AND COMPONENTS ARE "0".
 - ONE PANEL MOUNT EMERGENCY STOP PUSH BUTTON AND ONE REMOTE HANDHELD CONTROL WITH LMBILICAL CABLE ARE INSTALLED AT FIELD JUNCTION BOX EJ-FCS-1B-6214.
 - FOR A LIST OF ALL FCS AND SERVO SOFT TAGS REFER TO DOCUMENT 24915-07-J0-RHS-00010.

This document has been reviewed for ITAR/EAR and no ITAR/EAR sensitive information was found. 17 Dec 2013

This document has been reviewed for OPSEC material, and none was found. 17 Dec 2013

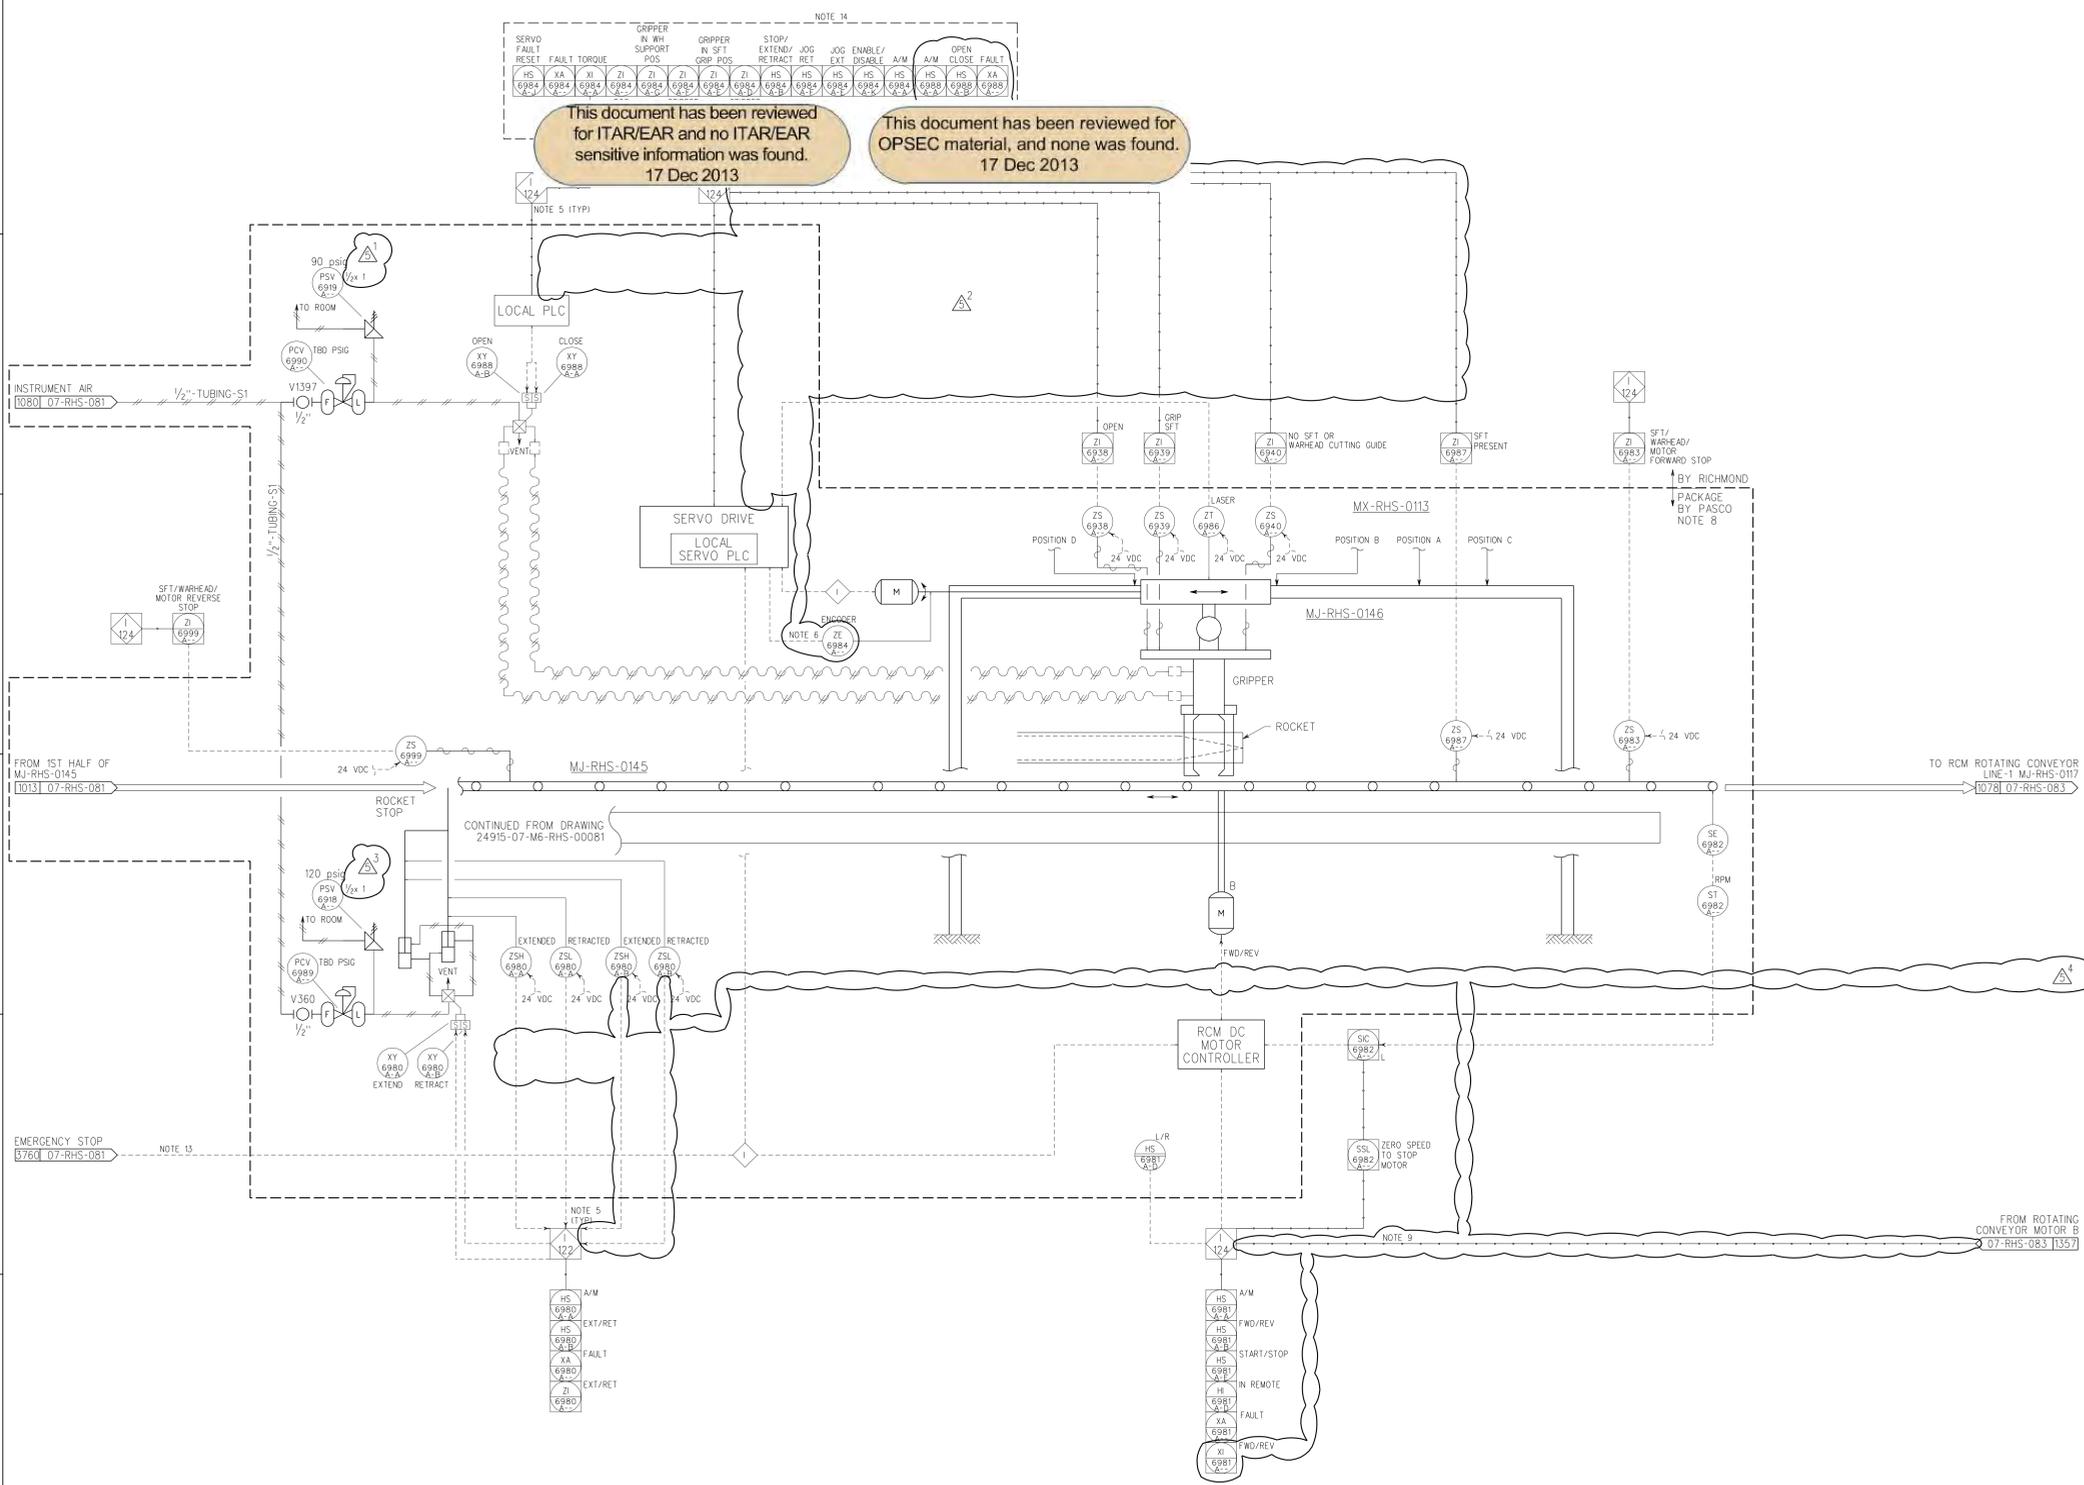

NO.	DATE	DESCRIPTION	DR	CK	DL	PE	APVD

09/26/12	IFC, INCORPORATED DCN-302-417	GM	JDC	SA	KMR	KMR
12/21/10	IFC, INCORPORATED DCN-163, 166 THRU 170, 214, 218	PEB	MDV	SA	BBB	BBB
03/26/10	IFC, DELETED "SOFT" NOTE 11	PEB	MDV	SA	BBB	BBB
08/11/09	IFC, INCORPORATED REVISED DESIGN REQUIREMENTS	JLL	PEB	BM	BBB	BBB
06/13/07	IFC, PASCO COMMENTS INCORPORATED, TREND 157	IT	JLL	PEB	JB	BBB
10/25/06	ISSUED FOR DESIGN (IFD), ADD DESIGN DEVELOPMENT	RZ	JLL	PEB	JB	BBB

QUALITY Non-0

BECHTEL PARSONS
 BLUE GRASS CHEMICAL AGENT DESTRUCTION PILOT PLANT PROJECT (BCAPP)
 RICHMOND, KENTUCKY
 DAAA09-03-D-0023

US ARMY ENGINEERING AND SUPPORT CENTER, HUNTSVILLE, ALABAMA

MUNITIONS DEMILITARIZATION BUILDING
 RCM SFT REMOVAL ASSEMBLY LN-1
 PIPING & INSTRUMENT DIAGRAM

DRAWING NUMBER: 24915-07-M6-RHS-00082
 SHEET: 1 OF 1
 REV: 5

DRAWING CONTAINS PE SEAL ORIGINAL ON FILE
 PROFESSIONAL STAMP


07MRHS002.dwg 09/26/12
 DESIGN FILE: DONSPEC
 PLOTTED BY: USER ON DATE: 9/26/12 4:58:22 PM

MJ-RHS-0117
RCM ROTATING CONVEYOR LN-1
MOTOR HP (A) : 0.25 HP DC
MOTOR HP (B) : 4 KW SERVO
MOTOR HP (C) : 0.25 HP DC

This document has been reviewed for ITAR/EAR and no ITAR/EAR sensitive information was found. 17 Dec 2013

This document has been reviewed for OPSEC material, and none was found. 17 Dec 2013

- GENERAL NOTES:
- FOR SYMBOLS AND LEGEND, SEE DRAWINGS 24915-00-M6-00-00010 THRU 00015.
 - DRAWING NUMBERS IN OFF-PAGE CONNECTORS ARE TRUNCATED BY SUPPRESSING PROJECT NUMBER "24915" AND DOCUMENTS TYPE "M6". TWO LEADING ZEROS IN SEQUENCE NUMBER ARE NOT SHOWN.
 - ALL EQUIPMENT NUMBERS, INSTRUMENT TAG NUMBERS AND VALVE NUMBERS ARE PREFIXED "07" UNLESS OTHERWISE NOTED.
 - FOR CONVEYOR LAYOUT/LOCATION SEE MATERIALS HANDLING EQUIPMENT GENERAL ARRANGEMENT DRAWING 24915-07-MJ-00-00002.
 - DELETED.
 - DELETED.
 - CONVEYOR MOTOR AND TURNABLE MOTOR SHALL BE HARDWIRE INTERLOCKED TO PREVENT SIMULTANEOUS OPERATION.
 - DELETED.
 - A FLOOR MOUNTED HARD STOP SHALL BE PROVIDED ON THE WEST END OF TURNABLE.
 - ROTATING CONVEYOR MOTOR SHALL BE INTERLOCKED WITH ROTATING SERVO ENCODER POSITION ON RCM ROTATING CONVEYOR (PKID 24915-07-M6-RHS-00083) AND ZS 0992A-- TO PREVENT ITS MOTOR FROM RUNNING WHILE RCM ROTATING CONVEYOR LN-1 IS NEITHER AT EAST-WEST NOR NORTH-SOUTH ALIGNMENT.
 - UNLESS OTHERWISE NOTED, FCS INTERLOCK NUMBERS ARE PREFIXED WITH "07-RHS-" AND FPS (OR Z) INTERLOCKS ARE PREFIXED WITH "07-FPS-".
 - EQUIPMENT AND FIELD INSTRUMENTS INSIDE DASHED LINES ARE DESIGNED AND FABRICATED BY PASCO.
 - MECHANICAL STOPPERS FOR -5 AND 95 DEGREE POSITION.
 - RCM ROTATING CONVEYOR SHALL NOT RUN IF ROTATING CONVEYOR IS NOT LOCATED AT 0 OR 90 DEGREE POSITION.
 - ROTATING CONVEYOR OVER TRAVEL PROTECTION.
 - DURING THE ROCKET LEAKER CAMPAIGN, OPERATOR TO LOAD LEAKER ROCKET ON THE LEAKER ROCKET ORIENTATION FEED TABLE TO CONFIRM THE CORRECT ORIENTATION (WARHEAD @ FORWARD POSITION), AND LOADED ON THE ROTATING CONVEYOR. THE LEAKER ROCKET ORIENTATION FEED TABLE WILL BE INSTALLED AT LINE-1 ROTATING CONVEYOR DURING LEAKER OPERATION ONLY.
 - SENSOR ZS-0992A-- IS LOCATED AT CONVEYOR MJ-RHS-0132 TO DETECT ROTATING CONVEYOR AT EAST-WEST ORIENTATION (BY PASADENA).
 - DELETED.
 - DELETED.
 - DELETED.
 - ONE PANEL MOUNT EMERGENCY STOP PUSH BUTTON AND ONE REMOTE HANDHELD CONTROL WITH UMBILICAL CABLE ARE INSTALLED AT FIELD JUNCTION BOX EJ-FCS-TBF-6214.
 - ROCKET CUTTING MACHINE SHALL INCLUDE A GUARD WHICH LOCATES THE SHIPPING AND FIRING TUBE INDEXING RING TO PREVENT OPERATORS FROM MANUALLY LOADING A ROCKET IN THE WRONG ORIENTATION.
 - THE ROTATING CONVEYOR ROLLERS ARE OPERATED BY TWO INDEPENDENT DC MOTORS. THE FRONT PORTION OF THE ROLLERS ARE CONTROLLED BY MOTOR A AND THE BACK ROLLERS ARE CONTROLLED BY MOTOR C. THE ROTATION OF THE CONVEYOR IS CONTROLLED BY SERVO MOTOR B.
 - FOR A LIST OF ALL FCS AND SERVO SOFT TAGS REFER TO DOCUMENT 24915-07-JQ-RHS-00001.

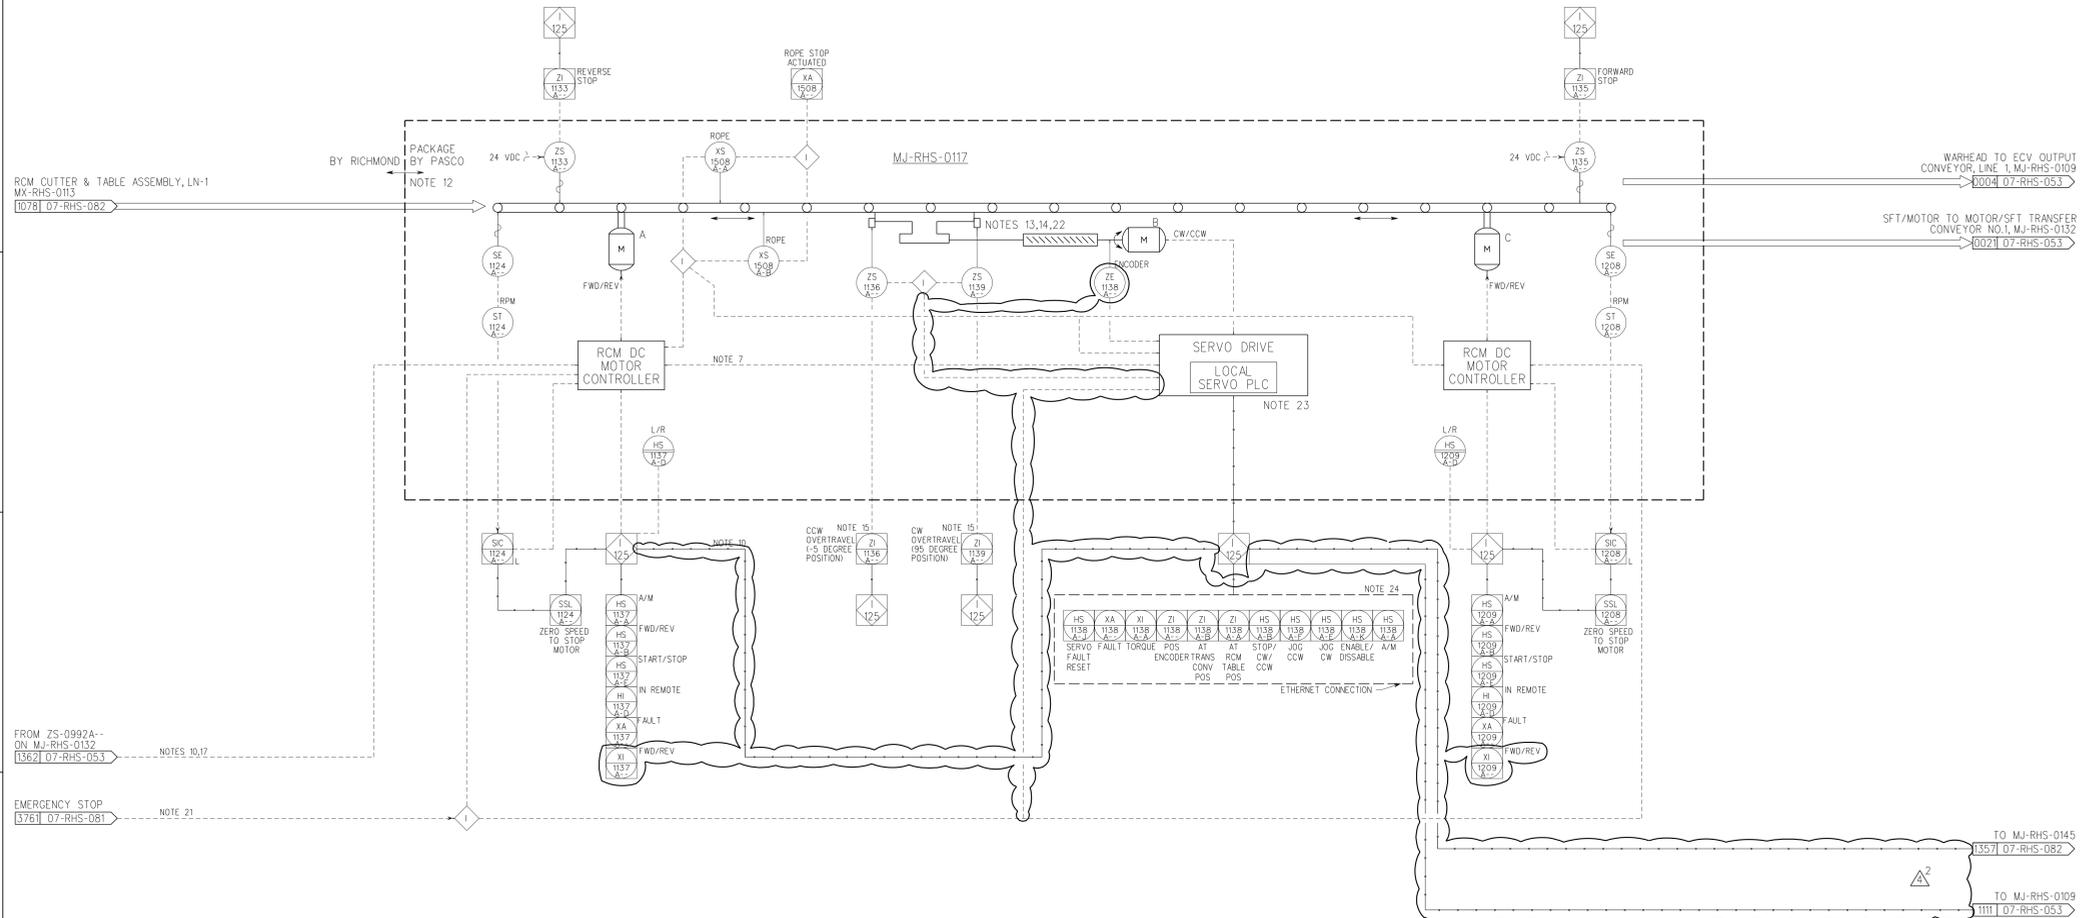

NO.	DATE	DESCRIPTION	DR	CK	DL	PE	APVD

NO.	DATE	DESCRIPTION	DR	CK	DL	PE	APVD
23	09/26/12	IFC, INCORPORATED DCN-302, -417	GM	JDC	SA	KMR	KMR
24	12/21/10	IFC, INCORPORATED DCN-163, -166, -167, -170, -214	PEB	MDV	SA	BBB	BBB
25	03/26/10	IFC, HTL-1055, ADDED PASCO COMMENTS FOR E-STOPS	PEB	MDV	SA	BBB	BBB
26	06/13/07	IFC, PASCO COMMENTS INCORPORATED, TREND 157	IT	JLL	PEB	JB	BBB
27	10/25/06	ISSUED FOR DESIGN (IFD), ADD DESIGN DEVELOPMENT	RZ	JLL	PEB	JB	BBB

BECHTEL PARSONS BLUE GRASS
DOD PROGRAM MANAGER FOR ASSEMBLED CHEMICAL WEAPONS ASSESSMENT EDgewood, MARYLAND
US ARMY ENGINEERING AND SUPPORT CENTER, HUNTSVILLE HUNTSVILLE, ALABAMA


BLUE GRASS CHEMICAL AGENT DESTRUCTION PILOT PLANT PROJECT (BCAPP)
RICHMOND, KENTUCKY
DAAA09-03-D-0023

MUNITIONS DEMILITARIZATION BUILDING
RCM ROTATING CONVEYOR LN-1
PIPING & INSTRUMENT DIAGRAM

DRAWING NUMBER: 24915-07-M6-RHS-00083
SHEET: 1 OF 1
REV: 4



07MRHS083.plt 09/26/12 DESIGN FILE: DONSPEC PLOTTED BY: USER ON DATE: 9/26/2012 4:59:07 PM

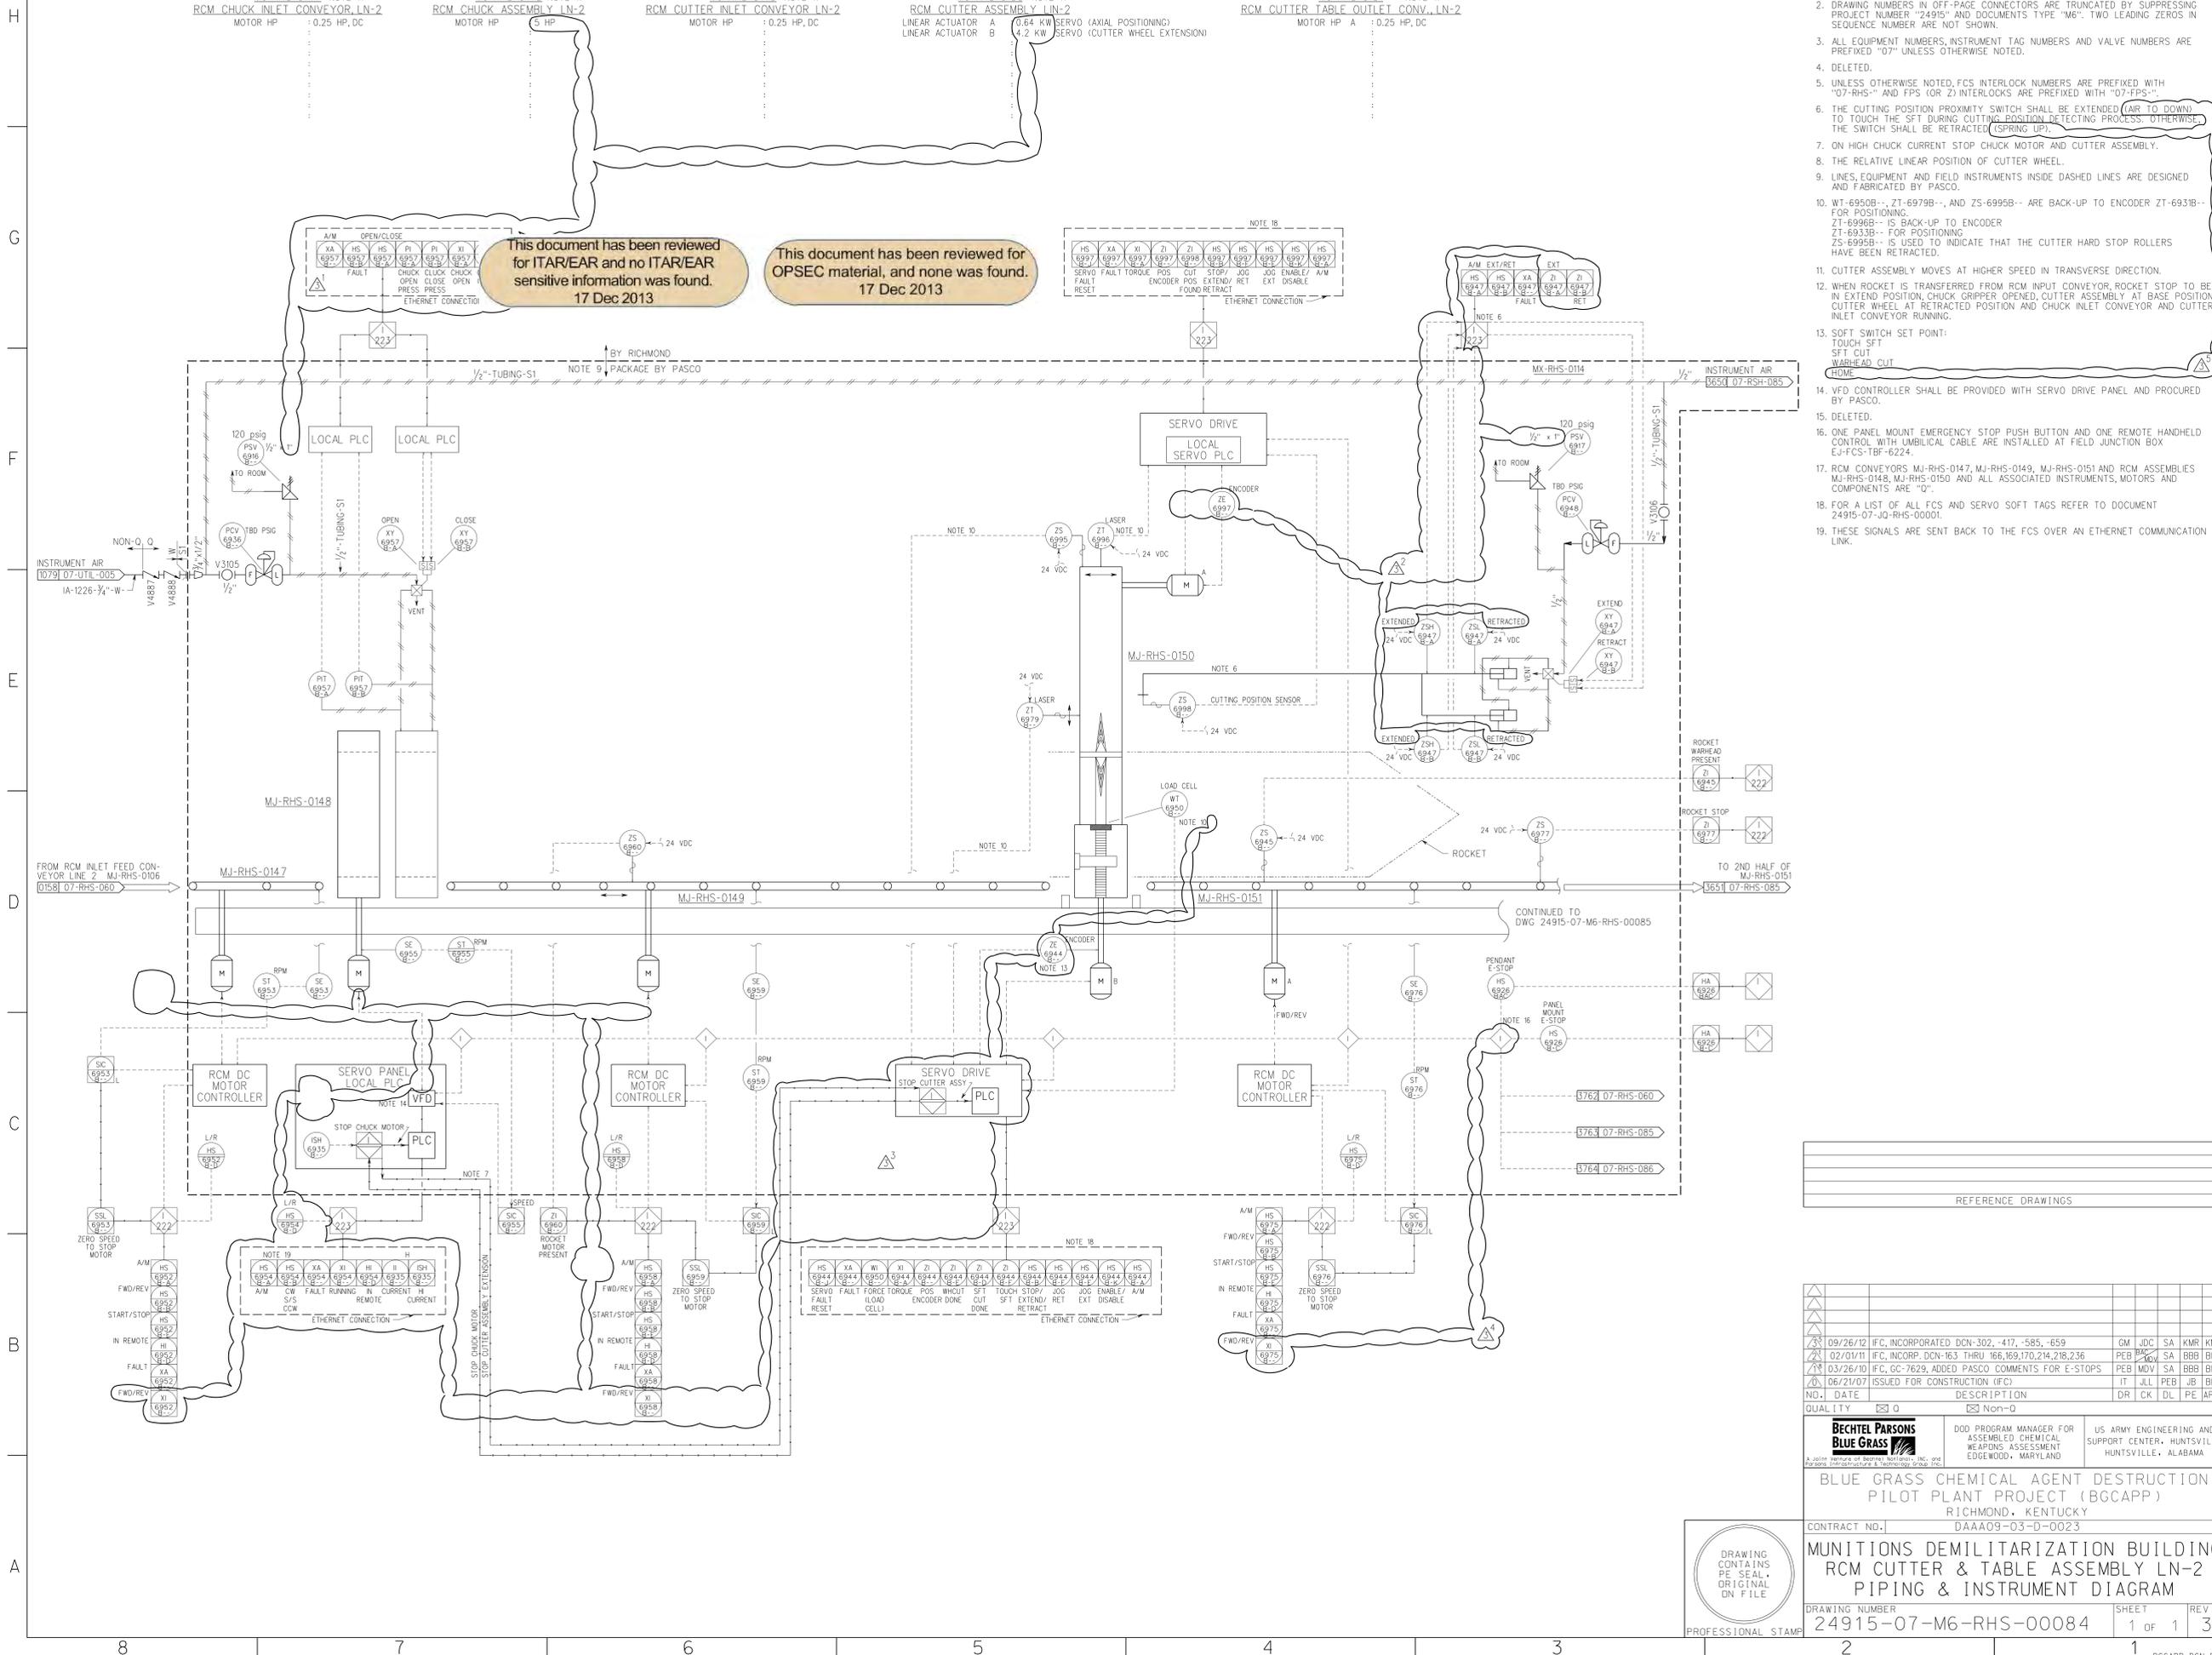

- GENERAL NOTES:
- FOR SYMBOLS AND LEGEND, SEE DRAWINGS 24915-00-M6-00-00010 THRU 00015.
 - DRAWING NUMBERS IN OFF-PAGE CONNECTORS ARE TRUNCATED BY SUPPRESSING PROJECT NUMBER "24915" AND DOCUMENTS TYPE "M6". TWO LEADING ZEROS IN SEQUENCE NUMBER ARE NOT SHOWN.
 - ALL EQUIPMENT NUMBERS, INSTRUMENT TAG NUMBERS AND VALVE NUMBERS ARE PREFIXED "07" UNLESS OTHERWISE NOTED.
 - DELETED.
 - UNLESS OTHERWISE NOTED, FCS INTERLOCK NUMBERS ARE PREFIXED WITH "07-RHS--" AND FPS (OR Z) INTERLOCKS ARE PREFIXED WITH "07-FPS--".
 - THE CUTTING POSITION PROXIMITY SWITCH SHALL BE EXTENDED (AIR TO DOWN) TO TOUCH THE SFT DURING CUTTING POSITION DETECTING PROCESS. OTHERWISE, THE SWITCH SHALL BE RETRACTED (SPRING UP).
 - ON HIGH CHUCK CURRENT STOP CHUCK MOTOR AND CUTTER ASSEMBLY.
 - THE RELATIVE LINEAR POSITION OF CUTTER WHEEL.
 - LINE, EQUIPMENT AND FIELD INSTRUMENTS INSIDE DASHED LINES ARE DESIGNED AND FABRICATED BY PASCO.
 - WT-6950B--, Z1-6979B--, AND Z5-6995B-- ARE BACK-UP TO ENCODER Z1-6931B-- FOR POSITIONING. Z1-6996B-- IS BACK-UP TO ENCODER Z1-6933B-- FOR POSITIONING. Z5-6995B-- IS USED TO INDICATE THAT THE CUTTER HARD STOP ROLLERS HAVE BEEN RETRACTED.
 - CUTTER ASSEMBLY MOVES AT HIGHER SPEED IN TRANSVERSE DIRECTION.
 - WHEN ROCKET IS TRANSFERRED FROM RCM INPUT CONVEYOR ROCKET STOP TO BE IN EXTEND POSITION, CHUCK GRIPPER OPENED, CUTTER ASSEMBLY AT BASE POSITION, CUTTER WHEEL AT RETRACTED POSITION AND CHUCK INLET CONVEYOR AND CUTTER INLET CONVEYOR RUNNING.
 - SOFT SWITCH SET POINT: SFT CUT WARHEAD CUT HOME
 - VFD CONTROLLER SHALL BE PROVIDED WITH SERVO DRIVE PANEL AND PROCURED BY PASCO.
 - DELETED.
 - ONE PANEL MOUNT EMERGENCY STOP PUSH BUTTON AND ONE REMOTE HANDHELD CONTROL WITH UMBILICAL CABLE ARE INSTALLED AT FIELD JUNCTION BOX EJ-FCS-1BF-6224.
 - RCM CONVEYORS MJ-RHS-0147, MJ-RHS-0149, MJ-RHS-0151 AND RCM ASSEMBLIES MJ-RHS-0148, MJ-RHS-0150 AND ALL ASSOCIATED INSTRUMENTS, MOTORS AND COMPONENTS ARE "0".
 - FOR A LIST OF ALL FCS AND SERVO SOFT TAGS REFER TO DOCUMENT 24915-07-J0-RHS-00001.
 - THESE SIGNALS ARE SENT BACK TO THE FCS OVER AN ETHERNET COMMUNICATION LINK.

This document has been reviewed for ITAR/EAR and no ITAR/EAR sensitive information was found. 17 Dec 2013

This document has been reviewed for OPSEC material, and none was found. 17 Dec 2013

NO.	DATE	DESCRIPTION	DR	CK	DL	PE	APVD

09/26/12	IFC, INCORPORATED DCN-302, -417, -585, -659	GM	JDC	SA	KMR	KMR
02/01/11	IFC, INCORP. DCN-163 THRU 166, 169, 170, 214, 216, 236	PEB	SA	SA	BBB	BBB
03/26/10	IFC, GC-7629, ADDED PASCO COMMENTS FOR E-STOPS	PEB	MDV	SA	BBB	BBB
06/21/07	ISSUED FOR CONSTRUCTION (IFC)	IT	JLL	PEB	JB	BBB

QUALITY Non-0

BECHTEL PARSONS
BLUE GRASS

DOD PROGRAM MANAGER FOR WEAPONS ASSESSMENT EDgewood, MARYLAND

US ARMY ENGINEERING AND SUPPORT CENTER, HUNTSVILLE, ALABAMA

BLUE GRASS CHEMICAL AGENT DESTRUCTION PILOT PLANT PROJECT (BCAPP)
 RICHMOND, KENTUCKY
 DAAA09-03-D-0023

MUNITIONS DEMILITARIZATION BUILDING
 RCM CUTTER & TABLE ASSEMBLY LN-2
 PIPING & INSTRUMENT DIAGRAM

CONTRACT NO. | DRAWING NUMBER | SHEET | REV |
 24915-07-M6-RHS-00084 | 1 OF 1 | 3



07MHS004.rvt 09/26/12
 DESIGN FILE: DONSPENCER
 PLOTTED BY: USER ON DATE: 9/26/2012 4:59:53 PM

MX-RHS-014 NOTE 12
 RCM CUTTER & TABLE ASSEMBLY LN-2 MODULE
 MJ-RHS-0151 MJ-RHS-0152
 RCM CUTTER TABLE CONVEYOR LN-2 RCM SFT REMOVAL ASSEMBLY LN-2
 MOTOR HP B 0.25 HP, DC MOTOR HP 1.13 KW SERVO


- GENERAL NOTES:
- FOR SYMBOLS AND LEGEND, SEE DRAWINGS 24915-00-M6-00-00010 THRU 00015.
 - DRAWING NUMBERS IN OFF-PAGE CONNECTORS ARE TRUNCATED BY SUPPRESSING PROJECT NUMBER "24915" AND DOCUMENTS TYPE "M6". TWO LEADING ZEROS IN SEQUENCE NUMBER ARE NOT SHOWN.
 - ALL EQUIPMENT NUMBERS, INSTRUMENT TAG NUMBERS AND VALVE NUMBERS ARE PREFIXED "07" UNLESS OTHERWISE NOTED.
 - DELETED.
 - UNLESS OTHERWISE NOTED, FCS INTERLOCK NUMBERS ARE PREFIXED WITH "07-RHS-" AND FPS (OR Z) INTERLOCKS ARE PREFIXED WITH "07-FPS-".
 - SFT REMOVAL GRIPPER TRAVEL POSITION:

POSITION	GRIPPER	SWITCH
A: BASE POSITION	OPEN	ZS-6938B--
B: SFT GRIPPING POSITION FOR SFT REMOVAL	CLOSE	ZS-6939B--
C: SFT REMOVED FROM WARHEAD	OPEN	ZS-6938B--
D: NO SFT/WARHEAD CUTTING GUIDE	CLOSE	ZS-6940B--

- SFT REMOVAL POSITION AND GRIPPER OPERATION TO BE INTERLOCKED.
- ON HIGH TORQUE FROM THE SFT REMOVAL ASSEMBLY SERVO MOTOR THE GRIPPER FINGERS WILL BE OPENED AND THE SFT REMOVAL ASSEMBLY WILL BE STOPPED.
 - INES, EQUIPMENT AND FIELD INSTRUMENTS INSIDE DASHED LINES ARE DESIGNED AND FABRICATED BY PASCO.
 - RCM CUTTER TABLE CONVEYOR LN-2 MOTOR "B" SHALL BE INTERLOCKED WITH SERVO ENCODER POSITION TO PREVENT ITS MOTOR TO RUN IN FORWARD DIRECTION.
 - DELETED.
 - DELETED.
 - MJ-RHS-0151 AND MJ-RHS-0152 AND ALL ASSOCIATED INSTRUMENTS, MOTOR AND COMPONENTS ARE "0".
 - ONE PANEL MOUNT EMERGENCY STOP PUSH BUTTON AND ONE REMOTE HANDHELD CONTROL WITH UMBILICAL CABLE ARE INSTALLED AT FIELD JUNCTION BOX EJ-FCS-TBF-6224.
 - FOR A LIST OF ALL FCS AND SERVO SOFT TAGS REFER TO DOCUMENT 24915-07-JQ-RHS-00001.

This document has been reviewed for ITAR/EAR and no ITAR/EAR sensitive information was found. 17 Dec 2013

This document has been reviewed for OPSEC material, and none was found. 17 Dec 2013

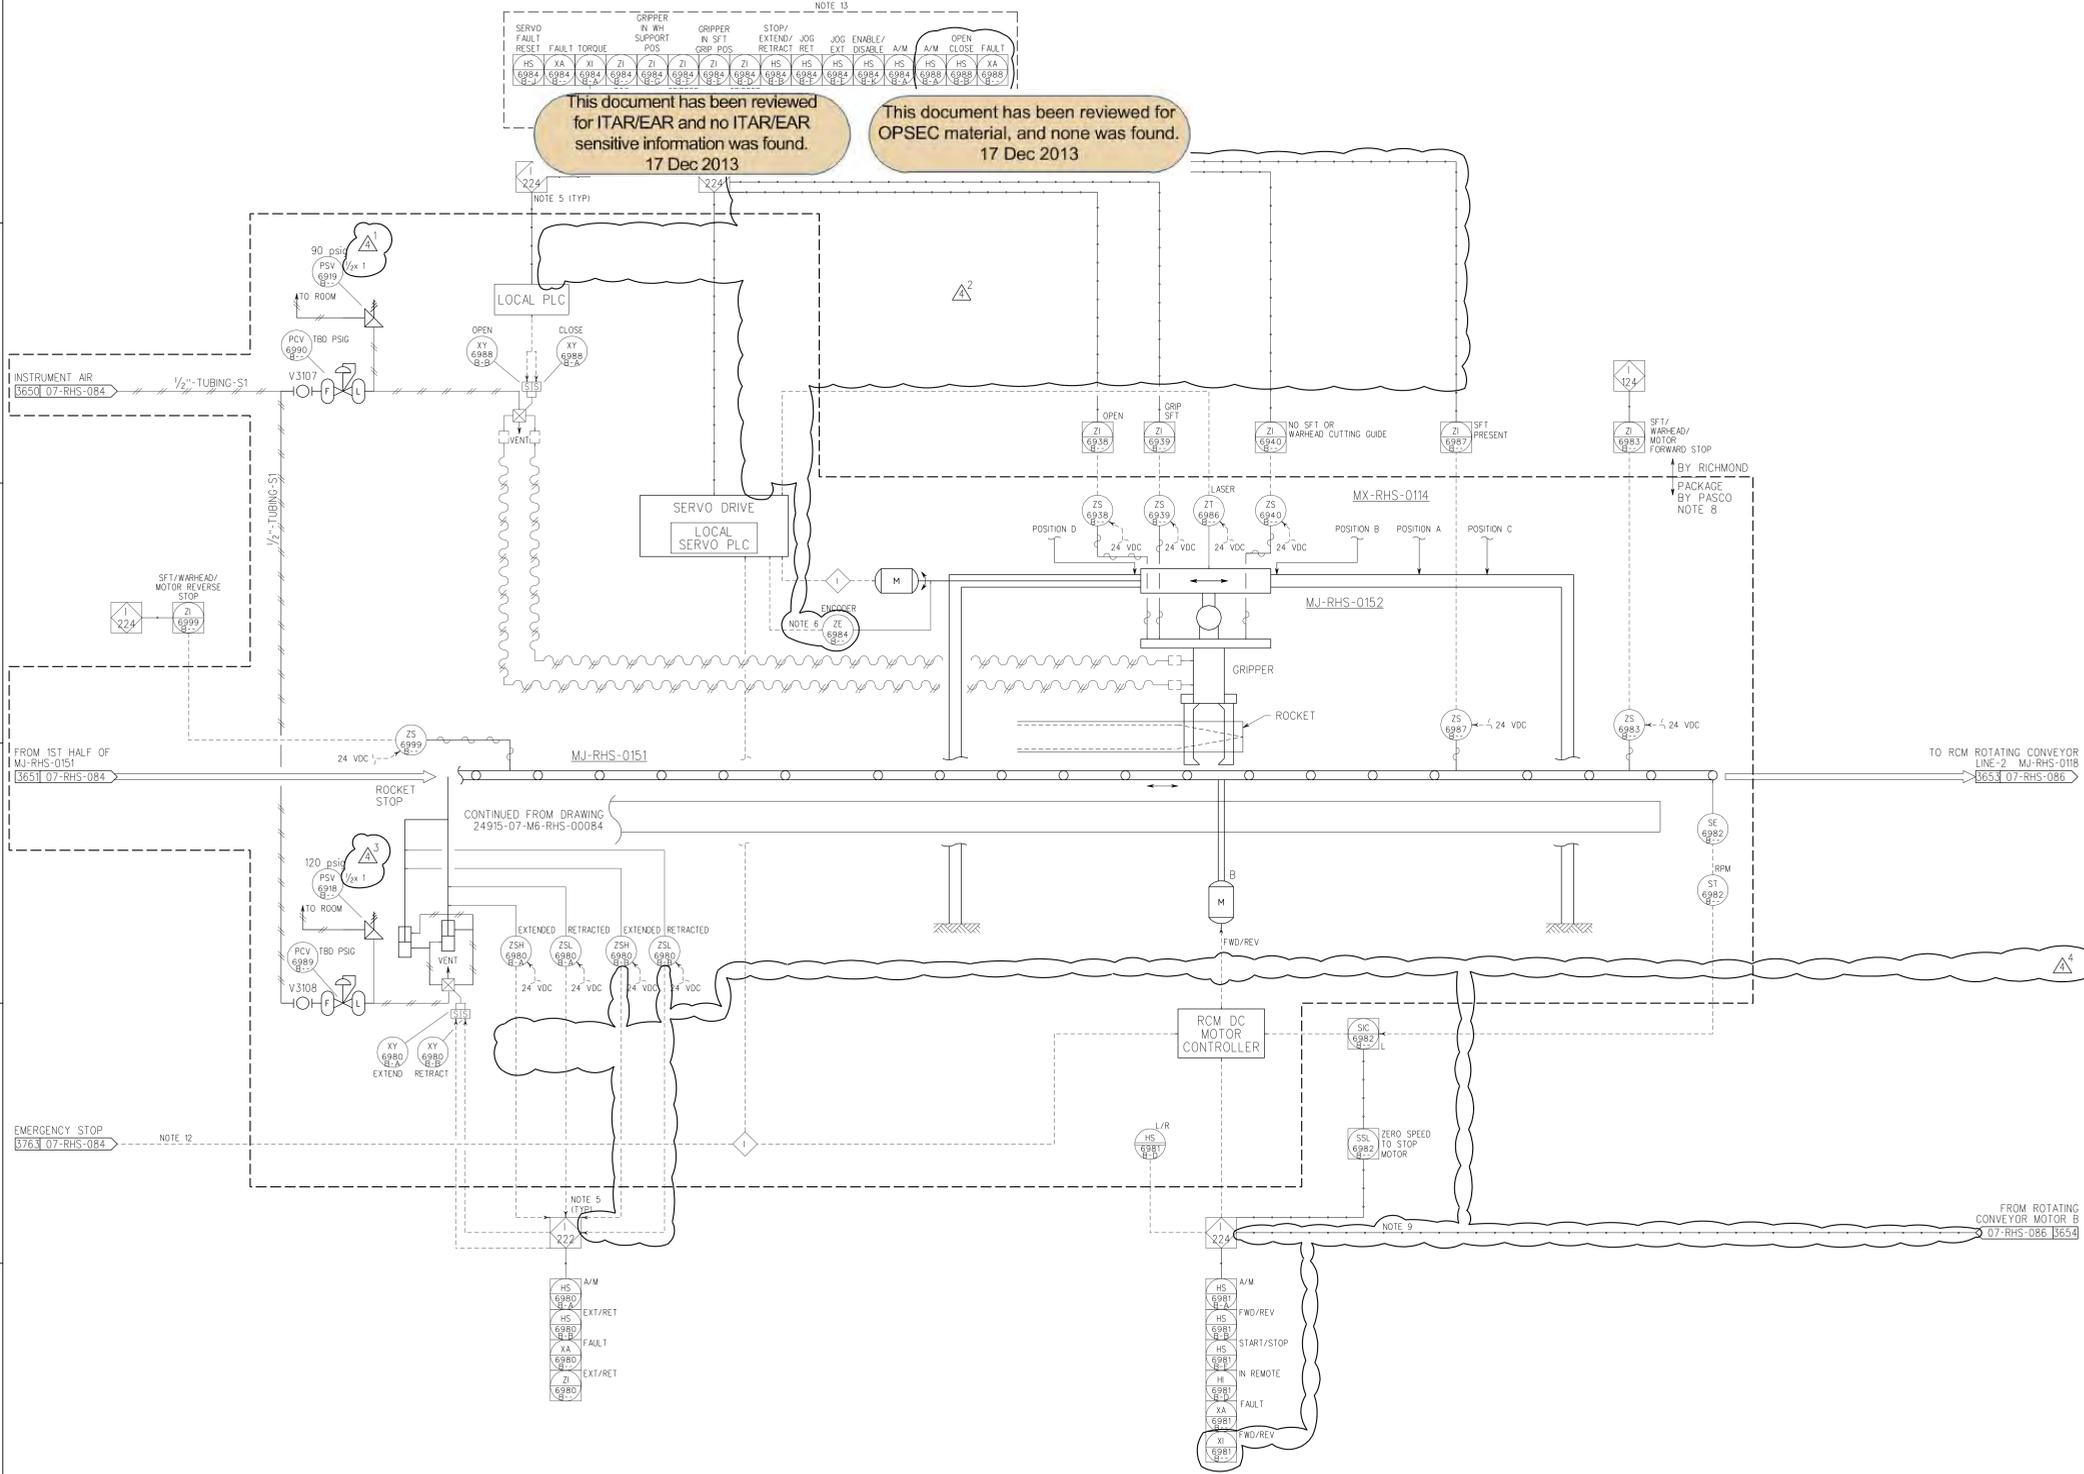

NO.	DATE	DESCRIPTION	DR	CK	DL	PE	APVD

NO.	DATE	DESCRIPTION	DR	CK	DL	PE	APVD
1	09/26/12	I/C, INCORPORATED DCN-302, -417	GM	JDC	SA	KMR	KMR
2	12/21/10	I/C, INCORPORATED DCN-163, 166 THRU 170, 214, 218	PEB	MDV	SA	BBB	BBB
3	03/26/10	I/C, DELETED "SOFT" NOTE 10	PEB	MDV	SA	BBB	BBB
4	08/11/09	I/C, GC 7629, ADDED REVISED DESIGN REQUIREMENTS	JLL	PEB	BM	BBB	BBB
5	06/21/07	ISSUED FOR CONSTRUCTION (I/C)	IT	JLL	PEB	JB	BBB

QUALITY Non-0

BECHTEL PARSONS
 A joint venture of Bechtel Corporation, Inc. and Parsons Infrastructure & Technology Group, Inc.

DOD PROGRAM MANAGER FOR ASSEMBLED CHEMICAL WEAPONS ASSESSMENT EDgewood, MARYLAND

US ARMY ENGINEERING AND SUPPORT CENTER, HUNTSVILLE, ALABAMA

BLUE GRASS CHEMICAL AGENT DESTRUCTION PILOT PLANT PROJECT (BCAPP)
 RICHMOND, KENTUCKY
 CONTRACT NO. DAAA09-03-D-0023

MUNITIONS DEMILITARIZATION BUILDING
 RCM SFT REMOVAL ASSEMBLY LN-2
 PIPING & INSTRUMENT DIAGRAM

DRAWING NUMBER 24915-07-M6-RHS-00085 SHEET 1 OF 1 REV 4




07MRHS0085.ppt 09/26/12
 DESIGN FILE: DONSPEC
 PLOTTED BY USER ON DATE 09/26/12

MJ-RHS-0118
RCM ROTATING CONVEYOR LN-2
MOTOR HP (A) : 0.25 HP DC
MOTOR HP (B) : 4 KW SERVO
MOTOR HP (C) : 0.25 HP DC

This document has been reviewed for ITAR/EAR and no ITAR/EAR sensitive information was found. 17 Dec 2013

This document has been reviewed for OPSEC material, and none was found. 17 Dec 2013

- GENERAL NOTES:
- FOR SYMBOLS AND LEGEND, SEE DRAWINGS 24915-00-M6-00-00010 THRU 00015.
 - DRAWING NUMBERS IN OFF-PAGE CONNECTORS ARE TRUNCATED BY SUPPRESSING PROJECT NUMBER "24915" AND DOCUMENTS TYPE "M6". TWO LEADING ZEROS IN SEQUENCE NUMBER ARE NOT SHOWN.
 - ALL EQUIPMENT NUMBERS, INSTRUMENT TAG NUMBERS AND VALVE NUMBERS ARE PREFIXED "07" UNLESS OTHERWISE NOTED.
 - FOR CONVEYOR LAYOUT/LOCATION SEE MATERIALS HANDLING EQUIPMENT GENERAL ARRANGEMENT DRAWING 24915-07-MJ-00-00002.
 - DELETED.
 - DELETED.
 - CONVEYOR MOTOR AND TURNABLE MOTOR SHALL BE HARDWIRE INTERLOCKED TO PREVENT SIMULTANEOUS OPERATION.
 - DELETED.
 - A FLOOR MOUNTED HARD STOP SHALL BE PROVIDED ON THE WEST END OF TURNABLE.
 - ROTATING CONVEYOR MOTOR SHALL BE INTERLOCKED WITH ROTATING SERVO ENCODER POSITION ON RCM ROTATING CONVEYOR (P&ID: 24915-07-M6-RHS-00085) AND ZS-0992B-- TO PREVENT ITS MOTOR FROM RUNNING WHILE RCM ROTATING CONVEYOR LN-2 IS NEITHER AT EAST-WEST NOR NORTH-SOUTH ALIGNMENT.
 - UNLESS OTHERWISE NOTED, FCS INTERLOCK NUMBERS ARE PREFIXED WITH "07-RHS-" AND FPS (OR Z) INTERLOCKS ARE PREFIXED WITH "07-FPS-".
 - EQUIPMENT AND FIELD INSTRUMENTS INSIDE DASHED LINES ARE DESIGNED AND FABRICATED BY PASCO.
 - MECHANICAL STOPPERS FOR -5 AND 95 DEGREE POSITION.
 - RCM ROTATING CONVEYOR SHALL NOT RUN IF ROTATING CONVEYOR IS NOT LOCATED AT 0 OR 90 DEGREE POSITION.
 - ROTATING CONVEYOR OVER TRAVEL PROTECTION.
 - DURING THE ROCKET LEAKER CAMPAIGN, OPERATOR TO LOAD LEAKER ROCKET ON THE LEAKER ROCKET ORIENTATION FEED TABLE TO CONFIRM THE CORRECT ORIENTATION (WARHEAD @ FORWARD POSITION), AND LOADED ON THE ROTATING CONVEYOR, THE LEAKER ROCKET ORIENTATION FEED TABLE WILL BE INSTALLED AT LINE-2 ROTATING CONVEYOR DURING LEAKER OPERATION ONLY.
 - SENSOR ZS-0992B-- IS LOCATED AT CONVEYOR MJ-RHS-0140 TO DETECT ROTATING CONVEYOR AT EAST-WEST ORIENTATION (BY PASADENA).
 - DELETED.
 - DELETED.
 - DELETED.
 - ONE PANEL MOUNT EMERGENCY STOP PUSH BUTTON AND ONE REMOTE HANDHELD CONTROL WITH UMBILICAL CABLE ARE INSTALLED AT FIELD JUNCTION BOX EJ-FCS-TBF-6224.
 - ROCKET CUTTING MACHINE SHALL INCLUDE A GUARD WHICH LOCATES THE SHIPPING AND FIRING TUBE INDEXING RING TO PREVENT OPERATORS FROM MANUALLY LOADING A ROCKET IN THE WRONG ORIENTATION.
 - THE ROTATING CONVEYOR ROLLERS ARE OPERATED BY TWO INDEPENDENT DC MOTORS. THE FRONT PORTION OF THE ROLLERS ARE CONTROLLED BY MOTOR A AND THE BACK ROLLERS ARE CONTROLLED BY MOTOR C. THE ROTATION OF THE CONVEYOR IS CONTROLLED BY SERVO MOTOR B.
 - FOR A LIST OF ALL FCS AND SERVO SOFT TAGS REFER TO DOCUMENT 24915-07-JQ-RHS-00001.

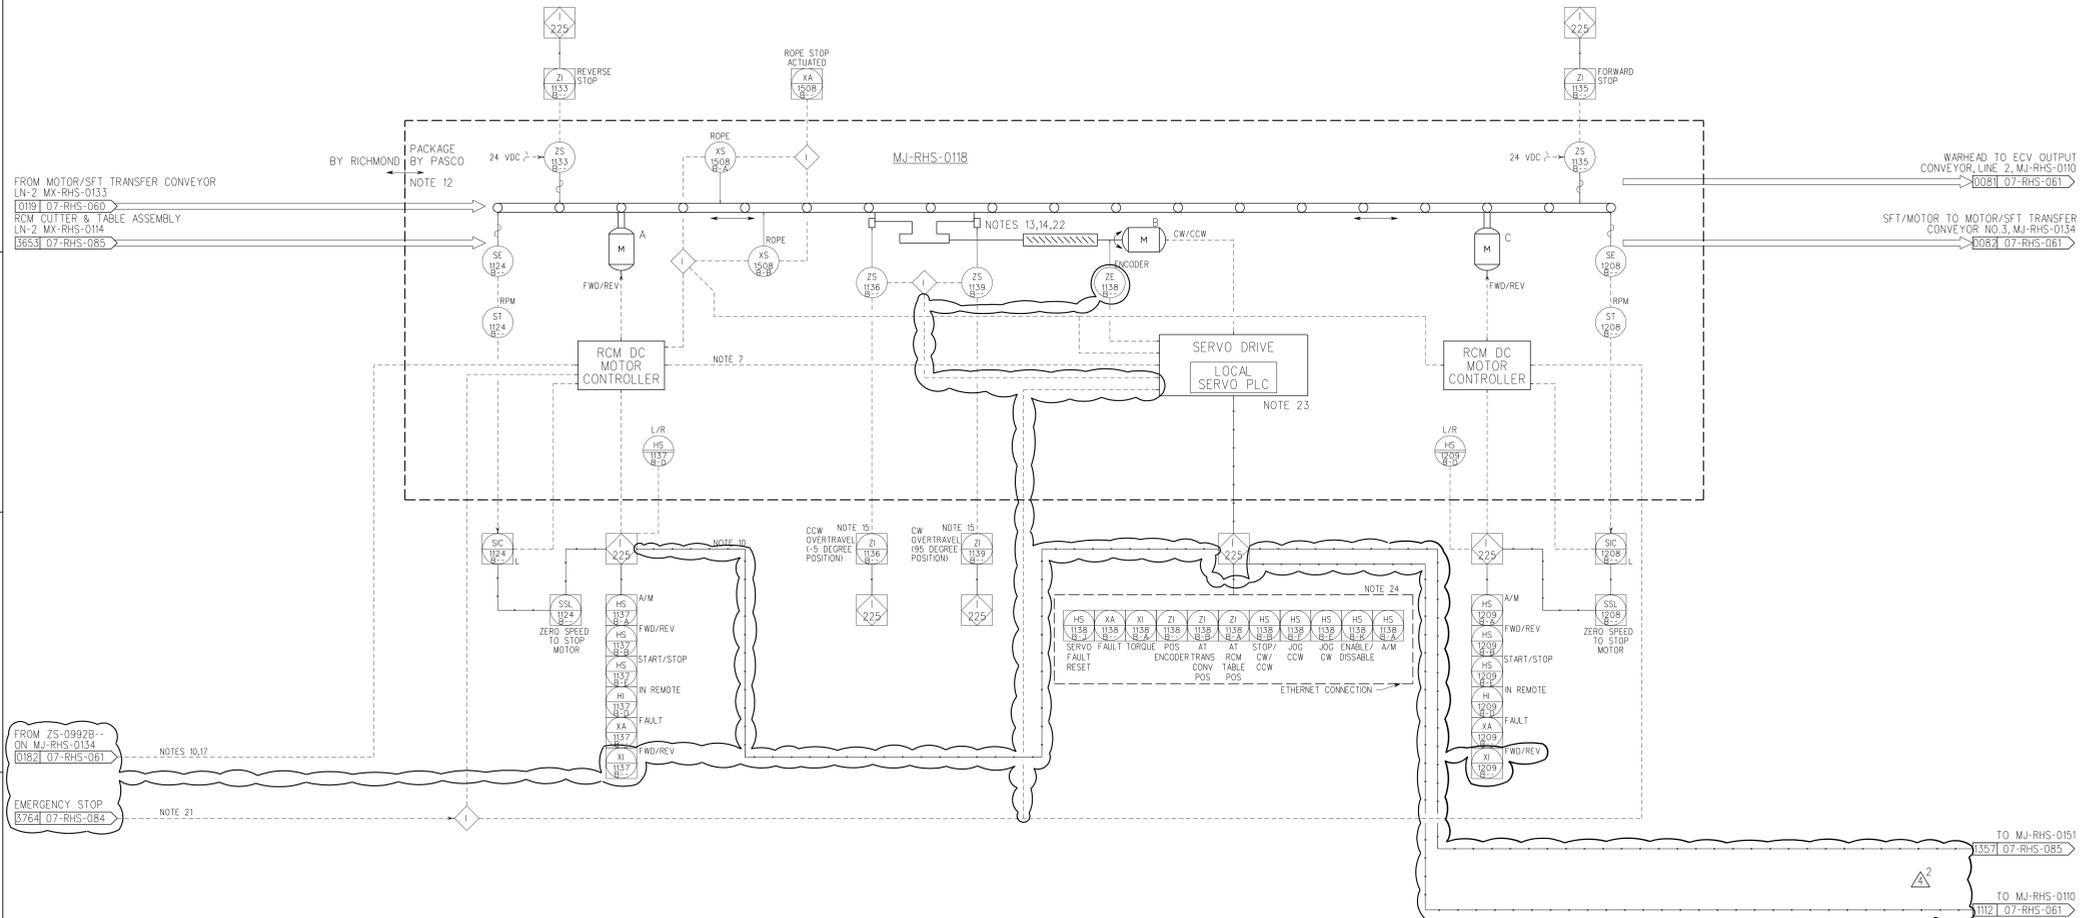

NO.	DATE	DESCRIPTION	DR	CK	DL	PE	APVD

NO.	DATE	DESCRIPTION	DR	CK	DL	PE	APVD
23	09/26/12	IFC, INCORPORATED DCN-302, -360, -417	GM	JDC	SA	KMR	KMR
22	12/21/10	IFC, INCORPORATED DCN-163, -166, -167, -170, -214	PEB	MDV	SA	BBB	BBB
21	03/26/10	IFC, DELETED "SOFT" NOTE 20	PEB	MDV	SA	BBB	BBB
20	08/11/09	IFC, HTL-1055, ADDED REVISED DESIGN REQUIREMENTS	JLL	PEB	BM	BBB	BBB
19	06/21/07	ISSUED FOR CONSTRUCTION (IFC)	IT	JLL	PEB	JB	BBB

BECHTEL PARSONS BLUE GRASS
DOD PROGRAM MANAGER FOR ASSEMBLED CHEMICAL WEAPONS ASSESSMENT EDgewood, MARYLAND
US ARMY ENGINEERING AND SUPPORT CENTER, HUNTSVILLE HUNTSVILLE, ALABAMA

BLUE GRASS CHEMICAL AGENT DESTRUCTION PILOT PLANT PROJECT (BCAPP)
RICHMOND, KENTUCKY
DAAA09-03-D-0023

MUNITIONS DEMILITARIZATION BUILDING
RCM ROTATING CONVEYOR LN-2
PIPING & INSTRUMENT DIAGRAM

DRAWING NUMBER: 24915-07-M6-RHS-00086
SHEET: 1 OF 1
REV: 4



07MRHS0086.plt 09/26/12
 DESIGN FILE: DONSPEC
 PLOTTED BY: USER ON DATE: 9/26/2012 5:01:45 PM



MX-ANS-011
AGENT HYDROLYSATE & SPENT DECON SAMPLER MODULE

MX-ANS-010
AGENT HYDROLYSATE & SPENT DECON GLOVE PORT MODULE

- GENERAL NOTES:
- FOR SYMBOLS AND LEGEND, SEE DRAWINGS 24915-00-M6-00-00010 THRU 00015.
 - DRAWING NUMBERS IN OFF-PAGE CONNECTORS ARE TRUNCATED BY SUPPRESSING PROJECT NUMBER "24915" AND DOCUMENTS TYPE "M6". TWO LEADING ZEROS IN SEQUENCE NUMBER ARE NOT SHOWN.
 - ALL EQUIPMENT NUMBERS, INSTRUMENT TAG NUMBERS AND VALVE NUMBERS ARE PREFIXED "07" UNLESS OTHERWISE NOTED.
 - DELETED.
 - DELETED.
 - DELETED.
 - DELETED.
 - DELETED.
 - ONE GLOVE PORT SAMPLER FOR ALL THREE OF THE SPENT DECON HOLDING TANKS.
 - LOCATE GLOVE PORTS NEAR THE BAG-IN BAG-OUT PORT SUCH THAT SAMPLES CAN BE READILY PLACED ONTO THE BAG-IN BAG-OUT PORT.
 - DELETED.
 - AGENT SAMPLING IS NOT REQUIRED WHEN AGENT WASHOUT IS STORED IN ANY OF THE TANKS MV-SDS-0101/0201/0301. REMOVABLE SPOOLS ARE INSTALLED ON THE SAMPLING LINES TO PROVIDE POSITIVE ISOLATION FROM THE SAMPLING UNIT WHEN AGENT WASHOUT IS BEING HANDLED AS SHOWN ON P&ID 24915-07-SDS-00004 & 5.
 - UNLESS OTHERWISE NOTED, FCS INTERLOCK NUMBERS ARE PREFIXED WITH "07-SDS-" AND FPS (OR Z) INTERLOCKS ARE PREFIXED WITH "07-FPS-".
 - LINES, EQUIPMENT AND FIELD INSTRUMENTS INSIDE DASHED LINES ARE PHYSICALLY LOCATED ON MODULE AND ARE DESIGNED, PROCURED AND FABRICATED BY PASCO.
 - DELETED.
 - DELETED.
 - THE FLUSHING OF THE INLET PORTION OF THE SAMPLE LINE REQUIRES THAT THE SOURCE PUMP MP-SDS-0102 A/B AND MP-SDS-0101 A/B BE SHUT OFF DURING THE FLUSHING PERIOD OF 15 MINUTES. FLUSHING OF THE DOWNSTREAM PORTION OF THE LINE CAN BE DONE WITH THE PUMP RUNNING.
 - QUICK CONNECTION, HOSE, NOZZLE, AND FITTINGS TO BE SPECIFIED AND PURCHASED BY OPERATIONS DURING SYSTEMIZATION.

This document has been reviewed for ITAR/EAR and no ITAR/EAR sensitive information was found. 17 Dec 2013

This document has been reviewed for OPSEC material, and none was found. 17 Dec 2013

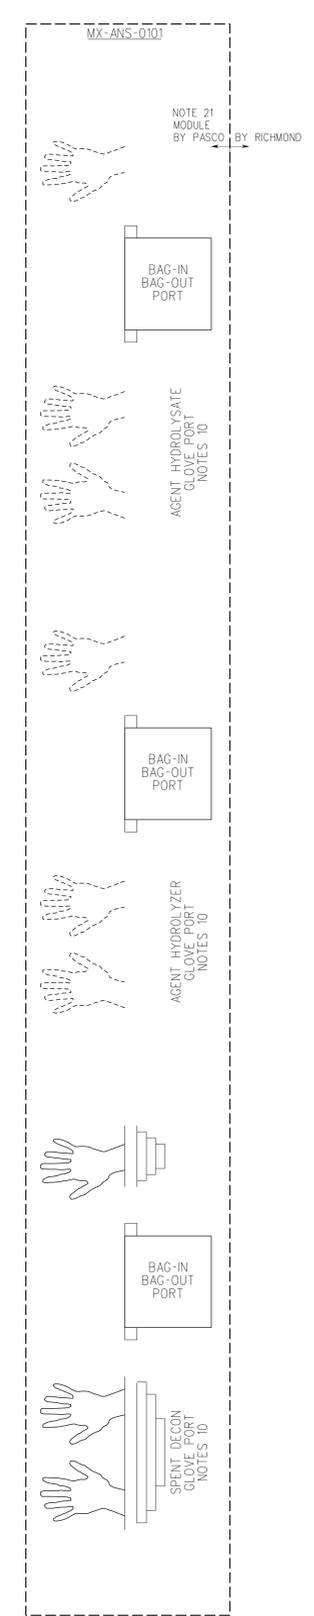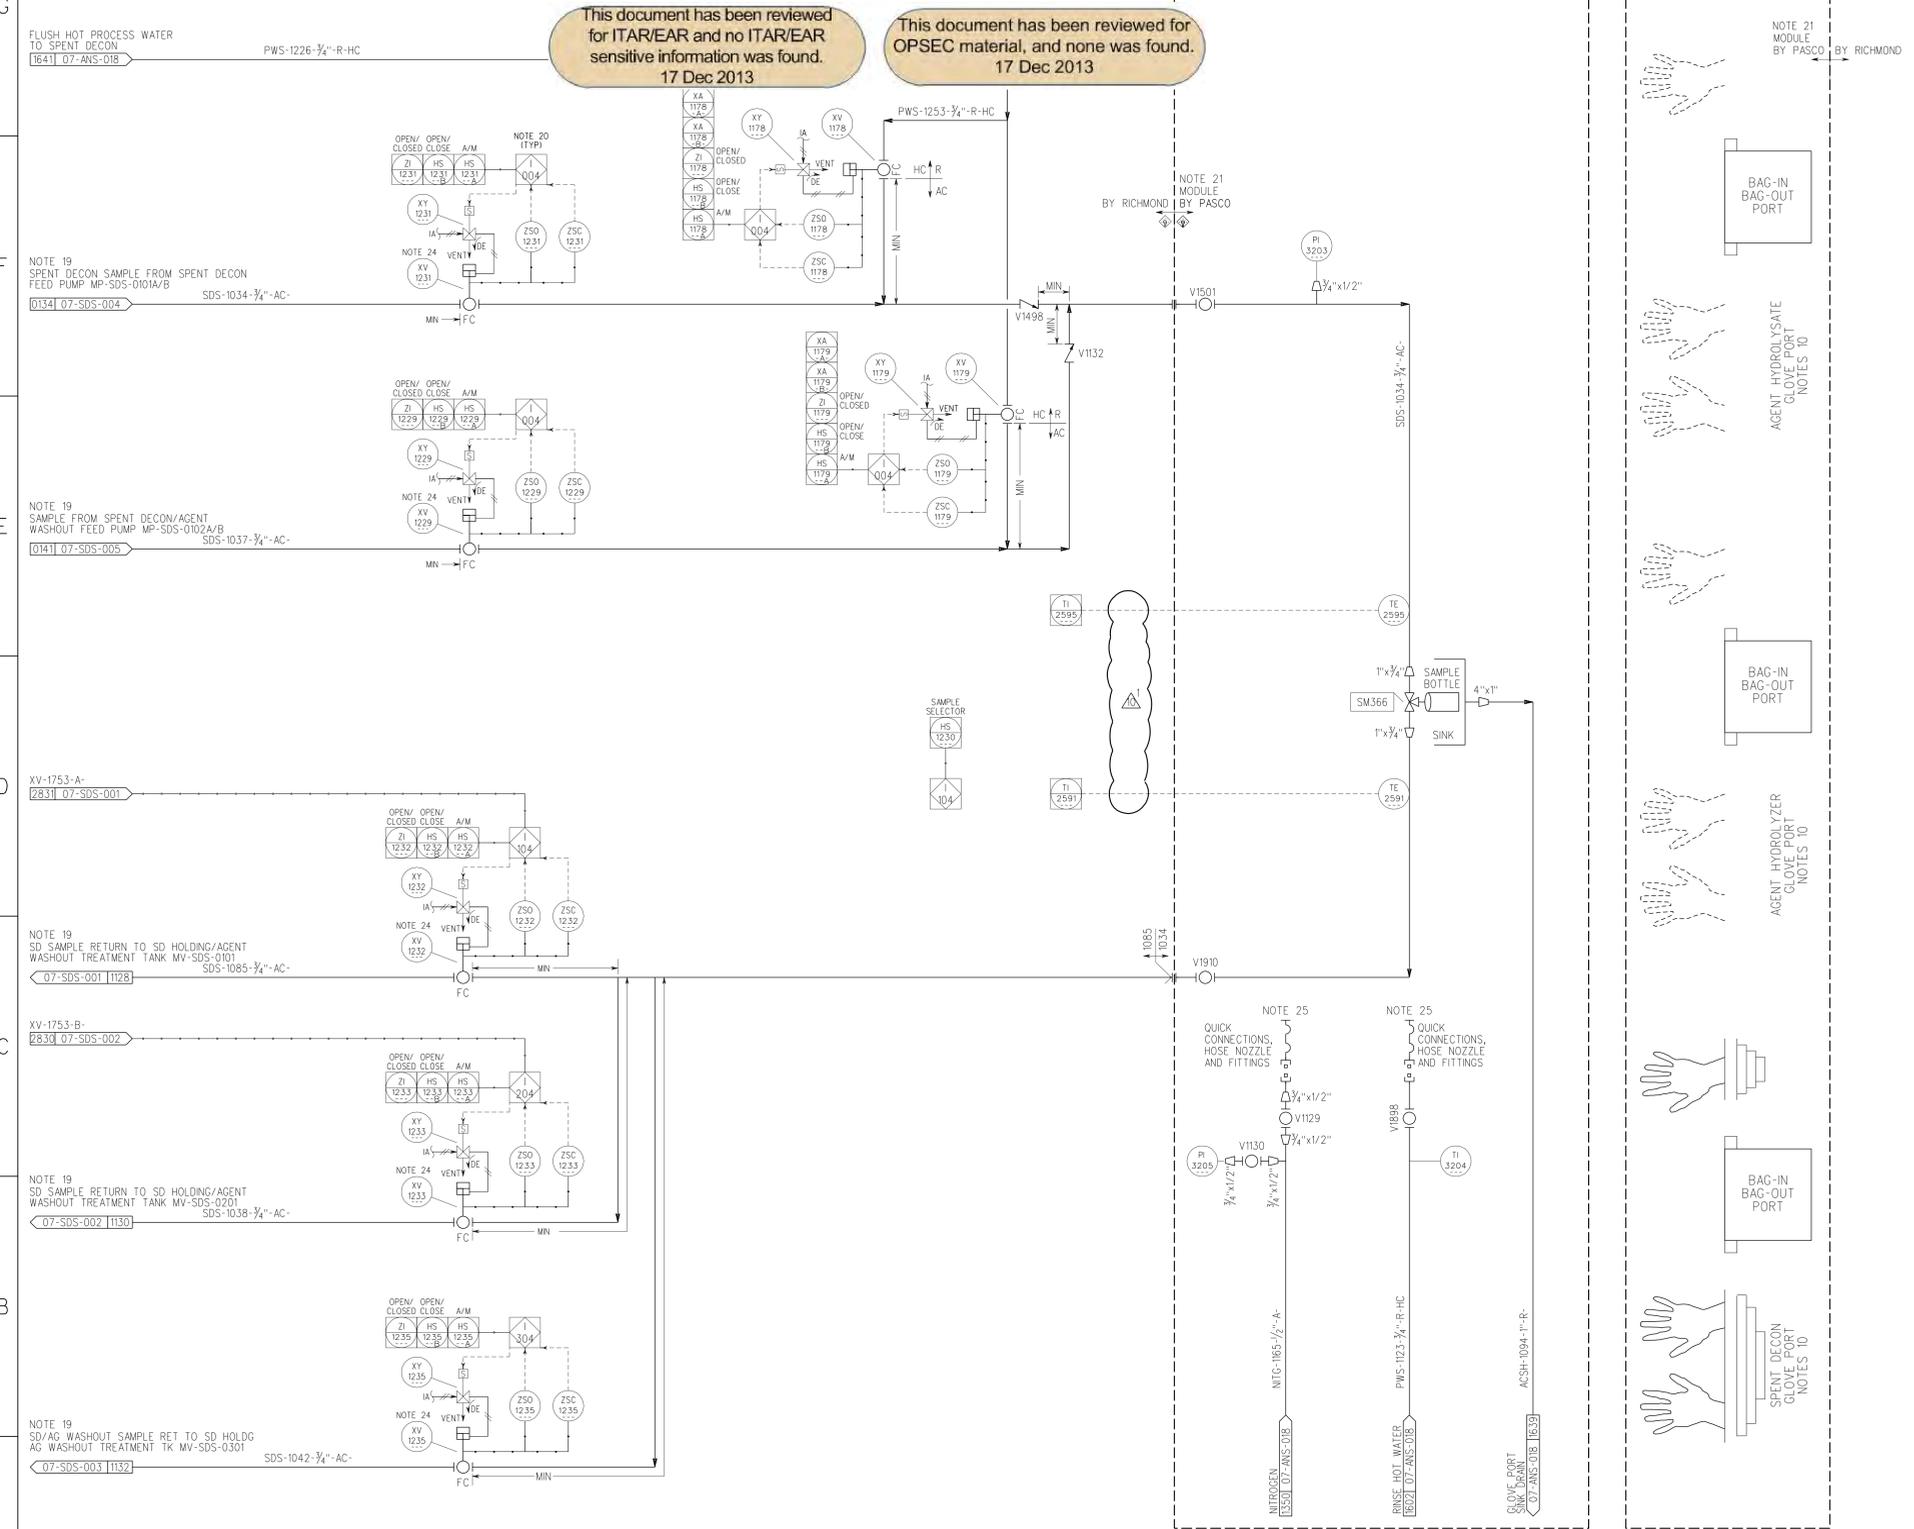

BASED ON BLUE GRASS PFD 24915-07-M6-ANS-00002 REV. B
BASED ON BLUE GRASS MSD 24915-07-NO-ANS-00002 REV. 5

REFERENCE DRAWINGS

NO.	DATE	DESCRIPTION	DR	CK	DL	PE	APVD
40	08/03/12	IFC, INCORPORATED DCN-394	SC	JOC	SA	KMR	KMR
39	04/21/11	IFC, INCORPORATED DCN-365	SA	PEB	SA	BBB	BBB
28	03/17/11	IFC, INCORPORATED DCN-248, -333, HTL-5452	SA	PEB	SA	BBB	BBB
7	06/08/09	IFC, ADDED PIPING AND INSTRUMENT COMMENTS	JLL	PEB	BM	BBB	BBB
6	05/29/07	IFC, ADD PIPING AND PASCO COMMENTS	SF	JLL	PEB	JB	BBB
5	02/07/07	ISSUED FOR DESIGN (IFD), ADD PASCO CHANGES	SF	JLL	PEB	JB	BBB
4	09/27/06	IFD, ADD GOV COMMENT, DESIGN DEVELOPMENT	SF	JLL	PEB	JB	BBB
3	05/03/06	ISSUED FOR DESIGN (IFD), ADD DESIGN DEVELOPMENT	SF	JLL	PEB	JB	BBB

QUALITY Non-0

BECHTEL PARSONS
BLUE GRASS

DOD PROGRAM MANAGER FOR ASSEMBLED CHEMICAL WEAPONS ASSESSMENT EDgewood, MARYLAND

US ARMY ENGINEERING AND SUPPORT CENTER, HUNTSVILLE, ALABAMA

BLUE GRASS CHEMICAL AGENT DESTRUCTION PILOT PLANT PROJECT (BCAPP)
RICHMOND, KENTUCKY
CONTRACT NO. DAAA09-03-D-0023


MUNITIONS DEMILITARIZATION BUILDING
SPENT DECON SAMPLER
PIPING & INSTRUMENT DIAGRAM

DRAWING NUMBER 24915-07-M6-SDS-00010 SHEET 1 OF 1 REV 10



07MS25010.dwg 08/08/12
DESIGN FILE: DONSPEC
PLOTTED BY: USER ON DATE: 8/8/2012 12:00:54 PM

- GENERAL NOTES:
- FOR SYMBOLS AND LEGEND, SEE DRAWINGS 24915-00-M6-00-00010 THRU 00015.
 - DRAWING NUMBERS IN OFF-PAGE CONNECTORS ARE TRUNCATED BY SUPPRESSING PROJECT NUMBER "24915" AND DOCUMENTS TYPE "M6". TWO LEADING ZEROS IN SEQUENCE NUMBER ARE NOT SHOWN.
 - ALL EQUIPMENT NUMBERS, INSTRUMENT TAG NUMBERS AND VALVE NUMBERS ARE PREFIXED "07" UNLESS OTHERWISE NOTED.
 - PIPING TIE-IN LAYOUT BY PIPING.
 - THE FLOOR SUMP, BS-SDS-0227 AND PUMP, MP-SDS-0227 ARE LOCATED ON THE 2ND FLOOR OF THE EQUIPMENT PLATFORM AT EL. 925 FT.

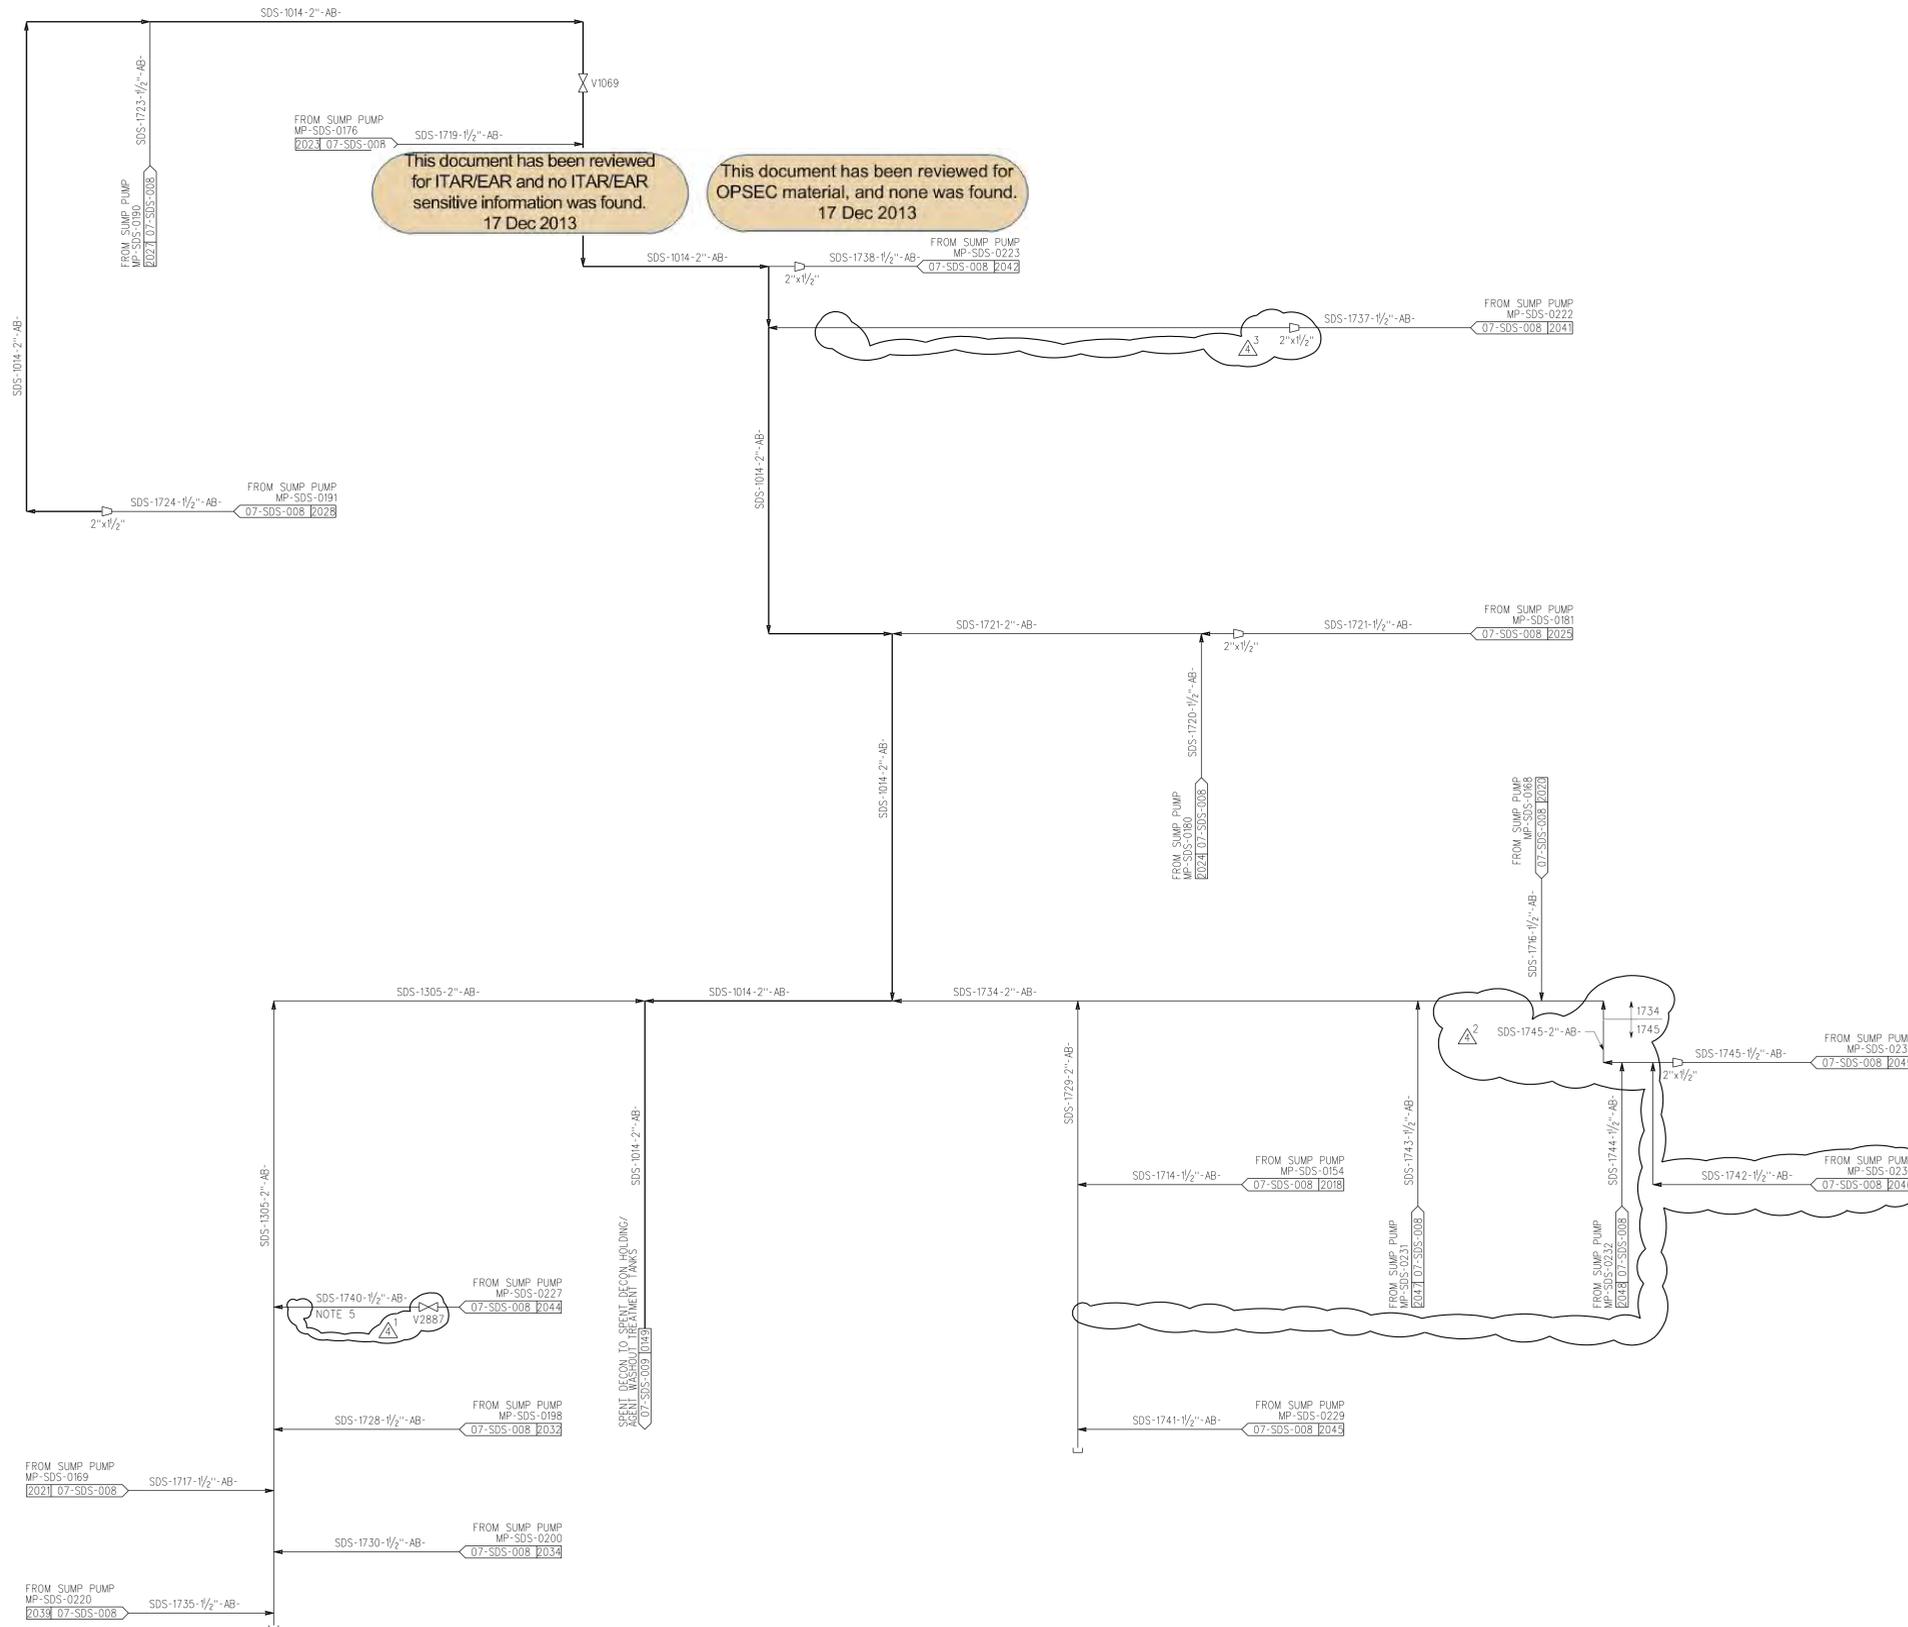

This document has been reviewed for ITAR/EAR and no ITAR/EAR sensitive information was found. 17 Dec 2013

This document has been reviewed for OPSEC material, and none was found. 17 Dec 2013

BASED ON BLUE GRASS MSD 24915-07-NO-SDS-00001 REV 6
REFERENCE DRAWINGS

NO.	DATE	DESCRIPTION	DR	CK	DL	PE	APVD
4	06/08/09	IFC, ADDED PIPING COMMENTS	JLL	PEB	BM	BBB	BBB
3	03/09/07	IFC, ADDED VALVE, REVISED LINE NUMBER, LOCATION	RZ	JLL	PEB	JB	BBB
2	09/28/06	IFD, ADD DESIGN DEVELOPMENT	BE	JLL	PEB	JB	BBB
1	04/26/06	IFD, DESIGN DEVELOPMENT, SHEET REDRAWN	BE	JLL	PEB	JB	BBB
0	04/18/06	ISSUED FOR DESIGN (IFD)	BE	JLL	PEB	JB	BBB

QUALITY Non-0

BECHTEL PARSONS
BLUE GRASS
A Joint Venture of Bechtel Technology, Inc. and Parsons Infrastructure & Technology Group, Inc.

DOD PROGRAM MANAGER FOR ASSEMBLED CHEMICAL WEAPONS ASSESSMENT EDgewood, MARYLAND

US ARMY ENGINEERING AND SUPPORT CENTER, HUNTSVILLE, ALABAMA

BLUE GRASS CHEMICAL AGENT DESTRUCTION PILOT PLANT PROJECT (BGCAPP)
 RICHMOND, KENTUCKY
 CONTRACT NO. DAAA09-03-D-0023
MUNITIONS DEMILITARIZATION BUILDING CAT-C SUMP PUMPS DISTRIBUTION HDR PIPING & INSTRUMENT DIAGRAM

DRAWING CONTAINS PE SEAL ORIGINAL ON FILE
 PROFESSIONAL STAMP

DRAWING NUMBER 24915-07-M6-SDS-00013 SHEET 1 OF 1 REV 4

07MSDS0013.dwg 06/10/09
 DESIGN FILE: DONSPEC AT SYTIME USING COLOR...
 PLOTTED BY: USER4 ON DATE: 6/10/09 2:29:05 PM

MJ-THS-0125
TMA INPUT CONVEYOR
MOTOR HP : 3 HP

AD-THS-0108
TMA INPUT AIRLOCK IN-GATE
MOTOR HP : 2 HP

MJ-THS-0126
TMA INPUT AIRLOCK/CONVEYOR
MOTOR HP : 3 HP
TRIM : TRIM-1096-0"-A-



AD-THS-0109
TMA INPUT AIRLOCK OUT-GATE
MOTOR HP : 2 HP

- GENERAL NOTES:
- FOR SYMBOLS AND LEGEND, SEE DRAWINGS 24915-00-M6-00-00010 THRU 00015.
 - DRAWING NUMBERS IN OFF-PAGE CONNECTORS ARE TRUNCATED BY SUPPRESSING PROJECT NUMBER "24915" AND DOCUMENTS TYPE "M6". TWO LEADING ZEROS IN SEQUENCE NUMBER ARE NOT SHOWN.
 - ALL EQUIPMENT NUMBERS, INSTRUMENT TAG NUMBERS AND VALVE NUMBERS ARE PREFIXED "07" UNLESS OTHERWISE NOTED.
 - FOR CONVEYOR LAYOUT/LOCATION SEE MATERIALS HANDLING EQUIPMENT GENERAL ARRANGEMENT DRAWING 24915-07-MJ-00-00002.
 - INLET GATE AD-THS-0108 SHALL BE INTERLOCKED WITH OUTLET GATE AD-THS-0109 THROUGH A TIMER TO PREVENT IT FROM OPENING AFTER OUTLET GATE CLOSES UNTIL THE AIRLOCK HAS BEEN PURGED.
 - INSTRUMENTATION AND VALVES SHOWN ON HVAC DRAWING NO. 24915-07-M6-HVAC-00127.
 - UNLESS OTHERWISE NOTED, FCS INTERLOCK NUMBERS ARE PREFIXED WITH "07-THS-" AND FPS (OR Z) INTERLOCKS ARE PREFIXED WITH "07-FPS-".
 - WARNING LIGHT IS INTERLOCKED TO TURN ON 10 SECONDS BEFORE CONVEYOR MOTOR STARTS AND TURN OFF 10 SECONDS AFTER CONVEYOR STARTS.
 - GATE CLEAR SWITCHES SHOWN ON AIRLOCK GATES ARE PHYSICALLY LOCATED ON ADJACENT CONVEYORS.

This document has been reviewed for ITAR/EAR and no ITAR/EAR sensitive information was found. 17 Dec 2013

This document has been reviewed for OPSEC material, and none was found. 17 Dec 2013

TO HD8664 & AD8665
252807-HVAC-0127

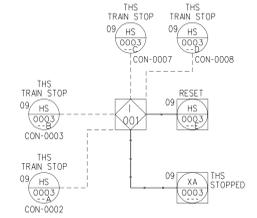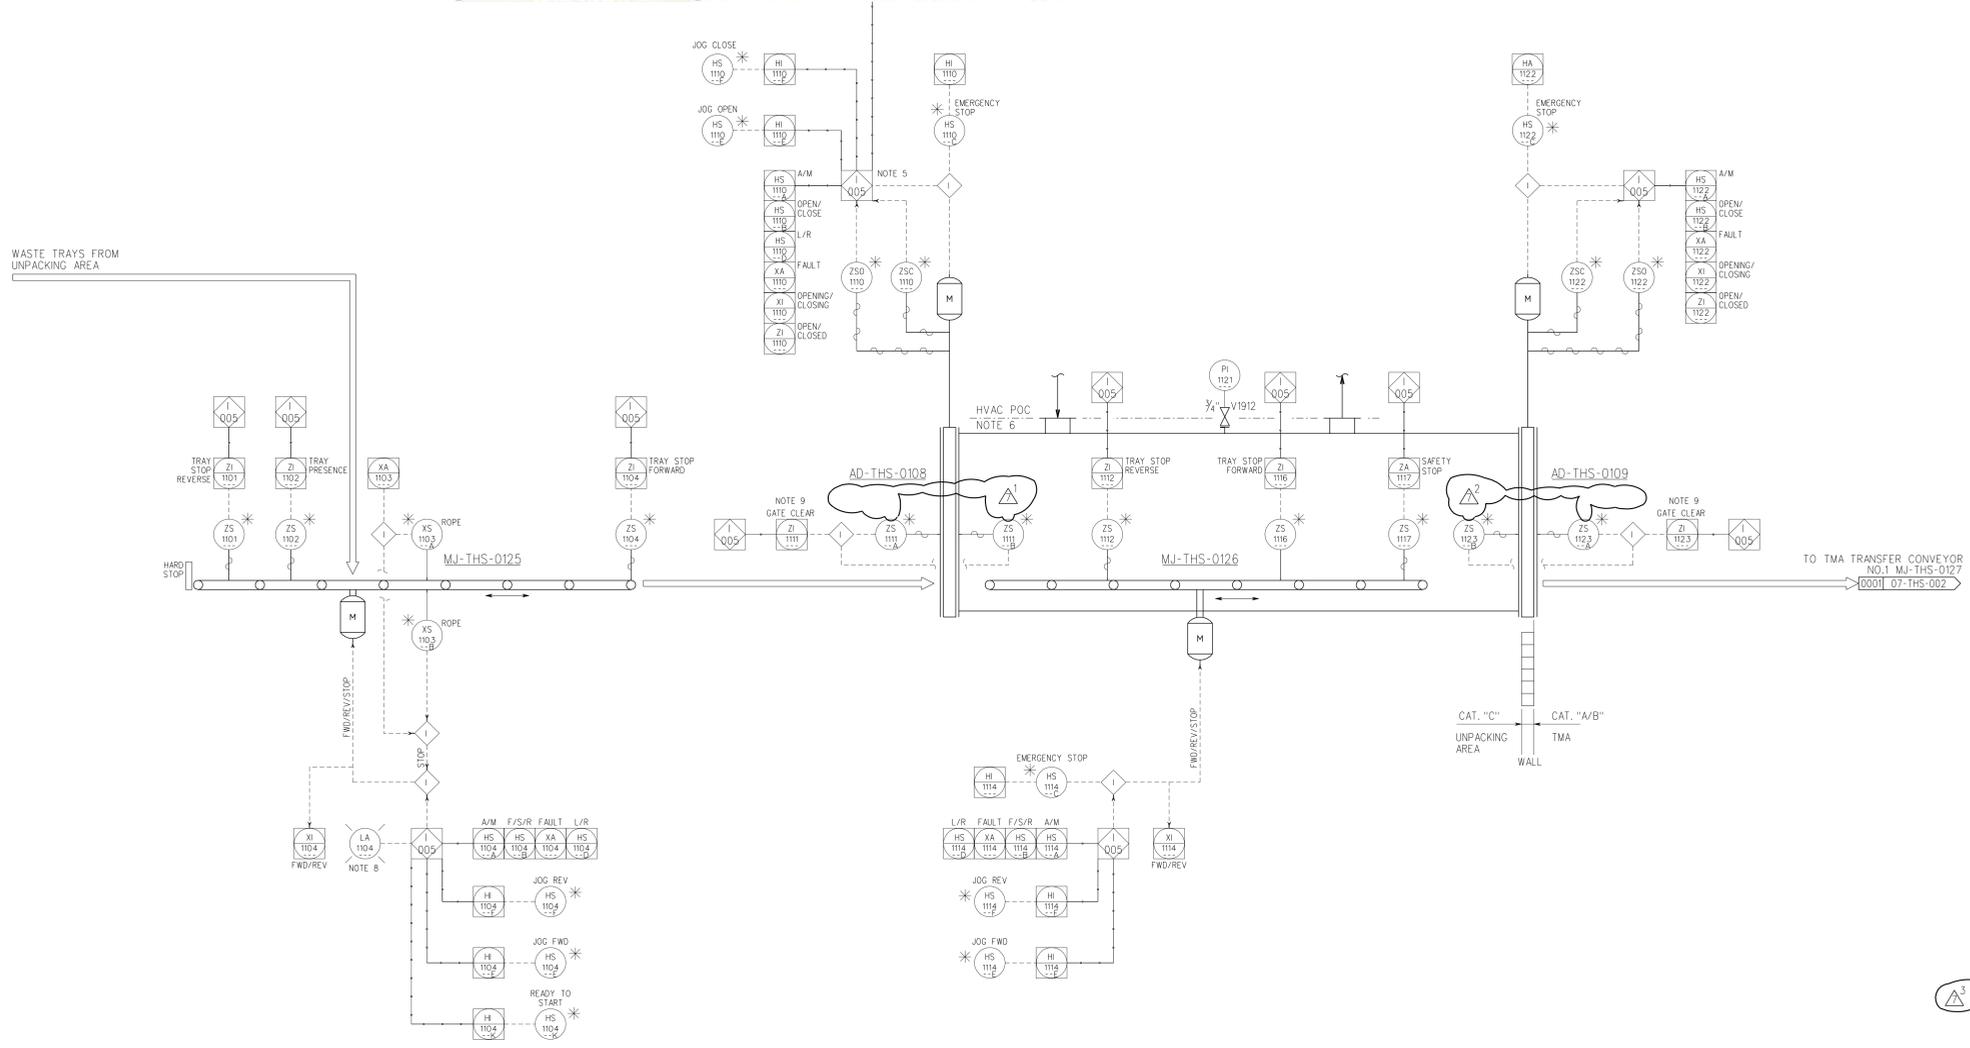

02/21/12	IFC, INCORPORATED DCN-689	GM	MDV	SA	BBB	BBB
07/22/09	IFC, INCORPORATED REVISED DESIGN REQUIREMENTS	PEB	JLL	BM	BBB	BBB
02/01/07	IFC, CLARIFY INSTRUMENTS SUPPLIED W/ EQUIPMENT	RZ	JLL	PEB	JB	BBB
11/15/06	IFD, ADDED GOV. COMMENTS AND INTERLOCK TAG NO.	RZ	JLL	PEB	JB	BBB
05/05/06	ISSUED FOR DESIGN (IFD), ADD DESIGN DEVELOPMENT	RZ	JLL	PEB	JB	BBB
10/31/05	IFD, DC-1 INCORPORATED	RZ	JLL	PEB	JB	PCK
09/27/05	ISSUED FOR APPROVAL (IFA)	RZ	JLL	PEB	JB	JU
01/03/05	ISSUED FOR DESIGN (IFD)	NP	RZ	PEB	JB	JU
NO. DATE	DESCRIPTION	DR	CK	DL	PE	APVD
QUALITY	<input type="checkbox"/> Non-0					

BECHTEL PARSONS BLUE GRASS
A Joint Venture of Bechtel Technology, LLC and Parsons Infrastructure & Technology Group, Inc.

DDO PROGRAM MANAGER FOR ASSEMBLED CHEMICAL WEAPONS ASSESSMENT EDGEMOOD, MARYLAND

US ARMY ENGINEERING AND SUPPORT CENTER, HUNTSVILLE, ALABAMA

BLUE GRASS CHEMICAL AGENT DESTRUCTION PILOT PLANT PROJECT (BCAPP)
RICHMOND, KENTUCKY
DAAA09-03-D-0023

MUNITIONS DEMILITARIZATION BUILDING
TMA LOAD & INPUT AIRLOCK/CONVEYOR
PIPING & INSTRUMENT DIAGRAM

CONTRACT NO. | DRAWING NUMBER | SHEET | REV
24915-07-M6-THS-00001 | 1 OF 1 | 7



07MTHS0001.dwg 02/23/12
 DESIGN FILE: DONSPEC
 PLOTTED BY: USER4 ON DATE: 02/23/12 AT 5:11 PM
 .../347/np/dmga/pl14/07mtha001.plt 2/23/2012 7:48:35 AM

MJ-THS-0127
TMA TRANSFER CONVEYOR NO.1
MOTOR HP : 3 HP



MJ-THS-0128
TMA TRANSFER CONVEYOR NO.2
MOTOR HP : 3 HP

MJ-THS-0129
TMA SWING CONVEYOR
MOTOR HP (A) : 3 HP
MOTOR HP (B) : 0.75 HP (SERVO)

- GENERAL NOTES:
- FOR SYMBOLS AND LEGEND, SEE DRAWINGS 24915-00-M6-00-00010 THRU 00015.
 - DRAWING NUMBERS IN OFF-PAGE CONNECTORS ARE TRUNCATED BY SUPPRESSING PROJECT NUMBER "24915" AND DOCUMENTS TYPE "M6". TWO LEADING ZEROS IN SEQUENCE NUMBER ARE NOT SHOWN.
 - ALL EQUIPMENT NUMBERS, INSTRUMENT TAG NUMBERS AND VALVE NUMBERS ARE PREFIXED "07" UNLESS OTHERWISE NOTED.
 - DELETED.
 - FOR CONVEYOR LAYOUT/LOCATION SEE MATERIALS HANDLING EQUIPMENT GENERAL ARRANGEMENT DRAWING 24915-07-MJ-00-00002.
 - CONVEYOR MJ-THS-0128 MOTOR SHALL BE HARDWIRE INTERLOCKED WITH ZS-1155--- SWITCH ON CONVEYOR MJ-THS-0129 TO PREVENT ITS MOTOR RUNNING IN FORWARD DIRECTION WHILE THEY ARE NOT ALIGNED.
 - CONVEYOR MJ-THS-0129 MOTOR SHALL BE HARDWIRE INTERLOCKED WITH ZS-1155--- TO PREVENT ITS MOTOR FROM RUNNING WHILE IT IS NOT IN NORTH-SOUTH ORIENTATION.
 - ONLY LOCAL CONTROL REQUIRED.
 - UNLESS OTHERWISE NOTED, FCS INTERLOCK NUMBERS ARE PREFIXED WITH "07-THS-" AND FPS (OR Z) INTERLOCKS ARE PREFIXED WITH "07-FPS-".
 - SWING CONVEYOR MJ-THS-0129 SWING MOTOR "B" SHALL BE HARDWIRE INTERLOCKED WITH CONVEYOR MOTOR "A" TO PREVENT CONVEYOR ROLLERS TURNING WHILE SWING MOTOR IS OPERATING. ACTUATION OF ROPE WILL STOP THE SWING MOTOR AND CONVEYOR MOTOR.
 - TMA SWING CONVEYOR MJ-THS-0129 LOCAL JOG OPEN AND CLOSE SWITCHES SHALL BE PROVIDED AND SHIPPED LOOSE BY THE CONVEYOR SUPPLIER, EASTSIDE AND WESTSIDE SWITCHES SHALL BE MOUNTED IN SEPARATE CONTROL BOXES.

This document has been reviewed for ITAR/EAR and no ITAR/EAR sensitive information was found. 17 Dec 2013

This document has been reviewed for OPSEC material, and none was found. 17 Dec 2013

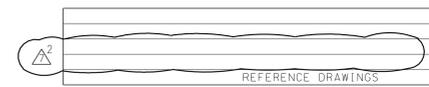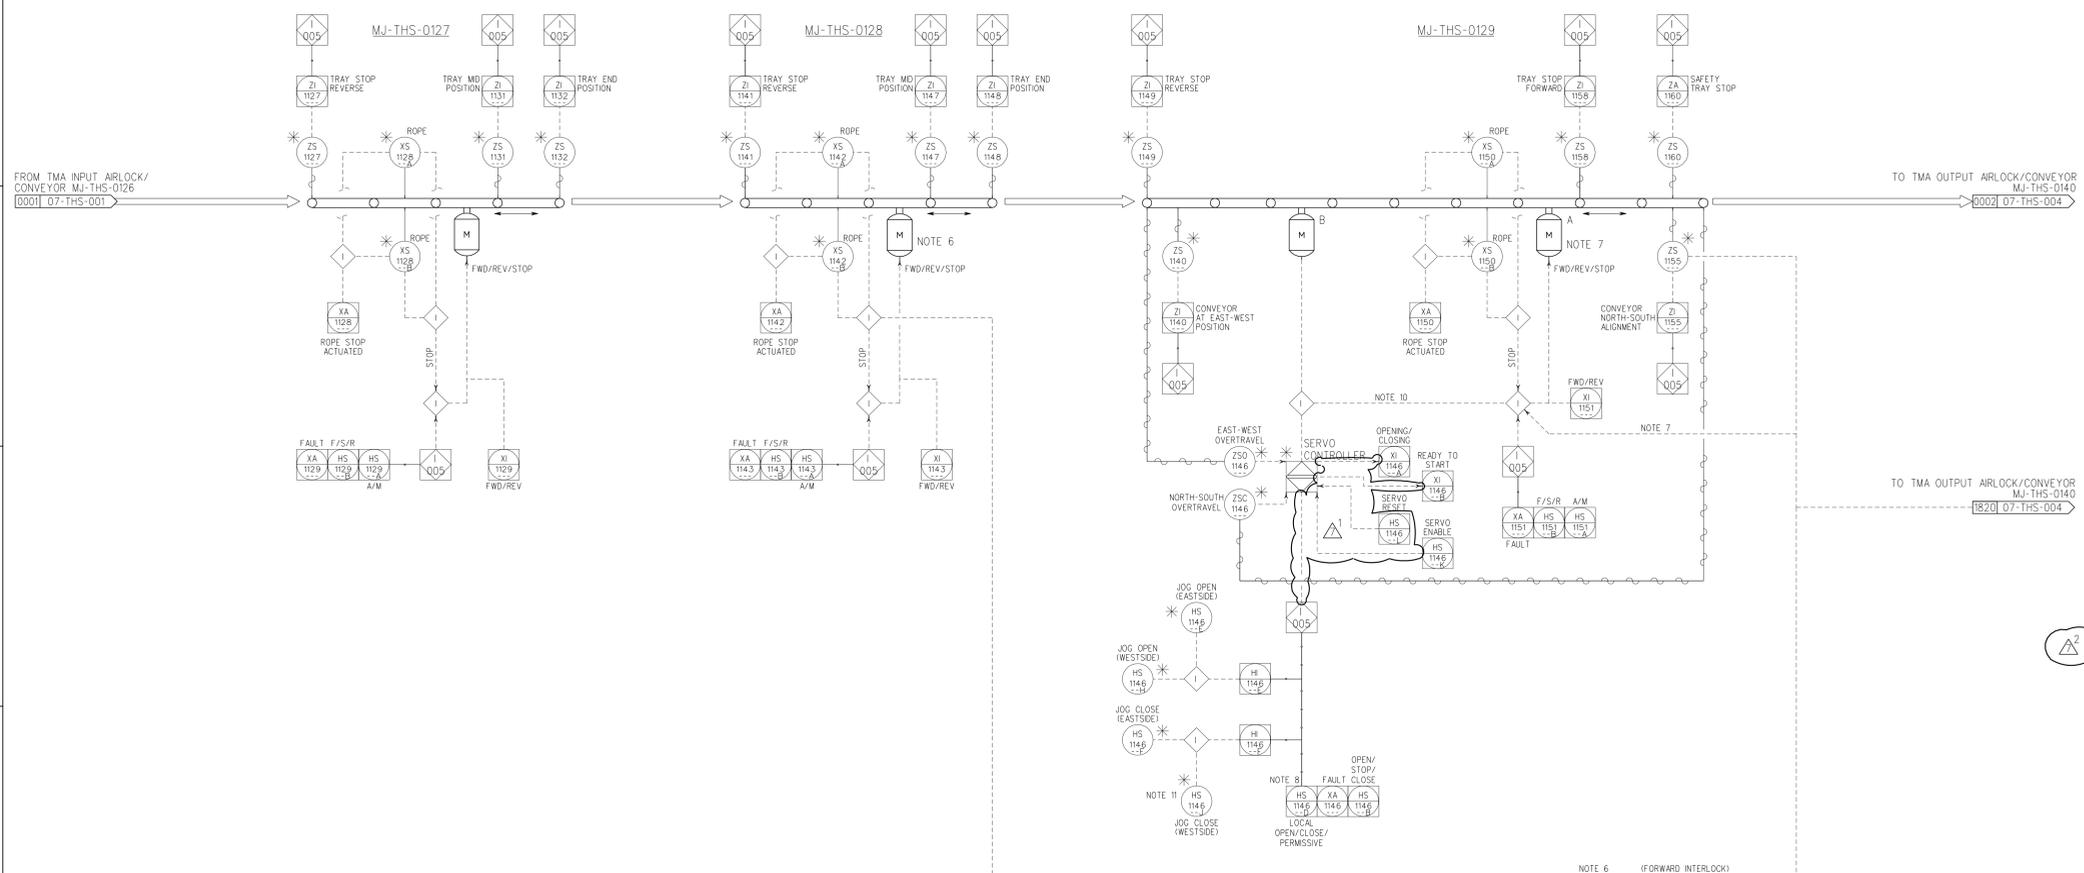

NO.	DATE	DESCRIPTION	DR	CK	DL	PE	APVD
7	02/21/12	IFC, INCORPORATED DCN-689	GM	MDV	SA	BBB	BBB
6	07/22/09	IFC, GC 7730, VENDOR DATA	PEB	JLL	BM	BBB	BBB
5	02/01/07	IFC, CLARIFY INSTRUMENTS SUPPLIED W/ EQUIPMENT	RZ	JLL	PEB	JB	BBB
4	11/15/06	IFD, ADDED GOV. COMMENTS AND INTERLOCK TAG NO.	RZ	JLL	PEB	JB	BBB
3	05/05/06	ISSUED FOR DESIGN (IFD), ADD DESIGN DEVELOPMENT	RZ	JLL	PEB	JB	BBB
2	10/31/05	IFD, DC-1 INCORPORATED	RZ	JLL	PEB	JB	PCK
1	09/27/05	ISSUED FOR APPROVAL (IFA)	RZ	JLL	PEB	JB	JU
0	01/03/05	ISSUED FOR DESIGN (IFD)	NP	RZ	PEB	JB	JU

QUALITY 0 Non-0

BECHTEL PARSONS BLUE GRASS DOD PROGRAM MANAGER FOR ASSEMBLED CHEMICAL WEAPONS ASSESSMENT EDGEMOOD, MARYLAND US ARMY ENGINEERING AND SUPPORT CENTER, HUNTSVILLE, ALABAMA

BLUE GRASS CHEMICAL AGENT DESTRUCTION PILOT PLANT PROJECT (BCAPP) RICHMOND, KENTUCKY DAAA09-03-D-0023

MUNITIONS DEMILITARIZATION BUILDING TMA TRANSFER CONVEYORS PIPING & INSTRUMENT DIAGRAM


DRAWING NUMBER 24915-07-M6-THS-00002 SHEET 1 OF 1 REV 7



07MTHS002.ppt 02/23/12 DESIGN FILE: DONSPEC AT SYTIME USING COLOR... PLOTTED BY: USER ON DATE: 2/23/12 7:36:13 AM

MJ-THS-0111
MPT BUFFER CONVEYOR
MOTOR HP (A) 1.5 HP
MOTOR HP (B) 1.5 HP

- GENERAL NOTES:
- FOR SYMBOLS AND LEGEND, SEE DRAWINGS 24915-00-M6-00-00010 THRU 00015.
 - DRAWING NUMBERS IN OFF-PAGE CONNECTORS ARE TRUNCATED BY SUPPRESSING PROJECT NUMBER "24915" AND DOCUMENTS TYPE "M6". TWO LEADING ZEROS IN SEQUENCE NUMBER ARE NOT SHOWN.
 - ALL EQUIPMENT NUMBERS, INSTRUMENT TAG NUMBERS AND VALVE NUMBERS ARE PREFIXED "07" UNLESS OTHERWISE NOTED.
 - FOR CONVEYOR LAYOUT/LOCATION SEE MATERIALS HANDLING EQUIPMENT GENERAL ARRANGEMENT DRAWING 24915-07-MJ-00-00002.
 - MPT BUFFER CONVEYOR HAS A CAPACITY TO CONTAIN 3 TRAYS.
 - CONVEYOR MOTOR AND POP-UP CONVEYOR MOTOR ARE HARDWIRE INTERLOCKED TO PREVENT SIMULTANEOUS OPERATION AND PULLING ANY OF THE ROPES SHALL STOP BOTH MOTORS FROM RUNNING.
 - CONVEYOR MOTOR SHALL BE HARDWIRE INTERLOCKED WITH ZS-0884--- SWITCH ON CONVEYOR MJ-THS-0123 TO PREVENT ITS MOTOR RUNNING IN REVERSE (NORTH) DIRECTION IF TURNTABLE IS NOT AT NORTH-SOUTH ORIENTATION.
 - ROLLER CONVEYOR MOTOR SHALL BE HARDWIRE INTERLOCKED WITH ZS-0186--- SWITCH ON CONVEYOR MJ-THS-0110 TO PREVENT ITS MOTOR RUNNING IN FORWARD DIRECTION IF TURNTABLE IS NOT AT NORTH-SOUTH ORIENTATION.
 - UNLESS OTHERWISE NOTED, FCS INTERLOCK NUMBERS ARE PREFIXED WITH "07-THS-" AND FPS (OR Z) INTERLOCKS ARE PREFIXED WITH "07-FPS-".
 - LACK OF POWER TO SWITCHES ZSL-0226--- AND ZSH-0226--- SHALL PREVENT SOLENOID VALVE XY-0226--- FROM OPERATING.

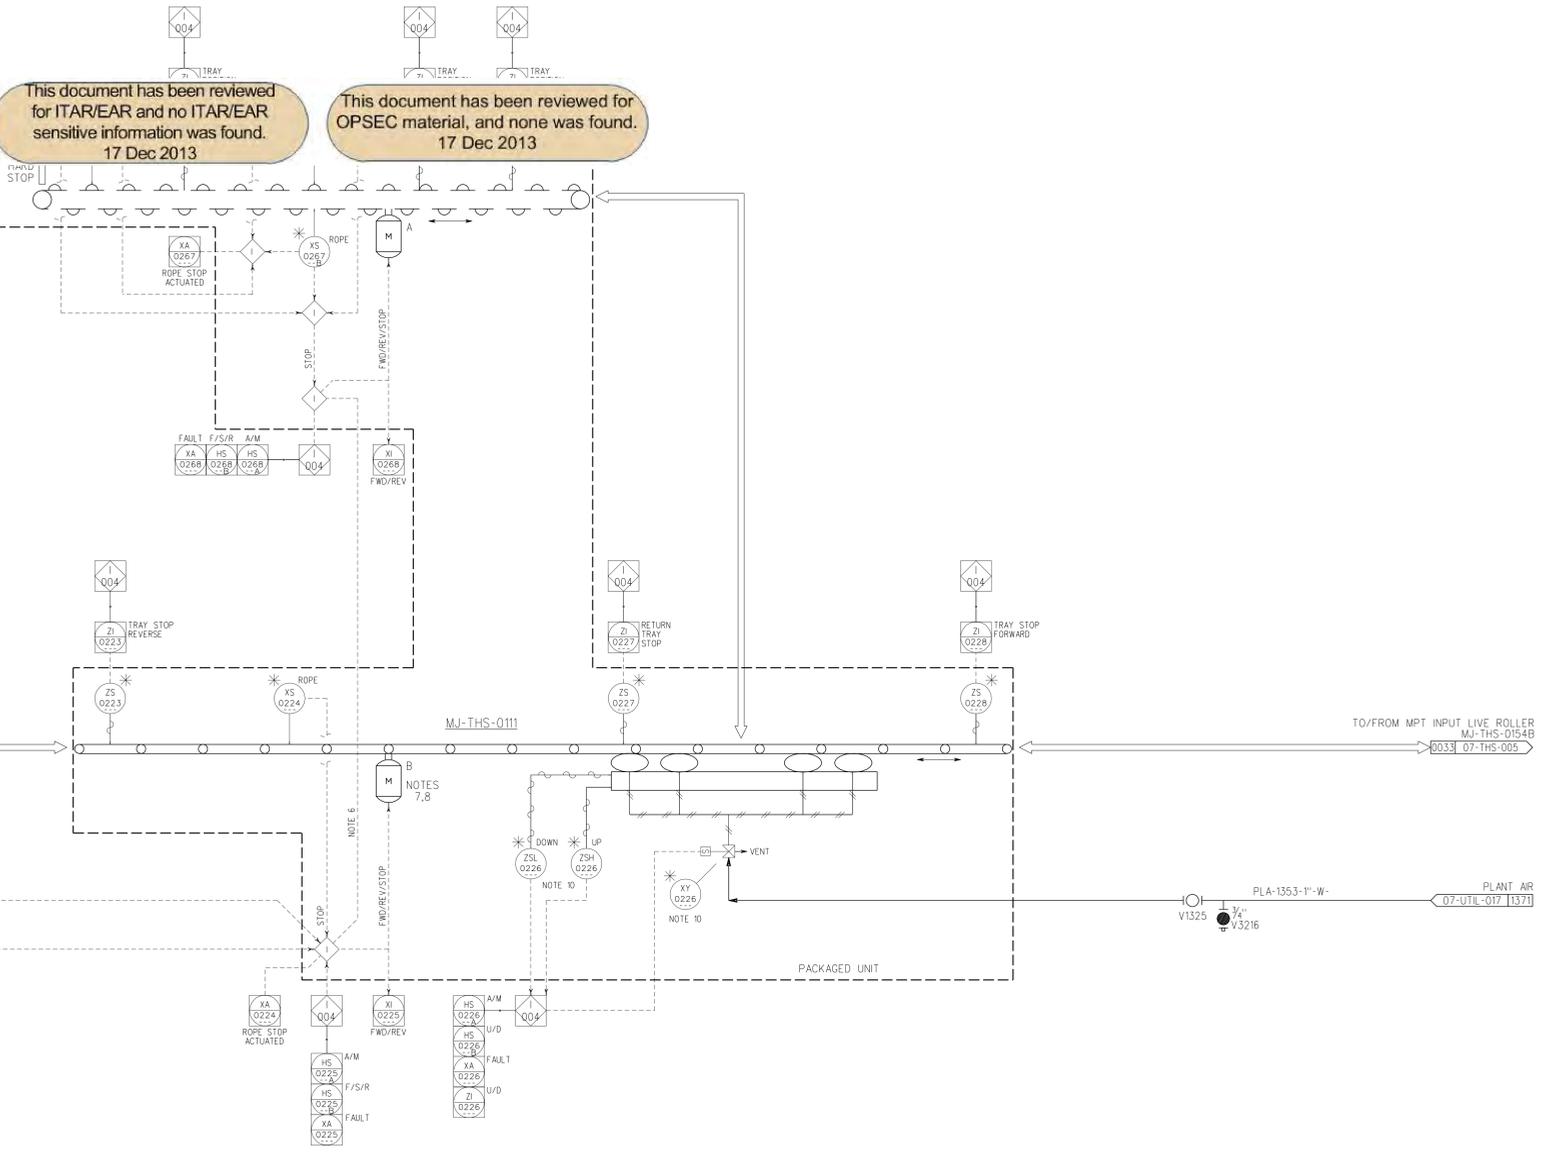

FROM/TO MPT INPUT LIVE ROLLER
MJ-THS-0154A
00660 07-THS-007

TO/FROM MPT INPUT LIVE ROLLER
MJ-THS-0154B
00330 07-THS-005

FROM ZS-0884--- TURNTABLE CONV. NO.3
MJ-THS-0123 IN NORTH-SOUTH POSITION
18181 07-THS-005

NOTE 7 (REVERSE INTERLOCK)

FROM ZS-0186--- TURNTABLE CONV. NO.2
MJ-THS-0110 IN NORTH-SOUTH POSITION
18191 07-THS-007

NOTE 8 (FORWARD INTERLOCK)

PLA-1353-1"-W-
V1325 1/4" V5216
07-UTIL-017 1371
PLANT AIR

NO.	DATE	DESCRIPTION	DR	CK	DL	PE	APVD

NO.	DATE	DESCRIPTION	DR	CK	DL	PE	APVD
5	02/21/12	IFC, INCORPORATED DCN-689	GM	MDV	SA	BBB	BBB
4	07/22/09	IFC, INCORPORATED REVISED DESIGN REQUIREMENTS	PEB	JLL	BM	BBB	BBB
3	02/01/07	IFC, CHANGED FLAG DESCRIPTION	RZ	JLL	PEB	JB	BBB
2	11/15/06	IFD, ADDED GOV. COMMENTS & INTERLOCK TAG NO.	RZ	JLL	PEB	JB	BBB
1	05/05/06	ISSUED FOR DESIGN (IFD), ADD DESIGN DEVELOPMENT	RZ	JLL	PEB	JB	BBB
0	10/31/05	ISSUED FOR DESIGN (IFD)	RZ	JLL	PEB	JB	PKG

BECHTEL PARSONS
BLUE GRASS
A joint venture of Bechtel Technology, Inc. and Parsons Infrastructure & Technology Group, Inc.

DDO PROGRAM MANAGER FOR ASSEMBLED CHEMICAL WEAPONS ASSESSMENT EDgewood, MARYLAND

US ARMY ENGINEERING AND SUPPORT CENTER, HUNTSVILLE HUNTSVILLE, ALABAMA

BLUE GRASS CHEMICAL AGENT DESTRUCTION
PILOT PLANT PROJECT (BCAPP)
RICHMOND, KENTUCKY
DAAA09-03-D-0023

MUNITIONS DEMILITARIZATION BUILDING
MPT BUFFER CONVEYOR
PIPING & INSTRUMENT DIAGRAM

DRAWING NUMBER 24915-07-M6-THS-00006 SHEET 1 OF 1 REV 5



07MTHS006.pld 02/23/12
 DESIGN FILE: DONSPEC AT SYTIME USING COLORPLOT AT SYTIME
 PLOTTED BY: USER ON DATE: 2/23/12 7:39:50 AM


MJ-THS-0110
 TURNABLE CONVEYOR NO.2
 MOTOR HP (A) : 3 HP
 MOTOR HP (B) : 0.75 HP

MJ-THS-0154A
 MPT INLET LIVE ROLLER
 MOTOR HP : 0.5 HP

- GENERAL NOTES:
- FOR SYMBOLS AND LEGEND, SEE DRAWINGS 24915-00-M6-00-00010 THRU 00015.
 - DRAWING NUMBERS IN OFF-PAGE CONNECTORS ARE TRUNCATED BY SUPPRESSING PROJECT NUMBER "24915" AND DOCUMENTS TYPE "M6". TWO LEADING ZEROS IN SEQUENCE NUMBER ARE NOT SHOWN.
 - ALL EQUIPMENT NUMBERS, INSTRUMENT TAG NUMBERS AND VALVE NUMBERS ARE PREFIXED "07" UNLESS OTHERWISE NOTED.
 - FOR CONVEYOR LAYOUT/LOCATION SEE MATERIALS HANDLING EQUIPMENT GENERAL ARRANGEMENT DRAWING 24915-07-MJ-00-00002.
 - MOTORS SHALL BE PROVIDED WITH INTEGRAL BRAKE.
 - DELETED.
 - CONVEYOR MOTOR AND TURNABLE MOTOR SHALL BE HARDWIRE INTERLOCKED TO PREVENT SIMULTANEOUS OPERATION.
 - WARNING LIGHT IS INTERLOCKED TO TURN ON 10 SECONDS BEFORE TURNABLE MOTOR STARTS AND TURN OFF WHEN MOTOR STOPS.
 - A FLOOR MOUNTED HARD STOP SHALL BE PROVIDED ON THE SOUTH END OF TURNABLE.
 - TURNABLE CONVEYOR MOTOR SHALL BE HARDWIRE INTERLOCKED WITH ZS-0185--- OR ZS-0186--- TO PREVENT ITS MOTOR FROM RUNNING WHILE IT IS NOT ALIGNED.
 - UNLESS OTHERWISE NOTED, FCS INTERLOCK NUMBERS ARE PREFIXED WITH "07-THS-1" AND FPS OR ZI INTERLOCKS ARE PREFIXED WITH "07-FPS-1".
 - VENDOR SHALL PROVIDE THE REQUIRED PROGRAMMING TO REDUCE THE VFD SPEED ONCE EITHER OF THE REDUNDANT SLOW SPEED SWITCHES ASSOCIATED WITH THE ALIGNMENT IS ACTIVATED. WHEN THE TABLE IS SLOWING DOWN AND REACHES THE NORTH-SOUTH OR EAST-WEST ALIGNMENT SWITCH, FCS WILL COMMAND THE TABLE TO STOP. VENDOR SHALL ALSO PROVIDE THE SAFETY HARD STOP WITH SPRING TO ELIMINATE DAMAGE IN THE EVENT OF SENSOR FAILURE.

This document has been reviewed for ITAR/EAR and no ITAR/EAR sensitive information was found. 17 Dec 2013

This document has been reviewed for OPSEC material, and none was found. 17 Dec 2013

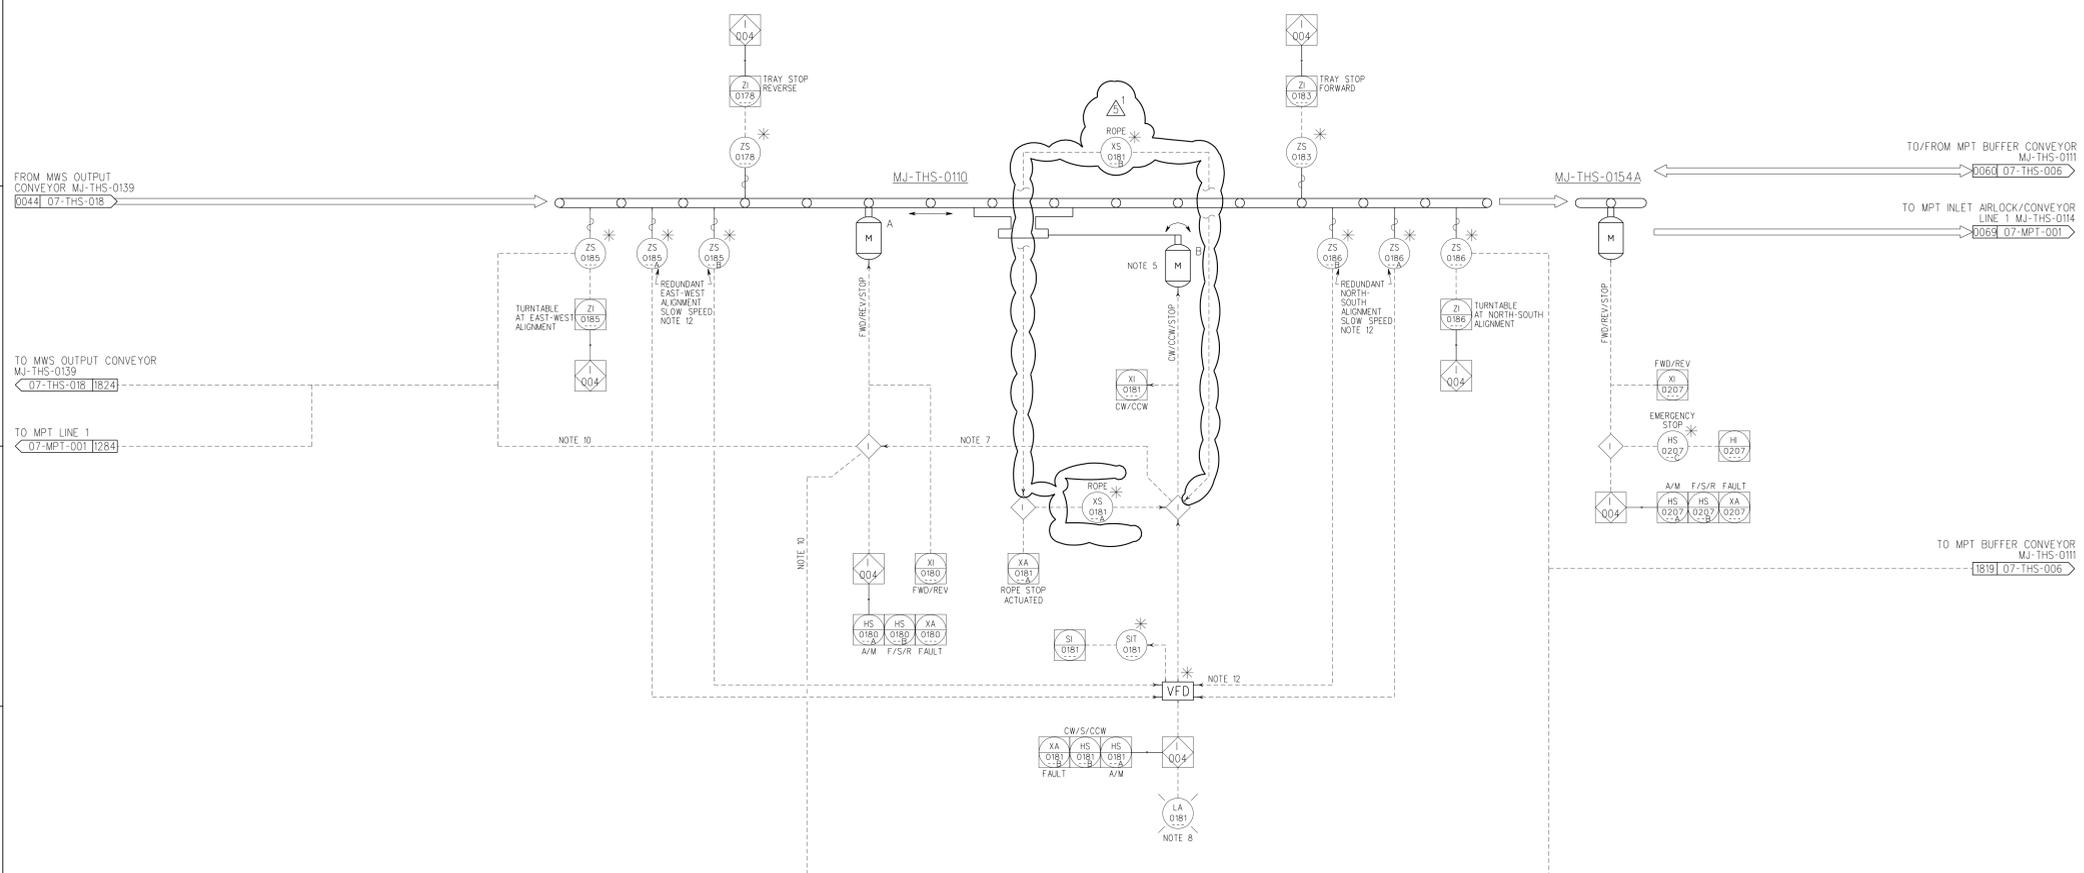

NO.	DATE	DESCRIPTION	DR	CK	DL	PE	APVD

NO.	DATE	DESCRIPTION	DR	CK	DL	PE	APVD
1	01/20/12	IFC, INCORPORATED DCN-627	GM	PEB	SA	BBB	BBB
2	07/22/09	IFC, VENDOR DATA, REVISED DESIGN REQUIREMENTS	PEB	JLL	BM	BBB	BBB
3	02/07/07	IFC, ADDED MJ-RHS-0154A, REVISED NOTE 6	RZ	JLL	PEB	JB	BBB
4	11/15/06	IFD, ADDED GOV. COMMENTS AND INTERLOCK TAG NO.	RZ	JLL	PEB	JB	BBB
5	05/05/06	ISSUED FOR DESIGN (IFD), ADD DESIGN DEVELOPMENT	RZ	JLL	PEB	JB	BBB
6	10/31/05	ISSUED FOR DESIGN (IFD)	RZ	JLL	PEB	JB	PKG

BECHTEL PARSONS
BLUE GRASS
 A joint venture of Bechtel Inc. and Parsons Infrastructure & Technology Group, Inc.

000 PROGRAM MANAGER FOR ASSEMBLED CHEMICAL WEAPONS ASSESSMENT EDgewood, MARYLAND

US ARMY ENGINEERING AND SUPPORT CENTER, HUNTSVILLE, ALABAMA

BLUE GRASS CHEMICAL AGENT DESTRUCTION PILOT PLANT PROJECT (BGCAPP)
 RICHMOND, KENTUCKY
 DAAA09-03-D-0023

MUNITIONS DEMILITARIZATION BUILDING
 TURNABLE CONVEYOR NO.2
 PIPING & INSTRUMENT DIAGRAM

CONTRACT NO. | SHEET 1 OF 1 | REV 5



07MTHS007.pdf 01/20/12
 DESIGN FILE: DONSPEC AT SYTIME USING COLORPLOT AT SYTIME
 PLOTTED BY: USER ON DATE: 1/20/12 11:18:31 AM


MJ-THS-0101
TRAY INPUT CONVEYOR NO.1
MOTOR HP : 3 HP

MJ-THS-0144
TRAY INPUT CONVEYOR NO.2
MOTOR HP : 3 HP

- GENERAL NOTES:
- FOR SYMBOLS AND LEGEND, SEE DRAWINGS 24915-00-M6-00-00010 THRU 00015.
 - DRAWING NUMBERS IN OFF-PAGE CONNECTORS ARE TRUNCATED BY SUPPRESSING PROJECT NUMBER "24915" AND DOCUMENTS TYPE "M6". TWO LEADING ZEROS IN SEQUENCE NUMBER ARE NOT SHOWN.
 - ALL EQUIPMENT NUMBERS, INSTRUMENT TAG NUMBERS AND VALVE NUMBERS ARE PREFIXED "07" UNLESS OTHERWISE NOTED.
 - FOR CONVEYOR LAYOUT/LOCATION SEE MATERIALS HANDLING EQUIPMENT GENERAL ARRANGEMENT DRAWING 24915-07-MJ-00-00002.
 - WARNING LIGHT IS INTERLOCKED TO TURN ON 10 SECONDS BEFORE CONVEYOR MOTOR STARTS AND TURN OFF 10 SECONDS AFTER CONVEYOR STARTS.
 - UNLESS OTHERWISE NOTED, FCS INTERLOCK NUMBERS ARE PREFIXED WITH "07-THS-" AND FPS (OR Z) INTERLOCKS ARE PREFIXED WITH "07-FPS-".
 - TRAY DOES NOT STOP AT FORWARD SENSOR BUT IS REQUIRED TO INDICATE FORWARD MOVEMENT TO THE FCS.

This document has been reviewed for ITAR/EAR and no ITAR/EAR sensitive information was found. 17 Dec 2013

This document has been reviewed for OPSEC material, and none was found. 17 Dec 2013

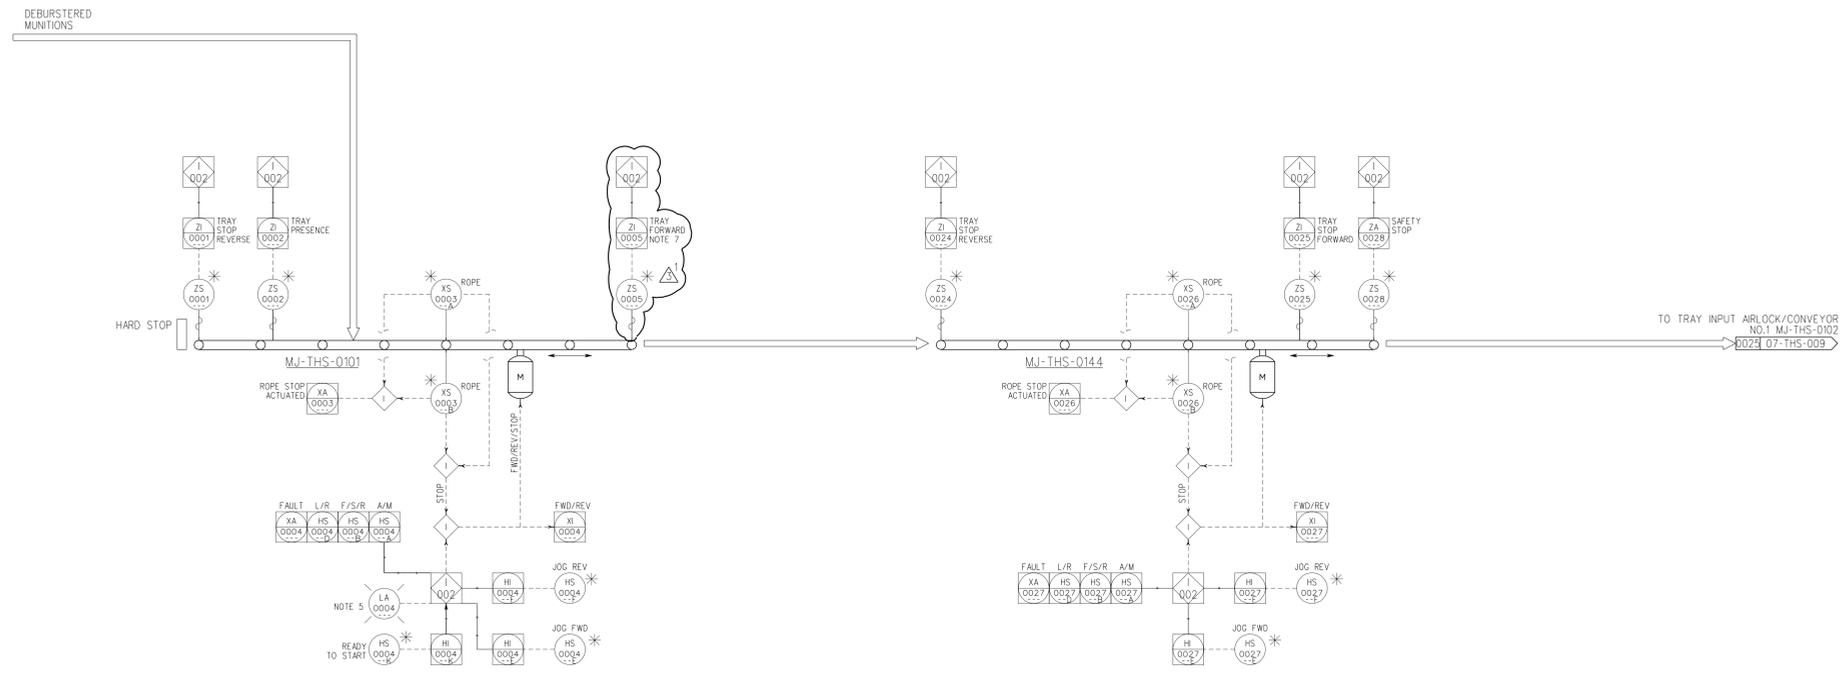

NO.	DATE	DESCRIPTION	DR	CK	DL	PE	APVD

NO.	DATE	DESCRIPTION	DR	CK	DL	PE	APVD
33	07/22/09	IFC, INCORPORATED REVISED DESIGN REQUIREMENTS	PEB	JLL	BM	BBB	BBB
32	02/01/07	IFC, CLARIFY INSTRUMENTS SUPPLIED W/ EQUIPMENT	RZ	JLL	PEB	JB	BBB
31	11/15/06	IFC, ADDED GOV. COMMENTS AND INTERLOCK TAG NO.	RZ	JLL	PEB	JB	BBB
30	10/31/05	ISSUED FOR DESIGN (IFD)	RZ	JLL	PEB	JB	PGK

BECHTEL PARSONS BLUE GRASS
A Joint Venture of Bechtel Technology, Inc. and Parsons Infrastructure & Technology Group, Inc.
DOD PROGRAM MANAGER FOR ASSEMBLED CHEMICAL WEAPONS ASSESSMENT EDGEMOOD, MARYLAND
US ARMY ENGINEERING AND SUPPORT CENTER, HUNTSVILLE, ALABAMA

BLUE GRASS CHEMICAL AGENT DESTRUCTION PILOT PLANT PROJECT (BGCAPP)
RICHMOND, KENTUCKY
CONTRACT NO. DAAA09-03-D-0023

MUNITIONS DEMILITARIZATION BUILDING TRAY INPUT CONVEYORS PIPING & INSTRUMENT DIAGRAM

DRAWING NUMBER 24915-07-M6-THS-00008 SHEET 1 OF 1 REV 3



07MTHS0008.pld 07/23/09
DESIGN FILE: DONSPEC
PLOTTED BY: USER ON DATE: 07/23/09 AT 5:11 PM

AD-THS-0104
TRAY INPUT AIRLOCK NO.1 IN-GATE
MOTOR HP : 2 HP

MJ-THS-0102
TRAY INPUT AIRLOCK/CONVEYOR NO.1
MOTOR HP : 3 HP
TRIM : TRM-1098-01-A


AD-THS-0105
TRAY INPUT AIRLOCK NO.1 OUT-GATE
MOTOR HP : 2 HP

- GENERAL NOTES:
- FOR SYMBOLS AND LEGEND, SEE DRAWINGS 24915-00-M6-00-00010 THRU 00015.
 - DRAWING NUMBERS IN OFF-PAGE CONNECTORS ARE TRUNCATED BY SUPPRESSING PROJECT NUMBER "24915" AND DOCUMENTS TYPE "M6". TWO LEADING ZEROS IN SEQUENCE NUMBER ARE NOT SHOWN.
 - ALL EQUIPMENT NUMBERS, INSTRUMENT TAG NUMBERS AND VALVE NUMBERS ARE PREFIXED "07" UNLESS OTHERWISE NOTED.
 - FOR CONVEYOR LAYOUT/LOCATION SEE MATERIALS HANDLING EQUIPMENT GENERAL ARRANGEMENT DRAWING 24915-07-MJ-00-00002.
 - INLET GATE AD-THS-0104 SHALL BE INTERLOCKED WITH OUTLET GATE AD-THS-0105 TO PREVENT IT FROM OPENING AFTER OUTLET GATE CLOSES UNTIL THE AIRLOCK HAS BEEN PURGED. AIRLOCK GATES ARE INTERLOCKED WITH A TIMER.
 - INSTRUMENTATION AND VALVING SHOWN ON HVAC DRAWING NUMBER 24915-07-M6-HVAC-00127.
 - CONVEYOR MOTOR IN FORWARD DIRECTION SHALL BE HARDWIRE INTERLOCKED WITH ZS 0037--- SWITCH ON SWING CONVEYOR MJ-THS-0103 TO PREVENT TRAY TRANSFER WHILE SWING CONVEYOR IS NOT AT NORTH-SOUTH ALIGNMENT.
 - UNLESS OTHERWISE NOTED, FCS INTERLOCK NUMBERS ARE PREFIXED WITH "07-THS-" AND FPS (OR Z) INTERLOCKS ARE PREFIXED WITH "07-FPS-".
 - GATE CLEAR SWITCHES (ZS 0010--A, ZS 0010--B, ZS 0023--B) SHOWN ON AIRLOCK GATES ARE PHYSICALLY LOCATED ON ADJACENT CONVEYORS.

This document has been reviewed for ITAR/EAR and no ITAR/EAR sensitive information was found. 17 Dec 2013

This document has been reviewed for OPSEC material, and none was found. 17 Dec 2013

TO H08670 & H08671
E52707-HVAC-0127

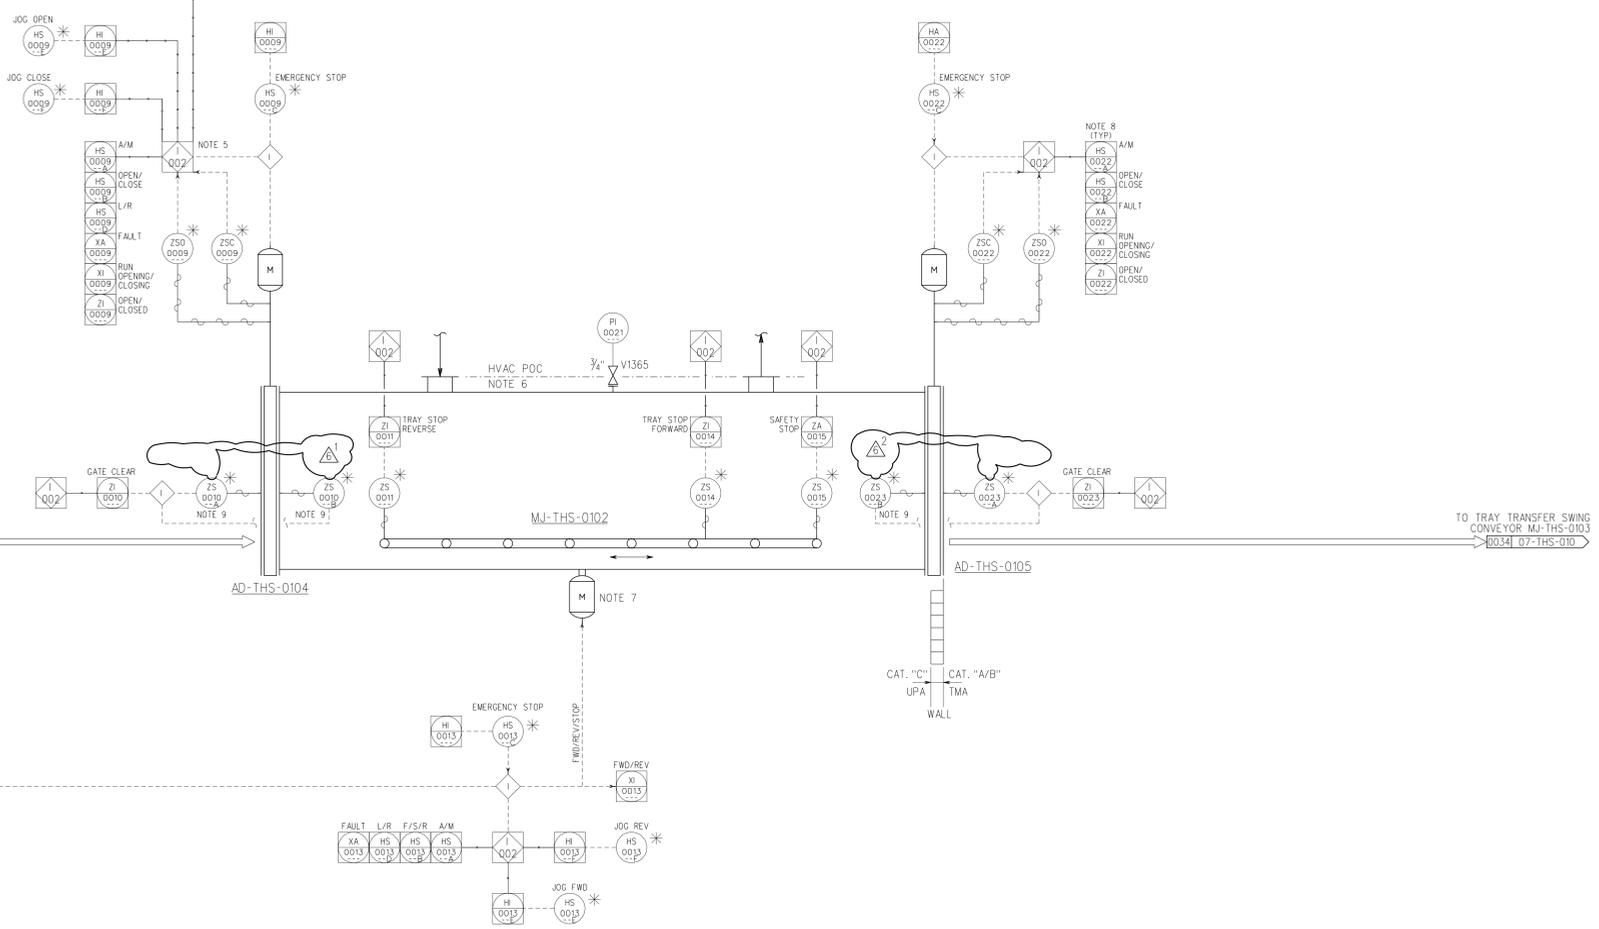

FROM TRAY INPUT CONVEYOR NO.2 MJ-THS-0104
00231 07-THS-008

TO TRAY TRANSFER SWING CONVEYOR MJ-THS-0103
00341 07-THS-010

FM ZS-0037--- TRAY TRANS. SWING CONV MJ-THS-0103 IN NORTH-SOUTH ALIGNMENT
00231 07-THS-010

NOTE 7 (FORWARD INTERLOCK)

NO.	DATE	DESCRIPTION	DR	CK	DL	PE	APVD

NO.	DATE	DESCRIPTION	DR	CK	DL	PE	APVD

BECHTEL PARSONS BLUE GRASS
DOD PROGRAM MANAGER FOR ASSEMBLED CHEMICAL WEAPONS ASSESSMENT EDGEWOOD, MARYLAND
US ARMY ENGINEERING AND SUPPORT CENTER, HUNTSVILLE HUNTSVILLE, ALABAMA

BLUE GRASS CHEMICAL AGENT DESTRUCTION PILOT PLANT PROJECT (BGCAPP)
RICHMOND, KENTUCKY
DAAA09-03-D-0023

MUNITIONS DEMILITARIZATION BUILDING TRAY INPUT AIRLOCK/CONVEYOR NO.1 PIPING & INSTRUMENT DIAGRAM

CONTRACT NO. DAAA09-03-D-0023
DRAWING NUMBER 24915-07-M6-THS-00009
SHEET 1 OF 1
REV 6



07MHS0102.dwg 02/23/12
DESIGN FILE: DONSPEC
PLOTTED BY: USER ON DATE: 02/23/12 AT 1:51:55 PM


MJ-THS-0103
 TRAY TRANSFER SWING CONVEYOR
 MOTOR HP (A) : 3 HP
 MOTOR HP (B) : 0.75 HP (SERVO)
 :
 :
 :
 :

MJ-THS-0104
 TRAY TRANSFER CONVEYOR NO.3
 MOTOR HP : 3 HP
 :
 :
 :
 :

- GENERAL NOTES:
- FOR SYMBOLS AND LEGEND, SEE DRAWINGS 24915-00-M6-00-00010 THRU 00015.
 - DRAWING NUMBERS IN OFF-PAGE CONNECTORS ARE TRUNCATED BY SUPPRESSING PROJECT NUMBER "24915" AND DOCUMENTS TYPE "M6". TWO LEADING ZEROS IN SEQUENCE NUMBER ARE NOT SHOWN.
 - ALL EQUIPMENT NUMBERS, INSTRUMENT TAG NUMBERS AND VALVE NUMBERS ARE PREFIXED "07" UNLESS OTHERWISE NOTED.
 - FOR CONVEYOR LAYOUT/LOCATION SEE MATERIALS HANDLING EQUIPMENT GENERAL ARRANGEMENT DRAWING 24915-07-MJ-00-00002.
 - CONVEYOR MOTOR SHALL BE HARDWIRE INTERLOCKED WITH ZS-0037--- SWITCH ON CONVEYOR MJ-THS-0103 TO PREVENT ITS MOTOR RUNNING EITHER IN FORWARD OR REVERSE DIRECTION WHILE CONVEYOR MJ-THS-0103 IS NOT ALIGNED.
 - SWING CONVEYOR MJ-THS-0103 SWING MOTOR "B" SHALL BE HARDWIRE INTERLOCKED WITH CONVEYOR MOTOR "A" TO PREVENT CONVEYOR ROLLERS TURNING WHILE SWING MOTOR IS OPERATING. ACTUATION OF ROPE SWITCHES WILL STOP THE SWING MOTOR AND CONVEYOR MOTOR.
 - UNLESS OTHERWISE NOTED, FCS INTERLOCK NUMBERS ARE PREFIXED WITH "07-THS-" AND FPS (OR Z) INTERLOCKS ARE PREFIXED WITH "07-FPS-".
 - TRAY TRANSFER SWING CONVEYOR MJ-THS-0103 LOCAL JOG OPEN AND CLOSE SWITCHES SHALL BE PROVIDED AND SHIPPED LOOSE BY THE CONVEYOR SUPPLIER. EASTSIDE AND WESTSIDE SWITCHES SHALL BE MOUNTED IN SEPARATE CONTROL BOXES.

This document has been reviewed for ITAR/EAR and no ITAR/EAR sensitive information was found. 17 Dec 2013

This document has been reviewed for OPSEC material, and none was found. 17 Dec 2013

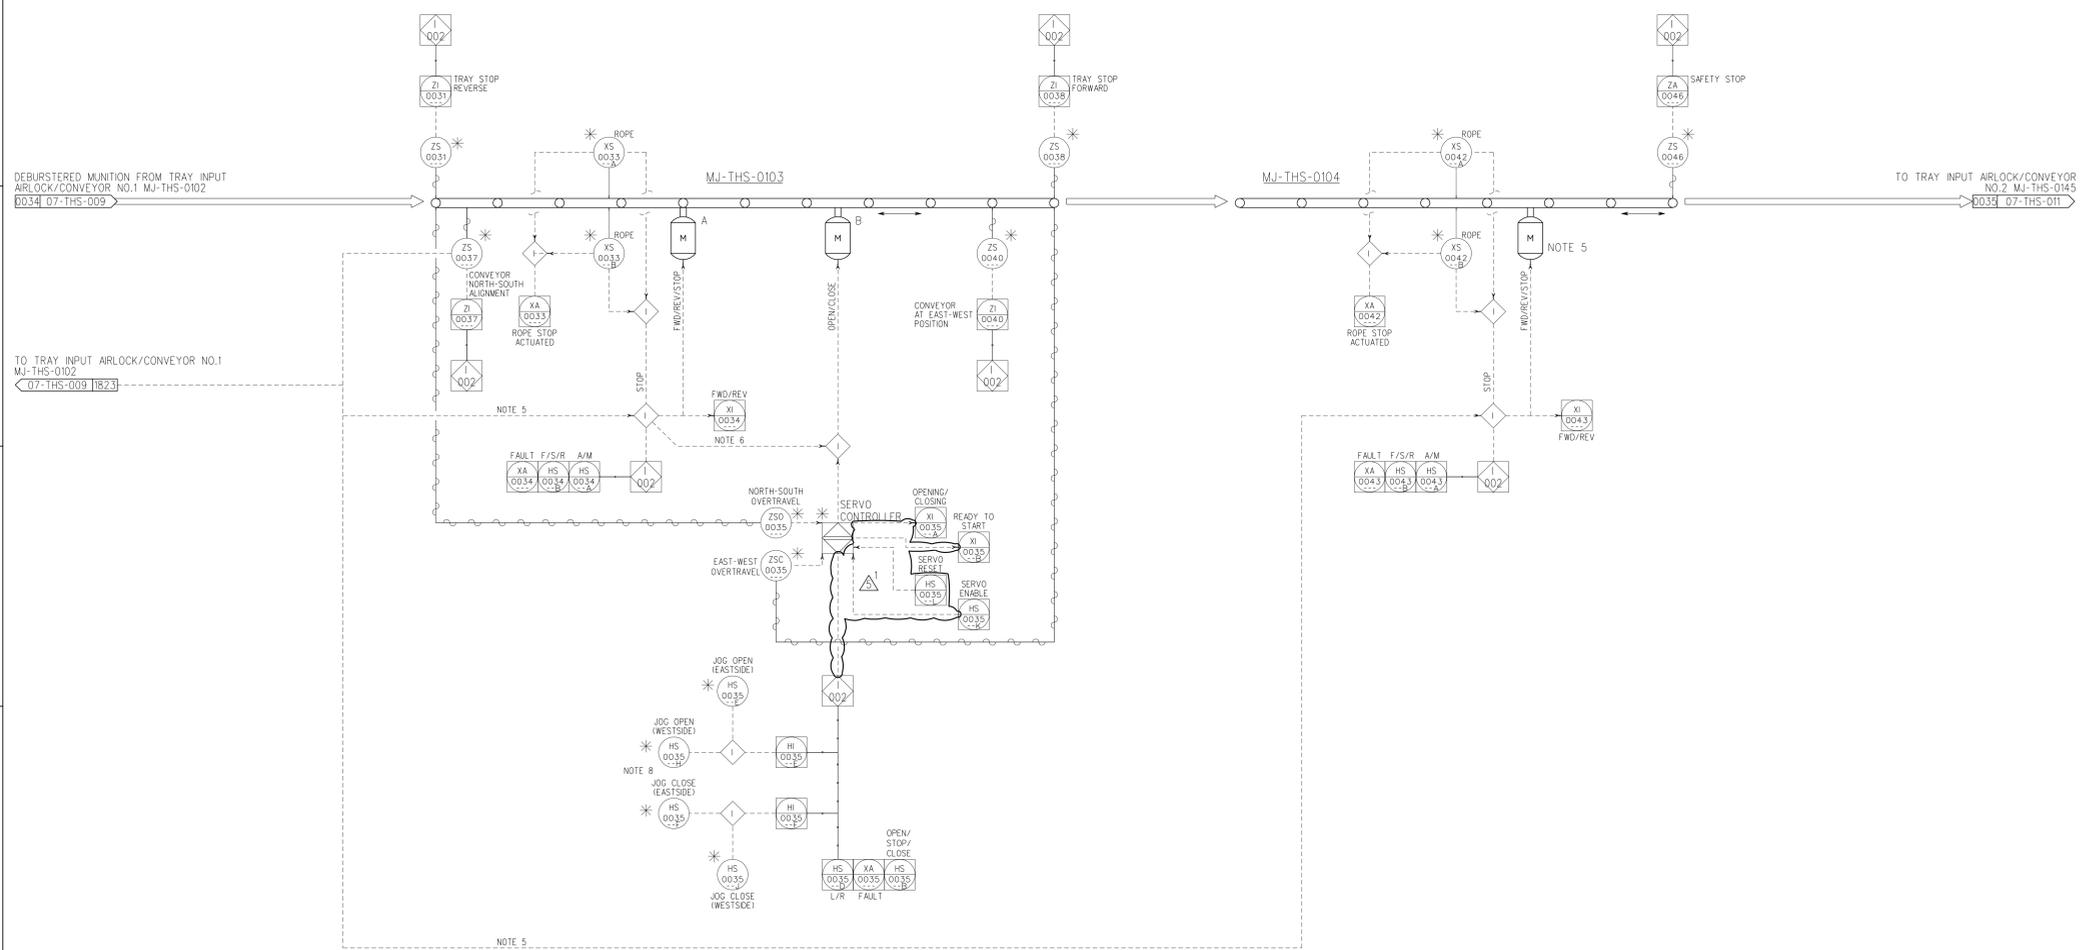

NO.	DATE	DESCRIPTION	DR	CK	DL	PE	APVD

NO.	DATE	DESCRIPTION	DR	CK	DL	PE	APVD

BECHTEL PARSONS BLUE GRASS
 DOD PROGRAM MANAGER FOR ASSEMBLED CHEMICAL WEAPONS ASSESSMENT EDGEMOOD, MARYLAND
 US ARMY ENGINEERING AND SUPPORT CENTER, HUNTSVILLE HUNTSVILLE, ALABAMA

BLUE GRASS CHEMICAL AGENT DESTRUCTION PILOT PLANT PROJECT (BCAPP)
 RICHMOND, KENTUCKY
 DAAA09-03-D-0023

MUNITIONS DEMILITARIZATION BUILDING TRAY TRANSFER CONVEYOR PIPING & INSTRUMENT DIAGRAM


CONTRACT NO. | SHEET 1 OF 1 | REV 5



07MTHS0104.dwg 02/23/12 DESIGN FILE: DONSPEC AT SYTIME USING COLORPLOT PLOTTED BY USER ON DATE: 02/23/12

MJ-THS-0118
PROJECTILE BUFFER CONVEYOR
MOTOR HP (A) 1.5 HP
MOTOR HP (B) 1.5 HP

- GENERAL NOTES:
- FOR SYMBOLS AND LEGEND, SEE DRAWINGS 24915-00-M6-00-00010 THRU 00015.
 - DRAWING NUMBERS IN OFF-PAGE CONNECTORS ARE TRUNCATED BY SUPPRESSING PROJECT NUMBER "24915" AND DOCUMENTS TYPE "M6". TWO LEADING ZEROS IN SEQUENCE NUMBER ARE NOT SHOWN.
 - ALL EQUIPMENT NUMBERS, INSTRUMENT TAG NUMBERS AND VALVE NUMBERS ARE PREFIXED "07" UNLESS OTHERWISE NOTED.
 - FOR CONVEYOR LAYOUT/LOCATION SEE MATERIALS HANDLING EQUIPMENT GENERAL ARRANGEMENT DRAWING 24915-07-MJ-00-00002.
 - CONVEYOR MOTOR AND POP-UP CONVEYOR MOTOR SHALL BE HARDWARE INTERLOCKED TO PREVENT SIMULTANEOUS OPERATION AND PULLING ANY OF THE ROPES SHALL STOP BOTH MOTORS FROM RUNNING.
 - ROLLER CONVEYOR MOTOR SHALL BE HARDWARE INTERLOCKED WITH ZS-1177--- SWITCH ON TURNTABLE MJ-THS-0106 TO PREVENT ITS MOTOR RUNNING IN FORWARD DIRECTION WHILE TURNTABLE IS NOT AT NORTH-SOUTH ORIENTATION.
 - UNLESS OTHERWISE NOTED, FCS INTERLOCK NUMBERS ARE PREFIXED WITH "07-THS-" AND FPS (OR Z) INTERLOCKS ARE PREFIXED WITH "07-FPS-".
 - LACK OF POWER TO SWITCHES ZSL-0857--- AND ZSH-0857--- SHALL PREVENT SOLENOID VALVE XY-0857--- FROM OPERATING.

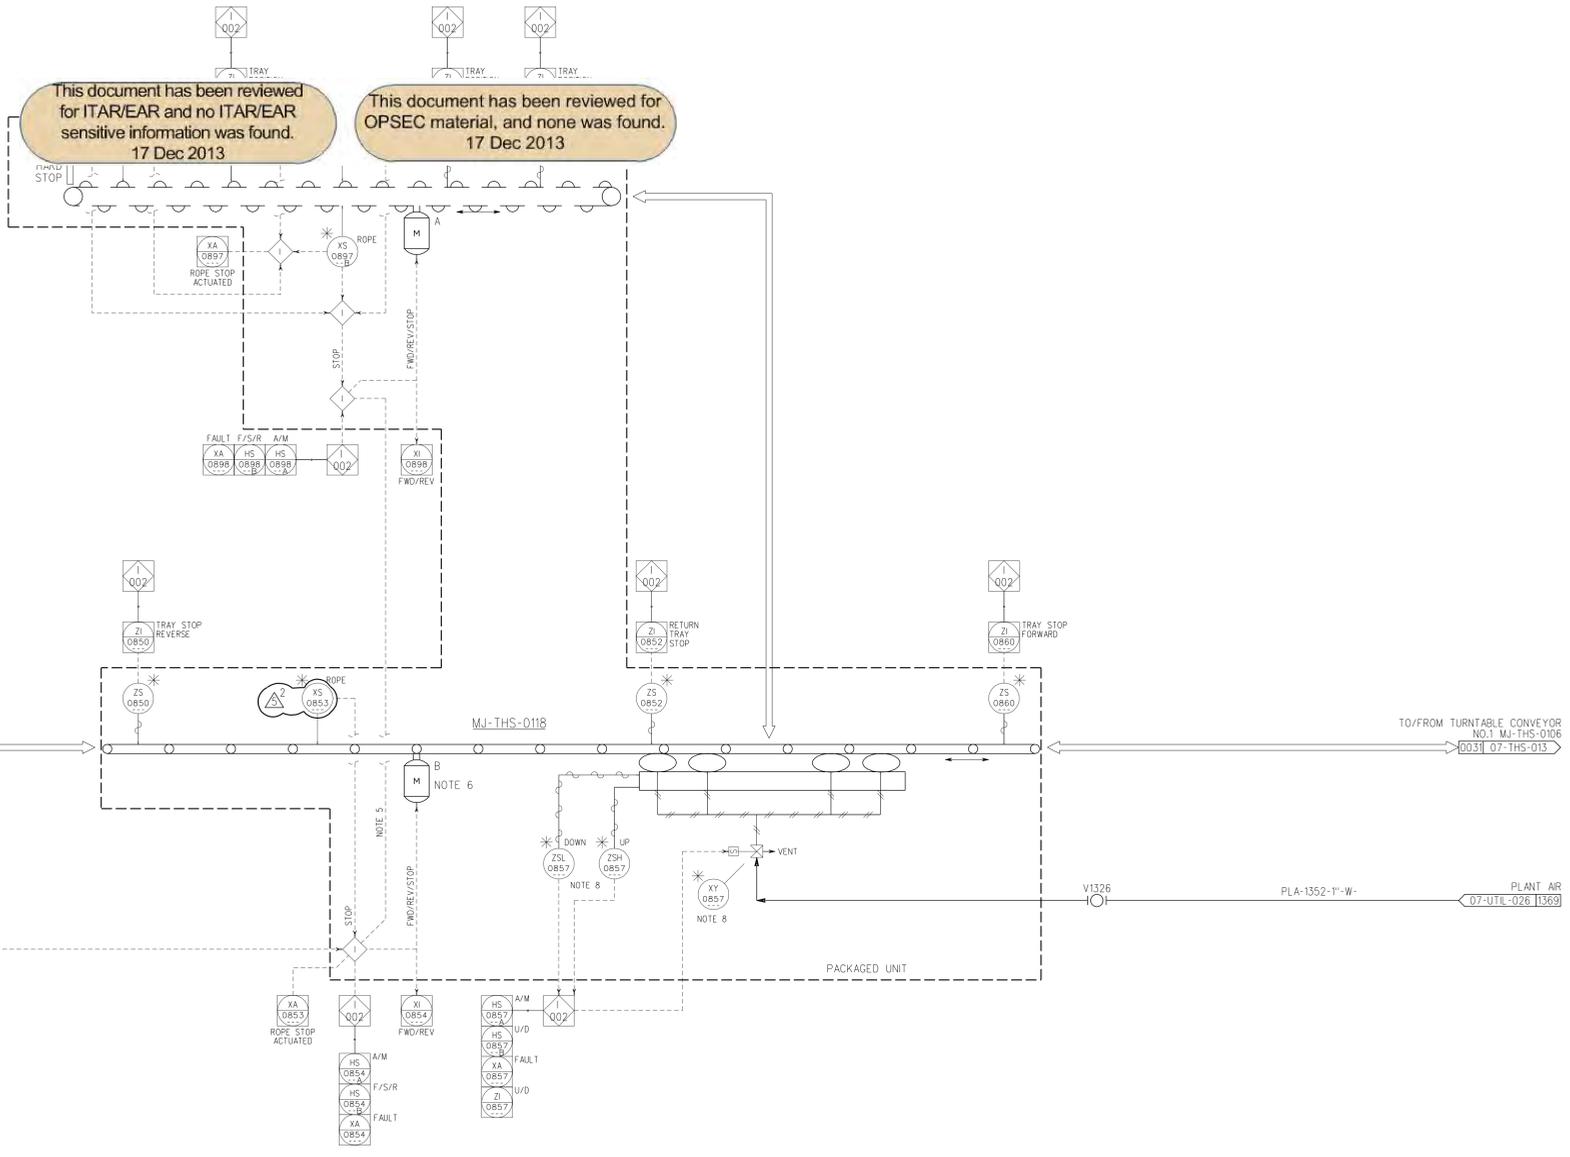

This document has been reviewed for ITAR/EAR and no ITAR/EAR sensitive information was found. 17 Dec 2013

This document has been reviewed for OPSEC material, and none was found. 17 Dec 2013

NO.	DATE	DESCRIPTION	DR	CK	DL	PE	APVD

NO.	DATE	DESCRIPTION	DR	CK	DL	PE	APVD
5	02/21/12	IFC, INCORPORATED DCN-689	GM	MDV	SA	BBB	BBB
4	07/22/09	IFC, INCORPORATED REVISED DESIGN REQUIREMENTS	PEB	JLL	BM	BBB	BBB
3	02/01/07	ISSUED FOR CONSTRUCTION (IFC), NO CHANGES	RZ	JLL	PEB	JB	BBB
2	11/15/06	IFD, ADDED GOV. COMMENTS & INTERLOCK TAG NO.	RZ	JLL	PEB	JB	BBB
1	05/05/06	ISSUED FOR DESIGN (IFD), ADD DESIGN DEVELOPMENT	RZ	JLL	PEB	JB	BBB
0	10/31/05	ISSUED FOR DESIGN (IFD)	RZ	JLL	PEB	JB	PKG

QUALITY 0 Non-0

BECHTEL PARSONS BLUE GRASS	DDO PROGRAM MANAGER FOR ASSEMBLED CHEMICAL WEAPONS ASSESSMENT EDgewood, MARYLAND	US ARMY ENGINEERING AND SUPPORT CENTER, HUNTSVILLE, ALABAMA
---	--	---

BLUE GRASS CHEMICAL AGENT DESTRUCTION PILOT PLANT PROJECT (BGCAPP)
RICHMOND, KENTUCKY
DAAA09-03-D-0023

MUNITIONS DEMILITARIZATION BUILDING
PROJECTILE BUFFER CONVEYOR
PIPING & INSTRUMENT DIAGRAM

CONTRACT NO. |
DRAWING NUMBER 24915-07-M6-THS-00012 SHEET 1 OF 1 REV 5




07MTHS0118.dwg 02/23/12
DESIGN FILE: DONSPEC
PLOTTED BY: USER ON DATE: 02/23/12 AT 5:11 PM

MJ-THS-0106
 TURNTABLE CONVEYOR NO.1
 MOTOR HP (A) : 3 HP
 MOTOR HP (B) : 0.75 HP

- GENERAL NOTES:
- FOR SYMBOLS AND LEGEND, SEE DRAWINGS 24915-00-M6-00-00010 THRU 00015.
 - DRAWING NUMBERS IN OFF-PAGE CONNECTORS ARE TRUNCATED BY SUPPRESSING PROJECT NUMBER "24915" AND DOCUMENTS TYPE "M6". TWO LEADING ZEROS IN SEQUENCE NUMBER ARE NOT SHOWN.
 - ALL EQUIPMENT NUMBERS, INSTRUMENT TAG NUMBERS AND VALVE NUMBERS ARE PREFIXED "07" UNLESS OTHERWISE NOTED.
 - FOR CONVEYOR LAYOUT/LOCATION SEE MATERIAL HANDLING EQUIPMENT GENERAL ARRANGEMENT DRAWING 24915-07-MJ-00002.
 - MOTOR SHALL BE PROVIDED WITH INTEGRAL BRAKE.
 - DELETED.
 - CONVEYOR MOTOR AND TURNTABLE MOTOR SHALL BE HARDWIRE INTERLOCKED TO PREVENT SIMULTANEOUS OPERATION.
 - WARNING LIGHT IS INTERLOCKED TO TURN ON 10 SECONDS BEFORE TURNTABLE MOTOR STARTS AND TURN OFF WHEN MOTOR STOPS.
 - A FLOOR MOUNTED HARD STOP SHALL BE PROVIDED ON THE SOUTH END OF TURNTABLE.
 - CONVEYOR MOTOR SHALL BE HARDWIRE INTERLOCKED WITH ZS-1176--- AND ZS-1177--- SWITCHES TO PREVENT ITS MOTOR FROM RUNNING WHILE TURNTABLE IS NOT ALIGNED IN EITHER EAST-WEST OR NORTH-SOUTH DIRECTIONS.
 - UNLESS OTHERWISE NOTED, FCS INTERLOCK NUMBERS ARE PREFIXED WITH "07-THS-" AND FPS (OR Z) INTERLOCKS ARE PREFIXED WITH "07-FPS-".
 - VENDOR SHALL PROVIDE THE REQUIRED PROGRAMMING TO REDUCE THE VFD SPEED ONCE EITHER OF THE REDUNDANT SLOW SPEED SWITCHES ASSOCIATED WITH THE ALIGNMENT IS ACTIVATED. WHEN THE TABLE IS SLOWING DOWN AND REACHES THE NORTH-SOUTH OR EAST-WEST ALIGNMENT SWITCH, FCS WILL COMMAND THE TABLE TO STOP. VENDOR SHALL ALSO PROVIDE THE SAFETY HARD STOP WITH SPRING TO ELIMINATE DAMAGE IN THE EVENT OF SENSOR FAILURE.

This document has been reviewed for ITAR/EAR and no ITAR/EAR sensitive information was found. 17 Dec 2013

This document has been reviewed for OPSEC material, and none was found. 17 Dec 2013

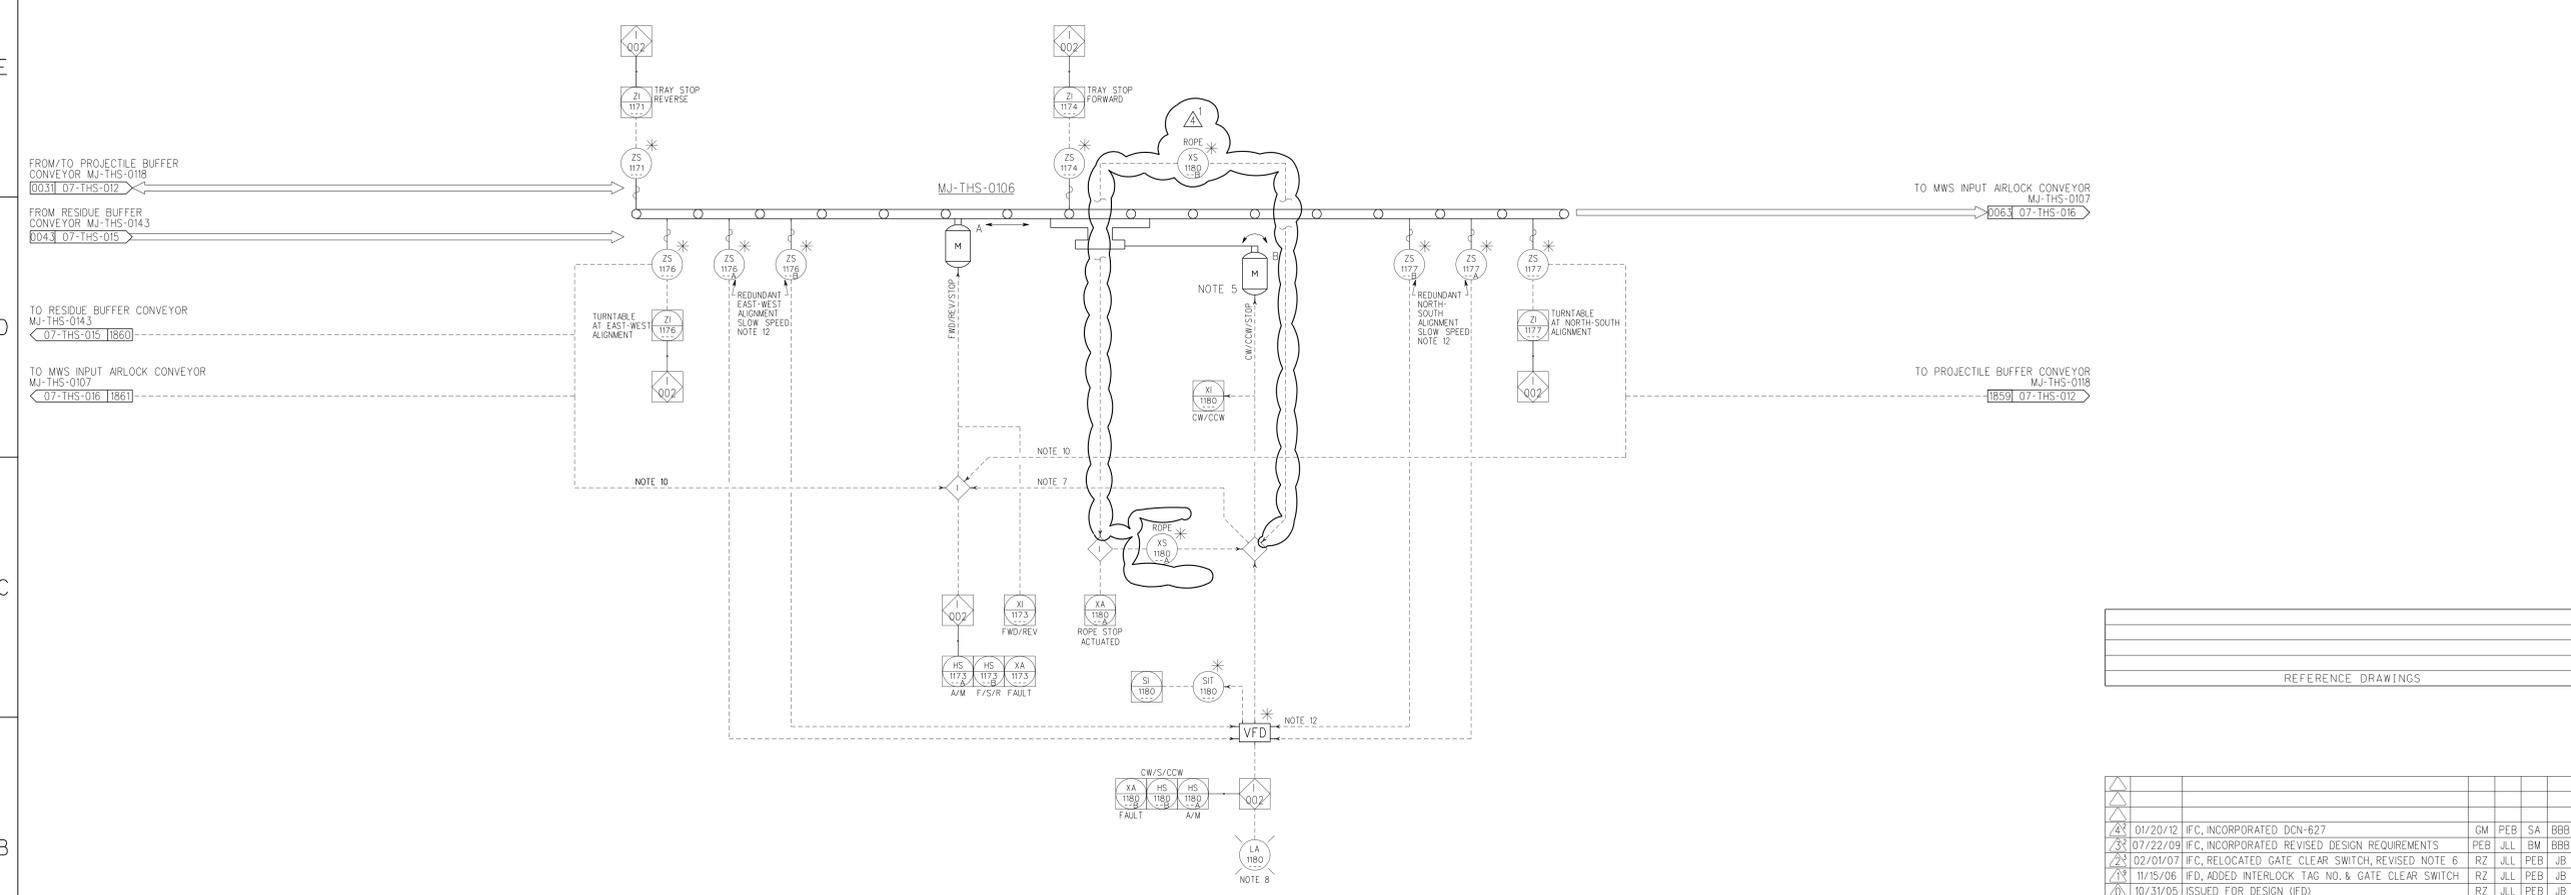

NO.	DATE	DESCRIPTION	DR	CK	DL	PE	APVD

NO.	DATE	DESCRIPTION	DR	CK	DL	PE	APVD

QUALITY 0 Non-0

BECHTEL PARSONS BLUE GRASS
 A joint venture of Bechtel Corporation, Inc. and Parsons Infrastructure & Technology Group, Inc.

DDO PROGRAM MANAGER FOR ASSEMBLED CHEMICAL WEAPONS ASSESSMENT EDgewood, MARYLAND

US ARMY ENGINEERING AND SUPPORT CENTER, HUNTSVILLE HUNTSVILLE, ALABAMA

BLUE GRASS CHEMICAL AGENT DESTRUCTION PILOT PLANT PROJECT (BGCAPP)
 RICHMOND, KENTUCKY
 DAAA09-03-D-0023

MUNITIONS DEMILITARIZATION BUILDING
 TURNTABLE CONVEYOR NO.1
 PIPING & INSTRUMENT DIAGRAM

CONTRACT NO. | SHEET | REV
 DRAWING NUMBER 24915-07-M6-THS-00013 | 1 OF 1 | 4



07MTHS0106.dwg 01/20/12
 DESIGN FILE: DONSPEC
 PLOTTED BY: USER ON DATE: 1/20/12 11:17:13 AM

AD-THS-0106 NOTE 7
MWS INPUT AIRLOCK IN-GATE
MOTOR HP (A) : 2 HP

MJ-THS-0107
MWS INPUT AIRLOCK CONVEYOR
MOTOR HP (B) : 3 HP
TRIM : TRM-1895-0"-A-


AD-THS-0107
MWS INPUT AIRLOCK OUT-GATE
MOTOR HP (C) : 2 HP

- GENERAL NOTES:
- FOR SYMBOLS AND LEGEND, SEE DRAWINGS 24915-00-M6-00-00010 THRU 00015.
 - DRAWING NUMBERS IN OFF-PAGE CONNECTORS ARE TRUNCATED BY SUPPRESSING PROJECT NUMBER "24915" AND DOCUMENTS TYPE "M6". TWO LEADING ZEROS IN SEQUENCE NUMBER ARE NOT SHOWN.
 - ALL EQUIPMENT NUMBERS, INSTRUMENT TAG NUMBERS AND VALVE NUMBERS ARE PREFIXED "07" UNLESS OTHERWISE NOTED.
 - FOR CONVEYOR LAYOUT/LOCATION SEE MATERIALS HANDLING EQUIPMENT GENERAL ARRANGEMENT DRAWING 24915-07-MJ-00-00002.
 - AIRLOCK CONVEYOR MOTOR SHALL BE HARDWIRE INTERLOCKED WITH ZS 1176--- SWITCH ON CONVEYOR MJ-THS-0106 TO PREVENT ITS MOTOR RUNNING IN REVERSE DIRECTION WHILE TURNABLE IS NOT AT EAST-WEST ALIGNMENT.
 - INSTRUMENTATION AND VALVING SHOWN ON HVAC DRAWING NUMBER 20915-07-M6-HVAC-00134.
 - INLET GATE AD-THS-0106 SHALL BE INTERLOCKED WITH OUTLET GATE AD-THS-0107 TO PREVENT IT FROM OPENING AFTER OUTLET GATE CLOSES UNTIL THE AIRLOCK HAS BEEN PURGED, AIRLOCK GATES ARE INTERLOCKED WITH A TIMER.
 - UNLESS OTHERWISE NOTED, FCS INTERLOCK NUMBERS ARE PREFIXED WITH "07-THS-" AND FPS (OR Z) INTERLOCKS ARE PREFIXED WITH "07-FPS-".
 - GATE CLEAR SWITCHES (ZS 0087--B, ZS 0089--A, ZS 0089--B) SHOWN ON AIRLOCK GATES ARE PHYSICALLY LOCATED ON ADJACENT CONVEYORS.

This document has been reviewed for ITAR/EAR and no ITAR/EAR sensitive information was found. 17 Dec 2013

This document has been reviewed for OPSEC material, and none was found. 17 Dec 2013

TO HD8830 & HD8831
E52807-HVAC-0127

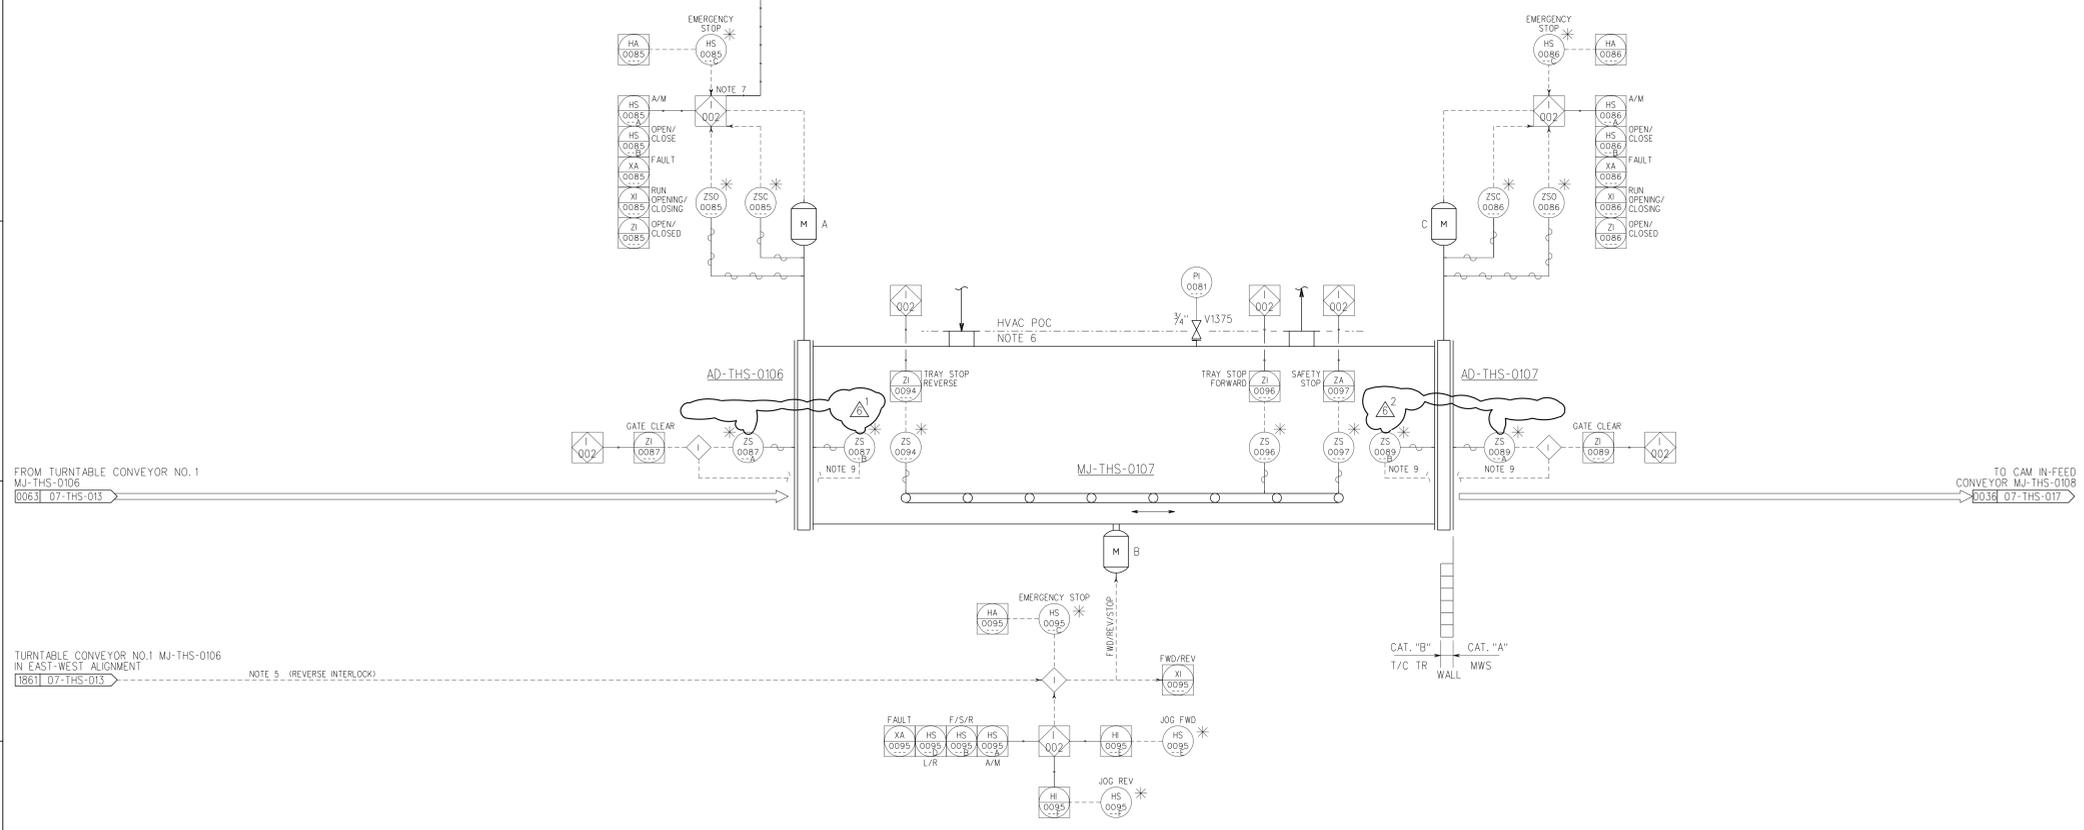

FROM TURNABLE CONVEYOR NO. 1
MJ-THS-0106
E063 07-THS-013

TO CAM IN-FEED
CONVEYOR MJ-THS-0108
E038 07-THS-017

TURNABLE CONVEYOR NO.1 MJ-THS-0106
IN EAST-WEST ALIGNMENT


NO.	DATE	DESCRIPTION	DR	CK	DL	PE	APVD

NO.	DATE	DESCRIPTION	DR	CK	DL	PE	APVD
63	02/21/12	IFC, INCORPORATED DCN-689	GM	MDV	SA	BBB	BBB
64	07/01/10	IFC, INCORPORATED DCR-138	PEB	GM	SA	BBB	BBB
43	07/22/09	IFC, INCORPORATED REVISED DESIGN REQUIREMENTS	PEB	JLL	BM	BBB	BBB
38	02/01/07	IFC, CLARIFY INSTRUMENTS SUPPLIED W/ EQUIPMENT	RZ	JLL	PEB	JB	BBB
28	11/15/06	IFD, ADDED INTERLOCK TAG NO. & GATE CLEAR SWITCH	RZ	JLL	PEB	JB	BBB
17	05/05/06	ISSUED FOR DESIGN (IFD), ADD DESIGN DEVELOPMENT	RZ	JLL	PEB	JB	BBB
16	10/31/05	ISSUED FOR DESIGN (IFD)	RZ	JLL	PEB	JB	PKG

QUALITY 0 Non-0

BECHTEL PARSONS BLUE GRASS
A Joint Venture of Bechtel Technology, Inc. and Parsons Infrastructure & Technology Group, Inc.

DDO PROGRAM MANAGER FOR ASSEMBLED CHEMICAL WEAPONS ASSESSMENT EDgewood, MARYLAND

US ARMY ENGINEERING AND SUPPORT CENTER, HUNTSVILLE HUNTSVILLE, ALABAMA

BLUE GRASS CHEMICAL AGENT DESTRUCTION PILOT PLANT PROJECT (BGCAPP)
RICHMOND, KENTUCKY
DAAA09-03-D-0023

CONTRACT NO. | MUNITIONS DEMILITARIZATION BUILDING MWS INPUT AIRLOCK/CONVEYOR PIPING & INSTRUMENT DIAGRAM

DRAWING NUMBER 24915-07-M6-THS-00016 SHEET 1 OF 1 REV 6

DRAWING CONTAINS PE SEAL ORIGINAL ON FILE
PROFESSIONAL STAMP


07MTHS0106.pdf 02/23/12 DESIGN FILE: DONSPEC AT SYTIME USING COLORPLOT PLOTTED BY USER ON DATE: 02/23/12

MJ-THS-0132
 TRAY TRANSFER COOLING CONVEYOR LN-2
 MOTOR HP (A) 1.5 HP
 MOTOR HP (B) 1.5 HP

- GENERAL NOTES:
- FOR SYMBOLS AND LEGEND, SEE DRAWINGS 24915-00-M6-00-00010 THRU 00015.
 - DRAWING NUMBERS IN OFF-PAGE CONNECTORS ARE TRUNCATED BY SUPPRESSING PROJECT NUMBER "24915" AND DOCUMENTS TYPE "M6". TWO LEADING ZEROS IN SEQUENCE NUMBER ARE NOT SHOWN.
 - ALL EQUIPMENT NUMBERS, INSTRUMENT TAG NUMBERS AND VALVE NUMBERS ARE PREFIXED "07" UNLESS OTHERWISE NOTED.
 - FOR CONVEYOR LAYOUT/LOCATION SEE MATERIALS HANDLING EQUIPMENT GENERAL ARRANGEMENT DRAWING 24915-07-MJ-00-00002.
 - CONVEYOR MOTOR AND POP-UP CONVEYOR MOTOR ARE HARDWIRE INTERLOCKED TO PREVENT SIMULTANEOUS OPERATION AND PULLING ANY OF THE ROPES SHALL STOP BOTH MOTORS FROM RUNNING.
 - UNLESS OTHERWISE NOTED, FCS INTERLOCK NUMBERS ARE PREFIXED WITH "07-THS-" AND FPS (OR Z) INTERLOCKS ARE PREFIXED WITH "07-FPS-".
 - LACK OF POWER TO SWITCHES ZSL-0407B-- AND ZSH-0407B-- SHALL PREVENT SOLENOID VALVE XY-0407B-- FROM OPERATING.

This document has been reviewed for ITAR/EAR and no ITAR/EAR sensitive information was found. 17 Dec 2013

This document has been reviewed for OPSEC material, and none was found. 17 Dec 2013

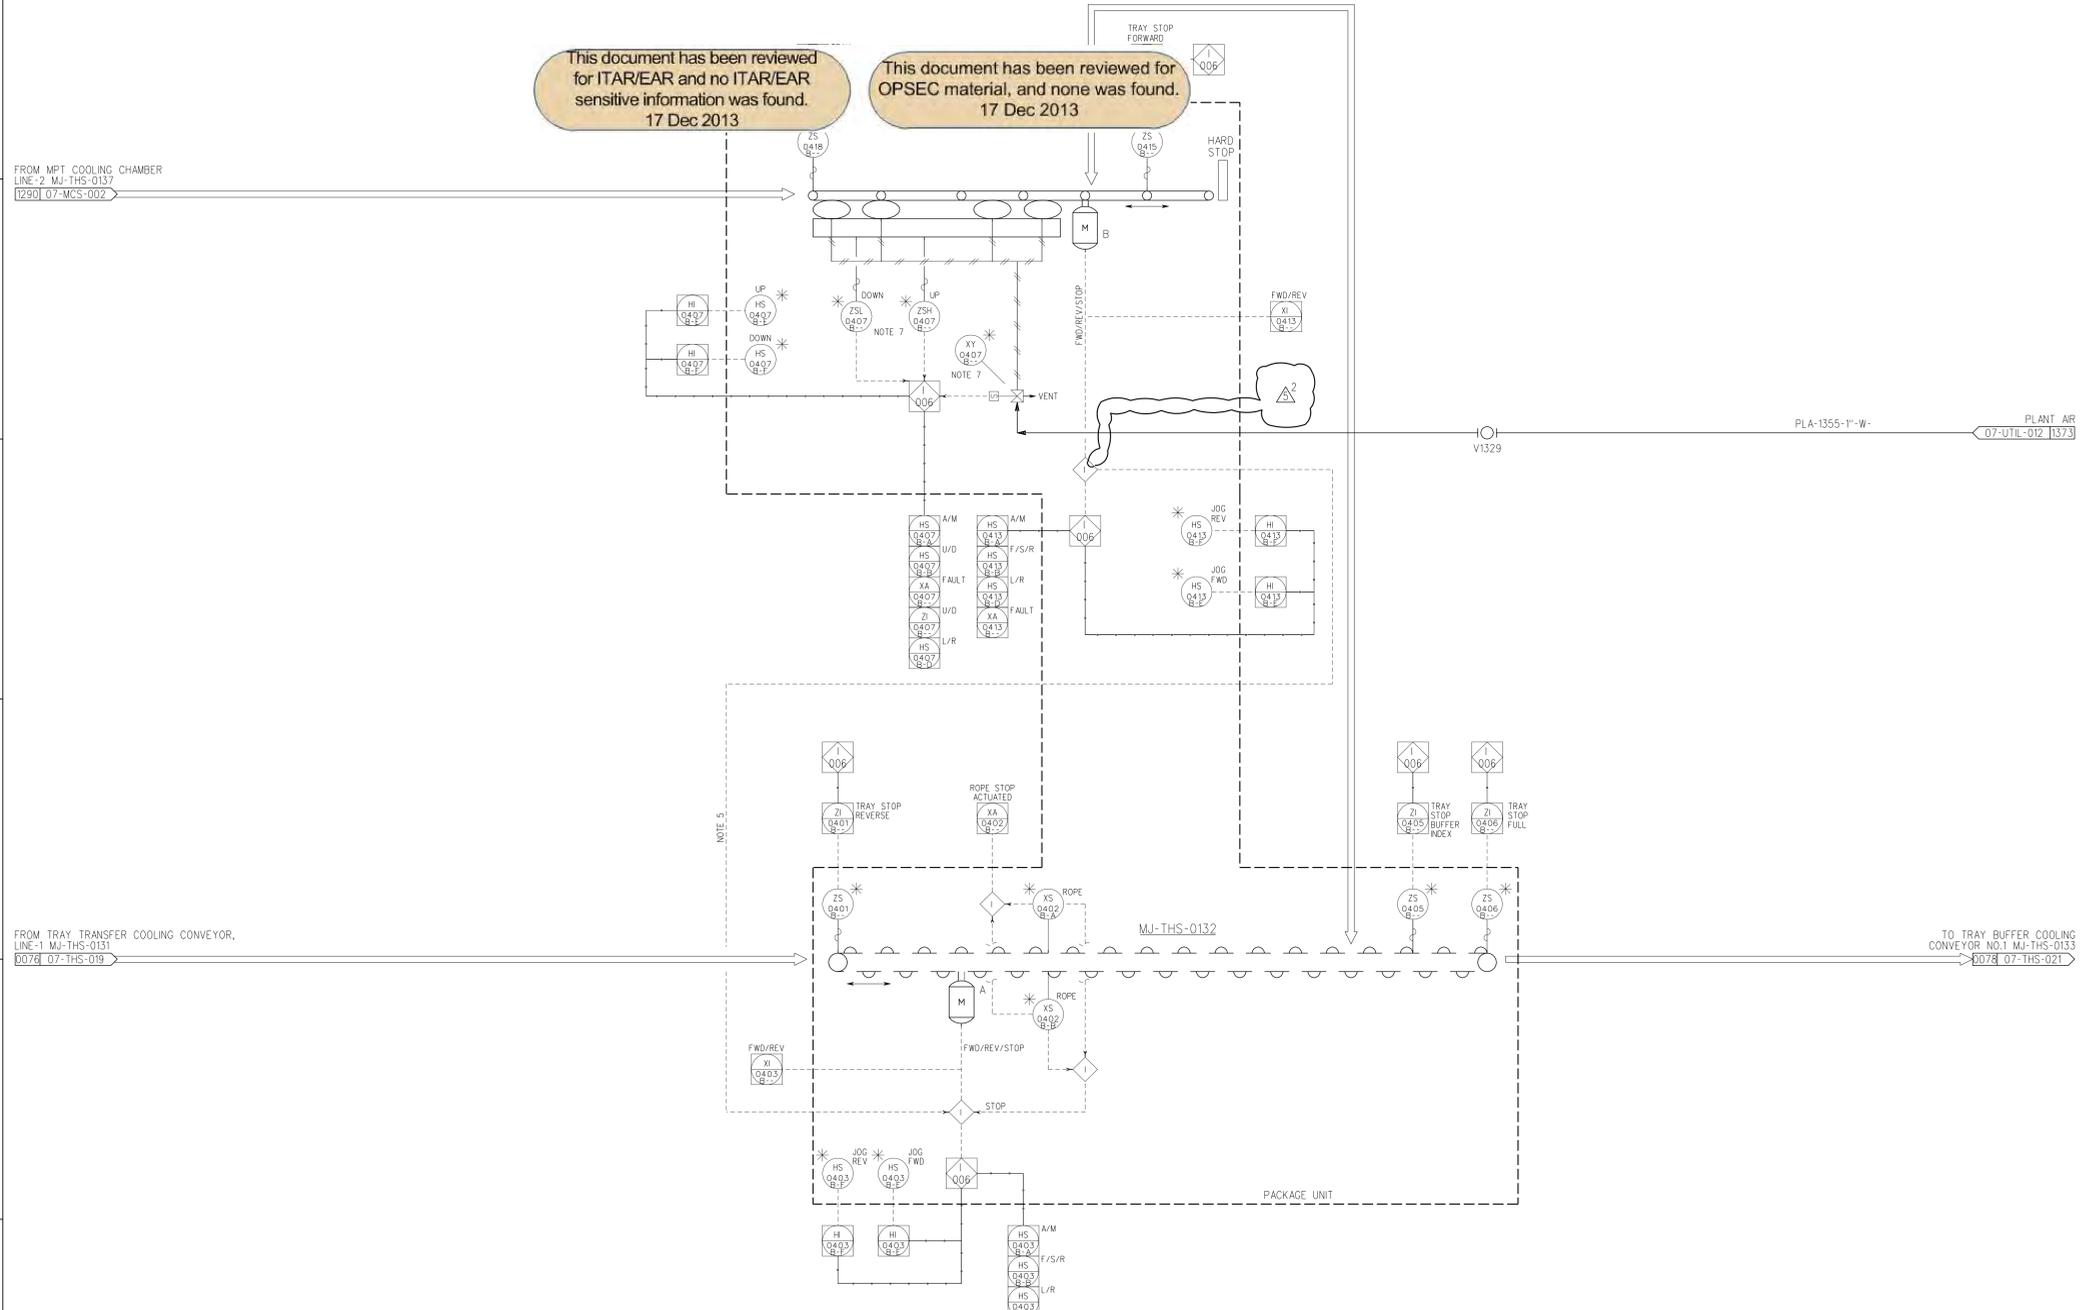

NO.	DATE	DESCRIPTION	DR	CK	DL	PE	APVD

NO.	DATE	DESCRIPTION	DR	CK	DL	PE	APVD
25	02/21/12	IFC, INCORPORATED DCN-689	GM	MDV	SA	BBB	BBB
23	07/22/09	IFC, INCORPORATED REVISED DESIGN REQUIREMENTS	PEB	JLL	BM	BBB	BBB
22	02/01/07	IFC, CLARIFY INSTRUMENTS SUPPLIED W/ EQUIPMENT	RZ	JLL	PEB	JB	BBB
21	11/15/06	ISSUED FOR DESIGN (IFD), ADDED INTERLOCK TAG NO.	RZ	JLL	PEB	JB	BBB
20	05/05/06	ISSUED FOR DESIGN (IFD), ADD DESIGN DEVELOPMENT	RZ	JLL	PEB	JB	BBB
19	10/31/05	ISSUED FOR DESIGN (IFD)	RZ	JLL	PEB	JB	PKG

BECHTEL PARSONS
BLUE GRASS
 A Joint Venture of Bechtel Technology, Inc. and Parsons Infrastructure & Technology Group, Inc.

DDO PROGRAM MANAGER FOR ASSEMBLED CHEMICAL WEAPONS ASSESSMENT EDGEMOOD, MARYLAND

US ARMY ENGINEERING AND SUPPORT CENTER, HUNTSVILLE HUNTSVILLE, ALABAMA

BLUE GRASS CHEMICAL AGENT DESTRUCTION PILOT PLANT PROJECT (BGCAPP)
 RICHMOND, KENTUCKY
 DAAA09-03-D-0023

MUNITIONS DEMILITARIZATION BUILDING TRAY TRANSFER COOLING CONVEYOR LN 2 PIPING & INSTRUMENT DIAGRAM

CONTRACT NO. | DRAWING NUMBER | SHEET | REV
 24915-07-M6-THS-00020 | 1 OF 1 | 5



07MTHS0020.rvt 02/23/12
 DESIGN FILE: DONSPEC AT SYTIME USING COLOR...
 PLOTTED BY: USER ON DATE...



A Joint Venture of Bechtel Parsons, Inc. and Parsons Infrastructure & Technology Group, Inc.

Project Number

24915

Document Number

24915-07-MTD-ACS-00001

Rev

1

Date

10/14/2009

Sheet of

1 9

Project, Client, Location

Blue Grass Chemical Agent-Destruction Pilot Plant (BGCAPP) Project

Document Title

AGENT HOLDING TANK MT-ACS-0105

- In-House Review
 Client Approval
 Quotation
 Purchase
 Construction
 Design

- All Data Sheets Attached
 Revised Data Sheets Only Attached

QUALITY:

Q

NON-Q

TOXIC CATEGORY

A

B

A/B

_____ OTHER

REV	DATE	BY	CHK	DL	PROJ ENGR	QA	APPR	REMARKS
0	02/25/09	SC	BM	BM	BBB	JW		Issued for Purchase
1	10/14/09	SC SC SC	SS SS	SA SA	BBB BBB	JW JW		Issued for Purchase (added pages 6 & 7 and completely revised page 5 to incorporate seismic data)

This sheet is a record of each issue or revision to the subject specification. Each time the specification is to be changed, only the new or revised sheets must be issued. The exact sheets changed and the nature of the change should be noted in the Remarks column; however, these remarks are not part of the specification. The revised data sheets shall become part of the original specification and shall be compiled within their entirety.




DATA SHEET

TITLE
 BGCAPP
 AGENT HOLDING TANK
 MT-ACS-0105

SHEET OF PROJECT NUMBER
 2 9 24915

DOCUMENT NUMBER REV
 24915-07-MTD-ACS-00001 1

HLL=7'-3"
 LLLL=0'-6"
 (NOTE 19)

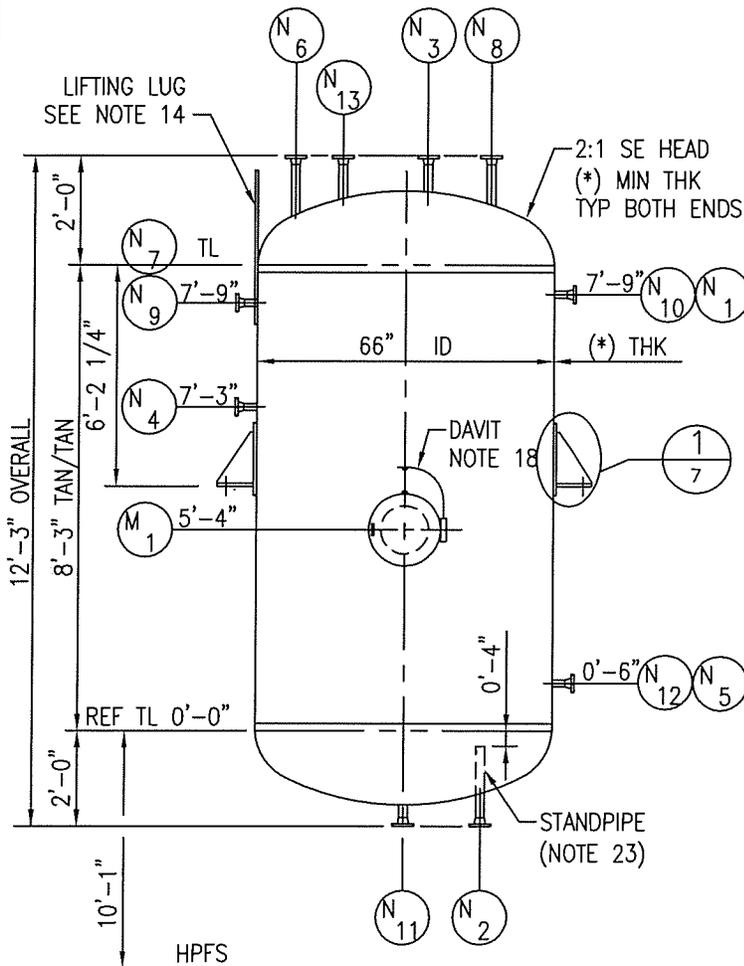

CODE:	ASME SECT VIII DIV 1 (CODE CONSTR. ONLY)	
CODE CERT REQD	NO	CODE STAMP NO
NATIONAL BOARD REGISTRATION:	NO	
OPR PRESS (INT)	0.2 PSIG AT	77 °F
DES PRESS. (INT)	14.9 PSIG AT	125 °F
DES PRESS. (EXT)	FULL VAC PSIG AT	125 °F
MIN DESIGN METAL TEMP (-)1 °F AT		14.9 PSIG
CRSN ALLOW SHELL =N/A HEADS =N/A NOZZ =N/A		
LIQUID LEVEL FOR DESIGN:	FULL	AT SP GR 1.29
SEISMIC DESIGN:	SEE NOTE 10	
WIND DESIGN:	SEE NOTE 11	
MAMP	(*) PSIG AT	125 °F LIMITED BY (*)
MAP N&C	(*) PSIG AT	AMB TEMP LIMITED BY (*)
SHOP HYD	(*) PSIG AT	70 °F MIN HORIZ POSN
FIELD HYD NEW	(*) PSIG AT	70 °F MIN OPR POSN
FIELD HYD CORR	(*) PSIG AT	70 °F MIN OPR POSN
PWHT	(PER CODE)	RADIOGRAPHY (FULL)
JOINT EFF: SHELL (PER CODE) HEADS (PER CODE)		
ALLOW STRESS	20,000 PSI AT DESIGN TEMP 125°F	

SHELL	SA-516-70 (SEE NOTE 20)	
HEADS	SA-516-70 (SEE NOTE 20)	
SUPPORTS	CS	
INTERNALS	N/A	TRAYS N/A
BOLTS (INT)	N/A	NUTS N/A
BOLTS (EXT)	SA-193-B7	NUTS SA-194-2H
FLANGES	SA-105	
NOZZLE NECKS	SA-106B	
GASKETS	NOTE 24	

CAPACITY (WORKING)	1000 GAL	
FAB WT (*) (NOTE 1&15) LB	EMPTY WT (*) (NOTE 1&15) LB	
TRAY WT	N/A LB	PACKING WT N/A LB
OPR WT (*) (NOTE 1&15) LB	TEST WT	(*) (NOTE 1&15) LB

PAINTING	SEE NOTE 12	
INSULATION	NONE	
FIREPROOFING	NONE	
ACCESSORIES BY FABRICATOR:	YES	NO
VESSEL DAVIT MARK No.		X
LADDER & PLATFORM CLIPS		X
PIPE SUPPORT AND PIPE GUIDE CLIPS		X
INSULATION SUPPORTS		X
FIREPROOFING SUPPORTS		X
VORTEX BREAKER		X
LIFTING AND GROUNDING LUGS	X	

NOZZLE SCHEDULE

ITEM	No.	SIZE	PROJ	RATING	SERVICE
M1	1	36"	3'-9"	150#	MH W/ BF & DAVIT
N1	1	2"	3'-5"	150#	INLET
N2	1	2"	SEE ELEV	150#	OUTLET
N3	1	8"	SEE ELEV	150#	LEVEL TRANSMITTER
N4	1	2"	3'-5"	150#	LSHH
N5	1	2"	3'-5"	150#	LSLL
N6	1	2"	SEE ELEV	150#	VENT/PURGE
N7	1	2"	3'-5"	150#	SPARE W/ BF
N8	1	2"	SEE ELEV	150#	AIR PURGE/DECON
N9	1	2"	3'-5"	150#	SPARE W/ BF
N10	1	3"	3'-5"	150#	PIT
N11	1	2"	SEE ELEV	150#	DRAIN
N12	1	2"	3'-5"	150#	SAMPLE CONNECTION
N13	1	6"	SEE ELEV	150#	PSV

ONE REQD MT-ACS-0105
 SEE SHEET 8 FOR TRUE ORIENTATION

FLANGE: RFWN FINISH: 125-250 AARH
 NOTE #7



DATA SHEET

TITLE
 BGCAPP
 AGENT HOLDING TANK
 MT-ACS-0105

SHEET 3	OF 9	PROJECT NUMBER 24915
DOCUMENT NUMBER 24915-07-MTD-ACS-00001		REV 1

NOTES

1. THE VESSEL SUPPLIER SHALL DESIGN, FURNISH, FABRICATE, INSPECT, TEST AND DELIVER THE VESSEL IN ACCORDANCE WITH THIS DATA SHEET, ATTACHED SPECIFICATIONS AND STANDARDS. VESSEL SHALL BE DESIGNED IN ACCORDANCE WITH SPECIFIED DESIGN REQUIREMENTS, SEE NOTES 10 AND 11.
2. ALL DIMENSIONS ARE FROM REF TANGENT LINE, EXCEPT AS SHOWN.
3. NOZZLES AND MANHOLE SHALL HAVE SAME DESIGNATION AS SHOWN ON THIS DRAWING.
4. BOLT HOLES SHALL STRADDLE THE VERTICAL CENTERLINES OF THE VESSEL FOR NOZZLES ON THE SHELL AND PLANT NORTH-SOUTH, EAST-WEST CENTERLINES FOR NOZZLES ON THE HEADS.
5. ALL ATTACHMENTS WELDED TO VESSEL PRESSURE PARTS SHALL BE SAME MATERIAL AS PRESSURE PART, UNLESS OTHERWISE NOTED.
6. VESSEL SHALL BE THOROUGHLY CLEANED INSIDE AND OUTSIDE, SHALL BE FREE FROM RUST, SCALE, SLAG, WELD SPLATTER AND FOREIGN MATTER PRIOR TO SHOP HYDROTEST, AND SHALL BE THOROUGHLY DRIED AFTER HYDROTEST.
7. PROJECTION OF RADIAL NOZZLES AND MANHOLES ARE FROM VESSEL CENTER LINE TO EXTREME FACE OF FLANGE.
8. ALL VESSEL COMPONENTS SHALL BE FURNISHED IN ACCORDANCE WITH STANDARDS LISTED BELOW.
9. ITEMS WITH (*) ARE VESSEL FABRICATOR RESPONSIBILITY.
10. SEISMIC FORCES SHALL BE PER SPECIFICATION 24915-000-3PS-SV00-00001, SPECIFICATION FOR SEISMIC PROTECTION OF EQUIPMENT. THE VESSEL IS LOCATED INSIDE THE MDB BUILDING (ANS ROOM 123). PER TABLE 1, APPLICABLE CODES AND IMPORTANCE FACTORS, SEISMIC PROTECTION SHALL BE IN ACCORDANCE WITH ICC INTERNATIONAL BUILDING CODE (IBC) 2000, SEISMIC DESIGN FOR BUILDINGS (SEISMIC GROUPS IIH AND IIE).
11. THE GENERAL PROJECT SPECIFICATION, 24915-000-3PS-G000-00001, PROVIDES PROJECT DETAILS AND DESIGN CONDITIONS FOR THE SITE. THIS VESSEL IS PART OF THE MUNITIONS DEMILITARIZATION BUILDING (MDB) AND IS INSTALLED INSIDE THE BUILDING (ROOM 123) AND WILL NOT BE SUBJECT TO SITE CONDITIONS SUCH AS WIND, PRECIPITATION, SNOW, ETC. OTHER GENERAL REQUIREMENTS FOR EQUIPMENT, MATERIAL, AND/OR SERVICES REQUIRED AS DEFINED IN THE SPECIFICATION APPLY.
12. ALL EXTERIOR BARE CARBON STEEL SURFACES SHALL BE PAINTED IN ACCORDANCE WITH SPECIFICATION 24915-000-3PS-AFPS-00001, SPECIAL COATINGS - METAL.
13. VESSEL SUPPLIER SHALL SUPPLY GROUNDING LUGS IN ACCORDANCE WITH STANDARD 24915-00-M0-00-00006. GROUNDING LUGS WITH DIMENSIONS SHALL BE CLEARLY CALLED OUT ON SUPPLIER DRAWINGS.
14. VESSEL SUPPLIER SHALL DESIGN AND INSTALL A MINIMUM OF TWO LIFTING LUGS FOR USE DURING LOADING, UNLOADING AND PLACING EQUIPMENT ON ITS FOUNDATION. DESIGN SHALL INCLUDE REQUIRED PIN, SHACKLE SIZE AND MAXIMUM SLOPE OF LIFTING CABLE AND LIFTING LUG PLANE. HOLE IN LIFTING LUG SHALL BE DRILLED OR MACHINED, DO NOT FLAME CUT. LIFTING LUG (AND PAD IF REQUIRED) SHALL BE THE SAME MATERIAL AS THE SHELL. LIFTING LUG SHALL NOT BE REMOVED AFTER INSTALLATION. EQUIPMENT SUPPLIER SHALL PERMANENTLY MARK ON THE LIFTING LUG WITH 1" MINIMUM HIGH LETTERS - "DO NOT REMOVE". SUPPLIER'S DRAWINGS SHALL PROVIDE LIFTING LUG DESIGN AND LOAD AND ANNOTATE EACH LUG WITH ITS LOAD CAPACITY.
15. VESSEL SUPPLIER SHALL PROVIDE FABRICATION, EMPTY, OPERATING, TEST AND INDIVIDUAL WEIGHTS OF HEAD, SHELL AND EQUIPMENT CENTER OF GRAVITY.
16. VESSEL SUPPLIER SHALL IDENTIFY ALL MATERIALS OF CONSTRUCTION (INCLUDING GASKETS) BY WEIGHT OR VOLUME.

STD NO.	DESCRIPTION	SPEC NO.	DESCRIPTION
24915-00-M0-00-00001	PRESSURE VESSEL TOLERANCES	24915-000-3PS-AFPS-00001	SPECIAL COATINGS - METAL
24915-00-M0-00-00002	STD BOLT HOLE ORIENT	24915-000-3PS-G000-00001	GENERAL PROJECT REQUIREMENTS
24915-00-M0-00-00004	VESSEL ABBREVIATIONS & SYMBOLS	24915-000-3PS-HXYQ-00001	QUALITY ASSURANCE
24915-00-M0-00-00006	GROUNDING CONN FOR VESSELS & TKS	24915-000-3PS-MV00-00001	PRESSURE VESSELS
		24915-000-3PS-NLLG-00001	INTERNAL TANK LINING
		24915-000-3PS-SV00-00001	SEISMIC PROTECTION OF EQUIP



DATA SHEET

TITLE

 BGCAPP
 AGENT HOLDING TANK
 MT-ACS-0105

SHEET OF

4

9

PROJECT NUMBER

24915

DOCUMENT NUMBER

24915-07-MTD-ACS-00001

REV

1

NOTES CONTINUED

17. ALL EXTERNAL BOLTS AND STUDS SHALL BE ASSEMBLED WITH ANTI-SEIZE LUBRICANT. SEE PRESSURE VESSEL SPECIFICATION.
18. VESSEL SUPPLIER SHALL DESIGN AND FABRICATE MANHOLE DAVIT FOR REMOVAL OF MANHOLE COVER.
19. LIQUID LEVELS ARE FROM BOTTOM TANGENT LINE, UNLESS OTHERWISE NOTED.
20. VESSEL FABRICATOR SHALL SPRAY OR LAMINATE LINE VESSEL IN ACCORDANCE WITH SPECIFICATION 24915-000-3PS-NLLG-00001, INTERNAL TANK LINING.
21. VESSEL FABRICATOR SHALL PREPARE ALL INTERNAL CARBON STEEL SURFACES FOR LINING PER NACE RP0178, FABRICATION DETAILS, SURFACE FINISH REQUIREMENTS, AND PROPER DESIGN CONSIDERATIONS FOR TANKS AND VESSELS TO BE LINED FOR IMMERSION SERVICE.
22. NOZZLES SMALLER THAN 2" SHALL BE HASTALLOY (UNS N10276). NOZZLES SMALLER THAN 2" CANNOT BE LINED.
23. STANDPIPE MATERIAL HASTALLOY (UNS N10276), 2" X.S. PIPE.
24. THREE SETS OF SPARE GASKETS FOR NOZZLES WITH BLIND FLANGES SHALL BE SUPPLIED BY VESSEL FABRICATOR. GASKETS SHALL BE FLAT RING, PTFE, 1/8" THK. CL150.
25. ALL BOLTS, NUTS AND WASHERS USED FOR EQUIPMENT IN TOXIC CATEGORIES "A" & "B" SHALL HAVE BOLTS NO SMALLER THAN 1/4". BOLTS ARE SIZED SO THAT PPE WEARERS CAN HANDLE THEM.
26. AGENT HOLDING TANK, MT-ACS-0105, IS REFERENCED ON P&ID 24915-07-M6-ACS-00003.




DATA SHEET

TITLE
 BGCAPP
 AGENT HOLDING TANK
 MT-ACS-0105

SHEET	OF	PROJECT NUMBER
5	9	24915

DOCUMENT NUMBER	REV
24915-07-MTD-ACS-00001	1

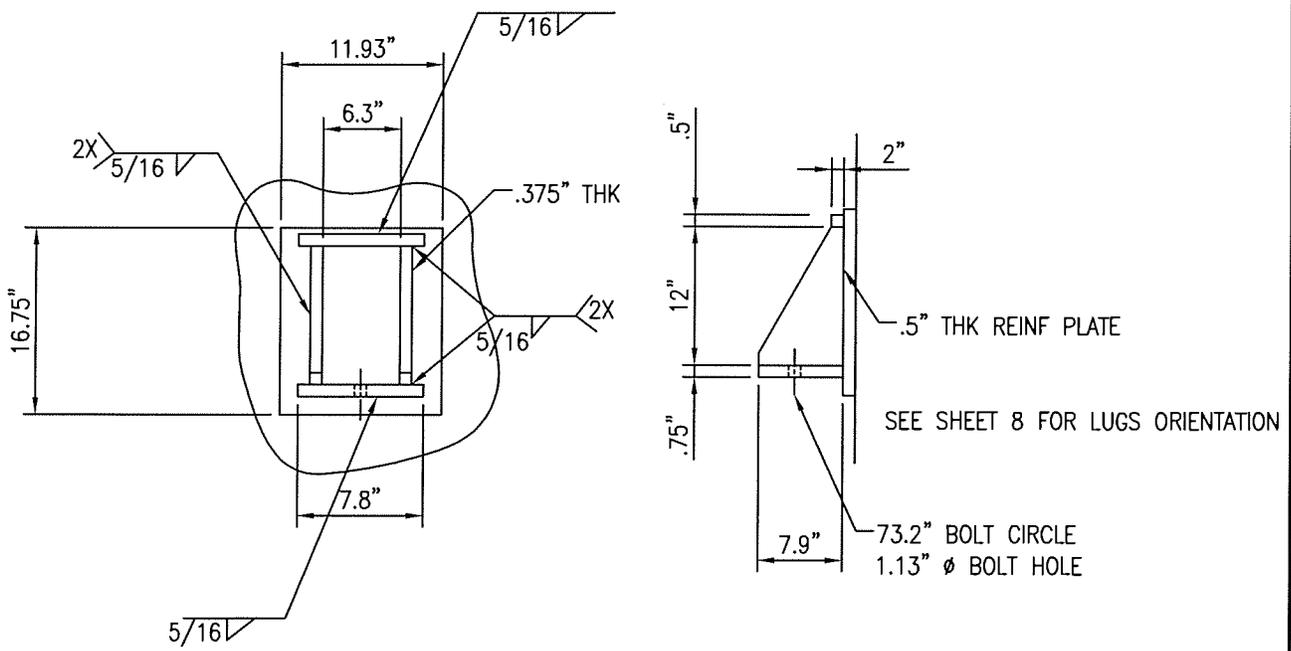

THE REINFORCING PAD WILL BE WELDED TO THE VESSEL SHELL ALL AROUND WITH A 3/8" WELD. REFER TO MANUFACTURER DRAWING FOR FULL LUG DETAILS.

DETAIL	1	REF
(4 REQ'D)		SHT 2



DATA SHEET

TITLE
 BGCAPP
 AGENT HOLDING TANK
 MT-ACS-0105

SHEET	OF	PROJECT NUMBER
6	9	24915
DOCUMENT NUMBER		REV
24915-07-MTD-ACS-00001		1

SEISMIC STRESSES IN SDS VESSELS SUPPORTED ON/FROM PLATFORMS

TABLE 1 SHOWS THE SEISMIC STRESSES (S11 AND S22) IN THE TWO ORTHOGONAL DIRECTIONS AT THE LOCATIONS SHOWN IN FIGURE 1 BASED OFF ORIGINAL VESSEL INFORMATION PROVIDED BY THE VENDOR. THESE STRESSES ACT IN BOTH TENSION AND COMPRESSION. THE SEISMIC STRESSES SHOWN IN TABLE 1 WERE COMBINED WITH THE ASME OPERATIONAL STRESSES BY THE VENDOR AND TABLE 3 SHOWS THE NECESSARY DESIGN CHANGE TO THE VESSELS FROM THE VENDOR TO ACCOUNT FOR THE SEISMIC STRESSES. THE BUYER HAS PERFORMED SEISMIC ANALYSIS ON THE UPDATED VESSEL INFORMATION (TABLE 3), AND DETERMINED THERE ARE NO INCREASES TO THE ACCELERATION OF THE CENTER OF GRAVITY OF THE VESSELS. THEREFORE, THE SEISMIC STRESSES IN TABLE 1 ARE A BOUNDING CONDITION PROVIDED THE VESSELS ARE FABRICATED AS DESCRIBED IN TABLE 3 AND LUGS DESIGNED AS SPECIFIED ON PAGE 5.

TABLE 1: S11 AND S22 SEISMIC STRESSES FOR MT-ACS-0105


LOCATION	S11 (KSI)	S22 (KSI)
TOP TANGENT LINE	1.0	1.0
BOTTOM TANGENT LINE	3.5	5.5
AT LUGS	27.0	25.5

Table 2: ACCELERATION OF COG FOR MT-ACS-0105

Vessel	Acceleration at COG (%g)		
	X	Y	Z
MT-ACS-0105	0.246	0.162	0.252
General Note:			
The 'X' direction is East-West			
The 'Y' direction is North-South			
The 'Z' direction is vertical			

* PLEASE NOTE THAT WHERE THESE ACCELERATIONS WILL PRODUCE LOWER LOADS THAN THOSE DERIVED FROM THE SEISMIC PROTECTION OF EQUIPMENT SPECIFICATION, THE VALUE FROM THE SEISMIC PROTECTION SPEC. IS TO BE USED FOR THE DESIGN OF THE VESSELS' INTERNALS AND ANCHORAGES OF THE VESSELS TO THE STEEL FRAME.

FIGURE 1: LOCATION & ORIENTATION OF STRESSES

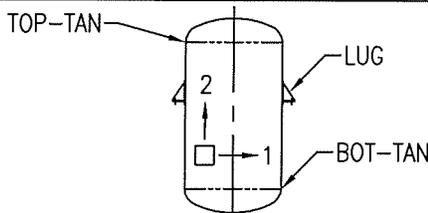



DATA SHEET

TITLE
 BGCAPP
 AGENT HOLDING TANK
 MT-ACS-0105


SHEET 7	OF 9	PROJECT NUMBER 24915
DOCUMENT NUMBER 24915-07-MTD-ACS-00001		REV 1

TABLE 3: UPDATED VESSEL INFORMATION FROM VENDOR


VESSEL TAG NO.	CENTER OF GRAVITY (IN) *			OPERATING WEIGHT (LBS)	SHELL THICKNESS (IN)	HEAD THICKNESS (IN)	SKIRT THICKNESS (IN)
	X	Y	Z				
MT-ACS-0105	0.02	-3.48	43.05	21,603	.5	.375	N/A

* THE CENTER OF GRAVITY IS BASED ON A STANDARD COORDINATE SYSTEM WITH REFERENCE TO PAGE 7. THE POSITIVE X,Y,Z DIRECTIONS ARE EAST, NORTH, AND UP THE VESSEL (OUT OF THE PAGE), RESPECTIVELY. THE ORIGIN IS AT THE INTERSECTION OF THE VESSEL CENTERLINE AND REFERENCE PLANE (LOWER TANGENT LINE).


FIGURE 2: MODEL SHOWING THE ANS PLATFORM

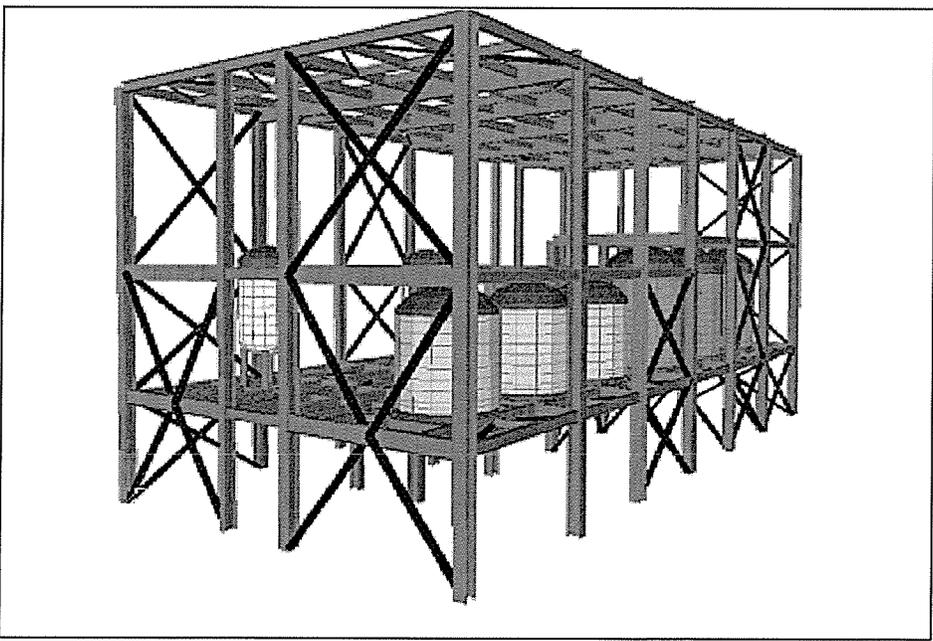

DATA SHEET	TITLE	BGCAPP AGENT HOLDING TANK 07-MT-ACS-0105	SHEET OF 8 9	PROJECT NUMBER 24915
				DOCUMENT NUMBER 24915-07-MTD-ACS-00001

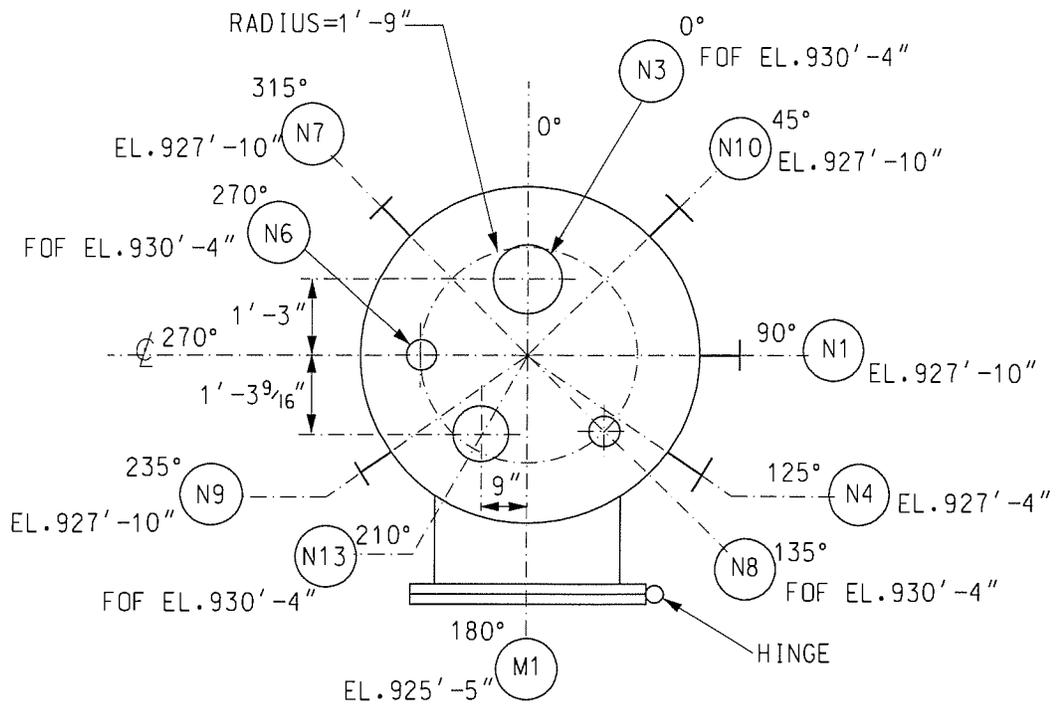


UPPER PLAN A REF. SHEET 9
8

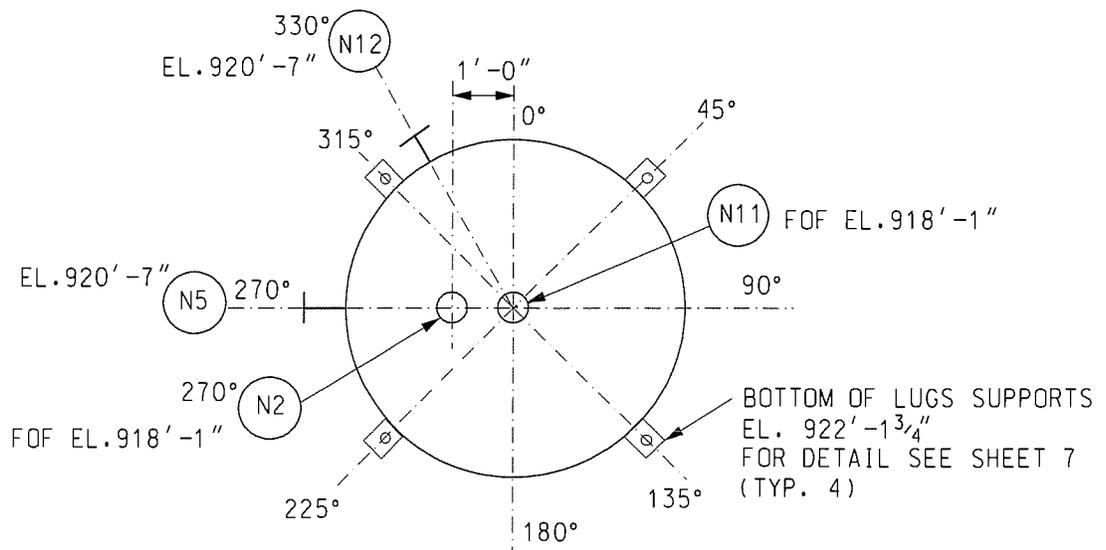

LOWER PLAN B REF. SHEET 9
8

DATA SHEET	TITLE	BGCAPP AGENT HOLDING TANK 07-MT-ACS-0105	SHEET	OF	PROJECT NUMBER
			9	9	24915
			DOCUMENT NUMBER		REV
			24915-07-MTD-ACS-00001		1

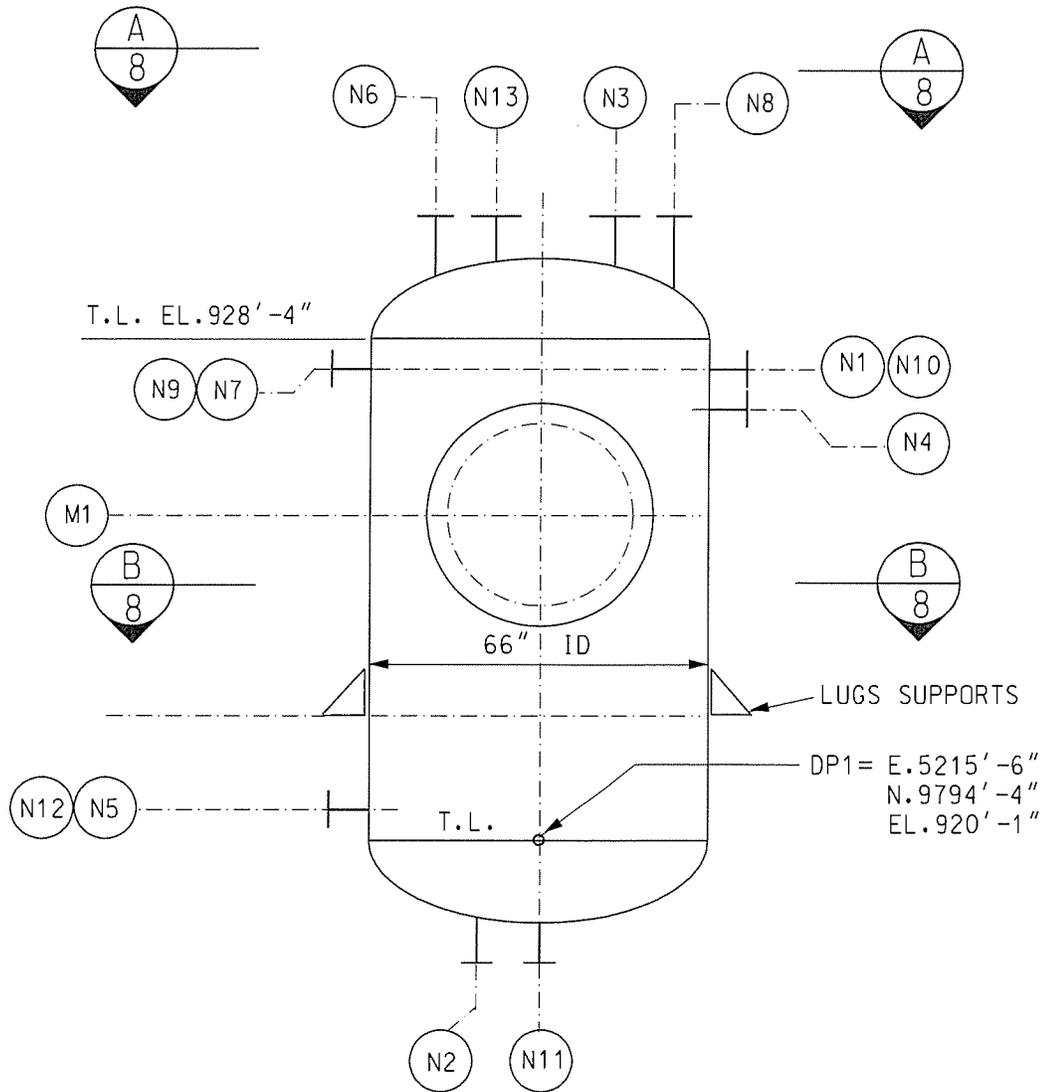

ELEVATION



A Joint Venture of Bechtel National, Inc. and Parsons Infrastructure & Technology Group Inc.

Project Number

24915

Document Number

24915-07-MTD-ACS-00002

Rev

1

Date

10/16/2009

Sheet of

1 9

Project, Client, Location

Blue Grass Chemical Agent-Destruction Pilot Plant (BGCAPP) Project

Document Title

AGENT SURGE TANK MT-ACS-0106

- In-House Review
 Client Approval
 Quotation
 Purchase
 Construction
 Design

- All Data Sheets Attached
 Revised Data Sheets Only Attached

QUALITY:

Q

NON-Q

TOXIC CATEGORY

A

B

A/B

_____ OTHER

REV	DATE	BY	CHK	DL	PROJ ENGR	QA	APPR	REMARKS
0	02/25/09	SC	BM	BM	BBB	JW		Issued for Purchase
1	10/16/09	SC	SS	SA	BBB	JW		Issued for Purchase (added pages 6 & 7 and completely revised page 5 to incorporate seismic data)

This sheet is a record of each issue or revision to the subject specification. Each time the specification is to be changed, only the new or revised sheets must be issued. The exact sheets changed and the nature of the change should be noted in the Remarks column; however, these remarks are not part of the specification. The revised data sheets shall become part of the original specification and shall be compiled within their entirety.




DATA SHEET

TITLE
BGCAPP
AGENT SURGE TANK
MT-ACS-0106

SHEET OF PROJECT NUMBER
2 9 24915

DOCUMENT NUMBER REV
24915-07-MTD-ACS-00002 1

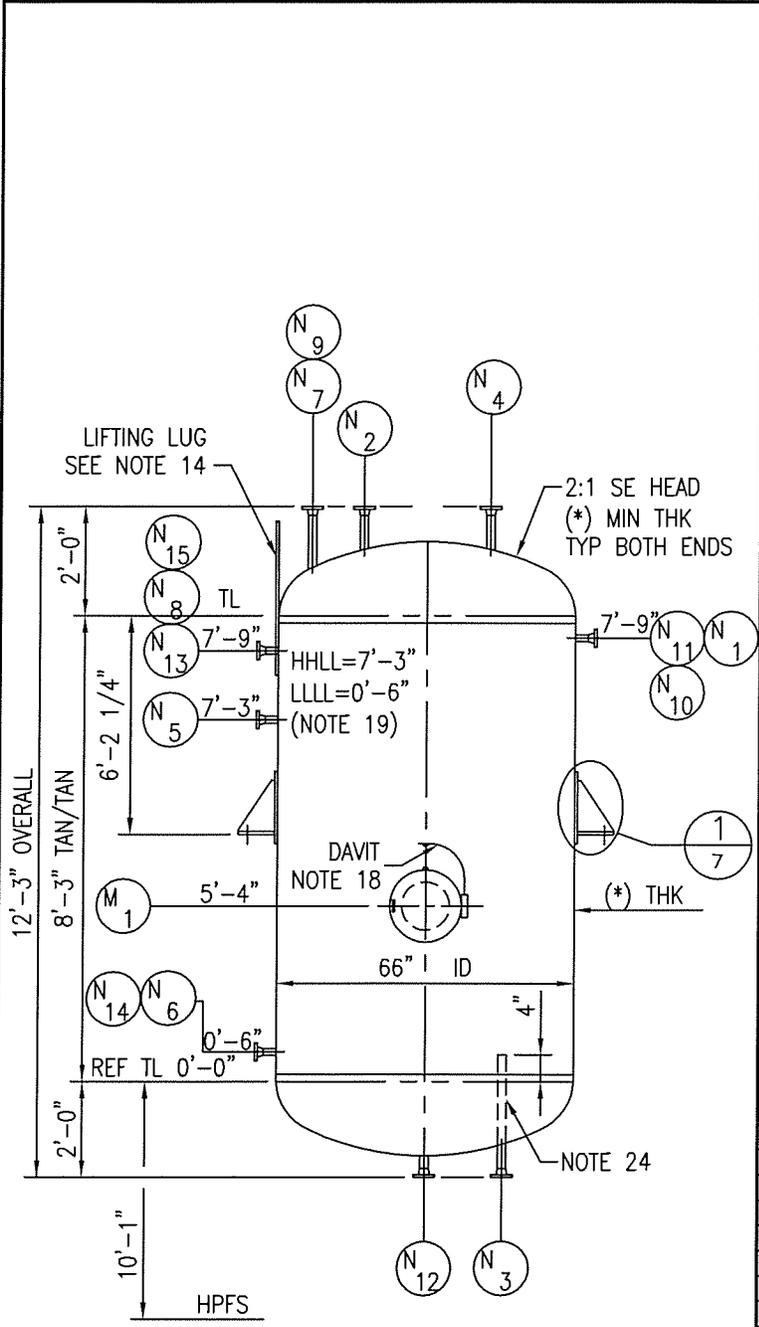

ONE REQD MT-ACS-0106
SEE SHEETS 8 AND 9 FOR TRUE ORIENTATION

CODE: ASME SECT VIII DIV 1 (CODE CONSTR. ONLY)	
CODE CERT REQD	NO CODE STAMP NO
NATIONAL BOARD REGISTRATION: NO	
OPR PRESS (INT)	0.02 PSIG AT 77 °F
DES PRESS. (INT)	14.9 PSIG AT 125 °F
DES PRESS. (EXT)	FULL VAC PSIG AT 125 °F
MIN DESIGN METAL TEMP	(-)-1 °F AT 14.9 PSIG
CRSN ALLOW SHELL	=N/A HEADS =N/A NOZZ =N/A
LIQUID LEVEL FOR DESIGN: FULL AT SP GR 1.29	
SEISMIC DESIGN: SEE NOTE 10	
WIND DESIGN: SEE NOTE 11	
MAWP (*) PSIG AT 125 °F LIMITED BY (*)	
MAP N&C (*) PSIG AT AMB TEMP LIMITED BY (*)	
SHOP HYD (*) PSIG AT 70 °F MIN HORIZ POSN	
FIELD HYD NEW (*) PSIG AT 70 °F MIN OPR POSN	
FIELD HYD CORR (*) PSIG AT 70 °F MIN OPR POSN	
PWHT (PER CODE) RADIOGRAPHY (FULL)	
JOINT EFF: SHELL (PER CODE) HEADS (PER CODE)	
ALLOW STRESS 20,000 PSI AT DESIGN TEMP 125°F	
SHELL	SA-516-70 (SEE NOTE 20)
HEADS	SA-516-70 (SEE NOTE 20)
SUPPORTS CS	
INTERNALS	N/A TRAYS N/A
BOLTS (INT)	N/A NUTS N/A
BOLTS (EXT)	SA-193-B7 NUTS SA-194-2H
FLANGES SA-105	
NOZZLE NECKS SA-106B	
GASKETS NOTE 23	
CAPACITY (WORKING) 1000 GAL	
FAB WT (*) (NOTE 1&15) LB	EMPTY WT (*) (NOTE 1&15) LB
TRAY WT	N/A LB PACKING WT N/A LB
OPR WT (*) (NOTE 1&15) LB	TEST WT (*) (NOTE 1&15) LB
PAINTING SEE NOTE 12	
INSULATION NONE	
FIREPROOFING NONE	
ACCESSORIES BY FABRICATOR:	YES NO
VESSEL DAVIT MARK No.	X
LADDER & PLATFORM CLIPS	X
PIPE SUPPORT AND PIPE GUIDE CLIPS	X
INSULATION SUPPORTS	X
FIREPROOFING SUPPORTS	X
VORTEX BREAKER	X
LIFTING AND GROUNDING LUGS	X

NOZZLE SCHEDULE					
ITEM	No.	SIZE	PROJ	RATING	SERVICE
M1	1	36"	3'-9"	150#	MH W/ BF & HINGE
N1	1	2"	3'-5"	150#	INLET - DRAINED AGENT
N2	1	6"	SEE ELEV	150#	PSV
N3	1	2"	SEE ELEV	150#	OUTLET
N4	1	8"	SEE ELEV	150#	LEVEL TRANS. (RADAR TYPE)
N5	1	2"	3'-5"	150#	LSHH
N6	1	2"	3'-5"	150#	LSLL
N7	1	2"	SEE ELEV	150#	VENT/PURGE
N8	1	2"	3'-5"	150#	SPARE W/ BF
N9	1	2"	SEE ELEV	150#	AIR PURGE/DECON
N10	1	2"	3'-5"	150#	INLET - AGENT CAT A SUMPS
N11	1	3"	3'-5"	150#	PIT
N12	1	2"	SEE ELEV	150#	DRAIN
N13	1	2"	3'-5"	150#	INLET - AGENT CAT B SUMPS
N14	1	2"	3'-5"	150#	SAMPLE CONNECTION
N15	1	2"	3'-5"	150#	SPARE W/ BF

FLANGE: RFWN FINISH: 125-250 AARH
NOTE #7



DATA SHEET

TITLE
 BGCAPP
 AGENT SURGE TANK
 MT-ACS-0106

SHEET OF PROJECT NUMBER
 3 9 24915

DOCUMENT NUMBER REV
 24915-07-MTD-ACS-00002 1

NOTES

1. THE VESSEL SUPPLIER SHALL DESIGN, FURNISH, FABRICATE, INSPECT, TEST AND DELIVER THE VESSEL IN ACCORDANCE WITH THIS DATA SHEET, ATTACHED SPECIFICATIONS AND STANDARDS. VESSEL SHALL BE DESIGNED IN ACCORDANCE WITH SPECIFIED DESIGN REQUIREMENTS, SEE NOTES 10 AND 11.
2. ALL DIMENSIONS ARE FROM REF TANGENT LINE, EXCEPT AS SHOWN.
3. NOZZLES AND MANHOLE SHALL HAVE SAME DESIGNATION AS SHOWN ON THIS DRAWING.
4. BOLT HOLES SHALL STRADDLE THE VERTICAL CENTERLINES OF THE VESSEL FOR NOZZLES ON THE SHELL AND PLANT NORTH-SOUTH, EAST-WEST CENTERLINES FOR NOZZLES ON THE HEADS.
5. ALL ATTACHMENTS WELDED TO VESSEL PRESSURE PARTS SHALL BE SAME MATERIAL AS PRESSURE PART, UNLESS OTHERWISE NOTED.
6. VESSEL SHALL BE THOROUGHLY CLEANED INSIDE AND OUTSIDE, SHALL BE FREE FROM RUST, SCALE, SLAG, WELD SPLATTER AND FOREIGN MATTER PRIOR TO SHOP HYDROTEST, AND SHALL BE THOROUGHLY DRIED AFTER HYDROTEST.
7. PROJECTION OF RADIAL NOZZLES AND MANHOLES ARE FROM VESSEL CENTER LINE TO EXTREME FACE OF FLANGE.
8. ALL VESSEL COMPONENTS SHALL BE FURNISHED IN ACCORDANCE WITH STANDARDS LISTED BELOW.
9. ITEMS WITH (*) ARE VESSEL FABRICATOR RESPONSIBILITY.
10. SEISMIC FORCES SHALL BE PER SPECIFICATION 24915-000-3PS-SV00-00001, SPECIFICATION FOR SEISMIC PROTECTION OF EQUIPMENT. THE VESSEL IS LOCATED INSIDE THE MDB BUILDING (ANS ROOM 123). PER TABLE 1, APPLICABLE CODES AND IMPORTANCE FACTORS, SEISMIC PROTECTION SHALL BE IN ACCORDANCE WITH ICC INTERNATIONAL BUILDING CODE (IBC) 2000, SEISMIC DESIGN FOR BUILDINGS (SEISMIC GROUPS IIIE AND IIIE).
11. THE GENERAL PROJECT SPECIFICATION, 24915-000-3PS-G000-00001, PROVIDES PROJECT DETAILS AND DESIGN CONDITIONS FOR THE SITE. THIS VESSEL IS PART OF THE MUNITIONS DEMILITARIZATION BUILDING (MDB) AND IS INSTALLED INSIDE THE BUILDING (ROOM 123) AND WILL NOT BE SUBJECT TO SITE CONDITIONS SUCH AS WIND, PRECIPITATION, SNOW, ETC. OTHER GENERAL REQUIREMENTS FOR EQUIPMENT, MATERIAL, AND/OR SERVICES REQUIRED AS DEFINED IN THE SPECIFICATION APPLY.
12. ALL EXTERIOR BARE CARBON STEEL SURFACES SHALL BE PAINTED IN ACCORDANCE WITH SPECIFICATION 24915-000-3PS-AFPS-00001, SPECIAL COATINGS - METAL.
13. VESSEL SUPPLIER SHALL SUPPLY GROUNDING LUGS IN ACCORDANCE WITH STANDARD 24915-00-M0-00-00006. GROUNDING LUGS WITH DIMENSIONS SHALL BE CLEARLY CALLED OUT ON SUPPLIER DRAWINGS.
14. VESSEL SUPPLIER SHALL DESIGN AND INSTALL A MINIMUM OF TWO LIFTING LUGS FOR USE DURING LOADING, UNLOADING AND PLACING EQUIPMENT ON ITS FOUNDATION. DESIGN SHALL INCLUDE REQUIRED PIN, SHACKLE SIZE AND MAXIMUM SLOPE OF LIFTING CABLE AND LIFTING LUG PLANE. HOLE IN LIFTING LUG SHALL BE DRILLED OR MACHINED, DO NOT FLAME CUT. LIFTING LUG (AND PAD IF REQUIRED) SHALL BE THE SAME MATERIAL AS THE SHELL. LIFTING LUG SHALL NOT BE REMOVED AFTER INSTALLATION. EQUIPMENT SUPPLIER SHALL PERMANENTLY MARK ON THE LIFTING LUG WITH 1" MINIMUM HIGH LETTERS - "DO NOT REMOVE". SUPPLIER'S DRAWINGS SHALL PROVIDE LIFTING LUG DESIGN AND LOAD AND ANNOTATE EACH LUG WITH ITS LOAD CAPACITY.
15. VESSEL SUPPLIER SHALL PROVIDE FABRICATION, EMPTY, OPERATING, TEST AND INDIVIDUAL WEIGHTS OF HEAD, SHELL AND EQUIPMENT CENTER OF GRAVITY.
16. VESSEL SUPPLIER SHALL IDENTIFY ALL MATERIALS OF CONSTRUCTION (INCLUDING GASKETS) BY WEIGHT OR VOLUME.

STD NO.	DESCRIPTION	SPEC NO.	DESCRIPTION
24915-00-M0-00-00001	PRESSURE VESSEL TOLERANCES	24915-000-3PS-AFPS-00001	SPECIAL COATINGS - METAL
24915-00-M0-00-00002	STD BOLT HOLE ORIENT	24915-000-3PS-G000-00001	GENERAL PROJECT REQUIREMENTS
24915-00-M0-00-00004	VESSEL ABBREVIATIONS & SYMBOLS	24915-000-3PS-HYQ-00001	QUALITY ASSURANCE
24915-00-M0-00-00006	GROUNDING CONN FOR VESSELS & TKS	24915-000-3PS-MV00-00001	PRESSURE VESSELS
		24915-000-3PS-NLLG-00001	INTERNAL TANK LINING
		24915-000-3PS-SV00-00001	SEISMIC PROTECTION OF EQUIP



DATA SHEET

TITLE

BGCAPP
AGENT SURGE TANK
MT-ACS-0106

SHEET OF
4 9

PROJECT NUMBER
24915

DOCUMENT NUMBER
24915-07-MTD-ACS-00002

REV
1

NOTES CONTINUED

17. ALL EXTERNAL BOLTS AND STUDS SHALL BE ASSEMBLED WITH ANTI-SEIZE LUBRICANT. SEE PRESSURE VESSEL SPECIFICATION.
18. VESSEL SUPPLIER SHALL DESIGN AND FABRICATE MANHOLE DAVIT FOR REMOVAL OF MANHOLE COVER.
19. LIQUID LEVELS ARE FROM BOTTOM TANGENT LINE, UNLESS OTHERWISE NOTED.
20. VESSEL FABRICATOR SHALL SPRAY OR LAMINATE LINE VESSEL IN ACCORDANCE WITH SPECIFICATION 24915-000-3PS-NLLG-00001, INTERNAL TANK LINING.
21. VESSEL FABRICATOR SHALL PREPARE ALL INTERNAL CARBON STEEL SURFACES FOR LINING PER NACE RP0178, FABRICATION DETAILS, SURFACE FINISH REQUIREMENTS, AND PROPER DESIGN CONSIDERATIONS FOR TANKS AND VESSELS TO BE LINED FOR IMMERSION SERVICE.
22. NOZZLES SMALLER THAN 2" SHALL BE HASTALLOY (UNS N10276). NOZZLES SMALLER THAN 2" CANNOT BE LINED. ISOLATION KIT REQUIRED.
23. THREE SETS OF SPARE GASKETS FOR NOZZLES WITH BLIND FLANGES SHALL BE SUPPLIED BY VESSEL FABRICATOR. GASKETS SHALL BE FLAT RING, PTFE, 1/8" THK, CL150.
24. STANDPIPE MATERIAL SHALL BE HASTALLOY (UNS N10276) X.S. PIPE.
25. ALL BOLTS, NUTS AND WASHERS USED FOR EQUIPMENT IN TOXIC CATEGORIES "A" & "B" SHALL HAVE BOLTS NO SMALLER THAN 1/4". BOLTS ARE SIZED SO THAT PPE WEARERS CAN HANDLE THEM.
26. AGENT SURGE TANK, MT-ACS-0106, IS REFERENCED ON P&ID 24915-07-M6-ACS-00002.



DATA SHEET

TITLE



BGCAPP
AGENT HOLDING TANK
MT-ACS-0106

SHEET OF
5 9

PROJECT NUMBER
24915

DOCUMENT NUMBER
24915-07-MTD-ACS-00002

REV
1

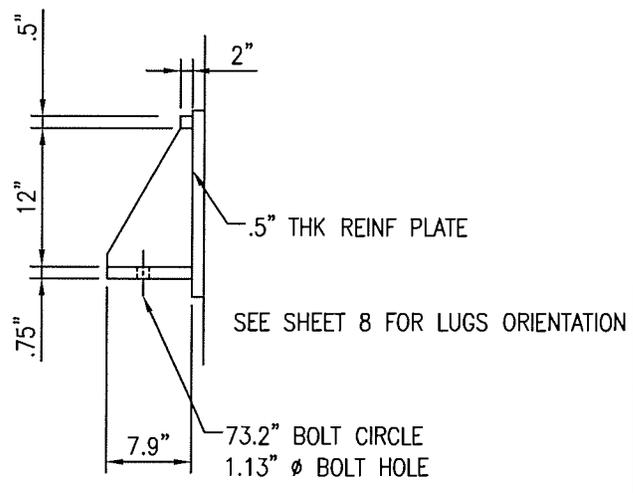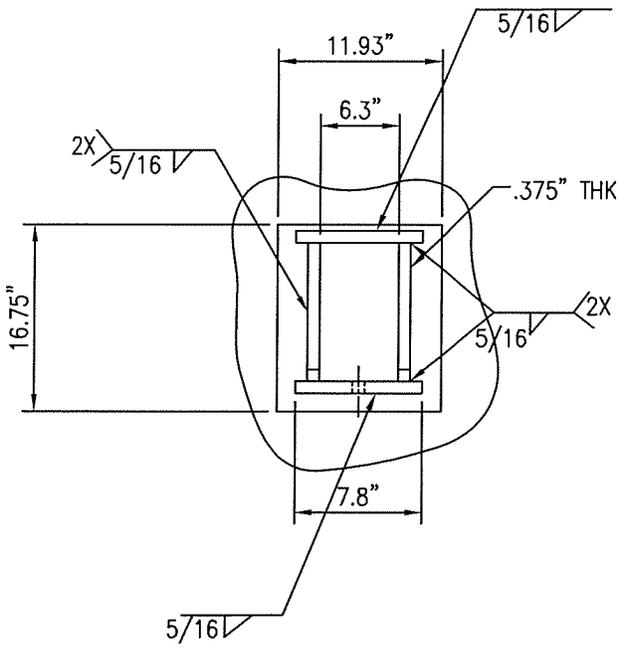

THE REINFORCING PAD WILL BE WELDED TO THE VESSEL SHELL ALL AROUND WITH A 3/8" WELD. REFER TO MANUFACTURER DRAWING FOR FULL LUG DETAILS.

DETAIL	1	REF
(4 REQ'D)	7	SHT 2



DATA SHEET

TITLE
 BGCAPP
 AGENT HOLDING TANK
 MT-ACS-0106

SHEET 6	OF 9	PROJECT NUMBER 24915
DOCUMENT NUMBER 24915-07-MTD-ACS-00002		REV 1

SEISMIC STRESSES IN SDS VESSELS SUPPORTED ON/FROM PLATFORMS

TABLE 1 SHOWS THE SEISMIC STRESSES (S11 AND S22) IN THE TWO ORTHOGONAL DIRECTIONS AT THE LOCATIONS SHOWN IN FIGURE 1 BASED OFF ORIGINAL VESSEL INFORMATION PROVIDED BY THE VENDOR. THESE STRESSES ACT IN BOTH TENSION AND COMPRESSION. THE SEISMIC STRESSES SHOWN IN TABLE 1 WERE COMBINED WITH THE ASME OPERATIONAL STRESSES BY THE VENDOR AND TABLE 3 SHOWS THE NECESSARY DESIGN CHANGE TO THE VESSELS FROM THE VENDOR TO ACCOUNT FOR THE SEISMIC STRESSES. THE BUYER HAS PERFORMED SEISMIC ANALYSIS ON THE UPDATED VESSEL INFORMATION (TABLE 3), AND DETERMINED THERE ARE NO INCREASES TO THE ACCELERATION OF THE CENTER OF GRAVITY OF THE VESSELS. THEREFORE, THE SEISMIC STRESSES IN TABLE 1 ARE A BOUNDING CONDITION PROVIDED THE VESSELS ARE FABRICATED AS DESCRIBED IN TABLE 3 AND LUGS DESIGNED AS SPECIFIED ON PAGE 5.


TABLE 1: S11 AND S22 SEISMIC STRESSES FOR MT-ACS-0106

LOCATION	S11 (KSI)	S22 (KSI)
TOP TANGENT LINE	1.0	1.0
BOTTOM TANGENT LINE	3.5	5.5
AT LUGS	27.0	25.5

Table 2: ACCELERATION OF COG FOR MT-ACS-0106			
Vessel	Acceleration at COG (%g)		
	X	Y	Z
MT-ACS-0106	0.246	0.162	0.252
General Note:			
The 'X' direction is East-West			
The 'Y' direction is North-South			
The 'Z' direction is vertical			

* PLEASE NOTE THAT WHERE THESE ACCELERATIONS WILL PRODUCE LOWER LOADS THAN THOSE DERIVED FROM THE SEISMIC PROTECTION OF EQUIPMENT SPECIFICATION, THE VALUE FROM THE SEISMIC PROTECTION SPEC. IS TO BE USED FOR THE DESIGN OF THE VESSELS' INTERNALS AND ANCHORAGES OF THE VESSELS TO THE STEEL FRAME.

FIGURE 1: LOCATION & ORIENTATION OF STRESSES

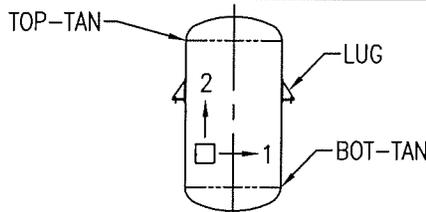



DATA SHEET

TITLE
 BGCAPP
 AGENT HOLDING TANK
 MT-ACS-0106

SHEET OF PROJECT NUMBER
 7 9 24915


DOCUMENT NUMBER REV
 24915-07-MTD-ACS-00002 1

TABLE 3: UPDATED VESSEL INFORMATION FROM VENDOR


VESSEL TAG NO.	CENTER OF GRAVITY (IN) *			OPERATING WEIGHT (LBS)	SHELL THICKNESS (IN)	HEAD THICKNESS (IN)	SKIRT THICKNESS (IN)
	X	Y	Z				
MT-ACS-0106	.02	-3.48	43.05	21,603	.5	.375	N/A

* THE CENTER OF GRAVITY IS BASED ON A STANDARD COORDINATE SYSTEM WITH REFERENCE TO PAGE 7. THE POSITIVE X,Y,Z DIRECTIONS ARE EAST, NORTH, AND UP THE VESSEL (OUT OF THE PAGE), RESPECTIVELY. THE ORIGIN IS AT THE INTERSECTION OF THE VESSEL CENTERLINE AND REFERENCE PLANE (LOWER TANGENT LINE).


FIGURE 2: MODEL SHOWING THE ANS PLATFORM

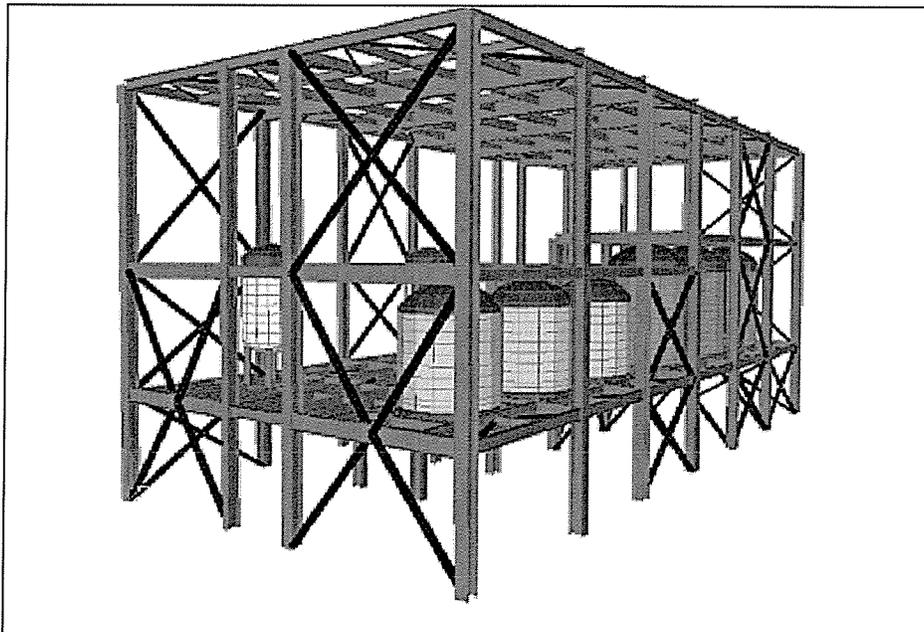

DATA SHEET	TITLE	BGCAPP AGENT SURGE TANK 07-MT-ACS-0106	SHEET OF	8 9	PROJECT NUMBER	24915	REV	1
				DOCUMENT NUMBER	24915-07-MTD-ACS-00002			

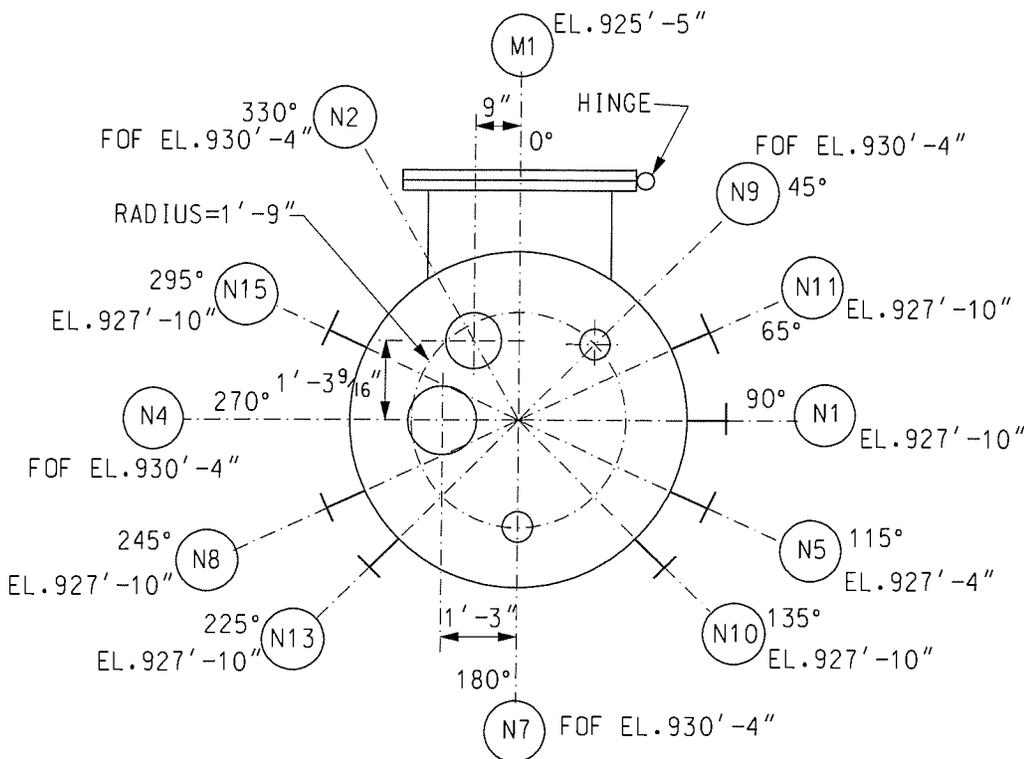


UPPER PLAN A REF.
8 SHEET 9

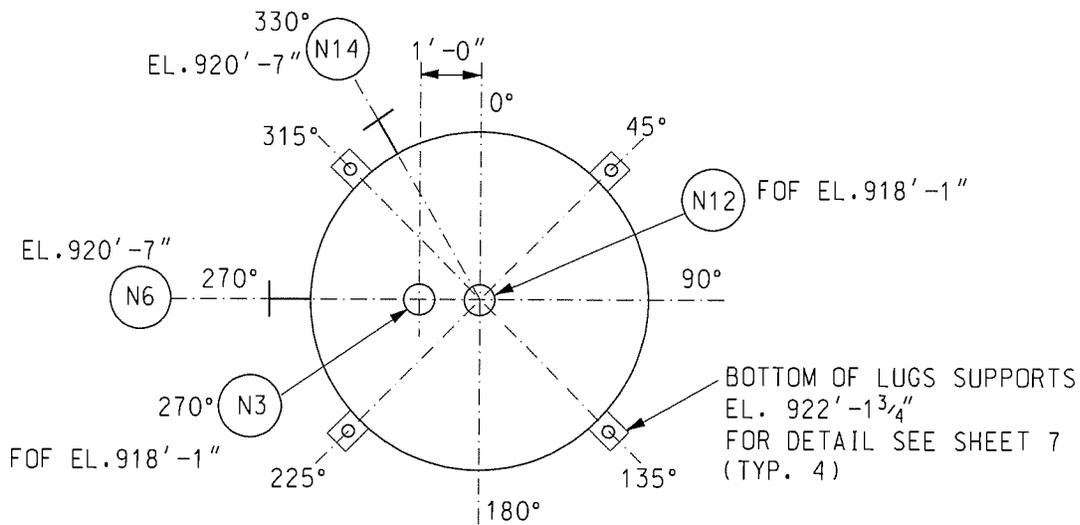

LOWER PLAN B REF.
8 SHEET 9

DATA SHEET	TITLE	BGCAPP AGENT SURGE TANK 07-MT-ACS-0106	SHEET OF 9 9	PROJECT NUMBER 24915
				DOCUMENT NUMBER 24915-07-MTD-ACS-00002

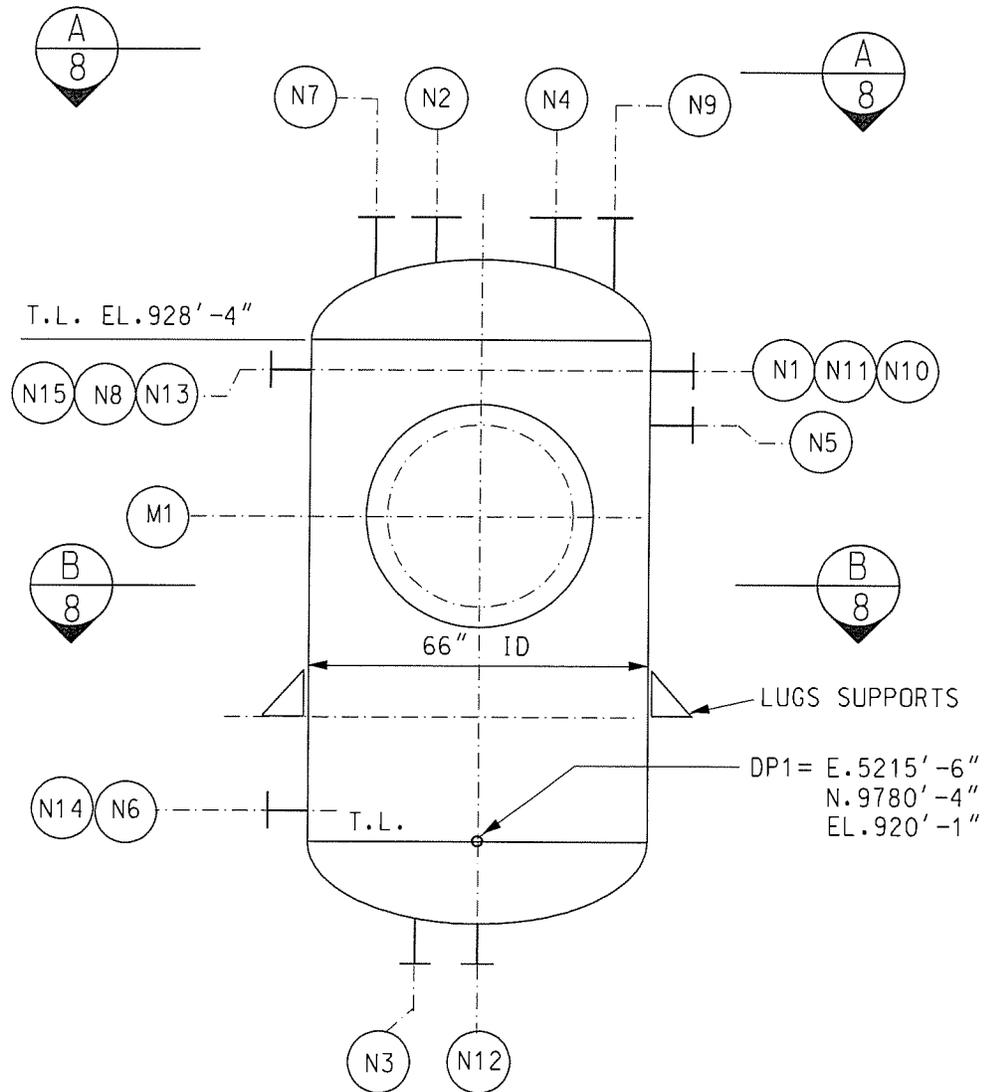

ELEVATION



A Joint Venture of Bechtel National, Inc. and Parsons Infrastructure & Technology Group Inc.

Project Number

24915

Document Number

24915-07-MTD-ANS-00001

Rev

2

Date

11/11/2009

Sheet of

1 10

Project, Client, Location

Blue Grass Chemical Agent-Destruction Pilot Plant (BGCAPP) Project

Document Title

AGENT HYDROLYSATE SAMPLING TANKS MT-ANS-0103/0203/0303

- In-House Review
 Client Approval
 Quotation
 Purchase
 Construction
 Design

- All Data Sheets Attached
 Revised Data Sheets Only Attached

QUALITY:

Q

NON-Q

TOXIC CATEGORY

A

B

A/B

_____ OTHER


REV	DATE	BY	CHK	DL	PROJ ENGR	QA	APPR	REMARKS
0	04/16/09	SC	BM	BM	BBB	JW		Issued for Purchase
1	09/04/09	SC	BM	SA	BBB	JW		Issued for Purchase (included seismic data for vendor's use by adding sheets 5 & 6)
2	11/11/09	MDV <i>MDV</i>	SC <i>SC</i>	SA <i>SA</i>	BBB <i>BBB</i>	JW <i>JW</i>		Issued for Purchase (revised seismic data for vendor's use and changes shown by clouds)

This sheet is a record of each issue or revision to the subject specification. Each time the specification is to be changed, only the new or revised sheets must be issued. The exact sheets changed and the nature of the change should be noted in the Remarks column; however, these remarks are not part of the specification. The revised data sheets shall become part of the original specification and shall be compiled within their entirety.

BECHTEL PARSONS
BLUE GRASS
DATA SHEET

TITLE
BGCAPP
AGENT HYDROLYSATE SAMPLING TANKS
MT-ANS-0103/0203/0303

SHEET OF PROJECT NUMBER
2 10 24915
DOCUMENT NUMBER REV
24915-07-MTD-ANS-00001 2

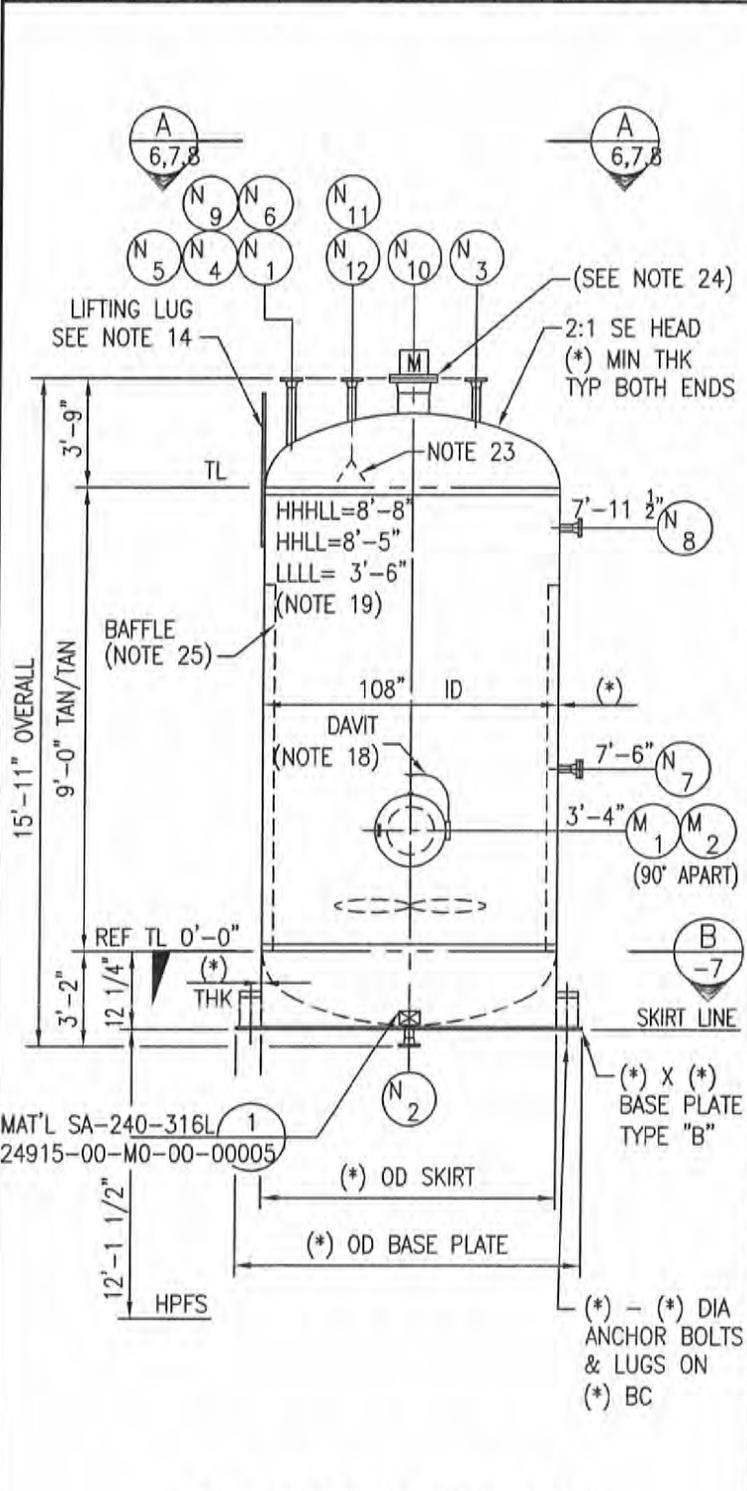

CODE: ASME SECT VII DIV 1 (CODE CONSTR. ONLY)

CODE CERT REQD	NO	CODE STAMP	NO
NATIONAL BOARD REGISTRATION: NO			
OPR PRESS (INT)	0.20 PSIG AT		100 °F
DES PRESS. (INT)	14.9 PSIG AT		125 °F
DES PRESS. (EXT)	FULL VAC PSIG AT		125 °F
MIN DESIGN METAL TEMP	(-)-1 °F AT		14.9 PSIG
CRSN ALLOW SHELL = 1/16" HEADS = 1/16" NOZZ = 1/16"			
LIQUID LEVEL FOR DESIGN: FULL AT SP GR 1.07			
SEISMIC DESIGN: SEE NOTE 10			
WIND DESIGN: SEE NOTE 11			
MAWP	(*) PSIG AT	125 °F LIMITED BY (*)	
MAP N&C	(*) PSIG AT	AMB TEMP LIMITED BY (*)	
SHOP HYD	(*) PSIG AT	70 °F MIN HORIZ POSN	
FIELD HYD NEW	(*) PSIG AT	70 °F MIN OPR POSN	
FIELD HYD CORR	(*) PSIG AT	70 °F MIN OPR POSN	
PWHT (PER CODE)		RADIOGRAPHY (FULL)	
JOINT EFF: SHELL (PER CODE)		HEADS (PER CODE)	
ALLOW STRESS 16,700 PSI AT DESIGN TEMP 125°F			
SHELL		SA-240-316L	
HEADS		SA-240-316L	
SUPPORTS		SA-240-316L	
INTERNALS		SA-240-316L TRAYS N/A	
BOLTS (INT)		N/A NUTS N/A	
BOLTS (EXT)		SA-193-B6 NUTS SA-194-6	
FLANGES		SA-182-F316L	
NOZZLE NECKS		SA-312-TP-316L	
GASKETS		NOTE 21	
CAPACITY (WORKING)		3120 GAL	
FAB WT (*) (NOTE 1&15)	LB	EMPTY WT (*) (NOTE 1&15)	LB
TRAY WT	N/A LB	PACKING WT	N/A LB
OPR WT (*) (NOTE 1&15)	LB	TEST WT (*) (NOTE 1&15)	LB
PAINTING SEE NOTE 12			
INSULATION NONE			
FIREPROOFING NONE			
ACCESSORIES BY FABRICATOR:			YES NO
VESSEL DAVIT MARK No.			X
LADDER & PLATFORM CLIPS			X
PIPE SUPPORT AND PIPE GUIDE CLIPS			X
INSULATION SUPPORTS			X
FIREPROOFING SUPPORTS			X
VORTEX BREAKER			X
LIFTING AND GROUNDING LUGS			X

NOZZLE SCHEDULE

ITEM	No.	SIZE	PROJ	RATING	SERVICE
M1,M2	2	36"	5'-6"	150#	MH W/ BF & DAVIT
N1	1	3"	SEE ELEV	150#	TANK INLET
N2	1	6"	SEE ELEV	150#	TANK OUTLET
N3	1	8"	SEE ELEV	150#	LEVEL TRANSMITTER
N4	1	2"	SEE ELEV	150#	LSHH
N5	1	2"	SEE ELEV	150#	LSHHH
N6	1	4"	SEE ELEV	150#	VENT
N7	1	3"	5'-2"	150#	RECYCLE LINE
N8	1	2"	5'-2"	150#	SPARE W/ BF
N9	1	2"	SEE ELEV	150#	PURGE INLET
N10	1	14"	SEE ELEV	150#	AGITATOR
N11	1	3"	SEE ELEV	150#	PIT
N12	1	2"	SEE ELEV	150#	DECON SPRAY

FLANGE: RFWN FINISH: 125-250 AARH
NOTE #7

ONE REQD MT-ANS-0103
ONE REQD MT-ANS-0203
ONE REQD MT-ANS-0303
SEE SHEETS 6, 7, & 8 FOR TRUE ORIENTATION

 DATA SHEET	TITLE BGCAPP AGENT HYDROLYSATE SAMPLING TANKS MT-ANS-0103/0203/0303	SHEET OF	PROJECT NUMBER
		3 10	24915
		DOCUMENT NUMBER	REV
		24915-07-MTD-ANS-00001	2

NOTES

1. THE VESSEL SUPPLIER SHALL DESIGN, FURNISH, FABRICATE, INSPECT, TEST AND DELIVER THE VESSEL IN ACCORDANCE WITH THIS DATA SHEET, ATTACHED SPECIFICATIONS AND STANDARDS. VESSEL SHALL BE DESIGNED IN ACCORDANCE WITH SPECIFIED DESIGN REQUIREMENTS, SEE NOTES 10 AND 11.
2. ALL DIMENSIONS ARE FROM REF TANGENT LINE, EXCEPT AS SHOWN.
3. NOZZLES AND MANHOLE SHALL HAVE SAME DESIGNATION AS SHOWN ON THIS DRAWING.
4. BOLT HOLES SHALL STRADDLE THE VERTICAL CENTERLINES OF THE VESSEL FOR NOZZLES ON THE SHELL AND PLANT NORTH-SOUTH, EAST-WEST CENTERLINES FOR NOZZLES ON THE HEADS.
5. ALL ATTACHMENTS WELDED TO VESSEL PRESSURE PARTS SHALL BE SAME MATERIAL AS PRESSURE PART, UNLESS OTHERWISE NOTED.
6. VESSEL SHALL BE THOROUGHLY CLEANED INSIDE AND OUTSIDE, SHALL BE FREE FROM RUST, SCALE, SLAG, WELD SPLATTER AND FOREIGN MATTER PRIOR TO SHOP HYDROTEST, AND SHALL BE THOROUGHLY DRIED AFTER HYDROTEST.
7. PROJECTION OF RADIAL NOZZLES AND MANHOLES ARE FROM VESSEL CENTER LINE TO EXTREME FACE OF FLANGE.
8. ALL VESSEL COMPONENTS SHALL BE FURNISHED IN ACCORDANCE WITH STANDARDS LISTED BELOW.
9. ITEMS WITH (*) ARE VESSEL FABRICATOR RESPONSIBILITY.
10. SEISMIC FORCES SHALL BE PER SPECIFICATION 24915-000-3PS-SV00-00001, SPECIFICATION FOR SEISMIC PROTECTION OF EQUIPMENT. THE VESSEL IS LOCATED INSIDE THE MDB BUILDING (ANS ROOM 123). PER TABLE 1, APPLICABLE CODES AND IMPORTANCE FACTORS, SEISMIC PROTECTION SHALL BE IN ACCORDANCE WITH ICC INTERNATIONAL BUILDING CODE (IBC) 2000, SEISMIC DESIGN FOR BUILDINGS (SEISMIC GROUPS IIIE AND IIIE).
11. THE GENERAL PROJECT SPECIFICATION, 24915-000-3PS-G000-00001, PROVIDES PROJECT DETAILS AND DESIGN CONDITIONS FOR THE SITE. THIS VESSEL IS PART OF THE MUNITIONS DEMILITARIZATION BUILDING (MDB) AND IS INSTALLED INSIDE THE BUILDING (ANS ROOM 123) AND WILL NOT BE SUBJECT TO SITE CONDITIONS SUCH AS WIND, PRECIPITATION, SNOW, ETC. OTHER GENERAL REQUIREMENTS FOR EQUIPMENT, MATERIAL, AND/OR SERVICES REQUIRED AS DEFINED IN THE SPECIFICATION APPLY.
12. ALL EXTERIOR BARE CARBON STEEL SURFACES SHALL BE PAINTED IN ACCORDANCE WITH SPECIFICATION 24915-000-3PS-AFPS-00001, SPECIAL COATINGS - METAL.
13. VESSEL SUPPLIER SHALL SUPPLY GROUNDING LUGS IN ACCORDANCE WITH STANDARD 24915-00-M0-00-00006. GROUNDING LUGS WITH DIMENSIONS SHALL BE CLEARLY CALLED OUT ON SUPPLIER DRAWINGS.
14. VESSEL SUPPLIER SHALL DESIGN AND INSTALL A MINIMUM OF TWO LIFTING LUGS FOR USE DURING LOADING, UNLOADING AND PLACING EQUIPMENT ON ITS FOUNDATION. DESIGN SHALL INCLUDE REQUIRED PIN, SHACKLE SIZE AND MAXIMUM SLOPE OF LIFTING CABLE AND LIFTING LUG PLANE. HOLE IN LIFTING LUG SHALL BE DRILLED OR MACHINED, DO NOT FLAME CUT. LIFTING LUG (AND PAD IF REQUIRED) SHALL BE THE SAME MATERIAL AS THE SHELL. LIFTING LUG SHALL NOT BE REMOVED AFTER INSTALLATION. EQUIPMENT SUPPLIER SHALL PERMANENTLY MARK ON THE LIFTING LUG WITH 1" MINIMUM HIGH LETTERS - "DO NOT REMOVE". SUPPLIER'S DRAWINGS SHALL PROVIDE LIFTING LUG DESIGN AND LOAD AND ANNOTATE EACH LUG WITH ITS LOAD CAPACITY.
15. VESSEL SUPPLIER SHALL PROVIDE FABRICATION, EMPTY, OPERATING, TEST AND INDIVIDUAL WEIGHTS OF HEAD, SHELL AND EQUIPMENT CENTER OF GRAVITY.
16. VESSEL SUPPLIER SHALL IDENTIFY ALL MATERIALS OF CONSTRUCTION (INCLUDING GASKETS) BY WEIGHT OR VOLUME.

STD NO.	DESCRIPTION	SPEC NO.	DESCRIPTION
24915-00-M0-00-00001	PRESSURE VESSEL TOLERANCES	24915-000-3PS-AFPS-00001	SPECIAL COATINGS - METAL
24915-00-M0-00-00002	STD BOLT HOLE ORIENT	24915-000-3PS-G000-00001	GENERAL PROJECT REQUIREMENTS
24915-00-M0-00-00004	VESSEL ABBREVIATIONS & SYMBOLS	24915-000-3PS-HXYQ-00001	QUALITY ASSURANCE
24915-00-M0-00-00005	VORTEX BREAKERS	24915-000-3PS-MMTO-00001	PMI FOR PRESSURE VESSELS & TANKS
24915-00-M0-00-00006	GROUNDING CONN FOR VESSELS & TKS	24915-000-3PS-MV00-00001	PRESSURE VESSELS
24915-00-M0-00-00008	SKIRT AND BASE DETAILS	24915-000-3PS-NW00-00002	NICKEL BASE ALLOY WELDING
		24915-000-3PS-SV00-00001	SEISMIC PROTECTION OF EQUIP



DATA SHEET

TITLE
BGCAPP
AGENT HYDROLYSATE SAMPLING TANKS
MT-ANS-0103/0203/0303

SHEET OF PROJECT NUMBER
4 10 24915

DOCUMENT NUMBER REV
24915-07-MTD-ANS-00001 2

NOTES CONTINUED

17. ALL EXTERNAL BOLTS AND STUDS SHALL BE ASSEMBLED WITH ANTI-SEIZE LUBRICANT. SEE PRESSURE VESSEL SPECIFICATION.
18. VESSEL SUPPLIER SHALL DESIGN AND FABRICATE MANHOLE DAVIT FOR REMOVAL OF MANHOLE COVER.
19. LIQUID LEVELS ARE FROM BOTTOM TANGENT LINE, UNLESS OTHERWISE NOTED.
20. AGENT HYDROLYSATE SAMPLING TANKS, MT-ANS-0103/0203/0303, ARE REFERENCED ON P&ID'S 24915-07-M6-ANS-00011, 00012, 00013.
21. THREE SETS OF SPARE GASKETS FOR NOZZLES WITH BLIND FLANGES SHALL BE SUPPLIED BY VESSEL FABRICATOR. GASKETS SHALL BE SP WND, HAST C, FLEX GRAPH FILLER, 1/8" THK, CARBON STEEL CENT RING, CLASS 150.
22. ALL BOLTS, NUTS AND WASHERS USED FOR EQUIPMENT IN TOXIC CATEGORIES "A" & "B" SHALL HAVE BOLTS NO SMALLER THAN 1/4". BOLTS ARE SIZED SO THAT PPE WEARERS CAN HANDLE THEM.
23. WASH SPRAY NOZZLE, N12, SHALL BE SUPPLIED BY VESSEL FABRICATOR. SPRAY NOZZLE BETE MODEL 1"-TW OR EQUAL. MATERIAL SHALL BE 316L.
24. AGITATOR SHALL BE PROVIDED BY VESSEL VENDOR. REFER TO DATA SHEET 24915-07-M5D-ANS-00002, AGENT HYDROLYSATE SAMPLING TANK AGITATORS.
25. FOUR VORTEX REDUCING BAFFLES REQUIRED. BAFFLES SHALL BE 316L MATERIAL. BAFFLES SHALL BE EQUALLY SPACED AT 90°. VESSEL FABRICATOR TO COORDINATE WITH BUYER ON SIZE AND POSITION OF THE INTERNAL BAFFLES. THE BAFFLES SHALL BE 7.5" WIDE, 5/8" THICK AND SHALL EXTEND FROM THE BOTTOM HEAD TANGENT LINE UP TO TOP HEAD TANGENT LINE. BAFFLES SHALL BE INSTALLED WITH 1" CLEARANCE FROM VESSEL WALL.
26. POSITIVE MATERIAL IDENTIFICATION PER SPECIFICATION 24915-000-3PS-MMTO-00001, IS REQUIRED.

SEISMIC STRESSES IN ANS VESSELS SUPPORTED ON/FROM PLATFORMS

TABLE 1 SHOWS THE SEISMIC STRESSES (S11 AND S22) IN THE TWO ORTHOGONAL DIRECTIONS AT THE LOCATIONS SHOWN IN FIGURE 1 BASED OFF ORIGINAL VESSEL INFORMATION PROVIDED BY THE VENDOR. THESE STRESSES ACT IN BOTH TENSION AND COMPRESSION. THE SEISMIC STRESSES SHOWN IN TABLE 1 WERE COMBINED WITH THE ASME OPERATIONAL STRESSES BY THE VENDOR AND TABLE 3 SHOWS THE NECESSARY DESIGN CHANGE TO THE VESSELS FROM THE VENDOR TO ACCOUNT FOR THE SEISMIC STRESSES. THE BUYER HAS PERFORMED SEISMIC ANALYSIS ON THE UPDATED VESSEL INFORMATION (TABLE 3), AND DETERMINED THERE ARE NO INCREASES TO THE ACCELERATION OF THE CENTER OF GRAVITY OF THE VESSELS. THEREFORE, THE SEISMIC STRESSES IN TABLE 1 ARE A BOUNDING CONDITION PROVIDED THE VESSELS ARE FABRICATED AS DESCRIBED IN TABLE 3.

TABLE 1: S11 AND S22 SEISMIC STRESSES FOR MT-ANS-0103/0203/0303

LOCATION	S11 (KSI)	S22 (KSI)
TOP TANGENT LINE	0.5	0.5
BOTTOM TANGENT LINE	4.5	4.5
SKIRT LINE	13.5	24.5


Table 2: ACCELERATION OF COG FOR
MT-ANS-0103/0203/0303

LOCATION	ACCELERATION at COG (%g)		
	X	Y	Z
MT-ANS-0103	0.203	0.165	0.253
MT-ANS-0203	0.203	0.165	0.253
MT-ANS-0303	0.203	0.165	0.253

GENERAL NOTE:

The 'X' direction is East-West
The 'Y' direction is North-South
The 'Z' direction is vertical

FIGURE 1: LOCATION & ORIENTATION OF STRESSES

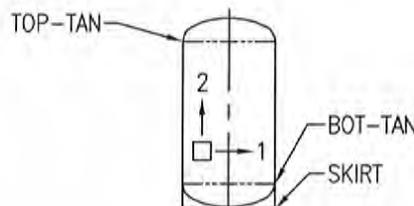



DATA SHEET

TITLE
 BGCAPP
 AGENT HYDROLYSATE SAMPLING TANKS
 MT-ANS-0103/0203/0303


SHEET 6	OF 10	PROJECT NUMBER 24915
DOCUMENT NUMBER 24915-07-MTD-ANS-00001		REV 2

TABLE 3: UPDATED VESSEL INFORMATION FROM VENDOR

VESSEL TAG NO.	CENTER OF GRAVITY (IN) *			OPERATING WEIGHT (LBS)	SHELL THICKNESS (IN)	HEAD THICKNESS (IN)	SKIRT THICKNESS (IN)
	X	Y	Z				
MT-ANS-0103	-1.97	0.02	44.88	56,100	.375	.4375	.75
MT-ANS-0203	-1.97	0.02	44.88	56,100	.375	.4375	.75
MT-ANS-0303	-1.97	0.02	44.88	56,100	.375	.4375	.75

* THE CENTER OF GRAVITY IS BASED ON A STANDARD COORDINATE SYSTEM WITH REFERENCE TO PAGE 7. THE POSITIVE X,Y,Z DIRECTIONS ARE EAST, NORTH, AND UP THE VESSEL (OUT OF THE PAGE), RESPECTIVELY. THE ORIGIN IS AT THE INTERSECTION OF THE VESSEL CENTERLINE AND REFERENCE PLANE (LOWER TANGENT LINE).

FIGURE 2: MODEL SHOWING THE ANS PLATFORM

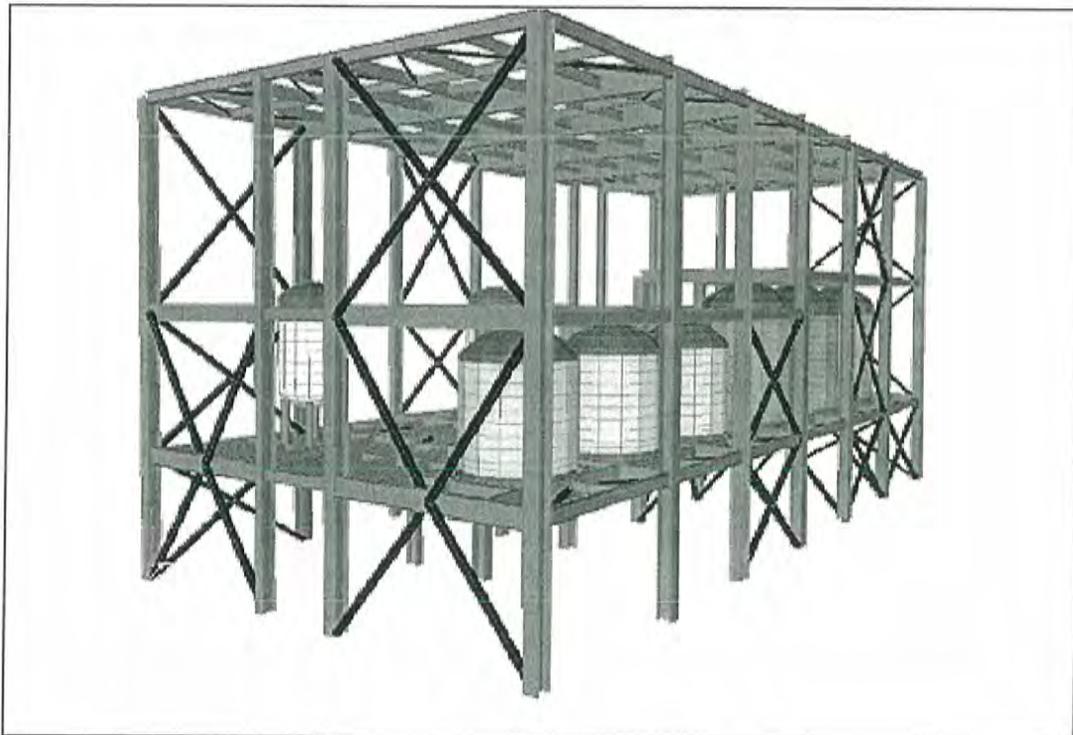




DATA SHEET

TITLE
BGCAPP
AGENT HYDROLYSATE SAMPLING TANKS
MT-ANS-0103/0203/0303

SHEET OF PROJECT NUMBER
7 10 24915

DOCUMENT NUMBER REV
24915-07-MTD-ANS-00001 2

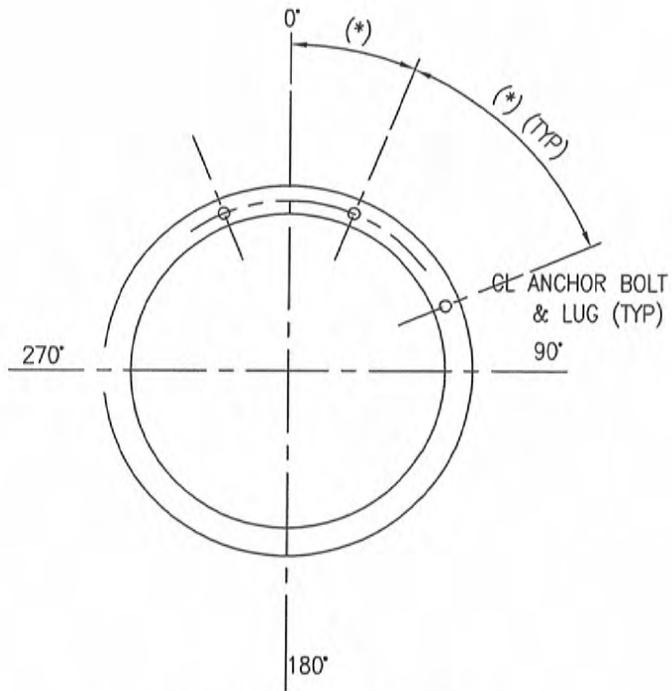

PLAN
ANCHOR BOLT
DETAIL

B	REF
7	SHT 2



TITLE
BGCAPP
AGENT HYDROLYSATE SAMPLING TANKS
07-MT-ANS-0103

SHEET OF PROJECT NUMBER
8 10 24915

DATA SHEET

DOCUMENT NUMBER
24915-07-MTD-ANS-00001

REV
2

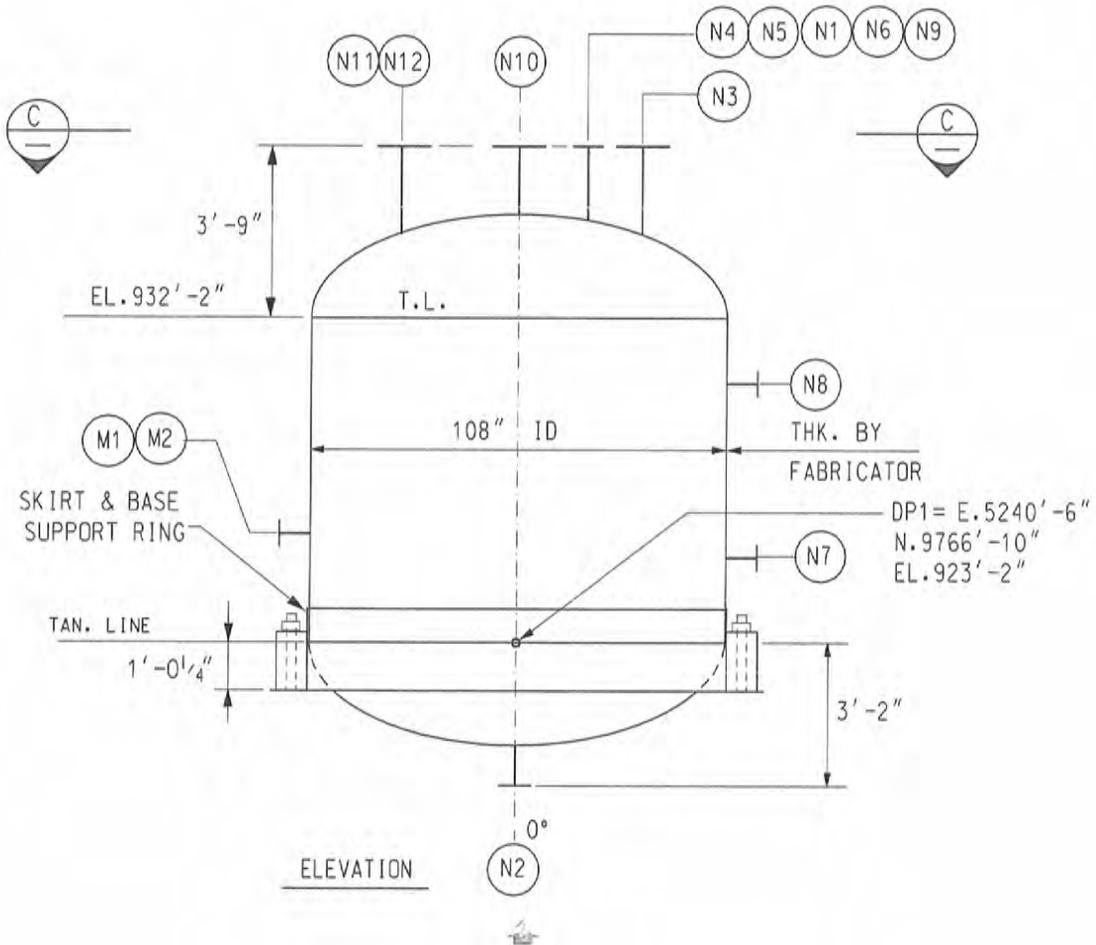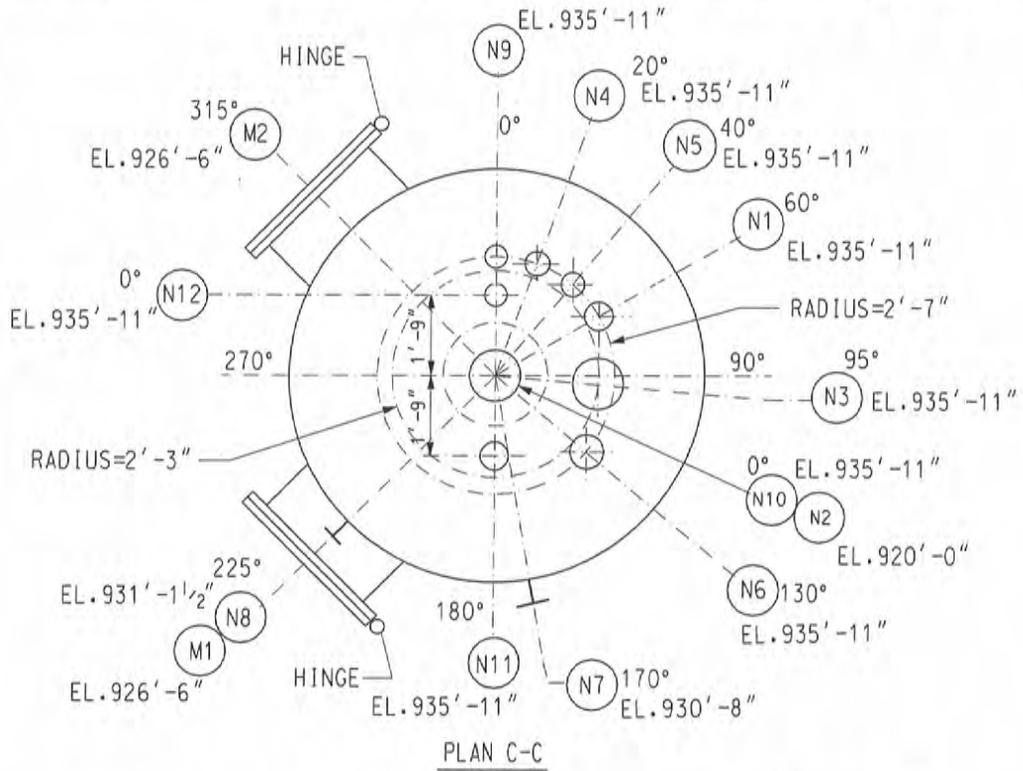


TITLE
BGCAPP
AGENT HYDROLYSATE SAMPLING TANKS
07-MT-ANS-0203

SHEET OF PROJECT NUMBER
9 10 24915


DOCUMENT NUMBER
24915-07-MTD-ANS-00001

REV
2


DATA SHEET

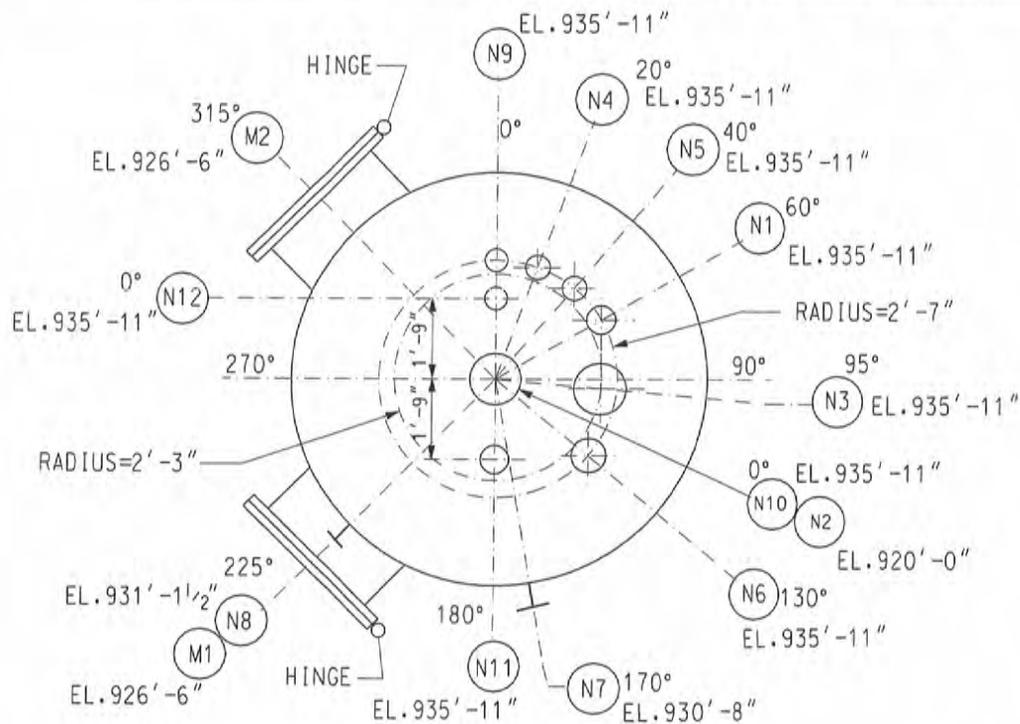

PLAN D-D

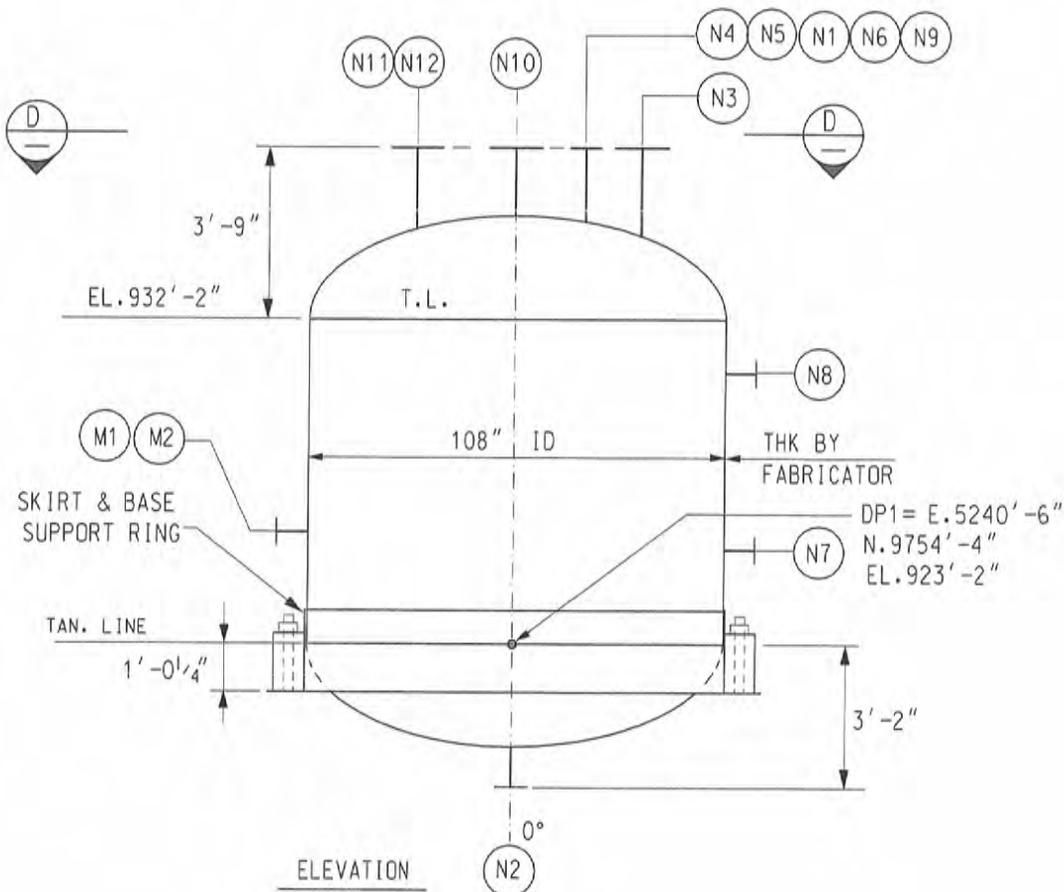

ELEVATION

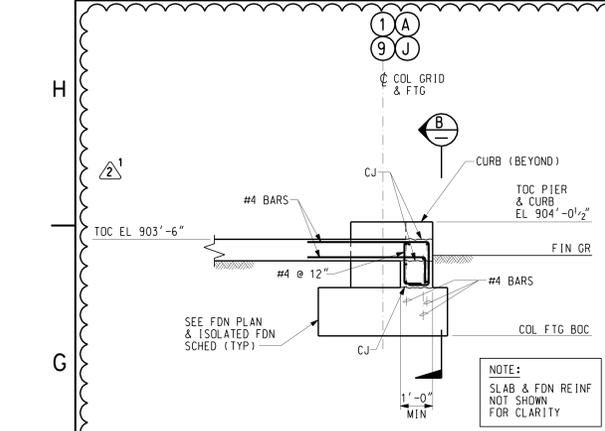


OPTION A


SECTION A REF
1/2" = 1'-0" 10-DB-00-00014 10-DB-00-00002
(PRE-ENGINEERED BUILDING)

This document has been reviewed for ITAR/EAR and no ITAR/EAR sensitive information was found. 17 Dec 2013


This document has been reviewed for OPSEC material, and none was found. 17 Dec 2013

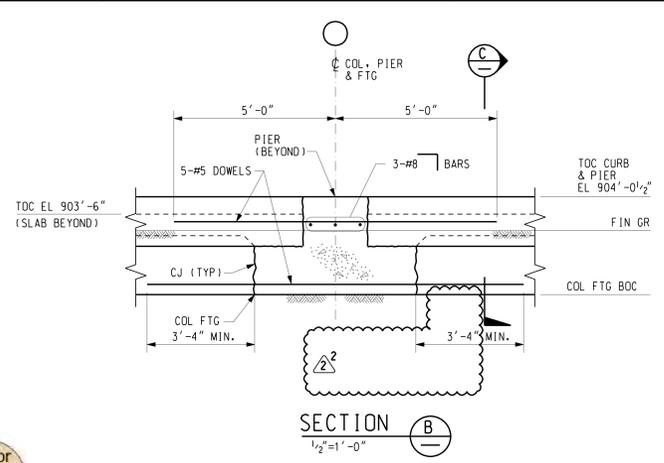

SECTION B
1/2" = 1'-0"

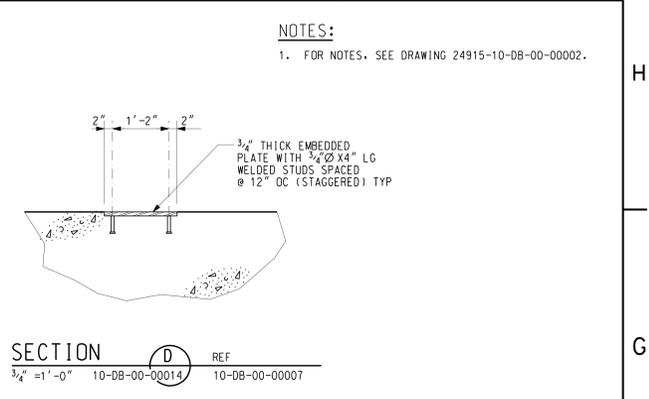


SECTION D REF
3/4" = 1'-0" 10-DB-00-00014 10-DB-00-00007

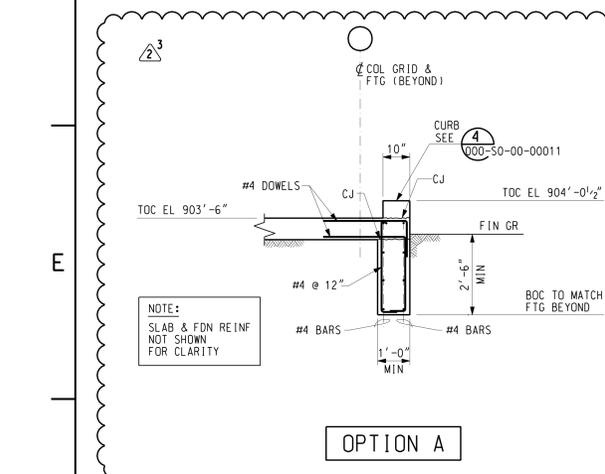


OPTION A


SECTION C REF
1/2" = 1'-0" 10-DB-00-00014 10-DB-00-00002
10-DB-00-00006
10-DB-00-00007
10-DB-00-00008
10-DB-00-00010
10-DB-00-00011

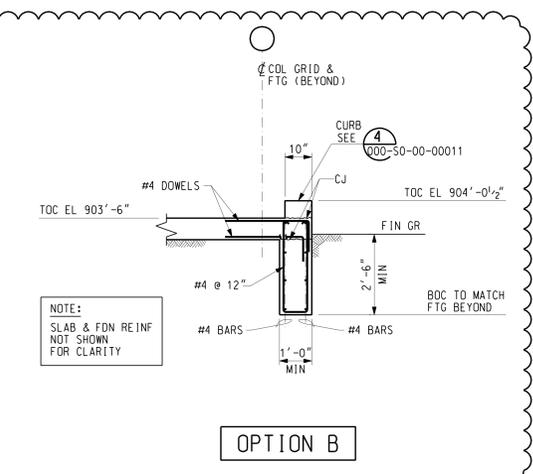


OPTION B

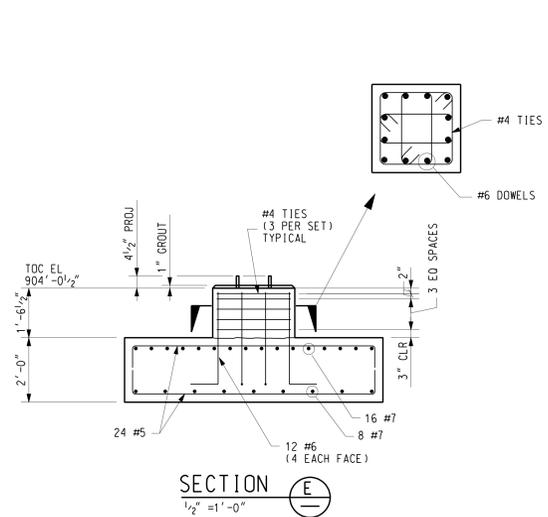


SECTION E
1/2" = 1'-0"

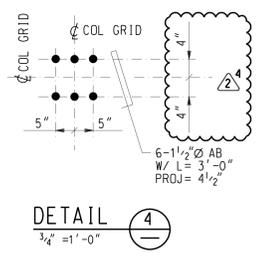


DETAIL 4
3/4" = 1'-0"

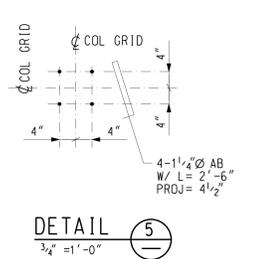


DETAIL 5
3/4" = 1'-0"

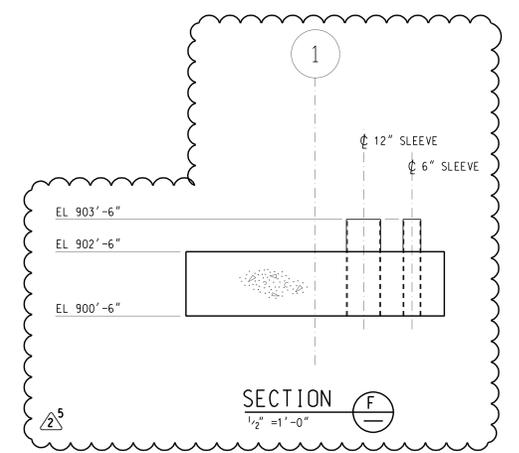


SECTION F
1/2" = 1'-0"

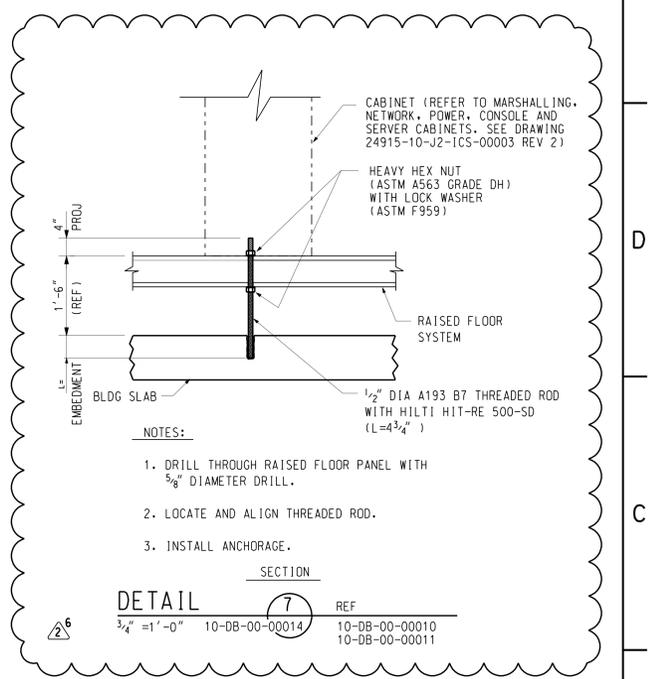


DETAIL 7 REF
3/4" = 1'-0" 10-DB-00-00014 10-DB-00-00010
10-DB-00-00011

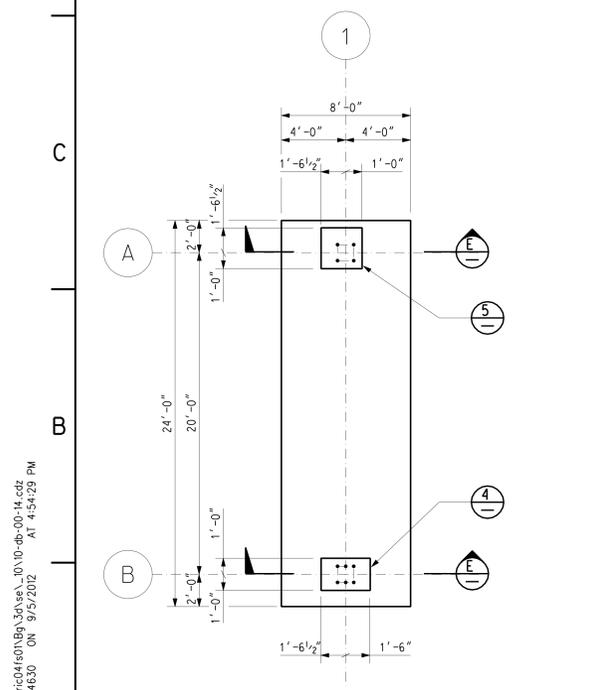

DETAIL 1 REF
1/4" = 1'-0" 10-DB-00-00014 10-DB-00-00002

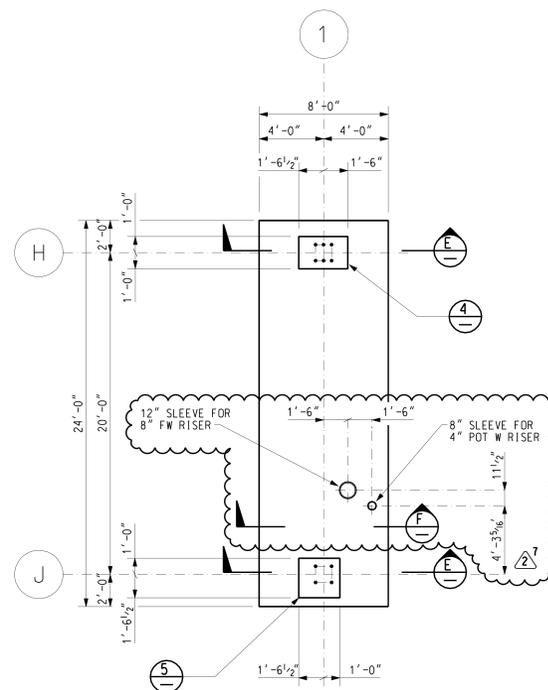


DETAIL 2 REF
1/4" = 1'-0" 10-DB-00-00014 10-DB-00-00002

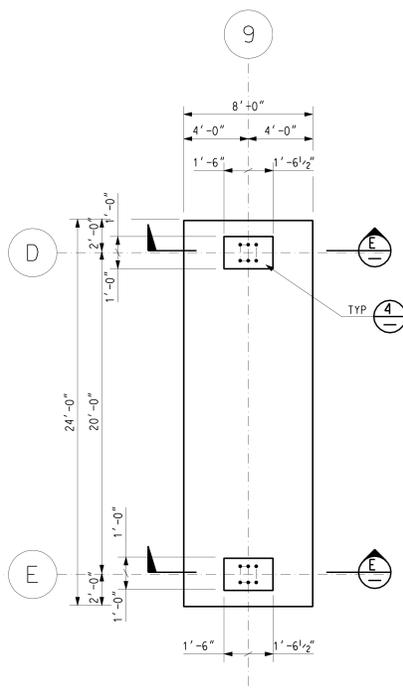

DETAIL 3 REF
1/4" = 1'-0" 10-DB-00-00014 10-DB-00-00002

REV 2 ADDITIONAL DESCRIPTION:
REVISED TO INCORPORATE DR 619,
FCR 764 & FCR 946

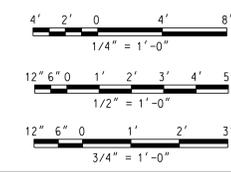

DRAWING CONTAINS
PE SEAL
ORIGINAL
ON FILE

09/05/12	IFC - REV TO INCORP DCN 346 & DCN 766	JS	CCC	HC	KMR	KMR
10/21/09	IFC - REV TO INCORP DCR-20035	JMT	RJM	HC	BBB	BBB
12/27/07	ISSUED FOR CONSTRUCTION	JMT	CCC	SAL	RA	BBB
NO.	DATE	DESCRIPTION	DR	CK	DL	PE APVD
QUALITY	0					
BECHTEL PARSONS BLUE GRASS		DOD PROGRAM MANAGER FOR ASSEMBLED CHEMICAL WEAPONS ASSESSMENT EDGEWOOD, MARYLAND		US ARMY ENGINEERING AND SUPPORT CENTER, HUNTSVILLE HUNTSVILLE, ALABAMA		
BLUE GRASS CHEMICAL AGENT DESTRUCTION PILOT PLANT PROJECT (BGCAPP) RICHMOND, KENTUCKY						
CONTRACT NO. DAAA09-03-D-0023						
SCWO PROCESS BUILDING PERIMETER FOOTINGS & SLAB SECTIONS & DETAILS						
DRAWING NUMBER 24915-10-DB-00-00014					SHEET 1 OF 12	

DESIGN FILE: \\pvc04f601\pvc04\30\se\10\10-db-00-00-14.cdf
PLOTTED BY: c0664630 ON: 9/5/2012 AT: 4:54:29 PM



A Joint Venture of Bechtel National, Inc. and
Parsons Infrastructure & Technology Group, Inc.

Calculation Sheet

Project:	BGCAPP
Job Number:	743341
Calc. No.	24915-10-DBC-00-00004
Sheet No.	1A of 9
Sheet Rev.	D

Subject: Gas Bottle Canopy, Supports, Equip. & Misc. Foundation (SPB)

By: M. Bratt Date: 1/25/2010

- Gas Bottle Canopy # 1 Foundation

A three dimensional structural analysis and design of the combined footing is carried out for the Gas Bottle Canopy # 1 support structure. It is a steel canopy structure located by the side of the exterior, eastern wall of the SCWO Process Building (SPB) between column Line A and Line D [Ref. 4.14]. (Appendix D1).

- Gas Bottle Canopy # 2 Foundation

A three dimensional structural analysis and design of the combined footing is carried out for the Gas Bottle Canopy # 2 support structure. It is a steel canopy structure located by the side of the exterior, western wall of SCWO Process Building (SPB) between column Line A and Line C [Ref. 4.14]. (Appendix D2).

- Miscellaneous Interior Equipment Foundations

Analysis and design of the foundations for the Effluent Caustic Day Tank, RO Skid, RO Multimedia Filters and Hydrolysate Heater Module are carried out. All equipment is located inside the SCWO Process Building (SPB) [Ref. 4.14] (Appendix E).

- SPB Floor Slab on Grade

Analysis and design is carried out for the floor slab on grade in the SCWO Process Building (SPB) (Appendix F).

- Anchor Bolt Design Calculation

Structural calculation is performed for the design of anchor bolt including it's adequacy for all the equipment inside and outside SCWO Process Building (SPB) (Appendix G).

- Containment and Retention Calculation

Structural calculation is carried out for containment storage area for the net capacity of the largest tank in the area inside SCWO Process Building (SPB) (Appendix H).

Changes from Rev. C to Rev. D are as follows:

1. Revised Appendix H, Containment and Retention Calculations, per environmental requirements.
2. Redesigned Gas Bottle Canopy #2 foundation due to underground interference with main building foundation.



A Joint Venture of Bechtel National, Inc. and Parsons Infrastructure & Technology Group, Inc.

Calculation Sheet

Project:	<u>BGCAPP</u>
Job Number:	<u>743341</u>
Calc. No.	<u>24915-10-DBC-00-00004</u>
Sheet No.	<u>2 of 9</u>
Sheet Rev.	<u>D</u>

Subject: Gas Bottle Canopy, Support Equip. & Misc. Foundation (SPB)

By: M. Bratt Date: 1/11/2010

Table of Contents

	Page
1. Objective	4
2. Inputs	4
3. Assumptions	7
4. References	8
5. Calculation Body	9
6. Summary	9
7. Appendices	9
App. A Design Reference Information	A-1 thru A-44
App. B Exterior Cable Tray Support Foundation.....	B-1 thru B-34
B.1 Objective	B-2
B.2 Inputs.....	B-2
B.3 Assumptions.....	B-2
B.4 Calculation Body	B-2
B.5 Summary	B-34
App. C HVAC Duct Support Foundation.....	C-1 thru C-22
C.1 Objective	C-2
C.2 Inputs.....	C-2
C.3 Assumptions.....	C-2
C.4 Calculation Body	C-2
C.6 Summary	C-22
App. D1 Gas Bottle Canopy # 1 Foundation.....	D1-1 thru D1-60
D1.1 Objective	D1-2
D1.2 Inputs.....	D1-2
D1.3 Assumptions.....	D1-2
D1.4 Calculation Body	D1-2
D1.5 Summary	D1-60



A Joint Venture of Bechtel National, Inc. and Parsons Infrastructure & Technology Group, Inc.

Calculation Sheet

Project:	<u>BGCAPP</u>
Job Number:	<u>743341</u>
Calc. No.	<u>24915-10-DBC-00-00004</u>
Sheet No.	<u>3 of 9</u>
Sheet Rev.	<u>D</u>

Subject: Gas Bottle Canopy, Support Equip. & Misc. Foundation (SPB)

By: M. Bratt Date: 1/11/2010

App. D2 Gas Bottle Canopy # 1 Foundation..... D2-1 thru D2-51

 D2.1 Objective..... D2-2

 D2.2 Inputs..... D2-2

 D2.3 Assumptions..... D2-2

 D2.4 Calculation Body D2-2

 D2.5 Summary D2-51

App. E Miscellaneous Interior Equipment Foundations E-1 thru E-80

 E.1 Objective..... E-2

 E.2 Inputs..... E-2

 E.3 Assumptions..... E-2

 E.4 Calculation Body E-3

 E.5 Summary E-80

App. F SPB Floor Slab on Grade..... F-1 thru F-5

 F.1 Objective..... F-2

 F.2 Inputs..... F-2

 F.3 Assumptions..... F-2

 F.4 Calculation Body F-2

 F.6 Summary F-5

App. G Anchor Bolt Calculations..... G-1 thru G-85

App. H Containment and Retention Calculations..... H-1 thru H-8

Project:	<u>BGCAPP</u>
Job Number:	<u>743341</u>
Calc. No.	<u>24915-10-DBC-00-00004</u>
Sheet No.	<u>4 of 9</u>
Sheet Rev.	<u>D</u>

Subject: Gas Bottle Canopy, Support Equip. & Misc. Foundation (SPB)By: M. Bratt Date: 1/11/2010

1. Objective

The objective of the calculation is to perform structural analysis and design for the gas bottle canopies, support equipment and miscellaneous foundations inside and outside the SCWO Processing Building (SPB) of the BGCAPP project per Dwg. # 24915-10-DB-00-00002 (refer to p. A-1 to A-46 for locations).

2. Inputs

2.1 Foundations

The calculation includes analysis and design of foundations for the following structures in the SCWO Processing Building (SPB).

- Exterior Cable Tray Support Foundations

A structural analysis and design of isolated footings are carried out for the supports for elevated cable trays located along the eastern wall of the SCWO Process Building (SPB). The cable tray support structure span from Column Line B thru Line J [Ref. 4.14].

(Ref. Appendix B)

- Exterior HVAC Duct Support Foundations

A structural analysis and design of isolated footings are carried out for the support for HVAC ducts along the eastern part of the SCWO Process Building (SPB). Ducts extend out from the face of the structure between column Line H thru Line J toward the east and connect to HVAC units 10-MA-HVAC-AHU 1001 and AHU-1002 [Ref. 4.14].

(Ref. Appendix C)

Project:	<u>BGCAPP</u>
Job Number:	<u>743341</u>
Calc. No.	<u>24915-10-DBC-00-00004</u>
Sheet No.	<u>5 of 9</u>
Sheet Rev.	<u>D</u>

Subject: Gas Bottle Canopy, Support Equip. & Misc. Foundation (SPB)By: M. Bratt Date: 1/11/2010

- Gas Bottle Canopy # 1 Foundation

A three dimensional structural analysis and design of the combined footing is carried out for the Gas Bottle Canopy # 1 support structure. It is a steel canopy structure located by the side of the exterior, eastern wall of the SCWO Process Building (SPB) between column Line A and Line D [Ref. 4.14]. The steel model in Calculation 24915-10-SSC-00-00006 has been updated to remove the dynamic seismic analysis. However, loads have not increased so the previous design is adequate.

(Ref. Appendix D1)

- Gas Bottle Canopy # 2 Foundation

A three dimensional structural analysis and design of the combined footing is carried out for the Gas Bottle Canopy # 2 support structure. It is a steel canopy structure located by the side of the exterior, western wall of the SCWO Process Building (SPB) between column Line A and Line C [Ref. 4.14]. The steel model in Calculation 24915-10-SSC-00-00006 has been updated to remove the dynamic seismic analysis. However, loads have not increased so the previous design is adequate.

(Ref. Appendix D2)

- Miscellaneous Interior Equipment Foundations

Analysis and design of the foundations are carried out for the Effluent Caustic Day Tank (MV-RO-0101), RO Skid (MK-RO-0101), RO Multi-Media Filters (MK-RO-0101A through MK-RO-0101F) and Hydrolysate Heater Module (MK-SCWO-0042). All equipment is located inside the SCWO Process Building (SPB) [Ref. 4.14].

(Ref. Appendix E).

- SPB Floor Slab on Grade

Analysis and design is carried out for the floor slab on grade in the SCWO Process Building (SPB).

(Ref. Appendix F)

Project:	<u>BGCAPP</u>
Job Number:	<u>743341</u>
Calc. No.	<u>24915-10-DBC-00-00004</u>
Sheet No.	<u>6 of 9</u>
Sheet Rev.	<u>D</u>

Subject: Gas Bottle Canopy, Support Equip. & Misc. Foundation (SPB)By: M. Bratt Date: 1/11/2010

- **Anchor Bolt Design Calculation**

Structural calculation is performed for the design of anchor bolts including their adequacy for all the equipment inside and outside the SCWO Process Building (SPB).

(Ref. Appendix G)

- **Containment and Retention Calculation**

Calculations are carried for containment storage areas to confine the net capacity of the largest tank in the area inside the SCWO Process Building (SPB).

(Ref. Appendix H)

2.2 Construction Materials

- Normal weight concrete with its 28-day concrete strength of at least $f'_c = 4,000$ psi and an elastic modulus $E_c = 3,600$ ksi [Ref. 4.5, 4.15].

The reinforcing steel is ASTM A706, Grade 60, $f_y = 60$ ksi [Ref. 4.5, 4.15].

2.3 Soil Properties

The soil properties for the project are listed below:

- Soil density is = 125 pcf [Ref. 4.3].
- Coefficient of vertical subgrade reaction of the soil is $k_s = 150$ pci [Ref. 4.1, 4.3].
- Maximum allowable net bearing pressure is 3,000 psf [Ref. 4.1, 4.3].
- Exterior footing should be founded at least 30 inch below final exterior grade for unheated structures, and 24 inch for heated structures [Ref. 4.2].

2.4 Seismic Analysis Data [Ref.4.6]

- The following data is based on Table 12-2 of the design criteria [Ref. 4.2], except as noted.
- Seismic use group: I

Project:	<u>BGCAPP</u>
Job Number:	<u>743341</u>
Calc. No.	<u>24915-10-DBC-00-00004</u>
Sheet No.	<u>7 of 9</u>
Sheet Rev.	<u>D</u>

Subject: Gas Bottle Canopy, Support Equip. & Misc. Foundation (SPB)By: M. Bratt Date: 1/11/2010

- Site classification: D
- Occupancy Importance Factor [Ref. 4.12]: I = 1.5 for Q equipment, 1.0 for non-Q
- Ground Motion A [Ref. 4.6]

$$S_{DS} = 2/3 S_{ms} = 0.273 g$$

$$S_{D1} = 2/3 S_{m1} = 0.167 g$$

2.5 Live Load

Roof live load is 20 psf [Ref. 4.2].

Platform and work area is 100 psf and 2000 lbs concentrated load [Ref. 4.2].

2.6 Wind Load

Per the basis of design [Ref. 4.12], the basic wind speed is 90 mph based on 3-second gust, the importance factor for wind is 1.15, and the site exposure classification is C [Ref. 4.4].

2.7 Snow Load

Per the basis of design (Ref. 4.12), the ground snow load is 15 psf, the importance factor for snow is 1.2, and roof snow load are calculated per ASCE 7-98 code (Ref. 4.4).

2.8 Tank Information

The available tank information is included in Appendix A that is used in the tank foundation analysis and design. Assumptions are made to those tank data not available at the time of design (see Sec. 3 for additional discussion).

3. Assumptions

Equipment information catalog cuts are obtained from the project directory (I:\Blue Grass). They are based on the best knowledge available at the time of the calculations. Final vendor information for

Project:	<u>BGCAPP</u>
Job Number:	<u>743341</u>
Calc. No.	<u>24915-10-DBC-00-00004</u>
Sheet No.	<u>8 of 9</u>
Sheet Rev.	<u>D</u>

Subject: Gas Bottle Canopy, Support Equip. & Misc. Foundation (SPB)By: M. Bratt Date: 1/11/2010

equipment loads was not available during the preparation of these calculations. It will be included in the final design and confirmed calculations.

4. References

- [4.1] BGCAPP BOD Rev 3, Section 3.3.2.2.3
- [4.2] BGCAPP Design Criteria (24915-000-3DR-G01-00001) Rev. 11 Structural, April 2009
- [4.3] Geotechnical Report (24915-00-30R-G01-00037 Rev 1)
- [4.4] ASCE 7-98: Minimum Design Loads for Buildings and Other Structures, ASCE, 2000
- [4.5] ACI 318-02: Building Code Requirements for structural Concrete, ACI, 2002
- [4.6] IBC 2000: International Building Code, ICBO, 2000
- [4.7] *** Removed from calculation ***
- [4.8] *** Removed from calculation ***
- [4.9] Munshi, J.A.: Design of Liquid-Containing Concrete Structures for Earthquake Forces, Portland Cement Association, 2002
- [4.10] ACI 350.3-01: Seismic Design of Liquid-Containing Concrete Structures, American Concrete Institute, 2001
- [4.11] Moss, D.R.: Pressure Vessel Design Manual, Gulf Publishing Company, 1987
- [4.12] BGCAPP Engineering Specification for General Project Requirements, Doc. No. 24915-000-3PS-G000-00001 Rev. 6, 11/2/2006
- [4.13] AISC Load and Resistance Factor Design 2nd Edition, 1995
- [4.14] BGCAPP Drawing No. 24915-10-DB-00-00002, 00005 thru -00011,-00022,-00037,-00038,-00050,-00061 (see p. A1 thru A19)
- [4.15] ACI 301 - Specification for Structural Concrete, ACI, 1999
- [4.16] Email from Leo Weitzman to Chiman Patel, Sept. 6, 2007
- [4.17] Portland Cement Association, "Anchorage to Concrete, Chapter 34", February, 2006
- [4.18] BGCAPP Calculation No. 24915-10-SSC-00-00001 thru -00004, 24915-10-DBC-00-00001, 00002, -00004



A Joint Venture of Bechtel National, Inc. and Parsons Infrastructure & Technology Group, Inc.

Calculation Sheet

Project:	<u>BGCAPP</u>
Job Number:	<u>743341</u>
Calc. No.	<u>24915-10-DBC-00-00004</u>
Sheet No.	<u>9 of 9</u>
Sheet Rev.	<u>D</u>

Subject: Gas Bottle Canopy, Support Equip. & Misc. Foundation (SPB)

By: M. Bratt Date: 1/11/2010

5. Calculation Body

The foundation design is included in appendices B through H of the calculation. MathCAD worksheets are developed to compute base shears and overturning moments of tanks based on IBC2000 provisions and the related standards and references listed in Sec. 4. Static analysis has been used in this calculation. Foundation3D and Mat3D are used to analyze and design the foundations.

6. Summary

This calculation includes analysis and design of foundations for structures and equipment in and around the SPB. Detailed design can be found in BGCAPP Drawings No. 24915-10-DB-00-00002, 00005 thru -00011, 00022, 00037, 00038, 00050, 00061 showing current revisions of the foundation design details. All loads and bearing pressures are checked according to their design capability to meet AISC/LRFD code requirements [Ref. 4.3, 4.13].

7. Appendices

Appendix A:	Design Reference Information	A-1 to A-44
Appendix B:	Exterior Cable Tray Support Foundations	B-1 to B-34
Appendix C:	Exterior HVAC Duct Support Foundations	C-1 to C-22
Appendix D1:	Gas Bottle Canopy # 1 Foundation	D1-1 to D1-60
Appendix D2:	Gas Bottle Canopy # 2 Foundation	D2-1 to D2-51
Appendix E:	Miscellaneous Interior Equipment Foundation	E-1 to E-80
Appendix F:	SPB Floor Slab on Grade	F-1 to F-5
Appendix G:	Anchor Bolt Calculation	G-1 to G-85
Appendix H:	Containment and Retention Calculation	H-1 to H-8



A Joint Venture of Bechtel National, Inc. and
Parsons Infrastructure & Technology Group, Inc.


Calculation Sheet

Project:	<u>BGCAPP</u>
Job Number:	<u>743341</u>
Calc. No.	<u>24915-10-DBC-00-00004</u>
Sheet No.	<u>A-1 of A-44</u>
Sheet Rev.	<u>D</u>


Subject:	<u>Gas Bottles Canopy, Supports, Equip., & Misc. Foundations</u>	
By:	<u>M. Bratt</u>	Date: <u>1/11/2010</u>

Appendix A

Design Reference Information

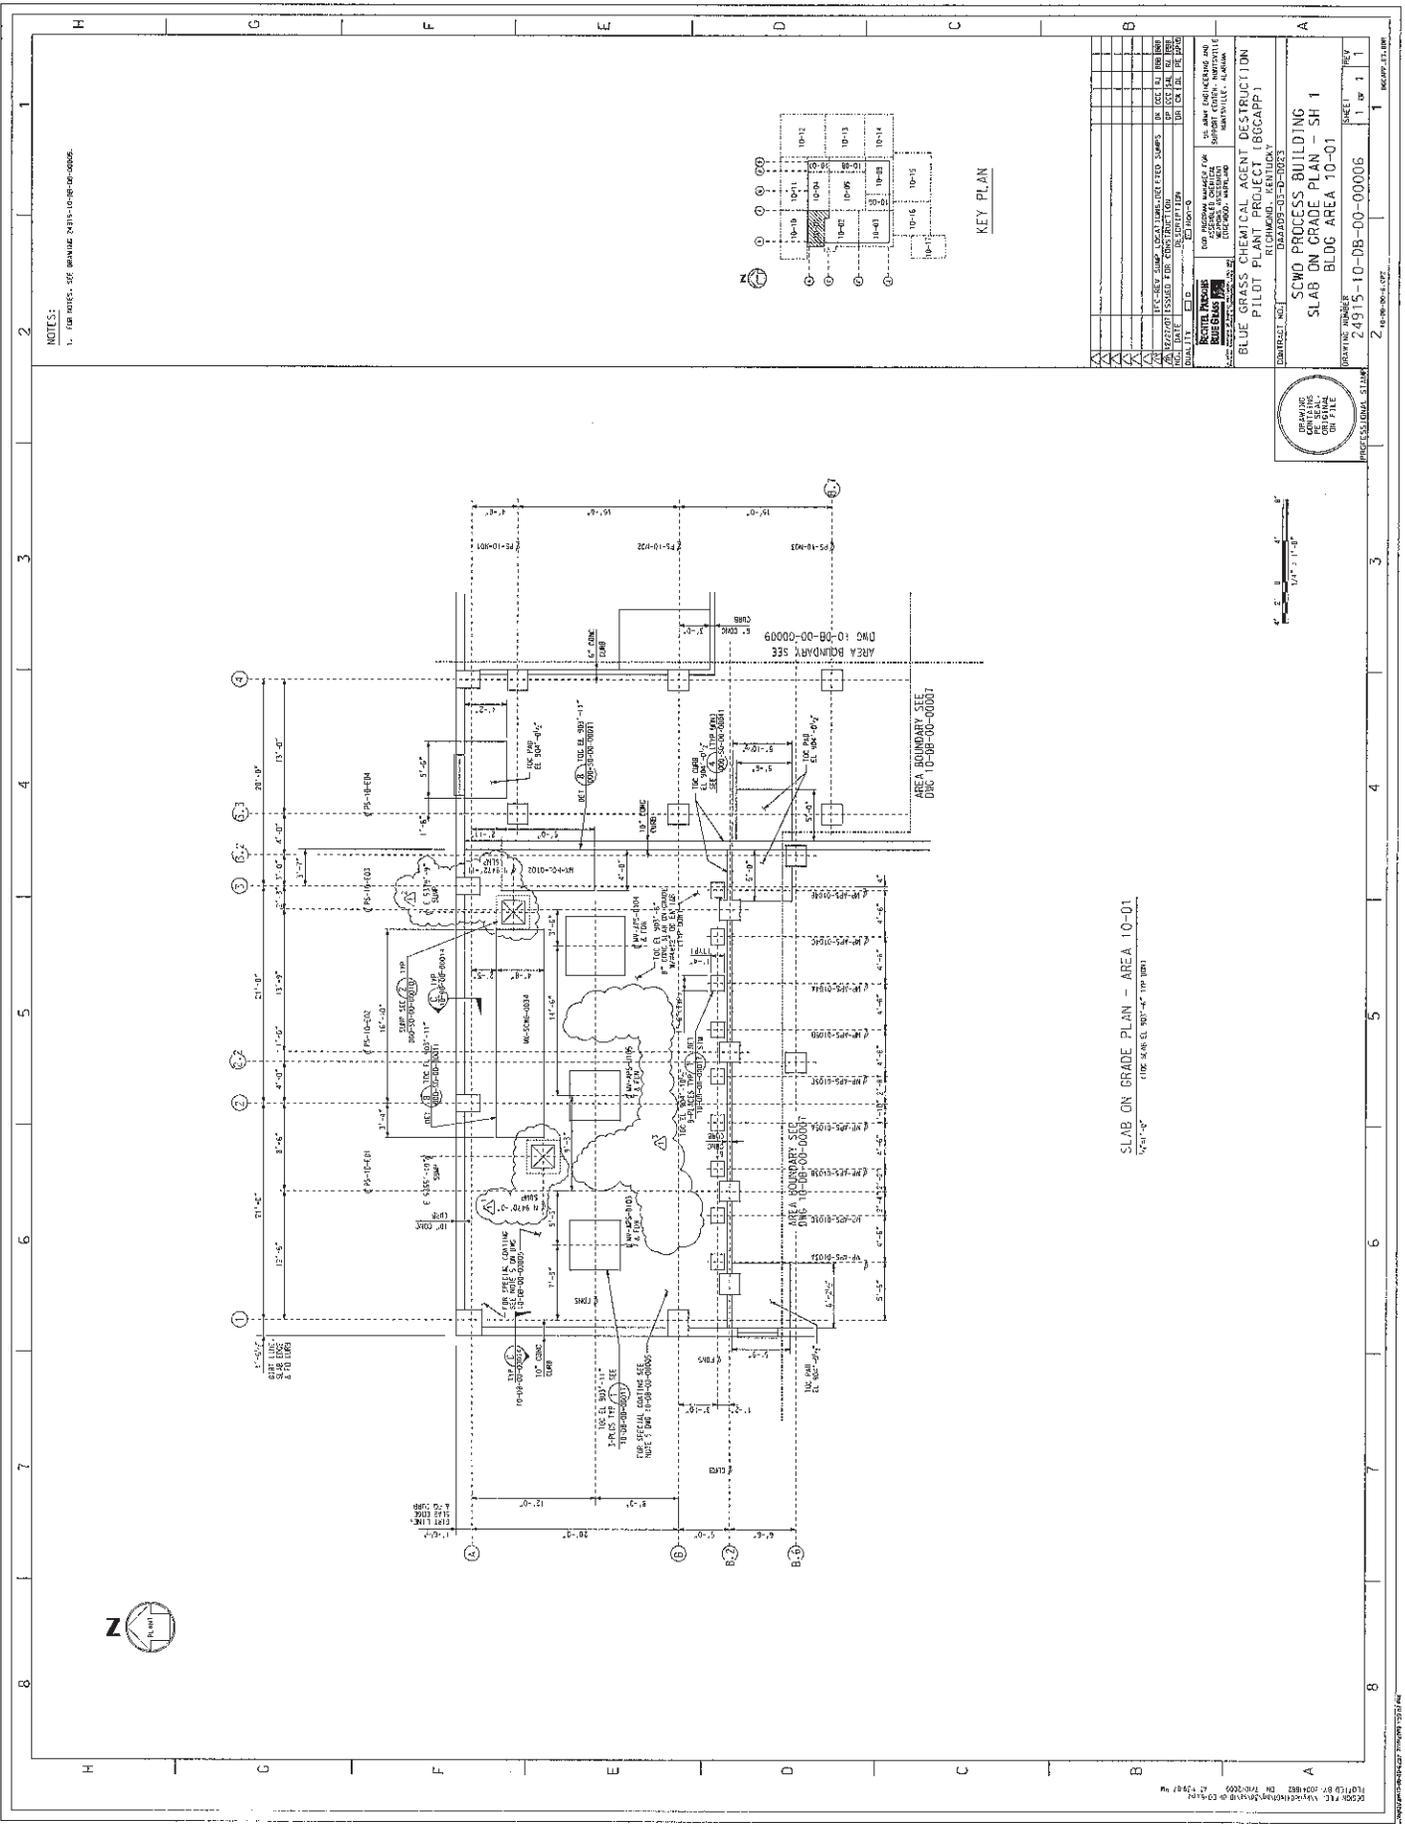

NOTES:
1. FOR NOTES, SEE DRAWING 24915-10-DB-00-00005.

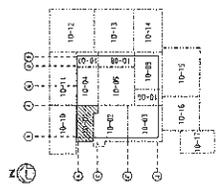


SLAB ON GRADE PLAN - AREA 10-01


DRAWING NUMBER: 24915-10-DB-00-00006
SHEET: 1 OF 1



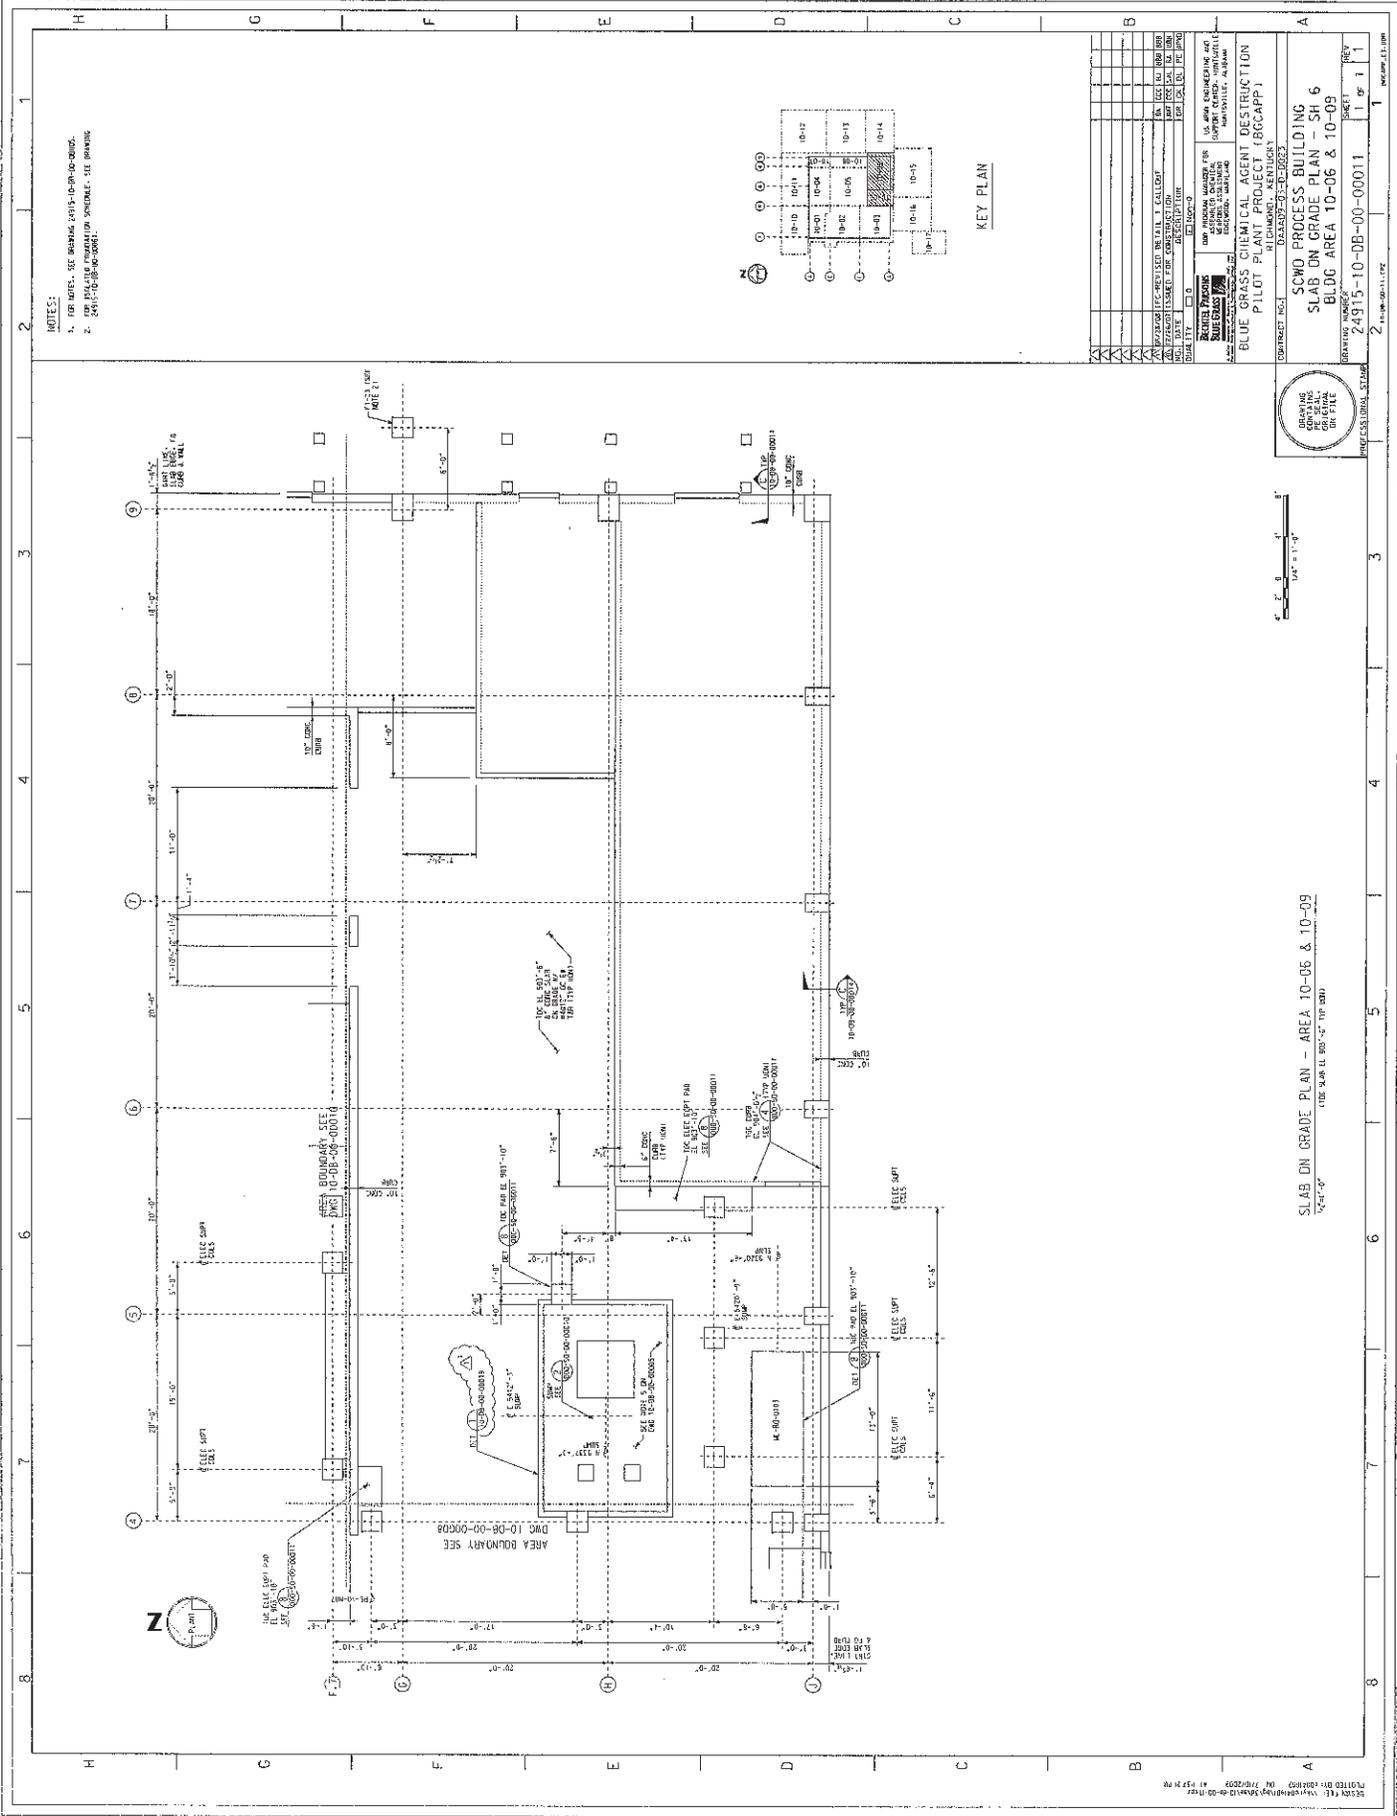

- NOTES:
1. FOR NOTES, SEE DRAWING 24915-10-DB-00-00005.
 2. FOR DETAILS, SEE DRAWING 24915-10-DB-00-00007.

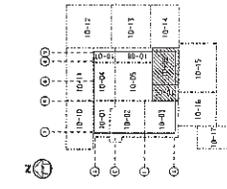

KEY PLAN

SCWO PROCESS BUILDING
 SLAB ON GRADE PLAN - SH 6
 BLDG AREA 10-06 & 10-09

24915-10-DB-00-00011

BLUE GRASS CHEMICAL AGENT DESTRUCTION
 PILOT PLANT

SCALE: 1/4" = 1'-0"

SLAB ON GRADE PLAN - AREA 10-06 & 10-09













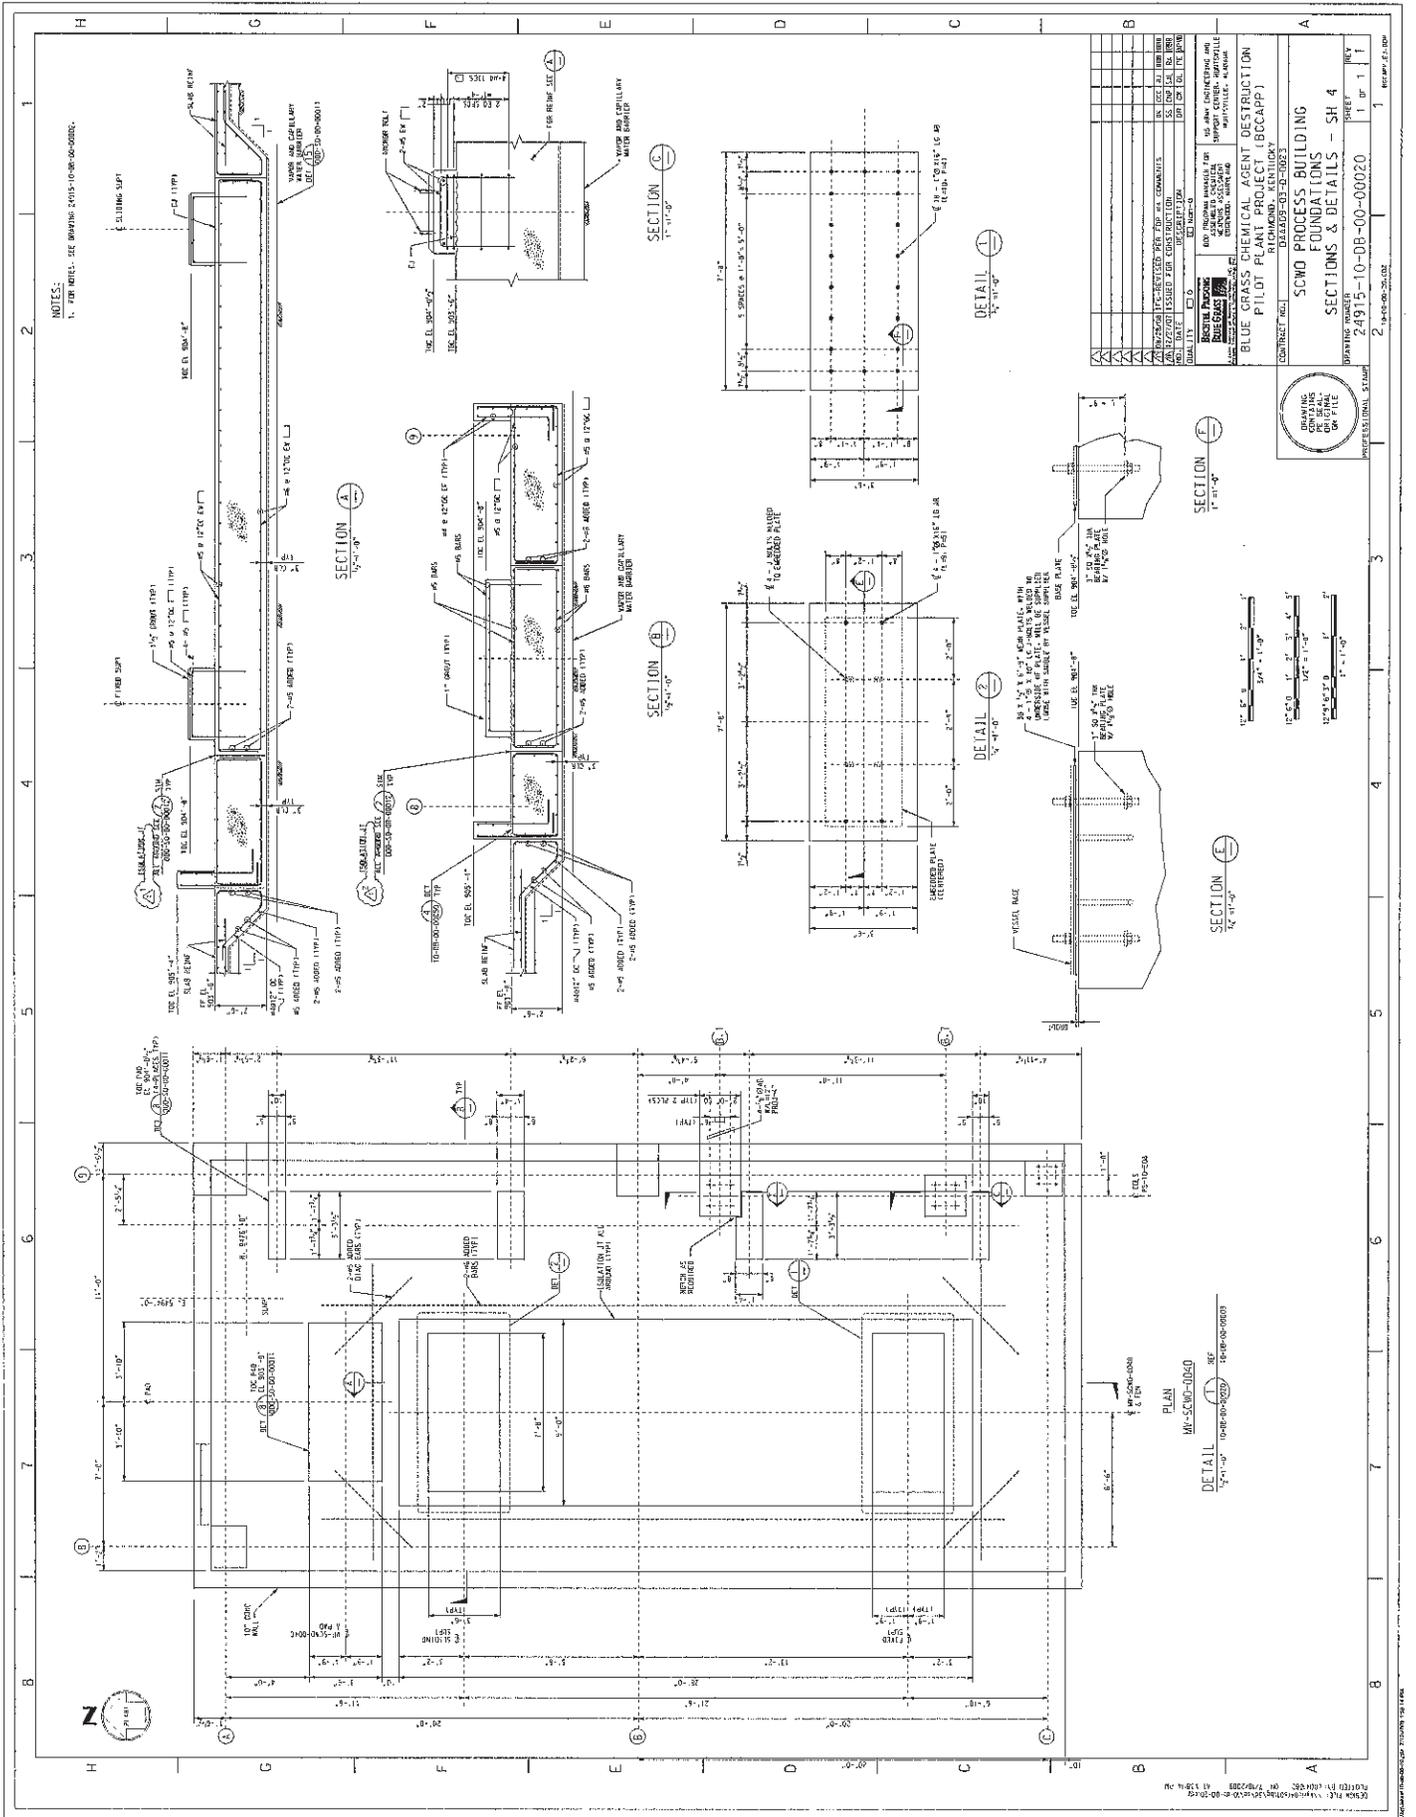

NOTES:
 1. FOR NOTES, SEE DRAWING 24915-10-DB-00-00004

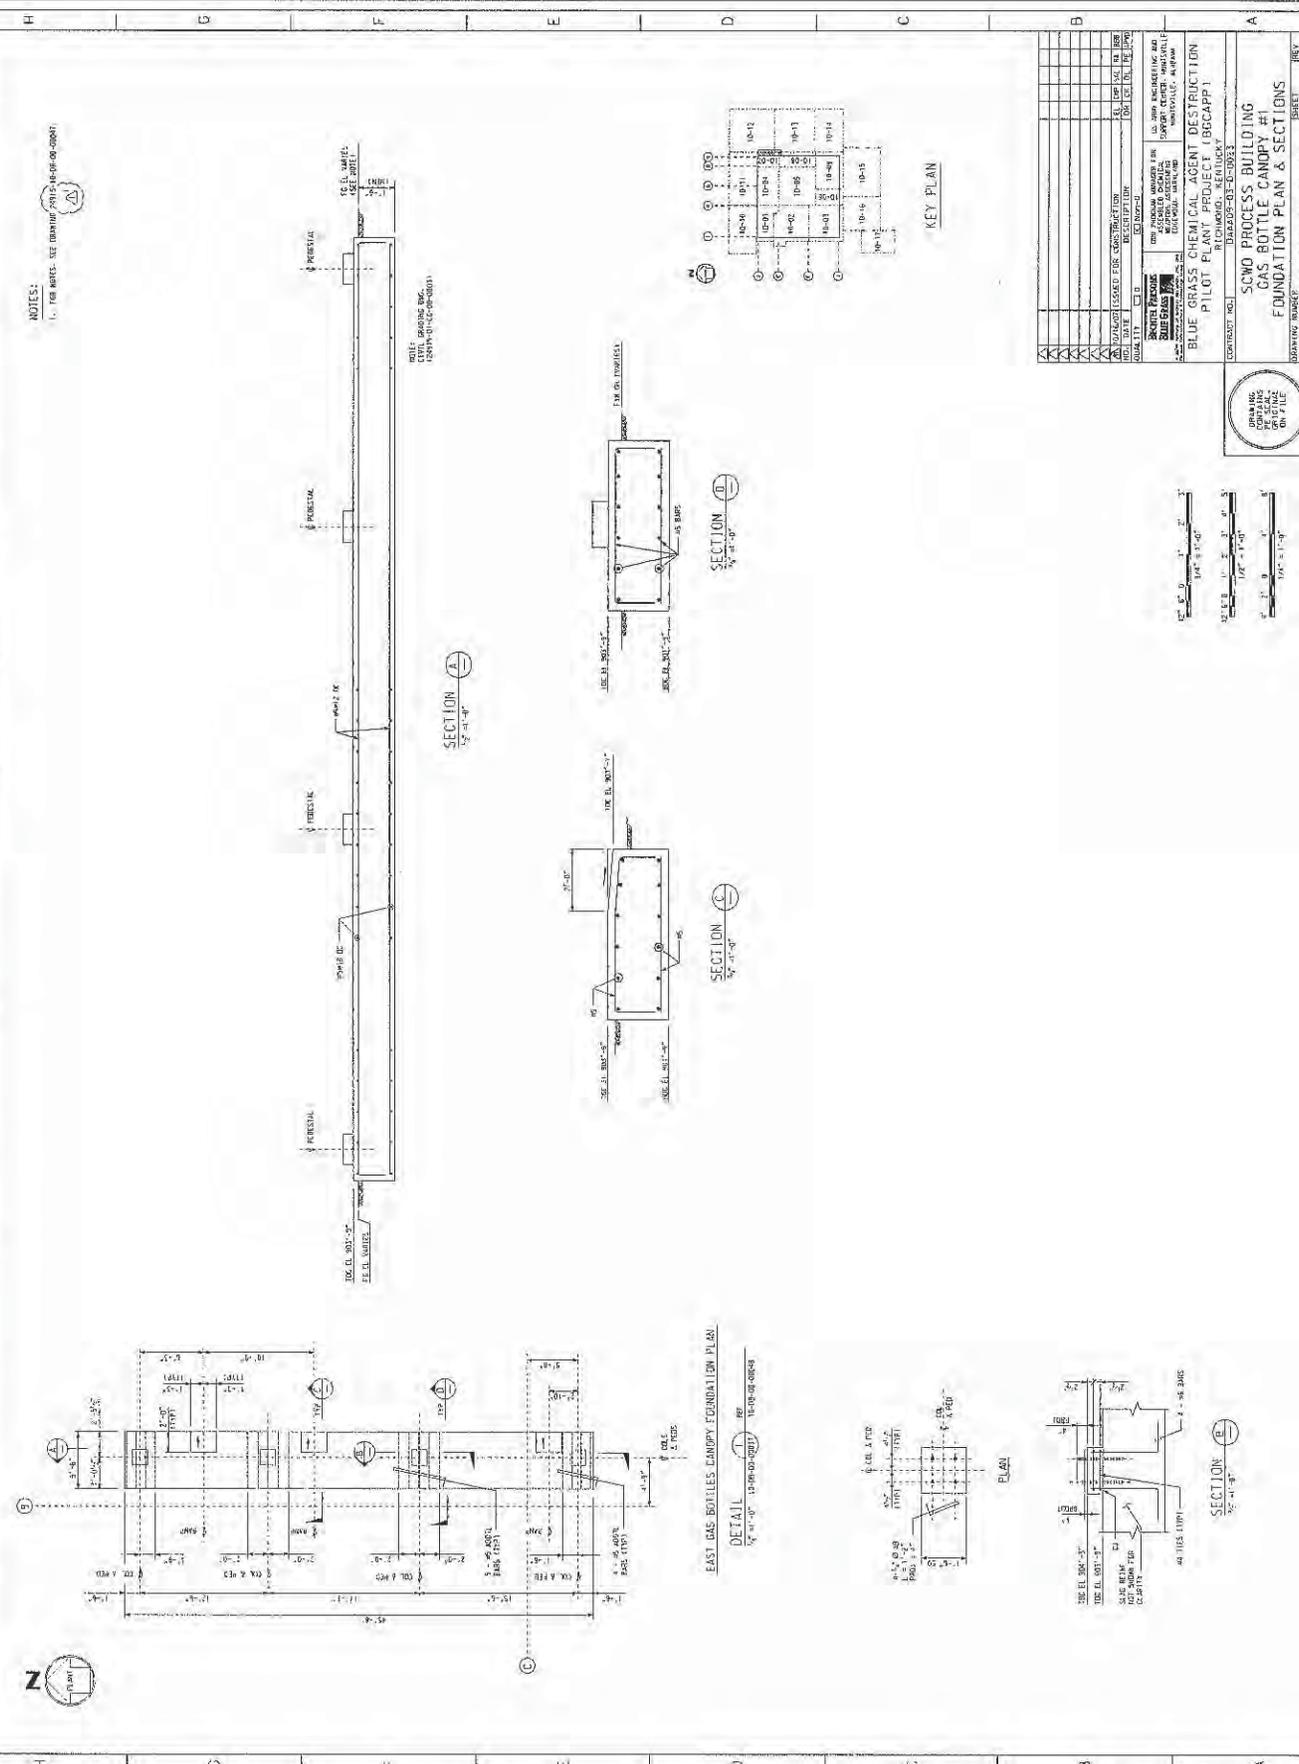



 RICHMOND, KENTUCKY

SCWO PROCESS BUILDING
 GAS BOTTLE CANOPY #1
 FOUNDATION PLAN & SECTIONS


DRAWING NUMBER: 24915-10-DB-00-00004
 SHEET: 1 OF 1
 REV: D

SCALE: 1/4" = 1'-0"
 1/2" = 1'-0"
 3/4" = 1'-0"
 1" = 1'-0"


UPDATING FOR CLEARANCE OF PIPE ON PLATE
 PROFESSIONAL SEAL

DATE: 10/11/10 10:58 AM


NOTES:
1. FOR NOTES, SEE DRAWING 10-55-00-0001.

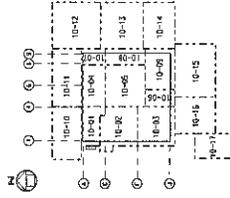


KEY PLAN

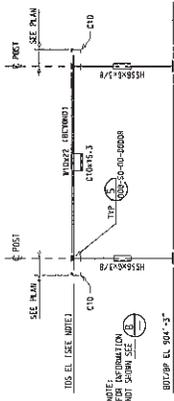


SECTION A-A
1/2" x 1'-0"

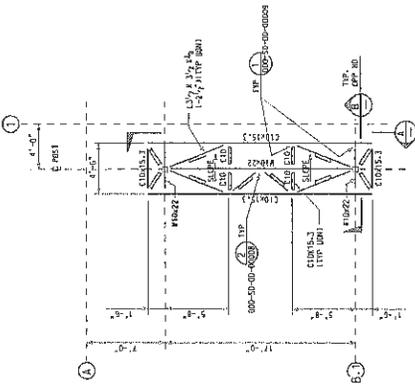

FRAMING PLAN
WEST GAS BOTTLE CANOPY
1/2" x 1'-0"

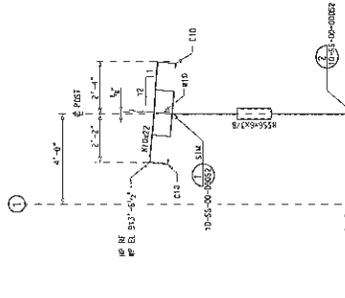

SECTION B-B
1/2" x 1'-0"

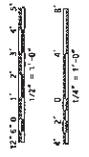







- NOTES:
1. FOR SYMBOLS, ABREVIATIONS, GENERAL NOTES AND TYPICAL DETAILS, SEE DRAWING 24915-10-SS-00-00001 THRU 24915-10-SS-00-00004.
 2. REFER TO DRAWING 24915-10-SS-00-00004 FOR DUCT SUPPORT FOUNDING ELEVATIONS.

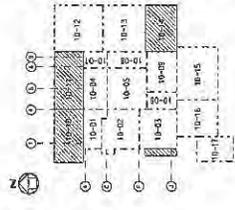

KEY PLAN

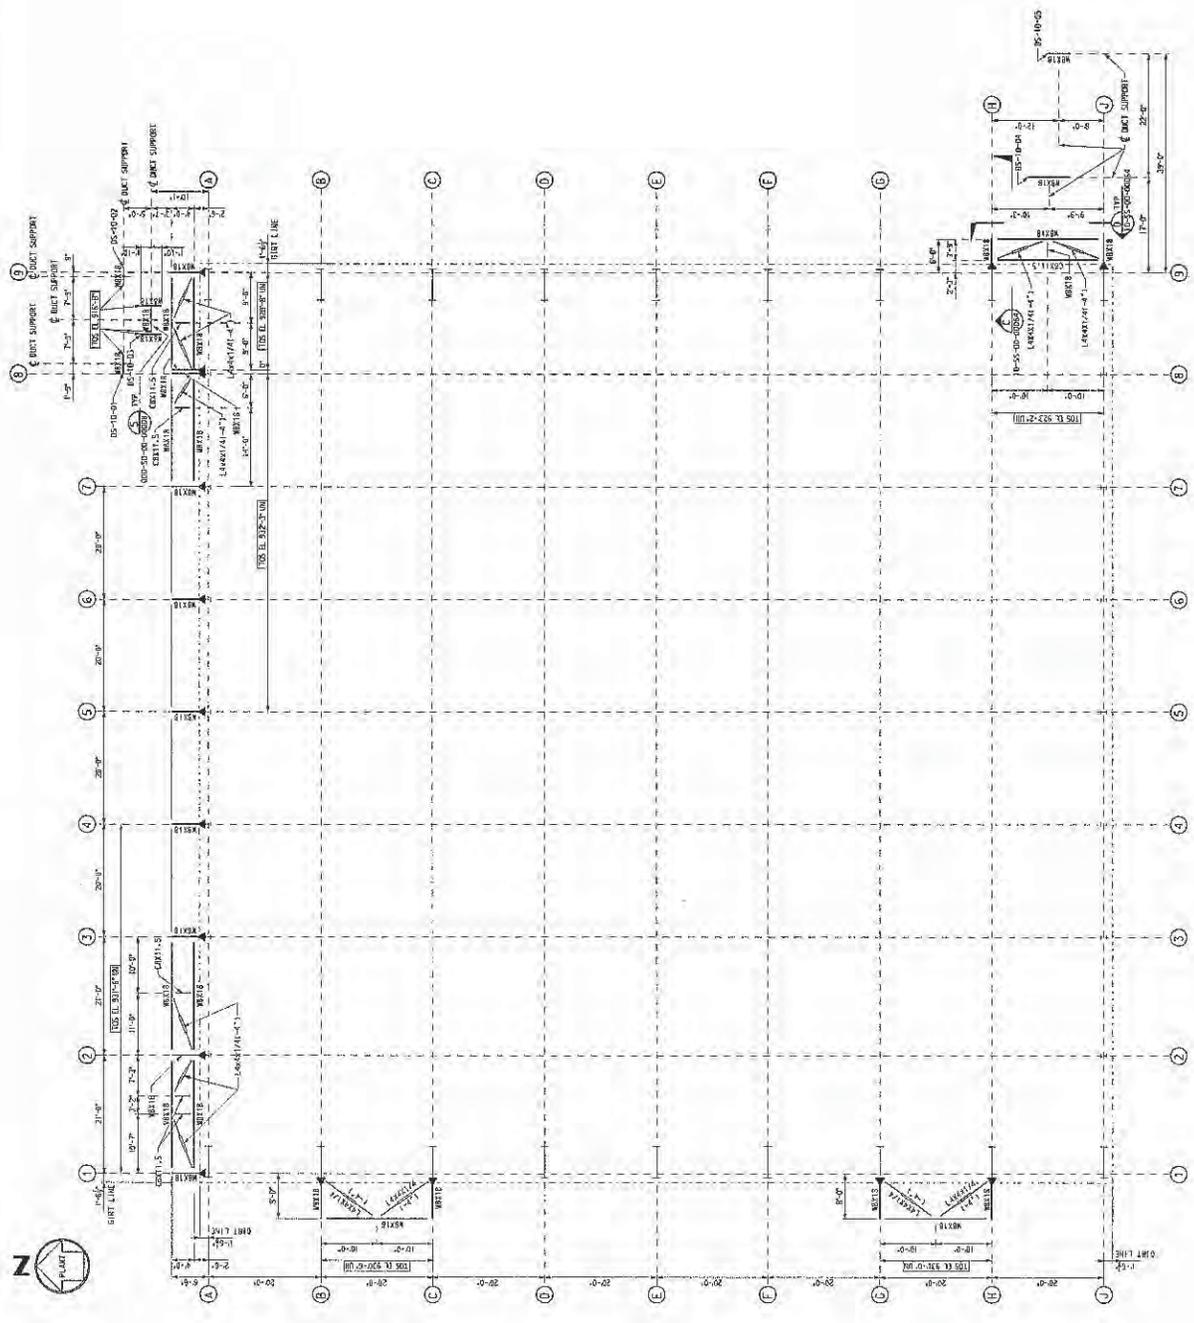

MISCELLANEOUS DUCT SUPPORTS: FRAMING PLAN
1/8" = 1'-0"




PROJECT NO. 24915-10-SS-00-00004
 CONTRACT NO. DAAG09-03-0-0003
 DRAWING NO. A-17 OF A-44
 SHEET 1 OF 10
 REV 10

 PILOT PLANT PROJECT (BGCAPP)







SCMO PROCESS BUILDING
 MISC DUCT SUPPORTS
 FRAMING PLAN

PROFESSIONAL STAMP
 24915-10-SS-00-00003
 10-10-03-01-002
 10-10-03-01-002



NOTES:

1. FOR SYMBOLS, ABBREVIATIONS, GENERAL NOTES AND TYPICAL DETAILS SEE DRAWING 24915-10-SS-00-00000 THRU 24915-10-SS-00-00004.

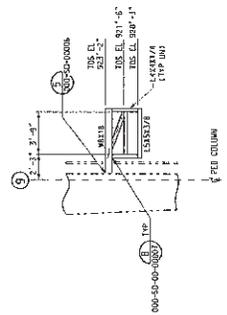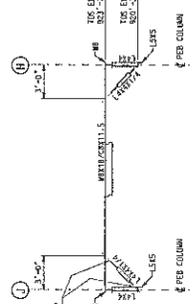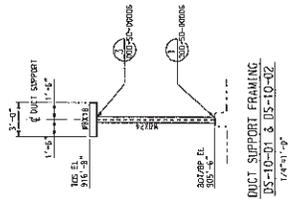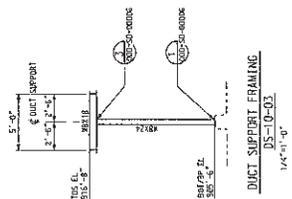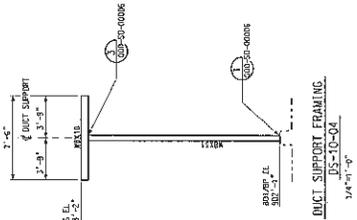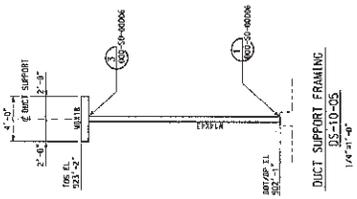











		Project Number	Document Number	Rev	Date	Sheet of		
		24915	24915-10-MVD-RO-00001	0	2/24/2009	1	7	
Project, Client, Location				Document Title				
Blue Grass Chemical Agent-Destruction Pilot Plant (BGCAPP) Project				SCWO EFFLUENT CAUSTIC DAY TANK MV-RO-0101				
<input type="checkbox"/> In-House Review		<input type="checkbox"/> Client Approval		<input type="checkbox"/> Quotation		<input checked="" type="checkbox"/> All Data Sheets Attached		
<input checked="" type="checkbox"/> Purchase		<input type="checkbox"/> Construction		<input type="checkbox"/> Design		<input type="checkbox"/> Revised Data Sheets Only Attached		
QUALITY:		<input type="checkbox"/> Q		<input checked="" type="checkbox"/> NON-Q				
TOXIC CATEGORY		<input type="checkbox"/> A		<input type="checkbox"/> B		<input type="checkbox"/> A/B		
						<input type="checkbox"/> N/A		
						<input type="checkbox"/> OTHER		
REV	DATE	BY	CHK	DL	PROJ ENGR	QA	APPR	REMARKS
0	02/24/09	SC SC	<i>BM</i> BM	<i>BM</i> BM	<i>BBB</i> BBB	<i>JW</i> JW		Issued for Purchase
This sheet is a record of each issue or revision to the subject specification. Each time the specification is to be changed, only the new or revised sheets must be issued. The exact sheets changed and the nature of the change should be noted in the Remarks column; however, these remarks are not part of the specification. The revised data sheets shall become part of the original specification and shall be compiled within their entirety.								
				DC-		DT-		

FILE NAME: MVR00101




DATA SHEET

TITLE
BGCAPP
SCWO EFFLUENT CAUSTIC DAY TANK
MV-RO-0101

SHEET OF PROJECT NUMBER
 2 7 24915

DOCUMENT NUMBER REV
 24915-10-MVD-RO-00001 0

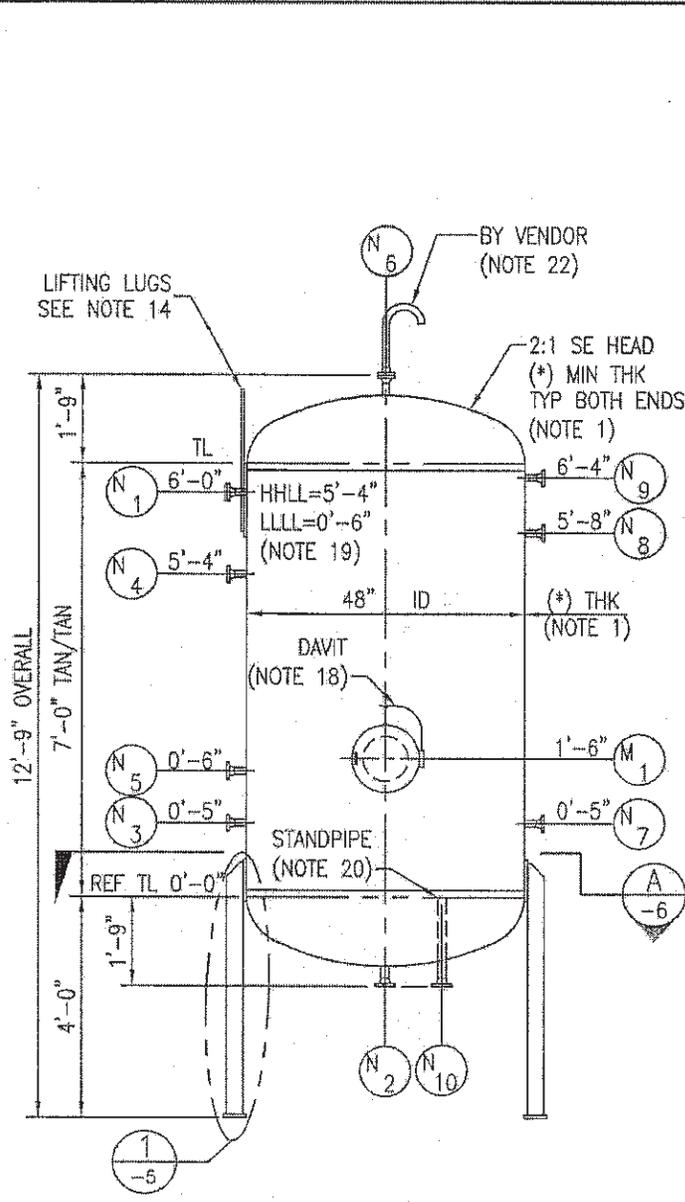

ONE REQD MV-RO-0101
 SEE SHEET 7 FOR TRUE ORIENTATION

CODE: ASME SECT VIII DIV 1 (CODE CONSTR. ONLY)	
CODE CERT REQD	NO
CODE STAMP	NO
NATIONAL BOARD REGISTRATION: NO	
OPR PRESS (INT)	ATM PSIG AT 77 °F
DES PRESS. (INT)	14.9 PSIG AT 125 °F
DES PRESS. (EXT)	0 PSIG AT 125 °F
MIN DESIGN METAL TEMP (-)	1 °F AT 14.9 PSIG
CRSN ALLOW SHELL = 1/8" HEADS = 1/8" NOZZ = 1/8"	
LIQUID LEVEL FOR DESIGN:	FULL AT SP GR 1.19
SEISMIC DESIGN:	SEE NOTE 10
WIND DESIGN:	SEE NOTE 11
MAWP	(*) PSIG AT 125 °F LIMITED BY (*)
MAP N&C	(*) PSIG AT AMB TEMP LIMITED BY (*)
SHOP HYD	(*) PSIG AT 70 °F MIN HORIZ POSN
FIELD HYD NEW	(*) PSIG AT 70 °F MIN OPR POSN
FIELD HYD CORR	(*) PSIG AT 70 °F MIN OPR POSN
PWHT	(PER CODE) RADIOGRAPHY (PER CODE)
JOINT EFF: SHELL	(PER CODE) HEADS (PER CODE)
ALLOW STRESS	20,000 PSI AT DESIGN TEMP 125°F
MATERIALS:	
SHELL	SA-516-70
HEADS	SA-516-70
SUPPORTS	SA-36
INTERNALS	N/A TRAYS N/A
BOLTS (INT)	N/A NUTS N/A
BOLTS (EXT)	SA-193-B7 NUTS SA-194-2H
FLANGES	SA-105
NOZZLE NECKS	SA-106B
GASKETS	NOTE 21
CAPACITY (WORKING)	350 GAL
FAB WT (*) (NOTE 1&15) LB	EMPTY WT (*) (NOTE 1&15) LB
TRAY WT	N/A LB PACKING WT N/A LB
OPR WT (*) (NOTE 1&15) LB	TEST WT (*) (NOTE 1&15) LB
PAINTING SEE NOTE 12	
INSULATION NONE	
FIREPROOFING NONE	
ACCESSORIES BY FABRICATOR:	YES NO
VESSEL DAVIT MARK No.	X
LADDER & PLATFORM CLIPS	X
PIPE SUPPORT AND PIPE GUIDE CLIPS	X
INSULATION SUPPORTS	X
FIREPROOFING SUPPORTS	X
VORTEX BREAKER	X
LIFTING AND GROUNDING LUGS	X

NOZZLE SCHEDULE

ITEM	No.	SIZE	PROJ	RATING	SERVICE
M1	1	24"	3'-0"	150#	MH W/ BF & DAVIT
N1	1	2"	2'-8"	150#	INLET
N2	1	2"	SEE ELEV	150#	DRAIN
N3	1	3"	2'-8"	150#	LEVEL TRANSMITTER
N4	1	2"	2'-8"	150#	LSHH
N5	1	2"	2'-8"	150#	LSLL
N6	1	2"	SEE ELEV	150#	VENT WITH PIPE
N7	1	2"	2'-8"	150#	THERMOWELL
N8	1	3"	2'-8"	150#	SPARE W/ BF
N9	1	2"	2'-8"	150#	OVERFLOW
N10	1	2"	SEE ELEV	150#	OUTLET W/ INT. PIPE

FLANGE: RFWN FINISH: 125-250 AARH

NOTE #7

FILE NAME: MVR00101B

 BECHTEL PARSONS BLUE GRASS DATA SHEET	TITLE	BGCAPP SCWO EFFLUENT CAUSTIC DAY TANK MV-RO-0101	SHEET 3	OF 7	PROJECT NUMBER 24915	DOCUMENT NUMBER 24915-10-MVD-RO-00001	REV 0

NOTES

1. THE VESSEL SUPPLIER SHALL DESIGN, FURNISH, FABRICATE, INSPECT, TEST AND DELIVER THE VESSEL IN ACCORDANCE WITH THIS DATA SHEET, ATTACHED SPECIFICATIONS AND STANDARDS. VESSEL SHELL THICKNESS, HEAD THICKNESS, WEIGHTS, AND SUPPORT DESIGN ARE PRELIMINARY. VESSEL SHALL BE DESIGNED IN ACCORDANCE WITH SPECIFIED DESIGN REQUIREMENTS, SEE NOTES 10 AND 11.
2. ALL DIMENSIONS ARE FROM REF TANGENT LINE, EXCEPT AS SHOWN.
3. NOZZLES AND MANHOLE SHALL HAVE SAME DESIGNATION AS SHOWN ON THIS DRAWING.
4. BOLT HOLES SHALL STRADDLE THE VERTICAL CENTERLINES OF THE VESSEL FOR NOZZLES ON THE SHELL AND PLANT NORTH-SOUTH, EAST-WEST CENTERLINES FOR NOZZLES ON THE HEADS.
5. ALL ATTACHMENTS WELDED TO VESSEL PRESSURE PARTS SHALL BE SAME MATERIAL AS PRESSURE PART, UNLESS OTHERWISE NOTED.
6. VESSEL SHALL BE THOROUGHLY CLEANED INSIDE AND OUTSIDE, SHALL BE FREE FROM RUST, SCALE, SLAG, WELD SPLATTER AND FOREIGN MATTER PRIOR TO SHOP HYDROTEST, AND SHALL BE THOROUGHLY DRIED AFTER HYDROTEST.
7. PROJECTION OF RADIAL NOZZLES AND MANHOLES ARE FROM VESSEL CENTER LINE TO EXTREME FACE OF FLANGE.
8. ALL VESSEL COMPONENTS SHALL BE FURNISHED IN ACCORDANCE WITH STANDARDS LISTED BELOW.
9. ITEMS WITH (*) ARE VESSEL FABRICATOR RESPONSIBILITY.
10. SEISMIC FORCES SHALL BE DETERMINED PER SPECIFICATION 24915-000-3PS-SV00-00001, SPECIFICATION FOR SEISMIC PROTECTION OF EQUIPMENT.
11. THE GENERAL PROJECT SPECIFICATION, 24915-000-3PS-G000-00001, PROVIDES PROJECT DETAILS AND DESIGN CONDITIONS FOR THE SITE. THIS VESSEL IS PART OF THE SUPER CRITICAL WATER OXIDATION (SCWO) BUILDING AND IS INSTALLED INSIDE THE BUILDING AND WILL NOT BE SUBJECT TO SITE CONDITIONS SUCH AS WIND, PRECIPITATION, SNOW, ETC. OTHER GENERAL REQUIREMENTS FOR EQUIPMENT, MATERIAL, AND/OR SERVICES REQUIRED AS DEFINED IN THE SPECIFICATION APPLY.
12. ALL EXTERIOR BARE CARBON STEEL SURFACES (LEGS, LUGS, AND MANHOLE DAVIT) SHALL BE PAINTED IN ACCORDANCE WITH SPECIFICATION 24915-000-3PS-NX00-00001, PAINTING, GENERAL.
13. VESSEL SUPPLIER SHALL SUPPLY GROUNDING LUGS IN ACCORDANCE WITH STANDARD 24915-00-MO-00-00006. GROUNDING LUGS WITH DIMENSIONS SHALL BE CLEARLY CALLED OUT ON SUPPLIER DRAWINGS.
14. VESSEL SUPPLIER SHALL DESIGN AND INSTALL A MINIMUM OF TWO LIFTING LUGS FOR USE DURING LOADING, UNLOADING AND PLACING EQUIPMENT ON ITS FOUNDATION. DESIGN SHALL INCLUDE REQUIRED PIN, SHACKLE SIZE AND MAXIMUM SLOPE OF LIFTING CABLE AND LIFTING LUG PLANE. HOLE IN LIFTING LUG SHALL BE DRILLED OR MACHINED, DO NOT FLAME CUT. LIFTING LUG MAY BE CARBON STEEL. PAD, WHICH IS REQUIRED, SHALL BE THE SAME MATERIAL AS THE SHELL. LIFTING LUG SHALL NOT BE REMOVED AFTER INSTALLATION. EQUIPMENT SUPPLIER SHALL PERMANENTLY MARK ON THE LIFTING LUG WITH 1" MINIMUM HIGH LETTERS - "DO NOT REMOVE". SUPPLIER'S DRAWINGS SHALL PROVIDE LIFTING LUG DESIGN AND LOAD AND ANNOTATE EACH LUG WITH ITS LOAD CAPACITY.
15. VESSEL SUPPLIER SHALL PROVIDE FABRICATION, EMPTY, OPERATING, TEST AND INDIVIDUAL WEIGHTS OF HEAD, SHELL AND EQUIPMENT CENTER OF GRAVITY.
16. VESSEL SUPPLIER SHALL IDENTIFY ALL MATERIALS OF CONSTRUCTION (INCLUDING GASKETS) BY WEIGHT OR VOLUME.

STD NO.	DESCRIPTION	SPEC NO.	DESCRIPTION
24915-00-MO-00-00001	PRESSURE VESSEL TOLERANCES	24915-000-3PS-G000-00001	GENERAL PROJECT REQUIREMENTS
24915-00-MO-00-00002	STD BOLT HOLE ORIENT	24915-000-3PS-HX00-00001	QUALITY ASSURANCE
24915-00-MO-00-00004	VESSEL ABBREVIATIONS & SYMBOLS	24915-000-3PS-MV00-00001	PRESSURE VESSELS
24915-00-MO-00-00006	GROUNDING CONN FOR VESSELS & TKS	24915-000-3PS-NX00-00001	PAINTING, GENERAL
		24915-000-3PS-SV00-00001	SEISMIC PROTECTION OF EQUIP

FILE NAME: MVR001010


 DATA SHEET	TITLE	BGCAPP	SHEET	OF	PROJECT NUMBER
	SCWO EFFLUENT CAUSTIC DAY TANK MV-RO-0101		4	7	24915
			DOCUMENT NUMBER		REV
			24915-10-MVD-RO-00001		0

NOTES CONTINUED

17. ALL EXTERNAL BOLTS AND STUDS SHALL BE ASSEMBLED WITH ANTI-SEIZE LUBRICANT. SEE PRESSURE VESSEL SPECIFICATION.
18. VESSEL SUPPLIER SHALL DESIGN AND FABRICATE MANHOLE DAVIT FOR REMOVAL OF MANHOLE COVER.
19. LIQUID LEVELS ARE FROM BOTTOM TANGENT LINE, UNLESS OTHERWISE NOTED.
20. STANDPIPE MATERIAL SA-106-B, 2" X.S. PIPE. PIPE TO EXTEND TO BOTTOM TANGENT LINE.
21. THREE SETS OF SPARE GASKETS FOR NOZZLES WITH BLIND FLANGES SHALL BE SUPPLIED BY VESSEL FABRICATOR. GASKETS SHALL BE FLAT RING, NON ASB FIBER, 1/8" THK, CL150.
22. VENT PIPE MATERIAL SA-106-B, 2" X.S. PIPE.
23. SCWO EFFLUENT CAUSTIC DAY TANK, MV-RO-0101, IS REFERENCED ON P&ID 24915-10-M6-RO-00021.

FILE NAME: MVR00101D

 BECHTEL PARSONS BLUE GRASS DATA SHEET	TITLE BGCAPP SCWO EFFLUENT CAUSTIC DAY TANK MV-RO-0101	SHEET 5 OF 7	PROJECT NUMBER 24915
		DOCUMENT NUMBER 24915-10-MVD-RO-00001	REV 0

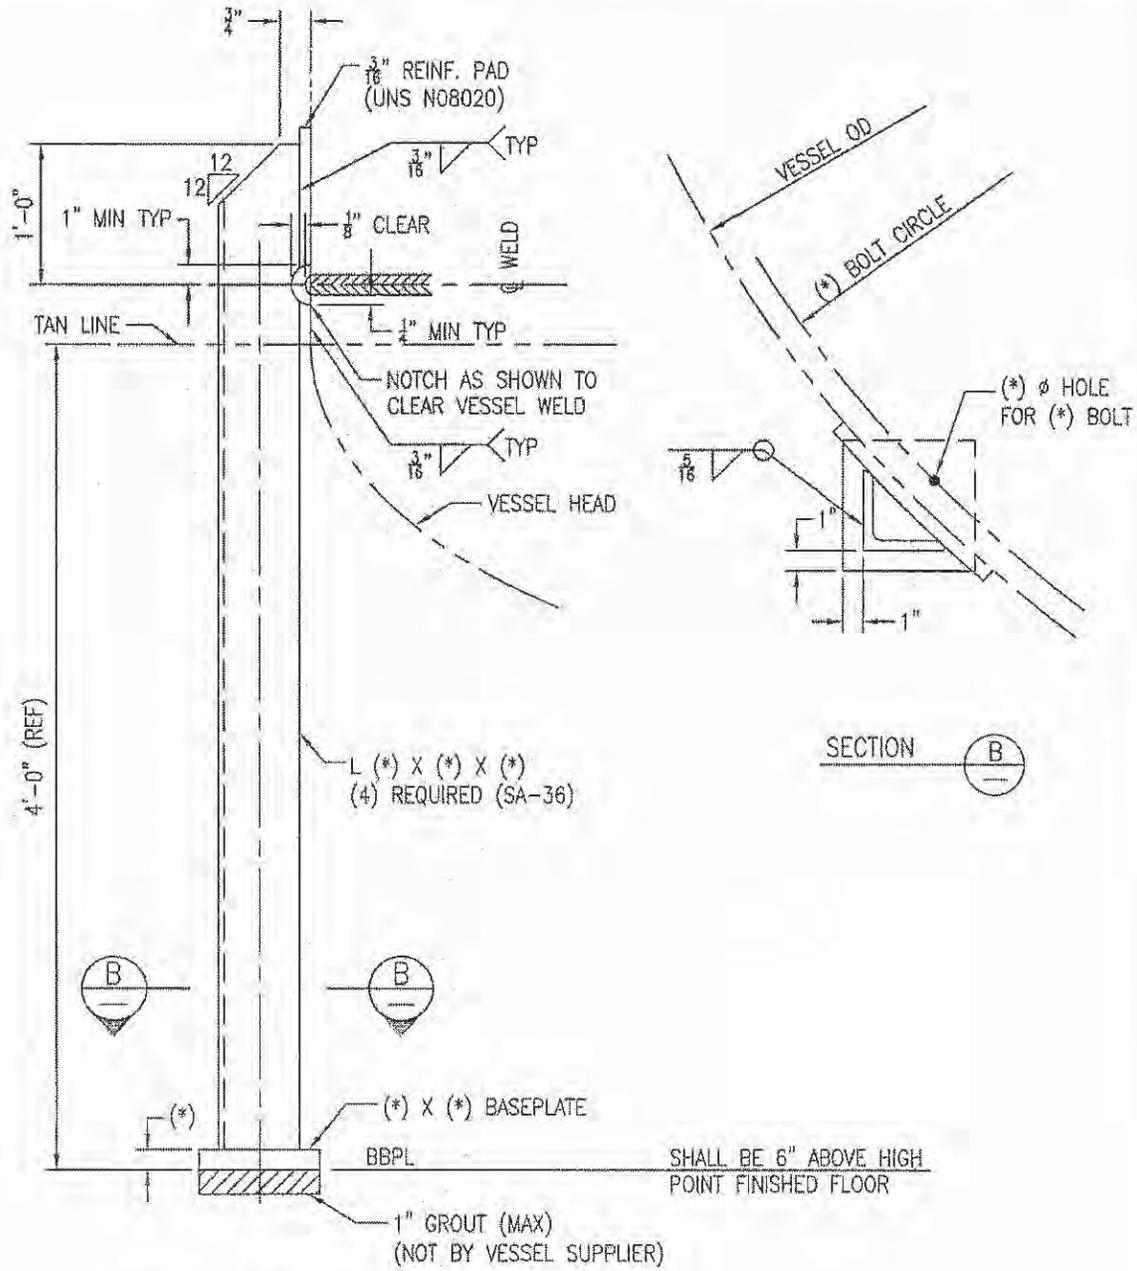

DETAIL 1 REF
 -5 SHIT 2

NOTE - VESSEL SUPPORT
 SUPPORT DESIGN IS PRELIMINARY, SEE NOTE 1, SHEET 3

FILE NAME: MVR00101E




DATA SHEET

TITLE
BGCAPP
SCWO EFFLUENT CAUSTIC DAY TANK
MV-RO-0101

SHEET OF PROJECT NUMBER
6 7 24915

DOCUMENT NUMBER REV
24915-10-MVD-RO-00001 0

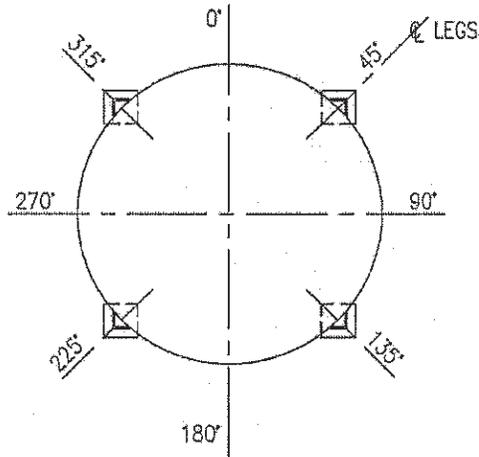


PLAN
TANK SUPPORT
ORIENTATION


(A)
6

REF
SHT 2

DATA SHEET	TITLE	BGCAPP SCWO EFFLUENT CAUSTIC DAY TANK MV-RO-0101	SHEET OF	7 7	PROJECT NUMBER	24915
			DOCUMENT NUMBER	24915-VO-10-MVD-RO-00001	REV	0

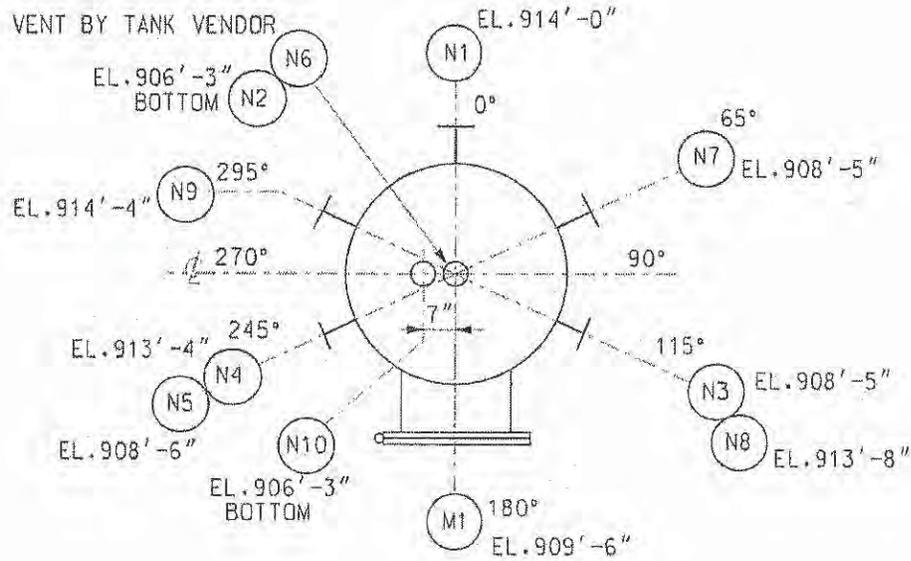

PLAN


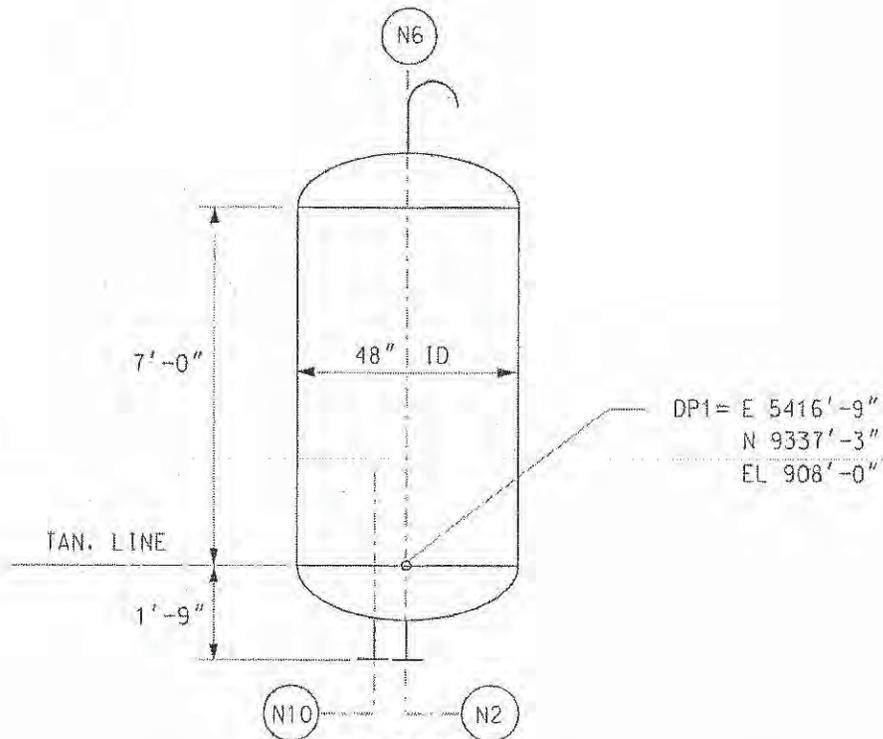


ELEVATION

- GENERAL NOTES:**
1. PIPING INTERFERENCE DATA ARE BASED ON BENCH MARK FROM THE SCWO TANK USING COORDINATE 24915-10-46C-SOWM-00002 AND THE SCWO PADS 24915-10-46C-SOWM-00014, -00019 AND 00020.
 2. \diamond SYMBOL DENOTES INTERFERENCE POINT (IP) NUMBER (X).
 4. MINIMUM 36" CLEARANCE REQUIRED AROUND MODULE ACCESS REQUIRED ON ALL SIDES OF MODULE.
 5. MODULE ANCHORING LOCATION AND DETAILS ARE DEPICTED ON SPB HYDROLYSATE BLEND/HOLDING TANK HEATER ARRANGEMENT DRAWING 24915-10-46C-SOWM-00116.
 6. PROCESS AND UTILITY PIPING LOCATION DIMENSION TOLERANCE IS $\pm 1/4"$.
 7. DETAILED EQUIPMENT AND PIPING SHOWN ON SPB HYDROLYSATE BLEND/HOLDING TANK HEATER MODULE ARRANGEMENT DRAWINGS 24915-10-46C-SOWM-00115 AND -00116.
 8. PIPING INTERFERENCES ARE LOCATED BY X-Y-Z COORDINATES (RIGHT HAND RULE) FROM NORTH CORNER. SEE INTERFERENCE DATA TABLE FOR X AND Y COORDINATE LOCATIONS. (Z COORDINATES SHOWN ON DRAWING).
 9. THE AGENT CONTAMINATION CATEGORY FOR THE SCWO SYSTEM IS N/A.
 10. THE THREE HEADERS ARE FED WITH A COMMON STEAM INLET THE FLOW VALUE PROVIDED IS COMPLICATED FOR THE THREE.
 11. 60,000 Btu/hr IS APPROPRIATE HEAT RELEASED BY TWO (2) HYDROLYSATE HEATERS RUNNING SIMULTANEOUSLY (20,000 Btu's EACH); IT IS NOT EXPECTED THAT THREE (3) WOULD BE HEATING AT ANY ONE TIME.

INTERFERENCE DATA

NO.	DESCRIPTION	IP NO.	X	Y	Z
1
2
3
4
5
6
7
8
9
10
11
12
13
14
15
16
17
18
19
20

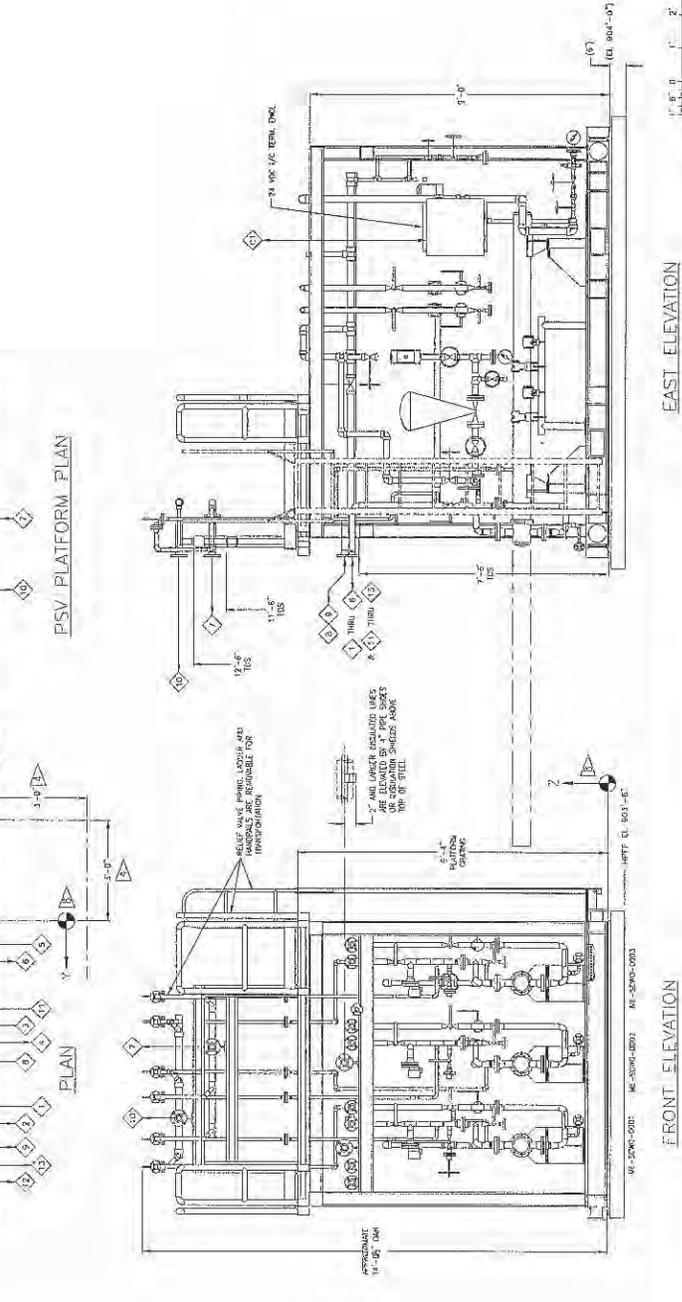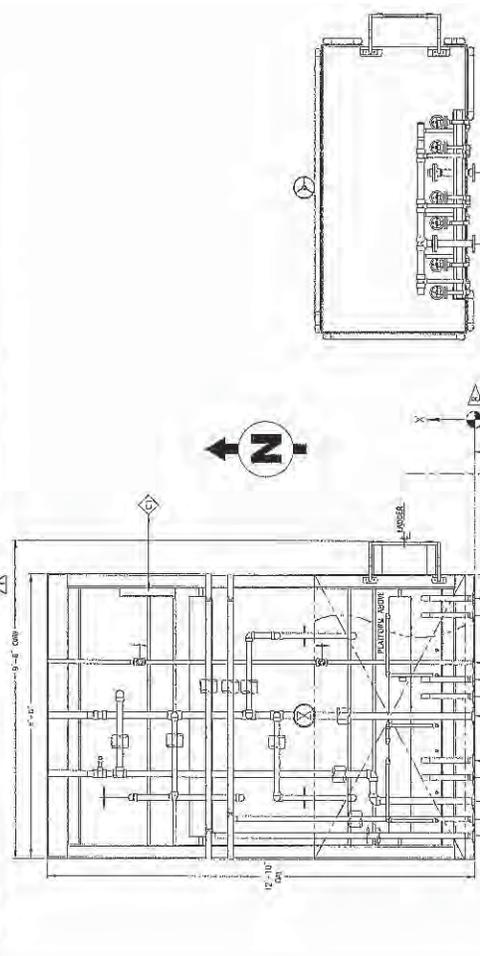

REVISIONS

NO.	DATE	DESCRIPTION
1
2
















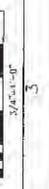

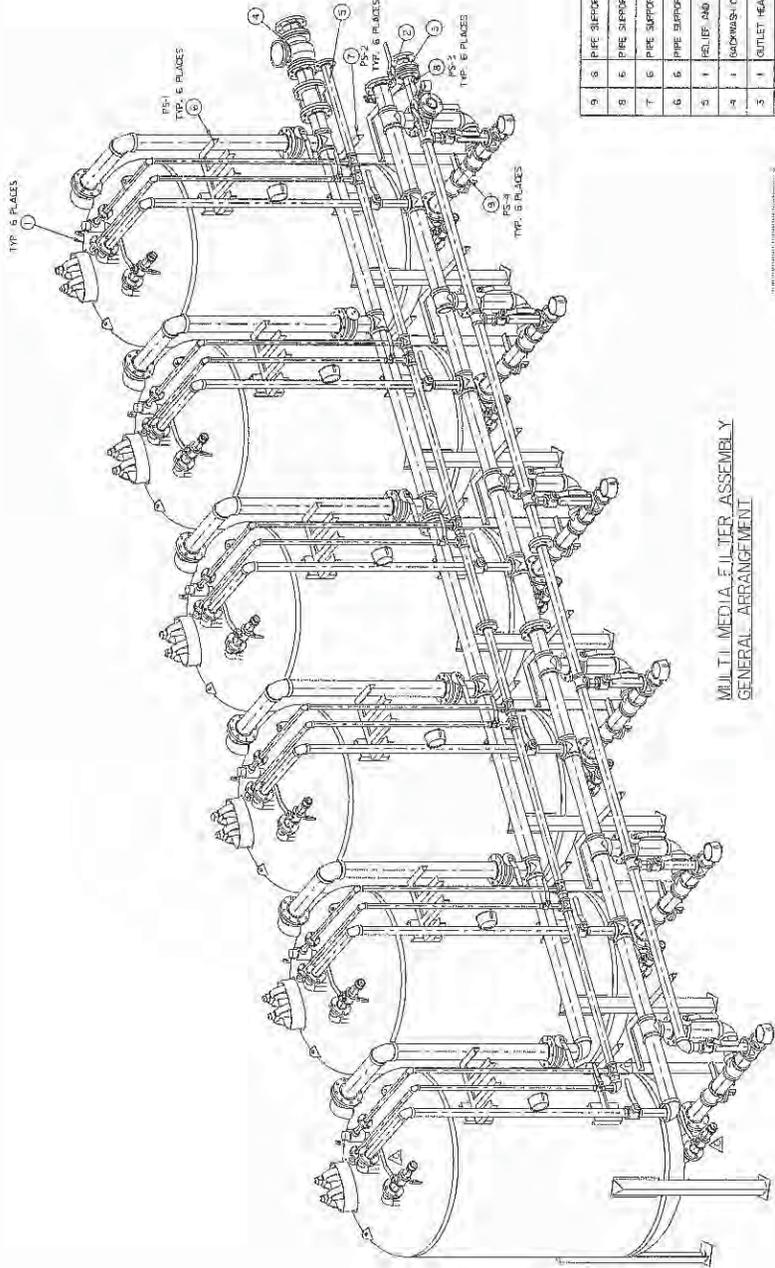

MULTI-MEDIA FILTER ASSEMBLY
GENERAL ARRANGEMENT

ITEM	DESCRIPTION	SPEC. AND/OR PART NO.

AVANTECH
L I F T I N G

CUSTOMER/PROJECT
BECHTEL, NATIONAL, INC.

DATE: 08/28/07
JOB NO.: 24915-10-000-000
SCALE: 1" = 12"



REV. DATE DESCRIPTION

8 7 6 5 4 3 2 1




DATE	08/28/07
BY	SM
CHECKED	SM
DATE	08/28/07
BY	SM
CHECKED	SM
DATE	08/28/07
BY	SM
CHECKED	SM

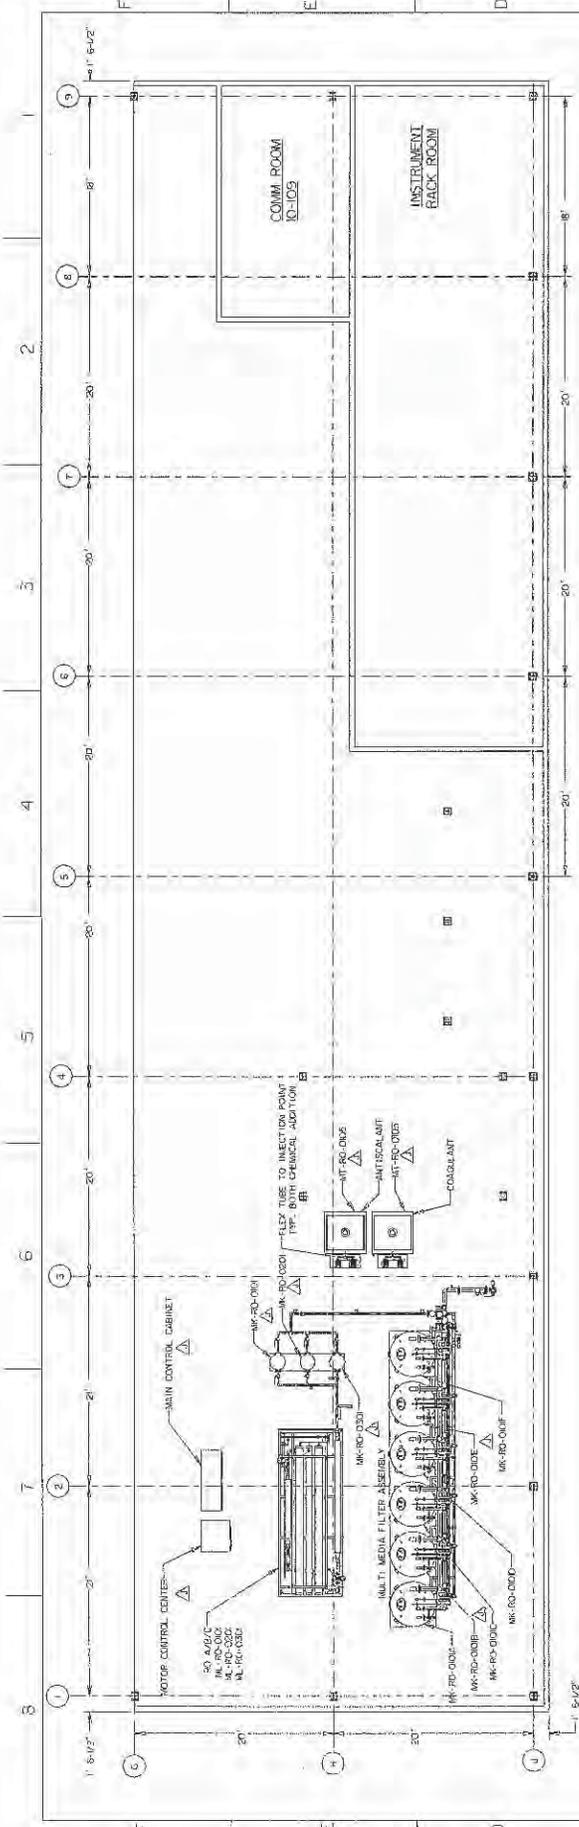

PLAN VIEW


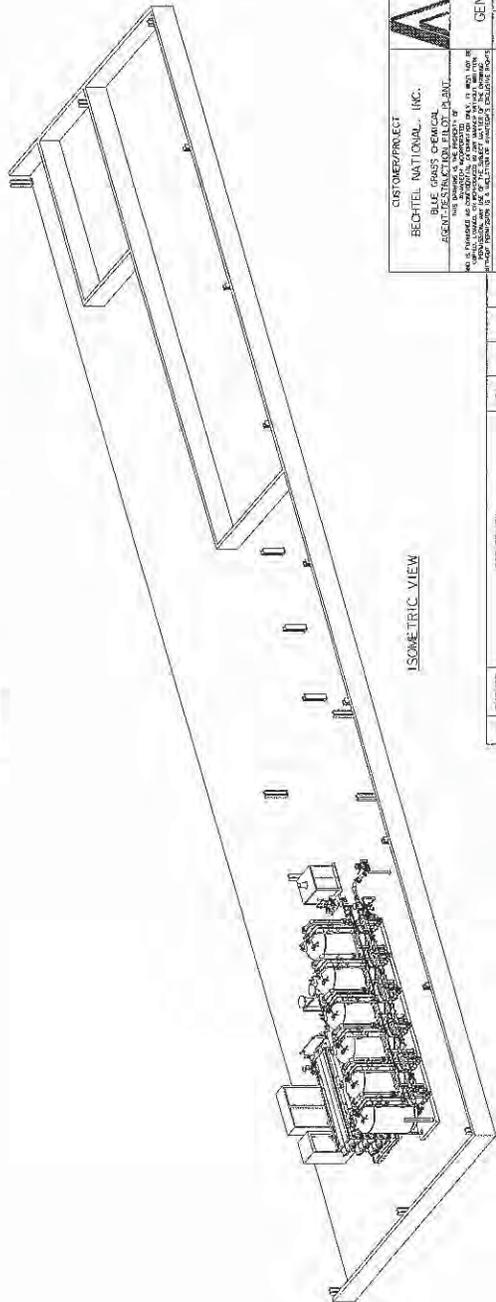

ISOMETRIC VIEW

AVANTECH
 WATER PURIFICATION SYSTEMS

CUSTOMER PROJECT

RO SYSTEM
 GENERAL ARRANGEMENT

SCALE: 1/4" = 1'-0"

DATE: 11/15/07








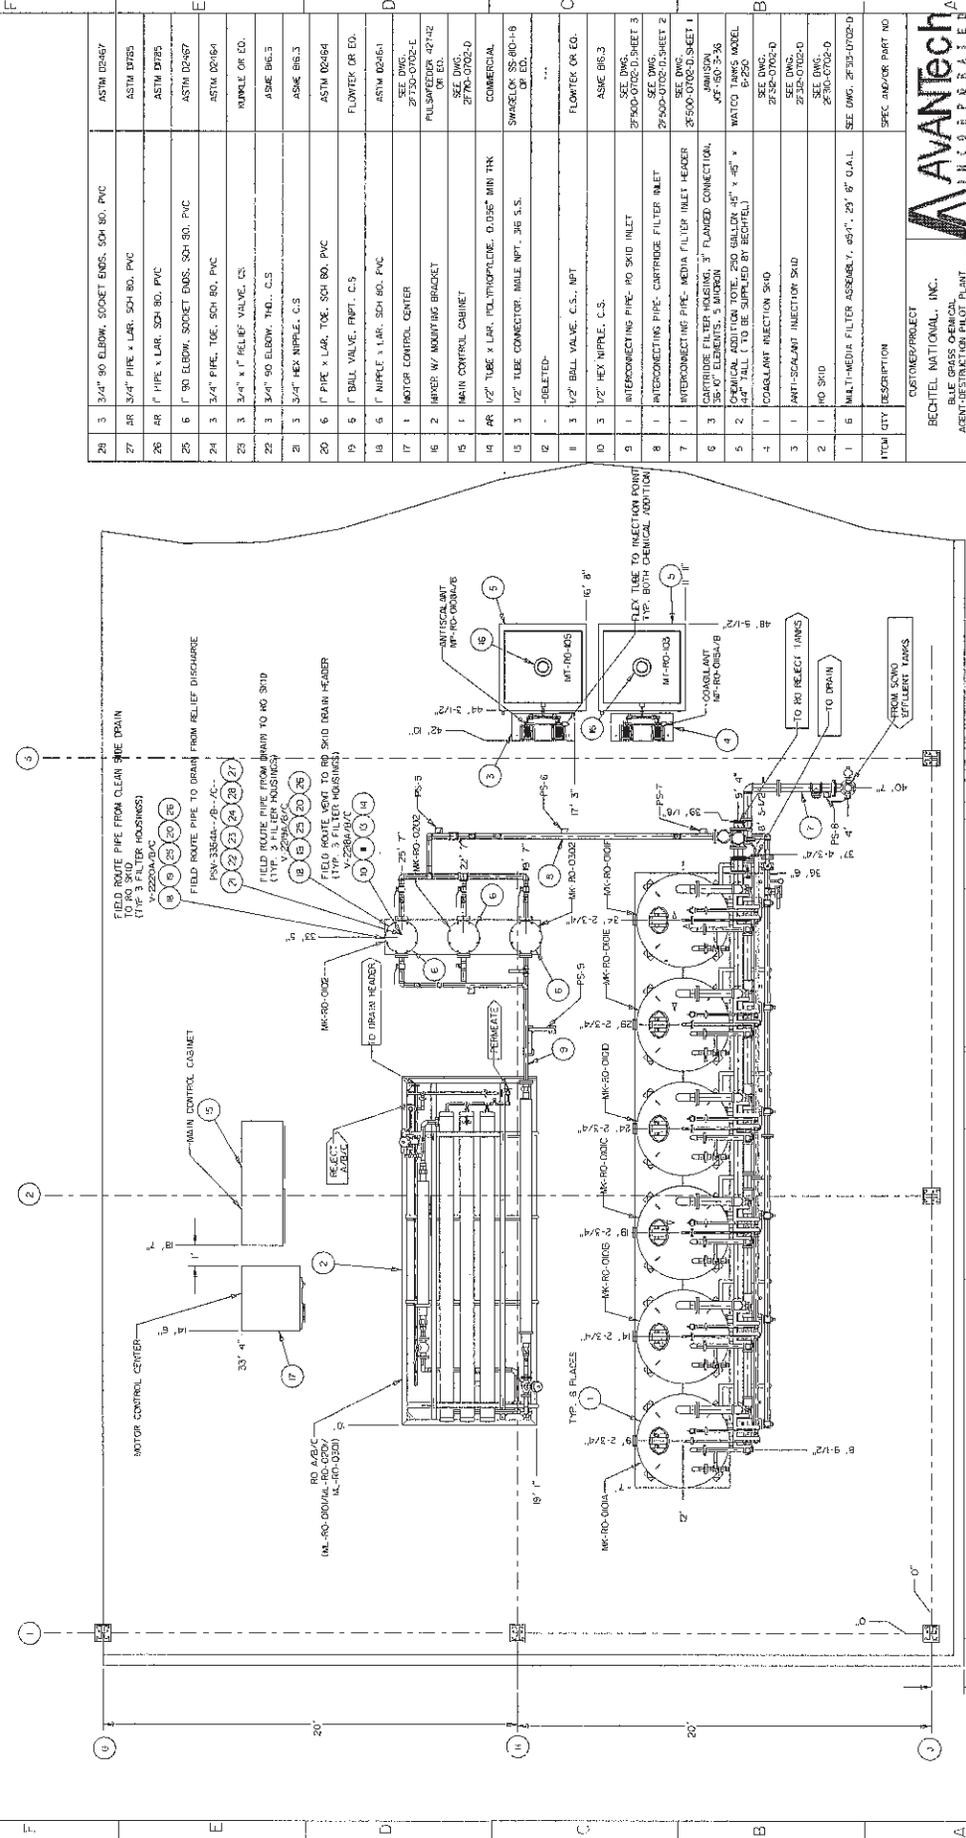

PLAN VIEW

ITEM	QTY	DESCRIPTION	SPEC. AND/OR PART NO.
29	3	3/4" 90 ELBOW, SOCKET ENDS, SCH 80, PVC	ASTM D2467
27	4R	3/4" PIPE x LAR, SCH 80, PVC	ASTM D1835
26	4R	1" PIPE x LAR, SCH 80, PVC	ASTM D1835
25	6	1" 90 ELBOW, SOCKET ENDS, SCH 80, PVC	ASTM D2467
24	3	3/4" PIPE, 106, SCH 80, PVC	ASTM D2164
23	3	3/4" x 1" RELIEF VALVE, CS	NIPPLE OR ED.
22	3	3/4" 90 ELBOW, 106, CS	ASME B16.5
21	3	3/4" HEX NIPPLE, CS	ASME B16.5
20	6	1" PIPE x LAR, TOE, SCH 80, PVC	ASTM D2464
19	5	1" BALL VALVE, FNPT, CS	FLOWTEK DR ED.
18	6	1" NIPPLE x LAR, SCH 80, PVC	ASTM D2461
17	1	MOTOR CONTROL CENTER	SEE DWG. 2730-0202-1
16	2	NIPPLE W/ MOUNTING BRACKET	PULSAR 4242
15	1	MAIN CONTROL CABINET	SEE DWG. 2770-0202-D
14	4R	1/2" TUBE x LAR, POLYPROPYLENE, 0.036" MIN THK	COMMERCIAL
13	3	1/2" TUBE CONNECTOR, MALE NPT, 3/8 S.S.	SWARDECK SS-80-HB
12	-	DELETED	...
11	3	1/2" BALL VALVE, CS, NPT	FLOWTEK DR ED.
10	3	1/2" HEX NIPPLE, CS	ASME B16.5
9	1	INTERCONNECTING PIPE, RO SKID INLET	SEE DWG. 2730-0202-SHEET 3
8	1	INTERCONNECTING PIPE, CARTRIDGE FILTER INLET	2730-0202-SHEET 2
7	1	INTERCONNECTING PIPE, MEDIA FILTER INLET HEADER	SEE DWG. 2730-0202-SHEET 1
6	3	CARTRIDGE FILTER HOUSING, 3" FLANGED CONNECTION, 36-6" ELEMENTS, 5 INCHON	AMWISON 45F-50 35-36
5	2	CHEMICAL ADDITION TOTE, 250 GALLON 45" x 45" x 44" TALL (TO BE SUPPLIED BY BECHTEL)	WATCO TANKS MODEL P-250
4	1	COAGULANT INJECTION SKID	SEE DWG. 2730-0202-D
3	1	PART-SIZALANT INJECTION SKID	SEE DWG. 2730-0202-D
2	1	RO SKID	SEE DWG. 2730-0202-D
1	6	MULTI-MEDIA FILTER ASSEMBLY, 45" x 29" x 6" O.A.L.	SEE DWG. 2730-0202-D

AVANTECH
 3 H O P E R S E
 BECHTEL NATIONAL, INC.
 BLUE GRASS CAMPUS
 WWW.AVANTECH.COM

CUSTOMER/PROJECT
 BECHTEL NATIONAL, INC.
 BLUE GRASS CAMPUS


CONCEPTUAL
 GENERAL ARRANGEMENT

FILE NO.	DATE	BY	CHK	APP	REV.	DESCRIPTION
2730-0202	02/02/03	1	ISSUES IN NOTES UNLESS SPECIFIED
2730-0202	02/02/03	2	SCALE 1/8" = 1'-0"
2730-0202	02/02/03	3	SHEET 2 OF 3

NO.	DATE	BY	CHK	APP	REV.	DESCRIPTION
1	02/02/03	1	FOR REVIEW
2	02/02/03	2	DESCRIPTION

NO.	DATE	BY	CHK	APP	REV.	DESCRIPTION
1	02/02/03	1	FOR REVIEW
2	02/02/03	2	DESCRIPTION

ITEM	SKID DESCRIPTION	ANCHOR BOLT SPEC	NO. OF ANCHORS	BOLT SIZE	MIN. EMBEDMENT DEPTH
7	RD SKID	EARED BOLTS 1 ASTM F558, GRADE 363	4	Ø 1"	12"
6	CARTRIIDGE FILTER C	POST INSTALLED EPOXY ANCHORS, ITW/ARABET CERAMIC & W/A-307 ANCHOR RODS	4	Ø 1/2"	5"
5	CARTRIIDGE FILTER B	POST INSTALLED EPOXY ANCHORS, ITW/ARABET CERAMIC & W/A-307 ANCHOR RODS	4	Ø 1/2"	5"
4	CARTRIIDGE FILTER A	POST INSTALLED EPOXY ANCHORS, ITW/ARABET CERAMIC & W/A-307 ANCHOR RODS	4	Ø 1/2"	5"
3	ANTI-SCALEANT SKID	POST INSTALLED EPOXY ANCHORS, ITW/ARABET CERAMIC & W/A-307 ANCHOR RODS	4	Ø 3/8"	3-3/8"
2	ANTI-SCALEANT SKID	POST INSTALLED EPOXY ANCHORS, ITW/ARABET CERAMIC & W/A-307 ANCHOR RODS	4	Ø 3/8"	3-3/8"
1	MULTI-MEDIA FILTER	POST INSTALLED EPOXY ANCHORS, ITW/ARABET CERAMIC & W/A-307 ANCHOR RODS FOR REFERENCE ONLY, SET 181.187.187	24	Ø 1"	12"

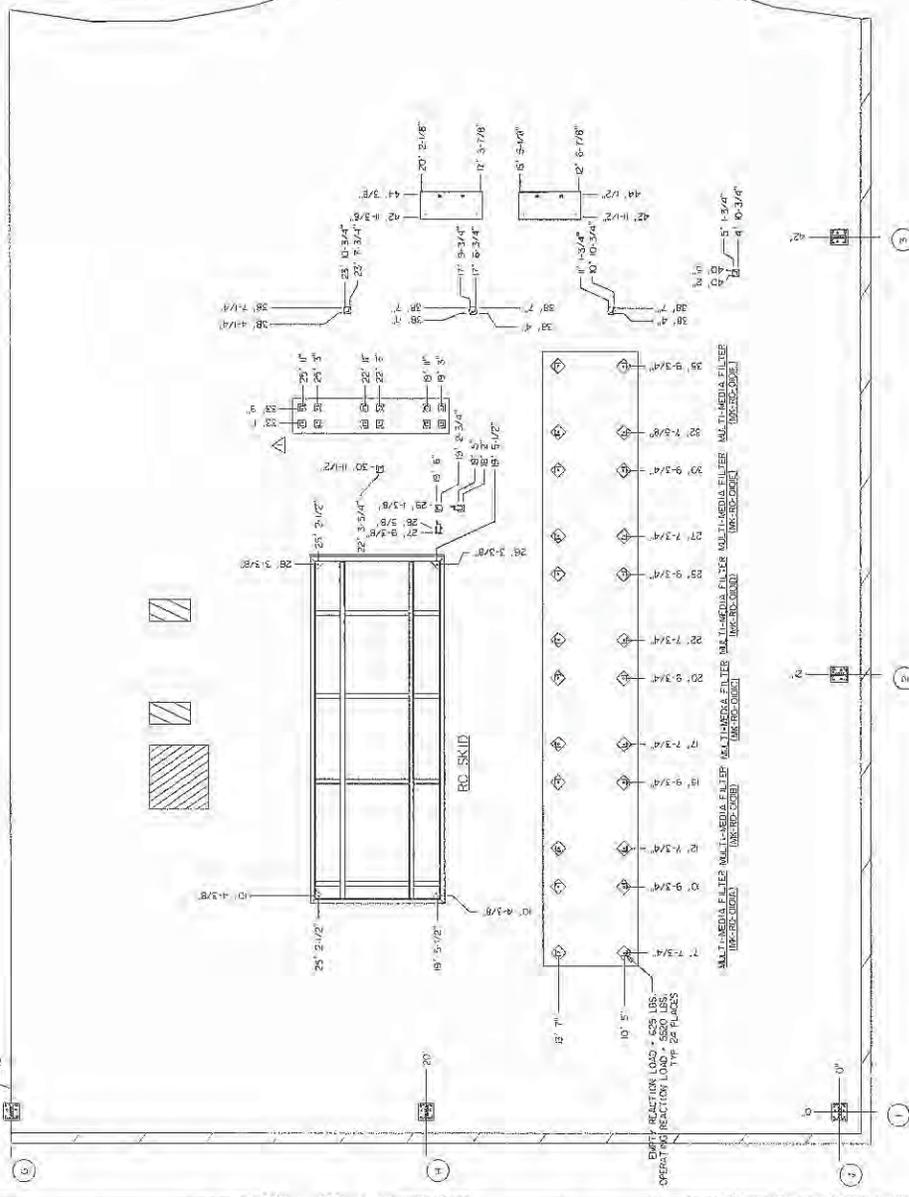

CUSTOMER PROJECT	BECHTEL NATIONAL, INC.
AGENT/RESUBMISSION PROJECT NO.	BLUE GRASS CHEMICAL
PROJECT NO.	AGN15-000000-0101-01-01
PROJECT NAME	RO SYSTEM
EQUIPMENT ANCHOR LOCATION	
FILE NO.	24915-10-DBC-00-00004
SCALE	AS SHOWN UNLESS SPECIFIED
DATE	07/20/10
SCALE	1/32"
MT. N/A	
REV.	

REV.	DATE	BY	CHK	DESCRIPTION
1	1/18/07	BY	BY	FOR REVIEW

NO.	DATE	BY	CHK	DESCRIPTION
1	07/20/10	BY	BY	FOR REVIEW

Patel, Chiman

From: Patel, Chiman
Sent: Thursday, September 06, 2007 7:16 AM
To: Aquino, Wilson; Briceno, Cairo
Subject: FW: STA tank volume

Tracking: Recipient Read
 Aquino, Wilson
 Briceno, Cairo Read: 9/6/2007 7:53 AM

For STA fdn & dike wall

-----Original Message-----

From: Weitzman, Leo
Sent: Thursday, September 06, 2007 5:17 AM
To: Patel, Chiman; Regan, Kevin
Cc: Phillips, John; Lawrence, Samir; Thakur, Shri; Parson, Gary
Subject: RE: STA tank volume

Thanks for Checking, Chiman.

1. Yes, the contained air volume of the largest tank must be used to size the containment

2. The STA tanks are outside so they need to be sized to contain both rainwater and 100% of the contents of the largest tank. The rainwater containment volume that we are using for this project is 5.75" (the 25-year, 24 hour rainfall event for Madison Co, KY). 110% is only required for agent-containing tanks.

Please feel free to contact Kevin or me if you have any more questions.

Regards,
Leo

Leo Weitzman
Bechtel Parsons Blue Grass
301 Highland Park Drive
Richmond, KY 40475
E-mail: lweitzma@bechtel.com
859-625-1277 Richmond Office
765-430-0809 Cell
859-625-9918 FAX

From: Patel, Chiman
Sent: Wednesday, September 05, 2007 7:41 PM
To: Regan, Kevin; Weitzman, Leo
Cc: Phillips, John; Lawrence, Samir (OWAPF); Thakur, Shri (OWAPF); Parson, Gary
Subject: STA tank volume

Kevin / Leo

2/14/2008

STA (storage tanks area) located south of SPB (SCWO Process Bldg.) has 8-tanks. The largest among them is MT-RO-0106/0206 which has 65500 gallon capacity and in size 21' dia & 32' high. Structural has to size peripheral wall height to retain 110% liquid volume of the tank. Should the gallons capacity or air volume be used to size the wall? I asked John Phillips (mechanical process) the same question and his reply were to use air volume but he asked me to check with you. The tank volume is 9631 cu.ft based on 110% of 65500 gallons capacity while it is 12191.9cu.ft based on air volume.

Chiman N. Patel, P.E, S.E.

Structural Engineer

626-440-4148



A Joint Venture of Bechtel National, Inc. and
Parsons Infrastructure & Technology Group, Inc.

Calculation Sheet

Project:	<u>BGCAPP</u>
Job Number:	<u>743341</u>
Calc. No.	<u>24915-10-DBC-00-00004</u>
Sheet No.	<u>B-1 / B-34</u>
Sheet Rev.	<u>D</u>

Subject:	<u>Gas Bottles Canopy, Supports, Equip, & Misc Foundations</u>	
By:	<u>R. Murphy</u>	Date: <u>12/16/2007</u>

Appendix B

Exterior Cable Tray Support Foundations



A Joint Venture of Bechtel National, Inc. and
Parsons Infrastructure & Technology Group, Inc.

Calculation Sheet

Project:	BGCAPP
Job Number:	743341
Calc. No.	24915-10-DBC-00-00004
Sheet No.	B-2 / B-34
Sheet Rev.	D

Subject: Gas Bottles Canopy, Supports, Equip, & Misc Foundations
By: R. Murphy Date: 12/16/2007

B.1. Objective

The calculation performed in this appendix includes structural analysis and design of isolated footings for supports of elevated cable trays along the exterior of the SCWO Processing Building (SPB).

B.2. Inputs

The cable trays are located along the Eastern wall of the SPB between column lines B and J. See Drawing no. 24915-10-DB-00-00009 to 00011, 24915-10-DB-00-00061 for footing locations.

- (1) The cable trays have a rectangular cross-section 3'-0" wide and 9" tall.
- (2) Six isolated footings are designed individually using the reaction output from GTSTRUDL.
- (3) Two worst-case designs were chosen, one worst case was used for footings at B, C, and D and another was used for footings at E, F, and G.
- (4) Construction materials are listed in Section 2.1 and load information is listed in Section 2.2.

B.3 Assumptions

Cable tray weight is assumed to be 110plf per request of electrical group.

Seismic loads are not considered in the analysis because they produced lower shear and overturning values than the wind loads.

B.4 Calculation Body

Base reactions from GTSTRUDL steel analysis and design are given here. These loads are the input for the Foundation3D footing design. Designs for the six individual footings are included in this appendix. Note that the designs for the footings at column lines B, C, D are the same (F-23), as are the designs for footings E, F, and G (F-22).



A Joint Venture of Bechtel National, Inc. and Parsons Infrastructure & Technology Group, Inc.

Calculation Sheet

Project: BGCAPP
 Job Number: 743341
 Calc. No. 24915-10-DBC-00-00004
 Sheet No. B-3 / B-34
 Sheet Rev. D

Subject: Gas Bottles Canopy, Supports, Equip, & Misc Foundations
 By: R. Murphy Date: 12/16/2007

Reaction Values from GTSTRUDL Analysis (units: kip, ft)

	Joint #	Load Case	Z FORCE	X FORCE	Y MOMENT	Y FORCE	X MOMENT	
FOUNDATION DESIGN F-23 JOINT 4 IS CONTROLLING CASE	3	'DEADLOAD'	3.005	0.000	9.169	0.001	-0.025	
	3	'SNOW'	0.450	0.000	1.674	0.000	0.002	
	3	'WLEW'	0.000	0.835	11.598	0.001	-0.019	
	3	'WLNS'	0.000	0.000	0.000	-0.302	2.667	
	4	'DEADLOAD'	3.184	0.000	9.833	0.000	0.000	
	4	'SNOW'	0.900	0.000	3.346	0.000	0.000	
	4	'WLEW'	0.000	1.005	14.444	0.000	0.000	
	4	'WLNS'	0.000	0.000	0.000	-0.304	2.715	
	5	'DEADLOAD'	3.184	0.000	9.839	0.001	-0.025	
	5	'SNOW'	0.900	0.000	3.348	0.000	0.002	
	5	'WLEW'	0.000	1.005	14.446	0.001	-0.019	
	5	'WLNS'	0.000	0.000	0.001	-0.302	2.667	
	FOUNDATION DESIGN F-22 JOINT 13 IS CONTROLLING CASE	6	'DEADLOAD'	5.342	0.001	21.019	0.003	-0.019
6		'SNOW'	0.900	0.000	4.245	0.000	-0.003	
6		'WLEW'	0.000	1.357	18.910	-0.001	0.007	
6		'WLNS'	0.000	0.268	4.082	-0.077	0.113	
13		'DEADLOAD'	7.336	-0.002	27.361	0.810	-0.021	
13		'SNOW'	0.810	0.000	3.812	0.057	-0.003	
13		'WLEW'	-0.002	1.922	26.646	-0.001	-0.002	
13		'WLNS'	-1.327	-0.268	-4.077	-0.948	0.072	
14		'DEADLOAD'	3.117	0.001	8.715	-0.816	0.008	
14		'SNOW'	0.136	0.000	0.653	-0.057	0.001	
14		'WLEW'	0.002	1.203	13.064	-0.001	-0.002	
14		'WLNS'	1.327	0.000	-0.006	-1.119	0.059	



A Joint Venture of Bechtel National, Inc. and
Parsons Infrastructure & Technology Group, Inc.

Calculation Sheet

Project:	BGCAPP
Job Number:	743341
Calc. No.	24915-10-DBC-00-00004
Sheet No.	B-4 / B-34
Sheet Rev.	D

Subject: Gas Bottles Canopy, Supports, Equip, & Misc Foundations
 By: R. Murphy Date: 12/16/2007

CIVIL ENGINEERING

FOUNDATION ANALYSIS/DESIGN REPORT

Miscellaneous: Fdn at Grid Line F

PROJECT NO. : 10-DBC-00-00004
 PROJECT NAME : SCWO Exterior Cable Tray Support Foundation at Node 4
 PROJECT LOCATION : Richmond, KY
 CLIENT :
 PROJECT TYPE :

REFERENCE DOCUMENTS : _____

By: _____ Checked: _____ Approved: _____
 Date: _____ Date: _____ Date: _____

Parsons

100 West Walnut, Pasadena, CA



A Joint Venture of Bechtel National, Inc. and Parsons Infrastructure & Technology Group, Inc.

Calculation Sheet

Project:	BGCAPP
Job Number:	743341
Calc. No.	24915-10-DBC-00-00004
Sheet No.	B-5 / B-34
Sheet Rev.	D

Subject: Gas Bottles Canopy, Supports, Equip, & Misc Foundations
 By: R. Murphy Date: 12/16/2007

Units:

Input Units:	English	Output Units:	English	Code:	ACI 318 - 2002
--------------	---------	---------------	---------	-------	----------------

Concrete Parameters:

Compressive Strength : (psi)	4000	Unit Weight : (pcf)	150
Pier Concrete Cover:		Allowable Concrete Stress increase:	
E-W Direction : (in)	3	Wind	0.00%
N-S Direction : (in)	3	Earthquake	0.00%
Footing Concrete Cover:		Test	0.00%
E-W Direction : (in)	3		
N-S Direction : (in)	3		
Top Steel to Top of footing : (in)	2		
Bot Steel to Bot of footing/ Top of Pile : (in)	3		

Reinforcing Steel Parameters:

Yield Strength : (ksi)	60	Unit Weight of Steel: (pcf)	490
Modulus of Elasticity of Steel: (ksi)	29000	Footing Bar Spacing:	
Pier Bars and Spacing:		Min Rebar spacing: (in)	3
Min Rebar spacing: (in)	3	Max Rebar spacing: (in)	12
Max no. of bars per Pier	800	Max Footing Rebar Size	9
Temperature and Shrinkage Steel Ratio:	0.0018	Min Footing Rebar Size	5

Soil/Pile Parameters:

Foundation Type :	Soil-Supported	Soil Unit Weight : (pcf)	120
Allowable Bearing Pressure : (psf)	3000	Allowable Soil Pressure increase	
Stability Ratios/Safety Factor:		Wind	33.33%
Minimum Stability Ratio for Erection	1.5	Earthquake	33.33%
Minimum Stability Ratio for Operation	1.5	Test	20.00%
Minimum Stability Ratio for Test	1.5	Type of Soil:	Granular
Safety Factor against Lateral Forces	1.5	Passive Pressure Coeff Kp	5
		Soil To Conc. Friction f:	0.5



A Joint Venture of Bechtel National, Inc. and Parsons Infrastructure & Technology Group, Inc.

Calculation Sheet

Project:	BGCAPP
Job Number:	743341
Calc. No.	24915-10-DBC-00-00004
Sheet No.	B-6 / B-34
Sheet Rev.	D

Subject: Gas Bottles Canopy, Supports, Equip, & Misc Foundations
 By: R. Murphy Date: 12/16/2007

Pier Parameters:

Shape:	Rectangular
Min. Reinf. Ratio:	0.0018

Footing Parameters:

Min. Footing or Cap Thickness Tf (ft):	1.5
Depth of Footing or Cap below grade Df (ft):	2.5
Min. Soil cover above Footing or Cap Sc (ft):	1
Depth of Water table below grade (ft):	0
Consider Buoyancy:	No



A Joint Venture of Bechtel National, Inc. and Parsons Infrastructure & Technology Group, Inc.

Calculation Sheet

Project: BGCAPP
 Job Number: 743341
 Calc. No. 24915-10-DBC-00-00004
 Sheet No. B-7 / B-34
 Sheet Rev. D

Subject: Gas Bottles Canopy, Supports, Equip, & Misc Foundations
 By: R. Murphy Date: 12/16/2007

Applied Loads Pier - P1 I:STRUCTSCWO 2007ASCWO MISCELLANEOUSCONCRETEAPP B CABLE TRAYSUPPORT AT JOINT 4.MSC

Proj. No.: 10-DBC-00-00004 Engr: R. Murphy Date: 12/14/2007 Checker: B. Rabe Date: 12/14/2007

Load No.	Load case	Axial KIP	Shear E-W KIP	Mom N-S KIP FT	Shear N-S KIP	Mom E-W KIP FT
1	Dead	3.18	0.00	9.83	0.00	0.00
2	Snow	0.90	0.00	3.35	0.00	0.00
3	WLEW	0.00	1.01	14.44	0.00	0.00
4	WLNS	0.00	0.00	0.00	-0.30	2.72



A Joint Venture of Bechtel National, Inc. and Parsons Infrastructure & Technology Group, Inc.

Calculation Sheet

Project: BGCAPP
 Job Number: 743341
 Calc. No. 24915-10-DBC-00-00004
 Sheet No. B-8 / B-34
 Sheet Rev. D

Subject: Gas Bottles Canopy, Supports, Equip, & Misc Foundations
 By: R. Murphy Date: 12/16/2007

Allowable Strength Load Combinations Pier - P1 E-STRUCTSCWO 2007SCWO MISCELLANEOUS/CONCRETE/APP B CABLE TRAYS/SUPPORT AT JOINT 4.MSC

Proj. No.: 10-DBC-00-00004 Engr: R. Murphy Date: 12/14/2007
 Checker: B. Rahe Date: 12/14/2007

Load No.	Load Combination	Axial KIP	Shear E-W KIP	Mom N-S KIP FT	Shear N-S KIP	Mom E-W KIP FT
1	Dead	3.18	0.00	9.83	0.00	0.00
2	Dead + Snow	4.08	0.00	13.18	0.00	0.00
3	Dead + 0.75Snow	3.86	0.00	12.34	0.00	0.00
4	Dead + WLEW	3.18	1.01	24.28	0.00	0.00
5	Dead + WLNS	3.18	0.00	9.83	-0.30	2.72
6	Dead + 0.75Snow + 0.75WLEW	3.86	0.75	23.18	0.00	0.00
7	Dead + 0.75Snow + 0.75WLNS	3.86	0.00	12.34	-0.23	2.04
8	0.6Dead + WLEW	1.91	1.01	20.34	0.00	0.00
9	0.6Dead + WLNS	1.91	0.00	5.90	-0.30	2.72



A Joint Venture of Bechtel National, Inc. and
Parsons Infrastructure & Technology Group, Inc.

Calculation Sheet

Project: BGCAPP
 Job Number: 743341
 Calc. No. 24915-10-DBC-00-00004
 Sheet No. B-9 / B-34
 Sheet Rev. D

Subject: Gas Bottles Canopy, Supports, Equip, & Misc Foundations
 By: R. Murphy Date: 12/16/2007

Ultimate Strength Load Combinations Pier - P1 F:STRUCT:SCWO 2007:SCWO MISCELLANEOUS/CONCRETE/APP B CABLE TRAYS/SUPPORT AT JOINT 4/MISC

Proj. No.: 10-DBC-00-00004 Engr: R. Murphy Date: 12/14/2007 Checker: B. Rahe Date: 12/14/2007

Load No.	Load Combination	Axial KIP	Shear E-W KIP	Mom N-S KIP FT	Shear N-S KIP	Mom E-W KIP FT
1	1.4Dead	4.46	0.00	13.77	0.00	0.00
2	1.2Dead + 0.5Snow	4.27	0.00	13.47	0.00	0.00
3	1.2Dead + 1.6Snow	5.26	0.00	17.15	0.00	0.00
4	1.2Dead + 1.6Snow + 0.8WLEW	5.26	0.80	28.71	0.00	0.00
5	1.2Dead + 1.6Snow + 0.8WLS	5.26	0.00	17.15	-0.24	2.17
6	1.2Dead + 0.5Snow + 1.6WLEW	4.27	1.61	36.58	0.00	0.00
7	1.2Dead + 0.5Snow + 1.6WLS	4.27	0.00	13.47	-0.49	4.34
8	1.2Dead + 0.2Snow	4.00	0.00	12.47	0.00	0.00
9	0.9Dead + 1.6WLEW	2.87	1.61	31.96	0.00	0.00
10	0.9Dead + 1.6WLS	2.87	0.00	8.85	-0.49	4.34



A Joint Venture of Bechtel National, Inc. and Parsons Infrastructure & Technology Group, Inc.

Calculation Sheet

Project: BGCAPP
 Job Number: 743341
 Calc. No. 24915-10-DBC-00-00004
 Sheet No. B-10 / B-34
 Sheet Rev. D

Subject: Gas Bottles Canopy, Supports, Equip, & Misc Foundations
 By: R. Murphy Date: 12/16/2007

BEARING CAPACITY I:STRUCT\SCWO 2007\SCWO MISCELLANEOUS\CONCRETEAPP B CABLE TRAYS\SUPPORT AT JOINT 4.MSC

Proj. No.: 10-DBC-00-00004 Engr: R. Murphy Date: 12/14/2007 Checker: B. Rahe Date: 12/14/2007

Load No.	Load Comb	Gross Soil Pres KSF	Allow Soil Pres KSF	S.R. in N/S Dir	S.R. in E/W Dir	Allow Min S.R.	Ecc. in N/S Dir FT	Ecc. in E/W Dir FT	Moment @ N/S axis KIP FT	Moment @ E/W axis KIP FT
1	Dead	0.72	3.30	100.00	4.89	1.50	0.00	0.61	9.83	0.00
2	Dead + Snow	0.84	3.30	100.00	3.85	1.50	0.00	0.78	13.18	0.00
3	Dead + 0.75Snow	0.81	3.30	100.00	4.06	1.50	0.00	0.74	12.34	0.00
4	Dead + WLEW	1.37	4.30	100.00	1.76	1.50	0.00	1.70	27.29	0.00
5	Dead + WLNS	0.77	4.30	18.04	4.89	1.50	0.11	0.61	9.83	1.80
6	Dead + 0.75Snow + 0.75WLEW	1.26	4.30	100.00	1.97	1.50	0.00	1.52	25.44	0.00
7	Dead + 0.75Snow + 0.75WLNS	0.84	4.30	24.94	4.06	1.50	0.08	0.74	12.34	1.35
8	0.6Dead + WLEW	1.87	4.30	100.00	1.89	1.50	0.00	2.43	23.36	0.00
9	0.6Dead + WLNS	0.48	4.30	16.63	7.50	1.50	0.19	0.61	5.90	1.80



A Joint Venture of Bechtel National, Inc. and
Parsons Infrastructure & Technology Group, Inc.

Calculation Sheet

Project: BGCAPP
 Job Number: 743341
 Calc. No. 24915-10-DBC-00-00004
 Sheet No. B-11 / B-34
 Sheet Rev. D

Subject: Gas Bottles Canopy, Supports, Equip, & Misc Foundations
 By: R. Murphy Date: 12/16/2007

PUNCHING SHEAR I:\STRUCT\SCWO 2007\SCWO MISCELLANEOUS\CONCRETE\APP B CABLE TRAYS\SUPPORT AT JOINT 4.MSC

Proj. No.: **10-DBC-00-00004** Engr: **R. Murphy** Date: **12/14/2007** Checker: **B. Rabe** Date: **12/14/2007**

Pier No.	Load Combination	Max. Load Shear Str KIPS	Applied Punch. Shear Str PSI	Allowed Punch. PSI	Pier Size	Pier Shape	Remarks
P1	9. 0.9Dead + 1.6WLEW	3.676	1.727	189.737	2.00 X 2.00	Square	



A Joint Venture of Bechtel National, Inc. and Parsons Infrastructure & Technology Group, Inc.

Calculation Sheet

Project: BGCAPP
 Job Number: 743341
 Calc. No. 24915-10-DBC-00-00004
 Sheet No. B-12 / B-34
 Sheet Rev. D

Subject: Gas Bottles Canopy, Supports, Equip, & Misc Foundations
 By: R. Murphy Date: 12/16/2007

MAXIMUM FOOTING SHEAR E:\STRUCT\SCWO 2007\SCWO MISCELLANEOUS\CONCRETE\APP B CABLE TRAYS\SUPPORT AT JOINT 4.MSC

Proj. No.: 10-DBC-00-00004 Engr: R. Murphy Date: 12/14/2007 Checker: B. Rahe Date: 12/14/2007

Load No.	Load Combination	Dist. From Left Edge FT	Max. Shear E-W Dir KIPS	Applied Max. Shear Str PSI	Allowed Max. Shear Str PSI	Remarks
1	1.4Dead	5.167	-2.441	2.421	94.868	
2	1.2Dead + 0.5Snow	5.167	-2.354	2.336	94.868	
3	1.2Dead + 1.6Snow	5.167	-2.932	2.909	94.868	
4	1.2Dead + 1.6Snow + 0.8WLEW	5.167	-4.980	4.940	94.868	
5	1.2Dead + 1.6Snow + 0.8WLNS	5.167	-2.932	2.909	94.868	
6	1.2Dead + 0.5Snow + 1.6WLEW	5.167	-8.322	8.256	94.868	
7	1.2Dead + 0.5Snow + 1.6WLNS	5.167	-2.354	2.336	94.868	
8	1.2Dead + 0.2Snow	5.167	-2.197	2.179	94.868	
9	0.9Dead + 1.6WLEW	5.167	-10.826	10.740	94.868	
10	0.9Dead + 1.6WLNS	5.167	-1.569	1.556	94.868	



A Joint Venture of Bechtel National, Inc. and Parsons Infrastructure & Technology Group, Inc.

Calculation Sheet

Project: BGCAPP
 Job Number: 743341
 Calc. No. 24915-10-DBC-00-00004
 Sheet No. B-13 / B-34
 Sheet Rev. D

Subject: Gas Bottles Canopy, Supports, Equip, & Misc Foundations
 By: R. Murphy Date: 12/16/2007

MAXIMUM FOOTING SHEAR I:\STRUCT\SCWO 2007\SCWO MISCELLANEOUS\CONCRETEAPP B CABLE TRAYS\SUPPORT AT JOINT 4.MSC

Checker: B. Rahe Date: 12/14/2007

Engr: R. Murphy Date: 12/14/2007

Proj. No.: 10-DBC-00-00004

Load No.	Load Combination	Dist. From Bottom Edge FT	Max. Shear N-S Dir KIPS	Applied Max. Shear Str PSI	Allowed Max. Shear Str PSI	Remarks
1	1.4Dead	0.833	0.794	0.788	94.868	
2	1.2Dead + 0.5Snow	5.167	-0.743	0.737	94.868	
3	1.2Dead + 1.6Snow	5.167	-0.881	0.874	94.868	
4	1.2Dead + 1.6Snow + 0.8WLEW	5.167	-0.881	0.874	94.868	
5	1.2Dead + 1.6Snow + 0.8WLNS	5.167	-1.053	1.045	94.868	
6	1.2Dead + 0.5Snow + 1.6WLEW	5.167	-0.743	0.737	94.868	
7	1.2Dead + 0.5Snow + 1.6WLNS	5.167	-1.088	1.080	94.868	
8	1.2Dead + 0.2Snow	5.167	-0.706	0.700	94.868	
9	0.9Dead + 1.6WLEW	5.167	-0.511	0.506	94.868	
10	0.9Dead + 1.6WLNS	5.167	-0.856	0.849	94.868	



A Joint Venture of Bechtel National, Inc. and Parsons Infrastructure & Technology Group, Inc.

Calculation Sheet

Project: BGCAPP
 Job Number: 743341
 Calc. No. 24915-10-DBC-00-00004
 Sheet No. B-14 / B-34
 Sheet Rev. D

Subject: Gas Bottles Canopy, Supports, Equip, & Misc Foundations
 By: R. Murphy Date: 12/16/2007

FOOTING REBARS I:\STRUCT\SCWO 2007\SCWO MISCELLANEOUS\CONCRETE\APP B CABLE TRAYS\SUPPORT AT JOINT 4-F.MSC
 Proj. No.: 10-DBC-00-00004 Engr: R. Murphy Date: 12/16/2007 Checker: B. Rahe Date: 12/16/2007

Footing Data:

Footing/Pile Cap Size in N/S Direction (ft)	6.00
Footing/Pile Cap Size in E/W Direction (ft)	6.00
Footing/Pile Cap Thickness (ft)	1.50

Top Steel:

Tot Bars	Bar Size	Rebar Sp (in)	Area Prov (sq in/ft)	Area Req (sq in/ft)	Ult Mom (kip ft/ft)	Controlling Load Case
E/W Dir	6	12	0.44	0.02	-0.80	6. 1.2Dead + 0.5Snow + 1.6WLEW
N/S Dir	6	12	0.44	0.00	0.00	10. 0.9Dead + 1.6WLNS

Bottom Steel:

Tot Bars	Bar Size	Rebar Sp (in)	Area Prov (sq in/ft)	Area Req (sq in/ft)	Ult Mom (kip ft/ft)	Controlling Load Case
E/W Dir	6	12	0.44	0.39	3.13	9. 0.9Dead + 1.6WLEW
N/S Dir	6	12	0.44	0.39	0.42	7. 1.2Dead + 0.5Snow + 1.6WLNS



A Joint Venture of Bechtel National, Inc. and Parsons Infrastructure & Technology Group, Inc.


Calculation Sheet

Project:	BGCAPP
Job Number:	743341
Calc. No.	24915-10-DBC-00-00004
Sheet No.	B-15 / B-34
Sheet Rev.	D

Subject: Gas Bottles Canopy, Supports, Equip, & Misc Foundations
 By: R. Murphy Date: 12/16/2007

Pier Data:

Pier Size in N/S Direction (ft)	2.00
Pier Size in E/W Direction (ft)	2.00
Rebar Size:	6
Number of Rebars:	
E/W Direction:	3
N/S Direction:	3
Total No. of bars:	8
Rebar Spacing: (in)	
E/W Direction:	8
N/S Direction:	8
Area Requested: (sq in)	1.04
Area Provided: (sq in)	3.53
Percent Steel Provided:	0.61%
Tie-bars:	
Total No. of Ties:	4
Tie bar size:	3
Major Tie bar spacing: (in)	10

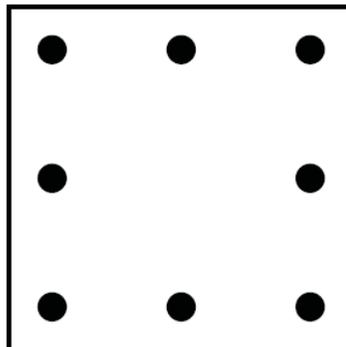



A Joint Venture of Bechtel National, Inc. and Parsons Infrastructure & Technology Group, Inc.

Calculation Sheet

Project: BGCAPP
 Job Number: 743341
 Calc. No. 24915-10-DBC-00-00004
 Sheet No. B-16 / B-34
 Sheet Rev. D

Subject: Gas Bottles Canopy, Supports, Equip, & Misc Foundations
 By: R. Murphy Date: 12/16/2007

PIER - P1 Ultimate Loads I:\STRUCT\SCWO 2007\SCWO MISCELLANEOUS\CONCRETE\APP B CABLE TRAYS\SUPPORT AT JOINT 4-F.MISC
 Proj. No.: 10-DBC-00-00004 Engr: R. Murphy Date: 12/16/2007 Checker: B. Rabe Date: 12/16/2007

Load Case	Load Combination	Axial App Load KIP	Axial All Load KIP	App Mom @ N/S axis KIP FT	All Mom @ N/S axis KIP FT	App Mom @ E/W axis KIP FT	All Mom @ E/W axis KIP FT	Remarks
1	1.4Dead	5.72	86.21	13.77	207.56	0.63	9.49	
2	1.2Dead + 0.5Snow	5.35	80.92	13.47	203.73	0.59	8.90	
3	1.2Dead + 1.6Snow	6.34	73.25	17.15	198.15	0.70	8.06	
4	1.2Dead + 1.6Snow + 0.8WLEW	6.34	36.22	29.91	170.86	0.70	3.98	
5	1.2Dead + 1.6Snow + 0.8WLS	6.34	72.92	17.15	197.27	1.81	20.79	
6	1.2Dead + 0.5Snow + 1.6WLEW	5.35	22.00	39.00	160.27	0.59	2.42	
7	1.2Dead + 0.5Snow + 1.6WLS	5.35	78.48	13.47	197.60	3.61	53.02	
8	1.2Dead + 0.2Snow	5.08	83.90	12.47	205.89	0.56	9.23	
9	0.9Dead + 1.6WLEW	3.68	16.73	34.37	156.34	0.40	1.83	
10	0.9Dead + 1.6WLS	3.68	80.47	8.85	193.58	3.61	79.09	



A Joint Venture of Bechtel National, Inc. and Parsons Infrastructure & Technology Group, Inc.

Calculation Sheet

Project:	BGCAPP
Job Number:	743341
Calc. No.	24915-10-DBC-00-00004
Sheet No.	B-17 / B-34
Sheet Rev.	D

Subject: Gas Bottles Canopy, Supports, Equip, & Misc Foundations
 By: R. Murphy Date: 12/16/2007

FOUNDATION MATERIAL QUANTITIES

EQUIPMENT TYPE	EQUIPMENT NAME/NUMBER
-----------------------	------------------------------

Miscellaneous	MISC
---------------	------

Concrete Volume: Cubic Yards (CY)	2.22
-----------------------------------	------


Formwork Area: Square Feet (SF)	48
---------------------------------	----

Reinforcing Steel Weight: Pounds (LB)	245.29
---------------------------------------	--------

Excavation Volume: Cubic Yards (CY)	13.22
-------------------------------------	-------

Project:	BGCAPP
Job Number:	743341
Calc. No.	24915-10-DBC-00-00004
Sheet No.	B-18 / B-34
Sheet Rev.	D

Subject: Gas Bottles Canopy, Supports, Equip, & Misc Foundations
 By: R. Murphy Date: 12/16/2007

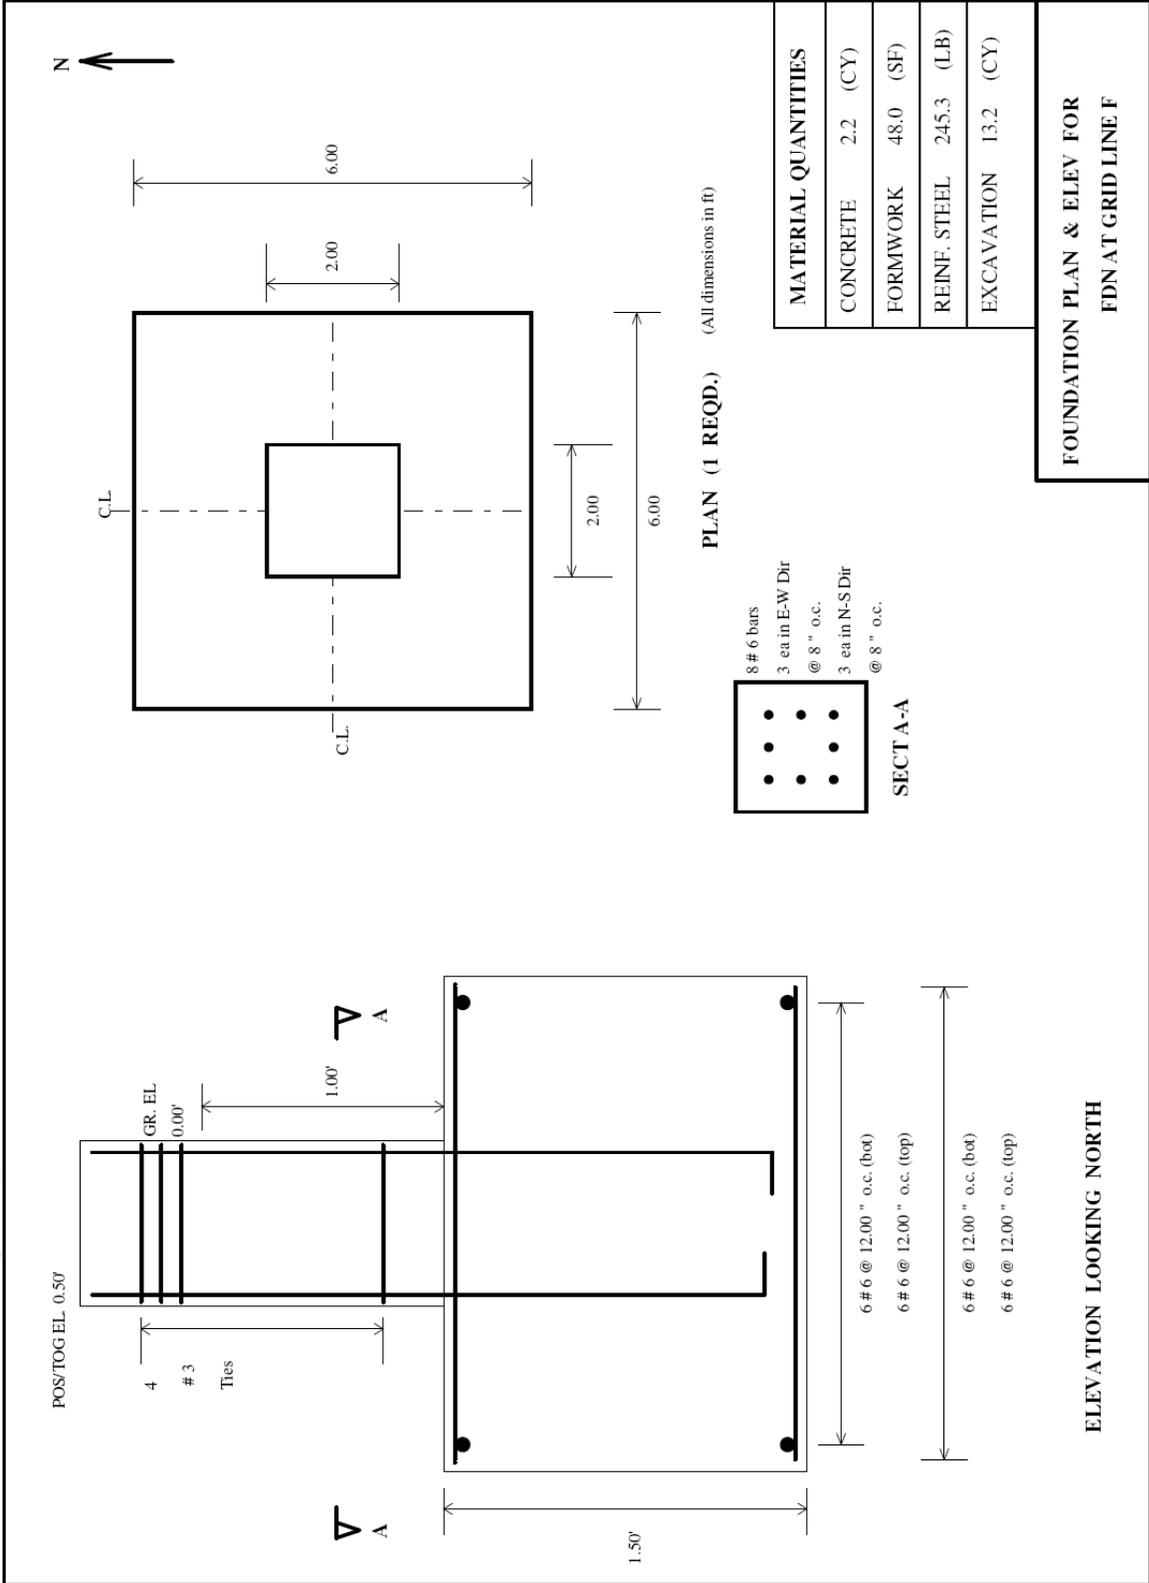

Proj. No.: 10-DBC-00-00004 Engr: R. Murphy Date: 12/16/2007
 Checker: B. Rabe Date: 12/16/2007



A Joint Venture of Bechtel National, Inc. and
Parsons Infrastructure & Technology Group, Inc.

Calculation Sheet

Project:	BGCAPP
Job Number:	743341
Calc. No.	24915-10-DBC-00-00004
Sheet No.	B-19 / B-34
Sheet Rev.	D

Subject: Gas Bottles Canopy, Supports, Equip, & Misc Foundations
 By: R. Murphy Date: 12/16/2007

CIVIL ENGINEERING
FOUNDATION ANALYSIS/DESIGN REPORT

Miscellaneous: Fdn at Grid Line C

PROJECT NO. : 10-DBC-00-00004

PROJECT NAME : SCWO Exterior Cable Tray Support Foundation at Node 13

PROJECT LOCATION : Richmond, KY

CLIENT :

PROJECT TYPE :

REFERENCE DOCUMENTS : _____

By: _____ Checked: _____ Approved: _____
 Date: _____ Date: _____ Date: _____

Parsons

100 West Walnut St., Pasadena, CA



A Joint Venture of Bechtel National, Inc. and Parsons Infrastructure & Technology Group, Inc.

Calculation Sheet

Project:	BGCAPP
Job Number:	743341
Calc. No.	24915-10-DBC-00-00004
Sheet No.	B-20 / B-34
Sheet Rev.	D

Subject: Gas Bottles Canopy, Supports, Equip, & Misc Foundations
 By: R. Murphy Date: 12/16/2007

Units:

Input Units:	English	Output Units:	English	Code:	ACI 318 - 2002
--------------	---------	---------------	---------	-------	----------------

Concrete Parameters:

Compressive Strength : (psi)	4000	Unit Weight : (pcf)	150
Pier Concrete Cover:		Allowable Concrete Stress increase:	
E-W Direction : (in)	3	Wind	0.00%
N-S Direction : (in)	3	Earthquake	0.00%
Footing Concrete Cover:		Test	0.00%
E-W Direction : (in)	3		
N-S Direction : (in)	3		
Top Steel to Top of footing : (in)	2		
Bot Steel to Bot of footing/ Top of Pile : (in)	3		

Reinforcing Steel Parameters:

Yield Strength : (ksi)	60	Unit Weight of Steel: (pcf)	490
Modulus of Elasticity of Steel: (ksi)	29000	Footing Bar Spacing:	
Pier Bars and Spacing:		Min Rebar spacing: (in)	3
Min Rebar spacing: (in)	3	Max Rebar spacing: (in)	12
Max no. of bars per Pier	800	Max Footing Rebar Size	9
Temperature and Shrinkage Steel Ratio:	0.0018	Min Footing Rebar Size	5

Soil/Pile Parameters:

Foundation Type :	Soil-Supported	Soil Unit Weight : (pcf)	120
Allowable Bearing Pressure : (psf)	3000	Allowable Soil Pressure increase	
Stability Ratios/Safety Factor:		Wind	33.33%
Minimum Stability Ratio for Erection	1.5	Earthquake	33.33%
Minimum Stability Ratio for Operation	1.5	Test	20.00%
Minimum Stability Ratio for Test	1.5	Type of Soil:	Granular
Safety Factor against Lateral Forces	1.5	Passive Pressure Coeff Kp	5
		Soil To Conc. Friction f:	0.5



A Joint Venture of Bechtel National, Inc. and Parsons Infrastructure & Technology Group, Inc.

Calculation Sheet

Project:	BGCAPP
Job Number:	743341
Calc. No.	24915-10-DBC-00-00004
Sheet No.	B-21 / B-34
Sheet Rev.	D

Subject: Gas Bottles Canopy, Supports, Equip, & Misc Foundations
 By: R. Murphy Date: 12/16/2007

Pier Parameters:

Shape:	Rectangular
Min. Reinf. Ratio:	0.0018

Footing Parameters:

Min. Footing or Cap Thickness Tf (ft):	2
Depth of Footing or Cap below grade Df (ft):	4.25
Min. Soil cover above Footing or Cap Sc (ft):	2.25
Depth of Water table below grade (ft):	0
Consider Buoyancy:	No



A Joint Venture of Bechtel National, Inc. and Parsons Infrastructure & Technology Group, Inc.

Calculation Sheet

Project: BGCAPP
 Job Number: 743341
 Calc. No. 24915-10-DBC-00-00004
 Sheet No. B-22 / B-34
 Sheet Rev. D

Subject: Gas Bottles Canopy, Supports, Equip, & Misc Foundations
 By: R. Murphy Date: 12/16/2007

Applied Loads Pier - P1 I:STRUCTSCWO 2007SCWO MISCELLANEOUS/CONCRETE/APP B CABLE TRAYS/SUPPORT AT JOINT 13.MSC

Proj. No.: 10-DBC-00-00004 Engr: R. Murphy Date: 12/13/2007 Checker: B. Rahe Date: 12/13/2007

Load No.	Load case	Axial	Shear E-W	Mom N-S	Shear N-S	Mom E-W
		KIP	KIP	KIP FT	KIP	KIP FT
1	Dead	7.34	0.00	27.36	0.81	-0.02
2	Snow	0.81	0.00	3.81	0.06	0.00
3	WLEW	0.00	1.92	26.65	0.00	0.00
4	WLNS	-1.33	-0.27	-4.08	-0.95	0.07



A Joint Venture of Bechtel National, Inc. and Parsons Infrastructure & Technology Group, Inc.

Calculation Sheet

Project: BGCAPP
 Job Number: 743341
 Calc. No. 24915-10-DBC-00-00004
 Sheet No. B-23 / B-34
 Sheet Rev. D

Subject: Gas Bottles Canopy, Supports, Equip, & Misc Foundations
 By: R. Murphy Date: 12/16/2007

Allowable Strength Load Combinations Pier - P1 I:STRUCTSCWO 2007SCWO MISCELLANEOUS/CONCRETEAPP B CABLE TRAYS/SUPPORT AT JOINT I:MSC

Proj. No.: 10-DBC-00-00004 Engr: R. Murphy Date: 12/13/2007 Checker: B. Rahe Date: 12/13/2007

Load No.	Load Combination	Axial KIP	Shear E-W KIP	Mom N-S KIP FT	Shear N-S KIP	Mom E-W KIP FT
1	Dead	7.34	0.00	27.36	0.81	-0.02
2	Dead + Snow	8.15	0.00	31.17	0.87	-0.02
3	Dead + 0.75Snow	7.94	0.00	30.22	0.85	-0.02
4	Dead + WLEW	7.33	1.92	54.01	0.81	-0.02
5	Dead + WLNS	6.01	-0.27	23.28	-0.14	0.05
6	Dead + 0.75Snow + 0.75WLEW	7.94	1.44	50.20	0.85	-0.02
7	Dead + 0.75Snow + 0.75WLNS	6.95	-0.20	27.16	0.14	0.03
8	0.6Dead + WLEW	4.40	1.92	43.06	0.49	-0.01
9	0.6Dead + WLNS	3.07	-0.27	12.34	-0.46	0.06



A Joint Venture of Bechtel National, Inc. and Parsons Infrastructure & Technology Group, Inc.

Calculation Sheet

Project: BGCAPP
 Job Number: 743341
 Calc. No. 24915-10-DBC-00-00004
 Sheet No. B-24 / B-34
 Sheet Rev. D

Subject: Gas Bottles Canopy, Supports, Equip, & Misc Foundations
 By: R. Murphy Date: 12/16/2007

Ultimate Strength Load Combinations Pier - P1 F-STRUCTSCWO 2007/SCWO MISCELLANEOUS/CONCRETE/APP B CABLE TRAYS/SUPPORT AT JOINT 13.MSC

Proj. No: 10-DBC-00-00004 Engr: R. Murphy Date: 12/13/2007 Checker: B. Rahe Date: 12/13/2007

Load No.	Load Combination	Axial KIP	Shear E-W KIP	Mom N-S KIP FT	Shear N-S KIP	Mom E-W KIP FT
1	1.4Dead	10.27	0.00	38.31	1.13	-0.03
2	1.2Dead + 0.5Snow	9.21	0.00	34.74	1.00	-0.03
3	1.2Dead + 1.6Snow	10.10	0.00	38.93	1.06	-0.03
4	1.2Dead + 1.6Snow + 0.8WLEW	10.10	1.54	60.25	1.06	-0.03
5	1.2Dead + 1.6Snow + 0.8WLNS	9.04	-0.22	35.67	0.30	0.03
6	1.2Dead + 0.5Snow + 1.6WLEW	9.21	3.07	77.37	1.00	-0.03
7	1.2Dead + 0.5Snow + 1.6WLNS	7.09	-0.43	28.22	-0.52	0.09
8	1.2Dead + 0.2Snow	8.97	0.00	33.60	0.98	-0.03
9	0.9Dead + 1.6WLEW	6.60	3.07	67.26	0.73	-0.02
10	0.9Dead + 1.6WLNS	4.48	-0.43	18.10	-0.79	0.10



A Joint Venture of Bechtel National, Inc. and Parsons Infrastructure & Technology Group, Inc.

Calculation Sheet

Project: BGCAPP
 Job Number: 743341
 Calc. No. 24915-10-DBC-00-00004
 Sheet No. B-25 / B-34
 Sheet Rev. D

Subject: Gas Bottles Canopy, Supports, Equip, & Misc Foundations
 By: R. Murphy Date: 12/16/2007

BEARING CAPACITY E:STRUCTSCWO 2007SCWO MISCELLANEOUSCONCRETEAPPB CABLE TRAYSUPPORT AT JOINT 13.MSC

Proj. No.: 10-DBC-00-00004 Engr: R. Murphy Date: 12/13/2007 Checker: B. Rabe Date: 12/13/2007

Load No.	Load Comb	Gross Soil Pres KSF	Allow Soil Pres KSF	S.R. in N/S Dir	S.R. in E/W Dir	Allow Min S.R.	Ecc. in N/S Dir FT	Ecc. in E/W Dir FT	Moment @ N/S axis KIP FT	Moment @ E/W axis KIP FT
1	Dead	1.41	3.51	24.84	4.07	1.50	0.12	0.86	27.35	3.83
2	Dead + Snow	1.51	3.51	23.79	3.67	1.50	0.13	0.95	31.16	4.09
3	Dead + 0.75Snow	1.49	3.51	24.04	3.76	1.50	0.12	0.93	30.21	4.03
4	Dead + WLEW	2.47	4.51	24.87	1.77	1.50	0.12	1.98	63.13	3.82
5	Dead + WLNS	1.19	4.51	100.00	4.64	1.50	0.02	0.72	22.00	0.60
6	Dead + 0.75Snow + 0.75WLEW	2.20	4.51	24.06	1.99	1.50	0.12	1.76	57.04	4.02
7	Dead + 0.75Snow + 0.75WLNS	1.30	4.51	100.00	4.09	1.50	0.02	0.83	26.20	0.70
8	0.6Dead + WLEW	2.93	4.51	37.65	1.94	1.50	0.12	2.73	52.19	2.29
9	0.6Dead + WLNS	0.70	4.51	37.74	7.93	1.50	0.12	0.62	11.06	2.14



A Joint Venture of Bechtel National, Inc. and Parsons Infrastructure & Technology Group, Inc.

Calculation Sheet

Project: BGCAPP
 Job Number: 743341
 Calc. No. 24915-10-DBC-00-00004
 Sheet No. B-26 / B-34
 Sheet Rev. D

Subject: Gas Bottles Canopy, Supports, Equip, & Misc Foundations
 By: R. Murphy Date: 12/16/2007

PUNCHING SHEAR I:\STRUCT\SCWO 2007\SCWO MISCELLANEOUS\CONCRETE\APP B CABLE TRAYS\SUPPORT AT JOINT 13.MSC

Proj. No.: 10-DBC-00-00004 Engr: R. Murphy Date: 12/13/2007 Checker: B. Rabe Date: 12/13/2007

Pier No.	Load Combination	Max. Load Shear Str KIPS	Applied Punch. Shear Str PSI	Allowed Punch. PSI	Pier Size	Pier Shape	Remarks
P1	9.0 _{Dead} + 1.6 _{WLEW}	7.756	2.203	189.737	FT 2.00 X 2.00	Square	



A Joint Venture of Bechtel National, Inc. and Parsons Infrastructure & Technology Group, Inc.

Calculation Sheet

Project: BGCAPP
 Job Number: 743341
 Calc. No. 24915-10-DBC-00-00004
 Sheet No. B-27 / B-34
 Sheet Rev. D

Subject: Gas Bottles Canopy, Supports, Equip, & Misc Foundations
 By: R. Murphy Date: 12/16/2007

MAXIMUM FOOTING SHEAR (STRUCTSCWO 2007) SCWO MISCELLANEOUS CONCRETE/TAPE B CABLE TRAYS/SUPPORT AT JOINT 13.MSC

Proj. No.: 10-DBC-00-00004 Engr: R. Murphy Date: 12/13/2007 Checker: B. Rate Date: 12/13/2007

Load No.	Load Combination	Dist. From Left Edge FT	Max. Shear E-W Dir KIPS	Applied Max. Shear Str PSI	Allowed Max. Shear Str PSI	Remarks
1	1.4Dead	6.167	-4.940	3.430	94.868	
2	1.2Dead + 0.5Snow	6.167	-4.454	3.093	94.868	
3	1.2Dead + 1.6Snow	6.167	-4.937	3.428	94.868	
4	1.2Dead + 1.6Snow + 0.8WLEW	6.167	-8.042	5.585	94.868	
5	1.2Dead + 1.6Snow + 0.8WLNS	6.167	-4.426	3.073	94.868	
6	1.2Dead + 0.5Snow + 1.6WLEW	6.167	-13.534	9.399	94.868	
7	1.2Dead + 0.5Snow + 1.6WLNS	6.167	-3.431	2.383	94.868	
8	1.2Dead + 0.2Snow	6.167	-4.322	3.001	94.868	
9	0.9Dead + 1.6WLEW	6.167	-16.948	11.770	94.868	
10	0.9Dead + 1.6WLNS	6.167	-2.153	1.495	94.868	



A Joint Venture of Bechtel National, Inc. and Parsons Infrastructure & Technology Group, Inc.

Calculation Sheet

Project: BGCAPP
 Job Number: 743341
 Calc. No. 24915-10-DBC-00-00004
 Sheet No. B-28 / B-34
 Sheet Rev. D

Subject: Gas Bottles Canopy, Supports, Equip, & Misc Foundations
 By: R. Murphy Date: 12/16/2007

MAXIMUM FOOTING SHEAR FOR STRUCTURE 2007SCWO MISCELLANEOUS CONCRETE APP B CABLE TRAYS SUPPORT AT JOINT 13.MSC

Proj. No.: 10-DBC-00-00004 Engr: R. Murphy Date: 12/13/2007 Checker: B. Rahe Date: 12/13/2007

Load No.	Load Combination	Dist. From Bottom Edge FT	Max. Shear N-S Dir KIPS	Applied Max. Shear Str PSI	Allowed Max. Shear Str PSI	Remarks
1	1.4Dead	5.667	-0.980	0.583	94.868	
2	1.2Dead + 0.5Snow	5.667	-0.870	0.518	94.868	
3	1.2Dead + 1.6Snow	5.667	-0.934	0.556	94.868	
4	1.2Dead + 1.6Snow + 0.8WLEW	5.667	-0.934	0.556	94.868	
5	1.2Dead + 1.6Snow + 0.8WLNS	5.667	-0.690	0.410	94.868	
6	1.2Dead + 0.5Snow + 1.6WLEW	5.667	-0.869	0.517	94.868	
7	1.2Dead + 0.5Snow + 1.6WLNS	0.333	0.628	0.374	94.868	
8	1.2Dead + 0.2Snow	5.667	-0.852	0.507	94.868	
9	0.9Dead + 1.6WLEW	5.667	-0.629	0.375	94.868	
10	0.9Dead + 1.6WLNS	0.333	0.523	0.311	94.868	



A Joint Venture of Bechtel National, Inc. and Parsons Infrastructure & Technology Group, Inc.

Calculation Sheet

Project: BGCAPP
 Job Number: 743341
 Calc. No. 24915-10-DBC-00-00004
 Sheet No. B-29 / B-34
 Sheet Rev. D

Subject: Gas Bottles Canopy, Supports, Equip, & Misc Foundations
 By: R. Murphy Date: 12/16/2007

FOOTING REBARS I:\STRUCT\SCWO 2007\SCWO MISCELLANEOUS\CONCRETE\APP B CABLE TRAYS\SUPPORT AT JOINT 13-C.MISC
 Proj. No.: 10-DBC-00-00004 Engr: R. Murphy Date: 12/16/2007
 Checker: B. Rabe Date: 12/16/2007

Footing Data:

Footing/Pile Cap Size in N/S Direction (ft)	6.00
Footing/Pile Cap Size in E/W Direction (ft)	7.00
Footing/Pile Cap Thickness (ft)	2.00

Top Steel:

Tot Bars	Bar Size	Rebar Sp (in)	Area Prov (sq in/ft)	Area Req (sq in/ft)	Ult Mom (kip ft/ft)	Controlling Load Case
E/W Dir	6	12	0.44	0.03	-2.04	6. 1.2Dead + 0.5Snow + 1.6WLEW
N/S Dir	7	12	0.44	0.00	0.00	10. 0.9Dead + 1.6WLNS

Bottom Steel:

Tot Bars	Bar Size	Rebar Sp (in)	Area Prov (sq in/ft)	Area Req (sq in/ft)	Ult Mom (kip ft/ft)	Controlling Load Case
E/W Dir	6	9	0.59	0.52	7.34	9. 0.9Dead + 1.6WLEW
N/S Dir	6	9	0.57	0.52	0.80	1. 1.4Dead



A Joint Venture of Bechtel National, Inc. and Parsons Infrastructure & Technology Group, Inc.


Calculation Sheet

Project:	BGCAPP
Job Number:	743341
Calc. No.	24915-10-DBC-00-00004
Sheet No.	B-30 / B-34
Sheet Rev.	D

Subject: Gas Bottles Canopy, Supports, Equip, & Misc Foundations
 By: R. Murphy Date: 12/16/2007

Pier Data:

Pier Size in N/S Direction (ft)	2.00
Pier Size in E/W Direction (ft)	2.00
Rebar Size:	6
Number of Rebars:	
E/W Direction:	3
N/S Direction:	3
Total No. of bars:	8
Rebar Spacing: (in)	
E/W Direction:	8
N/S Direction:	8
Area Requested: (sq in)	1.04
Area Provided: (sq in)	3.53
Percent Steel Provided:	0.61%
Tie-bars:	
Total No. of Ties:	5
Tie bar size:	3
Major Tie bar spacing: (in)	11

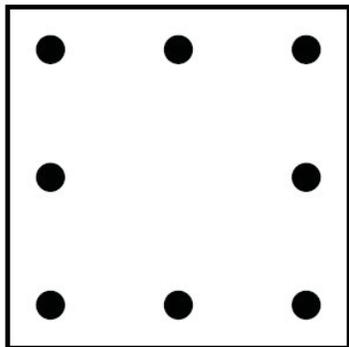



A Joint Venture of Bechtel National, Inc. and Parsons Infrastructure & Technology Group, Inc.

Calculation Sheet

Project: BGCAPP
 Job Number: 743341
 Calc. No. 24915-10-DBC-00-00004
 Sheet No. B-31 / B-34
 Sheet Rev. D

Subject: Gas Bottles Canopy, Supports, Equip, & Misc Foundations
 By: R. Murphy Date: 12/16/2007

PIER - P1 Ultimate Loads I:\STRUCT\SCWO 2007\SCWO MISCELLANEOUS\CONCRETE\APP B CABLE TRAYS\SUPPORT AT JOINT 13-C\MISC

Proj. No.: 10-DBC-00-00004 Engr: R. Murphy Date: 12/16/2007 Checker: B. Rabe Date: 12/16/2007

Load Case	Load Combination	Axial App Load KIP	Axial All Load KIP	App Mom @ N/S axis KIP FT	All Mom @ N/S axis KIP FT	App Mom @ E/W axis KIP FT	All Mom @ E/W axis KIP FT	Remarks
1	1.4Dead	12.58	62.35	38.30	189.79	3.09	15.31	
2	1.2Dead + 0.5Snow	11.19	60.77	34.73	188.65	2.72	14.80	
3	1.2Dead + 1.6Snow	12.08	57.90	38.93	186.57	2.89	13.87	
4	1.2Dead + 1.6Snow + 0.8WLEW	12.08	31.30	64.47	167.02	2.89	7.49	
5	1.2Dead + 1.6Snow + 0.8WLS	11.02	58.95	35.07	187.67	1.21	6.48	
6	1.2Dead + 0.5Snow + 1.6WLEW	11.19	20.76	85.82	159.22	2.72	5.04	
7	1.2Dead + 0.5Snow + 1.6WLS	9.07	64.20	27.03	191.44	1.33	9.43	
8	1.2Dead + 0.2Snow	10.95	61.69	33.59	189.32	2.68	15.10	
9	0.9Dead + 1.6WLEW	8.08	16.69	75.71	156.21	1.98	4.08	
10	0.9Dead + 1.6WLS	5.96	68.26	16.92	193.62	2.07	23.69	



A Joint Venture of Bechtel National, Inc. and
Parsons Infrastructure & Technology Group, Inc.

Calculation Sheet

Project:	BGCAPP
Job Number:	743341
Calc. No.	24915-10-DBC-00-00004
Sheet No.	B-32 / B-34
Sheet Rev.	D

Subject: Gas Bottles Canopy, Supports, Equip, & Misc Foundations
 By: R. Murphy Date: 12/16/2007

FOUNDATION MATERIAL QUANTITIES

EQUIPMENT TYPE

EQUIPMENT NAME/NUMBER

Miscellaneous

MISC

Concrete Volume: Cubic Yards (CY)

3.52

Formwork Area: Square Feet (SF)

74

Reinforcing Steel Weight: Pounds (LB)


339.24

Excavation Volume: Cubic Yards (CY)

36.92

Project:	BGCAPP
Job Number:	743341
Calc. No.	24915-10-DBC-00-00004
Sheet No.	B-33 / B-34
Sheet Rev.	D

Subject: Gas Bottles Canopy, Supports, Equip, & Misc Foundations
 By: R. Murphy Date: 12/16/2007

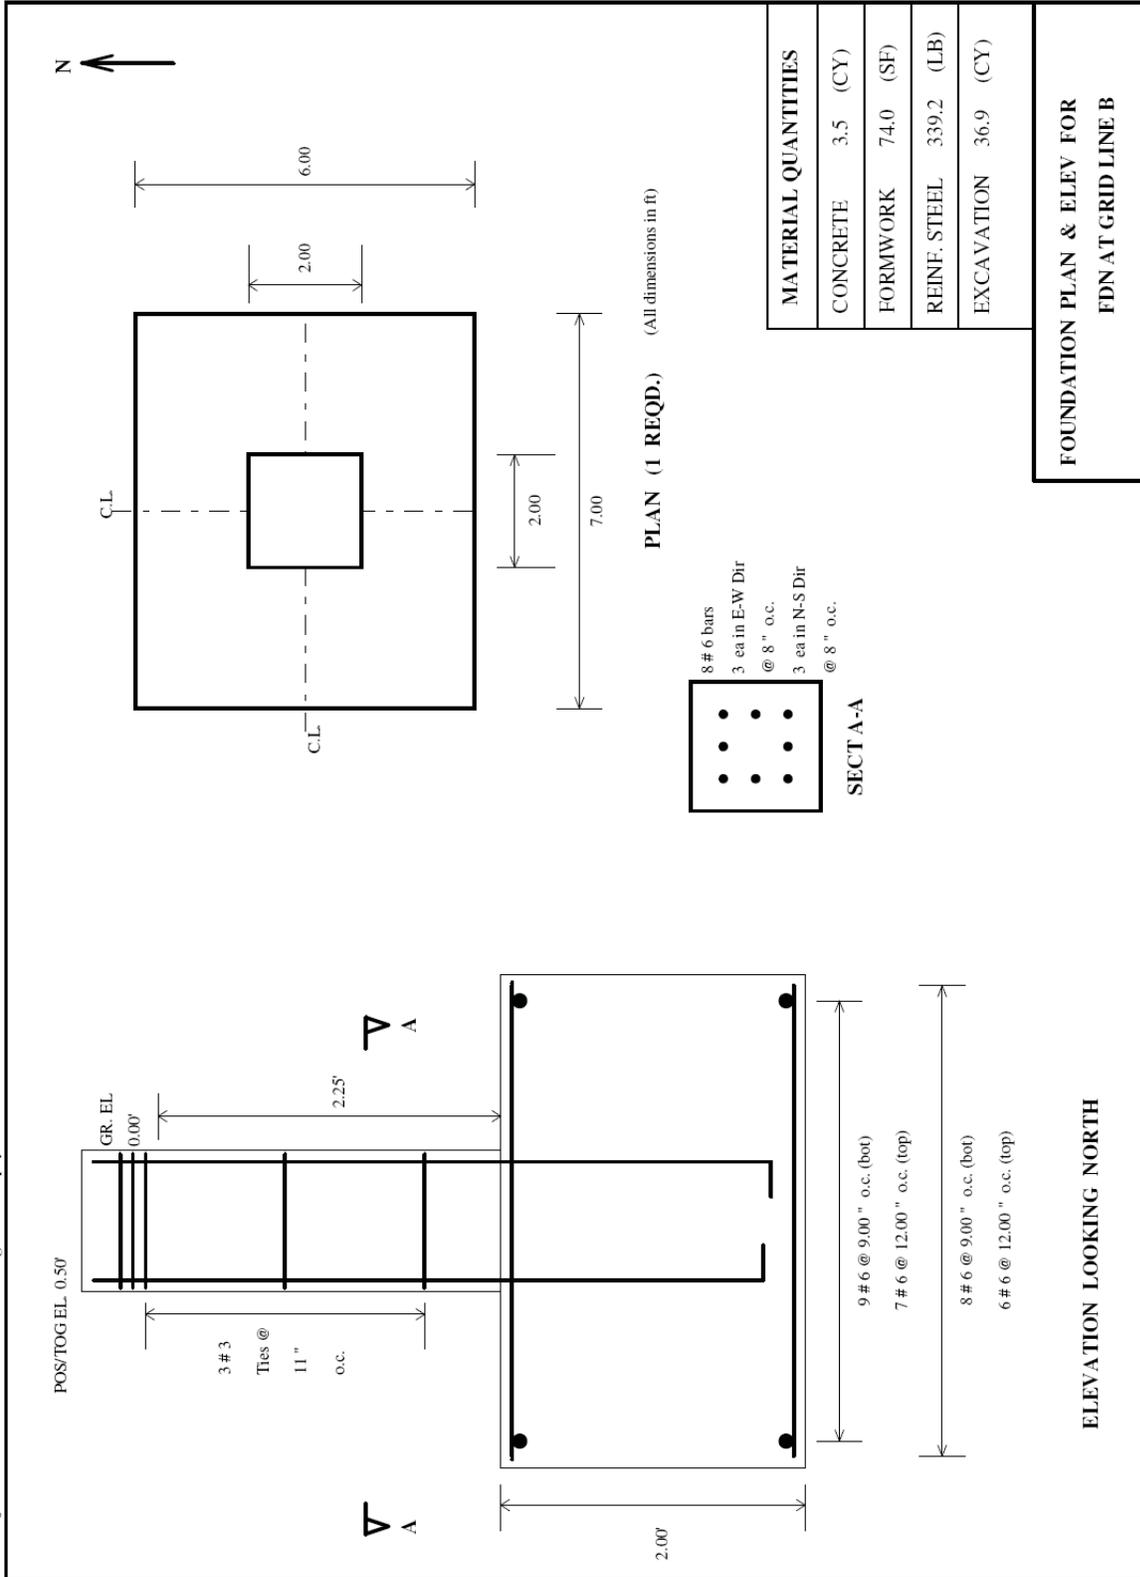

Checker: B. Rabe Date: 12/16/2007

Engr: R. Murphy Date: 12/16/2007

Proj. No.: 10-DBC-00-00004



A Joint Venture of Bechtel National, Inc. and Parsons Infrastructure & Technology Group, Inc.

Calculation Sheet

Project:	BGCAPP
Job Number:	743341
Calc. No.	24915-10-DBC-00-00004
Sheet No.	B-34 / B-34
Sheet Rev.	D

Subject: Gas Bottles Canopy, Supports, Equip, & Misc Foundations
 By: R. Murphy Date: 12/16/2007

B.5. Summary

The calculation performed in this appendix includes structural analysis and design of isolated footings for supports of elevated cable trays along the exterior of the SCWO Processing Building (SPB). Wind loads govern the design. No soil uplift is observed under worst-case overturning wind loads, and wind sliding resistance of the foundations is adequate.

Foundations at column lines B, C, and D (F-22) are 2' thick with 2'-3" of soil cover. They measure 7' in the E-W direction and 6' in the N-S direction. Reinforcement is #6 @ 9" o.c. N-S and E-W on bottom, and #6 @ 12" o.c. N-S and E-W on top.

Foundations at column lines E, F, and G (F-23) are 1'-6" thick with 1' of soil cover. They measure 6' in the E-W direction and 6' in the N-S direction. Reinforcement is #6 @ 12" o.c. N-S and E-W on bottom, and #6 @ 12" o.c. N-S and E-W on top.



A Joint Venture of Bechtel National, Inc. and
Parsons Infrastructure & Technology Group, Inc.

Calculation Sheet

Project:	<u>BGCAPP</u>
Job Number:	<u>743341</u>
Calc. No.	<u>24915-10-DBC-00-00004</u>
Sheet No.	<u>C-1 / C-22</u>
Sheet Rev.	<u>D</u>

Subject:	<u>Gas Bottles Canopy, Supports, Equip, & Misc Foundations</u>	
By:	<u>R. Murphy</u>	Date: <u>12/16/2007</u>

Appendix C

HVAC Duct Supports Foundations



A Joint Venture of Bechtel National, Inc. and
Parsons Infrastructure & Technology Group, Inc.

Calculation Sheet

Project:	BGCAPP
Job Number:	743341
Calc. No.	24915-10-DBC-00-00004
Sheet No.	C-2 / C-22
Sheet Rev.	D

Subject: Gas Bottles Canopy, Supports, Equip, & Misc Foundations
By: R. Murphy Date: 12/16/2007

C.1. Objective

The calculation performed in this appendix includes structural analysis and design of isolated footings for supports of elevated HVAC ducts at the exterior of the SCWO Processing Building (SPB).

C.2. Inputs

The ducts are located along the eastern face of the SPB. Two 32"x32" rectangular ducts extend out from the face of the structure between column lines H and J toward the east before and connect to HVAC units 10-MA-HVAC-AHU1001 and -AHU1002.

See drawing 24915-10-P2-HVAC-00008 for duct locations.

See drawings 24915-10-SS-00-00063 and 00064 for duct support framing layout and details.

Construction materials are listed in Section 2.1 and load information is listed in Section 2.2.

Loads from the steel duct supports are taken from calc. no. 24915-10-SSC-00-00006 Rev. A, Appendix C4.

C.3 Assumptions

Seismic loads are not considered in the analysis because they produced lower shear and overturning values than the wind loads.

C.4 Calculation Body

Base reactions from GTSTRUDL steel analysis and design are given here. These loads are the input for the Foundation3D footing design. Designs for the two individual footings are included in this appendix.



A Joint Venture of Bechtel National, Inc. and Parsons Infrastructure & Technology Group, Inc.

Calculation Sheet

Project: BGCAPP
 Job Number: 743341
 Calc. No. 24915-10-DBC-00-00004
 Sheet No. C-3 / C-22
 Sheet Rev. D

Subject: Gas Bottles Canopy, Supports, Equip, & Misc Foundations
 By: R. Murphy Date: 12/16/2007

Reaction Values from GTSTRUDL Analysis (units: kip, ft)

Joint	Z FORCE	X FORCE	Y MOMENT	Y FORCE	X MOMENT
10	1.953	0.013	0.096	-0.019	-0.528
	1.168	0.011	0.083	-0.017	-0.450
	-0.066	-0.010	-0.176	-1.208	21.943
	0.009	-0.927	-4.414	-0.182	4.073
15	2.314	-0.038	-0.207	0.001	-0.024
	1.153	-0.033	-0.177	0.001	-0.020
	-0.007	-0.104	-2.190	-2.692	53.474
	-0.033	-1.018	-7.113	-0.015	0.326

Following are the FOUNDATION 3D analyses of the isolated footings at nodes 10 and 15.



Calculation Sheet

Project: BGCAPP
 Job Number: 743341
 Calc. No. 24915-10-DBC-00-00004
 Sheet No.: C-4 of C-22
 Sheet Rev: D

Subject: Gas Bottle Canopy, Supports, Misc. Fdn's.
 By: R. Murphy
 Date: 1/22/08

Dimensional Solutions FOUNDATION3D	Version	4.0.0	Date	2/19/2008
Foundation Name	W8x31 Supt - Node 10		Time	8:26:48 AM
Designed By:		Engineer	Checker	
Filename:	C:\Documents and Settings\p0035165\Desktop\SCWO Misc CONCRETE\App C Duct Supports\pg8 foundation 1.msc			

SUMMARY REPORT FOR W8x31 Supt - Node 10

PROJECT INFORMATION

Project Name:
 Project Number:
 Client:
 Project Location:
 Foundation Description: FOUNDATION

DESIGN CODE: ACI 318 - 2002 INPUT UNITS: English OUTPUT UNITS: English

CONCRETE PARAMETERS:

Compressive Strength (psi): 4000.00
 Unit Weight (pcf): 150.00

REINFORCING STEEL PARAMETERS:

Yield Strength (ksi): 60.00
 Unit Weight (pcf): 490.00
 Modulus of Elasticity (ksi): 29000.00

SOIL PARAMETERS:

Allowable Net Bearing Capacity (psf): 6000.00
 Unit Weight (pcf): 120.00

MINIMUM FOUNDATION CRITERIA:

Depth of Footing Below Grade (ft): 3
 Minimum Soil Cover (ft): 1.00
 Grade Elevation (ft): 0.00

REBAR PARAMETERS:

Max Long Bar Size: 6
 Min Long Bar Size: 6
 Max Tie Bar Size: 4
 Min Tie Bar Size: 3
 Max Ftg Bar Size: 9
 Min Ftg Bar Size: 5
 Temp & Shrinkage Steel Ratio: 0.0018

BUOYANCY CRITERIA:

Consider Buoyancy: No
 Consider soil for buoyancy: No
 Water table below grade (ft): 0



Calculation Sheet

Project: BGCAPP
 Job Number: 743341
 Calc. No. 24915-10-DBC-00-00004
 Sheet No.: C-5 of C-22
 Sheet Rev: D

Subject: Gas Bottle Canopy, Supports, Misc. Fdn's.
 By: R. Murphy
 Date: 1/22/08

Dimensional Solutions FOUNDATION3D	Version 4.0.0	Date 2/19/2008
Foundation Name W8x31 Supt - Node 10		Time 8:26:48 AM
Designed By:	Engineer	Checker
Filename: pg8 foundation 1.msc	C:\Documents and Settings\p0035165\Desktop\SCWO Misc CONCRETE\App C Duct Supports\	

SUMMARY REPORT FOR W8x31 Supt - Node 10

PIER/BASE PLATE DESIGN INFORMATION

	P1
E-W Dim (ft)	2.00
N-S Dim (ft)	2.00
Height (ft)	1.50
E-W Offset (ft)	0.00
N-S Offset (ft)	0.00
Requested Reinf. Ratio	0.0018
Provided Reinf. Ratio	0.0061
Long Bar Size	6
Bars in E-W Dir	3
Bars in N-S Dir	3
Total Long Bars	8
Tie Bar Size	3
Total No. of Ties	4
Major Tie Spacing (in)	10

FOOTING DESIGN INFORMATION

E-W Dim (ft)	5.00
N-S Dim (ft)	5.00
Thickness (ft)	2.00

MATERIAL QUANTITIES

Concrete Cubic Yards (CY)	2.06
Reinforcing Steel Pounds (LB)	201.69
Formwork Square Feet (SF)	52
Excavation Cubic Yards (CY)	15.44

Top Steel

Governing Combination	No of Bars	Bar Size	Bar Spac (in)	Area Prov (sq in/ft)	Area Req (sq in/ft)	Moment (kip ft/ft)	Direction
7. 0.9Dead + 1.6Wind EW	4	6	18	0.35	0.01	-0.38	E-W
4. 1.2Dead + 0.5Live + 1.6Wind NS	4	6	18	0.35	0.01	-0.54	N-S


Bottom Steel

Governing Combination	No of Bars	Bar Size	Bar Spac (in)	Area Prov (sq in/ft)	Area Req (sq in/ft)	Moment (kip ft/ft)	Direction
5. 1.2Dead + 0.5Live + 1.6Wind EW	7	6	9	0.62	0.52	0.7	E-W
6. 0.9Dead + 1.6Wind NS	7	6	9	0.62	0.52	2.86	N-S

Subject: Gas Bottle Canopy, Supports, Misc. Fdn's.
 By: R. Murphy
 Date: 1/22/08

Dimensional Solutions FOUNDATION3D	Version 4.0.0	Date 2/19/2008
Foundation Name W8x31 Supt - Node 10	Engineer	Time 8:26:48 AM
Designed By:	Engineer	Checker
Filename: C:\Documents and Settings\p0035165\Desktop\SCWO Misc CONCRETE\App C Duct Supports\pg8 foundation 1.msc		

SUMMARY REPORT FOR W8x31 Supt - Node 10

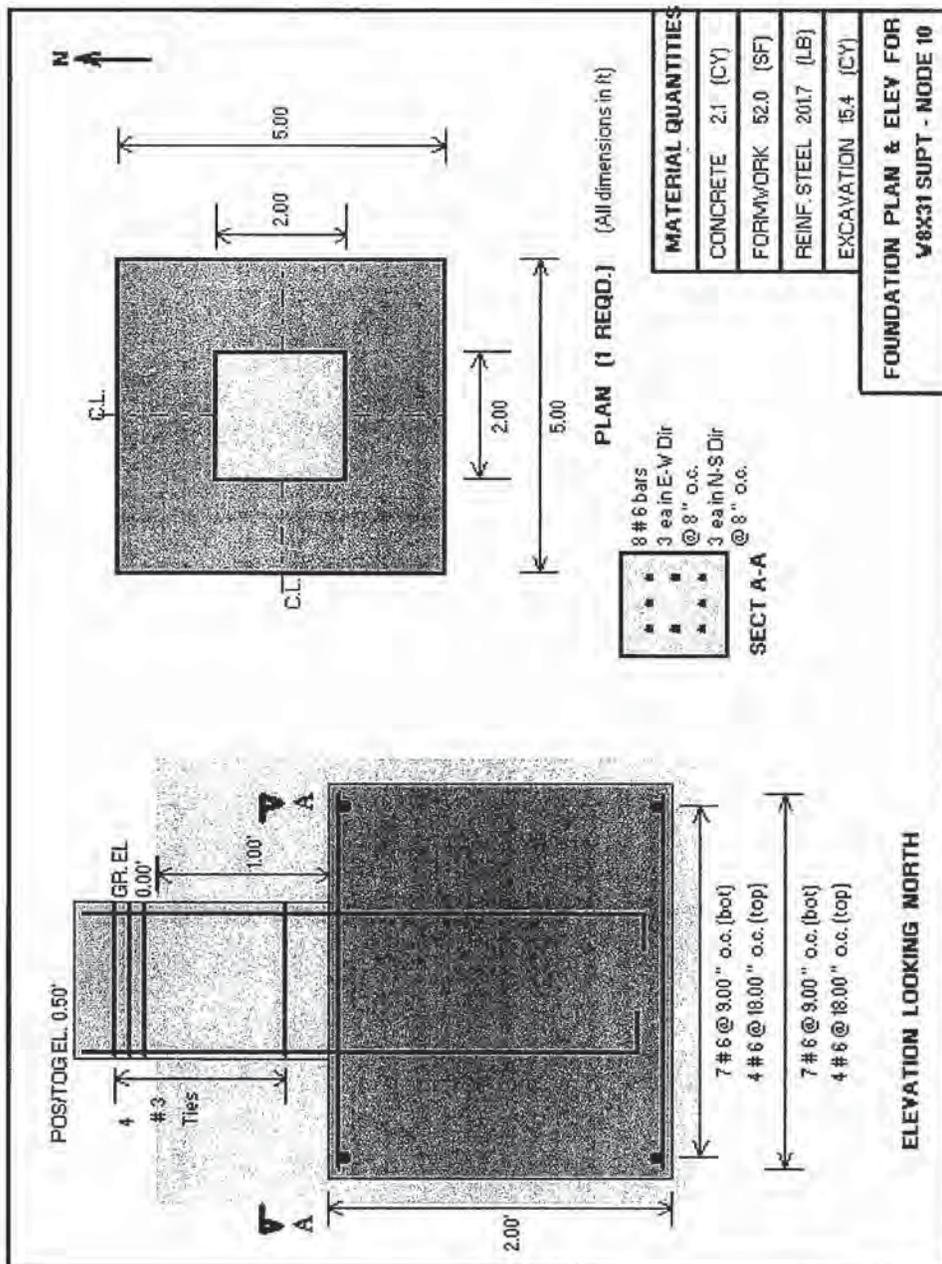



Calculation Sheet

Project: BGCAPP
 Job Number: 743341
 Calc. No. 24915-10-DBC-00-00004
 Sheet No. C-7 of C-22
 Sheet Rev: D

Subject: Gas Bottle Canopy, Supports, Misc. Fdn's.
 By: R. Murphy
 Date: 1/22/08

Dimensional Solutions FOUNDATION3D	Version	4.0.0	Date	2/19/2008
Foundation Name	W8x31 Supt - Node 10		Time	8:26:55 AM
Designed By:		Engineer	Checker	
Filename:	C:\Documents and Settings\p0035165\Desktop\SCWO Misc CONCRETE\App C Duct Supports\pg8 foundation 1.msc			

DETAIL REPORT FOR W8x31 Supt - Node 10

PROJECT INFORMATION

Project Name:
 Project Number:
 Client:
 Project Location:
 Foundation Description: FOUNDATION

DESIGN CODE: ACI 318 - 2002 INPUT UNITS: English OUTPUT UNITS: English

CONCRETE PARAMETERS:

Compressive Strength (psi): 4000.00
 Unit Weight (pcf): 150.00

REINFORCING STEEL PARAMETERS:

Yield Strength (ksi): 60.00
 Unit Weight (pcf): 490.00
 Modulus of Elasticity (ksi): 29000.00

SOIL PARAMETERS:

Allowable Net Bearing Capacity (psf): 6000.00
 Unit Weight (pcf): 120.00

MINIMUM FOUNDATION CRITERIA:

Depth of Footing Below Grade (ft): 3
 Minimum Soil Cover (ft): 1.00
 Grade Elevation (ft): 0.00

REBAR PARAMETERS:

Max Long Bar Size: 6
 Min Long Bar Size: 6
 Max Tie Bar Size: 4
 Min Tie Bar Size: 3
 Max Ftg Bar Size: 9
 Min Ftg Bar Size: 5
 Temp & Shrinkage Steel Ratio: 0.0018

BUOYANCY CRITERIA:

Consider Buoyancy: No
 Consider soil for buoyancy: No
 Water table below grade (ft): 0



Calculation Sheet

Project: BGCAPP
 Job Number: 743341
 Calc. No. 24915-10-DBC-00-00004
 Sheet No. C-8 of C-22
 Sheet Rev: D

Subject: Gas Bottle Canopy, Supports, Misc. Fdn's.
 By: R. Murphy
 Date: 1/22/08

Dimensional Solutions FOUNDATION3D	Version 4.0.0	Date 2/19/2008
Foundation Name W8x31 Supt - Node 10		Time 8:26:55 AM
Designed By:	Engineer	Checker
Filename: C:\Documents and Settings\p0035165\Desktop\SCWO Misc CONCRETE\App C Duct Supports\pg8 foundation 1.msc		

DETAIL REPORT FOR W8x31 Supt - Node 10

APPLIED LOADS

P1

Load Case	Axial (kips)	Shear E-W (kips)	Mom N-S (kip ft)	Shear N-S (kips)	Mom E-W (kip ft)
1 - Dead	1.95	0.01	0.10	-0.02	-0.53
2 - Live	1.17	0.01	0.08	-0.02	-0.45
3 - Wind NS	-0.07	-0.01	-0.18	-1.21	21.94
4 - Wind EW	0.01	-0.93	-4.41	-0.18	4.07

UNFACTORED (ALLOWABLE) LOAD COMBINATIONS

P1

Load Comb	Axial (kips)	Shear E-W (kips)	Mom N-S (kip ft)	Shear N-S (kips)	Mom E-W (kip ft)
1 - Dead	1.95	0.01	0.10	-0.02	-0.53
2 - Dead + Live	3.12	0.02	0.18	-0.04	-0.98
3 - Dead + Wind NS	1.89	0.00	-0.08	-1.23	21.42
4 - Dead + Wind EW	1.96	-0.91	-4.32	-0.20	3.55
5 - 0.6Dead + Wind NS	1.11	0.00	-0.12	-1.22	21.63
6 - 0.6Dead + Wind EW	1.18	-0.92	-4.36	-0.19	3.76

FACTORED (ULTIMATE) LOAD COMBINATIONS

P1

Load Comb	Axial (kips)	Shear E-W (kips)	Mom N-S (kip ft)	Shear N-S (kips)	Mom E-W (kip ft)
1 - 1.4Dead	2.73	0.02	0.13	-0.03	-0.74
2 - 1.2Dead + 1.6Live	4.21	0.03	0.25	-0.05	-1.35
3 - 1.2Dead + Live	3.51	0.03	0.20	-0.04	-1.08
4 - 1.2Dead + 0.5Live + 1.6Wind NS	2.82	0.01	-0.12	-1.96	34.25
5 - 1.2Dead + 0.5Live + 1.6Wind EW	2.94	-1.46	-6.91	-0.32	5.86
6 - 0.9Dead + 1.6Wind NS	1.65	0.00	-0.20	-1.95	34.63
7 - 0.9Dead + 1.6Wind EW	1.77	-1.47	-6.98	-0.31	6.04



Calculation Sheet

Project: BGCAPP
 Job Number: 743341
 Calc. No. 24915-10-DBC-00-00004
 Sheet No. C-9 of C-22
 Sheet Rev: D

Subject: Gas Bottle Canopy, Supports, Misc. Fdn's.
 By: R. Murphy
 Date: 1/22/08

Dimensional Solutions FOUNDATION3D	Version 4.0.0	Date 2/19/2008
Foundation Name W8x31 Supt - Node 10	Engineer	Time 8:26:55 AM
Designed By:	C:\Documents and Settings\p0035165\Desktop\SCWO Misc CONCRETE\App C Duct Supports\	Checker
Filename: pg8 foundation 1.msc		

DETAIL REPORT FOR W8x31 Supt - Node 10

BEARING CAPACITY - LINEAR SOIL PRESSURE METHOD

Load Comb	Max Pressure (ksf)	All Pressure (ksf)	Ecc N/S Dir (ft)	Ecc E/W Dir (ft)	Moment N/S axis (kip-ft)	Moment E/W axis (kip-ft)	Rem
1 - Dead	0.55	6.36	0.05	0.01	0.14	0.59	
2 - Dead + Live	0.63	6.36	0.08	0.02	0.26	1.10	
3 - Dead + Wind NS	1.47	8.36	1.34	0.00	0.07	17.12	
4 - Dead + Wind EW	1.01	8.36	0.22	0.58	7.52	2.84	
5 - 0.6Dead + Wind NS	4.42	8.36	2.27	0.02	0.13	17.36	
6 - 0.6Dead + Wind EW	0.86	8.36	0.40	0.98	7.57	3.08	

STABILITY RATIO / SLIDING SAFETY FACTOR

Load Comb	S.R. N/S Dir	S.R. E/W Dir	All S.R.	Sliding FS - N/S	Sliding FS - E/W	All FS	Remarks
1 - Dead	54.13	100.00	1.50	100.00	100.00	1.50	
2 - Dead + Live	31.80	100.00	1.50	100.00	100.00	1.50	
3 - Dead + Wind NS	1.70	100.00	1.50	15.00	100.00	1.50	
4 - Dead + Wind EW	9.28	4.28	1.50	91.75	20.18	1.50	
5 - 0.6Dead + Wind NS	1.59	100.00	1.50	12.98	100.00	1.50	
6 - 0.6Dead + Wind EW	8.23	3.99	1.50	82.04	17.26	1.50	



Calculation Sheet

Project: BGCAPP
 Job Number: 743341
 Calc. No. 24915-10-DBC-00-00004
 Sheet No. C-10 of C-22
 Sheet Rev: D

Subject: Gas Bottle Canopy, Supports, Misc. Fdn's.
 By: R. Murphy
 Date: 1/22/08

Dimensional Solutions FOUNDATION3D	Version 4.0.0	Date 2/19/2008
Foundation Name W8x31 Supt - Node 10		Time 8:26:55 AM
Designed By:	Engineer	Checker
Filename: C:\Documents and Settings\p0035165\Desktop\SCWO Misc CONCRETE\App C Duct Supports\pg8 foundation 1.msc		

DETAIL REPORT FOR W8x31 Supt - Node 10

FOOTING DESIGN INFORMATION

E-W Dim (ft) 5.00
 N-S Dim (ft) 5.00
 Thickness (ft) 2.00

Top Steel

Governing Combination	No of Bars	Bar Size	Bar Spac (in)	Area Prov (sq in/ft)	Area Req (sq in/ft)	Moment (kip ft/ft)	Direction
7. 0.9Dead + 1.6Wind EW	4	6	18	0.35	0.01	-0.38	E-W
4. 1.2Dead + 0.5Live + 1.6Wind NS	4	6	18	0.35	0.01	-0.54	N-S

Bottom Steel

Governing Combination	No of Bars	Bar Size	Bar Spac (in)	Area Prov (sq in/ft)	Area Req (sq in/ft)	Moment (kip ft/ft)	Direction
5. 1.2Dead + 0.5Live + 1.6Wind EW	7	6	9	0.62	0.52	0.7	E-W
6. 0.9Dead + 1.6Wind NS	7	6	9	0.62	0.52	2.86	N-S



Calculation Sheet

Project: BGCAPP
 Job Number: 743341
 Calc. No. 24915-10-DBC-00-00004
 Sheet No. C-11 of C-22
 Sheet Rev: D

Subject: Gas Bottle Canopy, Supports, Misc. Fdn's.
 By: R. Murphy
 Date: 1/22/08

Dimensional Solutions FOUNDATION3D	Version 4.0.0	Date 2/19/2008
Foundation Name W8x31 Supt - Node 10		Time 8:26:55 AM
Designed By:	Engineer	Checker
Filename: C:\Documents and Settings\p0035165\Desktop\SCWO Misc CONCRETE\App C Duct Supports\pg8 foundation 1.msc		

DETAIL REPORT FOR W8x31 Supt - Node 10

PUNCHING SHEAR

P1

Control Comb	Net Ult Load (kips)	Punch. Stress (psi)	All Stress (psi)	Rem
6. 0.9Dead + 1.6Wind NS	2.46	0.70	189.74	

MAXIMUM SHEAR - E-W DIRECTION

Load Comb	Left Dist (ft)	Max Shear (kips)	Shear Stress (psi)	All Stress (psi)	Rem
1 - 1.4Dead	5.00	0.00	0.00	94.87	
2 - 1.2Dead + 1.6Live	5.00	0.00	0.00	94.87	
3 - 1.2Dead + Live	5.00	0.00	0.00	94.87	
4 - 1.2Dead + 0.5Live + 1.6Wind NS	5.00	0.00	0.00	94.87	
5 - 1.2Dead + 0.5Live + 1.6Wind EW	5.00	0.00	0.00	94.87	
6 - 0.9Dead + 1.6Wind NS	5.00	0.00	0.00	94.87	
7 - 0.9Dead + 1.6Wind EW	5.00	0.00	0.00	94.87	

MAXIMUM SHEAR - N-S DIRECTION

Load Comb	Bottom Dist (ft)	Max Shear (kips)	Shear Stress (psi)	All Stress (psi)	Rem
1 - 1.4Dead	5.00	0.00	0.00	94.87	
2 - 1.2Dead + 1.6Live	5.00	0.00	0.00	94.87	
3 - 1.2Dead + Live	5.00	0.00	0.00	94.87	
4 - 1.2Dead + 0.5Live + 1.6Wind NS	5.00	1.13	0.94	94.87	
5 - 1.2Dead + 0.5Live + 1.6Wind EW	5.00	0.00	0.00	94.87	
6 - 0.9Dead + 1.6Wind NS	5.00	8.22	6.85	94.87	
7 - 0.9Dead + 1.6Wind EW	5.00	0.00	0.00	94.87	



Calculation Sheet

Project: BGCAPP
 Job Number: 743341
 Calc. No. 24915-10-DBC-00-00004
 Sheet No. C-12 of C-22
 Sheet Rev: D

Subject: Gas Bottle Canopy, Supports, Misc. Fdn's.
 By: R. Murphy
 Date: 1/22/08

Dimensional Solutions FOUNDATION3D	Version 4.0.0	Date 2/19/2008
Foundation Name W8x31 Supt - Node 10	Engineer	Time 8:28:55 AM
Designed By:	C:\Documents and Settings\p0035165\Desktop\SCWO Misc CONCRETE\App C Duct Supports\	Checker
Filename: pg8 foundation 1.msc		

DETAIL REPORT FOR W8x31 Supt - Node 10 PIER/BASE PLATE DESIGN INFORMATION

	P1
E-W Dim (ft)	2.00
N-S Dim (ft)	2.00
Height (ft)	1.50
E-W Offset (ft)	0.00
N-S Offset (ft)	0.00
Requested Reinf. Ratio	0.0018
Provided Reinf. Ratio	0.0061
Long Bar Size	6
Bars in E-W Dir	3
Bars in N-S Dir	3
Total Long Bars	8
Tie Bar Size	3
Total No. of Ties	4
Major Tie Spacing (in)	10

PIER ULTIMATE LOAD CAPACITIES

Load Comb	P1							Rem
	Axial Load (kips)	Axial Capa. (kips)	Mom N-S (kip ft)	Mom N-S Capa (kip ft)	Mom E-W (kip ft)	Mom E-W Capa (kip ft)		
1 - 1.4Dead	3.99	1055.63	0.44	113.67	0.78	207.70		
2 - 1.2Dead + 1.6Live	5.29	980.35	0.58	106.17	1.43	258.51		
3 - 1.2Dead + Live	4.59	987.44	0.51	109.89	1.14	244.43		
4 - 1.2Dead + 0.5Live + 1.6Wind NS	3.90	19.78	0.43	2.18	31.30	158.62		
5 - 1.2Dead + 0.5Live + 1.6Wind EW	4.02	81.99	9.10	184.73	5.17	105.17		
6 - 0.9Dead + 1.6Wind NS	2.46	11.87	0.27	1.29	31.71	152.71		
7 - 0.9Dead + 1.6Wind EW	2.58	45.43	9.18	161.59	5.58	98.17		



Calculation Sheet

Project: BGCAPP
 Job Number: 743341
 Calc. No. 24915-10-DBC-00-00004
 Sheet No. C-13 of C-22
 Sheet Rev: D

Subject: Gas Bottle Canopy, Supports, Misc. Fdn's.
 By: R. Murphy
 Date: 1/22/08

Dimensional Solutions FOUNDATION3D	Version 4.0.0	Date 2/19/2008
Foundation Name W14x43 Supt - Node 1	Time 8:23:22 AM	
Designed By:	Engineer	Checker
Filename: C:\Documents and Settings\p0035165\Desktop\SCWO Misc CONCRETE\App C Duct Supports\pg8 foundation 2.msc		

SUMMARY REPORT FOR W14x43 Supt - Node 1

PROJECT INFORMATION

Project Name:
 Project Number:
 Client:
 Project Location
 Foundation Description FOUNDATION

DESIGN CODE ACI 318 - 2002 INPUT UNITS English OUTPUT UNITS English

CONCRETE PARAMETERS:

Compressive Strength (psi) 4000.00
 Unit Weight (pcf) 150.00

REINFORCING STEEL PARAMETERS:

Yield Strength (ksi) 60.00
 Unit Weight (pcf) 490.00
 Modulus of Elasticity (ksi) 29000.00

SOIL PARAMETERS:

Allowable Net Bearing Capacity (psf) 6000.00
 Unit Weight (pcf) 120.00

MINIMUM FOUNDATION CRITERIA:

Depth of Footing Below Grade (ft) 3
 Minimum Soil Cover (ft) 1.00
 Grade Elevation (ft) 0.00

REBAR PARAMETERS:

Max Long Bar Size 6
 Min Long Bar Size 6
 Max Tie Bar Size 4
 Min Tie Bar Size 3
 Max Flg Bar Size 9
 Min Flg Bar Size 5
 Temp & Shrinkage Steel Ratio 0.0018

BUOYANCY CRITERIA:

Consider Buoyancy: No
 Consider soil for buoyancy: No
 Water table below grade (ft) 0



Calculation Sheet

Project: BGCAPP
 Job Number: 743341
 Calc. No. 24915-10-DBC-00-00004
 Sheet No. C-14 of C-22
 Sheet Rev: D

Subject: Gas Bottle Canopy, Supports, Misc. Fdn's.
 By: R. Murphy
 Date: 1/22/08

Dimensional Solutions FOUNDATION3D	Version 4.0.0	Date 2/19/2008
Foundation Name W14x43 Supt - Node 1		Time 8:23:22 AM
Designed By:	Engineer	Checker
Filename: C:\Documents and Settings\p0035165\Desktop\SCWO Misc CONCRETE\App C Duct Supports\pg8 foundation 2.msc		

SUMMARY REPORT FOR W14x43 Supt - Node 1

PIER/BASE PLATE DESIGN INFORMATION

	P1
E-W Dim (ft)	2.50
N-S Dim (ft)	2.50
Height (ft)	1.50
E-W Offset (ft)	0.00
N-S Offset (ft)	0.00
Requested Reinf. Ratio	0.0018
Provided Reinf. Ratio	0.0039
Long Bar Size	6
Bars in E-W Dir	3
Bars in N-S Dir	3
Total Long Bars	8
Tie Bar Size	3
Total No. of Ties	4
Major Tie Spacing (in)	10

FOOTING DESIGN INFORMATION

E-W Dim (ft)	6.00
N-S Dim (ft)	7.50
Thickness (ft)	2.00

MATERIAL QUANTITIES

Concrete Cubic Yards (CY)	3.68
Reinforcing Steel Pounds (LB)	297.9
Formwork Square Feet (SF)	69
Excavation Cubic Yards (CY)	20.19

Top Steel

Governing Combination	No of Bars	Bar Size	Bar Spac (in)	Area Prov (sq in/ft)	Area Req (sq in/ft)	Moment (kip ft/ft)	Direction
0.9Dead + 1.6Wind EW	5	6	18	0.29	0.01	-0.36	E-W
1.2Dead + 0.5Live + 1.6Wind NS	4	6	18	0.29	0.02	-1.51	N-S


Bottom Steel

Governing Combination	No of Bars	Bar Size	Bar Spac (in)	Area Prov (sq in/ft)	Area Req (sq in/ft)	Moment (kip ft/ft)	Direction
1.2Dead + 0.5Live + 1.6Wind EW	9	6	9	0.53	0.52	0.65	E-W
0.9Dead + 1.6Wind NS	8	6	9	0.59	0.52	6.51	N-S

Subject: Gas Bottle Canopy, Supports, Misc. Fdn's.
By: R. Murphy
Date: 1/22/08

Dimensional Solutions FOUNDATION3D	Version 4.0.0	Date 2/19/2008
Foundation Name W14x43 Supt - Node 1	Engineer	Time 8:23:22 AM
Designed By:	Engineer	Checker
Filename: C:\Documents and Settings\p0035165\Desktop\SCWO Misc CONCRETE\App C Duct Supports\pg8 foundation 2.msc		

SUMMARY REPORT FOR W14x43 Supt - Node 1

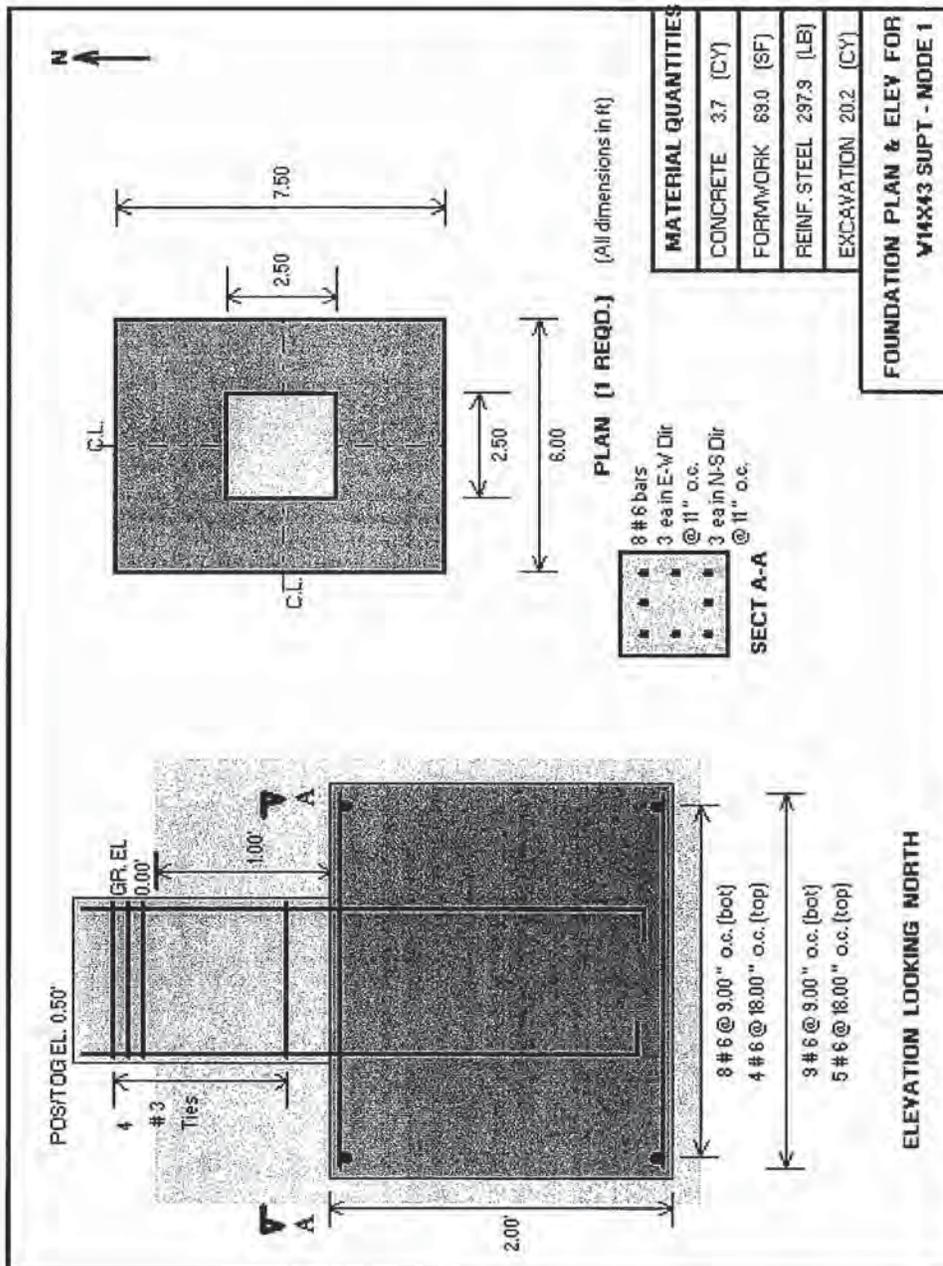



Calculation Sheet

Project: BGCAPP
 Job Number: 743341
 Calc. No. 24915-10-DBC-00-00004
 Sheet No. C-16 of C-22
 Sheet Rev: D

Subject: Gas Bottle Canopy, Supports, Misc. Fdn's.
 By: R. Murphy
 Date: 1/22/08

Dimensional Solutions FOUNDATION3D	Version	4.0.0	Date	2/19/2008
Foundation Name	W14x43 Supt - Node 1		Time	8:23:29 AM
Designed By:		Engineer	Checker	
Filename:	C:\Documents and Settings\p0035165\Desktop\SCWO Misc CONCRETE\App C Duct Supports\pg8 foundation 2.msc			

DETAIL REPORT FOR W14x43 Supt - Node 1

PROJECT INFORMATION

Project Name:
 Project Number:
 Client:
 Project Location
 Foundation Description FOUNDATION

DESIGN CODE ACI 318 - 2002 INPUT UNITS English OUTPUT UNITS English

CONCRETE PARAMETERS:

Compressive Strength (psi) 4000.00
 Unit Weight (pcf) 150.00

REINFORCING STEEL PARAMETERS:

Yield Strength (ksi) 60.00
 Unit Weight (pcf) 490.00
 Modulus of Elasticity (ksi) 29000.00

SOIL PARAMETERS:

Allowable Net Bearing Capacity (psf) 6000.00
 Unit Weight (pcf) 120.00

MINIMUM FOUNDATION CRITERIA:

Depth of Footing Below Grade (ft) 3
 Minimum Soil Cover (ft) 1.00
 Grade Elevation (ft) 0.00

REBAR PARAMETERS:

Max Long Bar Size 6
 Min Long Bar Size 6
 Max Tie Bar Size 4
 Min Tie Bar Size 3
 Max Ftg Bar Size 8
 Min Ftg Bar Size 5
 Temp & Shrinkage Steel Ratio 0.0018

BUOYANCY CRITERIA:

Consider Buoyancy: No
 Consider soil for buoyancy: No
 Water table below grade (ft) 0



Calculation Sheet

Project: BGCAPP
 Job Number: 743341
 Calc. No. 24915-10-DBC-00-00004
 Sheet No. C-17 of C-22
 Sheet Rev: D

Subject: Gas Bottle Canopy, Supports, Misc. Fdn's.
 By: R. Murphy
 Date: 1/22/08

Dimensional Solutions FOUNDATION3D	Version 4.0.0	Date 2/19/2008
Foundation Name W14x43 Supt - Node 1	Engineer	Time 8:23:29 AM
Designed By:	C:\Documents and Settings\p0035165\Desktop\SCWO Misc CONCRETE\App C Duct Supports\	Checker
Filename: pg8 foundation 2.msc		

DETAIL REPORT FOR W14x43 Supt - Node 1

APPLIED LOADS

P1

Load Case	Axial (kips)	Shear E-W (kips)	Mom N-S (kip ft)	Shear N-S (kips)	Mom E-W (kip ft)
1 - Dead	2.31	-0.04	-0.21	0.00	-0.02
2 - Live	1.15	-0.03	-0.18	0.00	-0.02
3 - Wind NS	-0.01	-0.10	-2.19	-2.69	53.47
4 - Wind EW	-0.03	-1.02	-7.11	-0.02	0.33

UNFACTORED (ALLOWABLE) LOAD COMBINATIONS

P1

Load Comb	Axial (kips)	Shear E-W (kips)	Mom N-S (kip ft)	Shear N-S (kips)	Mom E-W (kip ft)
1 - Dead	2.31	-0.04	-0.21	0.00	-0.02
2 - Dead + Live	3.47	-0.07	-0.38	0.00	-0.04
3 - Dead + Wind NS	2.31	-0.14	-2.40	-2.69	53.45
4 - Dead + Wind EW	2.28	-1.06	-7.32	-0.01	0.30
5 - 0.6Dead + Wind NS	1.38	-0.13	-2.31	-2.69	53.46
6 - 0.6Dead + Wind EW	1.35	-1.04	-7.24	-0.01	0.31

FACTORED (ULTIMATE) LOAD COMBINATIONS

P1

Load Comb	Axial (kips)	Shear E-W (kips)	Mom N-S (kip ft)	Shear N-S (kips)	Mom E-W (kip ft)
1 - 1.4Dead	3.24	-0.05	-0.29	0.00	-0.03
2 - 1.2Dead + 1.6Live	4.62	-0.10	-0.53	0.00	-0.06
3 - 1.2Dead + Live	3.93	-0.08	-0.43	0.00	-0.05
4 - 1.2Dead + 0.5Live + 1.6Wind NS	3.34	-0.23	-3.84	-4.31	85.52
5 - 1.2Dead + 0.5Live + 1.6Wind EW	3.30	-1.69	-11.72	-0.02	0.48
6 - 0.9Dead + 1.6Wind NS	2.07	-0.20	-3.69	-4.31	85.54
7 - 0.9Dead + 1.6Wind EW	2.03	-1.66	-11.57	-0.02	0.50



Calculation Sheet

Project: BGCAPP
 Job Number: 743341
 Calc. No. 24915-10-DBC-00-00004
 Sheet No. C-18 of C-22
 Sheet Rev: D

Subject: Gas Bottle Canopy, Supports, Misc. Fdn's.
 By: R. Murphy
 Date: 1/22/08

Dimensional Solutions FOUNDATION3D	Version 4.0.0	Date 2/19/2008
Foundation Name W14x43 Supt - Node 1		Time 8:23:29 AM
Designed By:	Engineer	Checker
Filename: pg8 foundation 2.msc	C:\Documents and Settings\p0035165\Desktop\SCWO Misc CONCRETE\App C Duct Supports\	

DETAIL REPORT FOR W14x43 Supt - Node 1

BEARING CAPACITY - LINEAR SOIL PRESSURE METHOD

Load Comb	Max Pressure (ksf)	All Pressure (ksf)	Ecc N/S Dir (ft)	Ecc E/W Dir (ft)	Moment N/S axis (kip-ft)	Moment E/W axis (kip-ft)	Rem
1 - Dead	0.49	8.36	0.00	0.02	0.34	0.02	
2 - Dead + Live	0.53	8.36	0.00	0.03	0.63	0.04	
3 - Dead + Wind NS	1.49	8.36	2.01	0.13	2.89	44.03	
4 - Dead + Wind EW	0.73	8.36	0.01	0.50	11.02	0.25	
5 - 0.6Dead + Wind NS	4.12	8.36	3.36	0.21	2.76	44.04	
6 - 0.6Dead + Wind EW	0.54	8.36	0.02	0.83	10.88	0.26	

STABILITY RATIO / SLIDING SAFETY FACTOR

Load Comb	S.R. N/S Dir	S.R. E/W Dir	All S.R.	Sliding FS - N/S	Sliding FS - E/W	All FS	Remarks
1 - Dead	100.00	100.00	1.50	100.00	100.00	1.50	
2 - Dead + Live	100.00	100.00	1.50	100.00	100.00	1.50	
3 - Dead + Wind NS	1.71	22.66	1.50	9.41	100.00	1.50	
4 - Dead + Wind EW	100.00	5.95	1.50	100.00	27.39	1.50	
5 - 0.6Dead + Wind NS	1.64	22.77	1.50	7.79	100.00	1.50	
6 - 0.6Dead + Wind EW	100.00	5.77	1.50	100.00	23.58	1.50	



Calculation Sheet

Project: BGCAPP
 Job Number: 743341
 Calc. No. 24915-10-DBC-00-00004
 Sheet No. C-19 of C-22
 Sheet Rev: D

Subject: Gas Bottle Canopy, Supports, Misc. Fdn's.
 By: R. Murphy
 Date: 1/22/08

Dimensional Solutions FOUNDATION3D	Version 4.0.0	Date 2/19/2008
Foundation Name W14x43 Supt - Node 1	Engineer	Time 8:23:29 AM
Designed By:	C:\Documents and Settings\p0035165\Desktop\SCWO Misc CONCRETE\App C Duct Supports\	Checker
Filename: pg8 foundation 2.msc		

DETAIL REPORT FOR W14x43 Supt - Node 1 FOOTING DESIGN INFORMATION

E-W Dim (ft) 6.00
 N-S Dim (ft) 7.50
 Thickness (ft) 2.00

Top Steel

Governing Combination	No of Bars	Bar Size	Bar Spac (in)	Area Prov (sq in/ft)	Area Req (sq in/ft)	Moment (kip ft/ft)	Direction
0.9Dead + 1.6Wind EW	5	6	18	0.29	0.01	-0.36	E-W
1.2Dead + 0.5Live + 1.6Wind NS	4	6	18	0.29	0.02	-1.51	N-S

Bottom Steel

Governing Combination	No of Bars	Bar Size	Bar Spac (in)	Area Prov (sq in/ft)	Area Req (sq in/ft)	Moment (kip ft/ft)	Direction
1.2Dead + 0.5Live + 1.6Wind EW	9	6	9	0.53	0.52	0.65	E-W
0.9Dead + 1.6Wind NS	8	6	9	0.59	0.52	6.51	N-S



Calculation Sheet

Project: BGCAPP
 Job Number: 743341
 Calc. No. 24915-10-DBC-00-00004
 Sheet No. C-20 of C-22
 Sheet Rev: D

Subject: Gas Bottle Canopy, Supports, Misc. Fdn's.
 By: R. Murphy
 Date: 1/22/08

Dimensional Solutions FOUNDATION3D	Version 4.0.0	Date 2/19/2008
Foundation Name W14x43 Supt - Node 1		Time 8:23:29 AM
Designed By:	Engineer	Checker
Filename: C:\Documents and Settings\p0035185\Desktop\SCWO Misc CONCRETE\App C Duct Supports\pg8 foundation 2.msc		

DETAIL REPORT FOR W14x43 Supt - Node 1

PUNCHING SHEAR

P1

Control Comb	Net Ult Load (kips)	Punch. Stress (psi)	All Stress (psi)	Rem
0.9Dead + 1.6Wind NS	3.34	0.83	189.74	

MAXIMUM SHEAR - E-W DIRECTION

Load Comb	Left Dist (ft)	Max Shear (kips)	Shear Stress (psi)	All Stress (psi)	Rem
1 - 1.4Dead	0.08	0.08	0.04	94.87	
2 - 1.2Dead + 1.6Live	0.08	0.10	0.05	94.87	
3 - 1.2Dead + Live	0.08	0.09	0.05	94.87	
4 - 1.2Dead + 0.5Live + 1.6Wind NS	0.08	0.13	0.07	94.87	
5 - 1.2Dead + 0.5Live + 1.6Wind EW	0.08	0.31	0.17	94.87	
6 - 0.9Dead + 1.6Wind NS	0.08	0.11	0.06	94.87	
7 - 0.9Dead + 1.6Wind EW	0.08	0.28	0.16	94.87	

MAXIMUM SHEAR - N-S DIRECTION

Load Comb	Bottom Dist (ft)	Max Shear (kips)	Shear Stress (psi)	All Stress (psi)	Rem
1 - 1.4Dead	0.83	0.58	0.40	94.87	
2 - 1.2Dead + 1.6Live	0.83	0.70	0.49	94.87	
3 - 1.2Dead + Live	6.67	-0.62	0.43	94.87	
4 - 1.2Dead + 0.5Live + 1.6Wind NS	6.67	-9.21	6.40	94.87	
5 - 1.2Dead + 0.5Live + 1.6Wind EW	6.67	-0.59	0.41	94.87	
6 - 0.9Dead + 1.6Wind NS	6.67	-17.86	12.40	94.87	
7 - 0.9Dead + 1.6Wind EW	6.67	-0.40	0.28	94.87	



Calculation Sheet

Project: BGCAPP
 Job Number: 743341
 Calc. No. 24915-10-DBC-00-00004
 Sheet No. C-21 of C-22
 Sheet Rev: D

Subject: Gas Bottle Canopy, Supports, Misc. Fdn's.
 By: R. Murphy
 Date: 1/22/08

Dimensional Solutions FOUNDATION3D	Version 4.0.0	Date 2/19/2008
Foundation Name W14x43 Supt - Node 1		Time 8:23:29 AM
Designed By:	Engineer	Checker
Filename: C:\Documents and Settings\p0035165\Desktop\SCWO Misc CONCRETE\App C Duct Supports\pg8 foundation 2.msc		

DETAIL REPORT FOR W14x43 Supt - Node 1

PIER/BASE PLATE DESIGN INFORMATION

	P1
E-W Dim (ft)	2.50
N-S Dim (ft)	2.50
Height (ft)	1.50
E-W Offset (ft)	0.00
N-S Offset (ft)	0.00
Requested Reinf. Ratio	0.0018
Provided Reinf. Ratio	0.0039
Long Bar Size	6
Bars in E-W Dir	3
Bars in N-S Dir	3
Total Long Bars	8
Tie Bar Size	3
Total No. of Ties	4
Major Tie Spacing (in)	10

PIER ULTIMATE LOAD CAPACITIES

Load Comb	P1						Rem
	Axial Load (kips)	Axial Capa. (kips)	Mom N-S (kip ft)	Mom N-S Capa (kip ft)	Mom E-W (kip ft)	Mom E-W Capa (kip ft)	
1 - 1.4Dead	5.21	1695.23	0.65	232.70	0.65	232.70	
2 - 1.2Dead + 1.6Live	6.31	1695.23	0.79	232.70	0.79	232.70	
3 - 1.2Dead + Live	5.62	1695.23	0.70	232.70	0.70	232.70	
4 - 1.2Dead + 0.5Live + 1.6Wind NS	5.03	12.88	4.18	10.72	79.06	202.52	
5 - 1.2Dead + 0.5Live + 1.6Wind EW	4.99	102.88	14.25	293.16	0.62	12.88	
6 - 0.9Dead + 1.6Wind NS	3.34	3.37	3.99	11.03	79.08	220.02	
7 - 0.9Dead + 1.6Wind EW	3.30	3.33	14.06	220.25	0.47	7.24	



A Joint Venture of Bechtel National, Inc. and Parsons Infrastructure & Technology Group, Inc.

Calculation Sheet

Project:	<u>BGCAPP</u>
Job Number:	<u>743341</u>
Calc. No.	<u>24915-10-DBC-00-00004</u>
Sheet No.	<u>C-22 / C-22</u>
Sheet Rev.	<u>D</u>

Subject: Gas Bottles Canopy, Supports, Equip, & Misc Foundations
 By: R. Murphy Date: 12/16/2007

C.5. Summary

The calculation performed in this appendix includes structural analysis and design of isolated footings for supports of elevated HVAC ducts along the exterior of the SCWO Processing Building (SPB). Wind loads govern the design. No soil uplift is observed under worst-case overturning wind loads, and wind sliding resistance of the foundations is adequate.

Foundation at node 10 is 2'-0" thick with 1'-0" of soil cover. It measures 5'-0" in the E-W direction and 5'-0" in the N-S direction. Reinforcement on top is 4#6 each way. Reinforcement on bottom is 6#6 each way.

Foundation at node 15 is 2'-0" thick with 1'-0" of soil cover. It measures 6'-0" in the E-W direction and 7'-6" in the N-S direction. Reinforcement on top is #6 @ 18" o.c. each way. Reinforcement on bottom is #6 @ 9" each way.



A Joint Venture of Bechtel Houston, Inc. and
Parsons Infrastructure & Technology Group, Inc.

Calculation Sheet

Project:	BGCAPP
Job Number:	743341
Calc. No.	24915-10-DBC-00-00004
Sheet No.	D1-1 / D1-60
Sheet Rev.	D

Subject: Gas Bottles Canopy, Supports, Equip, & Misc Foundations

By: R. Murphy Date: 12/16/2007

Appendix D1

Gas Bottle Canopy #1 Foundation

Project:	BGCAPP
Job Number:	743341
Calc. No.	24915-10-DBC-00-00004
Sheet No.	D1-2 / D1-60
Sheet Rev.	D

Subject: Gas Bottles Canopy, Supports, Equip, & Misc FoundationsBy: R. MurphyDate: 12/16/2007**D1.1. Objective**

The calculation performed in this appendix includes structural analysis and design of the combined footing for a gas bottle canopy on the exterior of the eastern wall of the SCWO Processing Building (SPB) between column lines A and D.

D1.2. Inputs

Refer to drawing 24915-10-DB-00-0003 for footing dimensions and reinforcement.

Refer to drawing 24915-10-SS-00-00052 for column base plate detail.

- (1) Footing loads are taken from SAP2000 base reactions.
- (2) Maximum soil bearing pressure is 3000 psf.
- (3) A test case is run in MathCad to show the process of checking the base plate and anchor bolts. All load cases are checked in Excel following the same procedure.

D1.3. Assumptions

It is assumed that wind loads and snow loads are applied evenly over the surface of the canopy. No uneven loading is considered, so the reactions applied to the foundation will be equal or equal and opposite for wind and snow load conditions.

D1.4. Calculation Body

Base reactions from SAP2000 steel analysis and design are given here. These loads are the input for the Mat3D footing design. The footing design check in Mat3D is included as well.

Base Plate and Anchor Bolt Design for HSS Section

This worksheet is used to illustrate the procedure to design the base plate and anchor bolts for a moment connected HSS column. Corresponding Excel spreadsheets are used to apply these calculations to a large data set. A test case is calculated using this worksheet to verify the accuracy of the excel spreadsheets. The test case is for the reactions at Joint 14 (see SAP model) resulting from the load combination UDSTL5. Since the moment about the two rotational axes (M1 and M2) are considered separately, only M1 is included in the test case. The test case values are highlighted in the excel spread sheet. To indicate to which spreadsheets the values in this calculation correlate, the following short hand notation is used:

BPJ14 = "BasePlate Joint 14"


JR = "Joint Reactions"

ATJ14 = "Anchor Tension Joint 14"


ASJ = "Anchor Shear Joint"

IC = "Interaction Check"

Subject: Gas Bottle Canopy & Misc Support Calculations
By: R. Murphy Date: 12/16/2007

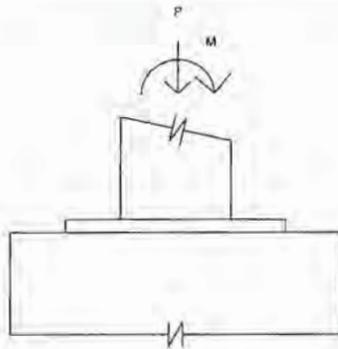

Elevation

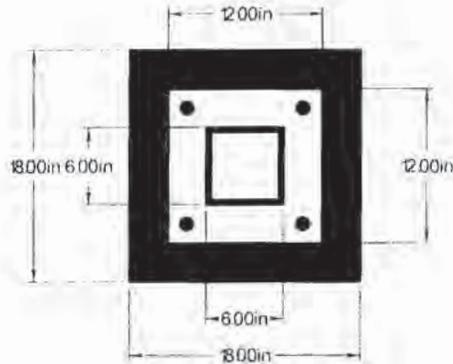

Plan

Force Properties

[JR Column G]	$P := 1.5820\text{kip}$	[JR Column E]	$V_1 := -0.711\text{kip}$
[JR Column H]	$M := 76.2240\text{kip}\cdot\text{in}$	[JR Column F]	$V_2 := 0.00273\text{kip}$
[BPJ14 Column E]	$e := \frac{M}{P} \quad e = 4\text{ft}$		


Geometric Properties (Base Plate)

Geometric Properties (Pedestal)

[BPJ14 Cell E6]	$t := .75\text{in}$	plate thickness	
	$N_{\text{plate}} := 12\text{in}$	baseplate edge length	$A_2 := 18\text{in}\cdot 18\text{in}$
[BPJ14 Cell D6]	$c_{\text{plate}} := 6\text{in}$	distance to plate's neutral axis	$A_2 = 2\text{ft}^2$
[BPJ14 Cell G6]	$d := 6\text{in}$	depth of column	$A := 12\text{in}\cdot 12\text{in}$
	$n := \frac{N_{\text{plate}}}{2} - \frac{0.95\cdot d}{2}$	distance from edge of plate to column face	
	$n = 0\text{ft}$		
	$A_1 := 12\text{in}\cdot 12\text{in}$	note : A1 can't be less than column width times column flange...include that in there	
[BPJ14 Cell A6]	$A_1 = 1\text{ft}^2$		
[BPJ14 Cell C6]	$I := \frac{1}{12}\cdot(12\text{in})^4$	$I = 0\text{ft}^4$	$Z_y := \frac{t^2\cdot 1\text{in}}{6} \quad Z_y = 0\text{gal}$


Subject: Gas Bottle Canopy & Misc Support Calculations
By: R. Murphy Date: 12/16/2007

Design Forces

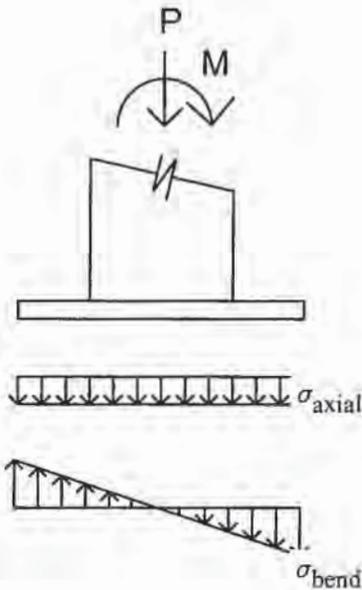


Stress Resultants

if $\sigma_{axial} = \sigma_{bending}$

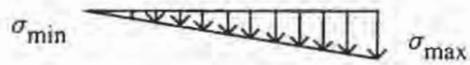

if $\sigma_{axial} > \sigma_{bending}$

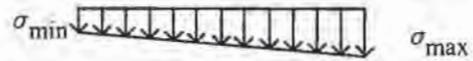

if $\sigma_{axial} < \sigma_{bending}$



Stress Calculations

[BPJ14 Column F] $\sigma_{axial} := \frac{P}{A}$ $\sigma_{axial} = 11 \text{ psi}$

[BPJ14 Column G] $\sigma_{bend} := |M| \cdot \frac{c_{plate}}{I}$ $\sigma_{bend} = 265 \text{ psi}$


Total Stress

[BPJ14 Column I] $\sigma_{max} := \sigma_{axial} + \sigma_{bend}$ $\sigma_{max} = 276 \text{ psi}$

[BPJ14 Column H] $\sigma_{min} := \sigma_{axial} - \sigma_{bend}$ $\sigma_{min} = -254 \text{ psi}$

Subject: Gas Bottle Canopy & Misc Support Calculations
By: R. Murphy Date: 12/16/2007

Calculating Force Resultants

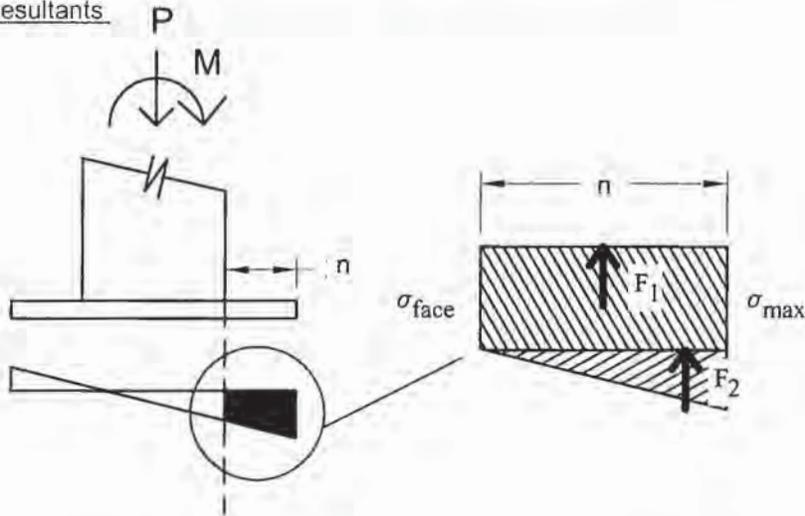

[BPJ14 Column K] $stress_slope := \frac{\sigma_{max} - \sigma_{face}}{N_{plate}}$ $stress_slope = 2452435 \frac{lb}{s^2 \cdot ft^2}$

[BPJ14 Column L] $\sigma_{face} := \sigma_{max} + stress_slope \cdot (9in - 12in)$ $\sigma_{face} = 143 \text{ psi}$

Rectangular Stress Block Resultants

[BPJ14 Column M] $F_{rect} := \sigma_{face} \cdot n \cdot 1in$ $F_{rect} = 451 \text{ lbf}$

[BPJ14 Column O] $M_{rect} := F_{rect} \cdot \frac{n}{2}$ $M_{rect} = 1906 \frac{ft^2 \cdot lb}{s^2}$

Triangular Stress Block Resultants

[BPJ14 Column N] $F_{tri} := \frac{(\sigma_{max} - \sigma_{face}) \cdot n \cdot 1in}{2}$ $F_{tri} = 208 \text{ lbf}$

[BPJ14 Column P] $M_{tri} := F_{tri} \cdot 2 \cdot \frac{n}{3}$ $M_{tri} = 1174 \frac{ft^2 \cdot lb}{s^2}$

Total Moment Per Unit Width

$M_{design} := M_{rect} + M_{tri}$

[BPJ14 Column Q] $M_{design} = 3080 \frac{ft^2 \cdot lb}{s^2}$

Subject: Gas Bottle Canopy & Misc Support Calculations
By: R. Murphy Date: 12/16/2007

Base Plate Design [LRFD-05 J9]

1. Concrete Bearing Stress [LRFD-05 J9]

[BPJ14 Cell L6] $f_c := 4 \text{ ksi}$

[BPJ14 Cell K6] $\phi_c := .6$

$$A_{\text{ratio}} := \text{if} \left[\left(\frac{A_2}{A_1} \right)^{\frac{1}{2}} < 2, \left(\frac{A_2}{A_1} \right)^{\frac{1}{2}}, 2 \right]$$

[BPJ14 Cell J6] $A_{\text{ratio}} = 2$

$F_p := \phi_c \cdot 0.85 \cdot f_c \cdot A_{\text{ratio}}$ [LRFD-05 EQ J9-2]

[BPJ14 Cell M6] $F_p = 3060 \text{ psi}$

$\text{pedestal_design} := \text{if}(\sigma_{\text{max}} < F_p, G_{\text{pedestal}}, NG_{\text{pedestal}})$

[BPJ14 Column T] $\text{pedestal_design} = \text{"Pedestal design is good"}$

2. Plate Thickness [LRFD-05 14]

$\phi_{\text{flex}} := .90$ $F_y := 36 \text{ ksi}$

[BPJ14 Column R] $t_p := \sqrt{4 \cdot \frac{M_{\text{design}} \cdot l}{\phi_{\text{flex}} \cdot F_y \cdot \text{in}}}$ $t_p = 0 \text{ ft}$ [LRFD-05 14-6]

Plate Bending Strength per unit width

$M_{\text{strength}} := \phi_{\text{flex}} \cdot F_y \cdot Z_y$ $M_{\text{strength}} = 3.037 \times 10^3 \cdot \text{in} \cdot \text{lbf}$

Design Check


$\text{base_plate_design} := \text{if}(t > t_p, G_d, NG)$

[BPJ14 Column S] $\text{base_plate_design} = \text{"Base Plate Design is Good"}$

Anchor Bolt Design

References:

- AISC Steel Design Guide: Base Plate and Anchor Rod Design
- ACI 318-05

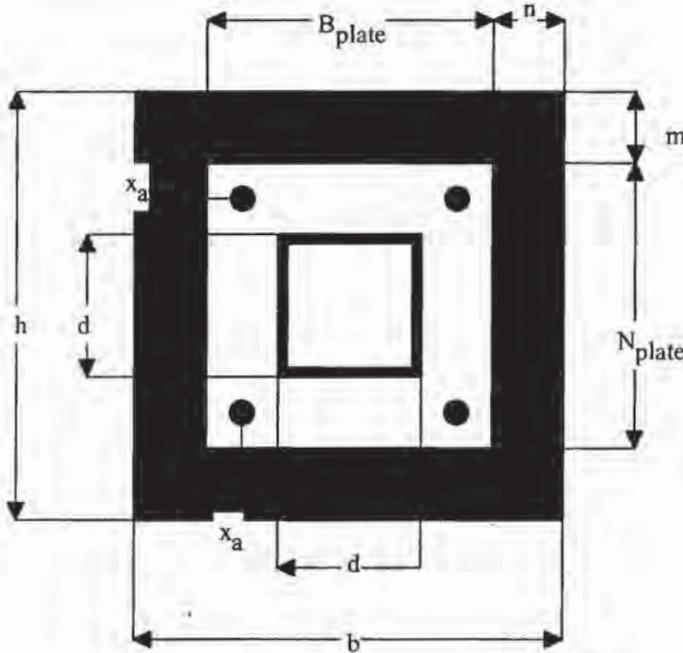


- [ATJ14 Cell A4] $N_{plate} = 1 \text{ ft}$
- [ATJ14 Cell C4] $x_a := 1.5 \text{ in}$
- $N' := N_{plate} - x_a$
- [ATJ14 Cell D4] $N' = 1 \text{ ft}$
- [ATJ14 Cell B4] $B := N_{plate}$
- [ATJ14 Cell E4] $A' := 4.5 \text{ in}$
- [BPJ14 Column H] $f_p := \sigma_{max}$
- [ATJ14 Column E] $e = 4 \text{ ft}$


Tension in Anchor Bolt due to Moment

[AISC Design Guide Appendix B]

if $e < e_{kern}$

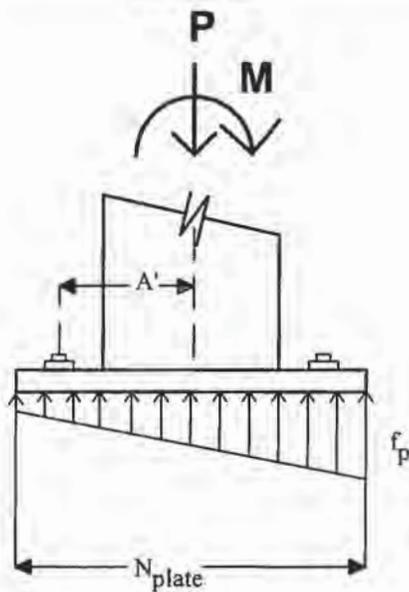

if $e > e_{kern}$

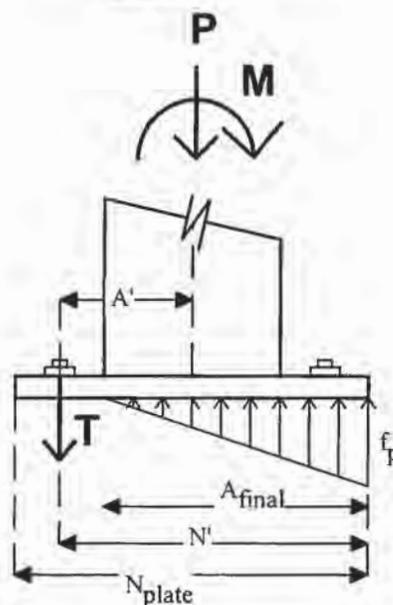

Determining effects of eccentricity [AISC B.3]

[ATJ14 Cell F4] $e_{kern} := \frac{N_{plate}}{6}$ $e_{kern} = 0 \text{ ft}$ [AISC B.3]

$anchor_tension := \text{if}(e > e_{kern}, BT, NBT)$

$anchor_tension = \text{"Anchor bolts in tension"}$

Determining Tension in Anchor Bolt [AISC B.4.2]

Determining Length of Stress Triangle

[ATJ14 Column H] $f := f_p \cdot N_{plate} \cdot \frac{N'}{2}$ $f = 17366 \text{ lbf}$

[ATJ14 Column I] $A_{plus} := \frac{f + \sqrt{f^2 - 4 \cdot \left(f_p \cdot \frac{B}{6} \right) \cdot (P \cdot A' + M)}}{f_p \cdot \frac{B}{3}}$ $A_{plus} = 2 \text{ ft}$

[ATJ14 Column J] $A_{minus} := \frac{f - \sqrt{f^2 - 4 \cdot \left(f_p \cdot \frac{B}{6} \right) \cdot (P \cdot A' + M)}}{f_p \cdot \frac{B}{3}}$ $A_{minus} = 0 \text{ ft}$


[ATJ14 Column K] $A_{final} := \begin{cases} \min(A_{plus}, A_{minus}) & \text{if } A_{plus} > 0 \wedge A_{minus} > 0 \\ A_{plus} & \text{if } A_{plus} > 0 \wedge A_{minus} < 0 \\ 0 & \text{if } A_{plus} < 0 \wedge A_{minus} < 0 \end{cases}$ $A_{final} = 0 \text{ ft}$

Determining Anchor Tension from Equilibrium

[ATJ14 Column L] $T_{anchors} := \frac{f_p \cdot A_{final} \cdot B}{2} - P$ $T_{anchors} = 8187 \text{ lbf}$

[ATJ14 Column M] $T_{one_anchor} := \frac{T_{anchors}}{2}$ $T_{one_anchor} = 4094 \text{ lbf}$

Pedestal and Foundation Cross Section

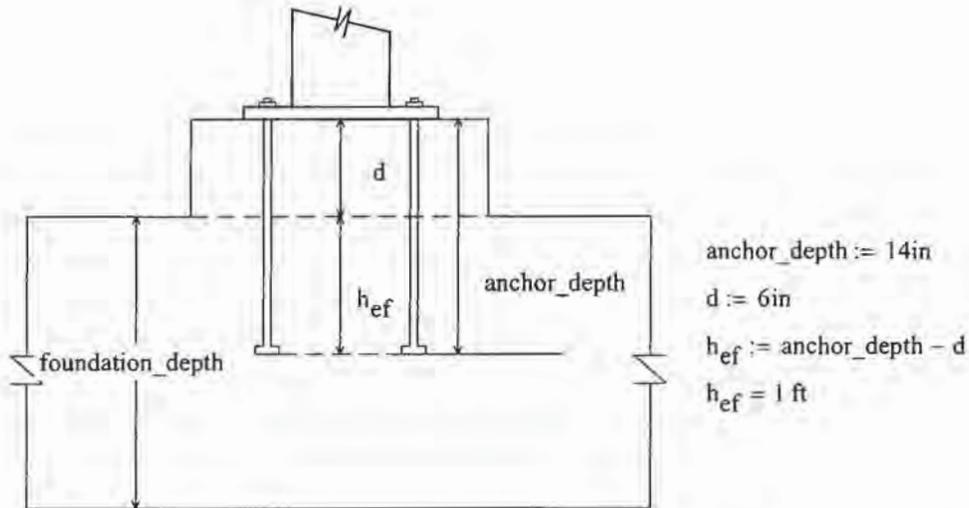

To simplify the calculation, the effective embedment depth of the anchor bolt is taken as the length of the bolt that extends beneath the column pedestal. This results in a conservative estimate of the strength of concrete breakout and pryout.

Steel Strength of anchor in tension [ACI 318.05 D.5.1]

$$f_{ya} := 36ksi \quad n_{anch} := 4$$

$$f_{uta} := \min(1.9 \cdot f_{ya}, 125ksi, 58ksi)$$

$$f_{uta} = 58000 \text{ psi}$$

$$d_o := 0.75in$$

$$n_t := \frac{10}{in} \quad \text{[LRFD-05 Table 7-18]}$$

$$A_{se} := \frac{\pi}{4} \cdot \left(d_o - \frac{0.9743}{n_t} \right)^2$$

$$A_{se} = 0 \text{ ft}^2 \quad \text{[LRFD-05 Table 7-18]}$$

$$N_{sa} := n_{anch} \cdot A_{se} \cdot f_{uta} \quad \text{[ACI 318.05 Eq D-3]}$$

[ATJ14 Cell L5]

$$N_{sa} = 77595 \text{ lbf}$$

one anchor

Subject: Gas Bottle Canopy & Misc Support Calculations
By: R. Murphy Date: 12/16/2007

Concrete breakout strength-Tension [ACI 318.05 D.5.2]

Concrete breakout strength based on a grouping of two anchors, since tension due to moment is the only tension present.

$$c_{a1} := 4.5\text{in} \quad s_1 := 9\text{in}$$

$$c_{a2} := 4.5\text{in} \quad s_2 := 9\text{in}$$

$$c_{a11} := 4.5\text{in} \quad f_c = 4000\text{psi}$$

$$c_{a22} := 4.5\text{in}$$

$$c_{amin} := \min(c_{a1}, c_{a11}, c_{a2}, c_{a22})$$

$$n_{anch_ten} := 2$$

Breakout Prism Properties

$$h'_{ef} := h_{ef}$$

$$A_{NCO} := 9 \cdot h'_{ef}{}^2$$

$$A_{NCO} = 4\text{ft}^2$$

$$A_{NC} := (1.5 \cdot h'_{ef} + s_1 + 1.5 \cdot h'_{ef}) \cdot (1.5 \cdot h'_{ef} + 1.5 \cdot h'_{ef})$$

$$A_{NC} = 5\text{ft}^2$$

$$A_{NC} := \min(A_{NC}, n_{anch_ten} \cdot A_{NCO})$$

$$A_{NC} = 5\text{ft}^2$$

$$\text{anchor_status} := \text{"cast in"}$$

$$k_c := \text{if}(\text{anchor_status} = \text{"cast in"}, 24, 17)$$

$$k_c = 24$$

$$N_b := \begin{cases} 16 \cdot \text{psi}^{.5} \cdot \text{in}^3 \cdot \sqrt{f_c} \cdot h'_{ef}{}^{.5} & \text{if } 11\text{in} \leq h'_{ef} \leq 25\text{in} \\ k_c \cdot \sqrt{f_c} \cdot h'_{ef}{}^{1.5} \cdot \text{psi}^{.5} \cdot \text{in}^{.5} & \text{otherwise} \end{cases}$$

[ACI 318-05 EQ D-7]

[ACI 318-05 EQ D-8]

$$N_b = 34346\text{ lbf}$$

Subject: Gas Bottle Canopy & Misc Support Calculations
By: R. Murphy Date: 12/16/2007

$e'_N := 4.5\text{in}$ Assumption that only one row of anchors on one side of the column center line carry tension load. Eccentricity is therefore distance from this row of anchors to the column center line

$$\psi_{ecN} := \min\left(\frac{1}{1 + \frac{2 \cdot e'_N}{3 \cdot h'_{ef}}}, 1.0\right) \quad [\text{ACI 318-05 EQ D-9}]$$

$$\psi_{ecN} = 1$$

$$\psi_{edN} := \begin{cases} 1 & \text{if } c_{amin} \geq 1.5 \cdot h'_{ef} \\ 0.7 + 0.3 \cdot \frac{c_{amin}}{1.5(h'_{ef})} & \text{if } c_{amin} < 1.5 \cdot h'_{ef} \end{cases} \quad \begin{matrix} [\text{ACI 318-05 EQ D-10}] \\ [\text{ACI 318-05 EQ D-11}] \end{matrix}$$

$$\psi_{edN} = 1$$

$$\psi_{cN} := \begin{cases} 1.25 & \text{if anchor_status} = \text{"cast in"} \\ 1.4 & \text{otherwise} \end{cases} \quad [\text{ACI 318-05 EQ D.5.2.6}]$$

$$\psi_{cN} = 1$$

$$\psi_{cpN} := 1 \quad [\text{ACI 318-05 D5.2.7}]$$

$$N_{cbg} := \frac{A_{NC}}{A_{NCO}} \cdot \psi_{ecN} \cdot \psi_{edN} \cdot \psi_{cN} \cdot \psi_{cpN} \cdot N_b \quad [\text{ACI 318-05 EQ D-5}]$$

[ATJ14 Cell M5] $N_{cbg} = 34883 \text{ lbf}$ Group of two anchors

Pullout Strength of Anchor in Tension [ACI 318-05 D.5.3]

$$A_{brg} := 0.654\text{in}^2 \quad \text{crack_status} := \text{"not cracked"} \quad \text{hook_status} := \text{"not hooked"}$$

$$N_p := 8 \cdot A_{brg} \cdot f_c \quad [\text{ACI 318-02 EQ D-15}]$$

$$\psi_{cP} := \text{if}[(\text{crack_status} = \text{"cracked"}), 1.4, 1.0] \quad [\text{ACI 318-05 D.5.3.6}]$$

$$N_{pn} := \psi_{cP} \cdot N_p \quad [\text{ACI 318-02 EQ D-14}]$$

[ATJ14 Cell N5] $N_{pn} = 20928 \text{ lbf}$ One Anchor

Subject: Gas Bottle Canopy & Misc Support Calculations
By: R. Murphy Date: 12/16/2007

Concrete side-face blowout strength-Tension [ACI 318.05 D.5.4]

$$c_{a1} = 0 \text{ ft}$$

$$N_{sb} := 160 \frac{\text{lbf}}{\text{in}} \cdot c_{a1} \cdot \sqrt{\frac{A_{brg}}{\text{in}^2}} \cdot \sqrt{\frac{f_c}{\text{psi}}} \quad [\text{ACI 318-05 EQ D-17}] \quad A_{brg} = 0 \text{ ft}^2$$

[ATJ14 Cell O5] $N_{sb} = 36826 \text{ lbf}$ one anchor

Tension Design Check

$N_{sa} = 77595 \text{ lbf}$ one anchor $N_{pn} = 20928 \text{ lbf}$ one anchor

$N_{cbg} = 34883 \text{ lbf}$ two anchors $N_{sb} = 36826 \text{ lbf}$ one anchor

$\phi_{\text{tension}} := 0.85$ Anchor governed by concrete breakout, side-face blowout, pullout, or pryout strength. Condition A is met [ACI 318-05 D.4.4]

$$N_{\text{design}} := \phi_{\text{tension}} \cdot \min\left(N_{sa}, \frac{N_{cbg}}{2}, N_{pn}, N_{sb}\right) \quad [\text{ACI 318-05 D.4.1.1}]$$

[ATJ14 Cell H4] $N_{\text{design}} = 14825 \text{ lbf}$

$$T_{\text{one_anchor}} = 4094 \text{ lbf}$$

tension_design := if($T_{\text{one_anchor}} \leq N_{\text{design}}$, "Good", "Not Good") [ACI 318-05 EQ D-1]

[ATJ14 Column M-Q] tension_design = "Good"

Subject: Gas Bottle Canopy & Misc Support Calculations
By: R. Murphy Date: 12/16/2007

Steel Strength of Anchor in Shear [ACI 318-05 D.6.1]

Anchor Types:

AT1 [ACI 318-05 D.6.1.a]

AT2 [ACI 318-05 D.6.1.b]

AT3 [ACI 318-05 D.6.1.c]

Anchor Type Used:

AT := "AT1"

Grout Pad Factor [ACI 318-05 D.6.1.3]:

grout_pad_used := "yes"

$$c_{\text{pad}} := \begin{cases} 0.8 & \text{if grout_pad_used} = \text{"yes"} \\ 1.0 & \text{otherwise} \end{cases}$$

$c_{\text{pad}} = 1$

Shear Strength:

$$V_{\text{sa}} := \begin{cases} c_{\text{pad}} \cdot n_{\text{anch}} \cdot A_{\text{se}} \cdot f_{\text{uta}} & \text{if AT} = \text{"AT1"} & \text{[ACI 318-05 EQ D-19]} \\ c_{\text{pad}} \cdot n_{\text{anch}} \cdot 0.6 \cdot A_{\text{se}} \cdot f_{\text{uta}} & \text{if AT} = \text{"AT2"} & \text{[ACI 318-05 EQ D-20]} \\ c_{\text{pad}} \cdot n_{\text{anch}} \cdot 0.6 \cdot A_{\text{se}} \cdot f_{\text{uta}} & \text{if AT} = \text{"AT3"} & \text{[ACI 318-05 EQ D-20]} \end{cases}$$

[ASJ Cell B7]

$V_{\text{sa}} = 62076 \text{ lbf}$ one anchor

Concrete Breakout Strength-Shear [ACI 318-05 D.6.2]

group_status := "group"

Projected Concrete Failure Area [ACI 318-05 D.6.2.1, RD.6.2.1]

$c_{a1} = 0$ ft Assuming that total shear is critical on one anchor row

$h_a := 6$ in Thickness of pedestal

$s_1 = 1$ ft Anchor Bolt Spacing

$$c := \begin{cases} 1.5 \cdot c_{a1} & \text{if } 1.5 \cdot c_{a1} < c_{a2} \\ c_{a2} & \text{otherwise} \end{cases} \quad c = 0 \text{ ft}$$

$$A_{vc} := \begin{cases} [2 \cdot (c) + s_1] \cdot h_a & \text{if } 1.5 \cdot c_{a1} > h_a \\ 2 \cdot [(c) + s_1] \cdot 1.5 \cdot c_{a1} & \text{otherwise} \end{cases} \quad \begin{matrix} \text{[ACI 318-05 Fig RD.6.2.1(b)]} \\ \text{Failure area for group of anchors} \end{matrix}$$

$$A_{vc} = 1 \text{ ft}^2$$

$$A_{vco} := 4.5 \cdot c_{a1}^2$$

$$A_{vco} = 1 \text{ ft}^2 \quad \text{[ACI 318-05 EQ D-23]}$$

$$A_{vc} := \min(A_{vc}, n_{anch} \cdot A_{vco})$$

$$A_{vc} = 1 \text{ ft}^2$$

Basic Concrete Breakout Strength [ACI 318-05 D.6.2.2]

$l_e := h_{ef}$ anchor load bearing length

$$V_b := 7 \cdot \left(\frac{l_e}{d_o} \right)^{0.2} \cdot \sqrt{d_o} \cdot \sqrt{f_c} \cdot c_{a1}^{1.5} \cdot \text{psi}^{-0.5} \quad \text{[ACI 318-05 EQ D.24]}$$

$$V_b = 5876 \text{ lbf}$$

$e'_v := 0 \text{ in}$ Assumption that shear is distributed equal to all anchors and no shear eccentricity results

$$\psi_{ecV} := \min \left(1, \frac{1}{1 + 2 \cdot \frac{e'_v}{3 \cdot c_{a1}}} \right)$$

$$\psi_{ecV} = 1$$

$$c_{a2} = 0 \text{ ft}$$

$$\psi_{edV} := \begin{cases} 1.0 & \text{if } c_{a2} \geq 1.5 \cdot c_{a1} & \text{[ACI 318-05 EQ D-27]} \\ 0.7 + 0.3 \cdot \frac{c_{a2}}{1.5 \cdot c_{a1}} & \text{if } c_{a2} < 1.5 \cdot c_{a1} & \text{[ACI 318-05 EQ D-28]} \end{cases}$$

$$\psi_{edV} = 1$$

crack_status = "not cracked"

$$\psi_{cV} := \begin{cases} 1.4 & \text{if crack_status = "not cracked"} \\ 1.0 & \text{if crack_status = "cracked no reinforce"} \\ 1.2 & \text{if crack_status = "cracked with reinforce"} \\ 1.4 & \text{if crack_status = "cracked with reinforce and stirrups"} \end{cases}$$

$$\psi_{cV} = 1$$

$$V_{cb} := \begin{cases} \frac{A_{vc}}{A_{vco}} \cdot \psi_{edV} \cdot \psi_{cV} \cdot V_b & \text{if group_status = "single anchor"} & \text{[ACI 318-05 EQ D-21]} \\ 0 & \text{otherwise} \end{cases}$$

$$V_{cbg} := \begin{cases} \frac{A_{vc}}{A_{vco}} \cdot \psi_{ecV} \cdot \psi_{edV} \cdot \psi_{cV} \cdot V_b & \text{if group_status = "group"} & \text{[ACI 318-05 EQ D-22]} \\ 0 & \text{otherwise} \end{cases}$$

$$V_{cb} = 0 \text{ lbf}$$

[ASJ Cell C7]

$$V_{cbg} = 8775 \text{ lbf}$$

group of 2 anchors

Subject: Gas Bottle Canopy & Misc Support Calculations
By: R. Murphy Date: 12/16/2007

Concrete prout strength of anchor in shear [ACI 318-05 D.6.3]

$$h_{ef} = 1 \text{ ft}$$

$$k_{cp} := \begin{cases} 1.0 & \text{if } h_{ef} < 2.5\text{in} \\ 2.0 & \text{if } h_{ef} \geq 2.5\text{in} \end{cases}$$

$$V_{cp} := \begin{cases} k_{cp} \cdot N_{cb} & \text{if group_status} = \text{"single anchor"} \\ 0 & \text{otherwise} \end{cases} \quad [\text{ACI 318-05 EQ D-29}]$$

$$V_{cpg} := \begin{cases} k_{cp} \cdot N_{cbg} & \text{if group_status} = \text{"group"} \\ 0 & \text{otherwise} \end{cases} \quad [\text{ACI 318-05 EQ D-30}]$$

[ASJ Cell D7] $V_{cpg} = 69765 \text{ lbf}$ group of 2 anchors

Shear Design Check

$V_{sa} = 62076 \text{ lbf}$ one anchor

$V_{cbg} = 8775 \text{ lbf}$ group of 2 anchors

$V_{cpg} = 69765 \text{ lbf}$ group of 2 anchors

[ASJ Cell B3] $\phi_{shear} := 0.85$ Anchor governed by concrete breakout, side-face blowout, pullout, or prout strength [ACI 318-05 D.4.4]

$$V_{design} := \phi_{shear} \cdot \min(V_{sa}, V_{cbg}, V_{cpg}) \quad [\text{ACI 318-05 D.4.1.1}]$$

$V_{design} = 7459 \text{ lbf}$

$$\text{design_shear} := \text{if}(V_1 \leq V_{design} \wedge V_2 \leq V_{design}, \text{"Design is OK"}, \text{"Design is insufficient"})$$

[ASJ Column E-J] $\text{design_shear} = \text{"Design is OK"}$ [ACI 318-05 EQ D-2]

Interaction of tensile and shear forces [ACI 318-05 D.7]

[[IC Column I] $\frac{V_1}{V_{design}} + \frac{T_{one_anchor}}{N_{design}} = 0$

$$ST_{check} := \text{if} \left(\frac{V_1}{V_{design}} + \frac{T_{one_anchor}}{N_{design}} \leq 1.2, \text{"Interaction OK"}, \text{"Interactoin Failure"} \right)$$

$$\text{interaction_check_V}_1 := \text{if} \left[(V_1 > 0.2 \cdot V_{design} \wedge T_{one_anchor} > N_{design}), ST_{check}, \text{"No check needed"} \right]$$

[[IC Column I] interaction_check_V1 = "No check needed"

[[IC Column J] $\frac{V_2}{V_{design}} + \frac{T_{one_anchor}}{N_{design}} = 0$

$$ST_{check} := \text{if} \left(\frac{V_2}{V_{design}} + \frac{T_{one_anchor}}{N_{design}} \leq 1.2, \text{"Interaction OK"}, \text{"Interactoin Failure"} \right)$$

$$\text{interaction_check_V}_2 := \text{if} \left[(V_2 > 0.2 \cdot V_{design} \wedge T_{one_anchor} > N_{design}), ST_{check}, \text{"No check needed"} \right]$$

[[IC Column J] interaction_check_V2 = "No check needed"



Calculation Sheet

Project: BGCAPP
 Job Number: 743341
 Calc No: 24915-10-DBC-00-00004
 Rev D
 Sheet No. D1-19 / D1-60

Gas Bottles Misc Support Calculations
 By R. Murphy Date: 12/16/2007

Joint Text	OutputCase Text	CaseType Text	StepType Text	F1 Kip	F2 Kip	F3 Kip	M1 Kip-in	M2 Kip-in	M3 Kip-in
14	UDSTL1	Combination		-1.774E-06	0.0002569	2.066	-1.811	-3.25E-05	-0.018
14	UDSTL2	Combination		-1.462E-06	0.0002166	3.259	-1.551	9.05E-05	-0.015
14	UDSTL3	Combination		0.001543	-0.664	1.582	62.471	0.179	0.034
14	UDSTL4	Combination		-0.001546	0.665	2.89	-65.575	-0.179	-0.064
14	UDSTL5	Combination		0.002073	-0.711	1.582	76.224	0.241	0.085
14	UDSTL6	Combination		-0.002076	0.712	2.89	-79.328	-0.241	-0.115
14	UDSTL7	Combination		-0.201	0.0001287	1.659	-1.539	-15.144	-0.01
14	UDSTL8	Combination		0.201	0.0003094	2.813	-1.565	15.144	-0.02
14	UDSTL9	Combination		-0.201	0.0001298	2.794	-1.539	-15.144	-0.01
14	UDSTL10	Combination		0.201	0.0003083	1.678	-1.565	15.144	-0.02
14	UDSTL11	Combination		0.001543	-0.664	0.674	62.859	0.179	0.037
14	UDSTL12	Combination		-0.001545	0.665	1.983	-65.187	-0.179	-0.06
14	UDSTL13	Combination		0.002073	-0.711	0.674	76.612	0.241	0.089
14	UDSTL14	Combination		-0.002075	0.711	1.983	-78.941	-0.241	-0.112
14	UDSTL15	Combination		-0.201	0.0000748	0.751	-1.151	-15.144	-0.006601
14	UDSTL16	Combination		0.201	0.0002555	1.906	-1.177	15.144	-0.016
14	UDSTL17	Combination		-0.201	7.591E-05	1.886	-1.151	-15.144	-0.006568
14	UDSTL18	Combination		0.201	0.0002544	0.77	-1.177	15.144	-0.016
14	UDSTL19	Combination		-0.157	0.001359	2.236	-1.68	-18.171	-0.001199
14	UDSTL20	Combination		0.157	-0.000921	2.236	-1.424	18.171	-0.029
14	UDSTL21	Combination		0.0004916	-0.159	2.236	16.916	0.057	0.00092
14	UDSTL22	Combination		-0.0004946	0.159	2.236	-20.02	-0.057	-0.031
14	UDSTL23	Combination		-0.157	0.001305	1.328	-1.292	-18.171	0.002593
14	UDSTL24	Combination		0.157	-0.000975	1.328	-1.036	18.171	-0.025
14	UDSTL25	Combination		0.0004919	-0.159	1.328	17.304	0.057	0.004712
14	UDSTL26	Combination		-0.0004942	0.159	1.328	-19.632	-0.057	-0.028
14	UDSTL27	Combination	Max	0.495	0.006384	2.236	-0.82	57.469	0.021
14	UDSTL27	Combination	Min	-0.495	-0.005946	2.236	-2.284	-57.469	-0.051
14	UDSTL28	Combination	Max	0.001568	0.494	2.24	58.491	0.182	0.448
14	UDSTL28	Combination	Min	-0.001571	-0.493	2.232	-61.595	-0.182	-0.479
14	UDSTL29	Combination	Max	0.495	0.00633	1.328	-0.432	57.469	0.024
14	UDSTL29	Combination	Min	-0.495	-0.006	1.328	-1.896	-57.469	-0.047
14	UDSTL30	Combination	Max	0.001569	0.494	1.333	58.879	0.182	0.452
14	UDSTL30	Combination	Min	-0.001571	-0.493	1.324	-61.207	-0.182	-0.475
15	UDSTL1	Combination		3.695E-06	-0.000178	1.807	-1.5	0.000286	-0.018
15	UDSTL2	Combination		5.745E-06	-0.000171	2.781	-1.286	0.000439	-0.015
15	UDSTL3	Combination		-0.001444	-0.608	1.392	58.98	-0.168	0.423
15	UDSTL4	Combination		0.001452	0.607	2.476	-59.552	0.168	-0.453
15	UDSTL5	Combination		-0.001944	-0.658	1.392	69.661	-0.226	0.534
15	UDSTL6	Combination		0.001952	0.657	2.476	-72.233	0.227	-0.565
15	UDSTL7	Combination		-0.201	-0.000504	1.743	-1.249	-15.081	-0.01
15	UDSTL8	Combination		0.201	0.0001865	2.125	-1.323	15.082	-0.02
15	UDSTL9	Combination		-0.201	-0.000509	2.125	-1.249	-15.081	-0.01
15	UDSTL10	Combination		0.201	0.0001918	1.743	-1.323	15.082	-0.02
15	UDSTL11	Combination		-0.001445	-0.608	0.62	57.302	-0.168	0.426
15	UDSTL12	Combination		0.00145	0.607	1.704	-59.231	0.168	-0.449
15	UDSTL13	Combination		-0.001946	-0.658	0.62	69.983	-0.226	0.538
15	UDSTL14	Combination		0.001951	0.657	1.704	-71.911	0.227	-0.561
15	UDSTL15	Combination		-0.201	-0.00046	0.971	-0.928	-15.082	-0.006458
15	UDSTL16	Combination		0.201	0.0002303	1.353	-1.001	15.082	-0.017
15	UDSTL17	Combination		-0.201	-0.000465	1.353	-0.928	-15.081	-0.006423
15	UDSTL18	Combination		0.201	0.0002356	0.971	-1.001	15.082	-0.017
15	UDSTL19	Combination		-0.157	-0.001184	1.934	-1.172	-18.171	-0.001352
15	UDSTL20	Combination		0.157	0.0008671	1.934	-1.4	18.171	-0.029
15	UDSTL21	Combination		-0.0004586	-0.147	1.934	15.717	-0.053	0.105
15	UDSTL22	Combination		0.0004665	0.146	1.934	-18.289	0.054	-0.135
15	UDSTL23	Combination		-0.157	-0.00114	1.162	-0.851	-18.171	0.002458
15	UDSTL24	Combination		0.157	0.000911	1.162	-1.078	18.171	-0.025
15	UDSTL25	Combination		-0.0004602	-0.147	1.162	16.039	-0.054	0.108
15	UDSTL26	Combination		0.0004649	0.146	1.162	-17.968	0.054	-0.131
15	UDSTL27	Combination	Max	0.496	0.005898	1.934	-0.573	57.47	0.021
15	UDSTL27	Combination	Min	-0.495	-0.006215	1.934	-1.999	-57.47	-0.051
15	UDSTL28	Combination	Max	0.00167	0.405	1.937	47.756	0.194	0.714
15	UDSTL28	Combination	Min	-0.001662	-0.406	1.931	-50.328	-0.193	-0.745
15	UDSTL29	Combination	Max	0.496	0.005942	1.162	-0.252	57.47	0.024

← Test Case (M1, not M2)



Calculation Sheet

Project: BGCAPP

Job Number: 743341

Calc No: 24915-10-DBC-00-00004

Rev. D

Sheet No. D1-20 / D1-80

Gas Bottles Misc Support Calculations
By R. Murphy Date: 12/16/2007

15	UDSTL29	Combination	Min	-0.495	-0.006171	1.162	-1.677	-57.47	-0.047
15	UDSTL30	Combination	Max	0.001668	0.405	1.165	48.077	0.194	0.718
15	UDSTL30	Combination	Min	-0.001663	-0.406	1.159	-50.006	-0.194	-0.741
16	UDSTL1	Combination		-2.416E-05	-0.001073	3.68	-1.657	-0.000768	-0.018
16	UDSTL2	Combination		-4.197E-05	-0.000926	6.083	-1.42	-0.001357	-0.015
16	UDSTL3	Combination		0.0007195	-0.739	2.782	66.475	0.085	0.17
16	UDSTL4	Combination		-0.0007742	0.737	5.357	-69.315	-0.087	-0.2
16	UDSTL5	Combination		0.0009646	-0.685	2.782	76.518	0.114	0.238
16	UDSTL6	Combination		-0.001019	0.683	5.357	-79.359	-0.115	-0.269
16	UDSTL7	Combination		-0.201	-0.000924	3.178	-1.423	-15.118	-0.011
16	UDSTL8	Combination		0.201	-0.00092	4.961	-1.418	15.116	-0.02
16	UDSTL9	Combination		-0.201	-0.00093	4.847	-1.422	-15.118	-0.01
16	UDSTL10	Combination		0.201	-0.000914	3.292	-1.418	15.117	-0.02
16	UDSTL11	Combination		0.0007314	-0.739	1.078	66.83	0.085	0.173
16	UDSTL12	Combination		-0.0007624	0.738	3.653	-68.96	-0.086	-0.196
16	UDSTL13	Combination		0.0009764	-0.685	1.078	76.873	0.114	0.242
16	UDSTL14	Combination		-0.001007	0.683	3.654	-79.004	-0.115	-0.265
16	UDSTL15	Combination		-0.201	-0.000692	1.474	-1.068	-15.118	-0.006699
16	UDSTL16	Combination		0.201	-0.000688	3.257	-1.063	15.117	-0.016
16	UDSTL17	Combination		-0.201	-0.000698	3.144	-1.068	-15.118	-0.006666
16	UDSTL18	Combination		0.201	-0.000682	1.588	-1.063	15.117	-0.016
16	UDSTL19	Combination		-0.157	-0.001567	4.07	-1.35	-18.199	-0.001292
16	UDSTL20	Combination		0.157	-0.000276	4.07	-1.491	18.197	-0.029
16	UDSTL21	Combination		0.0002067	-0.164	4.07	17.546	0.026	0.035
16	UDSTL22	Combination		-0.0002614	0.163	4.07	-20.387	-0.028	-0.066
16	UDSTL23	Combination		-0.157	-0.001335	2.366	-0.995	-18.199	0.002535
16	UDSTL24	Combination		0.157	-4.42E-05	2.366	-1.136	18.198	-0.026
16	UDSTL25	Combination		0.0002185	-0.164	2.366	17.901	0.027	0.039
16	UDSTL26	Combination		-0.0002496	0.163	2.366	-20.032	-0.028	-0.062
16	UDSTL27	Combination	Max	0.496	0.0006472	4.07	-1.243	57.555	0.021
16	UDSTL27	Combination	Min	-0.496	-0.002491	4.07	-1.598	-57.557	-0.052
16	UDSTL28	Combination	Max	0.0006711	0.454	4.075	56.478	0.08	0.536
16	UDSTL28	Combination	Min	-0.0007258	-0.456	4.065	-59.318	-0.082	-0.567
16	UDSTL29	Combination	Max	0.496	0.0008792	2.366	-0.888	57.555	0.025
16	UDSTL29	Combination	Min	-0.496	-0.002259	2.366	-1.243	-57.556	-0.048
16	UDSTL30	Combination	Max	0.0006829	0.454	2.371	56.833	0.081	0.54
16	UDSTL30	Combination	Min	-0.000714	-0.455	2.361	-58.963	-0.082	-0.563
17	UDSTL1	Combination		0.00002224	0.0009945	3.422	-1.632	0.001053	-0.018
17	UDSTL2	Combination		0.00003769	0.0008803	5.605	-1.4	0.001717	-0.015
17	UDSTL3	Combination		-0.0008187	-0.706	2.593	63.723	-0.096	0.339
17	UDSTL4	Combination		0.0008685	0.708	4.943	-66.521	0.099	-0.369
17	UDSTL5	Combination		-0.001093	-0.664	2.593	73.731	-0.13	0.438
17	UDSTL6	Combination		0.001143	0.666	4.943	-76.529	0.132	-0.469
17	UDSTL7	Combination		-0.201	0.001299	3.297	-1.446	-15.096	-0.01
17	UDSTL8	Combination		0.201	0.0004237	4.238	-1.352	15.098	-0.02
17	UDSTL9	Combination		-0.201	0.001309	4.22	-1.447	-15.095	-0.01
17	UDSTL10	Combination		0.201	0.0004135	3.316	-1.351	15.098	-0.02
17	UDSTL11	Combination		-0.0008293	-0.707	1.025	64.073	-0.097	0.342
17	UDSTL12	Combination		0.0008579	0.708	3.375	-66.171	0.098	-0.366
17	UDSTL13	Combination		-0.001104	-0.664	1.025	74.081	-0.13	0.442
17	UDSTL14	Combination		0.001132	0.665	3.375	-76.179	0.131	-0.465
17	UDSTL15	Combination		-0.201	0.001077	1.729	-1.096	-15.096	-0.006592
17	UDSTL16	Combination		0.201	0.0002019	2.67	-1.002	15.098	-0.017
17	UDSTL17	Combination		-0.201	0.001087	2.651	-1.097	-15.096	-0.006558
17	UDSTL18	Combination		0.201	0.0001917	1.748	-1.001	15.097	-0.017
17	UDSTL19	Combination		-0.157	0.001393	3.768	-1.455	-18.195	-0.001364
17	UDSTL20	Combination		0.157	0.0003295	3.768	-1.343	18.197	-0.029
17	UDSTL21	Combination		-0.0002396	-0.157	3.768	16.914	-0.03	0.082
17	UDSTL22	Combination		0.0002894	0.159	3.768	-19.712	0.032	-0.113
17	UDSTL23	Combination		-0.157	0.001171	2.2	-1.105	-18.195	0.002469
17	UDSTL24	Combination		0.157	0.0001077	2.2	-0.993	18.197	-0.026
17	UDSTL25	Combination		-0.0002502	-0.157	2.2	17.264	-0.03	0.086
17	UDSTL26	Combination		0.0002788	0.159	2.2	-19.362	0.032	-0.109
17	UDSTL27	Combination	Max	0.496	0.002161	3.768	-1.242	57.551	0.021
17	UDSTL27	Combination	Min	-0.496	-0.000439	3.768	-1.556	-57.548	-0.052
17	UDSTL28	Combination	Max	0.001039	0.426	3.772	52.395	0.121	0.659
17	UDSTL28	Combination	Min	-0.0009896	-0.424	3.764	-55.193	-0.118	-0.69
17	UDSTL29	Combination	Max	0.496	0.00194	2.2	-0.891	57.55	0.025



Calculation Sheet

Project: BGCAPP
Job Number: 743341
Calc No: 24915-10-DBC-00-00004
Rev. D
Sheet No. D1-21 / D1-60

Gas Bottles Misc Support Calculations
By R. Murphy Date: 12/16/2007

17	UDSTL29	Combination	Min	-0.496	-0.000661	2.2	-1.206	-57.549	-0.048
17	UDSTL30	Combination	Max	0.001029	0.425	2.203	52.745	0.12	0.663
17	UDSTL30	Combination	Min	-0.001	-0.424	2.196	-54.843	-0.119	-0.686



Gas Bottles Misc Support Calculations
By R. Murphy Date: 12/18/2007

Calculation Sheet

Project: BCCAPP
Job Number: 743341
Calc No: 24915-10-DBC-00-00004
Rev D
Sheet No. D1-22 / D1-60

Base Plate Design

HSS 6X6X3/8
12"x12" Plate

A (in/2)	l (in)	e (in)	h (in)	n(in)	d (in)	Fy (ksi)	A2 (in ²)	Aratio	Φc	Fc (ksi)	Fp (ksi)
144	1728	6	0.75	3.15	12	36	324	1.5	0.6	4	3.06

Joint	OutputCase	F3	M1	e	σ_axial	σ_bend	σ_max	σ_min	ratio	stress_slope	σ_fatc	F_rect	F_tri	M_rect	M_tri	M_design	Ip	d	check plate	d	check per bearing
Text	Text	Kip	Kip-in	in	ksi	ksi	ksi	ksi			ksi	Kip	Kip	Kip-in	Kip-in	Kip-in	in				
14	UDSTL1	2.0660	-1.8110	-0.8766	0.0143	0.0063	0.0208	0.0081	0.3905	0.0010	0.0173	0.0546	0.0052	0.0960	0.0109	0.0569	0.128776	0.105385	Design Good	Design Good	
14	UDSTL2	3.2590	-1.5510	-0.4759	0.0226	0.0054	0.0280	0.0172	0.6156	0.0009	0.0252	0.0793	0.0045	0.1250	0.0094	0.1343	0.128776	0.105385	Design Good	Design Good	
14	UDSTL3	1.5820	62.4710	39.4886	0.0110	0.2169	0.2279	-0.2059	-0.9036	0.0362	0.1140	0.3592	0.1794	0.5657	0.3767	0.6423	0.341093	0.565656	Design Good	Design Good	
14	UDSTL4	2.8600	-65.6750	-22.6603	0.0201	0.2277	0.2478	-0.2076	-0.8380	0.0379	0.1282	0.4039	0.1883	0.6361	0.3954	1.0315	0.374781	0.565656	Design Good	Design Good	
14	UDSTL5	1.5820	76.2240	46.1820	0.0110	0.2647	0.2757	-0.2537	-0.9203	0.0441	0.1367	0.4306	0.2168	0.6762	0.4396	1.1378	0.374781	0.565656	Design Good	Design Good	
14	UDSTL6	2.8600	-79.3280	-27.4491	0.0201	0.2754	0.2955	-0.2554	-0.8642	0.0459	0.1509	0.4754	0.2278	0.7487	0.4783	1.2270	0.395202	0.565656	Design Good	Design Good	
14	UDSTL7	1.6590	-1.5390	-0.9277	0.0115	0.0053	0.0169	0.0062	0.3663	0.0009	0.0141	0.0443	0.0044	0.0698	0.0093	0.0790	0.098776	0.10464	Design Good	Design Good	
14	UDSTL8	2.8130	-1.5650	-0.5503	0.0195	0.0064	0.0250	0.0141	0.5647	0.0009	0.0221	0.0697	0.0045	0.1097	0.0093	0.1192	0.120766	0.10464	Design Good	Design Good	
14	UDSTL9	2.7940	-1.5390	-0.5508	0.0194	0.0063	0.0247	0.0141	0.5681	0.0009	0.0219	0.0697	0.0045	0.1089	0.0093	0.1181	0.120766	0.10464	Design Good	Design Good	
14	UDSTL10	1.6780	-1.5650	-0.9327	0.0117	0.0054	0.0171	0.0062	0.3640	0.0009	0.0142	0.0448	0.0045	0.0706	0.0094	0.0801	0.098414	0.10464	Design Good	Design Good	
14	UDSTL11	0.8740	62.8590	93.2626	0.0047	0.2183	0.2229	-0.2136	-0.9580	0.0364	0.1084	0.3413	0.1805	0.5376	0.3790	0.8166	0.336388	0.5376	Design Good	Design Good	
14	UDSTL12	1.9830	-65.1670	-32.8729	0.0136	0.2263	0.2401	-0.2128	-0.8953	0.0377	0.1213	0.3620	0.1872	0.6017	0.3930	0.6948	0.350441	0.5376	Design Good	Design Good	
14	UDSTL13	0.6740	76.6120	113.6577	0.0047	0.2660	0.2707	-0.2613	-0.9654	0.0443	0.1310	0.4128	0.2200	0.6501	0.4619	1.1120	0.370523	0.6501	Design Good	Design Good	
14	UDSTL14	1.9830	-78.9410	-39.6099	0.0136	0.2741	0.2879	-0.2603	-0.9043	0.0457	0.1440	0.4535	0.2266	0.7143	0.4760	1.1902	0.383329	0.7143	Design Good	Design Good	
14	UDSTL15	0.7510	-1.1510	-1.5326	0.0052	0.0040	0.0092	0.0012	0.1323	0.0007	0.0071	0.0224	0.0033	0.0353	0.0069	0.0422	0.072207	0.0353	Design Good	Design Good	
14	UDSTL16	1.9060	-1.1770	-0.6175	0.0132	0.0041	0.0173	0.0091	0.5282	0.0007	0.0152	0.0476	0.0034	0.0753	0.0071	0.0824	0.100957	0.0753	Design Good	Design Good	
14	UDSTL17	1.8660	-1.1510	-0.6103	0.0131	0.0040	0.0171	0.0091	0.5324	0.0007	0.0150	0.0472	0.0033	0.0744	0.0069	0.0813	0.100208	0.0744	Design Good	Design Good	
14	UDSTL18	0.7700	-1.1770	-1.5286	0.0052	0.0041	0.0094	0.0013	0.1336	0.0007	0.0073	0.0250	0.0034	0.0362	0.0071	0.0433	0.073077	0.0362	Design Good	Design Good	
14	UDSTL19	2.2360	-1.6800	-0.7513	0.0195	0.0058	0.0214	0.0097	0.4538	0.0010	0.0193	0.0576	0.0048	0.0908	0.0101	0.1009	0.111617	0.0908	Design Good	Design Good	
14	UDSTL20	2.2360	-1.4240	-0.6369	0.0155	0.0049	0.0205	0.0106	0.5170	0.0008	0.0178	0.0563	0.0041	0.0897	0.0086	0.0973	0.109587	0.0897	Design Good	Design Good	
14	UDSTL21	2.2360	16.9160	7.5653	0.0155	0.0587	0.0743	-0.0432	-0.5118	0.0098	0.0434	0.1368	0.0486	0.2155	0.1020	0.3174	0.197967	0.2155	Design Good	Design Good	
14	UDSTL22	2.2360	-20.0200	-8.9535	0.0155	0.0895	0.0950	-0.0540	-0.5348	0.0116	0.0485	0.1529	0.0575	0.2409	0.1207	0.3618	0.211275	0.2409	Design Good	Design Good	
14	UDSTL23	1.3280	-1.2920	-0.9729	0.0092	0.0045	0.0137	0.0047	0.3455	0.0007	0.0114	0.0356	0.0037	0.0563	0.0078	0.0941	0.089569	0.0563	Design Good	Design Good	
14	UDSTL24	1.3280	-1.0360	-0.7801	0.0092	0.0036	0.0126	0.0056	0.4368	0.0006	0.0109	0.0344	0.0030	0.0542	0.0062	0.0695	0.089408	0.0542	Design Good	Design Good	
14	UDSTL25	1.3280	17.3040	13.0301	0.0092	0.0801	0.0883	-0.0509	-0.7339	0.0100	0.0378	0.1189	0.0497	0.1673	0.1043	0.2917	0.189782	0.1673	Design Good	Design Good	
14	UDSTL26	1.3280	-19.6320	-14.7831	0.0092	0.0882	0.0774	-0.0589	-0.7677	0.0114	0.0416	0.1310	0.0564	0.2064	0.1184	0.3246	0.200235	0.2064	Design Good	Design Good	
14	UDSTL27	2.2360	-0.8200	-0.3667	0.0155	0.0028	0.0164	0.0127	0.6901	0.0005	0.0169	0.0532	0.0024	0.0837	0.0049	0.0887	0.10464	0.0837	Design Good	Design Good	
14	UDSTL28	2.2360	-2.2840	-1.0215	0.0155	0.0079	0.0235	0.0076	0.3239	0.0013	0.0193	0.0508	0.0066	0.0957	0.0138	0.1085	0.116268	0.0957	Design Good	Design Good	
14	UDSTL29	2.2360	58.4910	26.1121	0.0158	0.2031	0.2186	-0.1875	-0.8547	0.0338	0.1120	0.3528	0.1679	0.5558	0.3527	0.8084	0.334893	0.5558	Design Good	Design Good	
14	UDSTL30	2.2360	-61.5950	-27.5863	0.0155	0.2139	0.2294	-0.1884	-0.8648	0.0356	0.1171	0.3688	0.1768	0.5809	0.3714	0.9523	0.342879	0.5809	Design Good	Design Good	
14	UDSTL31	1.3280	-0.4320	-0.3253	0.0092	0.0015	0.0107	0.0077	0.7202	0.0003	0.0099	0.0313	0.0012	0.0493	0.0026	0.0519	0.080041	0.0493	Design Good	Design Good	
14	UDSTL32	1.3280	-1.8960	-1.4277	0.0092	0.0066	0.0159	0.0026	0.1670	0.0011	0.0123	0.0388	0.0054	0.0613	0.0114	0.0727	0.094738	0.0613	Design Good	Design Good	
14	UDSTL33	1.3330	58.8790	44.1703	0.0093	0.2044	0.2137	-0.1952	-0.9134	0.0341	0.1094	0.3351	0.1690	0.5277	0.3950	0.8627	0.330116	0.5277	Design Good	Design Good	
14	UDSTL34	1.3240	-61.2070	-46.2289	0.0092	0.2125	0.2217	-0.2033	-0.9171	0.0384	0.1101	0.3470	0.1757	0.5464	0.3090	0.9155	0.336189	0.5464	Design Good	Design Good	

Joint Text	Output/Case Text	F3 Kip	M2 Kip-in	e in	σ_{axial} ksi	σ_{bend} ksi	σ_{max} ksi	σ_{min} ksi	ratio	stress_slope	σ_{flex} ksi	F_react Kip	F_tri Kip	M_react Kip-in	M_tri Kip-in	M_design Kip-in	ip in	d. check plate	d. check ped bearing
14	UDSTL1	2.0680	0.0000	0.0000	0.0143	0.0000	0.0143	0.0143	1.0000	0.0000	0.0143	0.0452	0.0000	0.0712	0.0000	0.0712	0.093743	Design Good	Design Good
14	UDSTL2	3.2590	0.0001	0.0000	0.0226	0.0000	0.0226	0.0226	1.0000	0.0000	0.0226	0.0713	0.0000	0.1123	0.0000	0.1123	0.117736	Design Good	Design Good
14	UDSTL3	1.5820	0.1131	0.0110	0.0006	0.0116	0.0104	0.0104	0.6929	0.0001	0.0113	0.0355	0.0005	0.0560	0.0011	0.0570	0.083923	Design Good	Design Good
14	UDSTL4	2.6900	-0.1790	-0.0619	0.0201	0.0006	0.0207	0.0194	0.9399	0.0001	0.0204	0.0641	0.0005	0.1010	0.0011	0.1021	0.112729	Design Good	Design Good
14	UDSTL5	1.6820	0.2410	0.1523	0.0110	0.0008	0.0118	0.0101	0.8564	0.0001	0.0114	0.0359	0.0007	0.0565	0.0015	0.0579	0.084569	Design Good	Design Good
14	UDSTL6	2.8900	-0.2410	-0.0834	0.0201	0.0008	0.0209	0.0192	0.9199	0.0001	0.0205	0.0645	0.0007	0.1015	0.0015	0.1030	0.117283	Design Good	Design Good
14	UDSTL7	1.6500	-15.1440	-9.1284	0.0115	0.0528	0.0641	-0.0411	-0.6406	0.0088	0.0365	0.1150	0.0435	0.1811	0.0913	0.2724	0.183378	Design Good	Design Good
14	UDSTL8	2.1100	15.1440	5.3655	0.0165	0.0528	0.0721	-0.0330	-0.4593	0.0088	0.0445	0.1402	0.0435	0.2202	0.0913	0.3121	0.195306	Design Good	Design Good
14	UDSTL9	2.7940	-15.1440	-9.4202	0.0194	0.0526	0.0720	-0.0332	-0.4609	0.0088	0.0444	0.1398	0.0435	0.2202	0.0913	0.3115	0.1951	Design Good	Design Good
14	UDSTL10	1.6760	15.1440	9.0250	0.0117	0.0526	0.0642	-0.0409	-0.5372	0.0088	0.0366	0.1154	0.0435	0.1817	0.0913	0.2730	0.183598	Design Good	Design Good
14	UDSTL11	0.6740	0.1790	0.2656	0.0047	0.0006	0.0053	0.0041	0.7656	0.0001	0.0050	0.0157	0.0005	0.0247	0.0011	0.0258	0.035644	Design Good	Design Good
14	UDSTL12	1.9830	-0.1790	-0.0903	0.0138	0.0006	0.0144	0.0131	0.9136	0.0001	0.0141	0.0443	0.0005	0.0608	0.0011	0.0709	0.093534	Design Good	Design Good
14	UDSTL13	0.6740	0.2410	0.3576	0.0047	0.0008	0.0055	0.0038	0.6967	0.0001	0.0051	0.0160	0.0007	0.0252	0.0015	0.0266	0.057366	Design Good	Design Good
14	UDSTL14	1.9830	-0.2410	-0.1215	0.0138	0.0008	0.0146	0.0129	0.8854	0.0001	0.0142	0.0446	0.0007	0.0703	0.0015	0.0717	0.094114	Design Good	Design Good
14	UDSTL15	0.7510	-15.1440	-20.1651	0.0052	0.0520	0.0578	-0.0474	-0.8195	0.0088	0.0302	0.0951	0.0435	0.1498	0.0913	0.2411	0.172526	Design Good	Design Good
14	UDSTL16	1.9060	15.1440	7.9454	0.0132	0.0526	0.0658	-0.0393	-0.5978	0.0088	0.0392	0.1204	0.0435	0.1896	0.0913	0.2609	0.186221	Design Good	Design Good
14	UDSTL17	1.8660	-15.1440	-8.0297	0.0131	0.0526	0.0657	-0.0395	-0.6012	0.0088	0.0381	0.1199	0.0435	0.1889	0.0913	0.2602	0.185992	Design Good	Design Good
14	UDSTL18	0.7700	15.1440	19.6675	0.0053	0.0526	0.0579	-0.0472	-0.8154	0.0088	0.0303	0.0955	0.0435	0.1504	0.0913	0.2418	0.17276	Design Good	Design Good
14	UDSTL19	2.2360	-18.1710	-8.1266	0.0155	0.0631	0.0786	-0.0476	-0.8050	0.0105	0.0455	0.1433	0.0522	0.2257	0.1096	0.3363	0.203452	Design Good	Design Good
14	UDSTL20	2.2360	18.1710	8.1266	0.0155	0.0631	0.0786	-0.0476	-0.8050	0.0105	0.0455	0.1433	0.0522	0.2257	0.1096	0.3363	0.203452	Design Good	Design Good
14	UDSTL21	2.2360	0.0570	0.0255	0.0155	0.0002	0.0157	0.0153	0.9748	0.0000	0.0156	0.0492	0.0002	0.0775	0.0003	0.0778	0.098035	Design Good	Design Good
14	UDSTL22	2.2360	-0.0570	-0.0255	0.0155	0.0002	0.0157	0.0153	0.9748	0.0000	0.0156	0.0492	0.0002	0.0775	0.0003	0.0778	0.098035	Design Good	Design Good
14	UDSTL23	1.3280	-18.1710	-13.6630	0.0092	0.0531	0.0723	-0.0539	-0.7449	0.0105	0.0392	0.1235	0.0522	0.1944	0.1096	0.3040	0.193728	Design Good	Design Good
14	UDSTL24	1.3280	18.1710	13.6630	0.0092	0.0531	0.0723	-0.0539	-0.7449	0.0105	0.0392	0.1235	0.0522	0.1944	0.1096	0.3040	0.193728	Design Good	Design Good
14	UDSTL25	1.3280	0.0570	0.0429	0.0092	0.0002	0.0094	0.0090	0.9560	0.0000	0.0093	0.0293	0.0002	0.0462	0.0003	0.0466	0.07582	Design Good	Design Good
14	UDSTL26	1.3280	-0.0570	-0.0429	0.0092	0.0002	0.0094	0.0090	0.9560	0.0000	0.0093	0.0293	0.0002	0.0462	0.0003	0.0466	0.07582	Design Good	Design Good
14	UDSTL27	2.2360	57.4690	25.7017	0.0155	0.1995	0.2151	-0.1840	-0.8556	0.0333	0.1103	0.3475	0.1650	0.5473	0.3465	0.8938	0.33218	Design Good	Design Good
14	UDSTL28	2.2360	-57.4690	-25.7017	0.0155	0.1995	0.2151	-0.1840	-0.8556	0.0333	0.1103	0.3475	0.1650	0.5473	0.3465	0.8938	0.33218	Design Good	Design Good
14	UDSTL29	2.2360	0.1820	0.0813	0.0155	0.0006	0.0162	0.0149	0.9219	0.0001	0.0159	0.0499	0.0005	0.0787	0.0011	0.0798	0.098233	Design Good	Design Good
14	UDSTL30	1.3280	57.4690	43.2748	0.0092	0.1995	0.2088	-0.1803	-0.9117	0.0333	0.1040	0.3276	0.1650	0.5160	0.3465	0.8625	0.326315	Design Good	Design Good
14	UDSTL31	1.3280	-57.4690	-43.2748	0.0092	0.1995	0.2088	-0.1803	-0.9117	0.0333	0.1040	0.3276	0.1650	0.5160	0.3465	0.8625	0.326315	Design Good	Design Good
14	UDSTL32	1.3280	0.1820	0.1365	0.0092	0.0006	0.0099	0.0086	0.8722	0.0001	0.0096	0.0301	0.0005	0.0474	0.0011	0.0485	0.07739	Design Good	Design Good
14	UDSTL33	1.3240	-0.1820	-0.1375	0.0092	0.0006	0.0099	0.0086	0.8714	0.0001	0.0095	0.0298	0.0005	0.0471	0.0011	0.0482	0.077142	Design Good	Design Good



Gas Bottles Misc Support Calculations
By R. Murphy Date: 12/18/2007

Calculation Sheet

Project: BGCAPP
Job Number: 743341
Calc No: 24915-10-DBC-00-00004
Rev D
Sheet No. D1-24 / D1-60

Base Plate Design

HSS 6X6X.375
12"x12" Plate
144

I (in)	1728	c (in)	6	I (in)	0.75	n(lb)	3.15	d (in)	12	Fy (ksi)	36	A2 (in ²)	324	Ratio	1.5	Phi	0.6	Fc (ksi)	4	Fp (ksi)	3.06
--------	------	--------	---	--------	------	-------	------	--------	----	----------	----	-----------------------	-----	-------	-----	-----	-----	----------	---	----------	------

Joint	OutputCase	F3	M1	theta	sigma_xtal	sigma_bend	sigma_max	sigma_min	ratio	stresst_slope	sigma_frc	F_rect	F_tri	M_rect	M_tri	M_design	ip	d, check plate	d, check ped bearing
Text	Text	Kip	Kip-in	in	ksi	ksi	ksi	ksi			ksi	Kip	Kip	Kip-in	Kip-in	Kip-in	in		
15	UDSTL1	1.8070	-1.5000	-0.8301	0.0125	0.0052	0.0178	0.0073	0.4134	0.0009	0.0150	0.0473	0.0043	0.0745	0.0038	0.0838	0.101577	Design Good	Design Good
15	UDSTL2	2.7810	-1.2860	-0.4624	0.0193	0.0045	0.0238	0.0148	-0.6244	0.0007	0.0214	0.0875	0.0037	0.1063	0.0078	0.1141	0.1186681	Design Good	Design Good
15	UDSTL3	1.3920	56.9800	40.9339	0.0097	0.1878	0.2075	-0.1882	-0.9058	0.0330	0.1036	3.2855	0.1636	0.5142	0.3435	0.8578	0.325416	Design Good	Design Good
15	UDSTL4	2.4760	-58.5520	-24.0517	0.0172	0.2068	0.2240	-0.1896	-0.8465	0.0045	0.1194	0.3636	0.1710	0.5726	0.3591	0.9317	0.359145	Design Good	Design Good
15	UDSTL5	1.3920	69.6810	50.0438	0.0097	0.2419	0.2515	-0.2322	-0.9231	0.0403	0.1246	0.3924	0.2000	0.6180	0.4200	1.0380	0.357974	Design Good	Design Good
15	UDSTL6	2.4760	-72.2330	-29.1733	0.0172	0.2508	0.2680	-0.2336	-0.8717	0.0418	0.1363	0.4294	0.2074	0.6784	0.4355	1.1119	0.370498	Design Good	Design Good
15	UDSTL7	1.7430	-1.2490	-0.7166	0.0121	0.0043	0.0164	0.0078	0.4724	0.0007	0.0142	0.0446	0.0036	0.0703	0.0075	0.0778	0.0980006	Design Good	Design Good
15	UDSTL8	2.1250	-1.3230	-0.8226	0.0148	0.0046	0.0194	0.0102	0.5252	0.0008	0.0168	0.0534	0.0038	0.0840	0.0060	0.10593	0.10593	Design Good	Design Good
15	UDSTL9	1.7430	-1.3730	-0.7500	0.0121	0.0046	0.0167	0.0075	0.4488	0.0008	0.0143	0.0450	0.0038	0.0709	0.0080	0.0769	0.088667	Design Good	Design Good
15	UDSTL10	1.8200	57.3020	32.4226	0.0043	0.1990	0.2093	-0.1947	-0.9576	0.0005	0.0988	0.3113	0.1645	0.4902	0.3455	0.8357	0.321211	Design Good	Design Good
15	UDSTL11	1.7040	-59.2310	-34.7600	0.0118	0.2057	0.2175	-0.1938	-0.8912	0.0343	0.1095	0.3450	0.1701	0.5434	0.3571	0.9005	0.333425	Design Good	Design Good
15	UDSTL12	0.6200	69.9830	112.8758	0.0043	0.2430	0.2473	-0.2387	-0.9652	0.0405	0.1187	0.3771	0.2009	0.5940	0.4219	1.0180	0.354156	Design Good	Design Good
15	UDSTL13	1.7040	-71.9110	-42.2013	0.0118	0.2497	0.2615	-0.2379	-0.9085	0.0416	0.1304	0.4109	0.2055	0.5471	0.4336	1.0807	0.365267	Design Good	Design Good
15	UDSTL14	0.9710	-0.9280	-0.9557	0.0067	0.0032	0.0100	0.0035	0.3533	0.0005	0.0083	0.0281	0.0027	0.0410	0.0056	0.0466	0.075884	Design Good	Design Good
15	UDSTL15	1.3530	-1.0010	-0.7398	0.0094	0.0035	0.0129	0.0059	0.4599	0.0006	0.0110	0.0348	0.0029	0.0548	0.0060	0.0608	0.086668	Design Good	Design Good
15	UDSTL16	1.3530	-0.9280	-0.6858	0.0094	0.0032	0.0126	0.0062	0.4883	0.0005	0.0109	0.0344	0.0027	0.0542	0.0056	0.0588	0.085925	Design Good	Design Good
15	UDSTL17	0.9710	-1.0010	-1.0308	0.0067	0.0035	0.0102	0.0033	0.3197	0.0005	0.0094	0.0284	0.0029	0.0415	0.0060	0.0477	0.076723	Design Good	Design Good
15	UDSTL18	1.9340	-1.1720	-0.8060	0.0134	0.0041	0.0175	0.0094	0.5349	0.0007	0.0154	0.0484	0.0034	0.0762	0.0071	0.0833	0.101403	Design Good	Design Good
15	UDSTL19	1.9340	-1.4000	-0.7239	0.0134	0.0049	0.0185	0.0096	0.4685	0.0008	0.0157	0.0496	0.0040	0.0781	0.0084	0.0885	0.103357	Design Good	Design Good
15	UDSTL20	1.9340	15.7170	8.1267	0.0134	0.0546	0.0680	-0.0411	-0.6050	0.0081	0.0394	0.1240	0.0451	0.1952	0.0948	0.2800	0.189216	Design Good	Design Good
15	UDSTL21	1.9340	-18.2890	-9.4566	0.0134	0.0635	0.0769	-0.0501	-0.6509	0.0106	0.0436	0.1373	0.0525	0.2183	0.1103	0.3266	0.200787	Design Good	Design Good
15	UDSTL22	1.9340	-18.2890	-9.4566	0.0134	0.0635	0.0769	-0.0501	-0.6509	0.0106	0.0436	0.1373	0.0525	0.2183	0.1103	0.3266	0.200787	Design Good	Design Good
15	UDSTL23	1.1620	-1.0780	-0.7324	0.0081	0.0030	0.0110	0.0051	0.4639	0.0005	0.0095	0.0298	0.0024	0.0470	0.0051	0.0521	0.080223	Design Good	Design Good
15	UDSTL24	1.1620	-0.9277	-0.6081	0.0081	0.0037	0.0118	0.0043	0.3653	0.0006	0.0098	0.0310	0.0031	0.0489	0.0065	0.0554	0.082668	Design Good	Design Good
15	UDSTL25	1.1620	16.0390	13.8029	0.0081	0.0557	0.0538	-0.0476	-0.7469	0.0009	0.0345	0.1087	0.0460	0.1773	0.0987	0.2880	0.181869	Design Good	Design Good
15	UDSTL26	1.1620	-17.9880	-15.4630	0.0081	0.0624	0.0705	-0.0543	-0.7709	0.0104	0.0377	0.1188	0.0516	0.1871	0.1083	0.2954	0.190967	Design Good	Design Good
15	UDSTL27	1.9340	-0.5730	-0.2963	0.0134	0.0020	0.0154	0.0114	0.7420	0.0003	0.0144	0.0453	0.0016	0.0713	0.0035	0.0748	0.096081	Design Good	Design Good
15	UDSTL28	1.9340	-1.9950	-1.0336	0.0134	0.0069	0.0204	0.0095	0.3186	0.0012	0.0167	0.0527	0.0057	0.0830	0.0121	0.0950	0.108322	Design Good	Design Good
15	UDSTL29	1.9310	47.7560	24.6546	0.0135	0.1658	0.1793	-0.1524	-0.8459	0.0276	0.0922	0.2905	0.1371	0.4575	0.2879	0.7454	0.303364	Design Good	Design Good
15	UDSTL30	1.9310	-50.3260	-26.0532	0.0134	0.1748	0.1882	-0.1613	-0.8575	0.0291	0.0964	0.3037	0.1445	0.4783	0.3034	0.7818	0.310672	Design Good	Design Good
15	UDSTL31	1.6200	-0.2520	-0.2169	0.0081	0.0009	0.0089	0.0022	0.8043	0.0001	0.0085	0.0267	0.0007	0.0421	0.0015	0.0436	0.07338	Design Good	Design Good
15	UDSTL32	1.6200	-1.6770	-1.4432	0.0081	0.0058	0.0158	0.0072	0.1817	0.0010	0.0106	0.0341	0.0048	0.0538	0.0101	0.0539	0.088797	Design Good	Design Good
15	UDSTL33	1.1650	48.0770	41.2878	0.0081	0.1669	0.1750	-0.1598	-0.9076	0.0278	0.0874	0.2753	0.1380	0.4335	0.2899	0.7234	0.298846	Design Good	Design Good
15	UDSTL34	1.1590	-50.0060	-43.1458	0.0080	0.1736	0.1817	-0.1656	-0.9114	0.0289	0.0805	0.2851	0.1436	0.4491	0.3015	0.7506	0.304414	Design Good	Design Good



Gas Bottles Misc Support Calculations
By R. Murphy Date: 12/16/2007

Calculation Sheet

Project: BGCAPP
Job Number: 743341
Calc No: 24915-10-DBC-00-00004
Rev D
Sheet No. D1-25 / D1-60

Joint Text	OutputCase	F3 Kip	M2 Kip-in	b in	σ_{axial} ksi	σ_{bend} ksi	σ_{max} ksi	σ_{min} ksi	ratio	stress_slope	σ_{face} ksi	F_rect Kip	F_Irt Kip	M_rect Kip-in	M_Irt Kip-in	M_design Kip-in	tp in	d. check plate	d. check ped bearing
15	UDSTL1	1.8070	0.0003	0.0002	0.0125	0.0000	0.0125	0.0125	0.9998	0.0000	0.0125	0.0395	0.0000	0.0623	0.0000	0.0623	0.087673	Design Good	Design Good
15	UDSTL2	2.7810	0.0004	0.0002	0.0193	0.0000	0.0193	0.0193	0.9998	0.0000	0.0193	0.0608	0.0000	0.0958	0.0000	0.0958	0.108764	Design Good	Design Good
15	UDSTL3	1.3820	-0.1680	-0.1207	0.0091	0.0006	0.0103	0.0091	0.8952	0.0001	0.0059	0.0313	0.0000	0.0493	0.0010	0.0503	0.078839	Design Good	Design Good
15	UDSTL4	2.4760	0.1680	0.0679	0.0172	0.0006	0.0178	0.0166	0.9444	0.0001	0.0175	0.0350	0.0000	0.0967	0.0010	0.0877	0.104005	Design Good	Design Good
15	UDSTL5	1.3820	-0.2260	-0.1684	0.0097	0.0008	0.0105	0.0089	0.8498	0.0001	0.0100	0.0306	0.0000	0.0496	0.0014	0.0512	0.079482	Design Good	Design Good
15	UDSTL6	2.4760	0.2270	0.0917	0.0172	0.0008	0.0180	0.0164	0.9123	0.0001	0.0176	0.0553	0.0007	0.0972	0.0014	0.0885	0.104546	Design Good	Design Good
15	UDSTL7	1.7430	-15.0810	-8.6523	0.0121	0.0524	0.0645	-0.0403	-0.8245	0.0087	0.0370	0.1165	0.0433	0.1635	0.0909	0.2744	0.184005	Design Good	Design Good
15	UDSTL8	2.1250	15.0820	7.0974	0.0148	0.0524	0.0671	-0.0376	-0.5603	0.0087	0.0398	0.1248	0.0433	0.1965	0.0909	0.2876	0.188417	Design Good	Design Good
15	UDSTL9	2.1250	-15.0810	-7.0999	0.0148	0.0524	0.0671	-0.0376	-0.5603	0.0087	0.0398	0.1248	0.0433	0.1965	0.0909	0.2876	0.188417	Design Good	Design Good
15	UDSTL10	1.7430	15.0820	8.6529	0.0121	0.0524	0.0645	-0.0403	-0.8245	0.0087	0.0370	0.1165	0.0433	0.1835	0.0909	0.2744	0.184054	Design Good	Design Good
15	UDSTL11	0.6200	-0.1680	-0.2710	0.0043	0.0006	0.0049	0.0037	0.7614	0.0001	0.0046	0.0144	0.0005	0.0227	0.0010	0.0237	0.054147	Design Good	Design Good
15	UDSTL12	1.7040	0.1680	0.0886	0.0118	0.0006	0.0124	0.0113	0.9060	0.0001	0.0121	0.0381	0.0005	0.0601	0.0010	0.0611	0.086849	Design Good	Design Good
15	UDSTL13	0.6200	-0.2260	-0.3845	0.0043	0.0008	0.0051	0.0035	0.6917	0.0001	0.0047	0.0147	0.0006	0.0232	0.0014	0.0246	0.055079	Design Good	Design Good
15	UDSTL14	1.7040	0.1332	0.0118	0.0118	0.0008	0.0126	0.0110	0.8751	0.0001	0.0122	0.0385	0.0007	0.0606	0.0014	0.0619	0.087443	Design Good	Design Good
15	UDSTL15	0.9710	-15.0820	-15.5324	0.0057	0.0524	0.0591	-0.0456	-0.7719	0.0087	0.0316	0.0996	0.0433	0.1969	0.0909	0.2478	0.174907	Design Good	Design Good
15	UDSTL16	1.3530	15.0820	11.1471	0.0094	0.0524	0.0618	-0.0430	-0.6957	0.0087	0.0343	0.1000	0.0433	0.1700	0.0909	0.2510	0.179491	Design Good	Design Good
15	UDSTL17	1.3530	-15.0810	-11.1463	0.0094	0.0524	0.0618	-0.0430	-0.6957	0.0087	0.0343	0.1075	0.0433	0.1700	0.0909	0.2510	0.179491	Design Good	Design Good
15	UDSTL18	0.9710	15.0820	15.5324	0.0067	0.0524	0.0591	-0.0456	-0.7719	0.0087	0.0316	0.0996	0.0433	0.1569	0.0909	0.2478	0.174907	Design Good	Design Good
15	UDSTL19	1.9340	-18.1710	-9.3956	0.0134	0.0631	0.0765	-0.0497	-0.6490	0.0105	0.0434	0.1367	0.0522	0.2153	0.1096	0.3249	0.200271	Design Good	Design Good
15	UDSTL20	1.9340	18.1710	9.3956	0.0134	0.0631	0.0765	-0.0497	-0.6490	0.0105	0.0434	0.1367	0.0522	0.2153	0.1096	0.3249	0.200271	Design Good	Design Good
15	UDSTL21	1.9340	-0.0530	-0.0274	0.0134	0.0002	0.0136	0.0132	0.9750	0.0000	0.0135	0.0426	0.0002	0.0671	0.0003	0.0674	0.200271	Design Good	Design Good
15	UDSTL22	1.9340	0.0540	0.0279	0.0134	0.0002	0.0136	0.0132	0.9726	0.0000	0.0135	0.0426	0.0002	0.0671	0.0003	0.0674	0.091219	Design Good	Design Good
15	UDSTL23	1.6200	-18.1710	-15.6377	0.0081	0.0631	0.0712	-0.0550	-0.7732	0.0105	0.0390	0.1198	0.0522	0.1887	0.1096	0.2983	0.191897	Design Good	Design Good
15	UDSTL24	1.6200	18.1710	15.6377	0.0081	0.0631	0.0712	-0.0550	-0.7732	0.0105	0.0390	0.1198	0.0522	0.1887	0.1096	0.2983	0.191897	Design Good	Design Good
15	UDSTL25	1.6200	-0.0540	-0.0465	0.0081	0.0002	0.0083	0.0079	0.9546	0.0000	0.0082	0.0257	0.0002	0.0405	0.0003	0.0408	0.070974	Design Good	Design Good
15	UDSTL26	1.6200	0.0540	0.0465	0.0081	0.0002	0.0083	0.0079	0.9546	0.0000	0.0082	0.0257	0.0002	0.0405	0.0003	0.0408	0.070974	Design Good	Design Good
15	UDSTL27	1.9340	57.4700	29.7158	0.0134	0.1995	0.2130	-0.1861	-0.8739	0.0333	0.1082	0.3409	0.1650	0.5369	0.3465	0.8934	0.302433	Design Good	Design Good
15	UDSTL28	1.9340	-57.4700	-29.7156	0.0134	0.1995	0.2130	-0.1861	-0.8739	0.0333	0.1082	0.3409	0.1650	0.5369	0.3465	0.8934	0.302433	Design Good	Design Good
15	UDSTL29	1.9310	-0.1930	-0.0999	0.0134	0.0007	0.0141	0.0128	0.9046	0.0001	0.0138	0.0434	0.0006	0.0683	0.0012	0.0695	0.092625	Design Good	Design Good
15	UDSTL30	1.9310	0.1930	0.0999	0.0134	0.0007	0.0141	0.0128	0.9046	0.0001	0.0138	0.0434	0.0006	0.0683	0.0012	0.0695	0.092625	Design Good	Design Good
15	UDSTL29	1.6200	57.4700	49.4578	0.0081	0.1995	0.2076	-0.1915	-0.9223	0.0333	0.1029	0.3240	0.1650	0.5103	0.3465	0.8568	0.325234	Design Good	Design Good
15	UDSTL29	1.6200	-57.4700	-49.4578	0.0081	0.1995	0.2076	-0.1915	-0.9223	0.0333	0.1029	0.3240	0.1650	0.5103	0.3465	0.8568	0.325234	Design Good	Design Good
15	UDSTL30	1.6550	0.1940	0.1665	0.0061	0.0007	0.0088	0.0074	0.8463	0.0001	0.0084	0.0265	0.0006	0.0417	0.0012	0.0429	0.072771	Design Good	Design Good
15	UDSTL30	1.1590	-0.1940	-0.1674	0.0060	0.0007	0.0087	0.0074	0.8455	0.0001	0.0084	0.0264	0.0006	0.0415	0.0012	0.0427	0.072596	Design Good	Design Good



Gas Boilers Misc Support Calculations
By R. Murphy Date: 12/18/2007

Calculation Sheet

Project: BGCAPP
Job Number: 743341
Calc No: 24915-10-DBC-00-00004
Rev D
Sheet No. D1-26 / D1-50

Base Plate Design

HSS 6X6X 3/8	1 (in)	1728
12" x 12" Plate	A (in ²)	144

F _y (ksi)	36
A ₂ (in ²)	324
A _{ratio}	1.5
φ _c	0.6
F _c (ksi)	4
F _p (ksi)	3.06

Joint	Output/Case	F3	M1	e	σ _{axial}	θ _{bend}	σ _{max}	σ _{min}	ratio	stress_slope	σ _{face}	F _{rect}	F _{tri}	M _{rect}	M _{tri}	M _{design}	tp	d. check plate	d. check ped bearing
Text	Text	Kip	Kip-in	in	ksi	ksi	ksi	ksi			ksi	Kip	Kip	Kip-in	Kip-in	Kip-in	in		
16	UDSTL1	3.6800	-1.6570	-0.4503	0.0256	0.0058	0.0313	0.0198	0.6325	0.0010	0.0283	0.0991	0.0048	0.1403	0.0100	0.1503	0.136235382	Design Good	Design Good
16	UDSTL2	6.0830	-1.4200	-0.2334	0.0422	0.0049	0.0472	0.0373	0.7910	0.0008	0.0446	0.1404	0.0041	0.2212	0.0066	0.2298	0.188420138	Design Good	Design Good
16	UDSTL3	2.7820	56.4750	23.8947	0.0193	0.2308	0.2501	-0.2115	-0.8455	0.0385	0.1290	0.4093	0.1909	0.6368	0.4008	1.0408	0.358423431	Design Good	Design Good
16	UDSTL4	5.3570	-69.3150	-12.9391	0.0372	0.2407	0.2779	-0.2035	0.7322	0.0401	0.1515	0.4773	0.1990	0.7517	0.4179	1.1887	0.360003933	Design Good	Design Good
16	UDSTL5	2.7820	76.9180	27.9047	0.0195	0.2657	0.2850	-0.2464	-0.8644	0.0443	0.1455	0.4594	0.2197	0.7220	0.4613	1.1653	0.382215069	Design Good	Design Good
16	UDSTL6	5.3570	-79.3590	-14.8141	0.0372	0.2756	0.3128	-0.2384	-0.7621	0.0459	0.1681	0.5295	0.2276	0.8339	0.4785	1.3124	0.402524230	Design Good	Design Good
16	UDSTL7	3.1780	-1.4230	-0.4478	0.0221	0.0049	0.0270	0.0171	0.6241	0.0008	0.0244	0.0769	0.0041	0.1211	0.0086	0.1287	0.1265475	Design Good	Design Good
16	UDSTL8	4.9610	-1.4180	-0.2858	0.0345	0.0049	0.0394	0.0285	0.7499	0.0008	0.0368	0.1159	0.0041	0.1825	0.0065	0.1911	0.153888535	Design Good	Design Good
16	UDSTL9	4.8470	-1.4220	-0.2934	0.0337	0.0049	0.0388	0.0287	0.7442	0.0008	0.0360	0.1134	0.0041	0.1788	0.0066	0.1872	0.152024867	Design Good	Design Good
16	UDSTL10	3.2920	-1.4180	-0.4307	0.0229	0.0049	0.0278	0.0179	0.6455	0.0009	0.0252	0.0794	0.0041	0.1250	0.0085	0.1336	0.128414924	Design Good	Design Good
16	UDSTL11	1.0760	66.8300	61.9944	0.0075	0.2320	0.2395	-0.2246	-0.9375	0.0397	0.1177	0.3708	0.1919	0.5840	0.4029	0.9868	0.349959174	Design Good	Design Good
16	UDSTL12	3.5530	-86.9600	-18.8776	0.0254	0.2354	0.2648	-0.2141	-0.8084	0.0399	0.1391	0.4382	0.1990	0.6901	0.4158	1.1059	0.309502645	Design Good	Design Good
16	UDSTL13	1.0760	76.8790	71.3106	0.0075	0.2669	0.2744	-0.2594	-0.9454	0.0445	0.1343	0.4230	0.2207	0.6662	0.4635	1.1297	0.373477869	Design Good	Design Good
16	UDSTL14	3.6540	-79.0040	-21.6212	0.0254	0.2743	0.2997	-0.2469	-0.8307	0.0457	0.1557	0.4904	0.2268	0.7724	0.4763	1.2487	0.392631165	Design Good	Design Good
16	UDSTL15	1.4740	-1.0680	-0.7246	0.0102	0.0037	0.0138	0.0055	0.4881	0.0006	0.0120	0.0378	0.0031	0.0595	0.0064	0.0660	0.090241261	Design Good	Design Good
16	UDSTL16	3.2570	-1.0630	-0.3264	0.0226	0.0037	0.0263	0.0189	0.7194	0.0006	0.0244	0.0768	0.0031	0.1209	0.0064	0.1273	0.125374054	Design Good	Design Good
16	UDSTL17	3.1440	-1.0680	-0.3397	0.0218	0.0037	0.0255	0.0181	0.7056	0.0006	0.0236	0.0743	0.0031	0.1171	0.0064	0.1235	0.123477868	Design Good	Design Good
16	UDSTL18	1.5880	-1.0630	-0.6694	0.0110	0.0037	0.0147	0.0073	0.4955	0.0006	0.0128	0.0493	0.0031	0.0634	0.0064	0.0698	0.092841846	Design Good	Design Good
16	UDSTL19	4.0700	-1.3500	-0.3317	0.0283	0.0047	0.0350	0.0236	0.7155	0.0008	0.0365	0.0998	0.0039	0.1513	0.0061	0.1594	0.140286437	Design Good	Design Good
16	UDSTL20	4.0700	-1.4910	-0.3663	0.0283	0.0052	0.0334	0.0232	0.6804	0.0009	0.0307	0.0998	0.0043	0.1524	0.0090	0.1614	0.141165424	Design Good	Design Good
16	UDSTL21	4.0700	17.5460	4.3111	0.0283	0.0609	0.0892	-0.0327	-0.3662	0.0102	0.0572	0.1802	0.0504	0.2838	0.1058	0.3996	0.219310487	Design Good	Design Good
16	UDSTL22	4.0700	-20.3870	-5.0091	0.0283	0.0706	0.0991	-0.0425	-0.4293	0.0118	0.0619	0.1949	0.0585	0.3070	0.1229	0.4300	0.23038486	Design Good	Design Good
16	UDSTL23	2.3660	-0.9650	-0.4205	0.0164	0.0035	0.0199	0.0130	0.6525	0.0006	0.0181	0.0569	0.0029	0.0807	0.0060	0.0857	0.108671522	Design Good	Design Good
16	UDSTL24	2.3660	-1.1360	-0.4801	0.0164	0.0039	0.0204	0.0125	0.6128	0.0007	0.0183	0.0577	0.0033	0.0908	0.0068	0.0977	0.109803881	Design Good	Design Good
16	UDSTL25	2.3660	17.9010	7.5659	0.0164	0.0622	0.0766	-0.0457	-0.5818	0.0104	0.0460	0.1448	0.0514	0.2280	0.1079	0.3359	0.203648684	Design Good	Design Good
16	UDSTL26	2.3660	-20.0330	-5.4866	0.0164	0.0696	0.0860	-0.0531	-0.6178	0.0116	0.0466	0.1588	0.0375	0.2454	0.1208	0.3662	0.212828601	Design Good	Design Good
16	UDSTL27	4.0700	-1.2430	-0.3054	0.0283	0.0043	0.0326	0.0239	0.7351	0.0007	0.0303	0.0955	0.0036	0.1504	0.0075	0.1579	0.139615711	Design Good	Design Good
16	UDSTL28	4.0700	-1.5980	-0.3926	0.0283	0.0055	0.0338	0.0227	0.6718	0.0009	0.0309	0.0973	0.0046	0.1533	0.0095	0.1629	0.141828821	Design Good	Design Good
16	UDSTL29	4.0750	56.4780	13.8596	0.0283	0.1961	0.2244	-0.1678	-0.7478	0.0327	0.1214	0.3825	0.1922	0.6025	0.3405	0.9431	0.341213096	Design Good	Design Good
16	UDSTL30	2.3660	-0.8880	-0.3753	0.0164	0.0035	0.0206	0.0133	0.6840	0.0005	0.0179	0.0564	0.0025	0.0888	0.0054	0.0941	0.107804277	Design Good	Design Good
16	UDSTL31	2.3660	-1.2430	-0.5254	0.0164	0.0043	0.0207	0.0121	0.5639	0.0007	0.0185	0.0582	0.0036	0.0917	0.0075	0.0892	0.110855456	Design Good	Design Good
16	UDSTL32	2.3710	56.8330	23.9701	0.0165	0.1973	0.2136	-0.1809	-0.8460	0.0329	0.1102	0.3471	0.1632	0.5467	0.3427	0.8884	0.331363452	Design Good	Design Good
16	UDSTL33	2.3610	-58.9650	-24.9737	0.0164	0.2047	0.2211	-0.1883	-0.6517	0.0341	0.1136	0.3580	0.1693	0.5638	0.3555	0.8193	0.336892282	Design Good	Design Good



Gas Bottles Misc Support Calculations
By R. Murphy Date: 12/19/2007

Calculation Sheet

Project: BGCAPP
Job Number: 743341
Calc No: 24815-10-DBC-06-00004
Rev D
Sheet No D1-27 / 01-60

Joint	OutputCase	F3	M2	e	σ_axial	σ_bend	σ_max	σ_min	ratio	stress_slope	σ_face	F_rect	F_tri	M_rect	M_tri	M_design	tp	d_check_plate	d_check_psd_bearing
Text	Text	Kip	Kip-in	in	ksi	ksi	ksi	ksi			ksi	Kip	Kip	Kip-in	Kip-in	Kip-in	in		
16	UDSTL1	3.6800	-0.0008	-0.0002	0.0256	0.0000	0.0256	0.0256	0.9998	0.0000	0.0256	0.0605	0.0000	0.1268	0.0000	0.1268	0.125116449	Design Good	Design Good
16	UDSTL2	6.0930	-0.0014	-0.0002	0.0422	0.0000	0.0422	0.0422	0.9998	0.0000	0.0422	0.1031	0.0000	0.2096	0.0000	0.2096	0.160660972	Design Good	Design Good
16	UDSTL3	2.7820	0.0850	0.0306	0.0190	0.0003	0.0190	0.0190	0.9999	0.0000	0.0195	0.0513	0.0000	0.0965	0.0005	0.0971	0.109463679	Design Good	Design Good
16	UDSTL4	5.3570	-0.0870	-0.0162	0.0375	0.0003	0.0375	0.0369	0.9939	0.0001	0.0373	0.1176	0.0000	0.1853	0.0005	0.1858	0.15454604	Design Good	Design Good
16	UDSTL5	2.7820	0.1140	0.0410	0.0193	0.0004	0.0197	0.0189	0.9598	0.0001	0.0195	0.0614	0.0000	0.0968	0.0007	0.0975	0.109695849	Design Good	Design Good
16	UDSTL6	5.3570	-0.1150	-0.0215	0.0376	0.0004	0.0376	0.0368	0.9780	0.0001	0.0374	0.1178	0.0000	0.1855	0.0007	0.1862	0.151616704	Design Good	Design Good
16	UDSTL7	3.1780	15.1180	-4.7571	0.0221	0.0525	0.0746	-0.0304	-0.4080	0.0087	0.0470	0.1481	0.0434	0.2332	0.0912	0.3243	0.200107301	Design Good	Design Good
16	UDSTL8	4.9610	15.1160	3.0470	0.0345	0.0625	0.0869	-0.0180	-0.2074	0.0087	0.0594	0.1871	0.0434	0.2946	0.0911	0.3857	0.218227779	Design Good	Design Good
16	UDSTL9	4.8470	-15.1180	-3.1190	0.0337	0.0625	0.0862	-0.0189	-0.2186	0.0087	0.0696	0.1846	0.0434	0.2907	0.0912	0.3819	0.217122032	Design Good	Design Good
16	UDSTL10	3.2920	15.1170	4.5920	0.0229	0.0625	0.0754	-0.0296	-0.3932	0.0087	0.0478	0.1506	0.0434	0.2371	0.0911	0.3283	0.201310887	Design Good	Design Good
16	UDSTL11	1.0780	0.0980	0.0788	0.0075	0.0003	0.0078	0.0072	0.9241	0.0000	0.0076	0.0240	0.0000	0.0378	0.0005	0.0363	0.068808934	Design Good	Design Good
16	UDSTL12	3.6530	-0.0860	-0.0235	0.0254	0.0003	0.0257	0.0251	0.9767	0.0000	0.0255	0.0604	0.0000	0.1268	0.0005	0.1271	0.125255044	Design Good	Design Good
16	UDSTL13	1.0780	0.1140	0.1068	0.0075	0.0004	0.0079	0.0071	0.8906	0.0001	0.0077	0.0242	0.0000	0.0381	0.0007	0.0368	0.069175592	Design Good	Design Good
16	UDSTL14	3.6540	-0.1150	-0.0315	0.0254	0.0004	0.0259	0.0250	0.9630	0.0001	0.0256	0.0605	0.0000	0.1268	0.0007	0.1275	0.125474844	Design Good	Design Good
16	UDSTL15	1.4740	-15.1180	-10.2564	0.0102	0.0625	0.0827	-0.0423	-0.6736	0.0087	0.0352	0.1108	0.0434	0.1745	0.0912	0.2658	0.161053394	Design Good	Design Good
16	UDSTL16	3.2570	15.1170	4.6414	0.0228	0.0625	0.0751	-0.0299	-0.3977	0.0087	0.0476	0.1498	0.0434	0.2359	0.0911	0.3271	0.200940791	Design Good	Design Good
16	UDSTL17	3.1440	-15.1180	-4.8085	0.0218	0.0625	0.0743	-0.0307	-0.4125	0.0087	0.0468	0.1473	0.0434	0.2320	0.0912	0.3232	0.199745623	Design Good	Design Good
16	UDSTL18	1.5880	15.1170	9.5195	0.0110	0.0525	0.0635	-0.0415	-0.6528	0.0087	0.0360	0.1133	0.0434	0.1784	0.0911	0.2995	0.182423015	Design Good	Design Good
16	UDSTL19	4.0700	-15.1990	-4.4715	0.0283	0.0632	0.0915	-0.0349	-0.3819	0.0105	0.0563	0.1836	0.0523	0.2891	0.1097	0.3869	0.221907233	Design Good	Design Good
16	UDSTL20	4.0700	18.1970	4.4710	0.0283	0.0632	0.0914	-0.0349	-0.3819	0.0105	0.0563	0.1836	0.0522	0.2891	0.1097	0.3868	0.221899326	Design Good	Design Good
16	UDSTL21	4.0700	0.0260	0.0064	0.0283	0.0001	0.0284	0.0282	0.9835	0.0000	0.0283	0.0892	0.0001	0.1404	0.0002	0.1408	0.131748918	Design Good	Design Good
16	UDSTL22	4.0700	-0.0260	-0.0069	0.0283	0.0001	0.0284	0.0282	0.9831	0.0000	0.0283	0.0892	0.0001	0.1405	0.0002	0.1408	0.131760285	Design Good	Design Good
16	UDSTL23	2.3660	-18.1990	-7.6919	0.0164	0.0632	0.0796	-0.0468	-0.5873	0.0105	0.0464	0.1463	0.0523	0.2304	0.1097	0.3402	0.204926581	Design Good	Design Good
16	UDSTL24	2.3660	18.1990	7.6915	0.0164	0.0632	0.0796	-0.0468	-0.5873	0.0105	0.0464	0.1463	0.0523	0.2304	0.1097	0.3401	0.204926581	Design Good	Design Good
16	UDSTL25	2.3660	0.0270	0.0114	0.0164	0.0001	0.0165	0.0163	0.9687	0.0000	0.0165	0.0519	0.0001	0.0817	0.0002	0.0819	0.100553908	Design Good	Design Good
16	UDSTL26	2.3660	-0.0280	-0.0116	0.0164	0.0001	0.0165	0.0163	0.9682	0.0000	0.0165	0.0519	0.0001	0.0817	0.0002	0.0819	0.100562632	Design Good	Design Good
16	UDSTL27	4.0700	57.5550	14.1413	0.0283	0.0989	0.2281	-0.1716	-0.7522	0.0333	0.1232	0.3880	0.1652	0.6112	0.3470	0.9562	0.343940659	Design Good	Design Good
16	UDSTL28	4.0700	-57.5570	-14.1418	0.0283	0.0989	0.2281	-0.1716	-0.7522	0.0333	0.1232	0.3881	0.1653	0.6112	0.3470	0.9562	0.34394576	Design Good	Design Good
16	UDSTL29	4.0700	0.0800	0.0196	0.0283	0.0003	0.0286	0.0286	0.9806	0.0000	0.0284	0.0896	0.0000	0.1411	0.0005	0.1415	0.132186474	Design Good	Design Good
16	UDSTL30	4.0700	-0.0820	-0.0202	0.0283	0.0003	0.0285	0.0279	0.9800	0.0000	0.0284	0.0896	0.0000	0.1411	0.0005	0.1415	0.132186474	Design Good	Design Good
16	UDSTL29	2.3660	57.5550	24.3263	0.0164	0.1989	0.2163	-0.1634	-0.8481	0.0333	0.1114	0.3508	0.1652	0.5525	0.3470	0.8995	0.333237543	Design Good	Design Good
16	UDSTL29	2.3660	-57.5560	-24.3263	0.0164	0.1989	0.2163	-0.1634	-0.8481	0.0333	0.1114	0.3508	0.1652	0.5525	0.3470	0.8995	0.333240176	Design Good	Design Good
16	UDSTL30	2.3710	0.0810	0.0342	0.0165	0.0003	0.0167	0.0162	0.9664	0.0000	0.0166	0.0523	0.0000	0.0824	0.0005	0.0828	0.10129134	Design Good	Design Good
16	UDSTL30	2.3610	-0.0820	-0.0347	0.0164	0.0003	0.0167	0.0161	0.9659	0.0000	0.0165	0.0521	0.0000	0.0820	0.0005	0.0825	0.100927309	Design Good	Design Good



Gas Boilers Misc Support Calculations
By R. Murphy Date: 12/16/2007

Calculation Sheet

Project: BGCAPP
Job Number: 743341
Calc No: 24915-10-DBC-00-00004
Rev: D
Sheet No. 01-29 / D1-50

Joint Text	Output/Case Text	F3 Kip	M2 Kip-in	e in	σ_axial ksi	σ_bend ksi	σ_max ksi	σ_min ksi	ratio	stress_slope	σ_fat ksi	F_rect Kip	F_int Kip	M_rect Kip-in	M_int Kip-in	M_design Kip-in	ip in	d_check_plate	d_check_ped_beating
17	UDSTL1	3.4220	0.0003	0.0003	0.0236	0.0000	0.0236	0.0000	0.9997	0.0000	0.0236	0.1749	0.0000	0.1179	0.0000	0.1179	0.120653	Design Good	Design Good
17	UDSTL2	5.6050	0.0017	0.0003	0.0389	0.0000	0.0389	0.0000	0.9997	0.0000	0.0389	0.1226	0.0000	0.1931	0.0000	0.1931	0.154414	Design Good	Design Good
17	UDSTL3	2.5930	-0.0990	-0.0370	0.0183	0.0001	0.0183	0.0001	0.9937	0.0001	0.0182	0.0572	0.0003	0.0901	0.0006	0.0907	0.105819	Design Good	Design Good
17	UDSTL4	4.9430	0.0590	0.0200	0.0347	0.0003	0.0347	0.0003	0.9951	0.0001	0.0345	0.1086	0.0003	0.1711	0.0006	0.1717	0.145597	Design Good	Design Good
17	UDSTL5	2.5930	-0.1300	-0.0501	0.0180	0.0005	0.0185	0.0001	0.9511	0.0001	0.0182	0.0574	0.0004	0.0904	0.0000	0.0912	0.105101	Design Good	Design Good
17	UDSTL6	4.9430	0.1320	0.0267	0.0343	0.0005	0.0346	0.0003	0.9936	0.0001	0.0345	0.1086	0.0004	0.1714	0.0008	0.1722	0.145796	Design Good	Design Good
17	UDSTL7	3.2970	-15.0960	-4.5787	0.0229	0.0524	0.0919	-0.0230	-0.3920	0.0087	0.0478	0.1506	0.0433	0.2371	0.0910	0.3281	0.201272	Design Good	Design Good
17	UDSTL8	4.2380	15.0960	3.5625	0.0294	0.0524	0.0919	-0.0230	-0.2809	0.0087	0.0543	0.1711	0.0433	0.2696	0.0910	0.3608	0.210989	Design Good	Design Good
17	UDSTL9	4.2380	-15.0960	-3.5770	0.0293	0.0524	0.0917	-0.0231	0.2828	0.0087	0.0542	0.1707	0.0433	0.2699	0.0910	0.3599	0.210795	Design Good	Design Good
17	UDSTL10	3.1660	15.0960	4.5531	0.0230	0.0524	0.0755	-0.0294	-0.3968	0.0087	0.0479	0.1510	0.0433	0.2378	0.0910	0.3288	0.201482	Design Good	Design Good
17	UDSTL11	1.0250	-0.0970	-0.0946	0.0071	0.0003	0.0075	0.0068	0.9096	0.0001	0.0073	0.0229	0.0003	0.0361	0.0006	0.0367	0.067305	Design Good	Design Good
17	UDSTL12	3.7550	0.0980	0.0234	0.0003	0.0003	0.0236	0.0231	0.9714	0.0001	0.0236	0.0743	0.0003	0.1171	0.0006	0.1177	0.12053	Design Good	Design Good
17	UDSTL13	1.0250	-0.1300	-0.1268	0.0071	0.0005	0.0076	0.0067	0.8807	0.0001	0.0073	0.0231	0.0004	0.0364	0.0008	0.0372	0.067734	Design Good	Design Good
17	UDSTL14	3.3750	0.1310	0.0388	0.0234	0.0005	0.0239	0.0230	0.9819	0.0001	0.0237	0.0745	0.0004	0.1174	0.0008	0.1181	0.12077	Design Good	Design Good
17	UDSTL15	1.7290	-15.0960	-8.7311	0.0120	0.0524	0.0644	-0.0404	-0.6273	0.0087	0.0369	0.1163	0.0433	0.1831	0.0910	0.2741	0.163959	Design Good	Design Good
17	UDSTL16	2.6700	15.0960	5.6547	0.0185	0.0524	0.0710	-0.0339	-0.4774	0.0087	0.0434	0.1388	0.0433	0.2155	0.0910	0.3066	0.194543	Design Good	Design Good
17	UDSTL17	2.6510	-15.0960	-5.6645	0.0184	0.0524	0.0708	-0.0340	-0.4801	0.0087	0.0433	0.1394	0.0433	0.2149	0.0910	0.3059	0.194526	Design Good	Design Good
17	UDSTL18	1.7480	15.0970	8.6357	0.0121	0.0524	0.0646	-0.0403	-0.6239	0.0087	0.0370	0.1167	0.0433	0.1838	0.0910	0.2748	0.164784	Design Good	Design Good
17	UDSTL19	3.7690	-18.1950	-4.9266	0.0262	0.0632	0.0893	-0.0370	-0.4142	0.0105	0.0562	0.1770	0.0522	0.2787	0.1097	0.3694	0.218978	Design Good	Design Good
17	UDSTL20	3.7680	18.1970	4.8254	0.0262	0.0632	0.0894	-0.0370	-0.4143	0.0105	0.0562	0.1770	0.0522	0.2787	0.1097	0.3694	0.218986	Design Good	Design Good
17	UDSTL21	3.7680	-0.3000	-0.0080	0.0262	0.0001	0.0263	0.0261	0.9921	0.0000	0.0262	0.0826	0.0001	0.1301	0.0002	0.1302	0.126806	Design Good	Design Good
17	UDSTL22	3.7680	0.3020	0.0085	0.0262	0.0001	0.0263	0.0261	0.9915	0.0000	0.0262	0.0826	0.0001	0.1301	0.0002	0.1303	0.126802	Design Good	Design Good
17	UDSTL23	2.2000	-18.1950	-8.2705	0.0163	0.0632	0.0785	-0.0479	-0.6105	0.0105	0.0453	0.1427	0.0522	0.2247	0.1097	0.3344	0.203179	Design Good	Design Good
17	UDSTL24	2.2000	18.1970	8.2714	0.0163	0.0632	0.0785	-0.0479	-0.6106	0.0105	0.0453	0.1427	0.0522	0.2247	0.1097	0.3344	0.203188	Design Good	Design Good
17	UDSTL25	2.2000	-0.3000	-0.0136	0.0153	0.0001	0.0154	0.0152	0.9665	0.0000	0.0153	0.0483	0.0001	0.0760	0.0002	0.0762	0.097007	Design Good	Design Good
17	UDSTL26	2.2000	0.3020	0.0145	0.0153	0.0001	0.0154	0.0152	0.9656	0.0000	0.0153	0.0483	0.0001	0.0761	0.0002	0.0763	0.097025	Design Good	Design Good
17	UDSTL27	3.7680	57.5510	15.2736	0.0262	0.1998	0.2260	-0.1737	-0.7684	0.0333	0.1211	0.3814	0.1652	0.6007	0.3470	0.9477	0.342058	Design Good	Design Good
17	UDSTL28	3.7680	-57.5480	-15.2728	0.0262	0.1998	0.2260	-0.1737	-0.7684	0.0333	0.1211	0.3814	0.1652	0.6007	0.3470	0.9477	0.342058	Design Good	Design Good
17	UDSTL29	3.7720	0.1210	0.0321	0.0262	0.0004	0.0266	0.0258	0.9684	0.0001	0.0264	0.0831	0.0003	0.1309	0.0007	0.1317	0.127501	Design Good	Design Good
17	UDSTL30	3.7640	-0.1180	-0.0313	0.0261	0.0004	0.0265	0.0257	0.9691	0.0001	0.0263	0.0830	0.0003	0.1306	0.0007	0.1314	0.127346	Design Good	Design Good
17	UDSTL31	2.2000	57.5500	26.1591	0.0153	0.1998	0.2151	-0.1845	-0.8579	0.0333	0.1102	0.3471	0.1652	0.5467	0.3470	0.8937	0.332163	Design Good	Design Good
17	UDSTL32	2.2000	-57.5490	-26.1586	0.0153	0.1998	0.2151	-0.1845	-0.8579	0.0333	0.1102	0.3471	0.1652	0.5467	0.3470	0.8937	0.332161	Design Good	Design Good
17	UDSTL33	2.2030	0.1200	0.0545	0.0153	0.0004	0.0157	0.0149	0.9470	0.0001	0.0156	0.0488	0.0003	0.0769	0.0007	0.0776	0.097882	Design Good	Design Good
17	UDSTL34	2.1960	-0.1190	-0.0542	0.0153	0.0004	0.0157	0.0148	0.9472	0.0001	0.0154	0.0487	0.0003	0.0766	0.0007	0.0774	0.097721	Design Good	Design Good



Gas Bottles Misc Support Calculations
By R. Murphy Date: 12/16/2007

Calculation Sheet

Project: BGCAPP
Job Number: 743341
Calc No: 24915-10-DBC-00-00004
Rev. D
Sheet No. D1-30 / D1-60

Anchor Bolt: Tension Design

N plate (in)	B plate (in)	xa (in)	N prime (in)	A prime (in)	e kern	φ	N design
12	12	1.5	10.5	4.5	2	0.85	14.82528

φN	Nsa (kip)	Ncgb (kip)	Npn (kip)	Nsb (kip)
	one anchor	two anchors	one anchor	one anchor
	77.6	34.863	20.93	36.83
	65.96	29.65055	17.1905	31.3055

←reduced by phi factor

Joint Text	OutputCase Text	F3 kip	M1 kip-in	e in	ip	anchor_tension	f_prime	A_plus	A_minus	A_final	T_anchors Kips	T_one_anchor Kips	Nsa check	Ncgb check	Nsb check	Npn check
14	UDSTL1	2.0860	-1.8110	-0.6766	0.0206	Anchor bolts not in tension	XXXX	XXXX	XXXX	XXXX	XXXX	XXXX	XXXX	XXXX	XXXX	XXXX
14	UDSTL2	3.2560	-1.5510	-0.4759	0.0280	Anchor bolts not in tension	XXXX	XXXX	XXXX	XXXX	XXXX	XXXX	XXXX	XXXX	XXXX	XXXX
14	UDSTL3	1.5820	62.4710	39.4886	0.2279	Anchor bolts in tension	14.3577	25.5165	5.9835	3.2999	3.2999	3.2999	Design OK	Design OK	Design OK	Design OK
14	UDSTL4	2.8900	-65.5750	-22.6903	0.2478	Anchor bolts in tension	15.6089	34.5690	-3.0690	3.0690	1.6722	1.6722	Design OK	Design OK	Design OK	Design OK
14	UDSTL5	1.5920	76.2240	48.1820	0.2757	Anchor bolts in tension	17.3661	25.5932	5.9068	5.9068	8.1874	4.0937	Design OK	Design OK	Design OK	Design OK
14	UDSTL6	2.8900	-79.3280	-27.4491	0.2955	Anchor bolts in tension	18.6174	34.7310	-3.2310	3.2310	2.8389	1.4194	Design OK	Design OK	Design OK	Design OK
14	UDSTL7	1.6560	-1.5390	-0.9277	0.0166	Anchor bolts not in tension	XXXX	XXXX	XXXX	XXXX	XXXX	XXXX	XXXX	XXXX	XXXX	XXXX
14	UDSTL8	2.8130	-1.5650	-0.5563	0.0250	Anchor bolts not in tension	XXXX	XXXX	XXXX	XXXX	XXXX	XXXX	XXXX	XXXX	XXXX	XXXX
14	UDSTL9	2.7940	-1.5390	-0.5508	0.0247	Anchor bolts not in tension	XXXX	XXXX	XXXX	XXXX	XXXX	XXXX	XXXX	XXXX	XXXX	XXXX
14	UDSTL10	1.6780	-1.5650	-0.9327	0.0171	Anchor bolts not in tension	XXXX	XXXX	XXXX	XXXX	XXXX	XXXX	XXXX	XXXX	XXXX	XXXX
14	UDSTL11	0.6740	62.9590	93.2626	0.2228	Anchor bolts in tension	14.0453	25.7642	5.7358	5.7358	6.9985	3.4993	Design OK	Design OK	Design OK	Design OK
14	UDSTL12	1.9830	-65.1870	-32.8729	0.2401	Anchor bolts in tension	15.1272	34.8608	-3.3608	3.3608	2.8588	1.4294	Design OK	Design OK	Design OK	Design OK
14	UDSTL13	0.6740	76.6120	113.6677	0.2707	Anchor bolts in tension	17.0538	25.7974	5.7026	5.7026	8.5880	4.2940	Design OK	Design OK	Design OK	Design OK
14	UDSTL14	1.9830	-78.9410	-39.8089	0.2879	Anchor bolts in tension	18.1359	34.9769	-3.4769	3.4769	3.4769	2.0112	Design OK	Design OK	Design OK	Design OK
14	UDSTL15	0.7510	-1.1510	-1.5326	0.0092	Anchor bolts not in tension	XXXX	XXXX	XXXX	XXXX	XXXX	XXXX	XXXX	XXXX	XXXX	XXXX
14	UDSTL16	1.9060	-1.1770	-0.6175	0.0173	Anchor bolts not in tension	XXXX	XXXX	XXXX	XXXX	XXXX	XXXX	XXXX	XXXX	XXXX	XXXX
14	UDSTL17	1.8860	-1.1510	-0.6103	0.0171	Anchor bolts not in tension	XXXX	XXXX	XXXX	XXXX	XXXX	XXXX	XXXX	XXXX	XXXX	XXXX
14	UDSTL18	0.7700	-1.1770	-1.5286	0.0094	Anchor bolts not in tension	XXXX	XXXX	XXXX	XXXX	XXXX	XXXX	XXXX	XXXX	XXXX	XXXX
14	UDSTL19	2.2360	-1.6800	-0.7513	0.0214	Anchor bolts not in tension	XXXX	XXXX	XXXX	XXXX	XXXX	XXXX	XXXX	XXXX	XXXX	XXXX
14	UDSTL20	2.2360	-1.4240	-0.6389	0.0205	Anchor bolts not in tension	XXXX	XXXX	XXXX	XXXX	XXXX	XXXX	XXXX	XXXX	XXXX	XXXX
14	UDSTL21	2.2360	16.9160	7.5653	0.0743	Anchor bolts in tension	4.6786	23.9002	7.5998	7.5998	1.1503	0.5752	Design OK	Design OK	Design OK	Design OK
14	UDSTL22	2.2360	-20.0200	-8.9535	0.0650	Anchor bolts in tension	5.3576	33.2803	-1.7503	1.7503	-1.3378	-0.6688	Design OK	Design OK	Design OK	Design OK
14	UDSTL23	1.3280	-1.2920	-0.9729	0.0137	Anchor bolts not in tension	XXXX	XXXX	XXXX	XXXX	XXXX	XXXX	XXXX	XXXX	XXXX	XXXX
14	UDSTL24	1.3280	-1.0360	-0.7801	0.0128	Anchor bolts not in tension	XXXX	XXXX	XXXX	XXXX	XXXX	XXXX	XXXX	XXXX	XXXX	XXXX
14	UDSTL25	1.3280	17.3040	13.0301	0.0693	Anchor bolts in tension	4.3663	24.7005	6.7995	6.7995	1.4995	0.7497	Design OK	Design OK	Design OK	Design OK
14	UDSTL26	1.3280	-19.6320	-14.7831	0.0774	Anchor bolts in tension	4.8755	34.0883	-2.5683	2.5683	-0.1262	-0.0631	Design OK	Design OK	Design OK	Design OK
14	UDSTL27	2.2360	-0.8200	-0.3667	0.0184	Anchor bolts not in tension	XXXX	XXXX	XXXX	XXXX	XXXX	XXXX	XXXX	XXXX	XXXX	XXXX
14	UDSTL27	2.2360	-2.2840	-1.0215	0.0235	Anchor bolts not in tension	XXXX	XXXX	XXXX	XXXX	XXXX	XXXX	XXXX	XXXX	XXXX	XXXX
14	UDSTL28	2.2400	58.4910	26.1121	0.2185	Anchor bolts in tension	13.7749	25.3028	6.1972	6.1972	5.8900	2.9450	Design OK	Design OK	Design OK	Design OK
14	UDSTL28	2.2320	-61.5950	-27.5963	0.2294	Anchor bolts in tension	14.4504	34.7352	-3.2352	3.2352	2.2203	1.1102	Design OK	Design OK	Design OK	Design OK
14	UDSTL28	1.3280	-0.4320	-0.3253	0.0107	Anchor bolts not in tension	XXXX	XXXX	XXXX	XXXX	XXXX	XXXX	XXXX	XXXX	XXXX	XXXX
14	UDSTL29	1.3280	-1.8960	-1.4277	0.0158	Anchor bolts not in tension	XXXX	XXXX	XXXX	XXXX	XXXX	XXXX	XXXX	XXXX	XXXX	XXXX
14	UDSTL30	1.3330	58.8790	44.1703	0.2137	Anchor bolts in tension	13.4630	25.5615	5.9385	5.9385	6.2813	3.1406	Design OK	Design OK	Design OK	Design OK
14	UDSTL30	1.3240	-61.2070	-46.2289	0.2217	Anchor bolts in tension	13.9683	35.0543	-3.5543	3.5543	3.4043	1.7021	Design OK	Design OK	Design OK	Design OK



Gas Bolts Misc Support Calculations
By R. Murphy Date: 12/16/2007

Calculation Sheet

Project: BGCAPP
Job Number: 743341
Calc No: 24915-10-DBC-00-00004
Rev. D
Sheet No. D1-32 / D1-60

Anchor Bolt: Tension Design

N.plate (in)	B.plate (in)	x.a (in)	N.plate (in)	A.plate (in)	e.kern	φ	N.design
12	12	1.5	10.5	4.5	2	0.65	14.82528

Nsa (kip)	Ncbg (kip)	Npn (kip)	Nsb (kip)
one anchor	two anchors	one anchor	one anchor
77.6	34.883	20.928	36.83
ΦN	65.95	17.7888	31.3055

<--reduced by phi factor

<--one anchor

Joint Text	Output/Case	F3 Kip	M1 Kip-in	e in	fp	anchor tension	t,prime	A,plus	A,minus	A,final	T,anchors Kips	T,one anchor Kips	Nsa check	Ncbg check	Nsb check	Npn check
15	UDSTL1	1.5070	-1.5000	-0.8301	0.0178	Anchor bolts not in tension	XXXX	XXXX	XXXX	XXXX	XXXX	XXXX	XXXX	XXXX	XXXX	XXXX
15	UDSTL2	2.7810	-1.2860	-0.4624	0.0238	Anchor bolts not in tension	XXXX	XXXX	XXXX	XXXX	XXXX	XXXX	XXXX	XXXX	XXXX	XXXX
15	UDSTL3	1.3920	56.9800	40.9339	0.2075	Anchor bolts in tension	13.0734	25.5315	5.9685	6.0393	6.0393	3.0196	Design OK	Design OK	Design OK	Design OK
15	UDSTL4	2.4760	-59.5520	-24.0517	0.2240	Anchor bolts in tension	14.1103	34.6215	-3.1215	3.1215	1.7188	0.8594	Design OK	Design OK	Design OK	Design OK
15	UDSTL5	1.3920	69.6610	50.0438	0.2515	Anchor bolts in tension	15.8473	25.6062	5.8936	5.8936	7.5033	3.7516	Design OK	Design OK	Design OK	Design OK
15	UDSTL6	2.4760	-72.2330	-29.1753	0.2680	Anchor bolts in tension	15.8842	34.7773	-3.2773	3.2773	2.7939	1.3970	Design OK	Design OK	Design OK	Design OK
15	UDSTL7	1.7430	-1.2490	-0.7166	0.0164	Anchor bolts not in tension	XXXX	XXXX	XXXX	XXXX	XXXX	XXXX	XXXX	XXXX	XXXX	XXXX
15	UDSTL8	2.1250	-1.2490	-0.6226	0.0194	Anchor bolts not in tension	XXXX	XXXX	XXXX	XXXX	XXXX	XXXX	XXXX	XXXX	XXXX	XXXX
15	UDSTL9	2.1250	-1.2490	-0.5878	0.0191	Anchor bolts not in tension	XXXX	XXXX	XXXX	XXXX	XXXX	XXXX	XXXX	XXXX	XXXX	XXXX
15	UDSTL10	1.7430	-1.3230	-0.7590	0.0167	Anchor bolts not in tension	XXXX	XXXX	XXXX	XXXX	XXXX	XXXX	XXXX	XXXX	XXXX	XXXX
15	UDSTL11	0.8200	57.3020	92.4226	0.2033	Anchor bolts in tension	12.8061	25.7625	5.7375	5.7375	6.3776	3.1888	Design OK	Design OK	Design OK	Design OK
15	UDSTL12	1.7040	-59.2310	-34.7600	0.2175	Anchor bolts in tension	13.7023	34.8968	-3.3968	3.3968	2.7288	1.3644	Design OK	Design OK	Design OK	Design OK
15	UDSTL13	0.6200	69.8830	112.8758	0.2473	Anchor bolts in tension	15.5800	25.7963	5.7037	5.7037	7.8432	3.9216	Design OK	Design OK	Design OK	Design OK
15	UDSTL14	1.7040	-71.9110	-42.2013	0.2615	Anchor bolts in tension	16.4760	35.0084	-3.5084	3.5084	3.8012	1.9006	Design OK	Design OK	Design OK	Design OK
15	UDSTL15	0.9710	-0.9280	-0.9557	0.0100	Anchor bolts not in tension	XXXX	XXXX	XXXX	XXXX	XXXX	XXXX	XXXX	XXXX	XXXX	XXXX
15	UDSTL16	1.3530	-1.0010	-0.7398	0.0129	Anchor bolts not in tension	XXXX	XXXX	XXXX	XXXX	XXXX	XXXX	XXXX	XXXX	XXXX	XXXX
15	UDSTL17	1.3530	-0.9280	-0.6859	0.0126	Anchor bolts not in tension	XXXX	XXXX	XXXX	XXXX	XXXX	XXXX	XXXX	XXXX	XXXX	XXXX
15	UDSTL18	0.9710	-1.0010	-1.0309	0.0102	Anchor bolts not in tension	XXXX	XXXX	XXXX	XXXX	XXXX	XXXX	XXXX	XXXX	XXXX	XXXX
15	UDSTL19	1.9340	-1.1720	-0.6060	0.0175	Anchor bolts not in tension	XXXX	XXXX	XXXX	XXXX	XXXX	XXXX	XXXX	XXXX	XXXX	XXXX
15	UDSTL20	1.9340	-1.4000	-0.7239	0.0183	Anchor bolts not in tension	XXXX	XXXX	XXXX	XXXX	XXXX	XXXX	XXXX	XXXX	XXXX	XXXX
15	UDSTL21	1.9340	15.7170	8.1267	0.0680	Anchor bolts in tension	4.2842	24.0272	7.4728	7.4728	1.1150	0.5575	Design OK	Design OK	Design OK	Design OK
15	UDSTL22	1.9340	-18.2690	-9.4566	0.0769	Anchor bolts in tension	4.8468	33.3671	-1.8671	1.8671	-1.0721	-0.5361	Design OK	Design OK	Design OK	Design OK
15	UDSTL23	1.1620	-0.8510	-0.7324	0.0110	Anchor bolts not in tension	XXXX	XXXX	XXXX	XXXX	XXXX	XXXX	XXXX	XXXX	XXXX	XXXX
15	UDSTL24	1.1620	-1.0780	-0.9277	0.0118	Anchor bolts not in tension	XXXX	XXXX	XXXX	XXXX	XXXX	XXXX	XXXX	XXXX	XXXX	XXXX
15	UDSTL25	1.1620	16.0390	13.8029	0.0638	Anchor bolts in tension	4.0169	24.7656	6.7344	6.7344	1.4143	0.7072	Design OK	Design OK	Design OK	Design OK
15	UDSTL26	1.1620	-17.9680	-15.4630	0.0705	Anchor bolts in tension	4.4389	34.1474	-2.6474	2.6474	-0.0428	-0.0214	Design OK	Design OK	Design OK	Design OK
15	UDSTL27	1.9340	-0.5730	-0.2963	0.0154	Anchor bolts not in tension	XXXX	XXXX	XXXX	XXXX	XXXX	XXXX	XXXX	XXXX	XXXX	XXXX
15	UDSTL28	1.9340	-1.9990	-1.0336	0.0204	Anchor bolts not in tension	XXXX	XXXX	XXXX	XXXX	XXXX	XXXX	XXXX	XXXX	XXXX	XXXX
15	UDSTL29	1.9340	47.7560	24.6546	0.1793	Anchor bolts in tension	11.2941	25.2661	6.2339	6.2339	4.7683	2.3842	Design OK	Design OK	Design OK	Design OK
15	UDSTL30	1.1620	-50.3280	-26.0632	0.1882	Anchor bolts in tension	11.8541	34.6896	-3.1896	3.1896	1.6899	0.8350	Design OK	Design OK	Design OK	Design OK
15	UDSTL31	1.1620	-0.2520	-0.2169	0.0089	Anchor bolts not in tension	XXXX	XXXX	XXXX	XXXX	XXXX	XXXX	XXXX	XXXX	XXXX	XXXX
15	UDSTL32	1.1620	-1.6770	-1.4432	0.0139	Anchor bolts not in tension	XXXX	XXXX	XXXX	XXXX	XXXX	XXXX	XXXX	XXXX	XXXX	XXXX
15	UDSTL33	1.1650	48.0770	41.2678	0.1750	Anchor bolts in tension	11.0255	25.5348	5.9652	5.9652	5.0993	2.5497	Design OK	Design OK	Design OK	Design OK
15	UDSTL34	1.1590	-50.0060	-43.1458	0.1817	Anchor bolts in tension	11.4459	35.0199	-3.5199	3.5199	2.6780	1.3390	Design OK	Design OK	Design OK	Design OK



Gas Bottles Misc Support Calculations
By R. Murphy Date: 12/16/2007

Calculation Sheet

Project: BGCAPP
Job Number: 743341
Calc No: 24915-10-DBC-00-00004
Rev D
Sheet No. D1-34 / D1-60

Anchor Bolt: Tension Design

N.plate (in)	B.plate (in)	x.a (in)	N.p. (in)	A.p. (in)	e.kern	φ	N.design
12	12	1.5	10.5	4.5	2	0.75	13,081.13

Nsa (kip)	Nsb (kip)	Npn (kip)	Nsb (kip)
77.6	34.853	20.93	36.83
58.2	26.18225	15.6975	27.8225

←--reduced by phi factor

Joint Text	OutputCase Text	F3 Kip	M1 Kip-in	a in	fp	anchor tension	f.p. (ksi)	A.plus	A.minus	A.final	T anchors Kips	Ncbg (kip) two anchors	Nsa (kip) one anchor	Npn (kip) one anchor	Nsb (kip) one anchor	Npn check	Nsb check	Npn check
16	UDSTL1	3.6800	-1.8570	-0.4503	0.0313	Anchor bolts not in tension	XXXX	XXXX	XXXX	XXXX	XXXX	XXXX	XXXX	XXXX	XXXX	XXXX	XXXX	XXXX
16	UDSTL2	6.0830	-1.4200	-0.2334	0.0472	Anchor bolts not in tension	XXXX	XXXX	XXXX	XXXX	XXXX	XXXX	XXXX	XXXX	XXXX	XXXX	XXXX	XXXX
16	UDSTL3	2.7820	66.4750	23.8947	0.2501	Anchor bolts in tension	15.7585	25.2453	6.2547	6.2547	6.6052	3.3026	Design OK	Design OK	Design OK	Design OK	Design OK	
16	UDSTL4	5.3570	-69.3150	-12.9391	0.2778	Anchor bolts in tension	17.5063	33.8986	-2.3996	2.3996	-1.3562	-0.8781	Design OK	Design OK	Design OK	Design OK	Design OK	
16	UDSTL5	2.7820	76.5160	27.5047	0.2850	Anchor bolts in tension	17.9554	25.3344	6.1656	6.1656	7.7614	3.8907	Design OK	Design OK	Design OK	Design OK	Design OK	
16	UDSTL6	5.3570	-79.3550	-14.8141	0.3128	Anchor bolts in tension	19.7035	34.0511	-2.5911	2.5911	-0.4948	-0.2474	Design OK	Design OK	Design OK	Design OK	Design OK	
16	UDSTL7	3.1780	-1.4230	-0.4478	0.0270	Anchor bolts not in tension	XXXX	XXXX	XXXX	XXXX	XXXX	XXXX	XXXX	XXXX	XXXX	XXXX	XXXX	XXXX
16	UDSTL8	4.9610	-1.4180	-0.2858	0.0394	Anchor bolts not in tension	XXXX	XXXX	XXXX	XXXX	XXXX	XXXX	XXXX	XXXX	XXXX	XXXX	XXXX	XXXX
16	UDSTL9	4.8470	-1.4220	-0.2934	0.0386	Anchor bolts not in tension	XXXX	XXXX	XXXX	XXXX	XXXX	XXXX	XXXX	XXXX	XXXX	XXXX	XXXX	XXXX
16	UDSTL10	3.2920	-1.4180	-0.4307	0.0278	Anchor bolts not in tension	XXXX	XXXX	XXXX	XXXX	XXXX	XXXX	XXXX	XXXX	XXXX	XXXX	XXXX	XXXX
16	UDSTL11	1.0780	66.8300	61.9944	0.2395	Anchor bolts in tension	15.0907	25.6715	5.8285	5.8285	7.2987	3.6494	Design OK	Design OK	Design OK	Design OK	Design OK	
16	UDSTL12	3.6530	-68.9600	-18.6776	0.2648	Anchor bolts in tension	16.8832	34.3841	-2.8841	2.8841	0.9295	0.4647	Design OK	Design OK	Design OK	Design OK	Design OK	
16	UDSTL13	1.0780	76.8730	71.3108	0.2744	Anchor bolts in tension	17.2876	25.7075	5.7925	5.7925	8.4590	4.2295	Design OK	Design OK	Design OK	Design OK	Design OK	
16	UDSTL14	3.6540	-79.0040	-21.6212	0.2997	Anchor bolts in tension	16.8908	34.5233	-3.0233	3.0233	1.7824	0.8912	Design OK	Design OK	Design OK	Design OK	Design OK	
16	UDSTL15	1.4740	-1.0680	-0.7246	0.0139	Anchor bolts not in tension	XXXX	XXXX	XXXX	XXXX	XXXX	XXXX	XXXX	XXXX	XXXX	XXXX	XXXX	XXXX
16	UDSTL16	3.2570	-1.0630	-0.3264	0.0263	Anchor bolts not in tension	XXXX	XXXX	XXXX	XXXX	XXXX	XXXX	XXXX	XXXX	XXXX	XXXX	XXXX	XXXX
16	UDSTL17	3.1440	-1.0680	-0.3397	0.0255	Anchor bolts not in tension	XXXX	XXXX	XXXX	XXXX	XXXX	XXXX	XXXX	XXXX	XXXX	XXXX	XXXX	XXXX
16	UDSTL18	1.5880	-1.0630	-0.6594	0.0147	Anchor bolts not in tension	XXXX	XXXX	XXXX	XXXX	XXXX	XXXX	XXXX	XXXX	XXXX	XXXX	XXXX	XXXX
16	UDSTL19	4.0700	-1.3500	-0.3317	0.0330	Anchor bolts not in tension	XXXX	XXXX	XXXX	XXXX	XXXX	XXXX	XXXX	XXXX	XXXX	XXXX	XXXX	XXXX
16	UDSTL20	4.0700	-1.4910	-0.3663	0.0334	Anchor bolts not in tension	XXXX	XXXX	XXXX	XXXX	XXXX	XXXX	XXXX	XXXX	XXXX	XXXX	XXXX	XXXX
16	UDSTL21	4.0700	17.5460	4.3111	0.0892	Anchor bolts in tension	5.6188	22.8071	8.8929	8.8929	0.6888	0.3444	Design OK	Design OK	Design OK	Design OK	Design OK	
16	UDSTL22	4.0700	-20.3870	-5.0091	0.0991	Anchor bolts in tension	6.2403	31.9286	-0.3286	0.3286	-3.8747	-1.9374	Design OK	Design OK	Design OK	Design OK	Design OK	
16	UDSTL23	2.3660	-0.9950	-0.4205	0.0198	Anchor bolts not in tension	XXXX	XXXX	XXXX	XXXX	XXXX	XXXX	XXXX	XXXX	XXXX	XXXX	XXXX	XXXX
16	UDSTL24	2.3660	-1.1360	-0.4801	0.0204	Anchor bolts not in tension	XXXX	XXXX	XXXX	XXXX	XXXX	XXXX	XXXX	XXXX	XXXX	XXXX	XXXX	XXXX
16	UDSTL25	2.3660	17.9010	7.5659	0.0786	Anchor bolts in tension	4.9510	23.9004	7.5996	7.5996	1.2174	0.6087	Design OK	Design OK	Design OK	Design OK	Design OK	
16	UDSTL26	2.3660	-20.0320	-6.4666	0.0860	Anchor bolts in tension	5.4171	33.1464	-1.8464	1.8464	-1.5166	-0.7583	Design OK	Design OK	Design OK	Design OK	Design OK	
16	UDSTL27	4.0700	-1.5980	-0.3926	0.0338	Anchor bolts not in tension	XXXX	XXXX	XXXX	XXXX	XXXX	XXXX	XXXX	XXXX	XXXX	XXXX	XXXX	XXXX
16	UDSTL28	4.0750	56.4780	13.8596	0.2244	Anchor bolts in tension	14.1374	24.7702	5.7298	6.7298	4.9852	2.4931	Design OK	Design OK	Design OK	Design OK	Design OK	
16	UDSTL28	4.0650	-59.3180	-14.5924	0.2342	Anchor bolts in tension	14.7543	34.0708	-2.5708	2.5708	-0.4526	-0.2263	Design OK	Design OK	Design OK	Design OK	Design OK	
16	UDSTL29	2.3660	-0.8880	-0.3753	0.0195	Anchor bolts not in tension	XXXX	XXXX	XXXX	XXXX	XXXX	XXXX	XXXX	XXXX	XXXX	XXXX	XXXX	XXXX
16	UDSTL29	2.3660	-1.2430	-0.5254	0.0207	Anchor bolts not in tension	XXXX	XXXX	XXXX	XXXX	XXXX	XXXX	XXXX	XXXX	XXXX	XXXX	XXXX	XXXX
16	UDSTL30	2.3710	56.8330	23.9701	0.2138	Anchor bolts in tension	13.4689	25.2474	6.2526	6.2526	5.6499	2.8250	Design OK	Design OK	Design OK	Design OK	Design OK	
16	UDSTL30	2.3610	-58.9630	-24.9737	0.2211	Anchor bolts in tension	13.9311	34.8540	-3.1540	3.1540	1.8237	0.9118	Design OK	Design OK	Design OK	Design OK	Design OK	



Gas Bolts Misc Support Calculations
By R. Murphy Date: 12/16/2007

Calculation Sheet

Project: BGCAPP
Job Number: 743341
Calc No: 24915-10-DBC-00-00004
Rev D
Sheet No. D1-35 / D1-50

Anchor Bolt: Tension Design

N.plate (in)	B.plate (in)	x.a (in)	N.prime (in)	A.prime (in)	e.kern	φ	N.design
12	12	1.5	10.5	4.5	2	0.75	13,081.13

Nsa (kip)	Ncbg (kip)	Npn (kip)	Nsb (kip)
one anchor	two anchors	one anchor	one anchor
77.6	34.883	20.93	36.83
φN	59.2	15.6875	27.6225

← one anchor

← reduced by phi factor

Joint Text	OutputCase	F3	M1	a	fp	anchor tension	f.prime	A.plus	A.minus	A.final	T anchors	T one anchor	Nsa check	Ncbg check	Npn check	Nsb check	Npn check
	Text	Kip	Kip-in	in							Kips	Kips	one anchor	two anchors	one anchor	one anchor	one anchor
17	UDSTL1	3.4220	-1.6320	-0.4769	0.0294	Anchor bolts not in tension	XXXX	XXXX	XXXX	XXXX	XXXX	XXXX	XXXX	XXXX	XXXX	XXXX	XXXX
17	UDSTL2	5.6050	-1.4000	-0.2498	0.0438	Anchor bolts not in tension	XXXX	XXXX	XXXX	XXXX	XXXX	XXXX	XXXX	XXXX	XXXX	XXXX	XXXX
17	UDSTL3	2.9930	63.7230	24.5750	0.2393	Anchor bolts in tension	15.0738	25.2640	6.2360	6.2360	6.3594	3.1797	Design OK	Design OK	Design OK	Design OK	Design OK
17	UDSTL4	4.9430	-66.5210	-13.4576	0.2853	Anchor bolts in tension	16.7140	33.9574	-2.4574	-2.4574	-1.0313	-0.5156	Design OK	Design OK	Design OK	Design OK	Design OK
17	UDSTL5	2.5930	73.7310	28.4346	0.2740	Anchor bolts in tension	17.2631	25.3598	6.1462	6.1462	7.5119	3.7560	Design OK	Design OK	Design OK	Design OK	Design OK
17	UDSTL6	4.9430	-76.5290	-15.4823	0.3001	Anchor bolts in tension	18.9033	34.1490	-2.6490	-2.6490	-0.1740	-0.0870	Design OK	Design OK	Design OK	Design OK	Design OK
17	UDSTL7	3.2970	-1.4480	-0.4386	0.0279	Anchor bolts not in tension	XXXX	XXXX	XXXX	XXXX	XXXX	XXXX	XXXX	XXXX	XXXX	XXXX	XXXX
17	UDSTL8	4.2380	-1.3520	-0.3190	0.0341	Anchor bolts not in tension	XXXX	XXXX	XXXX	XXXX	XXXX	XXXX	XXXX	XXXX	XXXX	XXXX	XXXX
17	UDSTL9	4.2200	-1.4470	-0.3429	0.0343	Anchor bolts not in tension	XXXX	XXXX	XXXX	XXXX	XXXX	XXXX	XXXX	XXXX	XXXX	XXXX	XXXX
17	UDSTL10	3.3160	-1.3510	-0.4074	0.0277	Anchor bolts not in tension	XXXX	XXXX	XXXX	XXXX	XXXX	XXXX	XXXX	XXXX	XXXX	XXXX	XXXX
17	UDSTL11	1.0250	64.0730	62.5102	0.2296	Anchor bolts in tension	14.4644	25.6738	5.8262	5.8262	7.0009	3.5005	Design OK	Design OK	Design OK	Design OK	Design OK
17	UDSTL12	3.3750	-66.1710	-19.6062	0.2532	Anchor bolts in tension	15.9515	34.4246	-2.9246	-2.9246	1.0681	0.5340	Design OK	Design OK	Design OK	Design OK	Design OK
17	UDSTL13	1.0250	74.0810	72.2741	0.2843	Anchor bolts in tension	16.6537	25.7107	5.7893	5.7893	8.1572	4.0786	Design OK	Design OK	Design OK	Design OK	Design OK
17	UDSTL14	3.3750	-76.1790	-22.5716	0.2879	Anchor bolts in tension	18.1407	34.5641	-3.0641	-3.0641	1.9188	0.9594	Design OK	Design OK	Design OK	Design OK	Design OK
17	UDSTL15	1.2790	-1.0960	-0.6339	0.0158	Anchor bolts not in tension	XXXX	XXXX	XXXX	XXXX	XXXX	XXXX	XXXX	XXXX	XXXX	XXXX	XXXX
17	UDSTL16	2.6700	-1.0020	-0.3753	0.0220	Anchor bolts not in tension	XXXX	XXXX	XXXX	XXXX	XXXX	XXXX	XXXX	XXXX	XXXX	XXXX	XXXX
17	UDSTL17	2.6510	-1.0970	-0.4138	0.0222	Anchor bolts not in tension	XXXX	XXXX	XXXX	XXXX	XXXX	XXXX	XXXX	XXXX	XXXX	XXXX	XXXX
17	UDSTL18	1.7480	-1.0010	-0.5727	0.0156	Anchor bolts not in tension	XXXX	XXXX	XXXX	XXXX	XXXX	XXXX	XXXX	XXXX	XXXX	XXXX	XXXX
17	UDSTL19	3.7680	-1.4550	-0.3961	0.0312	Anchor bolts not in tension	XXXX	XXXX	XXXX	XXXX	XXXX	XXXX	XXXX	XXXX	XXXX	XXXX	XXXX
17	UDSTL20	3.7680	-1.3430	-0.3564	0.0308	Anchor bolts not in tension	XXXX	XXXX	XXXX	XXXX	XXXX	XXXX	XXXX	XXXX	XXXX	XXXX	XXXX
17	UDSTL21	3.7680	16.9140	4.4889	0.0849	Anchor bolts in tension	5.3484	22.7201	8.7799	8.7799	0.7042	0.3521	Design OK	Design OK	Design OK	Design OK	Design OK
17	UDSTL22	3.7680	-19.7120	-5.2314	0.0946	Anchor bolts in tension	5.9605	31.9558	-0.4558	-0.4558	-3.5093	-1.7546	Design OK	Design OK	Design OK	Design OK	Design OK
17	UDSTL23	2.2000	-1.1050	-0.5023	0.0191	Anchor bolts not in tension	XXXX	XXXX	XXXX	XXXX	XXXX	XXXX	XXXX	XXXX	XXXX	XXXX	XXXX
17	UDSTL24	2.2000	-0.9930	-0.4514	0.0187	Anchor bolts not in tension	XXXX	XXXX	XXXX	XXXX	XXXX	XXXX	XXXX	XXXX	XXXX	XXXX	XXXX
17	UDSTL25	2.2000	17.2640	7.8473	0.0752	Anchor bolts in tension	4.7390	23.9661	7.5339	7.5339	1.2003	0.6002	Design OK	Design OK	Design OK	Design OK	Design OK
17	UDSTL26	2.2000	-19.3620	-8.8009	0.0825	Anchor bolts in tension	5.1979	33.2258	-1.7258	-1.7258	-1.3457	-0.6728	Design OK	Design OK	Design OK	Design OK	Design OK
17	UDSTL27	3.7680	-1.2420	-0.3296	0.0305	Anchor bolts not in tension	XXXX	XXXX	XXXX	XXXX	XXXX	XXXX	XXXX	XXXX	XXXX	XXXX	XXXX
17	UDSTL28	3.7680	-1.5560	-0.4130	0.0316	Anchor bolts not in tension	XXXX	XXXX	XXXX	XXXX	XXXX	XXXX	XXXX	XXXX	XXXX	XXXX	XXXX
17	UDSTL29	3.7720	52.3950	13.8905	0.2081	Anchor bolts in tension	13.1117	24.7725	6.7274	6.7274	4.6287	2.3143	Design OK	Design OK	Design OK	Design OK	Design OK
17	UDSTL28	3.7640	-55.1930	-14.6634	0.2178	Anchor bolts in tension	13.7202	34.0773	-2.5773	-2.5773	-0.3962	-0.1991	Design OK	Design OK	Design OK	Design OK	Design OK
17	UDSTL29	2.2000	-0.9910	-0.4050	0.0184	Anchor bolts not in tension	XXXX	XXXX	XXXX	XXXX	XXXX	XXXX	XXXX	XXXX	XXXX	XXXX	XXXX
17	UDSTL28	2.2000	-1.2060	-0.5482	0.0195	Anchor bolts not in tension	XXXX	XXXX	XXXX	XXXX	XXXX	XXXX	XXXX	XXXX	XXXX	XXXX	XXXX
17	UDSTL30	2.2030	52.7450	23.9424	0.1984	Anchor bolts in tension	12.5018	25.2466	6.2534	6.2534	5.2426	2.6213	Design OK	Design OK	Design OK	Design OK	Design OK
17	UDSTL30	2.1960	-54.8430	-24.9740	0.2057	Anchor bolts in tension	12.9577	34.8540	-3.1540	-3.1540	3.1540	0.8481	Design OK	Design OK	Design OK	Design OK	Design OK



Gas Boilies Misc Support Calculations
By R. Murphy Date: 12/16/2007

Calculation Sheet

Project: BGCAPP
Job Number: 743341
Calc No: 24915-10-DBC-00-00004
Rev D
Sheet No. D1-37 / D1-60

Joint Text	Output/Case	F3 Kip	M2 Kip-in	e in	fp	anchor tension	f,prime	A,plus	A,minus	A,final	T anchors Kips	T ong. anchor Kips	Nsa check	Ncbg check	Nsb check	Npn check
17	UDSTL1	3.4220	0.0011	0.0003	0.0238	Anchor bolts not in tension	XXXX	XXXX	XXXX	XXXX	XXXX	XXXX	Design OK	XXXX	XXXX	XXXX
17	UDSTL2	5.6050	0.0017	0.0003	0.0389	Anchor bolts not in tension	XXXX	XXXX	XXXX	XXXX	XXXX	XXXX	Design OK	XXXX	XXXX	XXXX
17	UDSTL3	2.5930	-0.0960	-0.0370	0.0183	Anchor bolts not in tension	XXXX	XXXX	XXXX	XXXX	XXXX	XXXX	Design OK	XXXX	XXXX	XXXX
17	UDSTL4	4.9430	0.0980	0.0200	0.0347	Anchor bolts not in tension	XXXX	XXXX	XXXX	XXXX	XXXX	XXXX	Design OK	XXXX	XXXX	XXXX
17	UDSTL5	2.5930	-0.1300	-0.0501	0.0185	Anchor bolts not in tension	XXXX	XXXX	XXXX	XXXX	XXXX	XXXX	Design OK	XXXX	XXXX	XXXX
17	UDSTL6	4.9430	0.1320	0.0287	0.0348	Anchor bolts not in tension	XXXX	XXXX	XXXX	XXXX	XXXX	XXXX	Design OK	XXXX	XXXX	XXXX
17	UDSTL7	3.2970	-15.0960	-4.5787	0.0753	Anchor bolts in tension	4.7447	31.5548	-0.0546	0.0546	-3.2723	-1.6362	Design OK	Design OK	Design OK	Design OK
17	UDSTL8	4.2360	15.0960	3.5625	0.0819	Anchor bolts in tension	5.1568	22.0225	9.4775	9.4775	0.4167	0.2083	Design OK	Design OK	Design OK	Design OK
17	UDSTL9	4.2200	-15.0950	-3.5770	0.0817	Anchor bolts in tension	5.1483	30.7243	0.7757	0.7757	-3.8397	-1.9198	Design OK	Design OK	Design OK	Design OK
17	UDSTL10	3.3160	15.0960	4.5531	0.0755	Anchor bolts in tension	4.7534	22.7590	8.7410	8.7410	0.5411	0.3206	Design OK	Design OK	Design OK	Design OK
17	UDSTL11	1.0250	-0.0970	-0.0946	0.0075	Anchor bolts not in tension	XXXX	XXXX	XXXX	XXXX	XXXX	XXXX	Design OK	XXXX	XXXX	XXXX
17	UDSTL12	3.3750	0.0980	0.0290	0.0238	Anchor bolts not in tension	XXXX	XXXX	XXXX	XXXX	XXXX	XXXX	Design OK	XXXX	XXXX	XXXX
17	UDSTL13	1.0250	-0.1300	-0.1268	0.0076	Anchor bolts not in tension	XXXX	XXXX	XXXX	XXXX	XXXX	XXXX	Design OK	XXXX	XXXX	XXXX
17	UDSTL14	3.3750	0.1310	0.0386	0.0239	Anchor bolts not in tension	XXXX	XXXX	XXXX	XXXX	XXXX	XXXX	Design OK	XXXX	XXXX	XXXX
17	UDSTL15	1.7290	-15.0960	-8.7311	0.0644	Anchor bolts in tension	4.0587	33.2096	-1.7096	1.7096	-1.0682	-0.5341	Design OK	Design OK	Design OK	Design OK
17	UDSTL16	2.6700	15.0960	5.6547	0.0710	Anchor bolts in tension	4.4708	23.3020	8.1980	8.1980	0.8206	0.4103	Design OK	Design OK	Design OK	Design OK
17	UDSTL17	2.6510	-15.0960	-5.6945	0.0708	Anchor bolts in tension	4.4621	32.1943	-0.6943	0.6943	-2.3559	-1.1780	Design OK	Design OK	Design OK	Design OK
17	UDSTL18	1.7480	15.0970	6.6367	0.0646	Anchor bolts in tension	4.0672	24.1296	7.3704	7.3704	1.1070	0.5535	Design OK	Design OK	Design OK	Design OK
17	UDSTL19	3.7860	-18.1950	-4.8288	0.0893	Anchor bolts in tension	5.6287	31.7186	-0.2186	0.2186	-3.6508	-1.8254	Design OK	Design OK	Design OK	Design OK
17	UDSTL20	3.7860	18.1970	4.8294	0.0894	Anchor bolts in tension	5.6291	22.9158	8.5842	8.5842	0.8340	0.4170	Design OK	Design OK	Design OK	Design OK
17	UDSTL21	3.7680	-0.0300	-0.0080	0.0263	Anchor bolts not in tension	XXXX	XXXX	XXXX	XXXX	XXXX	XXXX	Design OK	XXXX	XXXX	XXXX
17	UDSTL22	3.7680	0.0320	0.0085	0.0263	Anchor bolts not in tension	XXXX	XXXX	XXXX	XXXX	XXXX	XXXX	Design OK	XXXX	XXXX	XXXX
17	UDSTL23	2.2000	-18.1950	-8.2705	0.0785	Anchor bolts in tension	4.9427	33.0973	-1.5973	1.5973	-1.4481	-0.7241	Design OK	Design OK	Design OK	Design OK
17	UDSTL24	2.2000	18.1970	8.2714	0.0785	Anchor bolts in tension	4.9431	24.0574	7.4426	7.4426	1.3037	0.6519	Design OK	Design OK	Design OK	Design OK
17	UDSTL25	2.2000	-0.0300	-0.0136	0.0154	Anchor bolts not in tension	XXXX	XXXX	XXXX	XXXX	XXXX	XXXX	Design OK	XXXX	XXXX	XXXX
17	UDSTL26	2.2000	0.0320	0.0145	0.0154	Anchor bolts not in tension	XXXX	XXXX	XXXX	XXXX	XXXX	XXXX	Design OK	XXXX	XXXX	XXXX
17	UDSTL27	3.7680	57.5510	15.2736	0.2260	Anchor bolts in tension	14.2378	24.8726	6.6274	6.6274	5.2186	2.6093	Design OK	Design OK	Design OK	Design OK
17	UDSTL27	3.7680	-57.5480	-15.2728	0.2260	Anchor bolts in tension	14.2371	34.1313	-2.6313	2.6313	-0.2001	-0.1001	Design OK	Design OK	Design OK	Design OK
17	UDSTL28	3.7720	0.1210	0.0321	0.0266	Anchor bolts not in tension	XXXX	XXXX	XXXX	XXXX	XXXX	XXXX	Design OK	XXXX	XXXX	XXXX
17	UDSTL28	3.7640	-0.1180	-0.0313	0.0265	Anchor bolts not in tension	XXXX	XXXX	XXXX	XXXX	XXXX	XXXX	Design OK	XXXX	XXXX	XXXX
17	UDSTL29	2.2000	57.5500	26.1591	0.2151	Anchor bolts in tension	13.5516	25.3040	6.1960	6.1960	5.7968	2.8984	Design OK	Design OK	Design OK	Design OK
17	UDSTL29	2.2000	-57.5490	-26.1566	0.2151	Anchor bolts in tension	13.5513	34.8928	-3.1926	3.1926	1.9204	0.9602	Design OK	Design OK	Design OK	Design OK
17	UDSTL30	2.2036	0.1200	0.0545	0.0157	Anchor bolts not in tension	XXXX	XXXX	XXXX	XXXX	XXXX	XXXX	Design OK	XXXX	XXXX	XXXX
17	UDSTL30	2.1960	-0.1190	-0.0542	0.0157	Anchor bolts not in tension	XXXX	XXXX	XXXX	XXXX	XXXX	XXXX	Design OK	XXXX	XXXX	XXXX

Gas Bottles Misc Support Calculations
By R. Murphy Date: 12/16/2007

Anchor Interaction Check

	Naa (kip)	Ncbg (kip)	Npn (kip)	Nab (kip)
one anchor	two anchors	one anchor	one anchor	
	77.6	9.859	20.928	36.826
φN	65.96	29.85055	17.7905	31.3055

	Vsa (kip)	Vcbg (kip)	Vcpg (kip)
one anchor	four anchor	four anchor	
	62.08	8.775	19.718
φV	52.768	7.45875	59.30025

one anchor--> N.design 14.825275
four anchor--> V.design 7.45875

Joint	OutputCase	T	F1=V1	F2=V2	T/N.design	V1/V.design	V2/V.design	Interaction Check (V1)	Interaction Check (V2)
Text	Text	Kips	Kip	Kip					
14	UDSTL1	XXXX	-0.000001774	0.0002569	0.000	0.000	0.000	Check not needed	Check not needed
14	UDSTL2	XXXX	-0.000001462	0.0002166	0.000	0.000	0.000	Check not needed	Check not needed
14	UDSTL3	3.299874983	0.001543	-0.664	0.223	0.000	-0.089	0.223	0.134
14	UDSTL4	0.836093269	-0.001546	0.665	0.056	0.000	0.089	Check not needed	Check not needed
14	UDSTL5	4.093678073	0.002073	-0.711	0.276	0.000	-0.095	0.276	0.181
14	UDSTL6	1.419428336	-0.002076	0.712	0.096	0.000	0.095	Check not needed	Check not needed
14	UDSTL7	XXXX	-0.201	0.0001287	0.000	-0.027	0.000	Check not needed	Check not needed
14	UDSTL8	XXXX	0.201	0.0003094	0.000	0.027	0.000	Check not needed	Check not needed
14	UDSTL9	XXXX	-0.201	0.0001298	0.000	0.027	0.000	Check not needed	Check not needed
14	UDSTL10	XXXX	0.201	0.0003083	0.000	0.027	0.000	Check not needed	Check not needed
14	UDSTL11	3.499258824	0.001543	-0.664	0.236	0.000	-0.089	0.236	0.147
14	UDSTL12	1.429422092	-0.001545	0.665	0.096	0.000	0.089	Check not needed	Check not needed
14	UDSTL13	4.293990946	0.002073	-0.711	0.290	0.000	-0.095	0.290	0.194
14	UDSTL14	2.011229067	-0.002075	0.711	0.136	0.000	0.095	Check not needed	Check not needed
14	UDSTL15	XXXX	-0.201	0.0000748	0.000	-0.027	0.000	Check not needed	Check not needed
14	UDSTL16	XXXX	0.201	0.0002555	0.000	0.027	0.000	Check not needed	Check not needed
14	UDSTL17	XXXX	-0.201	7.591E-05	0.000	-0.027	0.000	Check not needed	Check not needed
14	UDSTL18	XXXX	0.201	0.0002544	0.000	0.027	0.000	Check not needed	Check not needed
14	UDSTL19	XXXX	-0.157	0.001359	0.000	-0.021	0.000	Check not needed	Check not needed
14	UDSTL20	XXXX	0.157	-0.000921	0.000	0.021	0.000	Check not needed	Check not needed
14	UDSTL21	0.575162782	0.0004916	-0.159	0.039	0.000	-0.021	Check not needed	Check not needed
14	UDSTL22	-0.668905906	-0.0004946	0.159	-0.045	0.000	0.021	Check not needed	Check not needed
14	UDSTL23	XXXX	-0.157	0.001305	0.000	-0.021	0.000	Check not needed	Check not needed
14	UDSTL24	XXXX	0.157	-0.000975	0.000	0.021	0.000	Check not needed	Check not needed
14	UDSTL25	0.749739295	0.0004919	-0.159	0.051	0.000	-0.021	Check not needed	Check not needed
14	UDSTL26	-0.063089517	-0.0004942	0.159	-0.004	0.000	0.021	Check not needed	Check not needed
14	UDSTL27	XXXX	0.495	0.006384	0.000	0.066	0.001	Check not needed	Check not needed
14	UDSTL27	XXXX	-0.495	-0.005946	0.000	-0.066	-0.001	Check not needed	Check not needed
14	UDSTL28	2.945019233	0.001568	0.494	0.199	0.000	0.066	Check not needed	Check not needed
14	UDSTL28	1.110172608	-0.001571	-0.493	0.075	0.000	-0.066	Check not needed	Check not needed
14	UDSTL29	XXXX	0.495	0.00633	0.000	0.066	0.001	Check not needed	Check not needed
14	UDSTL29	XXXX	-0.495	-0.006	0.000	-0.066	-0.001	Check not needed	Check not needed
14	UDSTL30	3.140643526	0.001569	0.494	0.212	0.000	0.066	0.212	0.278
14	UDSTL30	1.702148173	-0.001571	-0.493	0.115	0.000	-0.066	Check not needed	Check not needed



Calculation Sheet

Project: BGCAPP
 Job Number: 743341
 Calc No: 24915-10-DBC-00-00004
 Rev. D
 Sheet No. D1-43 / D1-60

Gas Bottles Misc Support Calculations
 By R. Murphy Date: 12/16/2007

Joint	OutputCase	T one anchor	F1=V1	F2=V2	T/N.design	V1/V.design	V2/V.design	Interaction Check (V1)	Interaction Check (V2)
Text	Text	Kips	Kip	Kip					
15	UDSTL1	XXXX	0.000003695	-0.000178	0.000	0.000	0.000	Check not needed	Check not needed
15	UDSTL2	XXXX	0.000005745	-0.000171	0.000	0.000	0.000	Check not needed	Check not needed
15	UDSTL3	3.019647039	-0.001444	-0.608	0.204	0.000	-0.082	0.203	0.122
15	UDSTL4	0.859395444	0.001452	0.607	0.058	0.000	0.081	Check not needed	Check not needed
15	UDSTL5	3.751648245	-0.001944	-0.658	0.253	0.000	-0.088	0.253	0.165
15	UDSTL6	1.396954273	0.001952	0.657	0.094	0.000	0.088	Check not needed	Check not needed
15	UDSTL7	XXXX	-0.201	-0.000504	0.000	-0.027	0.000	Check not needed	Check not needed
15	UDSTL8	XXXX	0.201	0.0001865	0.000	0.027	0.000	Check not needed	Check not needed
15	UDSTL9	XXXX	-0.201	-0.000509	0.000	-0.027	0.000	Check not needed	Check not needed
15	UDSTL10	XXXX	0.201	0.0001918	0.000	0.027	0.000	Check not needed	Check not needed
15	UDSTL11	3.188808464	-0.001445	-0.608	0.215	0.000	-0.082	0.215	0.134
15	UDSTL12	1.364377883	0.00145	0.607	0.092	0.000	0.081	Check not needed	Check not needed
15	UDSTL13	3.921590843	-0.001946	-0.658	0.265	0.000	-0.088	0.264	0.176
15	UDSTL14	1.900609419	0.001951	0.657	0.128	0.000	0.088	Check not needed	Check not needed
15	UDSTL15	XXXX	-0.201	-0.00046	0.000	-0.027	0.000	Check not needed	Check not needed
15	UDSTL16	XXXX	0.201	0.0002303	0.000	0.027	0.000	Check not needed	Check not needed
15	UDSTL17	XXXX	-0.201	-0.000465	0.000	-0.027	0.000	Check not needed	Check not needed
15	UDSTL18	XXXX	0.201	0.0002356	0.000	0.027	0.000	Check not needed	Check not needed
15	UDSTL19	XXXX	-0.157	-0.001184	0.000	-0.021	0.000	Check not needed	Check not needed
15	UDSTL20	XXXX	0.157	0.0008671	0.000	0.021	0.000	Check not needed	Check not needed
15	UDSTL21	0.557519123	-0.0004586	-0.147	0.038	0.000	-0.020	Check not needed	Check not needed
15	UDSTL22	-0.536066689	0.0004665	0.146	-0.036	0.000	0.020	Check not needed	Check not needed
15	UDSTL23	XXXX	-0.157	-0.00114	0.000	-0.021	0.000	Check not needed	Check not needed
15	UDSTL24	XXXX	0.157	0.000911	0.000	0.021	0.000	Check not needed	Check not needed
15	UDSTL25	0.707155271	-0.0004602	-0.147	0.048	0.000	-0.020	Check not needed	Check not needed
15	UDSTL26	-0.021410884	0.0004649	0.146	-0.001	0.000	0.020	Check not needed	Check not needed
15	UDSTL27	XXXX	0.496	0.005898	0.000	0.066	0.001	Check not needed	Check not needed
15	UDSTL27	XXXX	-0.495	-0.006215	0.000	-0.066	-0.001	Check not needed	Check not needed
15	UDSTL28	2.384162571	0.00167	0.405	0.161	0.000	0.054	Check not needed	Check not needed
15	UDSTL28	0.834973769	-0.001662	-0.406	0.056	0.000	-0.054	Check not needed	Check not needed
15	UDSTL29	XXXX	0.496	0.005942	0.000	0.066	0.001	Check not needed	Check not needed
15	UDSTL29	XXXX	-0.495	-0.006171	0.000	-0.066	-0.001	Check not needed	Check not needed
15	UDSTL30	2.549667217	0.001668	0.405	0.172	0.000	0.054	Check not needed	Check not needed
15	UDSTL30	1.339001148	-0.001663	-0.406	0.090	0.000	-0.054	Check not needed	Check not needed



Calculation Sheet

Project: BGCAPP
 Job Number: 743341
 Calc No: 24915-10-DBC-00-00004
 Rev. D
 Sheet No. D1-44 / D1-60

Gas Bottles Misc Support Calculations
 By R. Murphy Date: 12/16/2007

Joint	OutputCase	T one anchor	F1=V1	F2=V2	T/N.design	V1/V.design	V2/V.design	Interaction Check (V1)	Interaction Check (V2)
Text	Text	Kips	Kip	Kip					
16	UDSTL1	XXXX	-0.00002416	-0.001073	0.000	0.000	0.000	Check not needed	Check not needed
16	UDSTL2	XXXX	-0.00004197	-0.000926	0.000	0.000	0.000	Check not needed	Check not needed
16	UDSTL3	3.3025933	0.0007195	-0.739	0.223	0.000	-0.099	0.223	0.124
16	UDSTL4	-0.67810083	-0.0007742	0.737	-0.046	0.000	0.099	Check not needed	Check not needed
16	UDSTL5	3.880702196	0.0009646	-0.685	0.262	0.000	-0.092	0.262	0.170
16	UDSTL6	-0.247401482	-0.001019	0.683	-0.017	0.000	0.092	Check not needed	Check not needed
16	UDSTL7	XXXX	-0.201	-0.000924	0.000	-0.027	0.000	Check not needed	Check not needed
16	UDSTL8	XXXX	0.201	-0.00092	0.000	0.027	0.000	Check not needed	Check not needed
16	UDSTL9	XXXX	-0.201	-0.00093	0.000	-0.027	0.000	Check not needed	Check not needed
16	UDSTL10	XXXX	0.201	-0.000914	0.000	0.027	0.000	Check not needed	Check not needed
16	UDSTL11	3.649353657	0.0007314	-0.739	0.246	0.000	-0.099	0.246	0.147
16	UDSTL12	0.464740446	-0.0007624	0.738	0.031	0.000	0.099	Check not needed	Check not needed
16	UDSTL13	4.229490835	0.0009764	-0.685	0.285	0.000	-0.092	0.285	0.193
16	UDSTL14	0.891206974	-0.001007	0.683	0.060	0.000	0.092	Check not needed	Check not needed
16	UDSTL15	XXXX	-0.201	-0.000692	0.000	-0.027	0.000	Check not needed	Check not needed
16	UDSTL16	XXXX	0.201	-0.000688	0.000	0.027	0.000	Check not needed	Check not needed
16	UDSTL17	XXXX	-0.201	-0.000698	0.000	-0.027	0.000	Check not needed	Check not needed
16	UDSTL18	XXXX	0.201	-0.000682	0.000	0.027	0.000	Check not needed	Check not needed
16	UDSTL19	XXXX	-0.157	-0.001567	0.000	-0.021	0.000	Check not needed	Check not needed
16	UDSTL20	XXXX	0.157	-0.000276	0.000	0.021	0.000	Check not needed	Check not needed
16	UDSTL21	0.344407872	0.0002067	-0.164	0.023	0.000	-0.022	Check not needed	Check not needed
16	UDSTL22	-1.937351998	-0.0002614	0.163	-0.131	0.000	0.022	Check not needed	Check not needed
16	UDSTL23	XXXX	-0.157	-0.001335	0.000	-0.021	0.000	Check not needed	Check not needed
16	UDSTL24	XXXX	0.157	-4.42E-05	0.000	0.021	0.000	Check not needed	Check not needed
16	UDSTL25	0.60868579	0.0002185	-0.164	0.041	0.000	-0.022	Check not needed	Check not needed
16	UDSTL26	-0.758293441	-0.0002496	0.163	-0.051	0.000	0.022	Check not needed	Check not needed
16	UDSTL27	XXXX	0.496	0.0006472	0.000	0.066	0.000	Check not needed	Check not needed
16	UDSTL27	XXXX	-0.496	-0.002491	0.000	-0.066	0.000	Check not needed	Check not needed
16	UDSTL28	2.493081613	0.0006711	0.454	0.168	0.000	0.061	Check not needed	Check not needed
16	UDSTL28	-0.22631162	-0.0007258	-0.456	-0.015	0.000	-0.061	Check not needed	Check not needed
16	UDSTL29	XXXX	0.496	0.0008792	0.000	0.066	0.000	Check not needed	Check not needed
16	UDSTL29	XXXX	-0.496	-0.002259	0.000	-0.066	0.000	Check not needed	Check not needed
16	UDSTL30	2.824964354	0.0006829	0.454	0.191	0.000	0.061	Check not needed	Check not needed
16	UDSTL30	0.911832832	-0.000714	-0.455	0.062	0.000	-0.061	Check not needed	Check not needed



Calculation Sheet

Project: BGCAPP
 Job Number: 743341
 Calc No: 24915-10-DBC-00-00004
 Rev D
 Sheet No. D1-45 / D1-60

Gas Bottles Misc Support Calculations
 By R. Murphy Date: 12/16/2007

Joint	OutputCase	T one anchor	F1=V1	F2=V2	T/N.design	V1/V.design	V2/V.design	Interaction Check (V1)	Interaction Check (V2)
Text	Text	Klps	Klp	Klp					
17	UDSTL1	XXXX	0.00002224	0.0009945	0.000	0.000	0.000	Check not needed	Check not needed
17	UDSTL2	XXXX	0.00003769	0.0008803	0.000	0.000	0.000	Check not needed	Check not needed
17	UDSTL3	3.179723502	-0.0008187	-0.706	0.214	0.000	-0.095	0.214	0.120
17	UDSTL4	-0.515830946	0.0008685	0.708	-0.035	0.000	0.095	Check not needed	Check not needed
17	UDSTL5	3.75595819	-0.001093	-0.664	0.253	0.000	-0.089	0.253	0.164
17	UDSTL6	-0.0870001	0.001143	0.666	-0.006	0.000	0.089	Check not needed	Check not needed
17	UDSTL7	XXXX	-0.201	0.001299	0.000	-0.027	0.000	Check not needed	Check not needed
17	UDSTL8	XXXX	0.201	0.0004237	0.000	0.027	0.000	Check not needed	Check not needed
17	UDSTL9	XXXX	-0.201	0.001309	0.000	-0.027	0.000	Check not needed	Check not needed
17	UDSTL10	XXXX	0.201	0.0004135	0.000	0.027	0.000	Check not needed	Check not needed
17	UDSTL11	3.500470916	-0.0008293	-0.707	0.236	0.000	-0.095	0.236	0.141
17	UDSTL12	0.534027421	0.0008579	0.708	0.036	0.000	0.095	Check not needed	Check not needed
17	UDSTL13	4.078593949	-0.001104	-0.664	0.275	0.000	-0.089	0.275	0.186
17	UDSTL14	0.959387904	0.001132	0.665	0.065	0.000	0.089	Check not needed	Check not needed
17	UDSTL15	XXXX	-0.201	0.001077	0.000	-0.027	0.000	Check not needed	Check not needed
17	UDSTL16	XXXX	0.201	0.0002019	0.000	0.027	0.000	Check not needed	Check not needed
17	UDSTL17	XXXX	-0.201	0.001087	0.000	-0.027	0.000	Check not needed	Check not needed
17	UDSTL18	XXXX	0.201	0.0001917	0.000	0.027	0.000	Check not needed	Check not needed
17	UDSTL19	XXXX	-0.157	0.001393	0.000	-0.021	0.000	Check not needed	Check not needed
17	UDSTL20	XXXX	0.157	0.0003295	0.000	0.021	0.000	Check not needed	Check not needed
17	UDSTL21	0.352122534	-0.0002396	-0.157	0.024	0.000	-0.021	Check not needed	Check not needed
17	UDSTL22	-1.754633742	0.0002894	0.159	-0.118	0.000	0.021	Check not needed	Check not needed
17	UDSTL23	XXXX	-0.157	0.001171	0.000	-0.021	0.000	Check not needed	Check not needed
17	UDSTL24	XXXX	0.157	0.0001077	0.000	0.021	0.000	Check not needed	Check not needed
17	UDSTL25	0.600152089	-0.0002502	-0.157	0.040	0.000	-0.021	Check not needed	Check not needed
17	UDSTL26	-0.672831788	0.0002788	0.159	-0.045	0.000	0.021	Check not needed	Check not needed
17	UDSTL27	XXXX	0.496	0.002161	0.000	0.066	0.000	Check not needed	Check not needed
17	UDSTL27	XXXX	-0.496	-0.000439	0.000	-0.066	0.000	Check not needed	Check not needed
17	UDSTL28	2.314344879	0.001039	0.426	0.156	0.000	0.057	Check not needed	Check not needed
17	UDSTL28	-0.198109855	-0.0009896	-0.424	-0.013	0.000	-0.057	Check not needed	Check not needed
17	UDSTL29	XXXX	0.496	0.00194	0.000	0.066	0.000	Check not needed	Check not needed
17	UDSTL29	XXXX	-0.496	-0.000661	0.000	-0.066	0.000	Check not needed	Check not needed
17	UDSTL30	2.621287127	0.001029	0.425	0.177	0.000	0.057	Check not needed	Check not needed
17	UDSTL30	0.848137104	-0.001	-0.424	0.057	0.000	-0.057	Check not needed	Check not needed



Calculation Sheet

Gas Bottles Misc Support Calculations
 By R. Murphy Date: 12/16/2007

Project: BGCAPP
 Job Number: 743341
 Calc No: 24915-10-DBC-00-00004
 Rev. D
 Sheet No. D1-46 / D1-60

Dimensional Solutions Mat3D	Version	4.0.0	Date	1/22/2008
Foundation Name	Shed_Temp		Time	11:28:49 AM
Designed By:	Parsons	Engineer	Jeremy Tillman	Checker
	I:\Struct\SCWO 2007\SCWO Miscellaneous\STEEL\App D Gas Bottle Canopies\Gas Bottle Canopy #1\			
Filename:	SAP Model\shed_temp.\$2k.m3d			

DETAIL REPORT

PROJECT INFORMATION

Project Name:
 Project Number:
 Client:
 Project Location
 Foundation Description SHED_TEMP

DESIGN CODE ACI 318 - 2005 INPUT UNITS English OUTPUT UNITS English

CONCRETE PARAMETERS:

Compressive Strength (psi) 4000.00
 Unit Weight (pcf) 150.00

REINFORCING STEEL PARAMETERS:

Yield Strength (ksi) 60.00
 Unit Weight (pcf) 490.00
 Modulus of Elasticity (ksi) 29000.00

SOIL PARAMETERS:

Allowable Net Bearing Capacity (psf) 3000.00
 Unit Weight (pcf) 120.00

MINIMUM FOUNDATION CRITERIA:

Depth of Footing Below Grade (ft) 1.50
 Minimum Soil Cover (ft) 0.00

PILE PARAMETERS:

Diameter (in) 0
 Type

REBAR PARAMETERS:

Max Long Bar Size 6
 Min Long Bar Size 6
 Max Tie Bar Size 4
 Min Tie Bar Size 4
 Max Ftg Bar Size 5
 Min Ftg Bar Size 5
 Temp & Shrinkage Steel Ratio 0.0000



Calculation Sheet

Project: BGCAPP
 Job Number: 743341
 Calc No: 24915-10-DBC-00-00004
 Rev D
 Sheet No. D1-46a / D1-60

Subject: Gas Bottles Misc Support Calculations
 By R. Murphy Date: 12/16/2007

Joint	OutputCase	CaseType	StepType	F1	F2	F3	M1	M2	M3
Text	Text	Text	Text	Kip	Kip	Kip	Kip-in	Kip-in	Kip-in
14	Wind_Envelope	Combination Max		0.001596	-6.865E-05	0.429	59.828	0.185	0.077
14	Wind_Envelope	Combination Min		-0.155	-0.547	-0.503	0.01	-11.649	0.003719
14	EQuake_Envelope	Combination Max		0.0004931	0.00114	-5.845E-07	18.468	0.057	0.016
14	EQuake_Envelope	Combination Min		-0.157	-0.159	-1.711E-05	-0.128	-18.171	0.014
14	Roof_Live_Snow	Combination		0.0004266	-0.038	3.655	11.049	0.05	0.041
14	DEAD_SELF_WEIGHT	Combination		-1.267E-06	0.0001835	1.476	-1.293	-2.323E-05	-0.013
15	Wind_Envelope	Combination Max		-0.001114	-0.0002654	0.147	54.575	-0.129	0.423
15	Wind_Envelope	Combination Min		-0.154	-0.506	-0.417	0.028	-11.601	0.003878
15	EQuake_Envelope	Combination Max		-0.0004626	-0.001026	0.00003258	17.003	-0.054	0.12
15	EQuake_Envelope	Combination Min		-0.157	-0.147	-2.436E-06	0.114	-18.171	0.014
15	Roof_Live_Snow	Combination		-0.0003973	-0.04	3.025	10.195	-0.047	0.089
15	DEAD_SELF_WEIGHT	Combination		2.639E-06	-0.0001274	1.291	-1.072	0.0002046	-0.013
16	Wind_Envelope	Combination Max		0.000763	-1.577E-06	0.598	59.953	0.088	0.195
16	Wind_Envelope	Combination Min		-0.155	-0.568	-0.99	-0.001927	-11.629	0.003725
16	EQuake_Envelope	Combination Max		0.000234	-0.0006456	5.304E-07	18.966	0.027	0.051
16	EQuake_Envelope	Combination Min		-0.157	-0.164	-2.063E-05	0.07	-18.198	0.014
16	Roof_Live_Snow	Combination		0.0001489	0.044	7.192	8.073	0.022	0.055
16	DEAD_SELF_WEIGHT	Combination		-1.726E-05	-0.0007664	2.629	-1.184	-0.0005488	-0.013
17	Wind_Envelope	Combination Max		-0.0006489	0.0003443	0.348	57.792	-0.075	0.349
17	Wind_Envelope	Combination Min		-0.155	-0.544	-0.904	-0.037	-11.613	0.003826
17	EQuake_Envelope	Combination Max		-0.0002645	0.0005316	5.165E-06	18.313	-0.031	0.098
17	EQuake_Envelope	Combination Min		-0.157	-0.158	2.491E-06	-0.056	-18.196	0.014
17	Roof_Live_Snow	Combination		-0.0001782	0.034	6.57	8.029	-0.025	0.08
17	DEAD_SELF_WEIGHT	Combination		0.00001589	0.0007103	2.444	-1.165	0.0007525	-0.013



Calculation Sheet

Project: BGCAPP
 Job Number: 743341
 Calc No: 24915-10-DBC-00-00004
 Rev D
 Sheet No. D1-47 / D1-60

Gas Bottles Misc Support Calculations
 By R. Murphy Date: 12/16/2007

Dimensional Solutions Mat3D	Version	4.0.0	Date	1/22/2008
Foundation Name	Shed_Temp		Time	11:28:49 AM
Designed By:	Parsons	Engineer	Jeremy Tillman	Checker
	I:\Struct\SCWO 2007\SCWO Miscellaneous\STEEL\App D Gas Bottle Canopies\Gas Bottle Canopy #1			
Filename:	SAP Model\shed_temp.\$2k.m3d			

DETAIL REPORT

APPLIED LOADS

P2

Load Case	Axial (kips)	Shear X (kips)	Mom Z (kip ft)	Shear Z (kips)	Mom X (kip ft)
1 - Dead	2.63	0.00	0.00	0.00	0.10
2 - Live	6.40	0.00	0.00	0.04	0.64
3 - Wind	0.30	0.17	1.06	0.34	2.99
4 - Earthquake	0.16	0.16	1.51	0.00	1.58

P3

Load Case	Axial (kips)	Shear X (kips)	Mom Z (kip ft)	Shear Z (kips)	Mom X (kip ft)
1 - Dead	2.44	0.00	0.00	0.00	0.10
2 - Live	5.84	0.00	0.00	0.03	0.64
3 - Wind	0.27	0.17	1.07	0.33	2.90
4 - Earthquake	0.00	0.16	1.52	0.16	1.53

P1

Load Case	Axial (kips)	Shear X (kips)	Mom Z (kip ft)	Shear Z (kips)	Mom X (kip ft)
1 - Dead	1.48	0.00	0.00	0.00	0.10
2 - Live	3.25	0.00	0.00	0.04	0.87
3 - Wind	0.15	0.17	1.06	0.16	3.14
4 - Earthquake	0.00	0.16	1.51	0.33	1.54

P4

Load Case	Axial (kips)	Shear X (kips)	Mom Z (kip ft)	Shear Z (kips)	Mom X (kip ft)
1 - Dead	1.29	0.00	0.00	0.00	0.09
2 - Live	2.69	0.00	0.00	0.04	0.61
3 - Wind	0.13	0.17	1.07	0.32	2.90
4 - Earthquake	0.00	0.16	1.51	0.15	1.42



Calculation Sheet

Project: BGCAPP
 Job Number: 743341
 Calc No: 24915-10-DBC-00-00004
 Rev D
 Sheet No. D1-48 / D1-60

Gas Bottles Misc Support Calculations
 By R. Murphy Date: 12/16/2007

Dimensional Solutions Mat3D	Version	4.0.0	Date	1/22/2008
Foundation Name	Shed_Temp		Time	11:28:49 AM
Designed By:	Parsons	Engineer	Jeremy Tillman	Checker
Filename:	I:\Struct\SCWO 2007\SCWO Miscellaneous\STEEL\App D Gas Bottle Canopies\Gas Bottle Canopy #1\SAP Model\shed_temp.\$2k.m3d			

DETAIL REPORT

UNFACTORED (ALLOWABLE) LOAD COMBINATIONS

P2

Load Comb	Axial (kips)	Shear X (kips)	Mom Z (kip ft)	Shear Z (kips)	Mom X (kip ft)
1 - Dead	2.63	0.00	0.00	0.00	0.10
2 - Dead + Live	9.03	0.00	0.00	0.04	0.74
3 - Dead + Live + Wind	9.33	0.17	1.06	0.38	3.73
4 - Dead + Wind	2.93	0.17	1.06	0.34	3.09
5 - Dead + Live + Earthquake	9.19	0.16	1.51	0.04	2.32
6 - Dead + Earthquake	2.79	0.16	1.51	0.00	1.68

P3

Load Comb	Axial (kips)	Shear X (kips)	Mom Z (kip ft)	Shear Z (kips)	Mom X (kip ft)
1 - Dead	2.44	0.00	0.00	0.00	0.10
2 - Dead + Live	8.28	0.00	0.00	0.03	0.74
3 - Dead + Live + Wind	8.55	0.17	1.07	0.36	3.64
4 - Dead + Wind	2.71	0.17	1.07	0.33	3.00
5 - Dead + Live + Earthquake	8.28	0.16	1.52	0.19	2.27
6 - Dead + Earthquake	2.44	0.16	1.52	0.16	1.63

P1

Load Comb	Axial (kips)	Shear X (kips)	Mom Z (kip ft)	Shear Z (kips)	Mom X (kip ft)
1 - Dead	1.48	0.00	0.00	0.00	0.10
2 - Dead + Live	4.73	0.00	0.00	0.04	0.97
3 - Dead + Live + Wind	4.88	0.17	1.06	0.20	4.11
4 - Dead + Wind	1.63	0.17	1.06	0.16	3.24
5 - Dead + Live + Earthquake	4.73	0.16	1.51	0.37	2.51
6 - Dead + Earthquake	1.48	0.16	1.51	0.33	1.64



Calculation Sheet

Gas Bottles Misc Support Calculations
 By R. Murphy Date: 12/16/2007

Project: BGCAPP
 Job Number: 743341
 Calc No: 24915-10-DBC-00-00004
 Rev, D
 Sheet No. D1-49 / D1-60

Dimensional Solutions Mat3D	Version	4.0.0	Date	1/22/2008
Foundation Name	Shed_Temp		Time	11:28:49 AM
Designed By:	Parsons	Engineer	Jeremy Tillman	Checker
	I:\Struct\SCWO 2007\SCWO Miscellaneous\STEEL\App D Gas Bottle Canopies\Gas Bottle Canopy #1			N/A
Filename:	SAP Modelshed_temp.\$2k.m3d			

DETAIL REPORT

P4

Load Comb	Axial (kips)	Shear X (kips)	Mom Z (kip ft)	Shear Z (kips)	Mom X (kip ft)
1 - Dead	1.29	0.00	0.00	0.00	0.09
2 - Dead + Live	3.98	0.00	0.00	0.04	0.90
3 - Dead + Live + Wind	4.11	0.17	1.07	0.36	3.80
4 - Dead + Wind	1.42	0.17	1.07	0.32	2.99
5 - Dead + Live + Earthquake	3.98	0.16	1.51	0.19	2.32
6 - Dead + Earthquake	1.29	0.16	1.51	0.15	1.51



Calculation Sheet

Project: BGCAPP
 Job Number: 743341
 Calc No: 24915-10-DBC-00-00004
 Rev. D
 Sheet No. D1-50 / D1-60

Gas Bottles Misc Support Calculations
 By R. Murphy Date: 12/16/2007

Dimensional Solutions Mat3D	Version	4.0.0	Date	1/22/2008
Foundation Name	Shed_Temp		Time	11:28:49 AM
Designed By:	Parsons	Engineer	Jeremy Tillman	Checker
Filename:	I:\Struct\SCWO 2007\SCWO Miscellaneous\STEEL\App D Gas Bottle Canopies\Gas Bottle Canopy #1\SAP Model\shed_temp.\$2k.m3d			

DETAIL REPORT

FACTORED (ULTIMATE) LOAD COMBINATIONS

P2

Load Comb	Axial (kips)	Shear X (kips)	Mom Z (kip ft)	Shear Z (kips)	Mom X (kip ft)
1 - 1.4Dead	3.68	0.00	0.00	0.00	0.14
2 - 1.2Dead + 1.6Live	13.40	0.00	0.00	0.06	1.14
3 - 1.2Dead + Live	9.56	0.00	0.00	0.04	0.76
4 - 1.2Dead + 0.8Wind	3.40	0.14	0.85	0.27	2.51
5 - 1.2Dead + Live + 1.6Wind	10.04	0.27	1.70	0.58	5.54
6 - 0.9Dead + 1.6Wind	2.85	0.27	1.70	0.54	4.87
7 - 1.2Dead + Live + Earthquake	9.72	0.16	1.51	0.04	2.34
8 - 0.9Dead + Earthquake	2.53	0.16	1.51	0.00	1.67

P3

Load Comb	Axial (kips)	Shear X (kips)	Mom Z (kip ft)	Shear Z (kips)	Mom X (kip ft)
1 - 1.4Dead	3.42	0.00	0.00	0.00	0.14
2 - 1.2Dead + 1.6Live	12.27	0.00	0.00	0.05	1.14
3 - 1.2Dead + Live	8.77	0.00	0.00	0.03	0.76
4 - 1.2Dead + 0.8Wind	3.14	0.14	0.86	0.26	2.44
5 - 1.2Dead + Live + 1.6Wind	9.20	0.27	1.71	0.56	5.40
6 - 0.9Dead + 1.6Wind	2.63	0.27	1.71	0.53	4.73
7 - 1.2Dead + Live + Earthquake	8.77	0.16	1.52	0.19	2.29
8 - 0.9Dead + Earthquake	2.20	0.16	1.52	0.16	1.62

P1

Load Comb	Axial (kips)	Shear X (kips)	Mom Z (kip ft)	Shear Z (kips)	Mom X (kip ft)
1 - 1.4Dead	2.07	0.00	0.00	0.00	0.14
2 - 1.2Dead + 1.6Live	6.98	0.00	0.00	0.06	1.51
3 - 1.2Dead + Live	5.03	0.00	0.00	0.04	0.99
4 - 1.2Dead + 0.8Wind	1.90	0.14	0.85	0.13	2.63
5 - 1.2Dead + Live + 1.6Wind	5.27	0.27	1.70	0.30	6.01
6 - 0.9Dead + 1.6Wind	1.57	0.27	1.70	0.26	5.11
7 - 1.2Dead + Live + Earthquake	5.03	0.16	1.51	0.37	2.53
8 - 0.9Dead + Earthquake	1.33	0.16	1.51	0.33	1.63



Calculation Sheet

Gas Bottles Misc Support Calculations
 By R. Murphy Date: 12/16/2007

Project: BGCAPP
 Job Number: 743341
 Calc No: 24915-10-DBC-00-00004
 Rev. D
 Sheet No. D1-51 / D1-60

Dimensional Solutions Mat3D	Version	4.0.0	Date	1/22/2008
Foundation Name	Shed_Temp		Time	11:28:49 AM
Designed By:	Parsons	Engineer	Jeremy Tillman	Checker
Filename:	I:\Struct\SCWO 2007\SCWO Miscellaneous\STEEL\App D Gas Bottle Canopies\Gas Bottle Canopy #1\			
	SAP Modelshed_temp.\$2k.m3d			

DETAIL REPORT

P4

Load Comb	Axial (kips)	Shear X (kips)	Mom Z (kip ft)	Shear Z (kips)	Mom X (kip ft)
1 - 1.4Dead	1.81	0.00	0.00	0.00	0.13
2 - 1.2Dead + 1.6Live	5.85	0.00	0.00	0.06	1.40
3 - 1.2Dead + Live	4.24	0.00	0.00	0.04	0.92
4 - 1.2Dead + 0.8Wind	1.65	0.14	0.86	0.26	2.43
5 - 1.2Dead + Live + 1.6Wind	4.45	0.27	1.71	0.55	5.56
6 - 0.9Dead + 1.6Wind	1.37	0.27	1.71	0.51	4.72
7 - 1.2Dead + Live + Earthquake	4.24	0.16	1.51	0.19	2.34
8 - 0.9Dead + Earthquake	1.16	0.16	1.51	0.15	1.50



Calculation Sheet

Gas Bottles Misc Support Calculations
 By R. Murphy Date: 12/16/2007

Project: BGCAPP
 Job Number: 743341
 Calc No: 24915-10-DBC-00-00004
 Rev. D
 Sheet No. D1-52 / D1-60

Dimensional Solutions Mat3D	Version	4.0.0	Date	1/22/2008
Foundation Name	Shed_Temp		Time	11:26:49 AM
Designed By:	Parsons	Engineer	Jeremy Tillman	Checker
	I:\Struct\SCWO 2007\SCWO Miscellaneous\STEEL\App D Gas Bottle Canopies\Gas Bottle Canopy #1\			
Filename:	SAP Model\shed_temp.\$2k.m3d			

DETAIL REPORT

BEARING CAPACITY - LINEAR SOIL PRESSURE METHOD

Load Comb	Max Pressure (ksf)	All Pressure (ksf)	Ecc N/S Dir (ft)	Ecc E/W Dir (ft)	Moment N/S axis (kip-ft)	Moment E/W axis (kip-ft)	Rem
1 - Dead	0.34	3.18	0.03	0.02	1.66	2.63	
2 - Dead + Live	0.42	3.18	0.05	0.02	1.65	5.75	
3 - Dead + Live + Wind	0.44	3.18	0.08	0.07	7.71	8.75	
4 - Dead + Wind	0.39	3.18	0.13	0.09	7.73	11.87	
5 - Dead + Live + Earthquake	0.41	3.18	0.02	0.08	8.31	1.86	
6 - Dead + Earthquake	0.36	3.18	0.06	0.09	8.33	4.98	

STABILITY RATIO / SLIDING SAFETY FACTOR

Load Comb	S.R. N/S Dir	S.R. E/W Dir	All S.R.	Sliding FS - N/S	Sliding FS - E/W	All FS	Remarks
1 - Dead	100.00	100.00	1.50	100.00	100.00	1.50	
2 - Dead + Live	83.84	100.00	1.50	100.00	100.00	1.50	
3 - Dead + Live + Wind	17.00	100.00	1.50	83.89	88.69	1.50	
4 - Dead + Wind	16.89	100.00	1.50	86.93	75.32	1.50	
5 - Dead + Live + Earthquake	27.45	100.00	1.50	100.00	93.69	1.50	
6 - Dead + Earthquake	31.57	100.00	1.50	100.00	79.49	1.50	



Calculation Sheet

Project: BGCAPP
 Job Number: 743341
 Calc No: 24915-10-DBC-00-00004
 Rev. D
 Sheet No. D1-53 / D1-60

Gas Bottles Misc Support Calculations
 By R. Murphy Date: 12/16/2007

Dimensional Solutions Mat3D	Version	4.0.0	Date	1/22/2008
Foundation Name:	Shed_Temp		Time	11:26:49 AM
Designed By:	Parsons	Engineer	Jeremy Tillman	Checker
	I:\Struct\SCWO 2007\SCWO Miscellaneous\STEELApp D Gas Bottle Canopies\Gas Bottle Canopy #1			
Filename:	SAP Modelshed_temp.\$2k.m3d			

DETAIL REPORT

FOOTING DESIGN INFORMATION

X Dim (ft)	46.33
Z Dim (ft)	5.71
Thickness (ft)	2.00

Top Steel

Governing Combination	No of Bars	Bar Size	Bar Spac (in)	Area Prov (sq in/ft)	Area Req (sq in/ft)	Moment (kip ft/ft)	Direction
2. 1.2Dead + 1.6Live	6	5	12	0.32	0.05	-3.46	E-W
6. 0.9Dead + 1.6Wind	46	5	12	0.3	0	-0.05	N-S

Bottom Steel

Governing Combination	No of Bars	Bar Size	Bar Spac (in)	Area Prov (sq in/ft)	Area Req (sq in/ft)	Moment (kip ft/ft)	Direction
2. 1.2Dead + 1.6Live	6	5	12	0.32	0.02	1.08	E-W
5. 1.2Dead + Live + 1.6Wind	46	5	12	0.3	0.01	0.49	N-S



Calculation Sheet

Gas Bottles Misc Support Calculations
 By R. Murphy Date: 12/16/2007

Project: BGCAPP
 Job Number: 743341
 Calc No: 24915-10-DBC-00-00004
 Rev. D
 Sheet No. D1-54 / D1-60

Dimensional Solutions Mat3D	Version	4.0.0	Date	1/22/2008
Foundation Name	Shed_Temp		Time	11:28:49 AM
Designed By:	Parsons	Engineer	Jeremy Tillman	Checker
Filename:	I:\Struct\SCWO 2007\SCWO Miscellaneous\STEEL\App D Gas Bottle Canopies\Gas Bottle Canopy #1\SAP Model\shed_temp.\$2k.m3d			

DETAIL REPORT

PUNCHING SHEAR

P2

Control Comb	Net Ult Load (kips)	Punch. Stress (psi)	All Stress (psi)	Rem
2. 1.2Dead + 1.6Live	8.50	2.80	189.74	

P3

Control Comb	Net Ult Load (kips)	Punch. Stress (psi)	All Stress (psi)	Rem
2. 1.2Dead + 1.6Live	7.37	2.43	189.74	

P1

Control Comb	Net Ult Load (kips)	Punch. Stress (psi)	All Stress (psi)	Rem
2. 1.2Dead + 1.6Live	4.70	2.10	189.74	

P4

Control Comb	Net Ult Load (kips)	Punch. Stress (psi)	All Stress (psi)	Rem
2. 1.2Dead + 1.6Live	1.08	0.48	189.74	



Calculation Sheet

Project: BGCAPP
 Job Number: 743341
 Calc No: 24915-10-DBC-00-00004
 Rev. D
 Sheet No. D1-55 / D1-60

Gas Bottles Misc Support Calculations
 By R. Murphy Date: 12/16/2007

Dimensional Solutions Mat3D	Version	4.0.0	Date	1/22/2008
Foundallon Name	Shed_Temp		Time	11:26:49 AM
Designed By:	Parsons	Engineer	Jeremy Tillman	Checker
Filename:	I:\Struct\SCWO 2007\SCWO Miscellaneous\STEEL\App D Gas Bottle Canopies\Gas Bottle Canopy #1\SAP Model\shed_temp.\$2k.m3d			

DETAIL REPORT

MAXIMUM SHEAR - X DIRECTION

Load Comb	Left Dist (ft)	Max Shear (kips)	Shear Stress (psi)	All Stress (psi)	Rem
1 - 1.4Dead	14.58	1.38	1.01	94.87	
2 - 1.2Dead + 1.6Live	14.58	5.14	3.75	94.87	
3 - 1.2Dead + Live	14.58	3.66	2.67	94.87	
4 - 1.2Dead + 0.8Wind	19.42	-1.35	0.98	94.87	
5 - 1.2Dead + Live + 1.6Wind	19.42	-3.61	2.63	94.87	
6 - 0.9Dead + 1.6Wind	19.42	-1.29	0.94	94.87	
7 - 1.2Dead + Live + Earthquake	14.58	3.52	2.57	94.87	
8 - 0.9Dead + Earthquake	19.42	-1.14	0.83	94.87	

MAXIMUM SHEAR - Z DIRECTION

Load Comb	Bottom Dist (ft)	Max Shear (kips)	Shear Stress (psi)	All Stress (psi)	Rem
1 - 1.4Dead	4.92	-1.19	0.11	94.87	
2 - 1.2Dead + 1.6Live	4.92	-4.44	0.40	94.87	
3 - 1.2Dead + Live	4.92	-3.16	0.28	94.87	
4 - 1.2Dead + 0.8Wind	4.92	-2.58	0.23	94.87	
5 - 1.2Dead + Live + 1.6Wind	4.92	-6.26	0.56	94.87	
6 - 0.9Dead + 1.6Wind	4.92	-3.87	0.35	94.87	
7 - 1.2Dead + Live + Earthquake	4.92	-4.14	0.37	94.87	
8 - 0.9Dead + Earthquake	4.92	-1.75	0.16	94.87	



Calculation Sheet

Gas Bottles Misc Support Calculations
 By R. Murphy Date: 12/16/2007

Project: BGCAPP
 Job Number: 743341
 Calc No: 24915-10-DBC-00-00004
 Rev. D
 Sheet No. D1-56 / D1-60

Dimensional Solutions Mat3D	Version	4.0.0	Date	1/22/2008
Foundation Name	Shed_Temp		Time	11:28:49 AM
Designed By:	Parsons	Engineer	Jeremy Tillman	Checker
Filename:	I:\Struct\SCWO 2007\SCWO Miscellaneous\STEEL\App D Gas Bottle Canopies\Gas Bottle Canopy #1\SAP Model\shed_temp.\$2k.m3d			

DETAIL REPORT

PIER/BASE PLATE DESIGN INFORMATION

	P2	P3	P1	P4
X Dim (ft)	1.50	1.50	1.50	1.50
Z Dim (ft)	1.50	1.50	1.50	1.50
Height (ft)	0.50	0.50	0.50	0.50
X Offset (ft)	17.00	32.00	1.50	44.83
Z Offset (ft)	2.50	2.50	2.50	2.50
Requested Reinf. Ratio	0.0018	0.0018	0.0018	0.0018
Provided Reinf. Ratio	0.0055	0.0055	0.0055	0.0055
Long Bar Size	6	6	6	6
Bars in X Dir	2	2	2	2
Bars in Z Dir	2	2	2	2
Total Long Bars	4	4	4	4
Tie Bar Size	3	4	4	4
Total No. of Ties	6	4	3	3
Major Tie Spacing (in)	0	0	1	1



Calculation Sheet

Project: BGCAPP
 Job Number: 743341
 Calc No: 24915-10-DBC-00-00004
 Rev. D
 Sheet No. D1-57 / D1-60

Gas Bottles Misc Support Calculations
 By R. Murphy Date: 12/16/2007

Dimensional Solutions Mat3D	Version	4.0.0	Date	1/22/2008
Foundation Name	Shed_Temp		Time	11:28:48 AM
Designed By:	Parsons	Engineer	Jeremy Tillman	Checker
	I:\Struct\SCWO 2007\SCWO Miscellaneous\STEEL\App D Gas Bottle Canopies\Gas Bottle Canopy #1			
Filename:	SAP Model\shed_temp.\$2k.m3d			

DETAIL REPORT

PIER ULTIMATE LOAD CAPACITIES

P2

Load Comb	Axial Load (kips)	Axial Capa. (kips)	Mom X (kip ft)	Mom X Capa (kip ft)	Mom Z (kip ft)	Mom Z Capa (kip ft)	Rem
1 - 1.4Dead	3.92	624.85	0.37	59.37	0.37	59.37	
2 - 1.2Dead + 1.6Live	13.60	624.85	1.29	59.37	1.29	59.37	
3 - 1.2Dead + Live	9.76	624.85	0.93	59.37	0.93	59.37	
4 - 1.2Dead + 0.8Wind	3.60	153.05	2.65	111.13	0.92	38.51	
5 - 1.2Dead + Live + 1.6Wind	10.24	227.84	5.84	129.60	1.83	40.74	
6 - 0.9Dead + 1.6Wind	3.00	43.57	5.15	74.75	1.83	26.62	
7 - 1.2Dead + Live + Earthquake	9.92	456.88	2.36	108.02	1.59	72.94	
8 - 0.9Dead + Earthquake	2.68	124.79	1.67	76.11	1.59	72.51	

P3

Load Comb	Axial Load (kips)	Axial Capa. (kips)	Mom X (kip ft)	Mom X Capa (kip ft)	Mom Z (kip ft)	Mom Z Capa (kip ft)	Rem
1 - 1.4Dead	3.65	624.85	0.35	59.37	0.35	59.37	
2 - 1.2Dead + 1.6Live	12.47	624.85	1.19	59.37	1.19	59.37	
3 - 1.2Dead + Live	8.97	624.85	0.85	59.37	0.85	59.37	
4 - 1.2Dead + 0.8Wind	3.35	141.16	2.57	106.64	0.92	39.01	
5 - 1.2Dead + Live + 1.6Wind	9.40	207.87	5.68	125.06	1.85	40.77	
6 - 0.9Dead + 1.6Wind	2.78	40.72	4.99	73.15	1.85	27.07	
7 - 1.2Dead + Live + Earthquake	8.97	423.08	2.39	111.55	1.60	75.01	
8 - 0.9Dead + Earthquake	2.35	99.22	1.70	70.52	1.60	66.43	

P1

Load Comb	Axial Load (kips)	Axial Capa. (kips)	Mom X (kip ft)	Mom X Capa (kip ft)	Mom Z (kip ft)	Mom Z Capa (kip ft)	Rem
1 - 1.4Dead	2.31	624.85	0.22	59.37	0.22	59.37	
2 - 1.2Dead + 1.6Live	7.18	538.29	1.54	108.28	0.68	42.33	
3 - 1.2Dead + Live	5.23	537.60	1.01	103.53	0.50	51.46	
4 - 1.2Dead + 0.8Wind	2.10	68.28	2.70	86.82	0.92	29.75	
5 - 1.2Dead + Live + 1.6Wind	5.47	85.53	6.16	95.72	1.83	28.66	
6 - 0.9Dead + 1.6Wind	1.72	20.96	5.24	63.74	1.83	22.28	
7 - 1.2Dead + Live + Earthquake	5.23	217.71	2.72	112.05	1.59	65.63	
8 - 0.9Dead + Earthquake	1.48	57.74	1.80	69.63	1.59	61.77	



Calculation Sheet

Gas Bottles Misc Support Calculations
 By R. Murphy Date: 12/16/2007

Project: BGCAPP
 Job Number: 743341
 Calc No: 24915-10-DBC-00-00004
 Rev. D
 Sheet No. D1-58 / D1-60

Dimensional Solutions Mat3D	Version	4.0.0	Date	1/22/2008
Foundation Name	Shed_Temp		Time	11:28:49 AM
Designed By:	Parsons	Engineer	Jeremy Tillman	Checker
Filename:	I:\Struct\SCWO 2007\SCWO Miscellaneous\STEEL\App D Gas Bottle Canopies\Gas Bottle Canopy #1			
	SAP Model\shed_temp.\$2k.m3d			

DETAIL REPORT


P4

Load Comb	Axial Load (kips)	Axial Capa. (kips)	Mom X (kip ft)	Mom X Capa (kip ft)	Mom Z (kip ft)	Mom Z Capa (kip ft)	Rem
1 - 1.4Dead	2.04	624.85	0.19	59.37	0.19	59.37	
2 - 1.2Dead + 1.6Live	6.05	497.88	1.44	117.46	0.58	47.22	
3 - 1.2Dead + Live	4.44	521.25	0.94	109.66	0.42	49.64	
4 - 1.2Dead + 0.8Wind	1.85	59.85	2.56	82.49	0.92	29.82	
5 - 1.2Dead + Live + 1.6Wind	4.65	71.41	5.83	88.73	1.85	28.36	
6 - 0.9Dead + 1.6Wind	1.52	19.11	4.98	62.55	1.85	23.23	
7 - 1.2Dead + Live + Earthquake	4.44	189.29	2.43	103.06	1.59	67.64	
8 - 0.9Dead + Earthquake	1.31	54.73	1.58	65.49	1.59	65.86	

Gas Bottles Misc Support Calculations
 By R. Murphy Date: 12/16/2007

Dimensional Solutions Mat3D	Version	4.0.0	Date	1/22/2008
Foundation Name	Shed_Temp		Time	11:28:49 AM
Designed By:	Parsons	Engineer	Jeremy Tillman	Checker
				N/A
Filename:	I:\Struct\SCWO 2007\SCWO Miscellaneous\STEEL\App D Gas Bottle Canopies\Gas Bottle Canopy #1\SAP Model\shed_temp.\$2k.m3d			

DETAIL REPORT

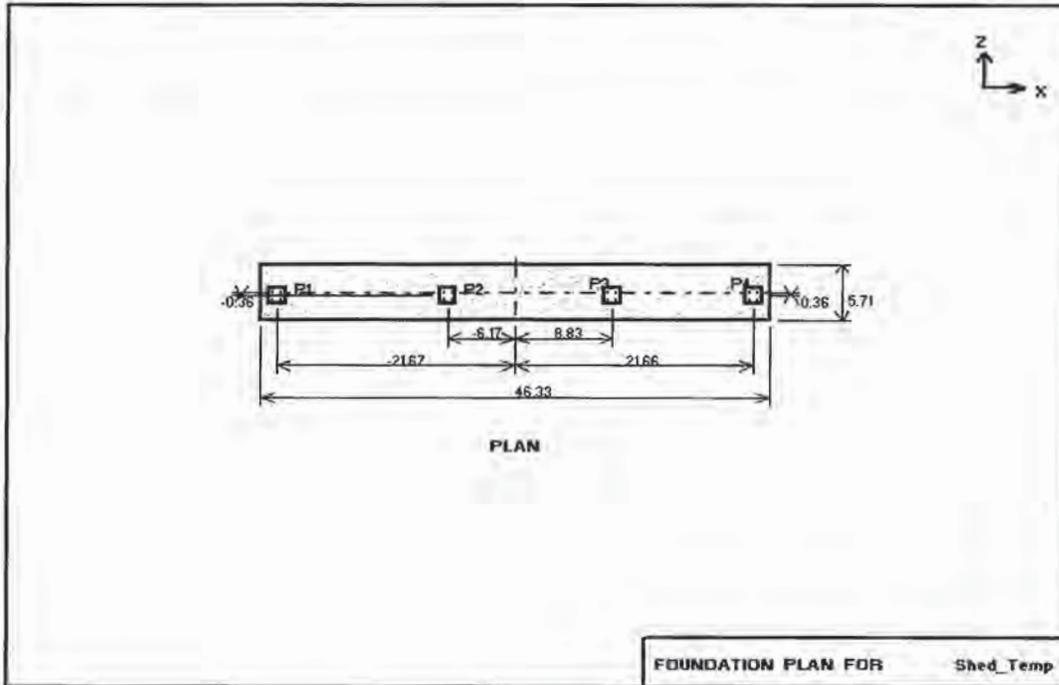

Calculation Sheet

Project:	BGCAPP
Job Number:	743341
Calc. No.	24915-10-DBC-00-00004
Sheet No.	D1-60 / D1-60
Sheet Rev.	D

Subject: Gas Bottles Canopy, Supports, Equip, & Misc Foundations

By: R. Murphy

Date: 12/16/2007

D1.5. Summary

The calculation performed in this appendix includes structural analysis and design of a combined footing gas bottle canopy #1. No soil uplift is observed under worst-case overturning loads, and wind and seismic sliding resistance of the foundations is adequate.

The footing is 2'-0" thick with top of slab 6" above finished grade. Reinforcement is as follows:

#5 @ 12" o.c. E-W top.

#5 @ 12" o.c. N-S top.

#5 @ 12" o.c. E-W bottom.

#5 @ 12" o.c. N-S bottom.

(4) additional horizontal #6 bars E-W at bottom under each pier.

Piers 1, 2, 3 & 4 are 1'-6" square and are 6" tall. Top of pier is 1'-0" above finished grade.

Reinforcement is (4) #6 longitudinal bars with (4) #3 ties.



A Joint Venture of Bechtel National, Inc. and
Parsons Infrastructure & Technology Group Inc.

Calculation Sheet

Project:	BGCAPP
Job Number:	743341
Calc. No.	24915-10-DBC-00-00004
Sheet No.	D2-1 / D2-51
Sheet Rev.	D

Subject: Gas Bottles Canopy, Supports, Equip, & Misc Foundations

By: R. Murphy

Date: 12/16/2007

Appendix D2

Gas Bottle Canopy #2 Foundation



A Joint Venture of Bechtel Group, Inc. and Parsons Infrastructure & Technology Group Inc.

Calculation Sheet

Project:	BGCAPP
Job Number:	743341
Calc. No.	24915-10-DBC-00-00004
Sheet No.	D2-2 / D2-51
Sheet Rev.	D

Subject: Gas Bottles Canopy, Supports, Equip, & Misc Foundations
By: R. Murphy Date: 12/16/2007

D2.1. Objective

The calculation performed in this appendix includes structural analysis and design of the combined footing for a gas bottle canopy on the exterior of the western wall of the SCWO Processing Building (SPB) between column lines A and B.

D2.2. Inputs

Refer to drawing 24915-10-DB-00-00038 for footing dimensions and reinforcement.

Refer to drawing 24915-10-SS-00-00052 for column base plate detail.

- (1) Footing loads are taken from GTSTRUDL base reactions.
- (2) Maximum soil bearing pressure is 3000 psf.
- (3) A test case is run in MathCad to show the process of checking the base plate and anchor bolts. All load cases are checked in Excel following the same procedure.

D2.3. Assumptions

It is assumed that wind loads and snow loads are applied evenly over the surface of the canopy. No uneven loading is considered, so the reactions applied to the foundation will be equal or equal and opposite for wind and snow load conditions.

D2.4. Calculation Body

Base reactions from GTSTRUDL steel analysis and design are given here. These loads are the input for the Mat3D footing design. The footing design check in Mat3D is included as well.



A Joint Venture of Bechtel National, Inc. and Parsons Infrastructure & Technology Group Inc.

Calculation Sheet

Project: BGCAPP
 Job Number: 743341
 Calc. No. 24915-10-DBC-00-00004
 Sheet No. D2-3 / D2-51
 Sheet Rev. D

Subject: Gas Bottles Canopy, Supports, Equip, & Misc Foundations
 By: R. Murphy Date: 12/16/2007

Reaction Values from GTSTRUDL Analysis (units: kip, ft)

JOINT #	LOAD	Y FORCE	X FORCE	Z MOMENT	Z FORCE	X MOMENT
9	Dead	1.874	-0.001	-0.062	0.173	0.484
9	Snow	1.842	-0.002	0.091	0.267	0.740
9	WLEW1	0.488	-0.774	6.447	0.043	0.127
9	WLEW2	0.486	-0.774	6.058	0.048	0.139
9	WLEW3	0.745	-0.752	6.167	0.069	0.200
9	WLEW4	0.772	-0.750	5.531	0.079	0.227
9	WLNS	-0.214	-0.071	0.614	0.133	0.545
9	EQX	0.012	0.342	3.068	0.003	0.009
9	EQY	0.183	0.004	0.032	0.409	1.930
JOINT #	LOAD	Y FORCE	X FORCE	Z MOMENT	Z FORCE	X MOMENT
10	Dead	1.932	0.001	-0.007	-0.173	-0.494
10	Snow	2.005	0.002	0.220	-0.267	-0.764
10	WLEW1	0.488	-0.774	6.447	-0.043	-0.127
10	WLEW2	0.486	-0.774	6.058	-0.048	-0.139
10	WLEW3	0.745	-0.752	6.167	-0.069	-0.200
10	WLEW4	0.772	-0.750	5.531	-0.079	-0.227
10	WLNS	-0.335	-0.075	0.636	0.213	0.769
10	EQX	0.010	0.358	3.201	0.003	0.009
10	EQY	0.183	0.004	0.032	0.409	1.930

Project:	BGCAPP
Job Number:	743341
Calc. No.	24915-10-DBC-00-00004
Sheet No.	D2-4 / D2-51
Sheet Rev.	D

Subject: Gas Bottles Canopy, Supports, Equip, & Misc Foundations
By: R. Murphy Date: 12/16/2007

D2.4.1 Base Plate and Anchor Bolt Design

Following is the MathCad calculation checking the base plate and anchor bolts for the HSS posts.

Base Plate and Anchor Bolt Design for HSS Section

This worksheet is used to illustrate the procedure to design the base plate and anchor bolts for a moment connected HSS column. Corresponding Excel spreadsheets are used to apply these calculations to a large data set. A test case is calculated using this worksheet to verify the accuracy of the excel spreadsheets. The test case is for the reactions at Joint 9 (see GTSTRUDL model) resulting from the load combination 'COMBO_4A'. Since the moment about the two rotational axes (MX and MZ) are considered separately, only MX is included in the test case. The test case values are highlighted in the excel spread sheet. To indicate to which spreadsheets the values in this calculation correlate, the following short hand notation is used.

BPJ9 = "BasePlate Joint 9"

JR = "Joint Reactions"

ATJ9 = "Anchor Tension Joint 9"


ASJ = "Anchor Shear Joint"

IC = "Interaction Check"


Calculation Sheet

Project: BGCAPP
Job Number: 743341
Calc. No.: 24915- 10-DBC-00-00004
Sheet No.: D2-5 / D2-51
Sheet Rev.: D

Subject: Gas Bottle Canopy, supports, equip, & misc. fdn.
By: R. Murphy
Date: 1/20/2008

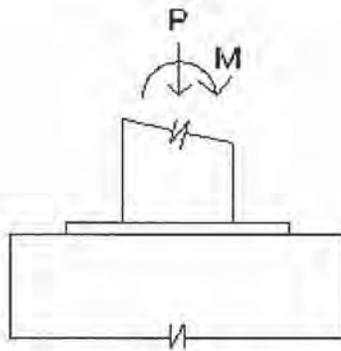

Elevation

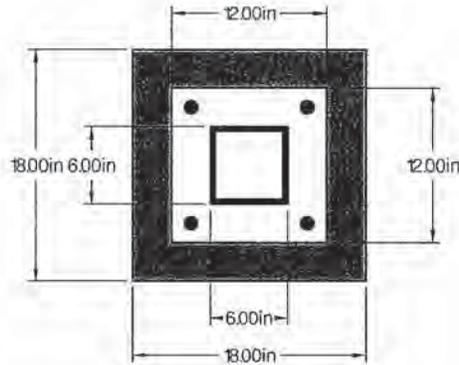

Plan

Force Properties (See Section D2.4.2)

[JR Column E]	$P := 3.0127\text{kip}$	[JR Column D]	$V_1 := 0.5767\text{kip}$
[JR Column I]	$M := 52.2029\text{kip}\cdot\text{in}$	[JR Column F]	$V_2 := 0.2445\text{kip}$
[BPJ9 Column E]	$e := \frac{M}{P} \quad e = 17.33\text{-in}$		

Geometric Properties (Base Plate)

[BPJ9 Cell E6]	$t := .75\text{in}$	plate thickness
	$N_{\text{plate}} := 12\text{in}$	baseplate edge length
[BPJ9 Cell D6]	$c_{\text{plate}} := 6\text{in}$	distance to plate's neutral axis
[BPJ9 Cell G6]	$d := 6\text{in}$	depth of column
	$n := \frac{N_{\text{plate}}}{2} - \frac{0.95\cdot d}{2}$	distance from edge of plate to column face
	$n = 3.15\text{-in}$	
	$A_1 := 12\text{in}\cdot 12\text{in}$	
[BPJ9 Cell A6]	$A_1 = 144\cdot\text{in}^2$	
[BPJ9 Cell C6]	$I := \frac{1}{12}\cdot(12\text{in})^4 \quad I = 1728\cdot\text{in}^4$	

Geometric Properties (Pedestal)


	$A_2 := 18\text{in}\cdot 18\text{in}$
	$A_2 = 324\cdot\text{in}^2$
	$A := 12\text{in}\cdot 12\text{in}$
	$A = 144\text{in}^2$
	$Z_y := \frac{t^2\cdot 1\text{in}}{6} \quad Z_y = 0.094\cdot\text{in}^3$

Calculation Sheet

Project: BGCAPP
Job Number: 743341
Calc. No.: 24915- 10-DBC-00-00004
Sheet No.: D2-6 / D2-51
Sheet Rev.: D


Subject: Gas Bottle Canopy, supports, equip, & misc. fdn.
By: R. Murphy
Date: 1/20/2008

Design Forces

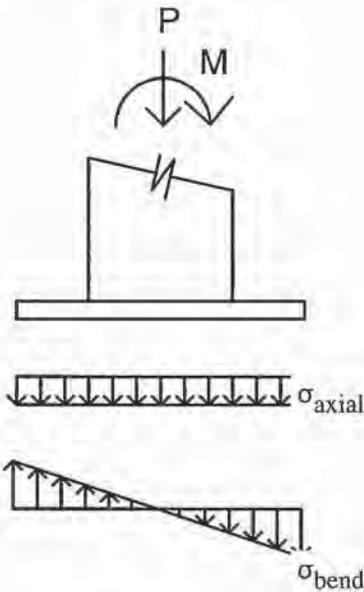


Stress Resultants

if $\sigma_{axial} = \sigma_{bending}$

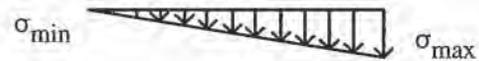

if $\sigma_{axial} > \sigma_{bending}$

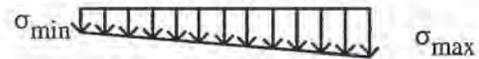

if $\sigma_{axial} < \sigma_{bending}$



Stress Calculations

[BPJ9 Column F] $\sigma_{axial} := \frac{P}{A}$ $\sigma_{axial} = 0.0209 \cdot \text{ksi}$

[BPJ9 Column G] $\sigma_{bend} := |M| \cdot \frac{c_{plate}}{I}$ $\sigma_{bend} = 0.1813 \cdot \text{ksi}$


Total Stress

[BPJ9 Column H] $\sigma_{max} := \sigma_{axial} + \sigma_{bend}$ $\sigma_{max} = 0.2022 \cdot \text{ksi}$

[BPJ9 Column I] $\sigma_{min} := \sigma_{axial} - \sigma_{bend}$ $\sigma_{min} = -0.1603 \cdot \text{ksi}$

Subject: Gas Bottle Canopy, supports, equip, & misc. fdn.
By: R. Murphy
Date: 1/20/2008

Calculating Force Resultants

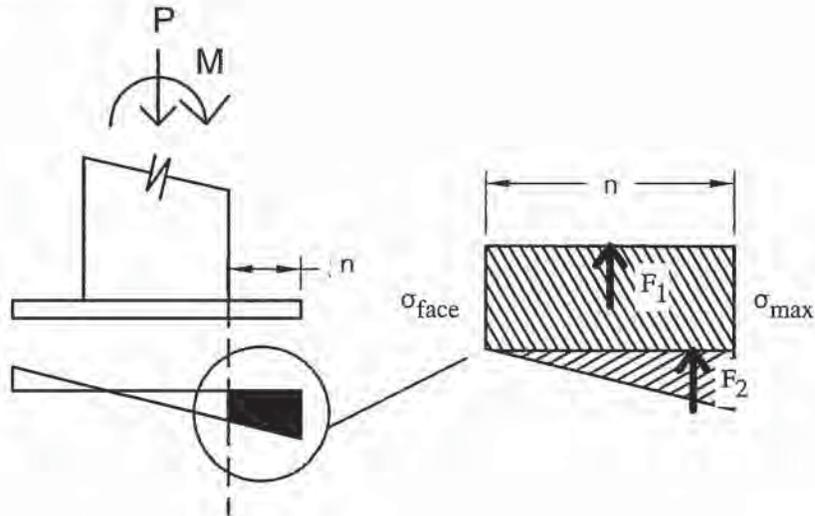

[BPJ9 Column K] $stress_slope := \frac{\sigma_{max} - \sigma_{min}}{N_{plate}}$ $stress_slope = 0.0302 \cdot \frac{kip}{in^3}$

[BPJ9 Column L] $\sigma_{face} := \sigma_{max} - stress_slope \cdot (n)$ $\sigma_{face} = 0.107 \cdot ksi$

Rectangular Stress Block Resultants $n = 3.15 \text{ in}$

[BPJ9 Column M] $F_{rect} := \sigma_{face} \cdot n \cdot 1 \text{ in}$ $F_{rect} = 0.3371 \cdot kip$

[BPJ9 Column O] $M_{rect} := F_{rect} \cdot \frac{n}{2}$ $M_{rect} = 0.531 \cdot kip \cdot in$

Triangular Stress Block Resultants

[BPJ9 Column N] $F_{tri} := \frac{(\sigma_{max} - \sigma_{face}) \cdot n \cdot 1 \text{ in}}{2}$ $F_{tri} = 0.1499 \cdot kip$

[BPJ9 Column P] $M_{tri} := F_{tri} \cdot 2 \cdot \frac{n}{3}$ $M_{tri} = 0.3147 \cdot kip \cdot in$

Total Moment Per Unit Width

$M_{design} := M_{rect} + M_{tri}$

[BPJ9 Column Q] $M_{design} = 0.8457 \cdot kip \cdot in$

Subject: Gas Bottle Canopy, supports, equip, & misc. fdn.
By: R. Murphy
Date: 1/20/2008

Base Plate Design [AISC-LRFD 2nd ED J9]

1. Concrete Bearing Stress [AISC LRFD-2nd ED J9]

[BPJ9 Cell L6]

$$f_c := 4 \text{ ksi}$$

[BPJ9 Cell K6]

$$\Phi_c := .6$$

$$A_{\text{ratio}} := \text{if} \left[\left(\frac{A_2}{A_1} \right)^{\frac{1}{2}} < 2, \left(\frac{A_2}{A_1} \right)^{\frac{1}{2}}, 2 \right]$$

[BPJ9 Cell J6]

$$A_{\text{ratio}} = 1.5$$

$$F_p := \Phi_c \cdot 0.85 \cdot f_c \cdot A_{\text{ratio}} \quad [\text{AISC LRFD-2nd ED EQ J9-2}]$$

[BPJ9 Cell M6]

$$F_p = 3.06 \cdot \text{ksi}$$

$$\text{pedestal_design} := \text{if}(\sigma_{\text{max}} < F_p, G_{\text{pedestal}}, \text{NG}_{\text{pedestal}})$$

[BPJ9 Column T]

$$\text{pedestal_design} = \text{"Pedestal design is good"}$$

2. Plate Thickness [AISC LRFD-2nd ED]

$$\Phi_{\text{flex}} := .90 \quad F_y := 36 \text{ ksi}$$

[BPJ9 Column R]

$$t_p := \sqrt{4 \cdot \frac{M_{\text{design}} \cdot l}{\Phi_{\text{flex}} \cdot F_y \cdot 1 \text{ in}}} \quad t_p = 0.3231 \cdot \text{in} \quad [\text{AISC LRFD-2nd ED 14-6}]$$

Plate Bending Strength per unit width

$$M_{\text{strength}} := \Phi_{\text{flex}} \cdot F_y \cdot Z_y \quad M_{\text{strength}} = 3.037 \cdot \text{kip} \cdot \text{in}$$

Design Check

$$\text{base_plate_design} := \text{if}(t > t_p, G_d, \text{NG})$$

[BPJ9 Column S]


$$\text{base_plate_design} = \text{"Base Plate Design is Good"}$$

Subject: Gas Bottle Canopy, supports, equip, & misc. fdn.
 By: R. Murphy
 Date: 1/20/2008

Anchor Bolt Design

References:

- AISC LRFD 2nd ed. Steel Design Guide:
Base Plate and Anchor Rod Design
- ACI 318-02

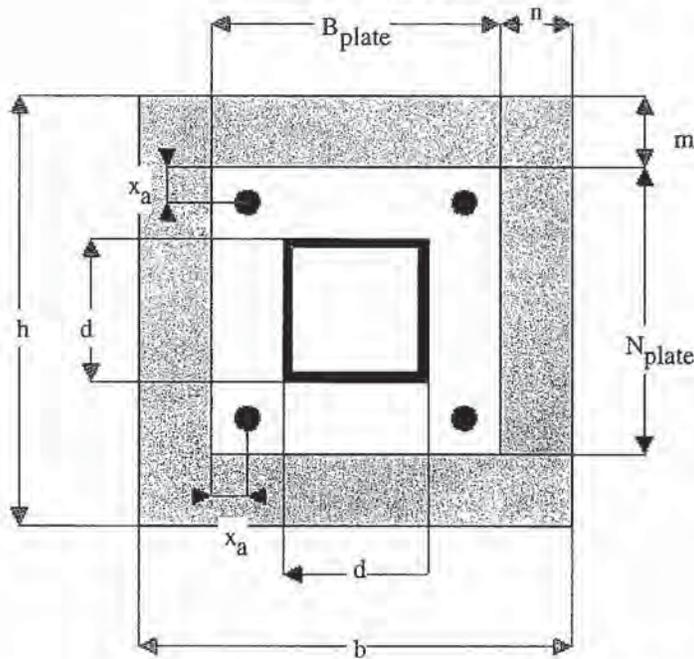


- [ATJ9 Cell A4] $N_{plate} = 12\text{-in}$
- [ATJ9 Cell C4] $x_a := 1.5\text{in}$
- $N' := N_{plate} - x_a$
- [ATJ9 Cell D4] $N' = 10\text{-in}$
- [ATJ9 Cell B4] $B := N_{plate}$
- [ATJ9 Cell E4] $A' := 4.5\text{in}$
- [BPJ9 Column H] $f_p := \sigma_{max}$
- [ATJ9 Column E] $e = 17\text{-in}$


Tension in Anchor Bolt due to Moment

[AISC Design Guide Appendix B]

if $e < e_{kern}$

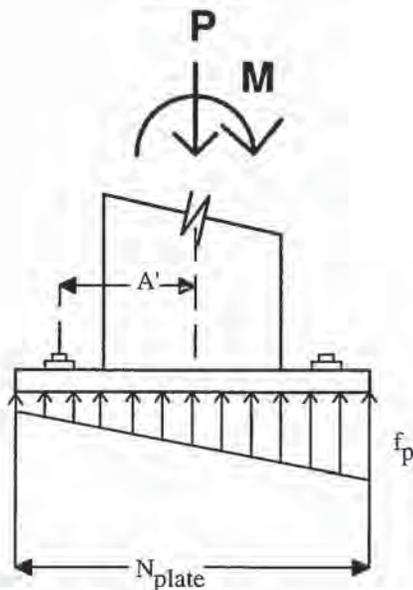

if $e > e_{kern}$

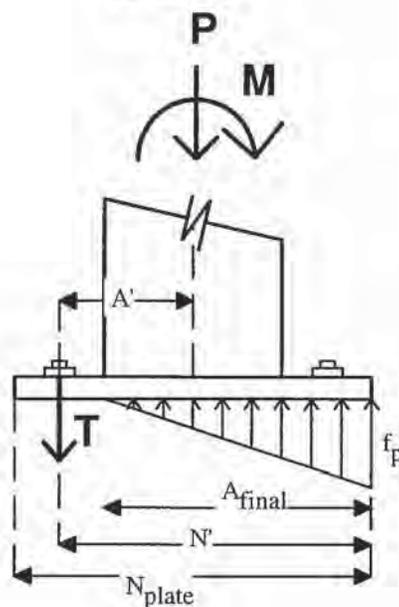

Subject: Gas Bottle Canopy, supports, equip, & misc. fdn.
By: R. Murphy
Date: 1/20/2008

Determining effects of eccentricity [AISC LRFD B.3]

[ATJ9 Cell F4]
$$e_{kern} := \frac{N_{plate}}{6} \quad \boxed{e_{kern} = 2 \cdot in} \quad [AISC B.3]$$

$$anchor_tension := \text{if}(e > e_{kern}, BT, NBT)$$

anchor_tension = "Anchor bolts in tension"

Determining Tension in Anchor Bolt [AISC B.4.2]

$P = 3013 \text{ lbf}$

$f_p = 0 \cdot \text{ksi}$

$B = 1 \text{ ft}$

Determining Length of Stress Triangle

[ATJ9 Column H]
$$f := f_p \cdot N_{plate} \cdot \frac{N'}{2} \quad \boxed{f = 12.7374 \cdot \text{kip}}$$

[ATJ9 Column I]
$$A_{plus} := \frac{f + \sqrt{f^2 - 4 \cdot \left(f_p \cdot \frac{B}{6}\right) \cdot (P \cdot A' + M)}}{f_p \cdot \frac{B}{3}} \quad \boxed{A_{plus} = 24.993 \cdot in}$$

[ATJ9 Column J]
$$A_{minus} := \frac{f - \sqrt{f^2 - 4 \cdot \left(f_p \cdot \frac{B}{6}\right) \cdot (P \cdot A' + M)}}{f_p \cdot \frac{B}{3}} \quad \boxed{A_{minus} = 6.507 \cdot in}$$

[ATJ9 Column K]
$$A_{final} := \begin{cases} \min(A_{plus}, A_{minus}) & \text{if } A_{plus} > 0 \wedge A_{minus} > 0 \\ A_{plus} & \text{if } A_{plus} > 0 \wedge A_{minus} < 0 \\ 0 & \text{if } A_{plus} < 0 \wedge A_{minus} < 0 \end{cases} \quad \boxed{A_{final} = 6.507 \cdot in}$$


Determining Anchor Tension from Equilibrium

[ATJ9 Column L]
$$T_{anchors} := \frac{f_p \cdot A_{final} \cdot B}{2} - P \quad \boxed{T_{anchors} = 4.8807 \cdot \text{kip}}$$

[ATJ9 Column M]
$$T_{one_anchor} := \frac{T_{anchors}}{2} \quad \boxed{T_{one_anchor} = 2.4403 \cdot \text{kip}}$$

Subject: Gas Bottle Canopy, supports, equip, & misc. fdn.
By: R. Murphy
Date: 1/20/2008

Pedestal and Foundation Cross Section

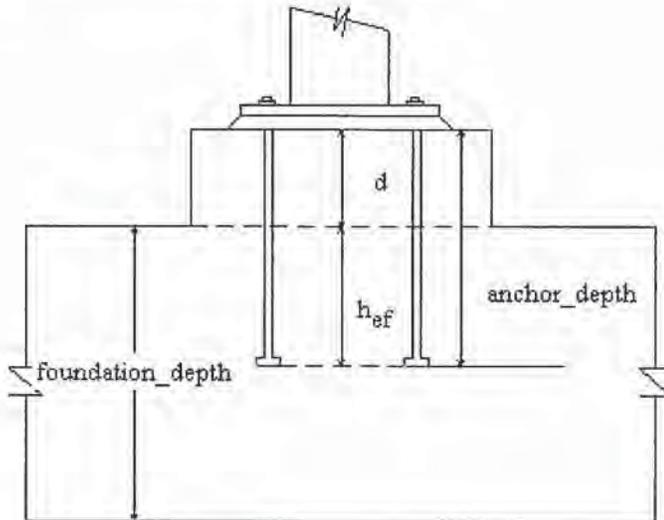

$$\begin{aligned} \text{anchor_depth} &:= 14\text{in} \\ d &:= 6\text{in} \\ h_{ef} &:= \text{anchor_depth} - d \\ h_{ef} &= 8\text{in} \end{aligned}$$

To simplify the calculation, the effective embedment depth of the anchor bolt is taken as the length of the bolt that extends beneath the column pedestal. This results in a conservative estimate of the strength of concrete breakout and pryout.

Steel Strength of anchor in tension [ACI 318.05 D.5.1]

$$f_{ya} := 36\text{ksi} \quad n_{\text{anch}} := 4$$

$$f_{uta} := \min(1.9 \cdot f_{ya}, 125\text{ksi}, 58\text{ksi})$$

$$f_{uta} = 58000 \text{ psi}$$

$$d_o := 0.75\text{in}$$

$$n_t := \frac{10}{\text{in}} \quad [\text{AISC LRFD-05 Table 7-18}]$$

$$A_{se} := \frac{\pi}{4} \cdot \left(d_o - \frac{0.9743}{n_t} \right)^2$$

$$A_{se} = 0.3345 \text{ in}^2 \quad \text{Net tensile area}$$

$$N_{sa} := n_{\text{anch}} \cdot A_{se} \cdot f_{uta} \quad [\text{ACI 318.05 Eq D-3}]$$

[ATJ9 Cell L5]

$$N_{sa} = 77.595 \text{ kip} \quad \text{one anchor}$$

Subject: Gas Bottle Canopy, supports, equip, & misc. fdn.
By: R. Murphy
Date: 1/20/2008

Concrete breakout strength-Tension [ACI 318.05 D.5.2]

Concrete breakout strength based on a grouping of two anchors, since tension due to moment is the only tension present.

$$\begin{aligned} c_{a1} &:= 4.5\text{in} & s_1 &:= 9\text{in} \\ c_{a2} &:= 4.5\text{in} & s_2 &:= 9\text{in} \\ c_{a11} &:= 4.5\text{in} & f_c &= 4000\text{psi} \\ c_{a22} &:= 4.5\text{in} \end{aligned}$$

$$c_{amin} := \min(c_{a1}, c_{a11}, c_{a2}, c_{a22})$$

$$n_{anch_ten} := 2$$

Breakout Prism Properties

$$h'_{ef} := h_{ef}$$

$$A_{NCO} := 9 \cdot h'_{ef}{}^2$$

$$A_{NCO} = 576 \cdot \text{in}^2$$

$$A_{NC} := (1.5 \cdot h'_{ef} + s_1 + 1.5 \cdot h'_{ef}) \cdot (1.5 \cdot h'_{ef} + 1.5 \cdot h'_{ef})$$

$$A_{NC} = 792 \cdot \text{in}^2$$

$$A_{NC} := \min(A_{NC}, n_{anch_ten} \cdot A_{NCO})$$

$$A_{NC} = 792 \cdot \text{in}^2$$

$$\text{anchor_status} := \text{"cast in"}$$

$$k_c := \text{if}(\text{anchor_status} = \text{"cast in"}, 24, 17)$$

$$k_c = 24$$

$$N_b := \begin{cases} 16 \cdot \text{psi} \cdot \text{in}^{\frac{1}{3}} \cdot \sqrt{f_c} \cdot h'_{ef}{}^{\frac{5}{3}} & \text{if } 11\text{in} \leq h'_{ef} \leq 25\text{in} \\ k_c \cdot \sqrt{f_c} \cdot h'_{ef}{}^{1.5} \cdot \text{psi} \cdot \text{in}^{\frac{5}{3}} & \text{otherwise} \end{cases}$$

[ACI 318-05 EQ D-7]

[ACI 318-05 EQ D-8]

$$N_b = 34346 \text{ lbf}$$

Subject: Gas Bottle Canopy, supports, equip, & misc. fdn.
By: R. Murphy
Date: 1/20/2008

$$e'_N := 4.5\text{in}$$

Assumption that only one row of anchors on one side of the column center line carry tension load. Eccentricity is therefore distance from this row of anchors to the column center line

$$\psi_{ecN} := \min\left(\frac{1}{1 + \frac{2 \cdot e'_N}{3 \cdot h'_{ef}}}, 1.0\right) \quad [\text{ACI 318-05 EQ D-9}]$$

$$\psi_{ecN} = 1$$

$$\psi_{edN} := \begin{cases} 1 & \text{if } c_{amin} \geq 1.5 \cdot h'_{ef} \\ 0.7 + 0.3 \cdot \frac{c_{amin}}{1.5(h'_{ef})} & \text{if } c_{amin} < 1.5 \cdot h'_{ef} \end{cases} \quad \begin{matrix} [\text{ACI 318-05 EQ D-10}] \\ [\text{ACI 318-05 EQ D-11}] \end{matrix}$$

$$\psi_{edN} = 1$$

$$\psi_{cN} := \begin{cases} 1.25 & \text{if anchor_status} = \text{"cast in"} \\ 1.4 & \text{otherwise} \end{cases} \quad [\text{ACI 318-05 EQ D.5.2.6}]$$

$$\psi_{cN} = 1$$

$$\psi_{cpN} := 1 \quad [\text{ACI 318-05 D5.2.7}]$$

$$N_{cbg} := \frac{A_{NC}}{A_{NCO}} \cdot \psi_{ecN} \cdot \psi_{edN} \cdot \psi_{cN} \cdot \psi_{cpN} \cdot N_b \quad [\text{ACI 318-05 EQ D-5}]$$

[ATJ9 Cell M5]

$$N_{cbg} = 34.883 \cdot \text{kip} \quad \text{Group of two anchors}$$

Pullout Strength of Anchor in Tension [ACI 318-05 D.5.3]

$$A_{brg} := 0.654\text{in}^2 \quad \text{crack_status} := \text{"not cracked"} \quad \text{hook_status} := \text{"not hooked"}$$

$$N_p := 8 \cdot A_{brg} \cdot f_c \quad [\text{ACI 318-02 EQ D-15}]$$

$$\psi_{cP} := \text{if}[(\text{crack_status} = \text{"cracked"}), 1.4, 1.0] \quad [\text{ACI 318-05 D.5.3.6}]$$

$$N_{pn} := \psi_{cP} \cdot N_p \quad [\text{ACI 318-02 EQ D-14}]$$

[ATJ9 Cell N5]

$$N_{pn} = 20.928 \cdot \text{kip} \quad \text{One Anchor}$$

Subject: Gas Bottle Canopy, supports, equip, & misc. fdn.
By: R. Murphy
Date: 1/20/2008

Concrete side-face blowout strength-Tension [ACI 318.05 D.5.4]

$$c_{a1} = 0 \text{ ft}$$

$$N_{sb} := 160 \frac{\text{lb}}{\text{in}} \cdot c_{a1} \cdot \sqrt{\frac{A_{brg}}{\text{in}^2}} \cdot \sqrt{\frac{f_c}{\text{psi}}} \quad [\text{ACI 318-05 EQ D-17}] \quad A_{brg} = 1 \cdot \text{in}^2$$

[ATJ9 Cell O5] $N_{sb} = 36.826 \text{ kip}$ one anchor

Tension Design Check

$N_{sa} = 77595 \text{ lbf}$ one anchor $N_{pn} = 20928 \text{ lbf}$ one anchor

$N_{cbg} = 34883 \text{ lbf}$ two anchors $N_{sb} = 36826 \text{ lbf}$ one anchor

$\Phi_{tension} := 0.85$ Anchor governed by concrete breakout, side-face blowout, pullout, or pryout strength. Condition A is met [ACI 318-05 D.4.4]

$$N_{design} := \Phi_{tension} \cdot \min \left(N_{sa}, \frac{N_{cbg}}{2}, N_{pn}, N_{sb} \right) \quad [\text{ACI 318-05 D.4.1.1}]$$

[ATJ9 Cell H4] $N_{design} = 14.825 \text{ kip}$

$$T_{one_anchor} = 2440 \text{ lbf}$$

$$tension_design := \text{if} (T_{one_anchor} \leq N_{design}, \text{"Good"}, \text{"Not Good"}) \quad [\text{ACI 318-05 EQ D-1}]$$

[ATJ9 Column M-Q] $tension_design = \text{"Good"}$

Calculation Sheet

Project: BGCAPP
Job Number: 743341
Calc. No.: 24915- 10-DBC-00-00004
Sheet No.: D2-15 / D2-51
Sheet Rev.: D

Subject: Gas Bottle Canopy, supports, equip, & misc. fdn.
By: R. Murphy
Date: 1/20/2008

Steel Strength of Anchor in Shear [ACI 318-05 D.6.1]

Anchor Types:

AT1 [ACI 318-05 D.6.1.a]

AT2 [ACI 318-05 D.6.1.b]

AT3 [ACI 318-05 D.6.1.c]

Anchor Type Used:

AT := "AT1"

Grout Pad Factor [ACI 318-05 D.6.1.3]:

grout_pad_used := "yes"

$$c_{pad} := \begin{cases} 0.8 & \text{if grout_pad_used} = \text{"yes"} \\ 1.0 & \text{otherwise} \end{cases}$$

$c_{pad} = 1$

Shear Strength:

$$V_{sa} := \begin{cases} c_{pad} \cdot n_{anch} \cdot A_{se} \cdot f_{uta} & \text{if AT} = \text{"AT1"} & [\text{ACI 318-05 EQ D-19}] \\ c_{pad} \cdot n_{anch} \cdot 0.6 \cdot A_{se} \cdot f_{uta} & \text{if AT} = \text{"AT2"} & [\text{ACI 318-05 EQ D-20}] \\ c_{pad} \cdot n_{anch} \cdot 0.6 \cdot A_{se} \cdot f_{uta} & \text{if AT} = \text{"AT3"} & [\text{ACI 318-05 EQ D-20}] \end{cases}$$

[ASJ Cell B7]

$V_{sa} = 62.076 \text{ kip}$ one anchor

Subject: Gas Bottle Canopy, supports, equip, & misc. fdn.
By: R. Murphy
Date: 1/20/2008

Concrete Breakout Strength-Shear [ACI 318-05 D.6.2]

group_status := "group"

Projected Concrete Failure Area [ACI 318-05 D.6.2.1, RD.6.2.1]

$c_{a1} = 5 \cdot \text{in}$ Assuming that total shear is critical on one anchor row

$h_a := 6 \cdot \text{in}$ Thickness of pedestal

$s_1 = 9 \cdot \text{in}$ Anchor Bolt Spacing

$c := \begin{cases} 1.5 \cdot c_{a1} & \text{if } 1.5 \cdot c_{a1} < c_{a2} \\ c_{a2} & \end{cases} \quad c = 5 \cdot \text{in}$

$A_{vc} := \begin{cases} [2 \cdot (c) + s_1] \cdot h_a & \text{if } 1.5c_{a1} > h_a \\ 2 \cdot [(c) + s_1] \cdot 1.5 \cdot c_{a1} & \text{otherwise} \end{cases}$ [ACI 318-05 Fig RD.6.2.1(b)]
Failure area for group of anchors

$$A_{vc} = 108 \cdot \text{in}^2$$

$$A_{vco} := 4.5 \cdot c_{a1}^2$$

$$A_{vco} = 91 \cdot \text{in}^2 \quad [\text{ACI 318-05 EQ D-23}]$$

$$A_{vc} := \min(A_{vc}, n_{\text{anch}} \cdot A_{vco})$$

$$A_{vc} = 108 \cdot \text{in}^2$$

Basic Concrete Breakout Strength [ACI 318-05 D.6.2.2]

$l_e := h_{ef}$ anchor load bearing length

$$V_b := 7 \cdot \left(\frac{l_e}{d_o} \right)^{0.2} \cdot \sqrt{d_o} \cdot \sqrt{f_c} \cdot c_{a1}^{1.5} \cdot \text{psi}^{0.5} \quad [\text{ACI 318-05 EQ D.24}]$$

$$V_b = 5876 \text{ lbf}$$

Calculation Sheet

Project: BGCAPP
Job Number: 743341
Calc. No.: 24915-10-DBC-00-00004
Sheet No.: D2-17 / D2-51
Sheet Rev.: D

Subject: Gas Bottle Canopy, supports, equip, & misc. fdn.
By: R. Murphy
Date: 1/20/2008

$e'_v := 0 \text{ in}$ Assumption that shear is distributed equal to all anchors and no shear eccentricity results

$$\psi_{ecV} := \min \left(1, \frac{1}{1 + 2 \cdot \frac{e'_v}{3 \cdot c_{a1}}} \right)$$

$$\psi_{ecV} = 1$$

$$c_{a2} = 5 \cdot \text{in}$$

$$\psi_{edV} := \begin{cases} 1.0 & \text{if } c_{a2} \geq 1.5 \cdot c_{a1} & \text{[ACI 318-05 EQ D-27]} \\ 0.7 + 0.3 \cdot \frac{c_{a2}}{1.5 \cdot c_{a1}} & \text{if } c_{a2} < 1.5 \cdot c_{a1} & \text{[ACI 318-05 EQ D-28]} \end{cases}$$

$$\psi_{edV} = 1$$

crack_status = "not cracked"

$$\psi_{cV} := \begin{cases} 1.4 & \text{if crack_status = "not cracked"} \\ 1.0 & \text{if crack_status = "cracked no reinforce"} \\ 1.2 & \text{if crack_status = "cracked with reinforce"} \\ 1.4 & \text{if crack_status = "cracked with reinforce and stirrups"} \end{cases}$$

$$\psi_{cV} = 1$$

$$V_{cb} := \begin{cases} \frac{A_{vc}}{A_{vco}} \cdot \psi_{edV} \cdot \psi_{cV} \cdot V_b & \text{if group_status = "single anchor"} & \text{[ACI 318-05 EQ D-21]} \\ 0 & \text{otherwise} \end{cases}$$

$$V_{cbg} := \begin{cases} \frac{A_{vc}}{A_{vco}} \cdot \psi_{ecV} \cdot \psi_{edV} \cdot \psi_{cV} \cdot V_b & \text{if group_status = "group"} & \text{[ACI 318-05 EQ D-22]} \\ 0 & \text{otherwise} \end{cases}$$

$$V_{cb} = 0 \text{ lbf}$$

[ASJ Cell C7]

$$V_{cbg} = 9 \cdot \text{kip}$$

group of 2 anchors

Calculation Sheet

Project: BGCAPP
Job Number: 743341
Calc. No.: 24915- 10-DBC-00-00004
Sheet No.: D2-18 / D2-51
Sheet Rev.: D

Subject: Gas Bottle Canopy, supports, equip, & misc. fdn.
By: R. Murphy
Date: 1/20/2008

Concrete pryout strength of anchor in shear [ACI 318-05 D.6.3]

$$h_{ef} = 8 \cdot \text{in}$$

$$k_{cp} := \begin{cases} 1.0 & \text{if } h_{ef} < 2.5 \text{in} \\ 2.0 & \text{if } h_{ef} \geq 2.5 \text{in} \end{cases}$$

$$V_{cp} := \begin{cases} k_{cp} \cdot N_{cb} & \text{if group_status} = \text{"single anchor"} \\ 0 & \text{otherwise} \end{cases} \quad [\text{ACI 318-05 EQ D-29}]$$

$$V_{cpg} := \begin{cases} k_{cp} \cdot N_{cbg} & \text{if group_status} = \text{"group"} \\ 0 & \text{otherwise} \end{cases} \quad [\text{ACI 318-05 EQ D-30}]$$

[ASJ Cell D7] $V_{cpg} = 69.765 \cdot \text{kip}$ group of 2 anchors

Shear Design Check

$V_{sa} = 62076 \cdot \text{lbf}$ one anchor

$V_{cbg} = 8775 \cdot \text{lbf}$ group of 2 anchors

$V_{cpg} = 69765 \cdot \text{lbf}$ group of 2 anchors

[ASJ Cell B3] $\Phi_{\text{shear}} = 0.85$ Anchor governed by concrete breakout, side-face blowout, pullout, or pryout strength [ACI 318-05 D.4.4]

$$V_{\text{design}} := \Phi_{\text{shear}} \cdot \min(V_{sa}, V_{cbg}, V_{cpg}) \quad [\text{ACI 318-05 D.4.1.1}]$$

$V_{\text{design}} = 7.459 \cdot \text{kip}$

$$\text{design_shear} := \text{if}(V_1 \leq V_{\text{design}} \wedge V_2 \leq V_{\text{design}}, \text{"Design is OK"}, \text{"Design is insufficient"})$$

[ASJ Column E-J] $\text{design_shear} = \text{"Design is OK"}$ [ACI 318-05 EQ D-2]

Subject: Gas Bottle Canopy, supports, equip, & misc. fdn.
 By: R. Murphy
 Date: 1/20/2008

Interaction of tensile and shear forces [ACI 318-05 D.7]

[IC Column I] $\frac{V_1}{V_{design}} + \frac{T_{one_anchor}}{N_{design}} = 0.242$

$$ST_{check} := \text{if} \left(\frac{V_1}{V_{design}} + \frac{T_{one_anchor}}{N_{design}} \leq 1.2, \text{"Interaction OK"}, \text{"Interactoin Failure"} \right)$$

$$\text{interaction_check_V}_1 := \text{if} \left[(V_1 > 0.2 \cdot V_{design} \wedge T_{one_anchor} > N_{design}), ST_{check}, \text{"No check needed"} \right]$$

[IC Column I] interaction_check_V1 = "No check needed"

[IC Column J] $\frac{V_2}{V_{design}} + \frac{T_{one_anchor}}{N_{design}} = 0.197$

$$ST_{check} := \text{if} \left(\frac{V_2}{V_{design}} + \frac{T_{one_anchor}}{N_{design}} \leq 1.2, \text{"Interaction OK"}, \text{"Interactoin Failure"} \right)$$

$$\text{interaction_check_V}_2 := \text{if} \left[(V_2 > 0.2 \cdot V_{design} \wedge T_{one_anchor} > N_{design}), ST_{check}, \text{"No check needed"} \right]$$

[IC Column J] interaction_check_V2 = "No check needed"



A Joint Venture of Bechtel Parsons, Inc. and
Parsons Infrastructure & Technology Group Inc.

Calculation Sheet

Project: BGCAPP
 Job Number: 743341
 Calc. No. 24915-10-DBC-00-00004
 Sheet No. D2-20 / D2-51
 Sheet Rev. D

Subject: Gas Bottles Canopy, Supports, Equip, & Misc Foundations
 By: R. Murphy Date: 12/16/2007

Table "Joint Reactions"

	A	B	C	D	E	F	G	H	I	J
1	TABLE: Joint Reactions									
2	Joint	OutputCase	CaseType	X FORCE	Y FORCE	Z FORCE	X MOMENT	Y MOMENT	Z MOMENT	
3	Text	Text	Text	Kip	Kip	Kip	Kip-in	Kip-in	Kip-in	
4	9	'COMBO 1'	Combination	0.0000	2.0869	0.1503	5.1053	0.1310	-0.5820	
5	9	'COMBO 2A	Combination	0.0000	1.7887	0.1289	4.3759	0.1123	-0.4988	
6	9	'COMBO 2B	Combination	0.0000	3.3699	0.3070	10.4146	0.2652	1.1212	
7	9	'COMBO 3A	Combination	-0.0332	2.1480	0.0350	-0.1982	0.1666	-3.8963	
8	9	'COMBO 3B	Combination	-0.2883	2.4007	0.1867	6.3906	0.1160	25.8521	
9	9	'COMBO 3C	Combination	-0.3903	1.1767	0.0713	2.3692	0.0001	36.3326	
10	9	'COMBO 3D	Combination	-0.3063	2.1847	0.1663	5.6810	0.0956	27.7016	
11	9	'COMBO 3E	Combination	-0.3723	1.3927	0.0916	3.0789	0.0206	34.4831	
12	9	'COMBO 3F	Combination	0.0332	7.2078	0.6051	19.1256	0.6558	1.2876	
13	9	'COMBO 3G	Combination	-0.2884	7.4605	0.7568	25.7145	0.6052	31.0360	
14	9	'COMBO 3H	Combination	-0.3903	1.1767	0.0713	2.3692	0.0001	36.3326	
15	9	'COMBO 3I	Combination	-0.3063	2.1847	0.1663	5.6810	0.0956	27.7016	
16	9	'COMBO 3J	Combination	-0.3723	1.3927	0.0916	3.0789	0.0206	34.4831	
17	9	'COMBO 3K	Combination	0.0000	6.8485	0.6990	23.6998	0.6015	4.6852	
18	9	'COMBO 3L	Combination	0.0000	6.8485	0.6990	23.6998	0.6015	4.6852	
19	9	'COMBO 3M	Combination	0.0000	1.7887	0.1289	4.3759	0.1123	-0.4988	
20	9	'COMBO 3N	Combination	0.0000	1.7887	0.1289	4.3759	0.1123	-0.4988	
21	9	'COMBO 4A	Combination	-0.5767	3.0127	0.2445	8.4053	0.1197	52.2029	←-Test
22	9	'COMBO 4B	Combination	-0.7807	0.5647	0.0136	0.3625	-0.1121	73.1639	
23	9	'COMBO 4C	Combination	-0.6127	2.5807	0.2037	6.9960	0.0788	55.9019	
24	9	'COMBO 4D	Combination	-0.7447	0.9967	0.0544	1.7818	-0.0712	69.4649	
25	9	'COMBO 4E	Combination	0.0663	2.5074	-0.0589	-4.7724	0.2209	-7.2940	
26	9	'COMBO 4F	Combination	-0.5767	4.5939	0.4226	14.4440	0.2726	53.8229	
27	9	'COMBO 4G	Combination	-0.7807	2.1459	0.1918	6.4012	0.0407	74.7839	
28	9	'COMBO 4H	Combination	-0.6127	4.1619	0.3819	13.0247	0.2317	57.5219	
29	9	'COMBO 4I	Combination	-0.7447	2.5779	0.2325	7.8205	0.0816	71.0849	
30	9	'COMBO 4J	Combination	0.0663	4.0885	0.1192	1.2663	0.3737	-5.6740	
31	9	'COMBO 6A	Combination	-0.5767	2.5656	0.2122	7.3113	0.0916	52.3276	
32	9	'COMBO 6B	Combination	-0.7807	0.1176	-0.0186	-0.7315	-0.1402	73.2886	
33	9	'COMBO 6C	Combination	-0.6127	2.1336	0.1715	5.8920	0.0507	56.0266	
34	9	'COMBO 6D	Combination	-0.7447	0.5496	0.0222	0.6878	-0.0993	69.5896	
35	9	'COMBO 6E	Combination	0.0663	2.0602	-0.0911	-5.8664	0.1928	-7.1693	
36	9	'COMBO 5A	Combination	0.2730	2.6473	0.5307	25.3616	0.3453	29.4265	
37	9	'COMBO 5B	Combination	0.2665	2.3577	-0.1168	-11.3164	0.1042	28.7370	
38	9	'COMBO 5C	Combination	-0.2665	2.6218	0.5269	25.2348	0.2514	-28.4769	
39	9	'COMBO 5D	Combination	-0.2730	2.3322	-0.1206	-11.4433	0.0103	-29.1664	
40	9	'COMBO 7A	Combination	0.2730	1.5676	0.4272	21.8522	0.2561	28.9032	
41	9	'COMBO 7B	Combination	0.2665	1.2781	-0.2203	-14.8259	0.0149	28.2138	
42	9	'COMBO 7C	Combination	-0.2665	1.5422	0.4235	21.7253	0.1621	-29.0002	
43	9	'COMBO 7D	Combination	-0.2730	1.2526	-0.2241	-14.9528	-0.0790	-29.6897	

Calculation Sheet

Project: BGCAPP
Job Number: 743341
Calc. No. 24915-10-DBC-00-00004
Sheet No. D2-21 / D2-51
Sheet Rev. D

Subject: Gas Bottles Canopy, Supports, Equip, & Misc Foundations
By: R. Murphy Date: 12/16/2007

Table "Joint Reactions" (Cont.)

	A	B	C	D	E	F	G	H	I	J
1	TABLE: Joint Reactions									
2	Joint	OutputCase	CaseType	X FORCE	Y FORCE	Z FORCE	X MOMENT	Y MOMENT	Z MOMENT	
3	Text	Text	Text	Kip	Kip	Kip	Kip-in	Kip-in	Kip-in	
44	10	'COMBO_1'	Combination	0.0000	2.0869	-0.1503	-5.1053	-0.1310	-0.5820	
45	10	'COMBO_2A	Combination	0.0000	1.7887	-0.1289	-4.3759	-0.1123	-0.4988	
46	10	'COMBO_2B	Combination	0.0000	3.3699	-0.3070	-10.4146	-0.2652	1.1212	
47	10	'COMBO_3A	Combination	0.0328	2.2214	-0.2977	-11.5653	-0.1330	-3.8828	
48	10	'COMBO_3B	Combination	-0.2884	2.4007	-0.1867	-6.3906	-0.1160	25.8620	
49	10	'COMBO_3C	Combination	-0.3904	1.1767	-0.0713	-2.3692	-0.0001	36.3325	
50	10	'COMBO_3D	Combination	-0.3064	2.1847	-0.1663	-5.6810	-0.0955	27.7015	
51	10	'COMBO_3E	Combination	-0.3724	1.3927	-0.0916	-3.0789	-0.0205	34.4830	
52	10	'COMBO_3F	Combination	0.0328	7.2812	-0.8678	-30.8892	-0.6222	1.3013	
53	10	'COMBO_3G	Combination	-0.2884	7.4605	-0.7568	-25.7145	-0.6052	31.0360	
54	10	'COMBO_3H	Combination	-0.3904	1.1767	-0.0713	-2.3692	-0.0001	36.3325	
55	10	'COMBO_3I	Combination	-0.3064	2.1847	-0.1663	-5.6810	-0.0955	27.7015	
56	10	'COMBO_3J	Combination	-0.3724	1.3927	-0.0916	-3.0789	-0.0205	34.4830	
57	10	'COMBO_3K	Combination	0.0000	6.8485	-0.6990	-23.6998	-0.6015	4.6852	
58	10	'COMBO_3L	Combination	0.0000	6.8485	-0.6990	-23.6998	-0.6015	4.6852	
59	10	'COMBO_3M	Combination	0.0000	1.7887	-0.1289	-4.3759	-0.1123	-0.4989	
60	10	'COMBO_3N	Combination	0.0000	1.7887	-0.1289	-4.3759	-0.1123	-0.4989	
61	10	'COMBO_4A	Combination	-0.5767	3.0127	-0.2445	-8.4053	-0.1197	52.2029	
62	10	'COMBO_4B	Combination	-0.7807	0.5647	-0.0136	-0.3625	0.1122	73.1639	
63	10	'COMBO_4C	Combination	-0.6127	2.5807	-0.2037	-6.9860	-0.0788	55.9019	
64	10	'COMBO_4D	Combination	-0.7447	0.9967	-0.0544	-1.7818	0.0712	69.4649	
65	10	'COMBO_4E	Combination	0.0657	2.6541	-0.4665	-18.7547	-0.1536	-7.2667	
66	10	'COMBO_4F	Combination	-0.5767	4.5939	-0.4226	-14.4440	-0.2726	53.8229	
67	10	'COMBO_4G	Combination	-0.7807	2.1459	-0.1918	-6.4012	-0.0407	74.7839	
68	10	'COMBO_4H	Combination	-0.6127	4.1619	-0.3819	-13.0247	-0.2317	57.5219	
69	10	'COMBO_4I	Combination	-0.7447	2.5779	-0.2325	-7.8205	-0.0816	71.0849	
70	10	'COMBO_4J	Combination	0.0657	4.2353	-0.6446	-24.7934	-0.3065	-5.6467	
71	10	'COMBO_6A	Combination	-0.5767	2.5656	-0.2122	-7.3113	-0.0916	52.3276	
72	10	'COMBO_6B	Combination	-0.7807	0.1176	0.0186	0.7315	0.1402	73.2886	
73	10	'COMBO_6C	Combination	-0.6127	2.1336	-0.1715	-5.8920	-0.0507	56.0266	
74	10	'COMBO_6D	Combination	-0.7447	0.5496	-0.0222	-0.6878	0.0993	69.5896	
75	10	'COMBO_6E	Combination	0.0657	2.2069	-0.4342	-17.6607	-0.1255	-7.1420	
76	10	'COMBO_5A	Combination	0.2730	2.6473	0.1206	11.4433	-0.0103	29.4265	
77	10	'COMBO_5B	Combination	0.2665	2.3577	-0.5269	-25.2348	-0.2514	28.7370	
78	10	'COMBO_5C	Combination	-0.2665	2.6218	0.1168	11.3164	-0.1042	-28.4769	
79	10	'COMBO_5D	Combination	-0.2730	2.3322	-0.5307	-25.3616	-0.3453	-29.1664	
80	10	'COMBO_7A	Combination	0.2730	1.5676	0.2241	14.9528	0.0790	28.9032	
81	10	'COMBO_7B	Combination	0.2665	1.2781	-0.4235	-21.7253	-0.1621	28.2138	
82	10	'COMBO_7C	Combination	-0.2665	1.5422	0.2203	14.8259	-0.0149	-29.0002	
83	10	'COMBO_7D	Combination	-0.2730	1.2526	-0.4272	-21.8522	-0.2561	-29.6897	

Calculation Sheet

Project: BGCAPP
 Job Number: 743341
 Calc. No. 24915-10-DBC-00-00004
 Sheet No. D2-22 / D2-51
 Sheet Rev. D

Subject: Gas Bottles Canopy, Supports, Equip, & Misc Foundations
 By: R. Murphy Date: 12/16/2007

A	B	C	D	E	F	G	H	I	J	K	L	M	N	O	P	Q	R	S	T	
3	HSS 6X6X.375																			
4	12" x 12" Plate																			
5	A (in ²)	17.23	6	0.76	3.15	12	36	324	1.5	0.8		Fp (ksi)								
6	144											4	3.06							
7																				
8																				
9																				
10	Joint	Output/Case	Fy	Mz	e	σ _{axial}	σ _{bend}	σ _{max}	σ _{min}	ratio	stress_slo	σ _{face}	F _{rect}	F _{irr}	M _{rect}	M _{irr}	M _{Design}	ip	design check	
11	Text	Text	Kip	Kip-in	in	ksi	ksi	ksi	ksi		pe	ksi	Kip	Kip	Kip-in	Kip-in	Kip-in	in	in	design check
12	9	'COMBO 1'	2.0689	-0.5920	-0.2769	0.0145	0.0020	0.0165	0.0125	0.7553	0.0003	0.0155	0.0487	0.0017	0.0767	0.0005	0.0005	0.0002	0.099	Design Good
13	9	'COMBO 2A	1.7887	-0.4898	-0.2789	0.0124	0.0017	0.0107	0.0107	0.7553	0.0003	0.0132	0.0417	0.0014	0.0657	0.0030	0.0068	0.0092	0.092	Design Good
14	9	'COMBO 2B	3.3599	1.1212	0.3327	0.0234	0.0039	0.0273	0.0195	0.7147	0.0006	0.0255	0.0795	0.0052	0.1253	0.0063	0.0126	0.128	0.128	Design Good
15	9	'COMBO 3A	2.1480	-3.8963	-1.8139	0.0149	0.0135	0.0284	0.0014	0.4458	0.0023	0.0213	0.0672	0.0112	0.1059	0.0235	0.04294	0.126	0.126	Design Good
16	9	'COMBO 3B	2.4007	25.8521	10.7684	0.0157	0.0898	0.1084	-0.0731	-0.8567	0.0150	0.0593	0.1868	0.0742	0.2943	0.1559	0.4501	0.268	0.268	Design Good
17	9	'COMBO 3C	1.1767	35.3326	30.8756	0.0082	0.1262	0.1343	-0.1180	-0.8783	0.0210	0.0681	0.2145	0.1043	0.3378	0.2191	0.5548	0.282	0.282	Design Good
18	9	'COMBO 3D	2.1547	27.7016	12.6796	0.0152	0.0962	0.1114	-0.0810	-0.7275	0.0160	0.0609	0.1917	0.0795	0.3019	0.1670	0.4890	0.241	0.241	Design Good
19	9	'COMBO 3E	1.3927	34.4831	24.7592	0.0097	0.1197	0.1294	-0.1101	-0.8505	0.0200	0.0625	0.2096	0.0950	0.3301	0.2079	0.5381	0.258	0.258	Design Good
20	9	'COMBO 3F	7.2078	1.2876	0.1785	0.0501	0.0045	0.0545	0.0456	0.8380	0.0007	0.0822	0.1644	0.0037	0.2589	0.0778	0.2666	0.181	0.181	Design Good
21	9	'COMBO 3G	7.4605	31.0360	4.1601	0.0518	0.1078	0.1966	-0.0560	-0.3507	0.0180	0.1030	0.3244	0.0081	0.5110	0.1871	0.6981	0.294	0.294	Design Good
22	9	'COMBO 3H	1.1767	35.3326	30.8756	0.0092	0.1262	0.1343	-0.1180	-0.8783	0.0210	0.0681	0.2145	0.1043	0.3378	0.2191	0.5548	0.282	0.282	Design Good
23	9	'COMBO 3I	2.1547	27.7016	12.6796	0.0152	0.0962	0.1114	-0.0810	-0.7275	0.0160	0.0609	0.1917	0.0795	0.3019	0.1670	0.4890	0.241	0.241	Design Good
24	9	'COMBO 3J	1.3927	34.4831	24.7592	0.0097	0.1197	0.1294	-0.1101	-0.8505	0.0200	0.0625	0.2096	0.0950	0.3301	0.2079	0.5381	0.258	0.258	Design Good
25	9	'COMBO 3K	6.8485	4.6852	0.6841	0.0476	0.0163	0.0598	0.0313	0.4502	0.0027	0.0563	0.1742	0.0135	0.2743	0.0292	0.3025	0.193	0.193	Design Good
26	9	'COMBO 3L	6.8485	4.6852	0.6841	0.0476	0.0163	0.0598	0.0313	0.4502	0.0027	0.0563	0.1742	0.0135	0.2743	0.0292	0.3025	0.193	0.193	Design Good
27	9	'COMBO 3M	1.7887	-0.4898	-0.2789	0.0124	0.0017	0.0142	0.0107	0.7553	0.0003	0.0132	0.0417	0.0014	0.0657	0.0030	0.0068	0.0092	0.092	Design Good
28	9	'COMBO 3N	1.7887	-0.4898	-0.2789	0.0124	0.0017	0.0142	0.0107	0.7553	0.0003	0.0132	0.0417	0.0014	0.0657	0.0030	0.0068	0.0092	0.092	Design Good
29	9	'COMBO 3O	3.0127	52.2029	17.3274	0.0209	0.1813	0.2022	-0.1693	-0.7930	0.0002	0.1079	0.3371	0.1489	0.8310	0.3147	0.8457	0.323	0.323	Design Good
30	9	'COMBO 4B	0.5647	73.1839	129.5541	0.0039	0.2540	0.2580	-0.2501	-0.9696	0.0423	0.1248	0.3925	0.2101	0.6181	0.4411	1.0593	0.362	0.362	Design Good
31	9	'COMBO 4C	2.5807	55.9019	21.6512	0.0179	0.1941	0.2120	-0.1762	-0.8309	0.0324	0.1101	0.3469	0.1605	0.5463	0.3370	0.8834	0.330	0.330	Design Good
32	9	'COMBO 4D	0.9967	69.4649	69.6926	0.0069	0.2412	0.2481	-0.2343	-0.9442	0.0402	0.1215	0.3827	0.1994	0.6097	0.4198	1.0216	0.355	0.355	Design Good
33	9	'COMBO 4E	2.5074	-7.2940	-2.9060	0.0174	0.0253	0.0427	-0.0079	-0.1852	0.0042	0.0294	0.0927	0.0209	0.1461	0.0440	0.1600	0.159	0.159	Design Good
34	9	'COMBO 4F	4.3539	53.8229	11.7162	0.0319	0.1869	0.2168	-0.1550	-0.7084	0.0311	0.1207	0.3801	0.1845	0.5987	0.3245	0.8232	0.336	0.336	Design Good
35	9	'COMBO 4G	2.1459	74.7859	34.8497	0.0149	0.2597	0.2746	-0.2448	-0.8915	0.0433	0.1382	0.4355	0.2147	0.6859	0.4509	1.1388	0.375	0.375	Design Good
36	9	'COMBO 4H	4.1619	57.5219	13.8211	0.0289	0.1997	0.2266	-0.1708	-0.7472	0.0333	0.1238	0.3809	0.1652	0.6141	0.3468	0.9109	0.344	0.344	Design Good
37	9	'COMBO 4I	2.5779	71.0849	27.5747	0.0179	0.2468	0.2647	-0.2289	-0.8647	0.0411	0.1351	0.4257	0.2041	0.6705	0.4286	1.0919	0.368	0.368	Design Good
38	9	'COMBO 4J	0.0885	-5.6740	-1.3978	0.0284	0.0197	0.0481	0.0087	0.1807	0.0033	0.0378	0.1189	0.0163	0.1873	0.0342	0.2215	0.185	0.185	Design Good
39	9	'COMBO 6A	2.5855	52.3276	20.3962	0.0178	0.1817	0.1995	-0.1639	-0.8214	0.0303	0.1041	0.3280	0.1502	0.5166	0.3155	0.8921	0.321	0.321	Design Good
40	9	'COMBO 6B	0.1176	73.2866	623.4596	0.0008	0.2545	0.2553	-0.2537	-0.9938	0.0424	0.1217	0.3833	0.2104	0.6037	0.4419	1.0456	0.359	0.359	Design Good
41	9	'COMBO 6C	2.1336	56.0266	26.2598	0.0148	0.1945	0.2094	-0.1797	-0.8585	0.0324	0.1072	0.3977	0.1609	0.5320	0.3378	0.8698	0.328	0.328	Design Good
42	9	'COMBO 6D	0.5466	69.5895	126.6299	0.0038	0.2416	0.2459	-0.2378	-0.9689	0.0403	0.1186	0.3736	0.1998	0.6894	0.4196	1.10079	0.353	0.353	Design Good
43	9	'COMBO 6E	2.0802	-7.1893	-3.4799	0.0143	0.0249	0.0592	-0.0106	-0.2701	0.0041	0.0261	0.0923	0.0206	0.1256	0.0432	0.1729	0.146	0.146	Design Good
44	9	'COMBO 5A	2.8473	29.4265	11.1157	0.0184	0.1022	0.1206	-0.0838	-0.6950	0.0170	0.0669	0.2108	0.0845	0.3320	0.1774	0.5094	0.251	0.251	Design Good
45	9	'COMBO 5B	2.3577	26.7370	12.1885	0.0164	0.0998	0.1162	-0.0834	-0.7181	0.0166	0.0638	0.2009	0.0825	0.3164	0.1733	0.4895	0.246	0.246	Design Good
46	9	'COMBO 5C	2.6218	-26.4769	-10.9515	0.0182	0.0989	0.1171	-0.0807	-0.6690	0.0165	0.0652	0.2053	0.0818	0.3233	0.1717	0.4895	0.247	0.247	Design Good
47	9	'COMBO 5D	2.3322	-29.1654	-12.5057	0.0162	0.1013	0.1175	-0.0951	-0.7242	0.0169	0.0643	0.2025	0.0837	0.3190	0.1759	0.4949	0.247	0.247	Design Good
48	9	'COMBO 7A	1.5876	28.9032	18.4374	0.0109	0.1004	0.1112	-0.0895	-0.8043	0.0167	0.0586	0.1845	0.0830	0.2905	0.1743	0.4848	0.240	0.240	Design Good
49	9	'COMBO 7B	1.2781	28.2138	22.0754	0.0089	0.0990	0.1068	-0.0891	-0.8339	0.0163	0.0554	0.1745	0.0810	0.2749	0.1701	0.4450	0.284	0.284	Design Good
50	9	'COMBO 7C	1.5422	-23.0002	-18.9047	0.0107	0.1007	0.1114	-0.0900	-0.8077	0.0168	0.0585	0.1844	0.0833	0.2904	0.1749	0.4659	0.240	0.240	Design Good
51	9	'COMBO 7D	1.2626	-25.8987	-23.7025	0.0087	0.1031	0.1118	-0.0944	-0.8444	0.0172	0.0577	0.1816	0.0852	0.2861	0.1790	0.4861	0.240	0.240	Design Good

Calculation Sheet

Project: BGCAPP
Job Number: 743341
Calc. No. 24915-10-DBC-00-00004
Sheet No. D2-23 / D2-51
Sheet Rev. D

Subject: Gas Bottles Canopy, Supports, Equip, & Misc Foundations

By: R. Murphy Date: 12/16/2007

A	B	C	D	E	F	G	H	I	J	K	L	M	N	O	P	Q	R	S	T	
Joint	Output/Case	Fy	Mx	e	σ_{axial}	σ_{bend}	σ_{max}	σ_{min}	ratio	stress_slo	σ_{flec}	F_rect	F_iri	M_rect	M_iri	M_design	tp	design check	design check	
Text	Text	Kip	Kip-in	in	ksi	ksi	ksi	ksi		pe	ksi	Kip	Kip	Kip-in	Kip-in	Kip-in	in	plate	ped bearing	
51	9	COMBO_1	2.0869	5.1053	2.4464	0.0177	0.0322	-0.0032	-0.1004	0.0030	0.0229	0.0722	0.0147	0.1137	0.0308	0.1445	0.1335	Design Good	Design Good	
52	9	COMBO_2A	1.7887	4.3759	2.4464	0.0182	0.0276	-0.0028	-0.1004	0.0025	0.0196	0.0619	0.0126	0.0974	0.0264	0.1238	0.1236	Design Good	Design Good	
53	9	COMBO_2B	3.3699	10.4146	3.0905	0.0294	0.0498	-0.0128	-0.2142	0.0080	0.0406	0.1278	0.0299	0.2013	0.0628	0.2641	0.1808	Design Good	Design Good	
54	9	COMBO_3A	2.1480	-0.1982	-0.0923	0.0148	0.0007	0.0156	0.142	0.0001	0.0152	0.0480	0.0006	0.0756	0.0012	0.0768	0.0974	Design Good	Design Good	
55	9	COMBO_3B	2.4007	6.3906	2.6619	0.0167	0.0222	-0.0055	-0.1420	0.0037	0.0272	0.0657	0.0183	0.1350	0.0395	0.1735	0.1464	Design Good	Design Good	
56	9	COMBO_3C	1.1767	2.8692	2.0124	0.0082	0.0082	-0.0001	-0.0083	0.0014	0.0121	0.0380	0.0068	0.0599	0.0143	0.0742	0.0957	Design Good	Design Good	
57	9	COMBO_3D	2.1847	5.6810	2.6003	0.0152	0.0349	-0.0046	-0.1305	0.0033	0.0245	0.0773	0.0163	0.1218	0.0343	0.1500	0.1388	Design Good	Design Good	
58	9	COMBO_3E	1.9927	3.0789	2.2107	0.0097	0.0107	-0.0010	-0.0500	0.0018	0.0147	0.0485	0.0088	0.0732	0.0186	0.0917	0.1064	Design Good	Design Good	
59	9	COMBO_3F	7.2078	19.1256	2.6835	0.0501	0.0684	-0.0164	-0.1404	0.0111	0.0816	0.2570	0.0549	0.4048	0.1153	0.2020	0.2934	Design Good	Design Good	
60	9	COMBO_3G	7.4605	25.7145	3.4468	0.0518	0.0893	-0.0375	-0.2656	0.0149	0.0942	0.2968	0.0738	0.4674	0.1550	0.2825	0.2772	Design Good	Design Good	
61	9	COMBO_3H	1.1767	5.6810	2.0134	0.0082	0.0164	-0.0001	-0.0083	0.0013	0.0121	0.0380	0.0068	0.0599	0.0143	0.0742	0.0957	Design Good	Design Good	
62	9	COMBO_3I	2.1847	5.6810	2.6003	0.0152	0.0349	-0.0046	-0.1305	0.0033	0.0245	0.0773	0.0163	0.1218	0.0343	0.1500	0.1388	Design Good	Design Good	
63	9	COMBO_3J	1.9927	3.0789	2.2107	0.0097	0.0107	-0.0010	-0.0500	0.0018	0.0147	0.0485	0.0088	0.0732	0.0186	0.0917	0.1064	Design Good	Design Good	
64	9	COMBO_3K	6.8485	23.6998	3.4806	0.0476	0.0823	-0.0347	-0.2675	0.0137	0.0866	0.2729	0.0680	0.4299	0.1429	0.2728	0.2659	Design Good	Design Good	
65	9	COMBO_3L	1.7887	4.3759	2.4464	0.0124	0.0152	-0.0028	-0.1004	0.0025	0.0196	0.0619	0.0126	0.0974	0.0264	0.1238	0.1236	Design Good	Design Good	
66	9	COMBO_3M	1.7887	4.3759	2.4464	0.0124	0.0152	-0.0028	-0.1004	0.0025	0.0196	0.0619	0.0126	0.0974	0.0264	0.1238	0.1236	Design Good	Design Good	
67	9	COMBO_4A	3.0127	8.4053	2.7809	0.0209	0.0292	-0.0093	-0.1649	0.0049	0.0348	0.1096	0.0241	0.1726	0.0507	0.2233	0.166	Design Good	Design Good	
68	9	COMBO_4B	0.5647	0.3625	0.6418	0.0039	0.0013	0.0052	0.0027	0.5141	0.0002	0.0046	0.0142	0.0010	0.0224	0.0022	0.0246	0.0551	Design Good	Design Good
69	9	COMBO_4C	2.5807	6.9660	2.7070	0.0179	0.0243	-0.0063	-0.1502	0.0040	0.0294	0.0827	0.0201	0.1461	0.0421	0.1682	0.1524	Design Good	Design Good	
70	9	COMBO_4D	0.9667	1.9718	1.7876	0.0069	0.0181	0.0007	0.0561	0.0010	0.0099	0.0311	0.0051	0.0489	0.0107	0.0597	0.0858	Design Good	Design Good	
71	9	COMBO_4E	2.5074	-1.9034	0.0174	0.0166	0.0340	0.0008	0.0248	0.0028	0.0253	0.0796	0.0137	0.1254	0.0298	0.1542	0.138	Design Good	Design Good	
72	9	COMBO_4F	4.5939	14.4440	3.1442	0.0319	0.0502	-0.0183	-0.2224	0.0084	0.0557	0.1755	0.0415	0.2765	0.0971	0.3636	0.2119	Design Good	Design Good	
73	9	COMBO_4G	2.1459	6.4012	2.9830	0.0149	0.0222	-0.0073	-0.1973	0.0037	0.0255	0.0602	0.0184	0.1268	0.0388	0.1784	0.1427	Design Good	Design Good	
74	9	COMBO_4H	4.1619	13.0247	3.1295	0.0289	0.0452	-0.0163	-0.2202	0.0075	0.0504	0.1587	0.0374	0.2500	0.0795	0.3285	0.2014	Design Good	Design Good	
75	9	COMBO_4I	2.5778	7.8205	3.0337	0.0179	0.0272	-0.0093	-0.2054	0.0045	0.0308	0.0970	0.0225	0.1528	0.0472	0.2010	0.157	Design Good	Design Good	
76	9	COMBO_4J	4.0885	1.2653	0.0397	0.0284	0.0328	0.0240	0.7318	0.0007	0.0305	0.0960	0.0036	0.1512	0.0076	0.1569	0.14	Design Good	Design Good	
77	9	COMBO_6A	2.5856	7.3113	2.8498	0.0178	0.0254	-0.0076	-0.1752	0.0042	0.0299	0.0941	0.0210	0.1482	0.0441	0.1923	0.1541	Design Good	Design Good	
78	9	COMBO_6B	0.1176	-0.7315	-6.2229	0.0009	0.0025	0.0034	-0.0017	-0.5186	0.0004	0.0020	0.0064	0.0021	0.0100	0.0044	0.0144	0.0422	Design Good	Design Good
79	9	COMBO_6C	2.1396	5.9820	2.7616	0.0148	0.0205	-0.0058	-0.1599	0.0034	0.0245	0.0773	0.0169	0.1217	0.0385	0.1572	0.1383	Design Good	Design Good	
80	9	COMBO_6D	0.5496	0.6878	1.2516	0.0088	0.0024	0.0062	0.0014	0.2802	0.0004	0.0050	0.0156	0.0020	0.0246	0.0041	0.0287	0.0385	Design Good	Design Good
81	9	COMBO_6E	2.0602	-2.8475	0.0143	0.0204	0.0347	-0.0051	-0.1748	0.0034	0.0240	0.0755	0.0168	0.1190	0.0354	0.1544	0.138	Design Good	Design Good	
82	9	COMBO_5A	2.6473	25.3816	9.5902	0.0184	0.0881	-0.0697	-0.6546	0.0147	0.0802	0.1897	0.0728	0.2987	0.1529	0.4516	0.2381	Design Good	Design Good	
83	9	COMBO_5B	2.3577	-11.3164	-4.7998	0.0164	0.0393	-0.0229	-0.4117	0.0085	0.0850	0.1104	0.0325	0.1798	0.0682	0.2421	0.1729	Design Good	Design Good	
84	9	COMBO_5C	2.6218	25.2348	9.6249	0.0182	0.0876	-0.0694	-0.6589	0.0146	0.0598	0.1885	0.0725	0.2968	0.1521	0.4380	0.2354	Design Good	Design Good	
85	9	COMBO_5D	2.3322	-11.4433	-4.9066	0.0162	0.0397	-0.0235	-0.4208	0.0066	0.0351	0.1105	0.0329	0.1740	0.0690	0.2430	0.1732	Design Good	Design Good	
86	9	COMBO_7A	1.5876	21.8522	13.9385	0.0109	0.0759	-0.0650	-0.7491	0.0126	0.0489	0.1478	0.0627	0.2328	0.1318	0.3846	0.2122	Design Good	Design Good	
87	9	COMBO_7B	1.2781	-14.8259	-11.8033	0.0089	0.0515	-0.0404	-0.7059	0.0086	0.0383	0.1050	0.0428	0.1653	0.0884	0.2547	0.1773	Design Good	Design Good	
88	9	COMBO_7C	1.5422	21.7253	14.0874	0.0107	0.0754	-0.0651	-0.7514	0.0126	0.0465	0.1466	0.0624	0.2309	0.1310	0.3619	0.2114	Design Good	Design Good	
89	9	COMBO_7D	1.2526	-14.9528	-11.9374	0.0087	0.0519	-0.0432	-0.7130	0.0087	0.0394	0.1051	0.0429	0.1655	0.0902	0.2557	0.1777	Design Good	Design Good	

"BasePlate Joint 9"

Calculation Sheet

Project: BGCAPP
 Job Number: 743341
 Calc. No. 24915-10-DBC-00-00004
 Sheet No. D2-24 / D2-51
 Sheet Rev. D

Subject: Gas Bottles Canopy, Supports, Equip, & Misc Foundations
 By: R. Murphy Date: 12/16/2007

A	B	C	D	E	F	G	H	I	J	K	L	M	N	O	P	Q	R	S	T					
3	HSS 6X6X.375																							
4	12"x12" Plate																							
5	A (in ²)	17.28	6	0.75	3.15	12	36	324	1.5	0.6	4	FP (ksi)												
6																								
7																								
8																								
9																								
10	Joint	Output/Case	Fy	Mz	e	σ _{axial}	σ _{beam}	d (in)	σ _{min}	σ _{max}	Fy (ksi)	σ _{base}	σ _{ope}	σ _{fat}	F _{fact}	F _{req}	F _{irr}	M _{req}	M _{irr}	M _{design}	tp	design check	design check	
11	Text	Text	Kip-in	Kip-in	in	ksi	ksi	ksi	ksi	ksi	ksi	ksi	ksi	ksi	ksi	ksi	ksi	ksi	kip-in	kip-in	kip-in	in	plate	bearing
48	10	COMBO_7A	1.5676	28.9032	18.4974	0.0109																		

Calculation Sheet

Project: BGCAPP
Job Number: 743341
Calc. No. 24915-10-DBC-00-00004
Sheet No. D2-25 / D2-51
Sheet Rev. D

Subject: Gas Bottles Canopy, Supports, Equip, & Misc Foundations
By: R. Murphy Date: 12/16/2007

58	Joint	A	B	C	D	E	F	G	H	I	J	K	L	M	N	O	P	Q	R	S	T
60	10	Text	Outputcase	Fy	Mx	in	ksi	ksi	ksi	ksi	ratio	stress_sl	ksi	F	F	M	M	M	in	design	design
61	10	COMBO_1	COMBO_1	20868	-4.464	-2.4464	0.0145	0.0177	0.0322	-0.0032	-0.1004	0.0030	0.0229	0.0722	0.0147	0.1137	0.0308	0.1745	0.18543	Design	design
62	10	COMBO_2A	COMBO_2A	17987	-4.3759	-2.4464	0.0124	0.0152	0.0276	-0.0028	-0.1004	0.0025	0.0196	0.0619	0.0126	0.0974	0.0264	-0.1288	0.128607	Design	Design
63	10	COMBO_2B	COMBO_2B	33694	-10.4148	-3.0905	0.0234	0.0362	0.0596	-0.0128	-0.1412	0.0060	0.0406	0.1276	0.0299	0.2013	0.0628	-0.2841	0.180574	Design	Design
64	10	COMBO_3A	COMBO_3A	22914	-11.5650	-5.2062	0.0154	0.0402	0.0556	-0.0247	-0.4439	0.0067	0.0345	0.1087	0.0332	0.1712	0.0597	-0.2409	0.172455	Design	Design
65	10	COMBO_3B	COMBO_3B	24007	-6.3916	-2.6619	0.0167	0.0222	0.0389	-0.0055	-0.1420	0.0037	0.0272	0.0857	0.0163	0.0950	0.0385	-0.1735	0.14637	Design	Design
66	10	COMBO_3C	COMBO_3C	17767	-2.4682	-2.0134	0.0082	0.0082	0.0082	-0.0001	-0.0093	0.0014	0.0121	0.0350	0.0068	0.0550	0.0143	-0.0732	0.095719	Design	Design
67	10	COMBO_3D	COMBO_3D	11847	-5.8510	-2.6003	0.0152	0.0197	0.0349	-0.0046	-0.1305	0.0033	0.0245	0.0773	0.0163	0.1218	0.0343	-0.1560	0.138781	Design	Design
68	10	COMBO_3E	COMBO_3E	13927	-3.0789	-2.2107	0.0097	0.0107	0.0204	-0.0010	-0.0500	0.0018	0.0147	0.0465	0.0068	0.0732	0.0196	-0.0917	0.104424	Design	Design
69	10	COMBO_3F	COMBO_3F	72612	-30.8892	-4.2423	0.0596	0.1075	0.1578	-0.0367	-0.5952	0.0179	0.1015	0.3198	0.0687	0.5036	0.1822	-0.6894	0.251834	Design	Design
70	10	COMBO_3G	COMBO_3G	74605	-25.7145	-3.4468	0.0518	0.0863	0.1411	-0.0375	-0.2656	0.0149	0.0942	0.2968	0.0738	0.4674	0.1550	-0.6259	0.272719	Design	Design
71	10	COMBO_3H	COMBO_3H	17767	-2.3982	-2.0134	0.0082	0.0082	0.0082	-0.0001	-0.0093	0.0014	0.0121	0.0350	0.0068	0.0550	0.0143	-0.0732	0.095719	Design	Design
72	10	COMBO_3I	COMBO_3I	21847	-5.8510	-2.6003	0.0152	0.0197	0.0349	-0.0046	-0.1305	0.0033	0.0245	0.0773	0.0163	0.1218	0.0343	-0.1560	0.138781	Design	Design
73	10	COMBO_3J	COMBO_3J	13927	-3.0789	-2.2107	0.0097	0.0107	0.0204	-0.0010	-0.0500	0.0018	0.0147	0.0465	0.0068	0.0732	0.0196	-0.0917	0.104424	Design	Design
74	10	COMBO_3K	COMBO_3K	63485	-23.6998	-3.4606	0.0476	0.0823	0.1298	-0.0347	-0.2675	0.0187	0.0866	0.2729	0.0689	0.4299	0.1429	-0.5728	0.265918	Design	Design
75	10	COMBO_3L	COMBO_3L	17987	-4.3759	-2.4464	0.0124	0.0152	0.0276	-0.0028	-0.1004	0.0025	0.0196	0.0619	0.0126	0.0974	0.0264	-0.1288	0.128607	Design	Design
76	10	COMBO_3M	COMBO_3M	17987	-4.3759	-2.4464	0.0124	0.0152	0.0276	-0.0028	-0.1004	0.0025	0.0196	0.0619	0.0126	0.0974	0.0264	-0.1288	0.128607	Design	Design
77	10	COMBO_3N	COMBO_3N	17987	-4.3759	-2.4464	0.0124	0.0152	0.0276	-0.0028	-0.1004	0.0025	0.0196	0.0619	0.0126	0.0974	0.0264	-0.1288	0.128607	Design	Design
78	10	COMBO_4A	COMBO_4A	30127	-8.4053	-2.7899	0.0209	0.0292	0.0591	-0.0063	-0.1649	0.0048	0.0348	0.1096	0.0241	0.1726	0.0507	-0.2923	0.165019	Design	Design
79	10	COMBO_4B	COMBO_4B	15647	-0.3625	-0.6418	0.0038	0.0073	0.0113	-0.0027	-0.5141	0.0002	0.0046	0.0142	0.0010	0.0224	0.0022	-0.0246	0.055119	Design	Design
80	10	COMBO_4C	COMBO_4C	25607	-6.9580	-2.7070	0.0179	0.0243	0.0422	-0.0063	-0.1502	0.0040	0.0294	0.0927	0.0201	0.1451	0.0421	-0.1892	0.152428	Design	Design
81	10	COMBO_4D	COMBO_4D	9967	-1.7818	-1.7876	0.0069	0.0062	0.0131	0.0007	0.0561	0.0010	0.0099	0.0311	0.0051	0.0489	0.0107	-0.0597	0.085625	Design	Design
82	10	COMBO_4E	COMBO_4E	25541	-15.7547	-7.0662	0.0184	0.0651	0.0836	-0.0467	-0.5988	0.0109	0.0494	0.1555	0.0508	0.3449	0.1131	-0.5600	0.210227	Design	Design
83	10	COMBO_4F	COMBO_4F	45930	-14.4460	-3.1442	0.0319	0.0502	0.0821	-0.0183	-0.2224	0.0084	0.0557	0.1755	0.0415	0.2765	0.0871	-0.3636	0.211856	Design	Design
84	10	COMBO_4G	COMBO_4G	21459	-6.4012	-2.9930	0.0146	0.0222	0.0371	-0.0073	-0.1973	0.0037	0.0255	0.0802	0.0184	0.1263	0.0396	-0.1848	0.142894	Design	Design
85	10	COMBO_4H	COMBO_4H	41619	-13.0247	-3.1295	0.0263	0.0452	0.0741	-0.0163	-0.2202	0.0075	0.0504	0.1587	0.0374	0.2500	0.0785	-0.3285	0.201383	Design	Design
86	10	COMBO_4I	COMBO_4I	25779	-7.8205	-3.0337	0.0179	0.0272	0.0451	-0.0093	-0.2054	0.0045	0.0309	0.0870	0.0225	0.1528	0.0472	-0.2000	0.15712	Design	Design
87	10	COMBO_4J	COMBO_4J	42353	-24.7954	-5.8540	0.0294	0.0861	0.1155	-0.0567	-0.4907	0.0143	0.0703	0.2215	0.0712	0.3488	0.1495	-0.4983	0.248024	Design	Design
88	10	COMBO_5A	COMBO_5A	25658	-7.3113	-2.8498	0.0178	0.0254	0.0432	-0.0076	-0.1752	0.0042	0.0299	0.0941	0.0210	0.1482	0.0441	-0.1923	0.15408	Design	Design
89	10	COMBO_5B	COMBO_5B	11176	0.7315	6.2229	0.0008	0.0025	0.0034	-0.0017	-0.5138	0.0004	0.0020	0.0064	0.0021	0.0100	0.0044	-0.0144	0.042231	Design	Design
90	10	COMBO_5C	COMBO_5C	15366	-5.8920	-1.7616	0.0148	0.0205	0.0353	-0.0056	-0.1599	0.0034	0.0245	0.0773	0.0169	0.1217	0.0345	-0.1572	0.13933	Design	Design
91	10	COMBO_5D	COMBO_5D	5496	-0.6878	-1.2516	0.0038	0.0034	0.0062	0.0014	0.2002	0.0004	0.0050	0.0156	0.0020	0.0246	0.0041	-0.0267	0.050594	Design	Design
92	10	COMBO_5E	COMBO_5E	22069	-17.5607	-5.0024	0.0130	0.0513	0.0766	-0.0460	-0.6001	0.0102	0.0445	0.1400	0.0507	0.2205	0.1065	-0.3270	0.200932	Design	Design
93	10	COMBO_5A	COMBO_5A	26479	11.4433	4.3227	0.0184	0.0397	0.0591	-0.0213	-0.3674	0.0068	0.0373	0.1174	0.0329	0.1948	0.0890	-0.2638	0.177026	Design	Design
94	10	COMBO_5B	COMBO_5B	23577	-25.2348	-10.7091	0.0164	0.0276	0.0440	-0.0712	-0.6851	0.0148	0.0580	0.1827	0.0725	0.2877	0.1521	-0.4389	0.233033	Design	Design
95	10	COMBO_5C	COMBO_5C	26218	11.3164	4.3162	0.0393	0.0573	0.0743	-0.0211	-0.3667	0.0065	0.0369	0.1161	0.0325	0.1829	0.0582	-0.2612	0.176099	Design	Design
96	10	COMBO_5D	COMBO_5D	23922	-25.3616	-10.8743	0.0162	0.0281	0.0438	-0.0719	-0.6693	0.0147	0.0580	0.1828	0.0728	0.2879	0.1529	-0.4408	0.233278	Design	Design
97	10	COMBO_7A	COMBO_7A	15678	14.9528	9.5984	0.0109	0.0519	0.0828	-0.0410	-0.6533	0.0087	0.0355	0.1120	0.0429	0.1764	0.0902	-0.2685	0.181383	Design	Design
98	10	COMBO_7B	COMBO_7B	12781	-21.7253	-16.9988	0.0089	0.0754	0.0843	-0.0666	-0.7895	0.0125	0.0447	0.1408	0.0624	0.2218	0.1310	-0.4928	0.208697	Design	Design
99	10	COMBO_7C	COMBO_7C	15422	14.3259	9.6136	0.0107	0.0515	0.0622	-0.0408	-0.6556	0.0086	0.0352	0.1108	0.0426	0.1744	0.0884	-0.2638	0.180478	Design	Design
99	10	COMBO_7D	COMBO_7D	12536	-21.8522	-17.4455	0.0087	0.0759	0.0846	-0.0672	-0.7843	0.0125	0.0447	0.1409	0.0627	0.2220	0.1318	-0.4937	0.208971	Design	Design

Calculation Sheet

Project: BGCAPP
Job Number: 743341
Calc. No. 24915-10-DBC-00-00004
Sheet No. D2-26 / D2-51
Sheet Rev. D

Subject: Gas Bottles Canopy, Supports, Equip, & Misc Foundations
By: R. Murphy Date: 12/16/2007

A	B	C	D	E	F	G	H	I	J	K	L	M	N	O	P	Q
N, plate (in)	B, plate (in)	x, a (in)	N, prime (in)	A, prime (in)	e, kern	ip, anchor_tensio	n, in tension	f, prime	A, minus	A, final	T, anchors	N, one anchor				
3	12	1.5	10.5	4.5	2	0.85	14.82528	← one anchor								
4																
5																
6																
7																
8	Joint	Case	Fy	Mz	Kp-in	in										
9	Text	Text	2.0659	-0.5620	0.1653	0.1596	10.0531	22.5044	8.9956	1.1923	1.523	0.5761	Design OK	Design OK	Design OK	Design OK
10	'COMBO_1'		2.0659	-0.5620	0.1653	0.1596	10.0531	22.5044	8.9956	1.1923	1.523	0.5761	Design OK	Design OK	Design OK	Design OK
11	'COMBO_2A'		1.7897	-0.4938	0.0142	0.1343	8.4626	25.3995	6.1005	3.7400	3.7400	1.8700	Design OK	Design OK	Design OK	Design OK
12	'COMBO_2B'		3.3889	1.1212	0.0273	0.1114	7.0155	24.8684	6.9316	2.3797	1.1899	1.1899	Design OK	Design OK	Design OK	Design OK
13	'COMBO_3A'		3.3889	-1.8139	0.0284	0.1294	8.1625	25.2689	6.2311	3.4453	1.7226	1.7226	Design OK	Design OK	Design OK	Design OK
14	'COMBO_3B'		2.4007	25.8521	0.1064	0.1943	6.7055	24.4602	6.1005	3.7400	3.7400	1.8700	Design OK	Design OK	Design OK	Design OK
15	'COMBO_3C'		1.1767	36.3926	0.0756	0.1545	8.4626	25.3995	6.1005	3.7400	3.7400	1.8700	Design OK	Design OK	Design OK	Design OK
16	'COMBO_3D'		2.1547	27.7016	0.1114	0.1294	7.0155	24.8684	6.9316	2.3797	1.1899	1.1899	Design OK	Design OK	Design OK	Design OK
17	'COMBO_3E'		1.3927	34.4831	0.2094	0.1545	8.1625	25.2689	6.2311	3.4453	1.7226	1.7226	Design OK	Design OK	Design OK	Design OK
18	'COMBO_3F'		7.2078	1.2976	0.1796	0.1596	10.0531	22.5044	8.9956	1.1923	1.523	0.5761	Design OK	Design OK	Design OK	Design OK
19	'COMBO_3G'		7.4905	31.0360	4.1601	0.1596	10.0531	22.5044	8.9956	1.1923	1.523	0.5761	Design OK	Design OK	Design OK	Design OK
20	'COMBO_3H'		1.1767	36.3226	0.0756	0.1343	8.4626	25.3995	6.1005	3.7400	3.7400	1.8700	Design OK	Design OK	Design OK	Design OK
21	'COMBO_3I'		2.1847	27.7016	0.1114	0.1114	7.0155	24.8684	6.9316	2.3797	1.1899	1.1899	Design OK	Design OK	Design OK	Design OK
22	'COMBO_3J'		1.3927	34.4831	0.2094	0.1294	8.1625	25.2689	6.2311	3.4453	1.7226	1.7226	Design OK	Design OK	Design OK	Design OK
23	'COMBO_3K'		6.8485	4.6852	0.6841	0.0638	XXXX	XXXX	XXXX	XXXX	XXXX	XXXX	Design OK	Design OK	Design OK	Design OK
24	'COMBO_3L'		6.8485	4.6852	0.6841	0.0638	XXXX	XXXX	XXXX	XXXX	XXXX	XXXX	Design OK	Design OK	Design OK	Design OK
25	'COMBO_3M'		1.7887	-0.4986	-0.2788	0.0142	XXXX	XXXX	XXXX	XXXX	XXXX	XXXX	Design OK	Design OK	Design OK	Design OK
26	'COMBO_3N'		1.7887	-0.4986	-0.2788	0.0142	XXXX	XXXX	XXXX	XXXX	XXXX	XXXX	Design OK	Design OK	Design OK	Design OK
27	'COMBO_4A'		3.0127	52.2029	17.3274	0.2022	12.7375	24.9332	6.9088	4.8906	2.4403	2.4403	Design OK	Design OK	Design OK	Design OK
28	'COMBO_4B'		6.6847	73.1639	129.5541	0.2580	16.2517	25.8161	5.6839	8.2327	4.1164	4.1164	Design OK	Design OK	Design OK	Design OK
29	'COMBO_4C'		2.5807	55.9019	21.6612	0.2120	13.3576	25.1759	6.2341	6.2341	5.4645	5.4645	Design OK	Design OK	Design OK	Design OK
30	'COMBO_4D'		0.9967	69.4649	69.6924	0.2461	15.6315	25.7019	5.7981	5.7981	7.6349	7.6349	Design OK	Design OK	Design OK	Design OK
31	'COMBO_4E'		2.5074	-7.2940	-2.9080	0.0427	2.6925	29.9413	1.5587	1.5587	-2.1077	-1.0538	Design OK	Design OK	Design OK	Design OK
32	'COMBO_4F'		4.5939	53.8229	11.7182	0.2188	13.7836	24.5713	6.9287	6.9287	4.5015	4.5015	Design OK	Design OK	Design OK	Design OK
33	'COMBO_4G'		2.1459	74.7839	34.8487	0.2746	17.2978	25.4605	6.0395	6.0395	7.8037	7.8037	Design OK	Design OK	Design OK	Design OK
34	'COMBO_4H'		4.1619	57.5219	13.8211	0.2286	14.4037	24.7671	6.7329	6.7329	5.0742	5.0742	Design OK	Design OK	Design OK	Design OK
35	'COMBO_4I'		2.5779	71.0549	27.5747	0.2647	16.6777	25.3359	6.1641	6.1641	7.2128	7.2128	Design OK	Design OK	Design OK	Design OK
36	'COMBO_4J'		4.0585	-5.6740	-1.3878	0.0481	XXXX	XXXX	XXXX	XXXX	XXXX	XXXX	Design OK	Design OK	Design OK	Design OK
37	'COMBO_6A'		2.6556	52.3276	20.3982	0.1995	12.5691	25.1302	6.3698	6.3698	5.0594	5.0594	Design OK	Design OK	Design OK	Design OK
38	'COMBO_6B'		0.1176	73.2898	623.4596	0.2553	16.0833	25.9229	5.5771	5.5771	8.4252	8.4252	Design OK	Design OK	Design OK	Design OK
39	'COMBO_6C'		2.1336	56.0256	26.2598	0.2094	13.1992	25.3063	6.1937	6.1937	5.6464	5.6464	Design OK	Design OK	Design OK	Design OK
40	'COMBO_6D'		0.5496	89.5996	126.6208	0.2454	15.4632	25.8130	6.6570	6.6570	7.8256	7.8256	Design OK	Design OK	Design OK	Design OK
41	'COMBO_6E'		2.0602	-7.1693	-3.4799	0.0392	2.4696	30.6247	0.8753	0.8753	-1.8543	-0.9272	Design OK	Design OK	Design OK	Design OK
42	'COMBO_5A'		2.6473	20.4265	11.1157	0.1206	7.5952	24.5030	6.9970	6.9970	2.4140	2.4140	Design OK	Design OK	Design OK	Design OK
43	'COMBO_5B'		2.3577	28.7370	12.1895	0.1162	7.3177	24.6207	6.8793	6.8793	2.4366	2.4366	Design OK	Design OK	Design OK	Design OK
44	'COMBO_5C'		2.8219	-26.4769	-10.8815	0.1171	7.3764	33.6186	-2.1186	2.1186	-1.1335	-0.5687	Design OK	Design OK	Design OK	Design OK
45	'COMBO_5D'		2.3322	-28.1664	-12.5057	0.1175	7.4005	33.8480	-2.3480	2.3480	-0.6774	-0.3387	Design OK	Design OK	Design OK	Design OK
46	'COMBO_7A'		1.5676	28.9032	18.4374	0.1112	7.0084	25.0477	6.4523	6.4523	2.7390	2.7390	Design OK	Design OK	Design OK	Design OK
47	'COMBO_7B'		1.2781	28.2139	22.0754	0.1068	6.7309	25.1998	6.3102	6.3102	2.7670	2.7670	Design OK	Design OK	Design OK	Design OK
48	'COMBO_7C'		1.5422	-28.0002	-18.8047	0.1114	7.0185	34.3799	-2.8799	2.8799	3.9828	3.9828	Design OK	Design OK	Design OK	Design OK
49	'COMBO_7D'		1.2526	-29.6897	-23.7025	0.1118	7.0426	34.6086	-3.1086	3.1086	0.8324	0.4162	Design OK	Design OK	Design OK	Design OK

Calculation Sheet

Project: BGCAPP
 Job Number: 743341
 Calc. No. 24915-10-DBC-00-00004
 Sheet No. D2-27 / D2-51
 Sheet Rev. D

Subject: Gas Bottles Canopy, Supports, Equip, & Misc Foundations
 By: R. Murphy Date: 12/16/2007

A	B	C	D	E	F	G	H	I	J	K	L	M	N	O	P	Q
Joint	Output/Case	Fy	Mx	e	fp	anchor_tensio	f.prim	A.plus	A.minus	A.fmal	T.anchors	T.one_anchor	Nsa check	Nbcg check	Nsb check	Npn check
Text	Text	Kip	Kip-in	in		n					Kips	Kips				
62	9	20869	5.1053	2.4464	0.0322	in tension	2.0295	20.5560	10.9440	10.9440	0.0287	0.0144	Design OK	Design OK	Design OK	Design OK
63	9	17887	4.3759	2.4464	0.0276	in tension	1.7998	20.5560	10.9440	10.9440	0.0246	0.0123	Design OK	Design OK	Design OK	Design OK
64	9	33699	10.4146	3.0905	0.0598	in tension	3.7525	21.5243	9.9757	9.9757	0.1953	0.0976	Design OK	Design OK	Design OK	Design OK
65	9	21460	-0.1982	-0.0923	0.0156	not in tension	XXXX	XXXX	XXXX	XXXX	XXXX	XXXX	XXXX	XXXX	XXXX	XXXX
66	9	24007	6.3906	2.8819	0.0389	in tension	2.4483	20.9009	10.5891	10.5891	0.0637	0.0319	Design OK	Design OK	Design OK	Design OK
67	9	21767	2.3692	2.0134	0.0164	in tension	1.0331	19.5397	11.9603	11.9603	0.0000	0.0000	Design OK	Design OK	Design OK	Design OK
68	9	21847	5.6810	2.6003	0.0349	in tension	2.1985	20.8300	10.6700	10.6700	0.0494	0.0247	Design OK	Design OK	Design OK	Design OK
69	9	33927	3.0789	2.2107	0.0204	in tension	1.2828	20.0587	11.4413	11.4413	0.0051	0.0025	Design OK	Design OK	Design OK	Design OK
70	9	72005	18.1256	2.6535	0.0165	in tension	7.3371	20.9173	10.5827	10.5827	0.1872	0.0986	Design OK	Design OK	Design OK	Design OK
71	9	40468	25.7145	3.4468	0.1411	in tension	8.8590	21.9118	9.5392	9.5392	0.6566	0.3283	Design OK	Design OK	Design OK	Design OK
72	9	11767	2.3692	2.0134	0.0164	in tension	1.0331	19.5397	11.9603	11.9603	0.0000	0.0000	Design OK	Design OK	Design OK	Design OK
73	9	21847	5.6810	2.6003	0.0349	in tension	2.1985	20.8300	10.6700	10.6700	0.0494	0.0247	Design OK	Design OK	Design OK	Design OK
74	9	33927	3.0789	2.2107	0.0204	in tension	1.2828	20.0587	11.4413	11.4413	0.0051	0.0025	Design OK	Design OK	Design OK	Design OK
75	9	68485	23.6988	3.4606	0.1288	in tension	8.1805	21.9254	9.5745	9.5745	0.6111	0.3055	Design OK	Design OK	Design OK	Design OK
76	9	68485	23.6988	3.4606	0.1288	in tension	8.1805	21.9254	9.5745	9.5745	0.6111	0.3055	Design OK	Design OK	Design OK	Design OK
77	9	17887	4.3759	2.4464	0.0276	in tension	1.7998	20.5560	10.9440	10.9440	0.0246	0.0123	Design OK	Design OK	Design OK	Design OK
78	9	30127	8.4053	2.7899	0.0501	in tension	3.1567	21.1283	10.3737	10.3737	0.1060	0.0530	Design OK	Design OK	Design OK	Design OK
79	9	5647	0.3625	0.6418	0.0052	not in tension	XXXX	XXXX	XXXX	XXXX	XXXX	XXXX	XXXX	XXXX	XXXX	XXXX
80	9	25907	6.9860	2.7070	0.0422	in tension	2.6573	21.0017	10.4983	10.4983	0.0761	0.0380	Design OK	Design OK	Design OK	Design OK
81	9	09867	1.7818	1.7876	0.0131	not in tension	XXXX	XXXX	XXXX	XXXX	XXXX	XXXX	XXXX	XXXX	XXXX	XXXX
82	9	25074	-4.7724	-1.9034	0.0340	not in tension	XXXX	XXXX	XXXX	XXXX	XXXX	XXXX	XXXX	XXXX	XXXX	XXXX
83	9	45938	14.4440	3.1442	0.0821	in tension	5.1695	21.5978	9.9122	9.9122	0.2851	0.1431	Design OK	Design OK	Design OK	Design OK
84	9	21459	8.4012	2.9830	0.0371	in tension	2.3391	21.3908	10.1094	10.1094	0.1062	0.0531	Design OK	Design OK	Design OK	Design OK
85	9	41619	13.0247	3.1295	0.0741	in tension	4.6700	21.5707	9.8283	9.8283	0.2543	0.1271	Design OK	Design OK	Design OK	Design OK
86	9	25779	7.8205	3.0337	0.0451	in tension	2.8386	21.4547	10.0453	10.0453	0.1377	0.0689	Design OK	Design OK	Design OK	Design OK
87	9	40885	1.2863	0.3097	0.0328	not in tension	XXXX	XXXX	XXXX	XXXX	XXXX	XXXX	XXXX	XXXX	XXXX	XXXX
88	9	25856	7.3113	2.8498	0.0432	in tension	2.7218	21.2119	10.2881	10.2881	0.1013	0.0508	Design OK	Design OK	Design OK	Design OK
89	9	01176	-0.7315	-6.2229	0.0334	in tension	0.2114	32.4304	-0.9304	0.9304	-0.0898	-0.0494	Design OK	Design OK	Design OK	Design OK
90	9	21336	5.8920	2.7616	0.0353	in tension	2.2223	21.0846	10.4154	10.4154	0.0709	0.0354	Design OK	Design OK	Design OK	Design OK
91	9	05496	0.6878	1.2516	0.0062	not in tension	XXXX	XXXX	XXXX	XXXX	XXXX	XXXX	XXXX	XXXX	XXXX	XXXX
92	9	20802	-5.8664	-2.8475	0.0347	in tension	2.1846	29.8558	1.6442	1.6442	-1.7181	-0.8590	Design OK	Design OK	Design OK	Design OK
93	9	26473	26.3616	9.3802	0.1064	in tension	6.7060	24.2925	7.2075	7.2075	1.9659	0.9780	Design OK	Design OK	Design OK	Design OK
94	9	33577	-11.3164	-4.7598	0.0557	in tension	3.5070	31.7002	-0.2002	0.2002	-2.2908	-1.1454	Design OK	Design OK	Design OK	Design OK
95	9	26218	35.2348	9.8249	0.1058	in tension	6.6672	24.2995	7.2005	7.2005	1.9502	0.9751	Design OK	Design OK	Design OK	Design OK
96	9	23322	-11.4433	-4.9086	0.0559	in tension	3.6236	31.7668	-0.2868	0.2868	-2.2427	-1.1214	Design OK	Design OK	Design OK	Design OK
97	9	18522	13.9395	0.0688	0.0688	in tension	5.4860	24.7765	6.7285	6.7285	1.9324	0.9682	Design OK	Design OK	Design OK	Design OK
98	9	12781	-14.8259	-11.6003	0.0604	in tension	3.8023	33.7289	-2.2288	2.2288	-0.4709	-0.2355	Design OK	Design OK	Design OK	Design OK
99	9	15422	21.7253	14.0874	0.0661	in tension	6.4271	24.7880	6.7120	6.7120	1.9271	0.9635	Design OK	Design OK	Design OK	Design OK
100	9	12526	-14.9528	-11.9374	0.0670	in tension	3.8189	33.7751	-2.2751	2.2751	-0.4251	-0.2126	Design OK	Design OK	Design OK	Design OK

Calculation Sheet

Project: BGCAPP
Job Number: 743341
Calc. No. 24915-10-DBC-00-00004
Sheet No. D2-28 / D2-51
Sheet Rev. D

Subject: Gas Bottles Canopy, Supports, Equip, & Misc Foundations
By: R. Murphy Date: 12/16/2007

A	B	C	D	E	F	G	H	I	J	K	L	M	N	O	P	Q
N.plate (in)	B.plate (in)	x.a (in)	N.prime (in)	A.prime (in)	e.kern	ψ	N.design	←one anchor	A.minus	A.final	T.anchors	Ncbq (kip)	Npn (kip)	Nsb (kip)		
Joint	Output/Case	Py	Mz	e	fp	anchor	t.prime	A.plus	A.minus	A.final	T.anchors	T.one_anchor	Nsa check	Ncbq check	Nsb check	Npn check
3	10	COMBO_1	1.5	10.5	4.5	2	14.82528	←one anchor	XXXX	XXXX	XXXX	XXXX	XXXX	XXXX	XXXX	XXXX
4	12	COMBO_2A	1.5	10.5	4.5	2	14.82528	←one anchor	XXXX	XXXX	XXXX	XXXX	XXXX	XXXX	XXXX	XXXX
5	12	COMBO_2B	1.5	10.5	4.5	2	14.82528	←one anchor	XXXX	XXXX	XXXX	XXXX	XXXX	XXXX	XXXX	XXXX
6	12	COMBO_3A	1.5	10.5	4.5	2	14.82528	←one anchor	XXXX	XXXX	XXXX	XXXX	XXXX	XXXX	XXXX	XXXX
7	12	COMBO_3B	1.5	10.5	4.5	2	14.82528	←one anchor	XXXX	XXXX	XXXX	XXXX	XXXX	XXXX	XXXX	XXXX
8	12	COMBO_3C	1.5	10.5	4.5	2	14.82528	←one anchor	XXXX	XXXX	XXXX	XXXX	XXXX	XXXX	XXXX	XXXX
9	12	COMBO_3E	1.5	10.5	4.5	2	14.82528	←one anchor	XXXX	XXXX	XXXX	XXXX	XXXX	XXXX	XXXX	XXXX
10	12	COMBO_3F	1.5	10.5	4.5	2	14.82528	←one anchor	XXXX	XXXX	XXXX	XXXX	XXXX	XXXX	XXXX	XXXX
11	12	COMBO_3G	1.5	10.5	4.5	2	14.82528	←one anchor	XXXX	XXXX	XXXX	XXXX	XXXX	XXXX	XXXX	XXXX
12	12	COMBO_3H	1.5	10.5	4.5	2	14.82528	←one anchor	XXXX	XXXX	XXXX	XXXX	XXXX	XXXX	XXXX	XXXX
13	12	COMBO_3I	1.5	10.5	4.5	2	14.82528	←one anchor	XXXX	XXXX	XXXX	XXXX	XXXX	XXXX	XXXX	XXXX
14	12	COMBO_3J	1.5	10.5	4.5	2	14.82528	←one anchor	XXXX	XXXX	XXXX	XXXX	XXXX	XXXX	XXXX	XXXX
15	12	COMBO_3K	1.5	10.5	4.5	2	14.82528	←one anchor	XXXX	XXXX	XXXX	XXXX	XXXX	XXXX	XXXX	XXXX
16	12	COMBO_3L	1.5	10.5	4.5	2	14.82528	←one anchor	XXXX	XXXX	XXXX	XXXX	XXXX	XXXX	XXXX	XXXX
17	12	COMBO_3M	1.5	10.5	4.5	2	14.82528	←one anchor	XXXX	XXXX	XXXX	XXXX	XXXX	XXXX	XXXX	XXXX
18	12	COMBO_3N	1.5	10.5	4.5	2	14.82528	←one anchor	XXXX	XXXX	XXXX	XXXX	XXXX	XXXX	XXXX	XXXX

Calculation Sheet

Project: BGCAPP
Job Number: 743341
Calc. No. 24915-10-DBC-00-00004
Sheet No. D2-29 / D2-51
Sheet Rev. D

Subject: Gas Bottles Canopy, Supports, Equip, & Misc Foundations
By: R. Murphy Date: 12/16/2007

	A	B	C	D	E	F	G	H	I	J	K	L	M	N	O	P	Q
	Joint	Output/Case	Pt	Kip	Kip-in	e	in	ip	anchor_tension	lptime	A,final	T_anchors	T_ore_anchor	N	O	P	Q
	Text	Text	Kip	Kip-in	Kip-in	in	in	ip	in tension	lptime	A,final	T_anchors	T_ore_anchor	N	O	P	Q
62																	
63																	
64	10	'COMBO_1'	2.0818	-5.1053	-2.4464	0.0322	in tension	0.0322	29.2242	2.2758	2.2758	-1.8469	-0.8235	Design OK	Design OK	Design OK	
65	10	'COMBO_2A'	1.7887	-4.3759	-2.4464	0.0276	in tension	0.0276	29.2242	2.2758	2.2758	-1.4116	-0.7058	Design OK	Design OK	Design OK	
66	10	'COMBO_2B'	3.8699	-10.4146	-3.0903	0.0506	in tension	0.0506	30.1788	1.3212	1.3212	-2.8977	-1.4489	Design OK	Design OK	Design OK	
67	10	'COMBO_3A'	2.2214	-11.5653	-5.2062	0.0556	in tension	0.0556	31.9418	-0.4418	0.4418	-2.0741	-1.0370	Design OK	Design OK	Design OK	
68	10	'COMBO_3B'	2.4007	-6.3906	-2.6519	0.0389	in tension	0.0389	29.5807	1.9193	1.9193	-1.9532	-0.9765	Design OK	Design OK	Design OK	
69	10	'COMBO_3C'	1.1767	-2.3682	-2.0134	0.0164	in tension	0.0164	28.3532	3.1468	3.1468	-0.8871	-0.4338	Design OK	Design OK	Design OK	
70	10	'COMBO_3D'	2.1847	-5.6810	-2.6003	0.0349	in tension	0.0349	29.4831	2.0160	2.0160	-1.7524	-0.8812	Design OK	Design OK	Design OK	
71	10	'COMBO_3E'	1.3927	-3.0769	-2.2107	0.0204	in tension	0.0204	28.7796	2.7204	2.7204	-1.0604	-0.5302	Design OK	Design OK	Design OK	
72	10	'COMBO_3F'	7.2812	-30.8892	-4.2423	0.1411	in tension	0.1411	31.3102	0.1998	0.1998	-7.1014	-3.3507	Design OK	Design OK	Design OK	
73	10	'COMBO_3G'	7.4605	-25.7145	-3.4463	0.1411	in tension	0.1411	30.5697	0.9103	0.9103	-6.6593	-3.3449	Design OK	Design OK	Design OK	
74	10	'COMBO_3H'	1.1767	-2.3682	-2.0134	0.0164	in tension	0.0164	28.3532	3.1468	3.1468	-0.8871	-0.4338	Design OK	Design OK	Design OK	
75	10	'COMBO_3I'	2.1847	-5.6810	-2.6003	0.0349	in tension	0.0349	29.4831	2.0160	2.0160	-1.7524	-0.8812	Design OK	Design OK	Design OK	
76	10	'COMBO_3J'	1.3927	-3.0769	-2.2107	0.0204	in tension	0.0204	28.7796	2.7204	2.7204	-1.0604	-0.5302	Design OK	Design OK	Design OK	
77	10	'COMBO_3K'	6.8495	-23.6998	-3.4806	0.1298	in tension	0.1298	30.6044	0.8955	0.8955	-6.1507	-3.0753	Design OK	Design OK	Design OK	
78	10	'COMBO_3L'	6.8485	-23.6998	-3.4806	0.1298	in tension	0.1298	30.6044	0.8955	0.8955	-6.1507	-3.0753	Design OK	Design OK	Design OK	
79	10	'COMBO_3M'	1.7887	-4.3759	-2.4464	0.0276	in tension	0.0276	29.2242	2.2758	2.2758	-1.4116	-0.7058	Design OK	Design OK	Design OK	
80	10	'COMBO_3N'	1.7887	-4.3759	-2.4464	0.0276	in tension	0.0276	29.2242	2.2758	2.2758	-1.4116	-0.7058	Design OK	Design OK	Design OK	
81	10	'COMBO_4A'	3.0127	-8.4053	-2.7899	0.0501	in tension	0.0501	29.7733	1.7267	1.7267	-2.4938	-1.2488	Design OK	Design OK	Design OK	
82	10	'COMBO_4B'	0.5647	-0.3625	-0.6418	0.0052	not in tension	XXXX	XXXX	XXXX	XXXX	XXXX	XXXX	XXXX	XXXX	XXXX	XXXX
83	10	'COMBO_4C'	2.5807	-8.9880	-2.7070	0.0422	in tension	0.0422	29.5489	1.9501	1.9501	-2.1125	-1.0563	Design OK	Design OK	Design OK	
84	10	'COMBO_4D'	0.9967	-1.7818	-1.7876	0.0131	not in tension	XXXX	XXXX	XXXX	XXXX	XXXX	XXXX	XXXX	XXXX	XXXX	XXXX
85	10	'COMBO_4E'	2.8541	-18.7547	-7.0682	0.0936	in tension	0.0936	32.7448	-1.2448	1.2448	-2.0301	-1.0151	Design OK	Design OK	Design OK	
86	10	'COMBO_4F'	4.5939	-14.4440	-3.1442	0.0821	in tension	0.0821	30.2451	1.2549	1.2549	-3.9761	-1.9890	Design OK	Design OK	Design OK	
87	10	'COMBO_4G'	2.1459	-8.4012	-2.9830	0.0371	in tension	0.0371	30.0407	1.4593	1.4593	-1.8208	-0.9104	Design OK	Design OK	Design OK	
88	10	'COMBO_4H'	4.1619	-13.0247	-3.1295	0.0741	in tension	0.0741	30.2272	1.2728	1.2728	-3.5953	-1.7979	Design OK	Design OK	Design OK	
89	10	'COMBO_4I'	2.5779	-7.3205	-3.0337	0.0451	in tension	0.0451	30.1067	1.3933	1.3933	-2.2012	-1.1006	Design OK	Design OK	Design OK	
90	10	'COMBO_4J'	4.2353	-24.7934	-5.8540	0.1155	in tension	0.1155	32.2693	-0.7693	0.7693	-3.7022	-1.8511	Design OK	Design OK	Design OK	
91	10	'COMBO_5A'	2.5856	-7.3113	-2.8498	0.0432	in tension	0.0432	29.8590	1.8410	1.8410	-2.1402	-1.0701	Design OK	Design OK	Design OK	
92	10	'COMBO_5B'	0.1176	0.7315	6.2229	0.0034	in tension	0.0034	23.5142	7.9858	7.9858	0.0433	0.0216	Design OK	Design OK	Design OK	
93	10	'COMBO_5C'	2.1336	-5.8920	-2.7616	0.0353	in tension	0.0353	29.7318	1.7682	1.7682	-1.7593	-0.8797	Design OK	Design OK	Design OK	
94	10	'COMBO_5D'	0.5496	-0.8578	-1.2516	0.0052	not in tension	XXXX	XXXX	XXXX	XXXX	XXXX	XXXX	XXXX	XXXX	XXXX	XXXX
95	10	'COMBO_5E'	2.2069	-17.6607	-8.0024	0.0766	in tension	0.0766	33.0267	-1.5267	1.5267	-1.5048	-0.7524	Design OK	Design OK	Design OK	
96	10	'COMBO_5A'	2.8473	11.4483	4.3227	0.0581	in tension	0.0581	22.6147	8.8653	8.8653	0.4511	0.2255	Design OK	Design OK	Design OK	
97	10	'COMBO_5B'	2.3577	-25.2348	-10.7031	0.1040	in tension	0.1040	33.5932	-2.0932	2.0932	-1.0518	-0.5253	Design OK	Design OK	Design OK	
98	10	'COMBO_5C'	2.6218	11.3164	4.3162	0.0575	in tension	0.0575	22.8105	8.8695	8.8695	0.4451	0.2225	Design OK	Design OK	Design OK	
99	10	'COMBO_5D'	2.8322	-25.3616	-10.8743	0.1043	in tension	0.1043	33.6208	-2.1206	2.1206	-1.0057	-0.5028	Design OK	Design OK	Design OK	
100	10	'COMBO_7A'	1.5876	14.9528	9.5394	0.0628	in tension	0.0628	24.2859	7.2141	7.2141	1.1509	0.5754	Design OK	Design OK	Design OK	
101	10	'COMBO_7B'	1.2781	-21.7253	-16.9986	0.0843	in tension	0.0843	34.2647	-2.7647	2.7647	0.1205	0.0603	Design OK	Design OK	Design OK	
102	10	'COMBO_7C'	1.5422	14.8259	9.6136	0.0622	in tension	0.0622	24.2978	7.2022	7.2022	1.1452	0.5726	Design OK	Design OK	Design OK	
103	10	'COMBO_7D'	1.2526	-21.8522	-17.4455	0.0846	in tension	0.0846	34.2953	-2.7953	2.7953	0.1639	0.0829	Design OK	Design OK	Design OK	

Calculation Sheet

Project: BGCAPP
Job Number: 743341
Calc. No. 24915-10-DBC-00-00004
Sheet No. D2-32 / D2-51
Sheet Rev. D

Subject: Gas Bottles Canopy, Supports, Equip, & Misc Foundations
By: R. Murphy Date: 12/16/2007

“Interaction Check”

A	B	C	D	E	F	G	H	I	J
3	Nsa (kip) one anchor 77.6	Ncbg (kip) two anchors 9.959	Npn (kip) one anchor 20.928	Nsb (kip) one anchor 36.826			Vsa (kip) one anchor 62.08	Vcbg (kip) four anchor 8.775	Vcpb (kip) four anchor 19.718
4									
5									
6	ΦN	29.65056	17.7905	91.3055			62.768	7.45875	59.30025
7									
8	one anchor-->	N.design	14.825275						
9	four anchor-->	V.design	7.45875						
10									
11	Joint	Output/Case	Fx=Vx	Fz=Vz	1/N.design	Vx/V.design	Vz/V.design	Interaction Check (Vx)	Interaction Check (Vz)
12	Text	Text	Kip	Kip					
13	9	'COMBO_1'	XXXX	0.0000	0.0000	0.0000	0.0202	Check not needed	Check not needed
14	9	'COMBO_2A	XXXX	0.1289	0.0000	0.0000	0.0173	Check not needed	Check not needed
15	9	'COMBO_2B	XXXX	0.3070	0.0000	0.0000	0.0412	Check not needed	Check not needed
16	9	'COMBO_3A	XXXX	0.0350	0.0000	0.0044	0.0047	Check not needed	Check not needed
17	9	'COMBO_3B	1.0475	0.1867	0.0707	-0.0387	0.0250	Check not needed	Check not needed
18	9	'COMBO_3C	1.8700	0.0713	0.1261	-0.0523	0.0096	Check not needed	Check not needed
19	9	'COMBO_3D	1.1899	0.1663	0.0803	-0.0411	0.0223	Check not needed	Check not needed
20	9	'COMBO_3E	1.7226	0.0916	0.1162	-0.0499	0.0123	Check not needed	Check not needed
21	9	'COMBO_3F	XXXX	0.6051	0.0000	0.0044	0.0811	Check not needed	Check not needed
22	9	'COMBO_3G	0.5761	0.7568	0.0389	-0.0387	0.1015	Check not needed	Check not needed
23	9	'COMBO_3H	1.8700	0.0713	0.1261	-0.0523	0.0096	Check not needed	Check not needed
24	9	'COMBO_3I	1.1899	0.1663	0.0803	-0.0411	0.0223	Check not needed	Check not needed
25	9	'COMBO_3J	1.7226	0.0916	0.1162	-0.0499	0.0123	Check not needed	Check not needed
26	9	'COMBO_3K	XXXX	0.6990	0.0000	0.0000	0.0937	Check not needed	Check not needed
27	9	'COMBO_3L	XXXX	0.6990	0.0000	0.0000	0.0937	Check not needed	Check not needed
28	9	'COMBO_3M	XXXX	0.1289	0.0000	0.0000	0.0173	Check not needed	Check not needed
29	9	'COMBO_3N	XXXX	0.1289	0.0000	0.0000	0.0173	Check not needed	Check not needed
30	9	'COMBO_4A	2.4403	0.2445	0.1646	-0.0773	0.0328	Check not needed	Check not needed
31	9	'COMBO_4B	4.1164	0.0136	0.2777	-0.1047	0.0018	0.173	0.279
32	9	'COMBO_4C	2.7322	0.2037	0.1843	-0.0821	0.0273	Check not needed	Check not needed
33	9	'COMBO_4D	3.8175	0.0544	0.2575	-0.0998	0.0073	0.158	0.265
34	9	'COMBO_4E	-1.0538	-0.0589	-0.0711	0.0089	-0.0079	Check not needed	Check not needed
35	9	'COMBO_4F	2.2508	0.4226	0.1518	-0.0773	0.0567	Check not needed	Check not needed
36	9	'COMBO_4G	3.9019	0.1918	0.2632	-0.1047	0.0257	0.159	0.289
37	9	'COMBO_4H	2.5371	0.3819	0.1711	-0.0821	0.0512	Check not needed	Check not needed
38	9	'COMBO_4I	3.6064	0.2325	0.2433	-0.0998	0.0312	0.143	0.274
39	9	'COMBO_4J	XXXX	0.1192	0.0000	0.0089	0.0160	Check not needed	Check not needed
40	9	'COMBO_6A	2.5297	0.2122	0.1706	-0.0773	0.0285	Check not needed	Check not needed
41	9	'COMBO_6B	4.2126	-0.0186	0.2842	-0.1047	-0.0025	0.179	0.282
42	9	'COMBO_6C	2.8232	0.1715	0.1904	-0.0821	0.0230	Check not needed	Check not needed
43	9	'COMBO_6D	3.9128	0.0222	0.2639	-0.0998	0.0030	0.164	0.267
44	9	'COMBO_6E	-0.9272	-0.0911	-0.0625	0.0089	-0.0122	Check not needed	Check not needed
45	9	'COMBO_5A	1.2070	0.5307	0.0814	0.0366	0.0712	Check not needed	Check not needed
46	9	'COMBO_5B	1.2183	-0.1168	0.0822	0.0357	-0.0157	Check not needed	Check not needed
47	9	'COMBO_5C	-0.5667	0.5269	-0.0382	-0.0357	0.0706	Check not needed	Check not needed
48	9	'COMBO_5D	-0.3387	-0.1206	-0.0228	-0.0366	-0.0162	Check not needed	Check not needed
49	9	'COMBO_7A	1.3695	0.4272	0.0924	0.0366	0.0573	Check not needed	Check not needed
50	9	'COMBO_7B	1.3835	-0.2203	0.0933	0.0357	-0.0295	Check not needed	Check not needed
51	9	'COMBO_7C	0.1914	0.4235	0.0129	-0.0357	0.0568	Check not needed	Check not needed
52	9	'COMBO_7D	0.4162	-0.2241	0.0281	-0.0366	-0.0300	Check not needed	Check not needed

Subject: Gas Bottles Canopy, Supports, Equip, & Misc Foundations
By: R. Murphy Date: 12/16/2007

“Interaction Check”

A	B	C	D	E	F	G	H	I	J
Joint text	OutputCase Text	U _{one_anchor} Kips	F _{x=V_x} Kip	F _{z=V_z} Kip	T/N _{design}	V _{x/V_{design}}	V _{z/V_{design}}	Interaction Check (Vz)	Interaction Check (Vz)
65	10								
67	10								
68	10	COMBO_1	0.0000	-0.1503	-0.0555	0.0000	-0.020	Check not needed	Check not needed
69	10	COMBO_2A	0.0000	-0.1269	-0.0476	0.0000	-0.017	Check not needed	Check not needed
70	10	COMBO_2B	0.0000	-0.3070	-0.0977	0.0000	-0.041	Check not needed	Check not needed
71	10	COMBO_3A	0.0328	-0.2977	-0.0700	0.0044	-0.040	Check not needed	Check not needed
72	10	COMBO_3B	-0.2864	-0.1867	-0.0659	-0.0367	-0.025	Check not needed	Check not needed
73	10	COMBO_3C	-0.4336	-0.3904	-0.0292	-0.0523	-0.010	Check not needed	Check not needed
74	10	COMBO_3D	-0.8812	-0.3064	-0.0594	-0.0411	-0.022	Check not needed	Check not needed
75	10	COMBO_3E	-0.5302	-0.3724	-0.0358	-0.0499	-0.012	Check not needed	Check not needed
76	10	COMBO_3F	0.0328	-0.8678	-0.2395	0.0044	-0.116	Check not needed	Check not needed
77	10	COMBO_3G	-0.2684	-0.7568	-0.2256	-0.0337	-0.101	Check not needed	Check not needed
78	10	COMBO_3H	-0.4336	-0.0713	-0.0292	-0.0523	-0.010	Check not needed	Check not needed
79	10	COMBO_3I	-0.8812	-0.1663	-0.0594	-0.0411	-0.022	Check not needed	Check not needed
80	10	COMBO_3J	-0.5302	-0.0916	-0.0358	-0.0499	-0.012	Check not needed	Check not needed
81	10	COMBO_3K	0.0000	-0.6990	-0.2074	0.0000	-0.094	Check not needed	Check not needed
82	10	COMBO_3L	0.0000	-0.6990	-0.2074	0.0000	-0.094	Check not needed	Check not needed
83	10	COMBO_3M	-0.7058	-0.1289	-0.0476	0.0000	-0.017	Check not needed	Check not needed
84	10	COMBO_3N	-0.7058	-0.1289	-0.0476	0.0000	-0.017	Check not needed	Check not needed
85	10	COMBO_4A	-1.2468	-0.2445	-0.0841	-0.0773	-0.033	Check not needed	Check not needed
86	10	COMBO_4B	XXXX	-0.0136	0.0000	-0.1047	-0.002	Check not needed	Check not needed
87	10	COMBO_4C	-1.0563	-0.2037	-0.0712	-0.0621	-0.027	Check not needed	Check not needed
88	10	COMBO_4D	XXXX	-0.0544	0.0000	-0.0998	-0.007	Check not needed	Check not needed
89	10	COMBO_4E	-1.0151	-0.4665	-0.0685	0.0088	-0.063	Check not needed	Check not needed
90	10	COMBO_4F	-1.9880	-0.5767	-0.1341	-0.0773	-0.057	Check not needed	Check not needed
91	10	COMBO_4G	-0.9104	-0.1918	-0.0614	-0.1047	-0.026	Check not needed	Check not needed
92	10	COMBO_4H	-1.7978	-0.3819	-0.1213	-0.0821	-0.051	Check not needed	Check not needed
93	10	COMBO_4I	-1.1006	-0.2325	-0.0742	-0.0998	-0.031	Check not needed	Check not needed
94	10	COMBO_4J	-1.8511	-0.6446	-0.1249	0.0088	-0.086	Check not needed	Check not needed
95	10	COMBO_6A	0.0218	-0.2122	-0.0722	-0.0773	0.002	Check not needed	Check not needed
96	10	COMBO_6B	-0.7807	0.0186	0.0015	-0.1047	0.002	Check not needed	Check not needed
97	10	COMBO_6C	-0.8797	-0.1715	-0.0593	-0.0821	-0.003	Check not needed	Check not needed
98	10	COMBO_6D	XXXX	-0.0222	0.0000	-0.0998	-0.003	Check not needed	Check not needed
99	10	COMBO_6E	-0.7524	-0.4342	-0.0508	0.0088	-0.058	Check not needed	Check not needed
100	10	COMBO_5A	0.2255	0.1206	0.0192	0.0365	0.016	Check not needed	Check not needed
101	10	COMBO_5B	-0.5258	-0.5269	-0.0355	0.0057	-0.071	Check not needed	Check not needed
102	10	COMBO_5C	0.2225	0.1168	0.0150	-0.0357	0.016	Check not needed	Check not needed
103	10	COMBO_5D	-0.5028	-0.5307	-0.0339	-0.0366	-0.071	Check not needed	Check not needed
104	10	COMBO_7A	0.5754	0.2241	0.0398	0.0365	0.030	Check not needed	Check not needed
105	10	COMBO_7B	0.0503	-0.4235	0.0041	0.0057	-0.057	Check not needed	Check not needed
106	10	COMBO_7C	0.5726	0.2203	0.0396	-0.0357	0.030	Check not needed	Check not needed
107	10	COMBO_7D	0.0629	-0.4272	0.0056	-0.0366	-0.057	Check not needed	Check not needed



Project: BGCAPP
 Job Number: 24915
 Calc. No.: 10-DBC-00-00004
 Sheet No.: D2-34 of D2-51
 Sheet Rev.: D

Subject: Gas Bottle Canopy, Supports, Equip Misc Foundations
 By: M. Bratt Date: 1/25/2010

Dimensional Solutions Mat3D	Version	5.1.0	Date	1/25/2010
Foundation Name	Gas bottle canopies, Supports, Equip. & Misc Fdns		Time	10:21:49 AM
Designed By:	PARSONS	Engineer	M. Bratt	Checker
Filename:	C:\Documents and Settings\p0045388\My Documents\SCWO\...App D.2 Gas Bottle Canopy 2\FOUNDATION.m3d			

D2.4.2 Combined Footing Design

DETAIL REPORT

PROJECT INFORMATION

Project Name: Gas Bottle Canopy #2
Project Number: 10-DBC-00-00004
Client:
Project Location Richmond, KY
Foundation Description GAS BOTTLE CANOPIES, SUPPORTS, EQUIP. & MISC FDNS

DESIGN CODE ACI 318 - 1999 **INPUT UNITS** English **OUTPUT UNITS** English

CONCRETE PARAMETERS:

Compressive Strength (psi) 4000.00
 Unit Weight (pcf) 150.00

PILE PARAMETERS:

Diameter (in) 0
 Type Drilled Shaft

REINFORCING STEEL PARAMETERS:

Yield Strength (ksi) 60.00
 Unit Weight (pcf) 490.00
 Modulus of Elasticity (ksi) 29000.00

REBAR PARAMETERS:

Max Long Bar Size 6
 Min Long Bar Size 4
 Max Tie Bar Size 6
 Min Tie Bar Size 3
 Max Ftg Bar Size 9
 Min Ftg Bar Size 4
 Temp & Shrinkage Steel Ratio 0.0018

SOIL PARAMETERS:

Allowable Net Bearing Capacity (psf) 3000.00
 Unit Weight (pcf) 125.50

MINIMUM FOUNDATION CRITERIA:

Depth of Footing Below Grade (ft) 0.70
 Minimum Soil Cover (ft) 0.00



Project: BGCAPP
 Job Number: 24915
 Calc. No.: 10-DBC-00-00004
 Sheet No.: D2-35 of D2-51
 Sheet Rev.: D

Subject: Gas Bottle Canopy, Supports, Equip Misc Foundations
 By: M. Bratt Date: 1/25/2010

Dimensional Solutions Mat3D	Version	5.1.0	Date	1/25/2010	
Foundation Name	Gas bottle canopies, Supports, Equip. & Misc Fdns			Time	10:21:49 AM
Designed By:	PARSONS	Engineer	M. Bratt	Checker	
Filename:	C:\Documents and Settings\p0045388\My Documents\SCWO\...App D.2 Gas Bottle Canopy 2\FOUNDATION.m3d				

APPLIED LOADS

1

Load Case	Axial (kips)	Shear X (kips)	Mom Z (kip ft)	Shear Z (kips)	Mom X (kip ft)
1 - Dead	1.87	0.00	-0.06	0.17	0.48
2 - Snow	1.84	0.00	0.09	0.27	0.74
3 - WLEW1	0.49	-0.77	6.45	0.04	0.13
4 - WLEW2	0.49	-0.77	6.06	0.05	0.14
5 - WLEW3	0.75	-0.75	6.17	0.07	0.20
6 - WLEW4	0.77	-0.75	5.53	0.08	0.23
7 - WLNS	-0.21	-0.07	0.61	0.13	0.55
8 - EQX	0.01	0.34	3.07	0.00	0.01
9 - EQY	0.18	0.00	0.03	0.41	1.93

P2

Load Case	Axial (kips)	Shear X (kips)	Mom Z (kip ft)	Shear Z (kips)	Mom X (kip ft)
1 - Dead	1.93	0.00	-0.01	-0.17	-0.49
2 - Snow	2.01	0.00	0.22	-0.27	-0.76
3 - WLEW1	0.49	-0.77	6.45	-0.04	-0.13
4 - WLEW2	0.49	-0.77	6.06	-0.05	-0.14
5 - WLEW3	0.75	-0.75	6.17	-0.07	-0.20
6 - WLEW4	0.77	-0.75	5.53	-0.08	-0.23
7 - WLNS	-0.34	-0.08	0.64	0.21	0.77
8 - EQX	0.01	0.36	3.20	0.00	0.01
9 - EQY	0.18	0.00	0.03	0.41	1.93



Project: BGCAPP
 Job Number: 24915
 Calc. No.: 10-DBC-00-00004
 Sheet No.: D2-36 of D2-51
 Sheet Rev.: D

Subject: Gas Bottle Canopy, Supports, Equip Misc Foundations
 By: M. Bratt Date: 1/25/2010

Dimensional Solutions Mat3D	Version	5.1.0	Date	1/25/2010	
Foundation Name	Gas bottle canopies, Supports, Equip. & Misc Fdns			Time	10:21:49 AM
Designed By:	PARSONS	Engineer	M. Bratt	Checker	
Filename:	C:\Documents and Settings\p0045388\My Documents\SCWO\...App D.2 Gas Bottle Canopy 2\FOUNDATION.m3d				

UNFACTORED (ALLOWABLE) LOAD COMBINATIONS

1

Load Comb	Axial (kips)	Shear X (kips)	Mom Z (kip ft)	Shear Z (kips)	Mom X (kip ft)
1 - Dead	1.87	0.00	-0.06	0.17	0.48
2 - Dead + Snow	3.72	0.00	0.03	0.44	1.22
3 - Dead + 0.75Snow	3.26	0.00	0.01	0.37	1.04
4 - Dead + WLEW1	2.36	-0.78	6.39	0.22	0.61
5 - Dead + WLEW2	2.36	-0.78	6.00	0.22	0.62
6 - Dead + WLEW3	2.62	-0.75	6.11	0.24	0.68
7 - Dead + WLEW4	2.65	-0.75	5.47	0.25	0.71
8 - Dead + WLNS	1.66	-0.07	0.55	0.31	1.03
9 - Dead + 0.7EQX	1.88	0.24	2.09	0.18	0.49
10 - Dead + 0.7EQY	2.00	0.00	-0.04	0.46	1.84
11 - Dead + 0.75Snow + 0.75WLEW1	3.62	-0.58	4.84	0.41	1.13
12 - Dead + 0.75Snow + 0.75WLEW2	3.62	-0.58	4.55	0.41	1.14
13 - Dead + 0.75Snow + 0.75WLEW3	3.81	-0.57	4.63	0.43	1.19
14 - Dead + 0.75Snow + 0.75WLEW4	3.83	-0.57	4.15	0.43	1.21
15 - Dead + 0.75Snow + 0.75WLNS	3.10	-0.06	0.47	0.47	1.45
16 - Dead + 0.75Snow + 0.525EQX	3.26	0.18	1.62	0.37	1.04
17 - Dead + 0.75Snow + 0.525EQY	3.35	0.00	0.02	0.59	2.05
18 - 0.6Dead + WLEW1	1.61	-0.77	6.41	0.15	0.42
19 - 0.6Dead + WLEW2	1.61	-0.77	6.02	0.15	0.43
20 - 0.6Dead + WLEW3	1.87	-0.75	6.13	0.17	0.49
21 - 0.6Dead + WLEW4	1.90	-0.75	5.49	0.18	0.52
22 - 0.6Dead + WLNS	0.91	-0.07	0.58	0.24	0.84
23 - 0.6Dead + 0.7EQX	1.13	0.24	2.11	0.11	0.30
24 - 0.6Dead + 0.7EQY	1.25	0.00	-0.01	0.39	1.64



Project: BGCAPP
 Job Number: 24915
 Calc. No.: 10-DBC-00-00004
 Sheet No.: D2-37 of D2-51
 Sheet Rev.: D

Subject: Gas Bottle Canopy, Supports, Equip Misc Foundations
 By: M. Bratt Date: 1/25/2010

Dimensional Solutions Mat3D	Version	5.1.0	Date	1/25/2010	
Foundation Name	Gas bottle canopies, Supports, Equip. & Misc Fdns			Time	10:21:49 AM
Designed By:	PARSONS	Engineer	M. Bratt	Checker	
Filename:	C:\Documents and Settings\p0045388\My Documents\SCWO\...App D.2 Gas Bottle Canopy 2\FOUNDATION.m3d				

P2

Load Comb	Axial (kips)	Shear X (kips)	Mom Z (kip ft)	Shear Z (kips)	Mom X (kip ft)
1 - Dead	1.93	0.00	-0.01	-0.17	-0.49
2 - Dead + Snow	3.94	0.00	0.21	-0.44	-1.26
3 - Dead + 0.75Snow	3.44	0.00	0.16	-0.37	-1.07
4 - Dead + WLEW1	2.42	-0.77	6.44	-0.22	-0.62
5 - Dead + WLEW2	2.42	-0.77	6.05	-0.22	-0.63
6 - Dead + WLEW3	2.68	-0.75	6.16	-0.24	-0.69
7 - Dead + WLEW4	2.70	-0.75	5.52	-0.25	-0.72
8 - Dead + WLNS	1.60	-0.07	0.63	0.04	0.28
9 - Dead + 0.7EQX	1.94	0.25	2.23	-0.17	-0.49
10 - Dead + 0.7EQY	2.06	0.00	0.02	0.11	0.86
11 - Dead + 0.75Snow + 0.75WLEW1	3.80	-0.58	4.99	-0.41	-1.16
12 - Dead + 0.75Snow + 0.75WLEW2	3.80	-0.58	4.70	-0.41	-1.17
13 - Dead + 0.75Snow + 0.75WLEW3	3.99	-0.56	4.78	-0.43	-1.22
14 - Dead + 0.75Snow + 0.75WLEW4	4.01	-0.56	4.31	-0.43	-1.24
15 - Dead + 0.75Snow + 0.75WLNS	3.18	-0.05	0.64	-0.21	-0.49
16 - Dead + 0.75Snow + 0.525EQX	3.44	0.19	1.84	-0.37	-1.06
17 - Dead + 0.75Snow + 0.525EQY	3.53	0.00	0.17	-0.16	-0.05
18 - 0.6Dead + WLEW1	1.65	-0.77	6.44	-0.15	-0.42
19 - 0.6Dead + WLEW2	1.65	-0.77	6.05	-0.15	-0.44
20 - 0.6Dead + WLEW3	1.90	-0.75	6.16	-0.17	-0.50
21 - 0.6Dead + WLEW4	1.93	-0.75	5.53	-0.18	-0.52
22 - 0.6Dead + WLNS	0.82	-0.07	0.63	0.11	0.47
23 - 0.6Dead + 0.7EQX	1.17	0.25	2.24	-0.10	-0.29
24 - 0.6Dead + 0.7EQY	1.29	0.00	0.02	0.18	1.05



Project: BGCAPP
 Job Number: 24915
 Calc. No.: 10-DBC-00-00004
 Sheet No.: D2-38 of D2-51
 Sheet Rev.: D

Subject: Gas Bottle Canopy, Supports, Equip Misc Foundations
 By: M. Bratt Date: 1/25/2010

Dimensional Solutions Mat3D	Version	5.1.0	Date	1/25/2010	
Foundation Name	Gas bottle canopies, Supports, Equip. & Misc Fdns			Time	10:21:49 AM
Designed By:	PARSONS	Engineer	M. Bratt	Checker	
Filename:	C:\Documents and Settings\p0045388\My Documents\SCWO\...App D.2 Gas Bottle Canopy 2\FOUNDATION.m3d				

FACTORED (ULTIMATE) LOAD COMBINATIONS

1

Load Comb	Axial (kips)	Shear X (kips)	Mom Z (kip ft)	Shear Z (kips)	Mom X (kip ft)
1 - 1.4Dead	2.62	0.00	-0.09	0.24	0.68
2 - 1.2Dead + 0.5Snow	3.17	0.00	-0.03	0.34	0.95
3 - 1.2Dead + 1.6Snow + 0.8WLEW1	5.59	-0.62	5.23	0.67	1.87
4 - 1.2Dead + 1.6Snow + 0.8WLEW2	5.58	-0.62	4.92	0.67	1.88
5 - 1.2Dead + 1.6Snow + 0.8WLEW3	5.79	-0.61	5.00	0.69	1.92
6 - 1.2Dead + 1.6Snow + 0.8WLEW4	5.81	-0.60	4.50	0.70	1.95
7 - 1.2Dead + 1.6Snow + 0.8WLNS	5.02	-0.06	0.56	0.74	2.20
8 - 1.2Dead + 0.5Snow + 1.6WLEW1	3.95	-1.24	10.29	0.41	1.15
9 - 1.2Dead + 0.5Snow + 1.6WLEW2	3.95	-1.24	9.66	0.42	1.17
10 - 1.2Dead + 0.5Snow + 1.6WLEW3	4.36	-1.21	9.84	0.45	1.27
11 - 1.2Dead + 0.5Snow + 1.6WLEW4	4.41	-1.20	8.82	0.47	1.31
12 - 1.2Dead + 0.5Snow + 1.6WLNS	2.83	-0.12	0.95	0.55	1.82
13 - 1.2Dead + 0.2Snow + EQX	2.63	0.34	3.01	0.26	0.74
14 - 1.2Dead + 0.2Snow + EQY	2.80	0.00	-0.02	0.67	2.66
15 - 0.9Dead + 1.6WLEW1	2.47	-1.24	10.26	0.22	0.64
16 - 0.9Dead + 1.6WLEW2	2.46	-1.24	9.64	0.23	0.66
17 - 0.9Dead + 1.6WLEW3	2.88	-1.20	9.81	0.27	0.76
18 - 0.9Dead + 1.6WLEW4	2.92	-1.20	8.79	0.28	0.80
19 - 0.9Dead + 1.6WLNS	1.34	-0.11	0.93	0.37	1.31
20 - 0.9Dead + EQX	1.70	0.34	3.01	0.16	0.44
21 - 0.9Dead + EQY	1.87	0.00	-0.02	0.56	2.37



Project: BGCAPP
 Job Number: 24915
 Calc. No.: 10-DBC-00-00004
 Sheet No.: D2-39 of D2-51
 Sheet Rev.: D

Subject: Gas Bottle Canopy, Supports, Equip Misc Foundations
 By: M. Bratt Date: 1/25/2010

Dimensional Solutions Mat3D	Version	5.1.0	Date	1/25/2010	
Foundation Name	Gas bottle canopies, Supports, Equip. & Misc Fdns			Time	10:21:49 AM
Designed By:	PARSONS	Engineer	M. Bratt	Checker	
Filename:	C:\Documents and Settings\p0045388\My Documents\SCWO\...App D.2 Gas Bottle Canopy 2\FOUNDATION.m3d				

P2

Load Comb	Axial (kips)	Shear X (kips)	Mom Z (kip ft)	Shear Z (kips)	Mom X (kip ft)
1 - 1.4Dead	2.70	0.00	-0.01	-0.24	-0.69
2 - 1.2Dead + 0.5Snow	3.32	0.00	0.10	-0.34	-0.97
3 - 1.2Dead + 1.6Snow + 0.8WLEW1	5.92	-0.61	5.50	-0.67	-1.92
4 - 1.2Dead + 1.6Snow + 0.8WLEW2	5.92	-0.61	5.19	-0.67	-1.93
5 - 1.2Dead + 1.6Snow + 0.8WLEW3	6.12	-0.60	5.28	-0.69	-1.98
6 - 1.2Dead + 1.6Snow + 0.8WLEW4	6.14	-0.60	4.77	-0.70	-2.00
7 - 1.2Dead + 1.6Snow + 0.8WLNS	5.26	-0.06	0.85	-0.46	-1.20
8 - 1.2Dead + 0.5Snow + 1.6WLEW1	4.10	-1.24	10.42	-0.41	-1.18
9 - 1.2Dead + 0.5Snow + 1.6WLEW2	4.10	-1.24	9.79	-0.42	-1.20
10 - 1.2Dead + 0.5Snow + 1.6WLEW3	4.51	-1.20	9.97	-0.45	-1.29
11 - 1.2Dead + 0.5Snow + 1.6WLEW4	4.56	-1.20	8.95	-0.47	-1.34
12 - 1.2Dead + 0.5Snow + 1.6WLNS	2.78	-0.12	1.12	0.00	0.26
13 - 1.2Dead + 0.2Snow + EQX	2.73	0.36	3.24	-0.26	-0.74
14 - 1.2Dead + 0.2Snow + EQY	2.90	0.01	0.07	0.15	1.18
15 - 0.9Dead + 1.6WLEW1	2.52	-1.24	10.31	-0.22	-0.65
16 - 0.9Dead + 1.6WLEW2	2.52	-1.24	9.69	-0.23	-0.67
17 - 0.9Dead + 1.6WLEW3	2.93	-1.20	9.86	-0.27	-0.76
18 - 0.9Dead + 1.6WLEW4	2.97	-1.20	8.84	-0.28	-0.81
19 - 0.9Dead + 1.6WLNS	1.20	-0.12	1.01	0.19	0.79
20 - 0.9Dead + EQX	1.75	0.36	3.19	-0.15	-0.44
21 - 0.9Dead + EQY	1.92	0.00	0.03	0.25	1.49



Project: BGCAPP
 Job Number: 24915
 Calc. No.: 10-DBC-00-00004
 Sheet No.: D2-40 of D2-51
 Sheet Rev.: D

Subject: Gas Bottle Canopy, Supports, Equip Misc Foundations
 By: M. Bratt Date: 1/25/2010

Dimensional Solutions Mat3D	Version	5.1.0	Date	1/25/2010	
Foundation Name	Gas bottle canopies, Supports, Equip. & Misc Fdns			Time	10:21:49 AM
Designed By:	PARSONS	Engineer	M. Bratt	Checker	
Filename:	C:\Documents and Settings\p0045388\My Documents\SCWO\...App D.2 Gas Bottle Canopy 2\FOUNDATION.m3d				

BEARING CAPACITY - LINEAR SOIL PRESSURE METHOD

Load Comb	Max Pressure (ksf)	All Pressure (ksf)	Ecc N/S Dir (ft)	Ecc E/W Dir (ft)	Moment N/S axis (kip-ft)	Moment E/W axis (kip-ft)	Rem
1 - Dead	0.23	3.09	0.02	0.00	0.07	0.48	
2 - Dead + Snow	0.28	3.09	0.08	0.01	0.24	1.84	
3 - Dead + 0.75Snow	0.26	3.09	0.06	0.00	0.16	1.50	
4 - Dead + WLEW1	0.39	4.09	0.02	0.48	10.19	0.48	
5 - Dead + WLEW2	0.38	4.09	0.02	0.44	9.42	0.48	
6 - Dead + WLEW3	0.39	4.09	0.02	0.44	9.71	0.48	
7 - Dead + WLEW4	0.37	4.09	0.02	0.39	8.44	0.48	
8 - Dead + WLNS	0.24	4.09	0.07	0.05	0.93	1.36	
9 - Dead + 0.7EQX	0.30	4.09	0.02	0.25	5.15	0.49	
10 - Dead + 0.7EQY	0.24	4.09	0.20	0.00	0.01	4.16	
11 - Dead + 0.75Snow + 0.75WLEW1	0.39	4.09	0.06	0.33	7.86	1.50	
12 - Dead + 0.75Snow + 0.75WLEW2	0.38	4.09	0.06	0.30	7.28	1.50	
13 - Dead + 0.75Snow + 0.75WLEW3	0.39	4.09	0.06	0.31	7.50	1.50	
14 - Dead + 0.75Snow + 0.75WLEW4	0.37	4.09	0.06	0.27	6.55	1.50	
15 - Dead + 0.75Snow + 0.75WLNS	0.27	4.09	0.09	0.04	0.92	2.16	
16 - Dead + 0.75Snow + 0.525EQX	0.32	4.09	0.06	0.18	4.08	1.51	
17 - Dead + 0.75Snow + 0.525EQY	0.27	4.09	0.18	0.00	0.20	4.26	
18 - 0.6Dead + WLEW1	0.30	4.09	0.02	0.78	10.22	0.29	
19 - 0.6Dead + WLEW2	0.29	4.09	0.02	0.72	9.44	0.29	
20 - 0.6Dead + WLEW3	0.30	4.09	0.02	0.71	9.74	0.29	
21 - 0.6Dead + WLEW4	0.28	4.09	0.02	0.62	8.47	0.29	
22 - 0.6Dead + WLNS	0.15	4.09	0.10	0.08	0.96	1.16	
23 - 0.6Dead + 0.7EQX	0.21	4.09	0.02	0.42	5.18	0.30	
24 - 0.6Dead + 0.7EQY	0.15	4.09	0.32	0.00	0.01	3.97	



Project: BGCAPP
 Job Number: 24915
 Calc. No.: 10-DBC-00-00004
 Sheet No.: D2-41 of D2-51
 Sheet Rev.: D

Subject: Gas Bottle Canopy, Supports, Equip Misc Foundations
 By: M. Bratt Date: 1/25/2010

Dimensional Solutions Mat3D	Version	5.1.0	Date	1/25/2010	
Foundation Name	Gas bottle canopies, Supports, Equip. & Misc Fdns			Time	10:21:49 AM
Designed By:	PARSONS	Engineer	M. Bratt	Checker	
Filename:	C:\Documents and Settings\p0045388\My Documents\SCWO\...App D.2 Gas Bottle Canopy 2\FOUNDATION.m3d				

STABILITY RATIO / SLIDING SAFETY FACTOR

Load Comb	S.R. N/S Dir	S.R. E/W Dir	All S.R.	Sliding FS - N/S	Sliding FS - E/W	All FS	Remarks
1 - Dead	100.00	100.00	1.50	100.00	100.00	1.50	
2 - Dead + Snow	100.00	100.00	1.50	100.00	100.00	1.50	
3 - Dead + 0.75Snow	100.00	100.00	1.50	100.00	100.00	1.50	
4 - Dead + WLEW1	100.00	3.95	1.50	100.00	12.72	1.50	
5 - Dead + WLEW2	100.00	4.20	1.50	100.00	12.72	1.50	
6 - Dead + WLEW3	100.00	4.21	1.50	100.00	13.27	1.50	
7 - Dead + WLEW4	100.00	4.71	1.50	100.00	13.32	1.50	
8 - Dead + WLNS	100.00	37.92	1.50	34.48	100.00	1.50	
9 - Dead + 0.7EQX	100.00	8.89	1.50	100.00	39.22	1.50	
10 - Dead + 0.7EQY	56.07	100.00	1.50	21.54	100.00	1.50	
11 - Dead + 0.75Snow + 0.75WLEW1	100.00	5.68	1.50	100.00	18.10	1.50	
12 - Dead + 0.75Snow + 0.75WLEW2	100.00	6.04	1.50	100.00	18.10	1.50	
13 - Dead + 0.75Snow + 0.75WLEW3	100.00	6.02	1.50	100.00	18.80	1.50	
14 - Dead + 0.75Snow + 0.75WLEW4	100.00	6.71	1.50	100.00	18.87	1.50	
15 - Dead + 0.75Snow + 0.75WLNS	100.00	46.77	1.50	51.80	100.00	1.50	
16 - Dead + 0.75Snow + 0.525EQX	100.00	12.82	1.50	100.00	56.21	1.50	
17 - Dead + 0.75Snow + 0.525EQY	76.35	100.00	1.50	32.00	100.00	1.50	
18 - 0.6Dead + WLEW1	100.00	3.67	1.50	100.00	10.09	1.50	
19 - 0.6Dead + WLEW2	100.00	3.91	1.50	100.00	10.09	1.50	
20 - 0.6Dead + WLEW3	100.00	3.93	1.50	100.00	10.56	1.50	
21 - 0.6Dead + WLEW4	100.00	4.39	1.50	100.00	10.61	1.50	
22 - 0.6Dead + WLNS	96.75	34.22	1.50	22.72	100.00	1.50	
23 - 0.6Dead + 0.7EQX	100.00	8.18	1.50	100.00	30.91	1.50	
24 - 0.6Dead + 0.7EQY	51.91	100.00	1.50	14.43	100.00	1.50	



Project: BGCAPP
 Job Number: 24915
 Calc. No.: 10-DBC-00-00004
 Sheet No.: D2-42 of D2-51
 Sheet Rev.: D

Subject: Gas Bottle Canopy, Supports, Equip Misc Foundations
 By: M. Bratt Date: 1/25/2010

Dimensional Solutions Mat3D	Version	5.1.0	Date	1/25/2010	
Foundation Name	Gas bottle canopies, Supports, Equip. & Misc Fdns			Time	10:21:49 AM
Designed By:	PARSONS	Engineer	M. Bratt	Checker	
Filename:	C:\Documents and Settings\p0045388\My Documents\SCWO\...App D.2 Gas Bottle Canopy 2\FOUNDATION.m3d				

FOOTING DESIGN INFORMATION

X Dim (ft) 4.50
 Z Dim (ft) 20.00
 Thickness (ft) 1.20

Top Steel

Governing Combination	No of Bars	Bar Size	Bar Spac (in)	Area Prov (sq in/ft)	Area Req (sq in/ft)	Moment (kip ft/ft)	Direction
15. 0.9Dead + 1.6WLEW1	20	5	12	0.31	0	-0.14	E-W
6. 1.2Dead + 1.6Snow + 0.8WLEW4	5	5	12	0.34	0.11	-4.11	N-S

Bottom Steel

Governing Combination	No of Bars	Bar Size	Bar Spac (in)	Area Prov (sq in/ft)	Area Req (sq in/ft)	Moment (kip ft/ft)	Direction
10. 1.2Dead + 0.5Snow + 1.6WLEW3	20	5	12	0.31	0.31	0.32	E-W
21. 0.9Dead + EQY	5	5	12	0.34	0.31	0.47	N-S

PUNCHING SHEAR

1

Control Comb	Net Ult Load (kips)	Punch. Stress (psi)	All Stress (psi)	Rem
6. 1.2Dead + 1.6Snow + 0.8WLEW4	5.31	4.74	215.04	



Project: BGCAPP
 Job Number: 24915
 Calc. No.: 10-DBC-00-00004
 Sheet No.: D2-43 of D2-51
 Sheet Rev.: D

Subject: Gas Bottle Canopy, Supports, Equip Misc Foundations
 By: M. Bratt Date: 1/25/2010

Dimensional Solutions Mat3D	Version	5.1.0	Date	1/25/2010	
Foundation Name	Gas bottle canopies, Supports, Equip. & Misc Fdns			Time	10:21:49 AM
Designed By:	PARSONS	Engineer	M. Bratt	Checker	
Filename:	C:\Documents and Settings\p0045388\My Documents\SCWO\...App D.2 Gas Bottle Canopy 2\FOUNDATION.m3d				

P2

Control Comb	Net Ult Load (kips)	Punch. Stress (psi)	All Stress (psi)	Rem
6. 1.2Dead + 1.6Snow + 0.8WLEW4	5.60	5.00	215.04	

MAXIMUM SHEAR - X DIRECTION

Load Comb	Left Dist (ft)	Max Shear (kips)	Shear Stress (psi)	All Stress (psi)	Rem
1 - 1.4Dead	0.67	0.86	0.36	107.52	
2 - 1.2Dead + 0.5Snow	0.67	1.02	0.43	107.52	
3 - 1.2Dead + 1.6Snow + 0.8WLEW1	3.83	-3.22	1.34	107.52	
4 - 1.2Dead + 1.6Snow + 0.8WLEW2	3.83	-3.11	1.30	107.52	
5 - 1.2Dead + 1.6Snow + 0.8WLEW3	3.83	-3.21	1.34	107.52	
6 - 1.2Dead + 1.6Snow + 0.8WLEW4	3.83	-3.05	1.27	107.52	
7 - 1.2Dead + 1.6Snow + 0.8WLNS	3.83	-1.79	0.75	107.52	
8 - 1.2Dead + 0.5Snow + 1.6WLEW1	3.83	-4.03	1.68	107.52	
9 - 1.2Dead + 0.5Snow + 1.6WLEW2	3.83	-3.82	1.59	107.52	
10 - 1.2Dead + 0.5Snow + 1.6WLEW3	3.83	-4.02	1.68	107.52	
11 - 1.2Dead + 0.5Snow + 1.6WLEW4	3.83	-3.69	1.54	107.52	
12 - 1.2Dead + 0.5Snow + 1.6WLNS	3.83	-1.17	0.49	107.52	
13 - 1.2Dead + 0.2Snow + EQX	3.83	-2.11	0.88	107.52	
14 - 1.2Dead + 0.2Snow + EQY	0.67	0.91	0.38	107.52	
15 - 0.9Dead + 1.6WLEW1	3.83	-3.55	1.48	107.52	
16 - 0.9Dead + 1.6WLEW2	3.83	-3.33	1.39	107.52	
17 - 0.9Dead + 1.6WLEW3	3.83	-3.53	1.47	107.52	
18 - 0.9Dead + 1.6WLEW4	3.83	-3.20	1.33	107.52	
19 - 0.9Dead + 1.6WLNS	3.83	-0.68	0.28	107.52	
20 - 0.9Dead + EQX	3.83	-1.80	0.75	107.52	
21 - 0.9Dead + EQY	0.67	0.61	0.25	107.52	



Project: BGCAPP
 Job Number: 24915
 Calc. No.: 10-DBC-00-00004
 Sheet No.: D2-44 of D2-51
 Sheet Rev.: D

Subject: Gas Bottle Canopy, Supports, Equip Misc Foundations
 By: M. Bratt Date: 1/25/2010

Dimensional Solutions Mat3D	Version	5.1.0	Date	1/25/2010	
Foundation Name	Gas bottle canopies, Supports, Equip. & Misc Fdns			Time	10:21:49 AM
Designed By:	PARSONS	Engineer	M. Bratt	Checker	
Filename:	C:\Documents and Settings\p0045388\My Documents\SCWO\...App D.2 Gas Bottle Canopy 2\FOUNDATION.m3d				

MAXIMUM SHEAR - Z DIRECTION

Load Comb	Bottom Dist (ft)	Max Shear (kips)	Shear Stress (psi)	All Stress (psi)	Rem
1 - 1.4Dead	16.92	2.02	3.74	107.52	
2 - 1.2Dead + 0.5Snow	16.92	2.41	4.47	107.52	
3 - 1.2Dead + 1.6Snow + 0.8WLEW1	16.92	4.18	7.73	107.52	
4 - 1.2Dead + 1.6Snow + 0.8WLEW2	16.92	4.17	7.73	107.52	
5 - 1.2Dead + 1.6Snow + 0.8WLEW3	16.92	4.32	8.00	107.52	
6 - 1.2Dead + 1.6Snow + 0.8WLEW4	16.92	4.33	8.02	107.52	
7 - 1.2Dead + 1.6Snow + 0.8WLNS	3.08	-3.72	6.88	107.52	
8 - 1.2Dead + 0.5Snow + 1.6WLEW1	16.92	2.95	5.47	107.52	
9 - 1.2Dead + 0.5Snow + 1.6WLEW2	16.92	2.95	5.46	107.52	
10 - 1.2Dead + 0.5Snow + 1.6WLEW3	16.92	3.24	5.99	107.52	
11 - 1.2Dead + 0.5Snow + 1.6WLEW4	16.92	3.27	6.05	107.52	
12 - 1.2Dead + 0.5Snow + 1.6WLNS	3.08	-2.21	4.09	107.52	
13 - 1.2Dead + 0.2Snow + EQX	16.92	2.01	3.72	107.52	
14 - 1.2Dead + 0.2Snow + EQY	3.08	-2.30	4.26	107.52	
15 - 0.9Dead + 1.6WLEW1	16.92	1.84	3.41	107.52	
16 - 0.9Dead + 1.6WLEW2	16.92	1.84	3.40	107.52	
17 - 0.9Dead + 1.6WLEW3	16.92	2.12	3.93	107.52	
18 - 0.9Dead + 1.6WLEW4	16.92	2.15	3.99	107.52	
19 - 0.9Dead + 1.6WLNS	3.08	-1.13	2.09	107.52	
20 - 0.9Dead + EQX	16.92	1.31	2.42	107.52	
21 - 0.9Dead + EQY	3.08	-1.61	2.99	107.52	



Project: BGCAPP
 Job Number: 24915
 Calc. No.: 10-DBC-00-00004
 Sheet No.: D2-45 of D2-51
 Sheet Rev.: D

Subject: Gas Bottle Canopy, Supports, Equip Misc Foundations
 By: M. Bratt Date: 1/25/2010

Dimensional Solutions Mat3D	Version	5.1.0	Date	1/25/2010
Foundation Name	Gas bottle canopies, Supports, Equip. & Misc Fdns		Time	10:21:49 AM
Designed By:	PARSONS	Engineer	M. Bratt	Checker
Filename:	C:\Documents and Settings\p0045388\My Documents\SCWO\...App D.2 Gas Bottle Canopy 2\FOUNDATION.m3d			

PIER/BASE PLATE DESIGN INFORMATION

	1	P2
X Dim (ft)	1.50	1.50
Z Dim (ft)	1.50	1.50
Height (ft)	0.50	0.50
X Offset (ft)	2.25	2.25
Z Offset (ft)	1.50	18.50
Requested Reinf. Ratio	0.0018	0.0018
Provided Reinf. Ratio	0.0055	0.0055
Long Bar Size	6	6
Bars in X Dir	2	2
Bars in Z Dir	2	2
Total Long Bars	4	4
Tie Bar Size	3	3
Total No. of Ties	2	2
Major Tie Spacing (in)	2	2



Project: BGCAPP
 Job Number: 24915
 Calc. No.: 10-DBC-00-00004
 Sheet No.: D2-46 of D2-51
 Sheet Rev.: D

Subject: Gas Bottle Canopy, Supports, Equip Misc Foundations
 By: M. Bratt Date: 1/25/2010

Dimensional Solutions Mat3D	Version	5.1.0	Date	1/25/2010	
Foundation Name	Gas bottle canopies, Supports, Equip. & Misc Fdns			Time	10:21:49 AM
Designed By:	PARSONS	Engineer	M. Bratt	Checker	
Filename:	C:\Documents and Settings\p0045388\My Documents\SCWO\...App D.2 Gas Bottle Canopy 2\FOUNDATION.m3d				

PIER ULTIMATE LOAD CAPACITIES

1

Load Comb	Axial Load (kips)	Axial Capa. (kips)	Mom X (kip ft)	Mom X Capa (kip ft)	Mom Z (kip ft)	Mom Z Capa (kip ft)	Rem
1 - 1.4Dead	2.86	497.23	0.80	137.80	0.27	47.13	
2 - 1.2Dead + 0.5Snow	3.37	446.11	1.12	146.71	0.32	42.29	
3 - 1.2Dead + 1.6Snow + 0.8WLEW1	5.79	118.37	2.20	45.00	4.92	100.29	
4 - 1.2Dead + 1.6Snow + 0.8WLEW2	5.79	132.36	2.21	50.32	4.61	104.04	
5 - 1.2Dead + 1.6Snow + 0.8WLEW3	5.99	134.86	2.27	50.79	4.70	104.70	
6 - 1.2Dead + 1.6Snow + 0.8WLEW4	6.02	153.60	2.30	58.39	4.19	106.11	
7 - 1.2Dead + 1.6Snow + 0.8WLNS	5.23	322.12	2.57	154.68	0.53	32.43	
8 - 1.2Dead + 0.5Snow + 1.6WLEW1	4.15	31.40	1.36	10.28	9.67	73.10	
9 - 1.2Dead + 0.5Snow + 1.6WLEW2	4.15	34.13	1.38	11.37	9.04	74.38	
10 - 1.2Dead + 0.5Snow + 1.6WLEW3	4.56	37.58	1.50	12.32	9.24	76.06	
11 - 1.2Dead + 0.5Snow + 1.6WLEW4	4.61	44.44	1.55	14.93	8.22	79.28	
12 - 1.2Dead + 0.5Snow + 1.6WLNS	3.03	171.26	2.10	117.26	0.90	50.17	
13 - 1.2Dead + 0.2Snow + EQX	2.83	90.12	0.87	27.70	3.18	100.48	
14 - 1.2Dead + 0.2Snow + EQY	3.00	101.64	2.99	100.93	0.29	9.65	
15 - 0.9Dead + 1.6WLEW1	2.62	18.16	0.75	5.21	9.64	66.83	
16 - 0.9Dead + 1.6WLEW2	2.62	19.58	0.77	5.80	9.02	67.50	
17 - 0.9Dead + 1.6WLEW3	3.03	22.71	0.89	6.66	9.21	69.02	
18 - 0.9Dead + 1.6WLEW4	3.07	26.58	0.94	8.13	8.19	70.85	
19 - 0.9Dead + 1.6WLNS	1.50	95.60	1.49	94.64	0.87	55.43	
20 - 0.9Dead + EQX	1.85	46.98	0.52	13.30	3.18	80.81	
21 - 0.9Dead + EQY	2.02	72.76	2.65	94.55	0.19	6.92	



Project: BGCAPP
 Job Number: 24915
 Calc. No.: 10-DBC-00-00004
 Sheet No.: D2-47 of D2-51
 Sheet Rev.: D

Subject: Gas Bottle Canopy, Supports, Equip Misc Foundations
 By: M. Bratt Date: 1/25/2010

Dimensional Solutions Mat3D	Version	5.1.0	Date	1/25/2010	
Foundation Name	Gas bottle canopies, Supports, Equip. & Misc Fdns			Time	10:21:49 AM
Designed By:	PARSONS	Engineer	M. Bratt	Checker	
Filename:	C:\Documents and Settings\p0045388\My Documents\SCWO\...App D.2 Gas Bottle Canopy 2\FOUNDATION.m3d				

P2


Load Comb	Axial Load (kips)	Axial Capa. (kips)	Mom X (kip ft)	Mom X Capa (kip ft)	Mom Z (kip ft)	Mom Z Capa (kip ft)	Rem
1 - 1.4Dead	2.94	464.26	0.81	127.33	0.28	44.01	
2 - 1.2Dead + 0.5Snow	3.52	420.46	1.15	135.23	0.33	39.86	
3 - 1.2Dead + 1.6Snow + 0.8WLEW1	6.12	111.04	2.25	40.85	5.19	93.98	
4 - 1.2Dead + 1.6Snow + 0.8WLEW2	6.12	124.23	2.26	45.72	4.88	97.60	
5 - 1.2Dead + 1.6Snow + 0.8WLEW3	6.32	126.20	2.32	46.05	4.98	98.27	
6 - 1.2Dead + 1.6Snow + 0.8WLEW4	6.35	142.79	2.35	52.59	4.47	99.70	
7 - 1.2Dead + 1.6Snow + 0.8WLNS	5.46	445.01	1.43	115.70	0.82	66.48	
8 - 1.2Dead + 0.5Snow + 1.6WLEW1	4.30	31.30	1.38	10.06	9.80	71.26	
9 - 1.2Dead + 0.5Snow + 1.6WLEW2	4.30	33.99	1.41	11.11	9.18	72.53	
10 - 1.2Dead + 0.5Snow + 1.6WLEW3	4.72	37.31	1.52	12.03	9.37	74.14	
11 - 1.2Dead + 0.5Snow + 1.6WLEW4	4.76	44.04	1.57	14.55	8.35	77.31	
12 - 1.2Dead + 0.5Snow + 1.6WLNS	2.99	395.88	0.28	37.46	1.06	138.86	
13 - 1.2Dead + 0.2Snow + EQX	2.93	82.82	0.87	24.49	3.42	95.57	
14 - 1.2Dead + 0.2Snow + EQY	3.10	357.39	1.26	142.61	0.29	33.79	
15 - 0.9Dead + 1.6WLEW1	2.67	17.89	0.76	5.09	9.69	64.89	
16 - 0.9Dead + 1.6WLEW2	2.67	19.29	0.78	5.66	9.07	65.55	
17 - 0.9Dead + 1.6WLEW3	3.08	22.31	0.90	6.50	9.26	67.02	
18 - 0.9Dead + 1.6WLEW4	3.13	26.09	0.95	7.92	8.24	68.81	
19 - 0.9Dead + 1.6WLNS	1.35	105.93	0.88	67.61	0.95	73.18	
20 - 0.9Dead + EQX	1.90	43.62	0.51	11.75	3.37	77.45	
21 - 0.9Dead + EQY	2.07	151.52	1.61	117.66	0.20	14.40	



Project: BGCAPP
Job Number: 24915
Calc. No.: 10-DBC-00-00004
Sheet No.: D2-48 of D2-51
Sheet Rev.: D

Subject: Gas Bottle Canopy, Supports, Equip Misc Foundations
By: M. Bratt Date: 1/25/2010

Dimensional Solutions Mat3D	Version	5.1.0	Date	1/25/2010
Foundation Name	Gas bottle canopies, Supports, Equip. & Misc Fdns		Time	10:21:49 AM
Designed By:	PARSONS	Engineer	M. Bratt	Checker
Filename:	C:\Documents and Settings\p0045388\My Documents\SCWO\...App D.2 Gas Bottle Canopy 2\FOUNDATION.m3d			

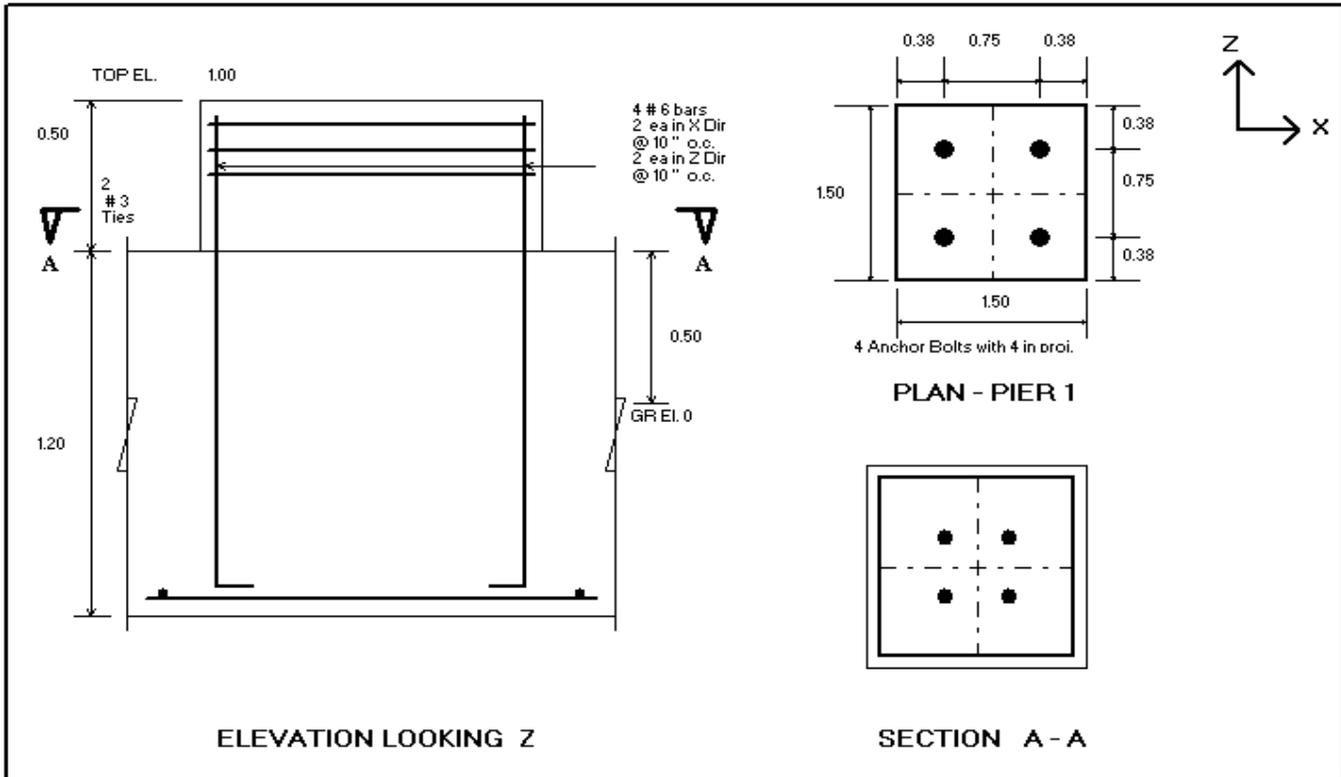




Project: BGCAPP
Job Number: 24915
Calc. No.: 10-DBC-00-00004
Sheet No.: D2-49 of D2-51
Sheet Rev.: D

Subject: Gas Bottle Canopy, Supports, Equip Misc Foundations
By: M. Bratt Date: 1/25/2010

Dimensional Solutions Mat3D	Version	5.1.0	Date	1/25/2010
Foundation Name	Gas bottle canopies, Supports, Equip. & Misc Fdns		Time	10:21:49 AM
Designed By:	PARSONS	Engineer	M. Bratt	Checker
Filename:	C:\Documents and Settings\p0045388\My Documents\SCWO\...App D.2 Gas Bottle Canopy 2\FOUNDATION.m3d			

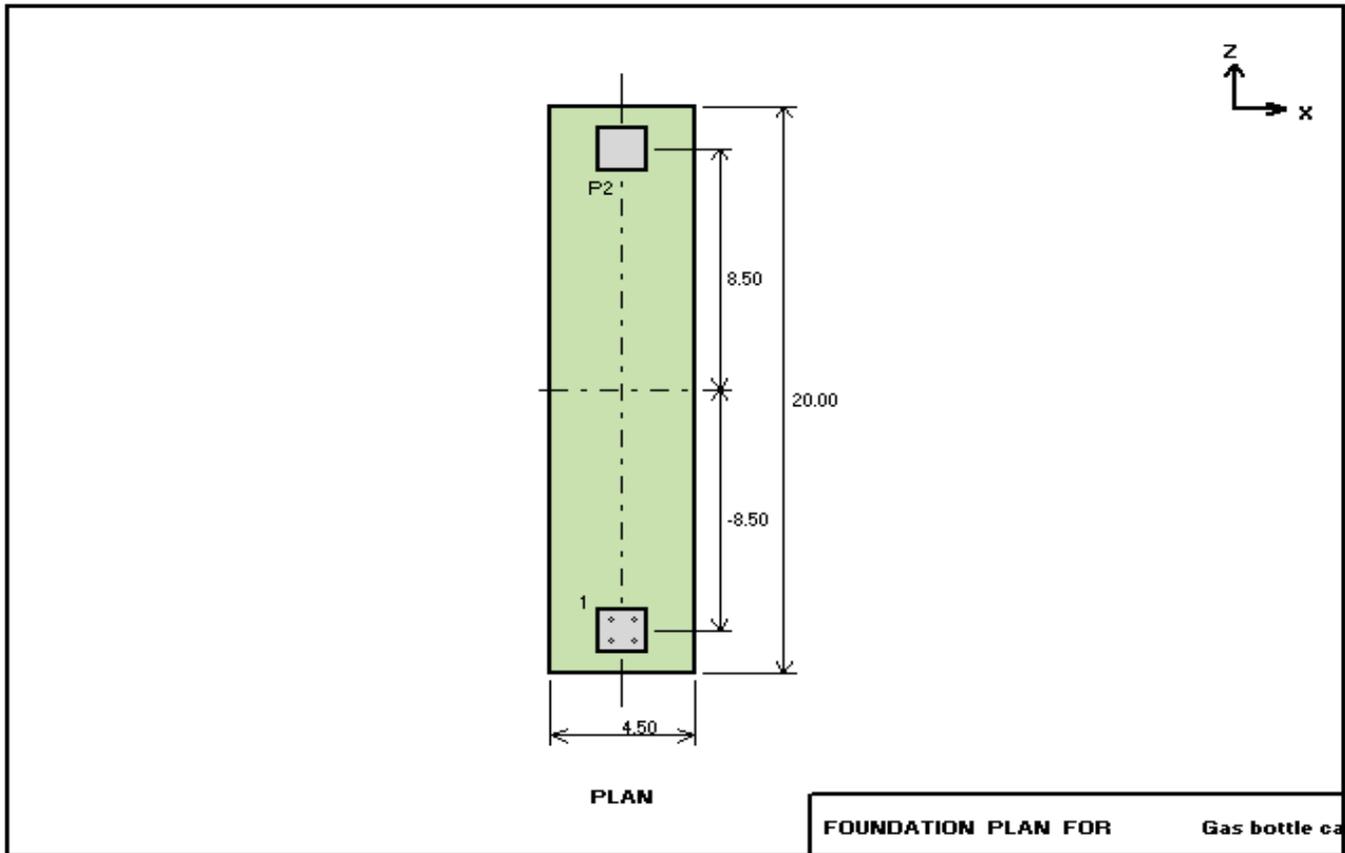




Project: BGCAPP
Job Number: 24915
Calc. No.: 10-DBC-00-00004
Sheet No.: D2-50 of D2-51
Sheet Rev.: D

Subject: Gas Bottle Canopy, Supports, Equip Misc Foundations
By: M. Bratt Date: 1/25/2010

Dimensional Solutions Mat3D	Version	5.1.0	Date	1/25/2010
Foundation Name	Gas bottle canopies, Supports, Equip. & Misc Fdns		Time	10:21:49 AM
Designed By:	PARSONS	Engineer	M. Bratt	Checker
Filename:	C:\Documents and Settings\p0045388\My Documents\SCWO\...App D.2 Gas Bottle Canopy 2\FOUNDATION.m3d			

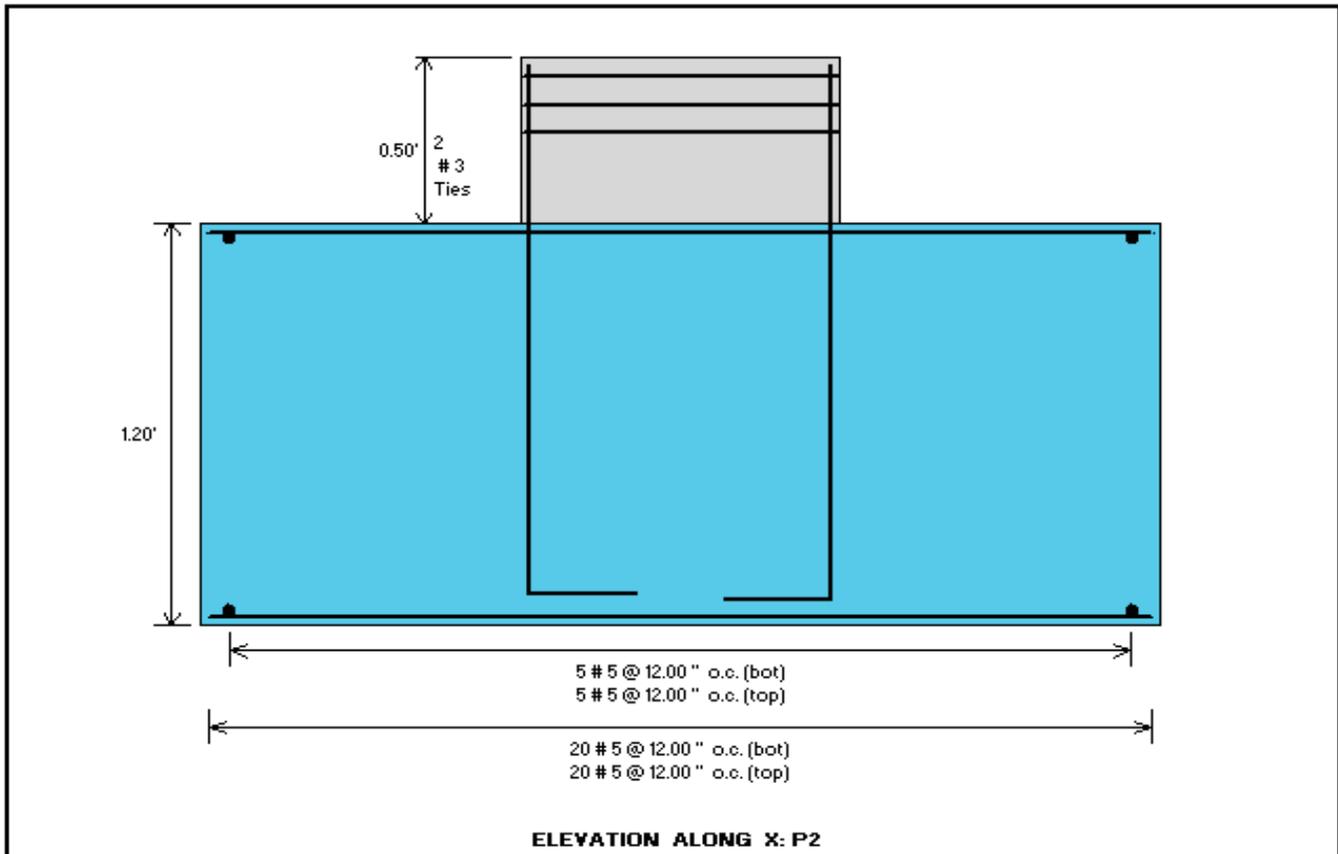



A Joint Venture of Bechtel Parsons, Inc. and
Parsons Infrastructure & Technology Group, Inc.

Calculation Sheet

Project:	BGCAPP
Job Number:	743341
Calc. No.	24915-10-DBC-00-00004
Sheet No.	D2-51 / D2-51
Sheet Rev.	D

Subject: Gas Bottles Canopy, Supports, Equip, & Misc Foundations
By: R. Murphy Date: 12/16/2007

D2.5. Summary

The calculation performed in this appendix includes structural analysis and design of a combined footing gas bottle canopy #2. No soil uplift is observed under worst-case overturning loads, and wind and seismic sliding resistance of the foundations is adequate.

The footing is 2'-0" thick with top of slab 6" above finished grade. Reinforcement is as follows:

#5 @ 12 o.c. E-W top.

(6) #5 eq. spc. N-S top.

#6 @ 12" o.c. E-W bottom.

(6) #6 eq. spc. N-S bottom.

(4) additional horizontal #6 bars E-W at bottom under each pier.

Piers 1 & 2 are 1'-6" square and are 6" tall. Top of pier is 1'-0" above finished grade.

Reinforcement is (4) #6 longitudinal bars with (4) #3 ties.



A Joint Venture of Bechtel National, Inc. and
Parsons Infrastructure & Technology Group, Inc.

Calculation Sheet

Project:	<u>BGCAPP</u>
Job Number:	<u>743341</u>
Calc. No.	<u>24915-10-DBC-00-00004</u>
Sheet No.	<u>E-1 / E-80</u>
Sheet Rev.	<u>D</u>

Subject: Gas Bottles Canopy, Supports, Equip, & Misc Foundations

By: M.Bratt

Date: 10/06/2009

Appendix E

Miscellaneous Interior Equipment Foundations

Project:	<u>BGCAPP</u>
Job Number:	<u>743341</u>
Calc. No.	<u>24915-10-DBC-00-00004</u>
Sheet No.	<u>E-2 / E-80</u>
Sheet Rev.	<u>D</u>

Subject: Gas Bottles Canopy, Supports, Equip, & Misc Foundations

By: M.Bratt

Date: 10/06/2009

E.1. Objective

The calculation performed in this appendix includes structural analysis and design of foundations for the Effluent Caustic Day Tank (MV-RO-0101), R.O. Skid (MK-RO-0101), R.O. Multimedia Filters (MK-RO-0101A through MK-RO-0101F), and Hydrolysate Heater Module (MX-SCWO-0042). All equipment is contained within the SCWO Processing Building (SPB).

E.2. Inputs

The Effluent Caustic Day Tank is located between column lines H.5, G, 4, and 5.

The R.O. Multimedia Filters and R.O. Skid are located between column lines J, G, 1, and 3.

The Hydrolysate Heater Module is located between column lines 6, 7, A and B.

See Drawing no. 24915-10-AE-00-00001 for equipment arrangement.

- (1) The Effluent Caustic Day Tank is circular and welded steel measuring 12'-9" tall (overall) and 4'-0" in diameter. It is supported on steel unbraced legs. The estimated operating weight of the tank is 10350 lb. See sheets A-1 through A-8 for dimensions and technical data.
- (2) The R.O Skid is 6'-10.5" tall, with a footprint of 16'-8" x 6'-6". The operating weight of the equipment is 12,100 lb. See sheets A-9 through A-10 for dimensions and technical data.
- (3) The R.O. Multimedia Filters are circular welded steel each measuring 10'-2.25" tall and 54" outside diameter. There are a total of six filters supported on steel unbraced legs. The estimated operating weight of each filter is 22080 lb. See sheets A-10 through A-12 for dimensions and technical data.
- (4) The Hydrolysate Heater Module is 9'-0" tall (not including platform) and has a footprint of 9'-2" x 13'-6". The operating weight of the equipment is 12,500 lb. See drawing 24915-10-B2-SCWO-00012 for weight and dimensions.

E.3 Assumptions

Dry and operating weights of the Effluent Caustic Day Tank are estimated based on the physical characteristics of the tank itself and its fluid capacity.

All equipment is inside the SPB, so wind and snow loads are ignored.



A Joint Venture of Bechtel National, Inc. and
Parsons Infrastructure & Technology Group, Inc.

Calculation Sheet

Project:	<u>BGCAPP</u>
Job Number:	<u>743341</u>
Calc. No.	<u>24915-10-DBC-00-00004</u>
Sheet No.	<u>E-3 / E-80</u>
Sheet Rev.	<u>D</u>

Subject: Gas Bottles Canopy, Supports, Equip, & Misc Foundations
By: M.Bratt Date: 10/06/2009

Assumed tank contents weight and sloshing calculations are based on the properties of water.

E.4 Calculation Body

Base shear and overturning moment of each piece of equipment are computed in the following MathCAD templates. These loads are then entered into Mat3D and the foundations are checked for sliding and soil uplift.


Subject: Gas Bottle Canopy, supports, equip, & misc fdn
 By: M. Bratt
 Date: 1/12/2010

Tank Seismic Load Calculation - Effluent Caustic Day Tank

Tank Information

The tank is circular, elevated, supported on unbraced legs, and welded steel.

- Operational weight: $W_t := 10350\text{-lbf}$
- Tank empty weight: $W_W := 2200\text{-lbf} \cdot 1.15$ $W_W = 2530\text{ lbf}$
 (Includes 15% increase for misc attachments)
- Diameter: $D_t := 48\text{-in}$
- Tank wall thickness: $t := \frac{3}{8}\text{-in}$
- Tank height: $H_t := 7\text{-ft}$
- Height of liquid: $H_L := H_t - 0.5\text{-ft}$ $H_L = 6.5\text{ ft}$
- Leg height: $H := 4\text{-ft}$
- Leg angle size: $L4 \times 4 \times 3/8$ (Assume) $A := 2.86\text{in}^2$
- Number of legs: $N := 4$ $r_z := 0.779\text{in}$

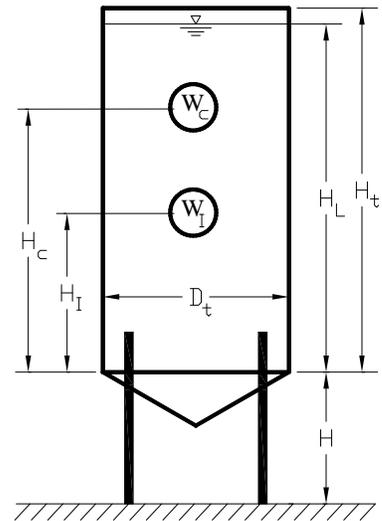

- Moment of inertia of a leg about x-axis: $I_x := 4.32\text{-in}^4$
- Moment of inertia of a leg about z-axis: $I_z := r_z^2 \cdot A$ $(= r_z^2 \times A)$ i.e. $I_z = 1.736\text{-in}^4$
- Moment of inertia of a leg about w-axis: $I_w := 2 \cdot I_x - I_z$ i.e. $I_w = 6.904\text{-in}^4$

Bolt circle diameter: $D_{\text{bolt}} := 4\text{ft}$

Base plate area: $A_{\text{bp}} := (6\text{-in})^2$

Liquid Content Density Estimation and Platform Weight

- Weight of liquid: $W_L := W_t - W_W$ i.e. $W_L = 7.82\text{-kip}$
- Tank content density: $V_{\text{liquid}} := \frac{W_L}{\frac{\pi}{4} \cdot D_t^2 \cdot H_L}$ i.e. $V_{\text{liquid}} = 95.738\text{-pcf}$

Subject: Gas Bottle Canopy, supports, equip, & misc fdn
 By: M. Bratt
 Date: 1/12/2010

Tank Seismic Load Calculation - Effluent Caustic Day Tank

Check if the Tank is a Rigid Structure

Density of steel: $\rho_s := 490 \cdot \text{pcf}$ Steel elastic modulus: $E_s := 29000 \cdot \text{ksi}$

Lateral deflection under N-S EQ load: $y_x := \frac{2 \cdot W_t \cdot H^3}{3 \cdot N \cdot E_s \cdot I_x}$ i.e. $y_x = 1.523 \cdot \text{in}$

Lateral deflection under NW EQ load: $y_2 := \frac{2 \cdot W_t \cdot H^3}{3 \cdot \frac{N}{2} \cdot E_s \cdot (I_z + I_w)}$ i.e. $y_2 = 1.523 \cdot \text{in}$

The fundamental period of the tank with its content is computed by using Ref. 4.11 Fig. 3-9 formula:

N-S EQ: $T_x := 2 \cdot \pi \cdot \sqrt{\frac{y_x}{g}}$ $T_x = 0.395 \text{ s} > 0.06$, the tank is not rigid and Sec. 1622.2.6 of IBC2000 is not used.

NW EQ: $T_2 := 2 \cdot \pi \cdot \sqrt{\frac{y_2}{g}}$ $T_2 = 0.395 \text{ s} > 0.06$, the tank is not rigid and Sec. 1622.2.6 of IBC2000 is not used.

Water Weights and Their C.G. Heights (Circular Tank)

Height of liquid: $H_L = 6.5 \text{ ft}$
 Tank diameter: $D_t = 4 \text{ ft}$ $D/HL := \frac{D_t}{H_L}$ $D/HL = 0.615$

Impulsive weight of liquid: $W_I := \frac{\tanh(0.866 \cdot D/HL)}{0.866 \cdot D/HL} \cdot W_L$ (ACI350.3-01 Eq. 9-15) $W_I = 7155.12 \text{ lbf}$

C.G. height of W_I : $H_I := H_L \cdot \begin{cases} 0.5 - 0.09375 \cdot D/HL & \text{if } D/HL < 1.333 \\ 0.375 & \text{otherwise} \end{cases}$ (ACI350.3-01 Eq. 9-17)
 (ACI350.3-01 Eq. 9-18)
 i.e. $H_I = 2.875 \text{ ft}$

Convective weight of liquid: $W_C := 0.230 \cdot D/HL \cdot \tanh\left(\frac{3.68}{D/HL}\right) \cdot W_L$ (ACI350.3-01 Eq. 9-16)
 i.e. $W_C = 1106.817 \text{ lbf}$

C.G. Height of W_C : $H_C := \left(1 - \frac{\cosh\left(\frac{3.68}{D/HL}\right) - 1}{\frac{3.68}{D/HL} \cdot \sinh\left(\frac{3.68}{D/HL}\right)} \right) \cdot H_L$ (ACI350.3-01 Eq. 9-19)
 i.e. $H_C = 5.419 \text{ ft}$

Subject: Gas Bottle Canopy, supports, equip, & misc fdn
 By: M. Bratt
 Date: 1/12/2010

Tank Seismic Load Calculation - Effluent Caustic Day Tank

Sloshing Periods

Coefficient λ (Fig. 9.9 of ACI350.3-01):

$$\lambda := \sqrt{3.68 \cdot 32.2 \cdot \tanh\left(\frac{3.68}{D/HL}\right)} \quad \text{i.e.} \quad \lambda = 10.886$$

$$\frac{2\pi}{\lambda} = 0.577$$

Period for convective component:

$$T_c := \frac{2\pi}{\lambda} \cdot \sqrt{\frac{D_t}{ft}} \quad (\text{ACI350.3-01 Eq. 9-30}) \quad \text{i.e.} \quad T_c = 1.154$$

Check Code Sloshing Requirement (IBC2000 Sec. 1622.4.3.1)

N-S EQ:
$$\frac{T_c \cdot \text{sec}}{T_x} = 292.556\%$$

$$\text{if} \left(70\% \leq \frac{T_c \cdot \text{sec}}{T_x} \leq 150\%, \text{"INCLUDE Sloshing"}, \text{"Ignore sloshing"} \right) = \text{"Ignore sloshing"}$$

NW EQ:
$$\frac{T_c \cdot \text{sec}}{T_2} = 292.556\%$$

$$\text{if} \left(70\% \leq \frac{T_c \cdot \text{sec}}{T_2} \leq 150\%, \text{"INCLUDE Sloshing"}, \text{"Ignore sloshing"} \right) = \text{"Ignore sloshing"}$$

Seismic Base Shear and Overturning Moment

Design spectral response acceleration parameters (Sec. 1615.1.3 of IBC2000)

At short period: $S_{DS} := 0.273$ (per BGCAPP Design Criteria and IBC2000)

At long period: $S_{D1} := 0.167$

Seismic Importance Factor: $I_E := 1.5$ (APS, Level = 2, Ref. 4.13)

The tank is elevated, supported by unbraced legs, and welded steel. Table 1622.2.5(1) of IBC2000 specifies the seismic coefficients as follows.

$$R := 3 \quad \Omega_o := 2 \quad C_d := 2.5$$

Component amplification factor (Table 1621.3 of IBC2000): $a_p := 2.50$

Height in structure at point of attachment of component: $z := 0$



Calculation Sheet

Project: BGCAPP
 Job Number: 743341
 Calc. No.: 24915-10-DBC-00-00004
 Sheet No.: E-7 / E-80
 Sheet Rev.: D

Subject: Gas Bottle Canopy, supports, equip, & misc fdn
 By: M. Bratt
 Date: 1/12/2010

Tank Seismic Load Calculation - Effluent Caustic Day Tank

Impulsive seismic force: $F_{P1} := \frac{0.4 \cdot a_p \cdot S_{DS}}{\frac{R}{I_E}} \cdot \left(1 + 2 \cdot \frac{z}{H} \right)$ i.e. $F_{P1} = 0.137$

$F_{Pmax} := 1.6 \cdot S_{DS} \cdot I_E$ i.e. $F_{Pmax} = 0.655$

$F_{Pmin} := 0.3 \cdot S_{DS} \cdot I_E$ i.e. $F_{Pmin} = 0.123$

$F_P := \max(\min(F_{P1}, F_{Pmax}), F_{Pmin})$ i.e. $F_P = 0.137$

Combined seismic coeff.: $C_s := F_P$ i.e. $C_s = 0.137$

Lateral base shear force: $V := C_s \cdot (W_W + W_L)$ (IBC2000 Eq. 16-34) i.e. $V = 1412.775 \text{ lbf}$

Vertical component of EQ: $0.2 \cdot S_{DS} = 0.055$

$$OTM := C_s \cdot \left[W_W \cdot \frac{H_t + H}{2} + W_L \cdot \left(\frac{H_t}{2} + H \right) \right]$$

i.e. $OTM = 9.905 \cdot \text{ft} \cdot \text{kip}$

Subject: Gas Bottle Canopy, supports, equip, & misc fdn
 By: M. Bratt
 Date: 1/12/2010

Mat Foundation Design Load Calculation - Effluent Caustic Day Tank

Gravity Loads Applied on Concrete Pad

Tank self-weight: $W_W = 2.53 \cdot \text{kip}$

Tank content weight: $W_L = 7.82 \cdot \text{kip}$

Pad thickness: $t_{\text{pad}} := 5 \cdot \text{in}$

Vertical load applied on concrete pad due to self-weight: $P_{\text{DLpad}} := \frac{W_W}{4} + \frac{t_{\text{pad}} \cdot 5.5 \text{ft} \cdot 5.5 \text{ft} \cdot 150 \cdot \text{pcf}}{4}$ i.e. $P_{\text{DLpad}} = 1105.156 \cdot \text{lbf}$

Vertical load applied on concrete pad due to tank liquid content with LL deducted:

$P_{\text{LLpad}} := \frac{W_L}{4}$ i.e. $P_{\text{LLpad}} = 1955 \cdot \text{lbf}$

Overtopping Moments Applied on Concrete Pad

Lateral base shear force: $V = 1.413 \cdot \text{kip}$

Overtopping moment at the mat top surface: $\text{OTM} = 9.905 \cdot \text{ft} \cdot \text{kip}$

Mat foundation thickness: $t_{\text{mat}} := 2 \cdot \text{ft} + 0 \cdot \text{in}$

Overtopping moment at the mat bottom: $\text{OTM2} := \text{OTM} + V \cdot (t_{\text{mat}} + t_{\text{pad}})$ i.e. $\text{OTM2} = 13 \cdot \text{ft} \cdot \text{kip}$

For N-S direction EQ load, assume that the seismic overturning moment of a tank is applied on two base plates using an upward uniform pressure value and on the remaining two using a downward value

Overtopping moment arm: $a_x := \frac{D_{\text{bolt}}}{\sqrt{2}}$ i.e. $a_x = 2.828 \cdot \text{ft}$

Pad force from OTM2: $P_{\text{xEQpad}} := \frac{\text{OTM2}}{a_x \cdot 2}$ i.e. $P_{\text{xEQpad}} = 2354.547 \cdot \text{lbf}$

Lateral Shear: $V_{\text{pl}} := \frac{V}{4}$ $V_{\text{pl}} = 0.353 \cdot \text{kip}$

For NW direction EQ load (diagonal), assume that the seismic overturning moment of a tank is applied on one base plate using an upward uniform pressure value and on the opposite one using a downward value

Overtopping moment arm: $a_2 := D_{\text{bolt}}$ i.e. $a_2 = 4 \cdot \text{ft}$

Pad force from OTM2: $P_{2\text{EQpad}} := \frac{\text{OTM2}}{a_2}$ i.e. $P_{2\text{EQpad}} = 3329.832 \cdot \text{lbf}$

Lateral Shear in x & y dir: $V_{\text{pl}} := \frac{V}{4} \cdot \cos(45)$ $V_{\text{pl}} = 0.186 \cdot \text{kip}$



Project: BGCAPP
 Job Number: 743341
 Calc. No.: 24915-10-DBC-00-00004
 Sheet No.: E-9 of E-80
 Sheet Rev.: D

Subject: Gas Bottle Canopy Misc Support Calculations
 By: M. Bratt Date: 10/5/2009

Dimensional Solutions Mat3D	Version	5.1.0	Date	10/7/2009
Foundation Name	Effluent Caustic Day Tank		Time	7:37:08 AM
Designed By:	PARSONS	Engineer	R. Murphy	Checker B. Rabe
Filename:	C:\Documents and Settings\p0045388\My Documents\SCWO\10-DBC-00-00004 Gas Bottle & Misc Concrete\...01 Effluent Caustic Day Tank\CAUSTIC DAY TANK.m3d			

DETAIL REPORT

PROJECT INFORMATION

Project Name:
Project Number: 24915-10-DBC-00-00004
Client:
Project Location
Foundation Description EFFLUENT CAUSTIC DAY TANK

DESIGN CODE ACI 318 - 1999 **INPUT UNITS** English **OUTPUT UNITS** English

CONCRETE PARAMETERS:

Compressive Strength (psi) 4000.00
 Unit Weight (pcf) 150.00

REINFORCING STEEL PARAMETERS:

Yield Strength (ksi) 60.00
 Unit Weight (pcf) 490.00
 Modulus of Elasticity (ksi) 29000.00

SOIL PARAMETERS:

Allowable Net Bearing Capacity (psf) 3000.00
 Unit Weight (pcf) 120.00

MINIMUM FOUNDATION CRITERIA:

Depth of Footing Below Grade (ft) 2.00
 Minimum Soil Cover (ft) 0.00

PILE PARAMETERS:

Diameter (in) 0
 Type Drilled Shaft

REBAR PARAMETERS:

Max Long Bar Size 9
 Min Long Bar Size 4
 Max Tie Bar Size 8
 Min Tie Bar Size 3
 Max Ftg Bar Size 9
 Min Ftg Bar Size 4
 Temp & Shrinkage Steel Ratio 0.0018



Project: BGCAPP
Job Number: 743341
Calc. No.: 24915-10-DBC-00-00004
Sheet No.: E-10 of E-80
Sheet Rev.: D

Subject: Gas Bottle Canopy Misc Support Calculations
By: M. Bratt Date: 10/5/2009

APPLIED LOADS

P1

Load Case	Axial (kips)	Shear X (kips)	Mom Z (kip ft)	Shear Z (kips)	Mom X (kip ft)
1 - Dead	1.11	0.00	0.00	0.00	0.00
2 - Live	1.96	0.00	0.00	0.00	0.00
3 - EQNS	-2.40	0.00	0.00	0.35	0.00
4 - EQEW	-2.40	0.35	0.00	0.00	0.00
5 - EQNE	-3.40	0.19	0.00	0.19	0.00

P2

Load Case	Axial (kips)	Shear X (kips)	Mom Z (kip ft)	Shear Z (kips)	Mom X (kip ft)
1 - Dead	1.11	0.00	0.00	0.00	0.00
2 - Live	1.96	0.00	0.00	0.00	0.00
3 - EQNS	2.40	0.00	0.00	0.35	0.00
4 - EQEW	-2.40	0.35	0.00	0.00	0.00
5 - EQNE	0.00	0.19	0.00	0.19	0.00

P3

Load Case	Axial (kips)	Shear X (kips)	Mom Z (kip ft)	Shear Z (kips)	Mom X (kip ft)
1 - Dead	1.11	0.00	0.00	0.00	0.00
2 - Live	1.96	0.00	0.00	0.00	0.00
3 - EQNS	-2.40	0.00	0.00	0.35	0.00
4 - EQEW	2.40	0.35	0.00	0.00	0.00
5 - EQNE	0.00	0.19	0.00	0.19	0.00



Project: BGCAPP
 Job Number: 743341
 Calc. No.: 24915-10-DBC-00-00004
 Sheet No.: E-11 of E-80
 Sheet Rev.: D

Subject: Gas Bottle Canopy Misc Support Calculations
 By: M. Bratt Date: 10/5/2009

P4

Load Case	Axial (kips)	Shear X (kips)	Mom Z (kip ft)	Shear Z (kips)	Mom X (kip ft)
1 - Dead	1.11	0.00	0.00	0.00	0.00
2 - Live	1.96	0.00	0.00	0.00	0.00
3 - EQNS	2.40	0.00	0.00	0.35	0.00
4 - EQEW	2.40	0.35	0.00	0.00	0.00
5 - EQNE	3.40	0.19	0.00	0.19	0.00

UNFACTORED (ALLOWABLE) LOAD COMBINATIONS

P1

Load Comb	Axial (kips)	Shear X (kips)	Mom Z (kip ft)	Shear Z (kips)	Mom X (kip ft)
1 - Dead	1.11	0.00	0.00	0.00	0.00
2 - Dead + Live	3.07	0.00	0.00	0.00	0.00
3 - Dead + 0.7EQNS	-0.57	0.00	0.00	0.25	0.00
4 - Dead + 0.7EQEW	-0.57	0.25	0.00	0.00	0.00
5 - Dead + 0.7EQNE	-1.27	0.13	0.00	0.13	0.00

P2

Load Comb	Axial (kips)	Shear X (kips)	Mom Z (kip ft)	Shear Z (kips)	Mom X (kip ft)
1 - Dead	1.11	0.00	0.00	0.00	0.00
2 - Dead + Live	3.07	0.00	0.00	0.00	0.00
3 - Dead + 0.7EQNS	2.79	0.00	0.00	0.25	0.00
4 - Dead + 0.7EQEW	-0.57	0.25	0.00	0.00	0.00
5 - Dead + 0.7EQNE	1.11	0.13	0.00	0.13	0.00



Project: BGCAPP
 Job Number: 743341
 Calc. No.: 24915-10-DBC-00-00004
 Sheet No.: E-12 of E-80
 Sheet Rev.: D

Subject: Gas Bottle Canopy Misc Support Calculations
 By: M. Bratt Date: 10/5/2009

P3

Load Comb	Axial (kips)	Shear X (kips)	Mom Z (kip ft)	Shear Z (kips)	Mom X (kip ft)
1 - Dead	1.11	0.00	0.00	0.00	0.00
2 - Dead + Live	3.07	0.00	0.00	0.00	0.00
3 - Dead + 0.7EQNS	-0.57	0.00	0.00	0.25	0.00
4 - Dead + 0.7EQEW	2.79	0.25	0.00	0.00	0.00
5 - Dead + 0.7EQNE	1.11	0.13	0.00	0.13	0.00

P4

Load Comb	Axial (kips)	Shear X (kips)	Mom Z (kip ft)	Shear Z (kips)	Mom X (kip ft)
1 - Dead	1.11	0.00	0.00	0.00	0.00
2 - Dead + Live	3.07	0.00	0.00	0.00	0.00
3 - Dead + 0.7EQNS	2.79	0.00	0.00	0.25	0.00
4 - Dead + 0.7EQEW	2.79	0.25	0.00	0.00	0.00
5 - Dead + 0.7EQNE	3.49	0.13	0.00	0.13	0.00

FACTORED (ULTIMATE) LOAD COMBINATIONS

P1

Load Comb	Axial (kips)	Shear X (kips)	Mom Z (kip ft)	Shear Z (kips)	Mom X (kip ft)
1 - 1.4Dead	1.55	0.00	0.00	0.00	0.00
2 - 1.2Dead + 1.6Live	4.47	0.00	0.00	0.00	0.00
3 - 1.2Dead + Live	3.29	0.00	0.00	0.00	0.00
4 - 1.2Dead + EQNS	-1.07	0.00	0.00	0.35	0.00
5 - 1.2Dead + EQEW	-1.07	0.35	0.00	0.00	0.00
6 - 1.2Dead + EQNE	-2.07	0.19	0.00	0.19	0.00



Project: BGCAPP
Job Number: 743341
Calc. No.: 24915-10-DBC-00-00004
Sheet No.: E-13 of E-80
Sheet Rev.: D

Subject: Gas Bottle Canopy Misc Support Calculations
By: M. Bratt Date: 10/5/2009

P2

Load Comb	Axial (kips)	Shear X (kips)	Mom Z (kip ft)	Shear Z (kips)	Mom X (kip ft)
1 - 1.4Dead	1.55	0.00	0.00	0.00	0.00
2 - 1.2Dead + 1.6Live	4.47	0.00	0.00	0.00	0.00
3 - 1.2Dead + Live	3.29	0.00	0.00	0.00	0.00
4 - 1.2Dead + EQNS	3.73	0.00	0.00	0.35	0.00
5 - 1.2Dead + EQEW	-1.07	0.35	0.00	0.00	0.00
6 - 1.2Dead + EQNE	1.33	0.19	0.00	0.19	0.00

P3

Load Comb	Axial (kips)	Shear X (kips)	Mom Z (kip ft)	Shear Z (kips)	Mom X (kip ft)
1 - 1.4Dead	1.55	0.00	0.00	0.00	0.00
2 - 1.2Dead + 1.6Live	4.47	0.00	0.00	0.00	0.00
3 - 1.2Dead + Live	3.29	0.00	0.00	0.00	0.00
4 - 1.2Dead + EQNS	-1.07	0.00	0.00	0.35	0.00
5 - 1.2Dead + EQEW	3.73	0.35	0.00	0.00	0.00
6 - 1.2Dead + EQNE	1.33	0.19	0.00	0.19	0.00

P4

Load Comb	Axial (kips)	Shear X (kips)	Mom Z (kip ft)	Shear Z (kips)	Mom X (kip ft)
1 - 1.4Dead	1.55	0.00	0.00	0.00	0.00
2 - 1.2Dead + 1.6Live	4.47	0.00	0.00	0.00	0.00
3 - 1.2Dead + Live	3.29	0.00	0.00	0.00	0.00
4 - 1.2Dead + EQNS	3.73	0.00	0.00	0.35	0.00
5 - 1.2Dead + EQEW	3.73	0.35	0.00	0.00	0.00
6 - 1.2Dead + EQNE	4.73	0.19	0.00	0.19	0.00



Project: BGCAPP
 Job Number: 743341
 Calc. No.: 24915-10-DBC-00-00004
 Sheet No.: E-14 of E-80
 Sheet Rev.: D

Subject: Gas Bottle Canopy Misc Support Calculations
 By: M. Bratt Date: 10/5/2009

BEARING CAPACITY - LINEAR SOIL PRESSURE METHOD

Load Comb	Max Pressure (ksf)	All Pressure (ksf)	Ecc N/S Dir (ft)	Ecc E/W Dir (ft)	Moment N/S axis (kip-ft)	Moment E/W axis (kip-ft)	Rem
1 - Dead	0.38	3.24	0.00	0.00	0.00	0.00	
2 - Dead + Live	0.52	3.24	0.00	0.00	0.00	0.00	
3 - Dead + 0.7EQNS	0.63	4.24	0.82	0.00	0.00	17.48	
4 - Dead + 0.7EQEW	0.63	4.24	0.00	0.82	17.48	0.00	
5 - Dead + 0.7EQNE	0.72	4.24	0.56	0.56	11.99	11.99	

STABILITY RATIO / SLIDING SAFETY FACTOR

Load Comb	S.R. N/S Dir	S.R. E/W Dir	All S.R.	Sliding FS - N/S	Sliding FS - E/W	All FS	Remarks
1 - Dead	100.00	100.00	1.50	100.00	100.00	1.50	
2 - Dead + Live	100.00	100.00	1.50	100.00	100.00	1.50	
3 - Dead + 0.7EQNS	7.82	100.00	1.50	20.09	100.00	1.50	
4 - Dead + 0.7EQEW	100.00	7.82	1.50	100.00	20.09	1.50	
5 - Dead + 0.7EQNE	8.66	8.66	1.50	37.01	37.01	1.50	

FOOTING DESIGN INFORMATION

X Dim (ft)	7.50
Z Dim (ft)	7.50
Thickness (ft)	2.00

Top Steel

Governing Combination	No of Bars	Bar Size	Bar Spac (in)	Area Prov (sq in/ft)	Area Req (sq in/ft)	Moment (kip ft/ft)	Direction
2. 1.2Dead + 1.6Live	8	5	12	0.33	0.01	-0.45	E-W
2. 1.2Dead + 1.6Live	8	5	12	0.33	0.01	-0.45	N-S



Project: BGCAPP
 Job Number: 743341
 Calc. No.: 24915-10-DBC-00-00004
 Sheet No.: E-15 of E-80
 Sheet Rev.: D

Subject: Gas Bottle Canopy Misc Support Calculations
 By: M. Bratt Date: 10/5/2009

Bottom Steel

Governing Combination	No of Bars	Bar Size	Bar Spac (in)	Area Prov (sq in/ft)	Area Req (sq in/ft)	Moment (kip ft/ft)	Direction
5. 1.2Dead + EQEW	15	5	6	0.61	0.52	0.32	E-W
4. 1.2Dead + EQNS	15	5	6	0.61	0.52	0.32	N-S

PUNCHING SHEAR

P1

Control Comb	Net Ult Load (kips)	Punch. Stress (psi)	All Stress (psi)	Rem
2. 1.2Dead + 1.6Live	2.99	1.44	215.04	

P2

Control Comb	Net Ult Load (kips)	Punch. Stress (psi)	All Stress (psi)	Rem
4. 1.2Dead + EQNS	3.30	1.59	215.04	

P3

Control Comb	Net Ult Load (kips)	Punch. Stress (psi)	All Stress (psi)	Rem
5. 1.2Dead + EQEW	3.30	1.59	215.04	



Project: BGCAPP
 Job Number: 743341
 Calc. No.: 24915-10-DBC-00-00004
 Sheet No.: E-16 of E-80
 Sheet Rev.: D

Subject: Gas Bottle Canopy Misc Support Calculations
 By: M. Bratt Date: 10/5/2009

P4

Control Comb	Net Ult Load (kips)	Punch. Stress (psi)	All Stress (psi)	Rem
6. 1.2Dead + EQNE	3.61	1.74	215.04	

MAXIMUM SHEAR - X DIRECTION

Load Comb	Left Dist (ft)	Max Shear (kips)	Shear Stress (psi)	All Stress (psi)	Rem
1 - 1.4Dead	4.08	0.28	0.16	107.52	
2 - 1.2Dead + 1.6Live	4.08	0.80	0.44	107.52	
3 - 1.2Dead + Live	4.08	0.59	0.33	107.52	
4 - 1.2Dead + EQNS	4.08	0.24	0.13	107.52	
5 - 1.2Dead + EQEW	3.42	-0.39	0.22	107.52	
6 - 1.2Dead + EQNE	4.08	0.24	0.14	107.52	

MAXIMUM SHEAR - Z DIRECTION

Load Comb	Bottom Dist (ft)	Max Shear (kips)	Shear Stress (psi)	All Stress (psi)	Rem
1 - 1.4Dead	4.08	0.28	0.16	107.52	
2 - 1.2Dead + 1.6Live	4.08	0.80	0.44	107.52	
3 - 1.2Dead + Live	4.08	0.59	0.33	107.52	
4 - 1.2Dead + EQNS	3.42	-0.39	0.22	107.52	
5 - 1.2Dead + EQEW	4.08	0.24	0.13	107.52	
6 - 1.2Dead + EQNE	4.08	0.24	0.14	107.52	

PIER/BASE PLATE DESIGN INFORMATION


	P1	P2	P3	P4
X Dim (ft)	0.50	0.50	0.50	0.50
Z Dim (ft)	0.50	0.50	0.50	0.50



Project: BGCAPP
 Job Number: 743341
 Calc. No.: 24915-10-DBC-00-00004
 Sheet No.: E-17 of E-80
 Sheet Rev.: D

Subject: Gas Bottle Canopy Misc Support Calculations
 By: M. Bratt Date: 10/5/2009

Height (ft)	0.33	0.42	0.42	0.42
X Offset (ft)	1.50	1.50	6.00	6.00
Z Offset (ft)	1.50	6.00	1.50	6.00
Requested Reinf. Ratio	0.0018	0.0018	0.0018	0.0018
Provided Reinf. Ratio	0.0000	0.0000	0.0000	0.0000
Long Bar Size	0	0	0	0
Bars in X Dir	0	0	0	0
Bars in Z Dir	0	0	0	0
Total Long Bars	0	0	0	0
Tie Bar Size	3	3	3	3
Total No. of Ties	1	1	1	1
Major Tie Spacing (in)	-1	1	1	1

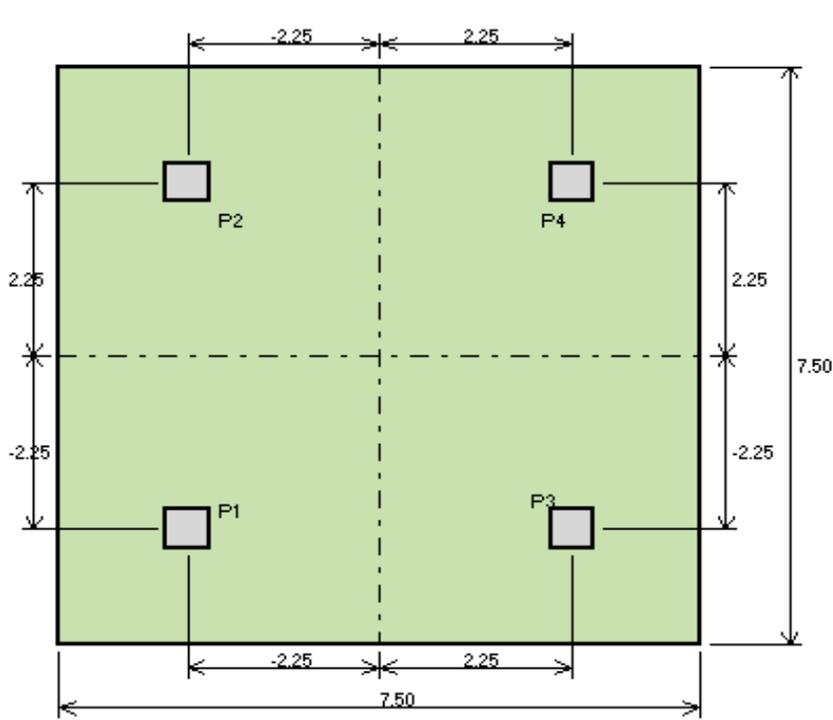

PLAN

FOUNDATION PLAN FOR Effluent Caustic I

Subject: Gas Bottle Canopy & Misc Support Calculations
By: M. Bratt
Date: 1/12/2010

Seismic Load Calculation - R.O. Skid

Operational weight: $W_t := 12210 \text{ lbf}$
 Empty weight: $W_W := 8767 \text{ lbf}$
 Contents Weight: $W_L := W_t - W_W$ $W_L = 3443 \text{ lbf}$
 COG Height: $H_t := 38 \text{ in}$
 Distance between Anchor Bolts: $D_{\text{bolt}} := 69 \text{ in}$

Seismic Base Shear and Overturning Moment

Design spectral response acceleration parameters (Sec. 1615.1.3 of IBC2003)

At short period: $S_{DS} := 0.273$ (per BGCAPP Design Criteria and IBC2000)

At long period: $S_{D1} := 0.167$

Seismic Importance Factor: $I_E := 1.0$ (APS, Level = 2, Ref. 4.13)

Response Modification factor (Table 12-6 BGCAPP Design Criteria): 'General Mechanical - Other' $R := 1$

Component amplification factor (Table 12-6 BGCAPP Design Criteria): $a_p := 2.50$

Height in structure at point of attachment of component: $z := 0$

Impulsive seismic force: $F_{P1} := \frac{0.4 \cdot a_p \cdot S_{DS}}{\frac{R}{I_E}} \cdot \left(1 + 2 \cdot \frac{z}{H} \right)$ $F_{P1} = 0$

$F_{Pmax} := 1.6 \cdot S_{DS} \cdot I_E$ $F_{Pmax} = 0$

$F_{Pmin} := 0.3 \cdot S_{DS} \cdot I_E$ $F_{Pmin} = 0$

$F_P := \max(\min(F_{P1}, F_{Pmax}), F_{Pmin})$ $F_P = 0$

Combined seismic coeff.: $C_s := F_P$ $C_s = 0.273$

Lateral base shear force: $V := C_s \cdot (W_t)$ (IBC2000 Eq. 16-34) $V = 3333 \text{ lbf}$

Vertical component of EQ: $0.2 \cdot S_{DS} = 0.055$

Overturning Moment: $OTM := C_s \cdot (W_t \cdot H_t)$ $OTM = 11 \cdot \text{ft} \cdot \text{kip}$

Subject: Gas Bottle Canopy & Misc Support Calculations
 By: M. Bratt
 Date: 1/12/2010

Seismic Load Calculation - R.O. Skid

Gravity Loads Applied on Concrete Pad

Unit self-weight: $W_W = 9 \cdot \text{kip}$

Unit content weight: $W_L = 3 \cdot \text{kip}$

Pad thickness: $t_{\text{pad}} := 1 \cdot \text{in}$

Vertical load applied on concrete pad due to self-weight:

$$P_{\text{DLpad}} := \frac{W_W}{4} \quad P_{\text{DLpad}} = 2.192 \cdot \text{kip}$$

Vertical load applied on concrete pad from internal contents:

$$P_{\text{LLpad}} := \frac{W_L}{4} \quad P_{\text{LLpad}} = 0.861 \cdot \text{kip}$$

Overturning Moments Applied on Concrete Pad

Lateral base shear force: $V = 3 \cdot \text{kip}$

Overturning moment per tank: $\text{OTM} = 11 \cdot \text{ft} \cdot \text{kip}$

Mat foundation thickness: $t_{\text{mat}} := 3 \cdot \text{ft} + 4 \cdot \text{in}$

For N-S direction EQ load, assume that the seismic overturning moment of the unit is applied on two anchor points using an upward force and on the remaining two using a downward force.

Overturning moment arm: $a_1 := D_{\text{bolt}} \quad a_1 = 6 \text{ ft}$

Pad force from OTM: $P_{\text{xEQpad}} := \frac{\text{OTM}}{a_1 \cdot 2} \quad P_{\text{xEQpad}} = 0.918 \cdot \text{kip}$

Lateral Shear: $V_{\text{pl}} := \frac{V}{4} \quad V_{\text{pl}} = 0.833 \cdot \text{kip}$

For NE direction EQ load, assume that the seismic overturning moment of the unit is applied on one anchor point using an upward force and on the opposite one using a downward force.

Overturning moment arm: $a_2 := D_{\text{bolt}} \cdot \sqrt{2} \quad a_2 = 6 \text{ ft}$

Pad force from OTM: $P_{2\text{EQpad}} := \frac{\text{OTM}}{a_2} \quad P_{2\text{EQpad}} = 1.298 \cdot \text{kip}$

Lateral Shear in x & y dir: $V_{\text{pl}} := \frac{V}{4} \cdot \cos(45) \quad V_{\text{pl}} = 0.438 \cdot \text{kip}$



Project: BGCAPP
 Job Number: 743341
 Calc. No.: 24915-10-DBC-00-00004
 Sheet No.: E-20 of E-80
 Sheet Rev.: D

Subject: Gas Bottle Canopy Misc Support Calculations
 By: M. Bratt Date: 10/5/2009

Dimensional Solutions Mat3D	Version	5.1.0	Date	10/7/2009
Foundation Name	R.O. Skid Foundation		Time	7:16:03 AM
Designed By:	PARSONS	Engineer	R. Murphy	Checker B. Rabe
Filename:	C:\Documents and Settings\p0045388\My Documents\SCWO\10-DBC-00-00004 Gas Bottle & Misc Concrete\...102 03 RO Skid\RO SKID FOUNDATION.m3d			

DETAIL REPORT

PROJECT INFORMATION

Project Name:
 Project Number: 10-DBC-00-00004
 Client:
 Project Location
 Foundation Description R.O. SKID FOUNDATION

DESIGN CODE ACI 318 - 2002 **INPUT UNITS** English **OUTPUT UNITS** English

CONCRETE PARAMETERS:

Compressive Strength (psi) 4000.00
 Unit Weight (pcf) 150.00

REINFORCING STEEL PARAMETERS:

Yield Strength (ksi) 60.00
 Unit Weight (pcf) 490.00
 Modulus of Elasticity (ksi) 29000.00

SOIL PARAMETERS:

Allowable Net Bearing Capacity (psf) 3000.00
 Unit Weight (pcf) 120.00

PILE PARAMETERS:

Diameter (in) 0
 Type Drilled Shaft

REBAR PARAMETERS:

Max Long Bar Size 9
 Min Long Bar Size 4
 Max Tie Bar Size 8
 Min Tie Bar Size 3
 Max Ftg Bar Size 9
 Min Ftg Bar Size 4
 Temp & Shrinkage Steel Ratio 0.0018

MINIMUM FOUNDATION CRITERIA:

Depth of Footing Below Grade (ft) 2.00
 Minimum Soil Cover (ft) 0.00



Project: BGCAPP
Job Number: 743341
Calc. No.: 24915-10-DBC-00-00004
Sheet No.: E-21 of E-80
Sheet Rev.: D

Subject: Gas Bottle Canopy Misc Support Calculations
By: M. Bratt Date: 10/5/2009

APPLIED LOADS

P1

Load Case	Axial (kips)	Shear X (kips)	Mom Z (kip ft)	Shear Z (kips)	Mom X (kip ft)
1 - Dead	2.19	0.00	0.00	0.00	0.00
2 - Live	0.86	0.00	0.00	0.00	0.00
3 - EQNS	-1.00	0.00	0.00	0.83	0.00
4 - EQEW	-1.00	0.83	0.00	0.00	0.00
5 - EQNE	-1.30	0.44	0.00	0.44	0.00

P2

Load Case	Axial (kips)	Shear X (kips)	Mom Z (kip ft)	Shear Z (kips)	Mom X (kip ft)
1 - Dead	2.19	0.00	0.00	0.00	0.00
2 - Live	0.86	0.00	0.00	0.00	0.00
3 - EQNS	1.00	0.00	0.00	0.83	0.00
4 - EQEW	-1.00	0.83	0.00	0.00	0.00
5 - EQNE	0.00	0.44	0.00	0.44	0.00

P3

Load Case	Axial (kips)	Shear X (kips)	Mom Z (kip ft)	Shear Z (kips)	Mom X (kip ft)
1 - Dead	2.19	0.00	0.00	0.00	0.00
2 - Live	0.86	0.00	0.00	0.00	0.00
3 - EQNS	-1.00	0.00	0.00	0.83	0.00
4 - EQEW	1.00	0.83	0.00	0.00	0.00
5 - EQNE	0.00	0.44	0.00	0.44	0.00



Project: BGCAPP
 Job Number: 743341
 Calc. No.: 24915-10-DBC-00-00004
 Sheet No.: E-22 of E-80
 Sheet Rev.: D

Subject: Gas Bottle Canopy Misc Support Calculations
 By: M. Bratt Date: 10/5/2009

P4

Load Case	Axial (kips)	Shear X (kips)	Mom Z (kip ft)	Shear Z (kips)	Mom X (kip ft)
1 - Dead	2.19	0.00	0.00	0.00	0.00
2 - Live	0.86	0.00	0.00	0.00	0.00
3 - EQNS	1.00	0.00	0.00	0.83	0.00
4 - EQEW	1.00	0.83	0.00	0.00	0.00
5 - EQNE	1.30	0.44	0.00	0.44	0.00

UNFACTORED (ALLOWABLE) LOAD COMBINATIONS

P1

Load Comb	Axial (kips)	Shear X (kips)	Mom Z (kip ft)	Shear Z (kips)	Mom X (kip ft)
1 - Dead	2.19	0.00	0.00	0.00	0.00
2 - Dead + Live	3.05	0.00	0.00	0.00	0.00
3 - Dead + 0.7EQNS	1.49	0.00	0.00	0.58	0.00
4 - Dead + 0.7EQEW	1.49	0.58	0.00	0.00	0.00
5 - Dead + 0.7EQNE	1.28	0.31	0.00	0.31	0.00

P2

Load Comb	Axial (kips)	Shear X (kips)	Mom Z (kip ft)	Shear Z (kips)	Mom X (kip ft)
1 - Dead	2.19	0.00	0.00	0.00	0.00
2 - Dead + Live	3.05	0.00	0.00	0.00	0.00
3 - Dead + 0.7EQNS	2.89	0.00	0.00	0.58	0.00
4 - Dead + 0.7EQEW	1.49	0.58	0.00	0.00	0.00
5 - Dead + 0.7EQNE	2.19	0.31	0.00	0.31	0.00



Project: BGCAPP
 Job Number: 743341
 Calc. No.: 24915-10-DBC-00-00004
 Sheet No.: E-23 of E-80
 Sheet Rev.: D

Subject: Gas Bottle Canopy Misc Support Calculations
 By: M. Bratt Date: 10/5/2009

P3

Load Comb	Axial (kips)	Shear X (kips)	Mom Z (kip ft)	Shear Z (kips)	Mom X (kip ft)
1 - Dead	2.19	0.00	0.00	0.00	0.00
2 - Dead + Live	3.05	0.00	0.00	0.00	0.00
3 - Dead + 0.7EQNS	1.49	0.00	0.00	0.58	0.00
4 - Dead + 0.7EQEW	2.89	0.58	0.00	0.00	0.00
5 - Dead + 0.7EQNE	2.19	0.31	0.00	0.31	0.00

P4

Load Comb	Axial (kips)	Shear X (kips)	Mom Z (kip ft)	Shear Z (kips)	Mom X (kip ft)
1 - Dead	2.19	0.00	0.00	0.00	0.00
2 - Dead + Live	3.05	0.00	0.00	0.00	0.00
3 - Dead + 0.7EQNS	2.89	0.00	0.00	0.58	0.00
4 - Dead + 0.7EQEW	2.89	0.58	0.00	0.00	0.00
5 - Dead + 0.7EQNE	3.10	0.31	0.00	0.31	0.00

FACTORED (ULTIMATE) LOAD COMBINATIONS

P1

Load Comb	Axial (kips)	Shear X (kips)	Mom Z (kip ft)	Shear Z (kips)	Mom X (kip ft)
1 - 1.4Dead	3.07	0.00	0.00	0.00	0.00
2 - 1.2Dead + 1.6Live	4.01	0.00	0.00	0.00	0.00
3 - 1.2Dead + Live	3.49	0.00	0.00	0.00	0.00
4 - 1.2Dead + EQNS	1.63	0.00	0.00	0.83	0.00
5 - 1.2Dead + EQEW	1.63	0.83	0.00	0.00	0.00
6 - 1.2Dead + EQNE	1.33	0.44	0.00	0.44	0.00



Project: BGCAPP
 Job Number: 743341
 Calc. No.: 24915-10-DBC-00-00004
 Sheet No.: E-24 of E-80
 Sheet Rev.: D

Subject: Gas Bottle Canopy Misc Support Calculations
 By: M. Bratt Date: 10/5/2009

P2

Load Comb	Axial (kips)	Shear X (kips)	Mom Z (kip ft)	Shear Z (kips)	Mom X (kip ft)
1 - 1.4Dead	3.07	0.00	0.00	0.00	0.00
2 - 1.2Dead + 1.6Live	4.01	0.00	0.00	0.00	0.00
3 - 1.2Dead + Live	3.49	0.00	0.00	0.00	0.00
4 - 1.2Dead + EQNS	3.63	0.00	0.00	0.83	0.00
5 - 1.2Dead + EQEW	1.63	0.83	0.00	0.00	0.00
6 - 1.2Dead + EQNE	2.63	0.44	0.00	0.44	0.00

P3

Load Comb	Axial (kips)	Shear X (kips)	Mom Z (kip ft)	Shear Z (kips)	Mom X (kip ft)
1 - 1.4Dead	3.07	0.00	0.00	0.00	0.00
2 - 1.2Dead + 1.6Live	4.01	0.00	0.00	0.00	0.00
3 - 1.2Dead + Live	3.49	0.00	0.00	0.00	0.00
4 - 1.2Dead + EQNS	1.63	0.00	0.00	0.83	0.00
5 - 1.2Dead + EQEW	3.63	0.83	0.00	0.00	0.00
6 - 1.2Dead + EQNE	2.63	0.44	0.00	0.44	0.00

P4

Load Comb	Axial (kips)	Shear X (kips)	Mom Z (kip ft)	Shear Z (kips)	Mom X (kip ft)
1 - 1.4Dead	3.07	0.00	0.00	0.00	0.00
2 - 1.2Dead + 1.6Live	4.01	0.00	0.00	0.00	0.00
3 - 1.2Dead + Live	3.49	0.00	0.00	0.00	0.00
4 - 1.2Dead + EQNS	3.63	0.00	0.00	0.83	0.00
5 - 1.2Dead + EQEW	3.63	0.83	0.00	0.00	0.00
6 - 1.2Dead + EQNE	3.93	0.44	0.00	0.44	0.00



Project: BGCAPP
 Job Number: 743341
 Calc. No.: 24915-10-DBC-00-00004
 Sheet No.: E-25 of E-80
 Sheet Rev.: D

Subject: Gas Bottle Canopy Misc Support Calculations
 By: M. Bratt Date: 10/5/2009

BEARING CAPACITY - LINEAR SOIL PRESSURE METHOD

Load Comb	Max Pressure (ksf)	All Pressure (ksf)	Ecc N/S Dir (ft)	Ecc E/W Dir (ft)	Moment N/S axis (kip-ft)	Moment E/W axis (kip-ft)	Rem
1 - Dead	0.41	3.24	0.00	0.00	0.00	0.00	
2 - Dead + Live	0.44	3.24	0.00	0.00	0.00	0.00	
3 - Dead + 0.7EQNS	0.51	4.24	0.28	0.00	0.00	13.49	
4 - Dead + 0.7EQEW	0.49	4.24	0.00	0.56	27.35	0.00	
5 - Dead + 0.7EQNE	0.52	4.24	0.17	0.35	17.12	8.12	

STABILITY RATIO / SLIDING SAFETY FACTOR

Load Comb	S.R. N/S Dir	S.R. E/W Dir	All S.R.	Sliding FS - N/S	Sliding FS - E/W	All FS	Remarks
1 - Dead	100.00	100.00	1.50	100.00	100.00	1.50	
2 - Dead + Live	100.00	100.00	1.50	100.00	100.00	1.50	
3 - Dead + 0.7EQNS	30.10	100.00	1.50	21.64	100.00	1.50	
4 - Dead + 0.7EQEW	100.00	72.67	1.50	100.00	15.10	1.50	
5 - Dead + 0.7EQNE	57.76	100.00	1.50	40.82	28.49	1.50	

FOOTING DESIGN INFORMATION

X Dim (ft)	17.00
Z Dim (ft)	7.00
Thickness (ft)	2.25

Top Steel

Governing Combination	No of Bars	Bar Size	Bar Spac (in)	Area Prov (sq in/ft)	Area Req (sq in/ft)	Moment (kip ft/ft)	Direction
2. 1.2Dead + 1.6Live	7	5	12	0.31	0.05	-4.1	E-W
2. 1.2Dead + 1.6Live	17	5	12	0.31	0.01	-0.53	N-S



Project: BGCAPP
 Job Number: 743341
 Calc. No.: 24915-10-DBC-00-00004
 Sheet No.: E-26 of E-80
 Sheet Rev.: D

Subject: Gas Bottle Canopy Misc Support Calculations
 By: M. Bratt Date: 10/5/2009

Bottom Steel

Governing Combination	No of Bars	Bar Size	Bar Spac (in)	Area Prov (sq in/ft)	Area Req (sq in/ft)	Moment (kip ft/ft)	Direction
5. 1.2Dead + EQEW	14	5	6	0.61	0.58	0.49	E-W
4. 1.2Dead + EQNS	34	5	6	0.61	0.58	0.19	N-S

PUNCHING SHEAR

P1

Control Comb	Net Ult Load (kips)	Punch. Stress (psi)	All Stress (psi)	Rem
2. 1.2Dead + 1.6Live	3.61	3.78	189.74	

P2

Control Comb	Net Ult Load (kips)	Punch. Stress (psi)	All Stress (psi)	Rem
2. 1.2Dead + 1.6Live	3.61	3.78	189.74	

P3

Control Comb	Net Ult Load (kips)	Punch. Stress (psi)	All Stress (psi)	Rem
2. 1.2Dead + 1.6Live	3.61	3.78	189.74	



Project: BGCAPP
 Job Number: 743341
 Calc. No.: 24915-10-DBC-00-00004
 Sheet No.: E-27 of E-80
 Sheet Rev.: D

Subject: Gas Bottle Canopy Misc Support Calculations
 By: M. Bratt Date: 10/5/2009

P4

Control Comb	Net Ult Load (kips)	Punch. Stress (psi)	All Stress (psi)	Rem
2. 1.2Dead + 1.6Live	3.61	3.78	189.74	

MAXIMUM SHEAR - X DIRECTION

Load Comb	Left Dist (ft)	Max Shear (kips)	Shear Stress (psi)	All Stress (psi)	Rem
1 - 1.4Dead	2.71	-4.18	2.16	94.87	
2 - 1.2Dead + 1.6Live	14.29	5.46	2.83	94.87	
3 - 1.2Dead + Live	2.71	-4.76	2.46	94.87	
4 - 1.2Dead + EQNS	2.71	-3.58	1.86	94.87	
5 - 1.2Dead + EQEW	14.29	3.74	1.93	94.87	
6 - 1.2Dead + EQNE	14.29	3.73	1.93	94.87	

MAXIMUM SHEAR - Z DIRECTION

Load Comb	Bottom Dist (ft)	Max Shear (kips)	Shear Stress (psi)	All Stress (psi)	Rem
1 - 1.4Dead	4.34	1.47	0.31	94.87	
2 - 1.2Dead + 1.6Live	4.34	1.92	0.41	94.87	
3 - 1.2Dead + Live	2.66	-1.67	0.36	94.87	
4 - 1.2Dead + EQNS	2.66	-3.15	0.67	94.87	
5 - 1.2Dead + EQEW	2.66	-1.26	0.27	94.87	
6 - 1.2Dead + EQNE	2.66	-2.30	0.49	94.87	

PIER/BASE PLATE DESIGN INFORMATION


	P1	P2	P3	P4
X Dim (ft)	0.25	0.25	0.25	0.25
Z Dim (ft)	0.25	0.25	0.25	0.25



Project: BGCAPP
 Job Number: 743341
 Calc. No.: 24915-10-DBC-00-00004
 Sheet No.: E-28 of E-80
 Sheet Rev.: D

Subject: Gas Bottle Canopy Misc Support Calculations
 By: M. Bratt Date: 10/5/2009

Height (ft)	0.08	0.08	0.08	0.08
X Offset (ft)	0.67	0.67	16.33	16.33
Z Offset (ft)	0.62	6.38	0.62	6.38
Requested Reinf. Ratio	0.0018	0.0018	0.0018	0.0018
Provided Reinf. Ratio	0.0000	0.0000	0.0000	0.0000
Long Bar Size	0	0	0	0
Bars in X Dir	0	0	0	0
Bars in Z Dir	0	0	0	0
Total Long Bars	0	0	0	0
Tie Bar Size	3	3	3	3
Total No. of Ties	2	2	2	2
Major Tie Spacing (in)	-4	-4	-4	-4

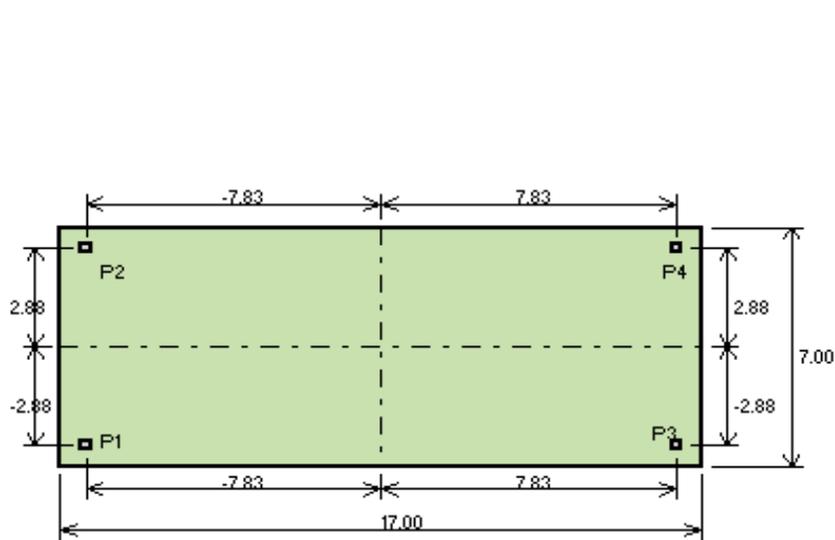

PLAN

FOUNDATION PLAN FOR R.O. Skid Founda

Subject: Gas Bottle Canopy & Misc Support Calculations
 By: M. Bratt
 Date: 1/12/2010

Tank Seismic Load Calculation - Multimedia Filter SCWO

Tank Information

The tank is circular, elevated, supported on unbraced legs, and welded steel.

Operational weight: $W_t := 11880 \text{ lbf}$

Tank empty weight: $W_W := 2651 \text{ lbf}$

Tank Content Weight: $W_L := W_t - W_W$ $W_L = 9229 \text{ lbf}$

Leg height: $H := 50 \text{ in}$

Tank COG: $H_t := 71 \text{ in}$

Leg angle size: $L3 \times 3 \times 3/8$

Number of legs: $N := 4$


Moment of inertia of a leg about x-axis: $I_x := 1.75 \text{ in}^4$

Moment of inertia of a leg about z-axis: $I_z := 0.581^2 \cdot 2.11 \text{ in}^4$ ($= r_z^2 \cdot A$) $I_z = 1 \cdot \text{in}^4$

Moment of inertia of a leg about w-axis: $I_w := 2 \cdot I_x - I_z$ $I_w = 3 \cdot \text{in}^4$

Distance between Anchor Bolts: $D_{\text{bolt}} := 38 \cdot \text{in}$

Base plate area: $A_{\text{bp}} := (6 \cdot \text{in})^2$ $A_{\text{bp}} = 0 \cdot \text{ft}^2$

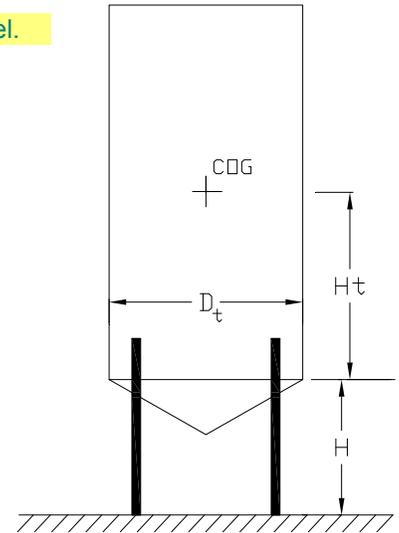

Check if the Tank is a Rigid Structure

Density of steel: $\rho_s := 490 \cdot \text{pcf}$

Steel elastic modulus: $E_s := 29000 \cdot \text{ksi}$

Lateral deflection under N-S EQ load: $y_x := \frac{2 \cdot W_t \cdot H^3}{3 \cdot N \cdot E_s \cdot I_w}$ $y_x = 5 \cdot \text{in}$

Lateral deflection under NW EQ load: $y_2 := \frac{2 \cdot W_t \cdot H^3}{3 \cdot \frac{N}{2} \cdot E_s \cdot (I_z + I_w)}$ $y_2 = 5 \cdot \text{in}$

The fundamental period of the tank with its content is computed by using Ref. 4.11 Fig. 3-9 formula:

N-S EQ: $T_x := 2 \cdot \pi \cdot \sqrt{\frac{y_x}{g}}$ $T_x = 0.706 \text{ s}$ > 0.06 , the tank is not rigid and Sec. 1622.2.6 of IBC2000 is not used.

NW EQ: $T_2 := 2 \cdot \pi \cdot \sqrt{\frac{y_2}{g}}$ $T_2 = 0.706 \text{ s}$ > 0.06 , the tank is not rigid and Sec. 1622.2.6 of IBC2000 is not used.

Subject: Gas Bottle Canopy & Misc Support Calculations
 By: M. Bratt
 Date: 1/12/2010

Tank Seismic Load Calculation - Multimedia Filter SCWO

Seismic Base Shear and Overturning Moment

Design spectral response acceleration parameters (Sec. 1615.1.3 of IBC2003)

At short period: $S_{DS} := 0.273$ (per BGCAPP Design Criteria and IBC2000)

At long period: $S_{D1} := 0.167$

Seismic Importance Factor: $I_E := 1.0$ (APS, Level = 2, Ref. 4.13)

The tank is elevated, supported by unbraced legs, and welded steel. Table 1622.2.5(1) of IBC2000 specifies the seismic coefficients as follows.

$$R := 3 \quad C_d := 2.5 \quad \Omega_o := 2$$

Component amplification factor (Table 1621.3 of IBC2000):

$$a_p := 2.50$$

Height in structure at point of attachment of component:

$$z := 0$$

$$z = 0$$

Impulsive seismic force: $F_{P1} := \frac{0.4 \cdot a_p \cdot S_{DS}}{\frac{R}{I_E}} \cdot \left(1 + 2 \cdot \frac{z}{H}\right)$ $F_{P1} = 0$

$$F_{Pmax} := 1.6 \cdot S_{DS} \cdot I_E \quad F_{Pmax} = 0$$

$$F_{Pmin} := 0.3 \cdot S_{DS} \cdot I_E \quad F_{Pmin} = 0$$

$$F_P := \max(\min(F_{P1}, F_{Pmax}), F_{Pmin}) \quad F_P = 0$$

Combined seismic coeff.: $C_s := F_P$ $C_s = 0.091$

Lateral base shear force: $V := C_s \cdot (W_t)$ (IBC2000 Eq. 16-34) $V = 1081 \text{ lbf}$

Vertical component of EQ: $0.2 \cdot S_{DS} = 0.055$

$$OTM := C_s \cdot \left(W_t \cdot \frac{H_t + H}{2}\right) \quad OTM = 5 \cdot \text{ft} \cdot \text{kip}$$

Live Loads Applied Outside Concrete Pad

$$LL := 200 \cdot \text{psf} \quad (\text{refer to Sec. D2.3})$$

Subject: Gas Bottle Canopy & Misc Support Calculations
 By: M. Bratt
 Date: 1/12/2010

Tank Seismic Load Calculation - Multimedia Filter SCWO

Gravity Loads Applied on Concrete Pad

Tank self-weight: $W_W = 3 \cdot \text{kip}$

Tank content weight: $W_L = 9 \cdot \text{kip}$

Pad thickness: $t_{\text{pad}} := 1 \cdot \text{in}$

Vertical load applied on concrete pad due to self-weight:

$$P_{\text{DLpad}} := \frac{W_W}{4} + t_{\text{pad}} \cdot A_{\text{bp}} \cdot 150 \cdot \text{pcf} \quad P_{\text{DLpad}} = 0.666 \cdot \text{kip}$$

Vertical load applied on concrete pad due to tank liquid content with LL deducted:

$$P_{\text{LLpad}} := \frac{W_L}{4} - \text{LL} \cdot A_{\text{bp}} \quad P_{\text{LLpad}} = 2.257 \cdot \text{kip}$$

Overturning Moments Applied on Concrete Pad

Lateral base shear force: $V = 1 \cdot \text{kip}$

Overturning moment per tank: $\text{OTM} = 5 \cdot \text{ft} \cdot \text{kip}$

Mat foundation thickness: $t_{\text{mat}} := 3 \cdot \text{ft} + 4 \cdot \text{in}$

For N-S direction EQ load, assume that the seismic overturning moment of a tank is applied on two base plates using an upward uniform pressure value and on the remaining two using a downward value.

Overturning moment arm: $a_1 := D_{\text{bolt}} \quad a_1 = 3 \text{ ft}$

Pad force from OTM: $P_{\text{xEQpad}} := \frac{\text{OTM}}{a_1 \cdot 2} \quad P_{\text{xEQpad}} = 0.861 \cdot \text{kip}$

Lateral Shear: $V_{\text{pl}} := \frac{V}{4} \quad V_{\text{pl}} = 0.270 \cdot \text{kip}$

For NE direction EQ load, assume that the seismic overturning moment of a tank is applied on one base plate using an upward uniform pressure value and on the opposite one using a downward value.

Overturning moment arm: $a_2 := D_{\text{bolt}} \cdot \sqrt{2} \quad a_1 = 3 \text{ ft}$

Pad force from OTM: $P_{2\text{EQpad}} := \frac{\text{OTM}}{a_2} \quad P_{2\text{EQpad}} = 1.217 \cdot \text{kip}$

Lateral Shear in x & y dir: $V_{\text{pl}} := \frac{V}{4} \cdot \cos(45) \quad V_{\text{pl}} = 0.142 \cdot \text{kip}$



Project: BGCAPP
 Job Number: 743341
 Calc. No.: 24915-10-DBC-00-00004
 Sheet No.: E-32 of E-80
 Sheet Rev.: D

Subject: Gas Bottle Canopy Misc Support Calculations
 By: M. Bratt Date: 10/5/2009

Dimensional Solutions Mat3D	Version	5.1.0	Date	10/7/2009
Foundation Name	Multimedia Filter		Time	11:01:53 AM
Designed By:	PARSONS	Engineer	R. Murphy	Checker
	C:\Documents and Settings\p0045388\My Documents\SCWO\			
Filename:	10-DBC-00-00004 Gas Bottle & Misc Concrete\...\App E\Foundation For Filters.m3d			

DETAIL REPORT

PROJECT INFORMATION

Project Name:
 Project Number: 10-DBC-00-00004
 Client:
 Project Location
 Foundation Description: MULTIMEDIA FILTER

DESIGN CODE ACI 318 - 1999 **INPUT UNITS** English **OUTPUT UNITS** English

CONCRETE PARAMETERS:

Compressive Strength (psi) 4000.00
 Unit Weight (pcf) 150.00

REINFORCING STEEL PARAMETERS:

Yield Strength (ksi) 60.00
 Unit Weight (pcf) 490.00
 Modulus of Elasticity (ksi) 29000.00

SOIL PARAMETERS:

Allowable Net Bearing Capacity (psf) 3000.00
 Unit Weight (pcf) 120.00

PILE PARAMETERS:

Diameter (in) 0
 Type Drilled Shaft

REBAR PARAMETERS:

Max Long Bar Size 9
 Min Long Bar Size 4
 Max Tie Bar Size 8
 Min Tie Bar Size 3
 Max Ftg Bar Size 9
 Min Ftg Bar Size 4
 Temp & Shrinkage Steel Ratio 0.0018

MINIMUM FOUNDATION CRITERIA:

Depth of Footing Below Grade (ft) 2.50
 Minimum Soil Cover (ft) 0.00



Project: BGCAPP
Job Number: 743341
Calc. No.: 24915-10-DBC-00-00004
Sheet No.: E-33 of E-80
Sheet Rev.: D

Subject: Gas Bottle Canopy Misc Support Calculations
By: M. Bratt Date: 10/5/2009

APPLIED LOADS

P1

Load Case	Axial (kips)	Shear X (kips)	Mom Z (kip ft)	Shear Z (kips)	Mom X (kip ft)
1 - Dead	0.67	0.00	0.00	0.00	0.00
2 - Live	2.26	0.00	0.00	0.00	0.00
3 - Earthquake NS	-0.86	0.00	0.00	0.27	0.00
4 - Earthquake EW	-0.86	0.27	0.00	0.00	0.00
5 - Earthquake NE	-1.22	0.14	0.00	0.14	0.00

P2

Load Case	Axial (kips)	Shear X (kips)	Mom Z (kip ft)	Shear Z (kips)	Mom X (kip ft)
1 - Dead	0.67	0.00	0.00	0.00	0.00
2 - Live	2.26	0.00	0.00	0.00	0.00
3 - Earthquake NS	0.86	0.00	0.00	0.27	0.00
4 - Earthquake EW	-0.86	0.27	0.00	0.00	0.00
5 - Earthquake NE	0.00	0.14	0.00	0.14	0.00

P3

Load Case	Axial (kips)	Shear X (kips)	Mom Z (kip ft)	Shear Z (kips)	Mom X (kip ft)
1 - Dead	0.67	0.00	0.00	0.00	0.00
2 - Live	2.26	0.00	0.00	0.00	0.00
3 - Earthquake NS	-0.86	0.00	0.00	0.27	0.00
4 - Earthquake EW	0.86	0.27	0.00	0.00	0.00
5 - Earthquake NE	0.00	0.14	0.00	0.14	0.00



Project: BGCAPP
Job Number: 743341
Calc. No.: 24915-10-DBC-00-00004
Sheet No.: E-34 of E-80
Sheet Rev.: D

Subject: Gas Bottle Canopy Misc Support Calculations
By: M. Bratt Date: 10/5/2009

P4

Load Case	Axial (kips)	Shear X (kips)	Mom Z (kip ft)	Shear Z (kips)	Mom X (kip ft)
1 - Dead	0.67	0.00	0.00	0.00	0.00
2 - Live	2.26	0.00	0.00	0.00	0.00
3 - Earthquake NS	0.86	0.00	0.00	0.27	0.00
4 - Earthquake EW	0.86	0.27	0.00	0.00	0.00
5 - Earthquake NE	1.22	0.14	0.00	0.14	0.00

P5

Load Case	Axial (kips)	Shear X (kips)	Mom Z (kip ft)	Shear Z (kips)	Mom X (kip ft)
1 - Dead	0.67	0.00	0.00	0.00	0.00
2 - Live	2.26	0.00	0.00	0.00	0.00
3 - Earthquake NS	-0.86	0.00	0.00	0.27	0.00
4 - Earthquake EW	-0.86	0.27	0.00	0.00	0.00
5 - Earthquake NE	-1.22	0.14	0.00	0.14	0.00

P6

Load Case	Axial (kips)	Shear X (kips)	Mom Z (kip ft)	Shear Z (kips)	Mom X (kip ft)
1 - Dead	0.67	0.00	0.00	0.00	0.00
2 - Live	2.26	0.00	0.00	0.00	0.00
3 - Earthquake NS	0.86	0.00	0.00	0.27	0.00
4 - Earthquake EW	-0.86	0.27	0.00	0.00	0.00
5 - Earthquake NE	0.00	0.14	0.00	0.14	0.00



Project: BGCAPP
Job Number: 743341
Calc. No.: 24915-10-DBC-00-00004
Sheet No.: E-35 of E-80
Sheet Rev.: D

Subject: Gas Bottle Canopy Misc Support Calculations
By: M. Bratt Date: 10/5/2009

P7

Load Case	Axial (kips)	Shear X (kips)	Mom Z (kip ft)	Shear Z (kips)	Mom X (kip ft)
1 - Dead	0.67	0.00	0.00	0.00	0.00
2 - Live	2.26	0.00	0.00	0.00	0.00
3 - Earthquake NS	-0.86	0.00	0.00	0.27	0.00
4 - Earthquake EW	0.86	0.27	0.00	0.00	0.00
5 - Earthquake NE	0.00	0.14	0.00	0.14	0.00

P8

Load Case	Axial (kips)	Shear X (kips)	Mom Z (kip ft)	Shear Z (kips)	Mom X (kip ft)
1 - Dead	0.67	0.00	0.00	0.00	0.00
2 - Live	2.26	0.00	0.00	0.00	0.00
3 - Earthquake NS	0.86	0.00	0.00	0.27	0.00
4 - Earthquake EW	0.86	0.27	0.00	0.00	0.00
5 - Earthquake NE	1.22	0.14	0.00	0.14	0.00

P9

Load Case	Axial (kips)	Shear X (kips)	Mom Z (kip ft)	Shear Z (kips)	Mom X (kip ft)
1 - Dead	0.67	0.00	0.00	0.00	0.00
2 - Live	2.26	0.00	0.00	0.00	0.00
3 - Earthquake NS	-0.86	0.00	0.00	0.27	0.00
4 - Earthquake EW	-0.86	0.27	0.00	0.00	0.00
5 - Earthquake NE	-1.22	0.14	0.00	0.14	0.00



Project: BGCAPP
Job Number: 743341
Calc. No.: 24915-10-DBC-00-00004
Sheet No.: E-36 of E-80
Sheet Rev.: D

Subject: Gas Bottle Canopy Misc Support Calculations
By: M. Bratt Date: 10/5/2009

P10

Load Case	Axial (kips)	Shear X (kips)	Mom Z (kip ft)	Shear Z (kips)	Mom X (kip ft)
1 - Dead	0.67	0.00	0.00	0.00	0.00
2 - Live	2.26	0.00	0.00	0.00	0.00
3 - Earthquake NS	0.86	0.00	0.00	0.27	0.00
4 - Earthquake EW	-0.86	0.27	0.00	0.00	0.00
5 - Earthquake NE	0.00	0.14	0.00	0.14	0.00

P11

Load Case	Axial (kips)	Shear X (kips)	Mom Z (kip ft)	Shear Z (kips)	Mom X (kip ft)
1 - Dead	0.67	0.00	0.00	0.00	0.00
2 - Live	2.26	0.00	0.00	0.00	0.00
3 - Earthquake NS	-0.86	0.00	0.00	0.27	0.00
4 - Earthquake EW	0.86	0.27	0.00	0.00	0.00
5 - Earthquake NE	0.00	0.14	0.00	0.14	0.00

P12

Load Case	Axial (kips)	Shear X (kips)	Mom Z (kip ft)	Shear Z (kips)	Mom X (kip ft)
1 - Dead	0.67	0.00	0.00	0.00	0.00
2 - Live	2.26	0.00	0.00	0.00	0.00
3 - Earthquake NS	0.86	0.00	0.00	0.27	0.00
4 - Earthquake EW	0.86	0.27	0.00	0.00	0.00
5 - Earthquake NE	1.22	0.14	0.00	0.14	0.00



Project: BGCAPP
 Job Number: 743341
 Calc. No.: 24915-10-DBC-00-00004
 Sheet No.: E-37 of E-80
 Sheet Rev.: D

Subject: Gas Bottle Canopy Misc Support Calculations
 By: M. Bratt Date: 10/5/2009

P13

Load Case	Axial (kips)	Shear X (kips)	Mom Z (kip ft)	Shear Z (kips)	Mom X (kip ft)
1 - Dead	0.67	0.00	0.00	0.00	0.00
2 - Live	2.26	0.00	0.00	0.00	0.00
3 - Earthquake NS	-0.86	0.00	0.00	0.27	0.00
4 - Earthquake EW	-0.86	0.27	0.00	0.00	0.00
5 - Earthquake NE	-1.22	0.14	0.00	0.14	0.00

P14

Load Case	Axial (kips)	Shear X (kips)	Mom Z (kip ft)	Shear Z (kips)	Mom X (kip ft)
1 - Dead	0.67	0.00	0.00	0.00	0.00
2 - Live	2.26	0.00	0.00	0.00	0.00
3 - Earthquake NS	0.86	0.00	0.00	0.27	0.00
4 - Earthquake EW	-0.86	0.27	0.00	0.00	0.00
5 - Earthquake NE	0.00	0.14	0.00	0.14	0.00

P15

Load Case	Axial (kips)	Shear X (kips)	Mom Z (kip ft)	Shear Z (kips)	Mom X (kip ft)
1 - Dead	0.67	0.00	0.00	0.00	0.00
2 - Live	2.26	0.00	0.00	0.00	0.00
3 - Earthquake NS	-0.86	0.00	0.00	0.27	0.00
4 - Earthquake EW	0.86	0.27	0.00	0.00	0.00
5 - Earthquake NE	0.00	0.14	0.00	0.14	0.00



Project: BGCAPP
Job Number: 743341
Calc. No.: 24915-10-DBC-00-00004
Sheet No.: E-38 of E-80
Sheet Rev.: D

Subject: Gas Bottle Canopy Misc Support Calculations
By: M. Bratt Date: 10/5/2009

P16

Load Case	Axial (kips)	Shear X (kips)	Mom Z (kip ft)	Shear Z (kips)	Mom X (kip ft)
1 - Dead	0.67	0.00	0.00	0.00	0.00
2 - Live	2.26	0.00	0.00	0.00	0.00
3 - Earthquake NS	0.86	0.00	0.00	0.27	0.00
4 - Earthquake EW	0.86	0.27	0.00	0.00	0.00
5 - Earthquake NE	1.22	0.14	0.00	0.14	0.00

P17

Load Case	Axial (kips)	Shear X (kips)	Mom Z (kip ft)	Shear Z (kips)	Mom X (kip ft)
1 - Dead	0.67	0.00	0.00	0.00	0.00
2 - Live	2.26	0.00	0.00	0.00	0.00
3 - Earthquake NS	-0.86	0.00	0.00	0.27	0.00
4 - Earthquake EW	-0.86	0.27	0.00	0.00	0.00
5 - Earthquake NE	-1.22	0.14	0.00	0.14	0.00

P18

Load Case	Axial (kips)	Shear X (kips)	Mom Z (kip ft)	Shear Z (kips)	Mom X (kip ft)
1 - Dead	0.67	0.00	0.00	0.00	0.00
2 - Live	2.26	0.00	0.00	0.00	0.00
3 - Earthquake NS	0.86	0.00	0.00	0.27	0.00
4 - Earthquake EW	-0.86	0.27	0.00	0.00	0.00
5 - Earthquake NE	0.00	0.14	0.00	0.14	0.00



Project: BGCAPP
Job Number: 743341
Calc. No.: 24915-10-DBC-00-00004
Sheet No.: E-39 of E-80
Sheet Rev.: D

Subject: Gas Bottle Canopy Misc Support Calculations
By: M. Bratt Date: 10/5/2009

P19

Load Case	Axial (kips)	Shear X (kips)	Mom Z (kip ft)	Shear Z (kips)	Mom X (kip ft)
1 - Dead	0.67	0.00	0.00	0.00	0.00
2 - Live	2.26	0.00	0.00	0.00	0.00
3 - Earthquake NS	-0.86	0.00	0.00	0.27	0.00
4 - Earthquake EW	0.86	0.27	0.00	0.00	0.00
5 - Earthquake NE	0.00	0.14	0.00	0.14	0.00

P20

Load Case	Axial (kips)	Shear X (kips)	Mom Z (kip ft)	Shear Z (kips)	Mom X (kip ft)
1 - Dead	0.67	0.00	0.00	0.00	0.00
2 - Live	2.26	0.00	0.00	0.00	0.00
3 - Earthquake NS	0.86	0.00	0.00	0.27	0.00
4 - Earthquake EW	0.86	0.27	0.00	0.00	0.00
5 - Earthquake NE	1.22	0.14	0.00	0.14	0.00

P21

Load Case	Axial (kips)	Shear X (kips)	Mom Z (kip ft)	Shear Z (kips)	Mom X (kip ft)
1 - Dead	0.67	0.00	0.00	0.00	0.00
2 - Live	2.26	0.00	0.00	0.00	0.00
3 - Earthquake NS	-0.86	0.00	0.00	0.27	0.00
4 - Earthquake EW	-0.86	0.27	0.00	0.00	0.00
5 - Earthquake NE	-1.22	0.14	0.00	0.14	0.00



Project: BGCAPP
Job Number: 743341
Calc. No.: 24915-10-DBC-00-00004
Sheet No.: E-40 of E-80
Sheet Rev.: D

Subject: Gas Bottle Canopy Misc Support Calculations
By: M. Bratt Date: 10/5/2009

P22

Load Case	Axial (kips)	Shear X (kips)	Mom Z (kip ft)	Shear Z (kips)	Mom X (kip ft)
1 - Dead	0.67	0.00	0.00	0.00	0.00
2 - Live	2.26	0.00	0.00	0.00	0.00
3 - Earthquake NS	0.86	0.00	0.00	0.27	0.00
4 - Earthquake EW	-0.86	0.27	0.00	0.00	0.00
5 - Earthquake NE	0.00	0.14	0.00	0.14	0.00

P23

Load Case	Axial (kips)	Shear X (kips)	Mom Z (kip ft)	Shear Z (kips)	Mom X (kip ft)
1 - Dead	0.67	0.00	0.00	0.00	0.00
2 - Live	2.26	0.00	0.00	0.00	0.00
3 - Earthquake NS	-0.86	0.00	0.00	0.27	0.00
4 - Earthquake EW	0.86	0.27	0.00	0.00	0.00
5 - Earthquake NE	0.00	0.14	0.00	0.14	0.00

P24

Load Case	Axial (kips)	Shear X (kips)	Mom Z (kip ft)	Shear Z (kips)	Mom X (kip ft)
1 - Dead	0.67	0.00	0.00	0.00	0.00
2 - Live	2.26	0.00	0.00	0.00	0.00
3 - Earthquake NS	0.86	0.00	0.00	0.27	0.00
4 - Earthquake EW	0.86	0.27	0.00	0.00	0.00
5 - Earthquake NE	1.22	0.14	0.00	0.14	0.00



Project: BGCAPP
Job Number: 743341
Calc. No.: 24915-10-DBC-00-00004
Sheet No.: E-41 of E-80
Sheet Rev.: D

Subject: Gas Bottle Canopy Misc Support Calculations
By: M. Bratt Date: 10/5/2009

UNFACTORED (ALLOWABLE) LOAD COMBINATIONS

P1

Load Comb	Axial (kips)	Shear X (kips)	Mom Z (kip ft)	Shear Z (kips)	Mom X (kip ft)
1 - Dead	0.67	0.00	0.00	0.00	0.00
2 - Dead + Live	2.92	0.00	0.00	0.00	0.00
3 - Dead + 0.7Earthquake NS	0.06	0.00	0.00	0.19	0.00
4 - Dead + 0.7Earthquake EW	0.06	0.19	0.00	0.00	0.00
5 - Dead + 0.7Earthquake NE	-0.19	0.10	0.00	0.10	0.00
6 - 0.6Dead + 0.7Earthquake NS	-0.20	0.00	0.00	0.19	0.00
7 - 0.6Dead + 0.7Earthquake EW	-0.20	0.19	0.00	0.00	0.00
8 - 0.6Dead + 0.7Earthquake NE	-0.45	0.10	0.00	0.10	0.00

P2

Load Comb	Axial (kips)	Shear X (kips)	Mom Z (kip ft)	Shear Z (kips)	Mom X (kip ft)
1 - Dead	0.67	0.00	0.00	0.00	0.00
2 - Dead + Live	2.92	0.00	0.00	0.00	0.00
3 - Dead + 0.7Earthquake NS	1.27	0.00	0.00	0.19	0.00
4 - Dead + 0.7Earthquake EW	0.06	0.19	0.00	0.00	0.00
5 - Dead + 0.7Earthquake NE	0.67	0.10	0.00	0.10	0.00
6 - 0.6Dead + 0.7Earthquake NS	1.00	0.00	0.00	0.19	0.00
7 - 0.6Dead + 0.7Earthquake EW	-0.20	0.19	0.00	0.00	0.00
8 - 0.6Dead + 0.7Earthquake NE	0.40	0.10	0.00	0.10	0.00

P3

Load Comb	Axial (kips)	Shear X (kips)	Mom Z (kip ft)	Shear Z (kips)	Mom X (kip ft)
1 - Dead	0.67	0.00	0.00	0.00	0.00
2 - Dead + Live	2.92	0.00	0.00	0.00	0.00
3 - Dead + 0.7Earthquake NS	0.06	0.00	0.00	0.19	0.00
4 - Dead + 0.7Earthquake EW	1.27	0.19	0.00	0.00	0.00
5 - Dead + 0.7Earthquake NE	0.67	0.10	0.00	0.10	0.00
6 - 0.6Dead + 0.7Earthquake NS	-0.20	0.00	0.00	0.19	0.00
7 - 0.6Dead + 0.7Earthquake EW	1.00	0.19	0.00	0.00	0.00



Project: BGCAPP
 Job Number: 743341
 Calc. No.: 24915-10-DBC-00-00004
 Sheet No.: E-43 of E-80
 Sheet Rev.: D

Subject: Gas Bottle Canopy Misc Support Calculations
 By: M. Bratt Date: 10/5/2009

7 - 0.6Dead + 0.7Earthquake EW	-0.20	0.19	0.00	0.00	0.00
8 - 0.6Dead + 0.7Earthquake NE	0.40	0.10	0.00	0.10	0.00

P7

Load Comb	Axial (kips)	Shear X (kips)	Mom Z (kip ft)	Shear Z (kips)	Mom X (kip ft)
1 - Dead	0.67	0.00	0.00	0.00	0.00
2 - Dead + Live	2.92	0.00	0.00	0.00	0.00
3 - Dead + 0.7Earthquake NS	0.06	0.00	0.00	0.19	0.00
4 - Dead + 0.7Earthquake EW	1.27	0.19	0.00	0.00	0.00
5 - Dead + 0.7Earthquake NE	0.67	0.10	0.00	0.10	0.00
6 - 0.6Dead + 0.7Earthquake NS	-0.20	0.00	0.00	0.19	0.00
7 - 0.6Dead + 0.7Earthquake EW	1.00	0.19	0.00	0.00	0.00
8 - 0.6Dead + 0.7Earthquake NE	0.40	0.10	0.00	0.10	0.00

P8

Load Comb	Axial (kips)	Shear X (kips)	Mom Z (kip ft)	Shear Z (kips)	Mom X (kip ft)
1 - Dead	0.67	0.00	0.00	0.00	0.00
2 - Dead + Live	2.92	0.00	0.00	0.00	0.00
3 - Dead + 0.7Earthquake NS	1.27	0.00	0.00	0.19	0.00
4 - Dead + 0.7Earthquake EW	1.27	0.19	0.00	0.00	0.00
5 - Dead + 0.7Earthquake NE	1.52	0.10	0.00	0.10	0.00
6 - 0.6Dead + 0.7Earthquake NS	1.00	0.00	0.00	0.19	0.00
7 - 0.6Dead + 0.7Earthquake EW	1.00	0.19	0.00	0.00	0.00
8 - 0.6Dead + 0.7Earthquake NE	1.25	0.10	0.00	0.10	0.00

P9

Load Comb	Axial (kips)	Shear X (kips)	Mom Z (kip ft)	Shear Z (kips)	Mom X (kip ft)
1 - Dead	0.67	0.00	0.00	0.00	0.00
2 - Dead + Live	2.92	0.00	0.00	0.00	0.00
3 - Dead + 0.7Earthquake NS	0.06	0.00	0.00	0.19	0.00
4 - Dead + 0.7Earthquake EW	0.06	0.19	0.00	0.00	0.00
5 - Dead + 0.7Earthquake NE	-0.19	0.10	0.00	0.10	0.00



Project: BGCAPP
 Job Number: 743341
 Calc. No.: 24915-10-DBC-00-00004
 Sheet No.: E-44 of E-80
 Sheet Rev.: D

Subject: Gas Bottle Canopy Misc Support Calculations
 By: M. Bratt Date: 10/5/2009

6 - 0.6Dead + 0.7Earthquake NS	-0.20	0.00	0.00	0.19	0.00
7 - 0.6Dead + 0.7Earthquake EW	-0.20	0.19	0.00	0.00	0.00
8 - 0.6Dead + 0.7Earthquake NE	-0.45	0.10	0.00	0.10	0.00

P10

Load Comb	Axial (kips)	Shear X (kips)	Mom Z (kip ft)	Shear Z (kips)	Mom X (kip ft)
1 - Dead	0.67	0.00	0.00	0.00	0.00
2 - Dead + Live	2.92	0.00	0.00	0.00	0.00
3 - Dead + 0.7Earthquake NS	1.27	0.00	0.00	0.19	0.00
4 - Dead + 0.7Earthquake EW	0.06	0.19	0.00	0.00	0.00
5 - Dead + 0.7Earthquake NE	0.67	0.10	0.00	0.10	0.00
6 - 0.6Dead + 0.7Earthquake NS	1.00	0.00	0.00	0.19	0.00
7 - 0.6Dead + 0.7Earthquake EW	-0.20	0.19	0.00	0.00	0.00
8 - 0.6Dead + 0.7Earthquake NE	0.40	0.10	0.00	0.10	0.00

P11

Load Comb	Axial (kips)	Shear X (kips)	Mom Z (kip ft)	Shear Z (kips)	Mom X (kip ft)
1 - Dead	0.67	0.00	0.00	0.00	0.00
2 - Dead + Live	2.92	0.00	0.00	0.00	0.00
3 - Dead + 0.7Earthquake NS	0.06	0.00	0.00	0.19	0.00
4 - Dead + 0.7Earthquake EW	1.27	0.19	0.00	0.00	0.00
5 - Dead + 0.7Earthquake NE	0.67	0.10	0.00	0.10	0.00
6 - 0.6Dead + 0.7Earthquake NS	-0.20	0.00	0.00	0.19	0.00
7 - 0.6Dead + 0.7Earthquake EW	1.00	0.19	0.00	0.00	0.00
8 - 0.6Dead + 0.7Earthquake NE	0.40	0.10	0.00	0.10	0.00

P12

Load Comb	Axial (kips)	Shear X (kips)	Mom Z (kip ft)	Shear Z (kips)	Mom X (kip ft)
1 - Dead	0.67	0.00	0.00	0.00	0.00
2 - Dead + Live	2.92	0.00	0.00	0.00	0.00
3 - Dead + 0.7Earthquake NS	1.27	0.00	0.00	0.19	0.00
4 - Dead + 0.7Earthquake EW	1.27	0.19	0.00	0.00	0.00



Project: BGCAPP
 Job Number: 743341
 Calc. No.: 24915-10-DBC-00-00004
 Sheet No.: E-45 of E-80
 Sheet Rev.: D

Subject: Gas Bottle Canopy Misc Support Calculations
 By: M. Bratt Date: 10/5/2009

5 - Dead + 0.7Earthquake NE	1.52	0.10	0.00	0.10	0.00
6 - 0.6Dead + 0.7Earthquake NS	1.00	0.00	0.00	0.19	0.00
7 - 0.6Dead + 0.7Earthquake EW	1.00	0.19	0.00	0.00	0.00
8 - 0.6Dead + 0.7Earthquake NE	1.25	0.10	0.00	0.10	0.00

P13

Load Comb	Axial (kips)	Shear X (kips)	Mom Z (kip ft)	Shear Z (kips)	Mom X (kip ft)
1 - Dead	0.67	0.00	0.00	0.00	0.00
2 - Dead + Live	2.92	0.00	0.00	0.00	0.00
3 - Dead + 0.7Earthquake NS	0.06	0.00	0.00	0.19	0.00
4 - Dead + 0.7Earthquake EW	0.06	0.19	0.00	0.00	0.00
5 - Dead + 0.7Earthquake NE	-0.19	0.10	0.00	0.10	0.00
6 - 0.6Dead + 0.7Earthquake NS	-0.20	0.00	0.00	0.19	0.00
7 - 0.6Dead + 0.7Earthquake EW	-0.20	0.19	0.00	0.00	0.00
8 - 0.6Dead + 0.7Earthquake NE	-0.45	0.10	0.00	0.10	0.00

P14

Load Comb	Axial (kips)	Shear X (kips)	Mom Z (kip ft)	Shear Z (kips)	Mom X (kip ft)
1 - Dead	0.67	0.00	0.00	0.00	0.00
2 - Dead + Live	2.92	0.00	0.00	0.00	0.00
3 - Dead + 0.7Earthquake NS	1.27	0.00	0.00	0.19	0.00
4 - Dead + 0.7Earthquake EW	0.06	0.19	0.00	0.00	0.00
5 - Dead + 0.7Earthquake NE	0.67	0.10	0.00	0.10	0.00
6 - 0.6Dead + 0.7Earthquake NS	1.00	0.00	0.00	0.19	0.00
7 - 0.6Dead + 0.7Earthquake EW	-0.20	0.19	0.00	0.00	0.00
8 - 0.6Dead + 0.7Earthquake NE	0.40	0.10	0.00	0.10	0.00

P15

Load Comb	Axial (kips)	Shear X (kips)	Mom Z (kip ft)	Shear Z (kips)	Mom X (kip ft)
1 - Dead	0.67	0.00	0.00	0.00	0.00
2 - Dead + Live	2.92	0.00	0.00	0.00	0.00
3 - Dead + 0.7Earthquake NS	0.06	0.00	0.00	0.19	0.00



Project: BGCAPP
 Job Number: 743341
 Calc. No.: 24915-10-DBC-00-00004
 Sheet No.: E-46 of E-80
 Sheet Rev.: D

Subject: Gas Bottle Canopy Misc Support Calculations
 By: M. Bratt Date: 10/5/2009

4 - Dead + 0.7Earthquake EW	1.27	0.19	0.00	0.00	0.00
5 - Dead + 0.7Earthquake NE	0.67	0.10	0.00	0.10	0.00
6 - 0.6Dead + 0.7Earthquake NS	-0.20	0.00	0.00	0.19	0.00
7 - 0.6Dead + 0.7Earthquake EW	1.00	0.19	0.00	0.00	0.00
8 - 0.6Dead + 0.7Earthquake NE	0.40	0.10	0.00	0.10	0.00

P16

Load Comb	Axial (kips)	Shear X (kips)	Mom Z (kip ft)	Shear Z (kips)	Mom X (kip ft)
1 - Dead	0.67	0.00	0.00	0.00	0.00
2 - Dead + Live	2.92	0.00	0.00	0.00	0.00
3 - Dead + 0.7Earthquake NS	1.27	0.00	0.00	0.19	0.00
4 - Dead + 0.7Earthquake EW	1.27	0.19	0.00	0.00	0.00
5 - Dead + 0.7Earthquake NE	1.52	0.10	0.00	0.10	0.00
6 - 0.6Dead + 0.7Earthquake NS	1.00	0.00	0.00	0.19	0.00
7 - 0.6Dead + 0.7Earthquake EW	1.00	0.19	0.00	0.00	0.00
8 - 0.6Dead + 0.7Earthquake NE	1.25	0.10	0.00	0.10	0.00

P17

Load Comb	Axial (kips)	Shear X (kips)	Mom Z (kip ft)	Shear Z (kips)	Mom X (kip ft)
1 - Dead	0.67	0.00	0.00	0.00	0.00
2 - Dead + Live	2.92	0.00	0.00	0.00	0.00
3 - Dead + 0.7Earthquake NS	0.06	0.00	0.00	0.19	0.00
4 - Dead + 0.7Earthquake EW	0.06	0.19	0.00	0.00	0.00
5 - Dead + 0.7Earthquake NE	-0.19	0.10	0.00	0.10	0.00
6 - 0.6Dead + 0.7Earthquake NS	-0.20	0.00	0.00	0.19	0.00
7 - 0.6Dead + 0.7Earthquake EW	-0.20	0.19	0.00	0.00	0.00
8 - 0.6Dead + 0.7Earthquake NE	-0.45	0.10	0.00	0.10	0.00

P18

Load Comb	Axial (kips)	Shear X (kips)	Mom Z (kip ft)	Shear Z (kips)	Mom X (kip ft)
1 - Dead	0.67	0.00	0.00	0.00	0.00
2 - Dead + Live	2.92	0.00	0.00	0.00	0.00



Project: BGCAPP
 Job Number: 743341
 Calc. No.: 24915-10-DBC-00-00004
 Sheet No.: E-47 of E-80
 Sheet Rev.: D

Subject: Gas Bottle Canopy Misc Support Calculations
 By: M. Bratt Date: 10/5/2009

3 - Dead + 0.7Earthquake NS	1.27	0.00	0.00	0.19	0.00
4 - Dead + 0.7Earthquake EW	0.06	0.19	0.00	0.00	0.00
5 - Dead + 0.7Earthquake NE	0.67	0.10	0.00	0.10	0.00
6 - 0.6Dead + 0.7Earthquake NS	1.00	0.00	0.00	0.19	0.00
7 - 0.6Dead + 0.7Earthquake EW	-0.20	0.19	0.00	0.00	0.00
8 - 0.6Dead + 0.7Earthquake NE	0.40	0.10	0.00	0.10	0.00

P19

Load Comb	Axial (kips)	Shear X (kips)	Mom Z (kip ft)	Shear Z (kips)	Mom X (kip ft)
1 - Dead	0.67	0.00	0.00	0.00	0.00
2 - Dead + Live	2.92	0.00	0.00	0.00	0.00
3 - Dead + 0.7Earthquake NS	0.06	0.00	0.00	0.19	0.00
4 - Dead + 0.7Earthquake EW	1.27	0.19	0.00	0.00	0.00
5 - Dead + 0.7Earthquake NE	0.67	0.10	0.00	0.10	0.00
6 - 0.6Dead + 0.7Earthquake NS	-0.20	0.00	0.00	0.19	0.00
7 - 0.6Dead + 0.7Earthquake EW	1.00	0.19	0.00	0.00	0.00
8 - 0.6Dead + 0.7Earthquake NE	0.40	0.10	0.00	0.10	0.00

P20

Load Comb	Axial (kips)	Shear X (kips)	Mom Z (kip ft)	Shear Z (kips)	Mom X (kip ft)
1 - Dead	0.67	0.00	0.00	0.00	0.00
2 - Dead + Live	2.92	0.00	0.00	0.00	0.00
3 - Dead + 0.7Earthquake NS	1.27	0.00	0.00	0.19	0.00
4 - Dead + 0.7Earthquake EW	1.27	0.19	0.00	0.00	0.00
5 - Dead + 0.7Earthquake NE	1.52	0.10	0.00	0.10	0.00
6 - 0.6Dead + 0.7Earthquake NS	1.00	0.00	0.00	0.19	0.00
7 - 0.6Dead + 0.7Earthquake EW	1.00	0.19	0.00	0.00	0.00
8 - 0.6Dead + 0.7Earthquake NE	1.25	0.10	0.00	0.10	0.00

P21

Load Comb	Axial (kips)	Shear X (kips)	Mom Z (kip ft)	Shear Z (kips)	Mom X (kip ft)
1 - Dead	0.67	0.00	0.00	0.00	0.00



Project: BGCAPP
 Job Number: 743341
 Calc. No.: 24915-10-DBC-00-00004
 Sheet No.: E-48 of E-80
 Sheet Rev.: D

Subject: Gas Bottle Canopy Misc Support Calculations
 By: M. Bratt Date: 10/5/2009

2 - Dead + Live	2.92	0.00	0.00	0.00	0.00
3 - Dead + 0.7Earthquake NS	0.06	0.00	0.00	0.19	0.00
4 - Dead + 0.7Earthquake EW	0.06	0.19	0.00	0.00	0.00
5 - Dead + 0.7Earthquake NE	-0.19	0.10	0.00	0.10	0.00
6 - 0.6Dead + 0.7Earthquake NS	-0.20	0.00	0.00	0.19	0.00
7 - 0.6Dead + 0.7Earthquake EW	-0.20	0.19	0.00	0.00	0.00
8 - 0.6Dead + 0.7Earthquake NE	-0.45	0.10	0.00	0.10	0.00

P22

Load Comb	Axial (kips)	Shear X (kips)	Mom Z (kip ft)	Shear Z (kips)	Mom X (kip ft)
1 - Dead	0.67	0.00	0.00	0.00	0.00
2 - Dead + Live	2.92	0.00	0.00	0.00	0.00
3 - Dead + 0.7Earthquake NS	1.27	0.00	0.00	0.19	0.00
4 - Dead + 0.7Earthquake EW	0.06	0.19	0.00	0.00	0.00
5 - Dead + 0.7Earthquake NE	0.67	0.10	0.00	0.10	0.00
6 - 0.6Dead + 0.7Earthquake NS	1.00	0.00	0.00	0.19	0.00
7 - 0.6Dead + 0.7Earthquake EW	-0.20	0.19	0.00	0.00	0.00
8 - 0.6Dead + 0.7Earthquake NE	0.40	0.10	0.00	0.10	0.00

P23

Load Comb	Axial (kips)	Shear X (kips)	Mom Z (kip ft)	Shear Z (kips)	Mom X (kip ft)
1 - Dead	0.67	0.00	0.00	0.00	0.00
2 - Dead + Live	2.92	0.00	0.00	0.00	0.00
3 - Dead + 0.7Earthquake NS	0.06	0.00	0.00	0.19	0.00
4 - Dead + 0.7Earthquake EW	1.27	0.19	0.00	0.00	0.00
5 - Dead + 0.7Earthquake NE	0.67	0.10	0.00	0.10	0.00
6 - 0.6Dead + 0.7Earthquake NS	-0.20	0.00	0.00	0.19	0.00
7 - 0.6Dead + 0.7Earthquake EW	1.00	0.19	0.00	0.00	0.00
8 - 0.6Dead + 0.7Earthquake NE	0.40	0.10	0.00	0.10	0.00



Project: BGCAPP
 Job Number: 743341
 Calc. No.: 24915-10-DBC-00-00004
 Sheet No.: E-49 of E-80
 Sheet Rev.: D

Subject: Gas Bottle Canopy Misc Support Calculations
 By: M. Bratt Date: 10/5/2009

P24

Load Comb	Axial (kips)	Shear X (kips)	Mom Z (kip ft)	Shear Z (kips)	Mom X (kip ft)
1 - Dead	0.67	0.00	0.00	0.00	0.00
2 - Dead + Live	2.92	0.00	0.00	0.00	0.00
3 - Dead + 0.7Earthquake NS	1.27	0.00	0.00	0.19	0.00
4 - Dead + 0.7Earthquake EW	1.27	0.19	0.00	0.00	0.00
5 - Dead + 0.7Earthquake NE	1.52	0.10	0.00	0.10	0.00
6 - 0.6Dead + 0.7Earthquake NS	1.00	0.00	0.00	0.19	0.00
7 - 0.6Dead + 0.7Earthquake EW	1.00	0.19	0.00	0.00	0.00
8 - 0.6Dead + 0.7Earthquake NE	1.25	0.10	0.00	0.10	0.00

FACTORED (ULTIMATE) LOAD COMBINATIONS

P1

Load Comb	Axial (kips)	Shear X (kips)	Mom Z (kip ft)	Shear Z (kips)	Mom X (kip ft)
1 - 1.4Dead	0.93	0.00	0.00	0.00	0.00
2 - 1.2Dead + 1.6Live	4.41	0.00	0.00	0.00	0.00
3 - 1.2Dead + Live	3.06	0.00	0.00	0.00	0.00
4 - 1.2Dead + Earthquake NS	-0.06	0.00	0.00	0.27	0.00
5 - 1.2Dead + Earthquake EW	-0.06	0.27	0.00	0.00	0.00
6 - 1.2Dead + Earthquake NE	-0.42	0.14	0.00	0.14	0.00
7 - 0.9Dead + Earthquake NS	-0.26	0.00	0.00	0.27	0.00
8 - 0.9Dead + Earthquake EW	-0.26	0.27	0.00	0.00	0.00
9 - 0.9Dead + Earthquake NE	-0.62	0.14	0.00	0.14	0.00

P2

Load Comb	Axial (kips)	Shear X (kips)	Mom Z (kip ft)	Shear Z (kips)	Mom X (kip ft)
1 - 1.4Dead	0.93	0.00	0.00	0.00	0.00
2 - 1.2Dead + 1.6Live	4.41	0.00	0.00	0.00	0.00
3 - 1.2Dead + Live	3.06	0.00	0.00	0.00	0.00
4 - 1.2Dead + Earthquake NS	1.66	0.00	0.00	0.27	0.00
5 - 1.2Dead + Earthquake EW	-0.06	0.27	0.00	0.00	0.00
6 - 1.2Dead + Earthquake NE	0.80	0.14	0.00	0.14	0.00



Project: BGCAPP
 Job Number: 743341
 Calc. No.: 24915-10-DBC-00-00004
 Sheet No.: E-50 of E-80
 Sheet Rev.: D

Subject: Gas Bottle Canopy Misc Support Calculations
 By: M. Bratt Date: 10/5/2009

7 - 0.9Dead + Earthquake NS	1.46	0.00	0.00	0.27	0.00
8 - 0.9Dead + Earthquake EW	-0.26	0.27	0.00	0.00	0.00
9 - 0.9Dead + Earthquake NE	0.60	0.14	0.00	0.14	0.00

P3

Load Comb	Axial (kips)	Shear X (kips)	Mom Z (kip ft)	Shear Z (kips)	Mom X (kip ft)
1 - 1.4Dead	0.93	0.00	0.00	0.00	0.00
2 - 1.2Dead + 1.6Live	4.41	0.00	0.00	0.00	0.00
3 - 1.2Dead + Live	3.06	0.00	0.00	0.00	0.00
4 - 1.2Dead + Earthquake NS	-0.06	0.00	0.00	0.27	0.00
5 - 1.2Dead + Earthquake EW	1.66	0.27	0.00	0.00	0.00
6 - 1.2Dead + Earthquake NE	0.80	0.14	0.00	0.14	0.00
7 - 0.9Dead + Earthquake NS	-0.26	0.00	0.00	0.27	0.00
8 - 0.9Dead + Earthquake EW	1.46	0.27	0.00	0.00	0.00
9 - 0.9Dead + Earthquake NE	0.60	0.14	0.00	0.14	0.00

P4

Load Comb	Axial (kips)	Shear X (kips)	Mom Z (kip ft)	Shear Z (kips)	Mom X (kip ft)
1 - 1.4Dead	0.93	0.00	0.00	0.00	0.00
2 - 1.2Dead + 1.6Live	4.41	0.00	0.00	0.00	0.00
3 - 1.2Dead + Live	3.06	0.00	0.00	0.00	0.00
4 - 1.2Dead + Earthquake NS	1.66	0.00	0.00	0.27	0.00
5 - 1.2Dead + Earthquake EW	1.66	0.27	0.00	0.00	0.00
6 - 1.2Dead + Earthquake NE	2.02	0.14	0.00	0.14	0.00
7 - 0.9Dead + Earthquake NS	1.46	0.00	0.00	0.27	0.00
8 - 0.9Dead + Earthquake EW	1.46	0.27	0.00	0.00	0.00
9 - 0.9Dead + Earthquake NE	1.82	0.14	0.00	0.14	0.00

P5

Load Comb	Axial (kips)	Shear X (kips)	Mom Z (kip ft)	Shear Z (kips)	Mom X (kip ft)
1 - 1.4Dead	0.93	0.00	0.00	0.00	0.00
2 - 1.2Dead + 1.6Live	4.41	0.00	0.00	0.00	0.00



Project: BGCAPP
 Job Number: 743341
 Calc. No.: 24915-10-DBC-00-00004
 Sheet No.: E-51 of E-80
 Sheet Rev.: D

Subject: Gas Bottle Canopy Misc Support Calculations
 By: M. Bratt Date: 10/5/2009

3 - 1.2Dead + Live	3.06	0.00	0.00	0.00	0.00
4 - 1.2Dead + Earthquake NS	-0.06	0.00	0.00	0.27	0.00
5 - 1.2Dead + Earthquake EW	-0.06	0.27	0.00	0.00	0.00
6 - 1.2Dead + Earthquake NE	-0.42	0.14	0.00	0.14	0.00
7 - 0.9Dead + Earthquake NS	-0.26	0.00	0.00	0.27	0.00
8 - 0.9Dead + Earthquake EW	-0.26	0.27	0.00	0.00	0.00
9 - 0.9Dead + Earthquake NE	-0.62	0.14	0.00	0.14	0.00

P6

Load Comb	Axial (kips)	Shear X (kips)	Mom Z (kip ft)	Shear Z (kips)	Mom X (kip ft)
1 - 1.4Dead	0.93	0.00	0.00	0.00	0.00
2 - 1.2Dead + 1.6Live	4.41	0.00	0.00	0.00	0.00
3 - 1.2Dead + Live	3.06	0.00	0.00	0.00	0.00
4 - 1.2Dead + Earthquake NS	1.66	0.00	0.00	0.27	0.00
5 - 1.2Dead + Earthquake EW	-0.06	0.27	0.00	0.00	0.00
6 - 1.2Dead + Earthquake NE	0.80	0.14	0.00	0.14	0.00
7 - 0.9Dead + Earthquake NS	1.46	0.00	0.00	0.27	0.00
8 - 0.9Dead + Earthquake EW	-0.26	0.27	0.00	0.00	0.00
9 - 0.9Dead + Earthquake NE	0.60	0.14	0.00	0.14	0.00

P7

Load Comb	Axial (kips)	Shear X (kips)	Mom Z (kip ft)	Shear Z (kips)	Mom X (kip ft)
1 - 1.4Dead	0.93	0.00	0.00	0.00	0.00
2 - 1.2Dead + 1.6Live	4.41	0.00	0.00	0.00	0.00
3 - 1.2Dead + Live	3.06	0.00	0.00	0.00	0.00
4 - 1.2Dead + Earthquake NS	-0.06	0.00	0.00	0.27	0.00
5 - 1.2Dead + Earthquake EW	1.66	0.27	0.00	0.00	0.00
6 - 1.2Dead + Earthquake NE	0.80	0.14	0.00	0.14	0.00
7 - 0.9Dead + Earthquake NS	-0.26	0.00	0.00	0.27	0.00
8 - 0.9Dead + Earthquake EW	1.46	0.27	0.00	0.00	0.00
9 - 0.9Dead + Earthquake NE	0.60	0.14	0.00	0.14	0.00



Project: BGCAPP
 Job Number: 743341
 Calc. No.: 24915-10-DBC-00-00004
 Sheet No.: E-52 of E-80
 Sheet Rev.: D

Subject: Gas Bottle Canopy Misc Support Calculations
 By: M. Bratt Date: 10/5/2009

P8

Load Comb	Axial (kips)	Shear X (kips)	Mom Z (kip ft)	Shear Z (kips)	Mom X (kip ft)
1 - 1.4Dead	0.93	0.00	0.00	0.00	0.00
2 - 1.2Dead + 1.6Live	4.41	0.00	0.00	0.00	0.00
3 - 1.2Dead + Live	3.06	0.00	0.00	0.00	0.00
4 - 1.2Dead + Earthquake NS	1.66	0.00	0.00	0.27	0.00
5 - 1.2Dead + Earthquake EW	1.66	0.27	0.00	0.00	0.00
6 - 1.2Dead + Earthquake NE	2.02	0.14	0.00	0.14	0.00
7 - 0.9Dead + Earthquake NS	1.46	0.00	0.00	0.27	0.00
8 - 0.9Dead + Earthquake EW	1.46	0.27	0.00	0.00	0.00
9 - 0.9Dead + Earthquake NE	1.82	0.14	0.00	0.14	0.00

P9

Load Comb	Axial (kips)	Shear X (kips)	Mom Z (kip ft)	Shear Z (kips)	Mom X (kip ft)
1 - 1.4Dead	0.93	0.00	0.00	0.00	0.00
2 - 1.2Dead + 1.6Live	4.41	0.00	0.00	0.00	0.00
3 - 1.2Dead + Live	3.06	0.00	0.00	0.00	0.00
4 - 1.2Dead + Earthquake NS	-0.06	0.00	0.00	0.27	0.00
5 - 1.2Dead + Earthquake EW	-0.06	0.27	0.00	0.00	0.00
6 - 1.2Dead + Earthquake NE	-0.42	0.14	0.00	0.14	0.00
7 - 0.9Dead + Earthquake NS	-0.26	0.00	0.00	0.27	0.00
8 - 0.9Dead + Earthquake EW	-0.26	0.27	0.00	0.00	0.00
9 - 0.9Dead + Earthquake NE	-0.62	0.14	0.00	0.14	0.00

P10

Load Comb	Axial (kips)	Shear X (kips)	Mom Z (kip ft)	Shear Z (kips)	Mom X (kip ft)
1 - 1.4Dead	0.93	0.00	0.00	0.00	0.00
2 - 1.2Dead + 1.6Live	4.41	0.00	0.00	0.00	0.00
3 - 1.2Dead + Live	3.06	0.00	0.00	0.00	0.00
4 - 1.2Dead + Earthquake NS	1.66	0.00	0.00	0.27	0.00
5 - 1.2Dead + Earthquake EW	-0.06	0.27	0.00	0.00	0.00
6 - 1.2Dead + Earthquake NE	0.80	0.14	0.00	0.14	0.00
7 - 0.9Dead + Earthquake NS	1.46	0.00	0.00	0.27	0.00



Project: BGCAPP
 Job Number: 743341
 Calc. No.: 24915-10-DBC-00-00004
 Sheet No.: E-53 of E-80
 Sheet Rev.: D

Subject: Gas Bottle Canopy Misc Support Calculations
 By: M. Bratt Date: 10/5/2009

8 - 0.9Dead + Earthquake EW	-0.26	0.27	0.00	0.00	0.00
9 - 0.9Dead + Earthquake NE	0.60	0.14	0.00	0.14	0.00

P11

Load Comb	Axial (kips)	Shear X (kips)	Mom Z (kip ft)	Shear Z (kips)	Mom X (kip ft)
1 - 1.4Dead	0.93	0.00	0.00	0.00	0.00
2 - 1.2Dead + 1.6Live	4.41	0.00	0.00	0.00	0.00
3 - 1.2Dead + Live	3.06	0.00	0.00	0.00	0.00
4 - 1.2Dead + Earthquake NS	-0.06	0.00	0.00	0.27	0.00
5 - 1.2Dead + Earthquake EW	1.66	0.27	0.00	0.00	0.00
6 - 1.2Dead + Earthquake NE	0.80	0.14	0.00	0.14	0.00
7 - 0.9Dead + Earthquake NS	-0.26	0.00	0.00	0.27	0.00
8 - 0.9Dead + Earthquake EW	1.46	0.27	0.00	0.00	0.00
9 - 0.9Dead + Earthquake NE	0.60	0.14	0.00	0.14	0.00

P12

Load Comb	Axial (kips)	Shear X (kips)	Mom Z (kip ft)	Shear Z (kips)	Mom X (kip ft)
1 - 1.4Dead	0.93	0.00	0.00	0.00	0.00
2 - 1.2Dead + 1.6Live	4.41	0.00	0.00	0.00	0.00
3 - 1.2Dead + Live	3.06	0.00	0.00	0.00	0.00
4 - 1.2Dead + Earthquake NS	1.66	0.00	0.00	0.27	0.00
5 - 1.2Dead + Earthquake EW	1.66	0.27	0.00	0.00	0.00
6 - 1.2Dead + Earthquake NE	2.02	0.14	0.00	0.14	0.00
7 - 0.9Dead + Earthquake NS	1.46	0.00	0.00	0.27	0.00
8 - 0.9Dead + Earthquake EW	1.46	0.27	0.00	0.00	0.00
9 - 0.9Dead + Earthquake NE	1.82	0.14	0.00	0.14	0.00

P13

Load Comb	Axial (kips)	Shear X (kips)	Mom Z (kip ft)	Shear Z (kips)	Mom X (kip ft)
1 - 1.4Dead	0.93	0.00	0.00	0.00	0.00
2 - 1.2Dead + 1.6Live	4.41	0.00	0.00	0.00	0.00
3 - 1.2Dead + Live	3.06	0.00	0.00	0.00	0.00



Project: BGCAPP
 Job Number: 743341
 Calc. No.: 24915-10-DBC-00-00004
 Sheet No.: E-54 of E-80
 Sheet Rev.: D

Subject: Gas Bottle Canopy Misc Support Calculations
 By: M. Bratt Date: 10/5/2009

4 - 1.2Dead + Earthquake NS	-0.06	0.00	0.00	0.27	0.00
5 - 1.2Dead + Earthquake EW	-0.06	0.27	0.00	0.00	0.00
6 - 1.2Dead + Earthquake NE	-0.42	0.14	0.00	0.14	0.00
7 - 0.9Dead + Earthquake NS	-0.26	0.00	0.00	0.27	0.00
8 - 0.9Dead + Earthquake EW	-0.26	0.27	0.00	0.00	0.00
9 - 0.9Dead + Earthquake NE	-0.62	0.14	0.00	0.14	0.00

P14

Load Comb	Axial (kips)	Shear X (kips)	Mom Z (kip ft)	Shear Z (kips)	Mom X (kip ft)
1 - 1.4Dead	0.93	0.00	0.00	0.00	0.00
2 - 1.2Dead + 1.6Live	4.41	0.00	0.00	0.00	0.00
3 - 1.2Dead + Live	3.06	0.00	0.00	0.00	0.00
4 - 1.2Dead + Earthquake NS	1.66	0.00	0.00	0.27	0.00
5 - 1.2Dead + Earthquake EW	-0.06	0.27	0.00	0.00	0.00
6 - 1.2Dead + Earthquake NE	0.80	0.14	0.00	0.14	0.00
7 - 0.9Dead + Earthquake NS	1.46	0.00	0.00	0.27	0.00
8 - 0.9Dead + Earthquake EW	-0.26	0.27	0.00	0.00	0.00
9 - 0.9Dead + Earthquake NE	0.60	0.14	0.00	0.14	0.00

P15

Load Comb	Axial (kips)	Shear X (kips)	Mom Z (kip ft)	Shear Z (kips)	Mom X (kip ft)
1 - 1.4Dead	0.93	0.00	0.00	0.00	0.00
2 - 1.2Dead + 1.6Live	4.41	0.00	0.00	0.00	0.00
3 - 1.2Dead + Live	3.06	0.00	0.00	0.00	0.00
4 - 1.2Dead + Earthquake NS	-0.06	0.00	0.00	0.27	0.00
5 - 1.2Dead + Earthquake EW	1.66	0.27	0.00	0.00	0.00
6 - 1.2Dead + Earthquake NE	0.80	0.14	0.00	0.14	0.00
7 - 0.9Dead + Earthquake NS	-0.26	0.00	0.00	0.27	0.00
8 - 0.9Dead + Earthquake EW	1.46	0.27	0.00	0.00	0.00
9 - 0.9Dead + Earthquake NE	0.60	0.14	0.00	0.14	0.00



Project: BGCAPP
 Job Number: 743341
 Calc. No.: 24915-10-DBC-00-00004
 Sheet No.: E-55 of E-80
 Sheet Rev.: D

Subject: Gas Bottle Canopy Misc Support Calculations
 By: M. Bratt Date: 10/5/2009

P16

Load Comb	Axial (kips)	Shear X (kips)	Mom Z (kip ft)	Shear Z (kips)	Mom X (kip ft)
1 - 1.4Dead	0.93	0.00	0.00	0.00	0.00
2 - 1.2Dead + 1.6Live	4.41	0.00	0.00	0.00	0.00
3 - 1.2Dead + Live	3.06	0.00	0.00	0.00	0.00
4 - 1.2Dead + Earthquake NS	1.66	0.00	0.00	0.27	0.00
5 - 1.2Dead + Earthquake EW	1.66	0.27	0.00	0.00	0.00
6 - 1.2Dead + Earthquake NE	2.02	0.14	0.00	0.14	0.00
7 - 0.9Dead + Earthquake NS	1.46	0.00	0.00	0.27	0.00
8 - 0.9Dead + Earthquake EW	1.46	0.27	0.00	0.00	0.00
9 - 0.9Dead + Earthquake NE	1.82	0.14	0.00	0.14	0.00

P17

Load Comb	Axial (kips)	Shear X (kips)	Mom Z (kip ft)	Shear Z (kips)	Mom X (kip ft)
1 - 1.4Dead	0.93	0.00	0.00	0.00	0.00
2 - 1.2Dead + 1.6Live	4.41	0.00	0.00	0.00	0.00
3 - 1.2Dead + Live	3.06	0.00	0.00	0.00	0.00
4 - 1.2Dead + Earthquake NS	-0.06	0.00	0.00	0.27	0.00
5 - 1.2Dead + Earthquake EW	-0.06	0.27	0.00	0.00	0.00
6 - 1.2Dead + Earthquake NE	-0.42	0.14	0.00	0.14	0.00
7 - 0.9Dead + Earthquake NS	-0.26	0.00	0.00	0.27	0.00
8 - 0.9Dead + Earthquake EW	-0.26	0.27	0.00	0.00	0.00
9 - 0.9Dead + Earthquake NE	-0.62	0.14	0.00	0.14	0.00

P18

Load Comb	Axial (kips)	Shear X (kips)	Mom Z (kip ft)	Shear Z (kips)	Mom X (kip ft)
1 - 1.4Dead	0.93	0.00	0.00	0.00	0.00
2 - 1.2Dead + 1.6Live	4.41	0.00	0.00	0.00	0.00
3 - 1.2Dead + Live	3.06	0.00	0.00	0.00	0.00
4 - 1.2Dead + Earthquake NS	1.66	0.00	0.00	0.27	0.00
5 - 1.2Dead + Earthquake EW	-0.06	0.27	0.00	0.00	0.00
6 - 1.2Dead + Earthquake NE	0.80	0.14	0.00	0.14	0.00
7 - 0.9Dead + Earthquake NS	1.46	0.00	0.00	0.27	0.00



Project: BGCAPP
 Job Number: 743341
 Calc. No.: 24915-10-DBC-00-00004
 Sheet No.: E-56 of E-80
 Sheet Rev.: D

Subject: Gas Bottle Canopy Misc Support Calculations
 By: M. Bratt Date: 10/5/2009

8 - 0.9Dead + Earthquake EW	-0.26	0.27	0.00	0.00	0.00
9 - 0.9Dead + Earthquake NE	0.60	0.14	0.00	0.14	0.00

P19

Load Comb	Axial (kips)	Shear X (kips)	Mom Z (kip ft)	Shear Z (kips)	Mom X (kip ft)
1 - 1.4Dead	0.93	0.00	0.00	0.00	0.00
2 - 1.2Dead + 1.6Live	4.41	0.00	0.00	0.00	0.00
3 - 1.2Dead + Live	3.06	0.00	0.00	0.00	0.00
4 - 1.2Dead + Earthquake NS	-0.06	0.00	0.00	0.27	0.00
5 - 1.2Dead + Earthquake EW	1.66	0.27	0.00	0.00	0.00
6 - 1.2Dead + Earthquake NE	0.80	0.14	0.00	0.14	0.00
7 - 0.9Dead + Earthquake NS	-0.26	0.00	0.00	0.27	0.00
8 - 0.9Dead + Earthquake EW	1.46	0.27	0.00	0.00	0.00
9 - 0.9Dead + Earthquake NE	0.60	0.14	0.00	0.14	0.00

P20

Load Comb	Axial (kips)	Shear X (kips)	Mom Z (kip ft)	Shear Z (kips)	Mom X (kip ft)
1 - 1.4Dead	0.93	0.00	0.00	0.00	0.00
2 - 1.2Dead + 1.6Live	4.41	0.00	0.00	0.00	0.00
3 - 1.2Dead + Live	3.06	0.00	0.00	0.00	0.00
4 - 1.2Dead + Earthquake NS	1.66	0.00	0.00	0.27	0.00
5 - 1.2Dead + Earthquake EW	1.66	0.27	0.00	0.00	0.00
6 - 1.2Dead + Earthquake NE	2.02	0.14	0.00	0.14	0.00
7 - 0.9Dead + Earthquake NS	1.46	0.00	0.00	0.27	0.00
8 - 0.9Dead + Earthquake EW	1.46	0.27	0.00	0.00	0.00
9 - 0.9Dead + Earthquake NE	1.82	0.14	0.00	0.14	0.00

P21

Load Comb	Axial (kips)	Shear X (kips)	Mom Z (kip ft)	Shear Z (kips)	Mom X (kip ft)
1 - 1.4Dead	0.93	0.00	0.00	0.00	0.00
2 - 1.2Dead + 1.6Live	4.41	0.00	0.00	0.00	0.00
3 - 1.2Dead + Live	3.06	0.00	0.00	0.00	0.00



Project: BGCAPP
 Job Number: 743341
 Calc. No.: 24915-10-DBC-00-00004
 Sheet No.: E-57 of E-80
 Sheet Rev.: D

Subject: Gas Bottle Canopy Misc Support Calculations
 By: M. Bratt Date: 10/5/2009

4 - 1.2Dead + Earthquake NS	-0.06	0.00	0.00	0.27	0.00
5 - 1.2Dead + Earthquake EW	-0.06	0.27	0.00	0.00	0.00
6 - 1.2Dead + Earthquake NE	-0.42	0.14	0.00	0.14	0.00
7 - 0.9Dead + Earthquake NS	-0.26	0.00	0.00	0.27	0.00
8 - 0.9Dead + Earthquake EW	-0.26	0.27	0.00	0.00	0.00
9 - 0.9Dead + Earthquake NE	-0.62	0.14	0.00	0.14	0.00

P22

Load Comb	Axial (kips)	Shear X (kips)	Mom Z (kip ft)	Shear Z (kips)	Mom X (kip ft)
1 - 1.4Dead	0.93	0.00	0.00	0.00	0.00
2 - 1.2Dead + 1.6Live	4.41	0.00	0.00	0.00	0.00
3 - 1.2Dead + Live	3.06	0.00	0.00	0.00	0.00
4 - 1.2Dead + Earthquake NS	1.66	0.00	0.00	0.27	0.00
5 - 1.2Dead + Earthquake EW	-0.06	0.27	0.00	0.00	0.00
6 - 1.2Dead + Earthquake NE	0.80	0.14	0.00	0.14	0.00
7 - 0.9Dead + Earthquake NS	1.46	0.00	0.00	0.27	0.00
8 - 0.9Dead + Earthquake EW	-0.26	0.27	0.00	0.00	0.00
9 - 0.9Dead + Earthquake NE	0.60	0.14	0.00	0.14	0.00

P23

Load Comb	Axial (kips)	Shear X (kips)	Mom Z (kip ft)	Shear Z (kips)	Mom X (kip ft)
1 - 1.4Dead	0.93	0.00	0.00	0.00	0.00
2 - 1.2Dead + 1.6Live	4.41	0.00	0.00	0.00	0.00
3 - 1.2Dead + Live	3.06	0.00	0.00	0.00	0.00
4 - 1.2Dead + Earthquake NS	-0.06	0.00	0.00	0.27	0.00
5 - 1.2Dead + Earthquake EW	1.66	0.27	0.00	0.00	0.00
6 - 1.2Dead + Earthquake NE	0.80	0.14	0.00	0.14	0.00
7 - 0.9Dead + Earthquake NS	-0.26	0.00	0.00	0.27	0.00
8 - 0.9Dead + Earthquake EW	1.46	0.27	0.00	0.00	0.00
9 - 0.9Dead + Earthquake NE	0.60	0.14	0.00	0.14	0.00



Project: BGCAPP
 Job Number: 743341
 Calc. No.: 24915-10-DBC-00-00004
 Sheet No.: E-58 of E-80
 Sheet Rev.: D

Subject: Gas Bottle Canopy Misc Support Calculations
 By: M. Bratt Date: 10/5/2009

P24

Load Comb	Axial (kips)	Shear X (kips)	Mom Z (kip ft)	Shear Z (kips)	Mom X (kip ft)
1 - 1.4Dead	0.93	0.00	0.00	0.00	0.00
2 - 1.2Dead + 1.6Live	4.41	0.00	0.00	0.00	0.00
3 - 1.2Dead + Live	3.06	0.00	0.00	0.00	0.00
4 - 1.2Dead + Earthquake NS	1.66	0.00	0.00	0.27	0.00
5 - 1.2Dead + Earthquake EW	1.66	0.27	0.00	0.00	0.00
6 - 1.2Dead + Earthquake NE	2.02	0.14	0.00	0.14	0.00
7 - 0.9Dead + Earthquake NS	1.46	0.00	0.00	0.27	0.00
8 - 0.9Dead + Earthquake EW	1.46	0.27	0.00	0.00	0.00
9 - 0.9Dead + Earthquake NE	1.82	0.14	0.00	0.14	0.00

BEARING CAPACITY - LINEAR SOIL PRESSURE METHOD

Load Comb	Max Pressure (ksf)	All Pressure (ksf)	Ecc N/S Dir (ft)	Ecc E/W Dir (ft)	Moment N/S axis (kip-ft)	Moment E/W axis (kip-ft)	Rem
1 - Dead	0.62	3.30	0.01	0.00	0.00	1.03	
2 - Dead + Live	1.07	3.30	0.03	0.00	0.01	4.48	
3 - Dead + 0.7Earthquake NS	0.99	4.30	0.47	0.00	0.00	37.59	
4 - Dead + 0.7Earthquake EW	0.68	4.30	0.01	0.48	38.35	1.13	
5 - Dead + 0.7Earthquake NE	0.88	4.30	0.29	0.30	24.32	23.41	
6 - 0.6Dead + 0.7Earthquake NS	0.75	4.30	0.79	0.00	0.00	38.00	
7 - 0.6Dead + 0.7Earthquake EW	0.43	4.30	0.01	0.80	38.35	0.72	
8 - 0.6Dead + 0.7Earthquake NE	0.65	4.30	0.49	0.50	24.31	23.82	

STABILITY RATIO / SLIDING SAFETY FACTOR

Load Comb	S.R. N/S Dir	S.R. E/W Dir	All S.R.	Sliding FS - N/S	Sliding FS - E/W	All FS	Remarks
1 - Dead	100.00	100.00	1.50	100.00	100.00	1.50	
2 - Dead + Live	100.00	100.00	1.50	100.00	100.00	1.50	
3 - Dead + 0.7Earthquake NS	10.28	100.00	1.50	29.28	100.00	1.50	
4 - Dead + 0.7Earthquake EW	100.00	74.65	1.50	100.00	11.99	1.50	
5 - Dead + 0.7Earthquake NE	13.61	44.90	1.50	55.68	22.80	1.50	
6 - 0.6Dead + 0.7Earthquake NS	6.14	100.00	1.50	25.74	100.00	1.50	
7 - 0.6Dead + 0.7Earthquake EW	30.70	19.98	1.50	100.00	8.45	1.50	



Project: BGCAPP
Job Number: 743341
Calc. No.: 24915-10-DBC-00-00004
Sheet No.: E-60 of E-80
Sheet Rev.: D

Subject: Gas Bottle Canopy Misc Support Calculations
By: M. Bratt Date: 10/5/2009

P2

Control Comb	Net Ult Load (kips)	Punch. Stress (psi)	All Stress (psi)	Rem
4. 1.2Dead + Earthquake NS	0.87	0.44	215.04	

P3

Control Comb	Net Ult Load (kips)	Punch. Stress (psi)	All Stress (psi)	Rem
8. 0.9Dead + Earthquake EW	1.08	0.31	215.04	

P4

Control Comb	Net Ult Load (kips)	Punch. Stress (psi)	All Stress (psi)	Rem
9. 0.9Dead + Earthquake NE	1.25	0.36	215.04	

P5

Control Comb	Net Ult Load (kips)	Punch. Stress (psi)	All Stress (psi)	Rem
7. 0.9Dead + Earthquake NS	0.93	0.27	215.04	



Project: BGCAPP
Job Number: 743341
Calc. No.: 24915-10-DBC-00-00004
Sheet No.: E-61 of E-80
Sheet Rev.: D

Subject: Gas Bottle Canopy Misc Support Calculations
By: M. Bratt Date: 10/5/2009

P6

Control Comb	Net Ult Load (kips)	Punch. Stress (psi)	All Stress (psi)	Rem
7. 0.9Dead + Earthquake NS	0.56	0.16	215.04	

P7

Control Comb	Net Ult Load (kips)	Punch. Stress (psi)	All Stress (psi)	Rem
9. 0.9Dead + Earthquake NE	1.08	0.33	215.04	

P8

Control Comb	Net Ult Load (kips)	Punch. Stress (psi)	All Stress (psi)	Rem
9. 0.9Dead + Earthquake NE	1.09	0.32	215.04	

P9

Control Comb	Net Ult Load (kips)	Punch. Stress (psi)	All Stress (psi)	Rem
7. 0.9Dead + Earthquake NS	1.01	0.30	215.04	



Project: BGCAPP
Job Number: 743341
Calc. No.: 24915-10-DBC-00-00004
Sheet No.: E-62 of E-80
Sheet Rev.: D

Subject: Gas Bottle Canopy Misc Support Calculations
By: M. Bratt Date: 10/5/2009

P10

Control Comb	Net Ult Load (kips)	Punch. Stress (psi)	All Stress (psi)	Rem
7. 0.9Dead + Earthquake NS	0.56	0.16	215.04	

P11

Control Comb	Net Ult Load (kips)	Punch. Stress (psi)	All Stress (psi)	Rem
9. 0.9Dead + Earthquake NE	1.08	0.33	215.04	

P12

Control Comb	Net Ult Load (kips)	Punch. Stress (psi)	All Stress (psi)	Rem
9. 0.9Dead + Earthquake NE	0.94	0.27	215.04	

P13

Control Comb	Net Ult Load (kips)	Punch. Stress (psi)	All Stress (psi)	Rem
7. 0.9Dead + Earthquake NS	1.01	0.30	215.04	



Project: BGCAPP
Job Number: 743341
Calc. No.: 24915-10-DBC-00-00004
Sheet No.: E-63 of E-80
Sheet Rev.: D

Subject: Gas Bottle Canopy Misc Support Calculations
By: M. Bratt Date: 10/5/2009

P14

Control Comb	Net Ult Load (kips)	Punch. Stress (psi)	All Stress (psi)	Rem
7. 0.9Dead + Earthquake NS	0.56	0.16	215.04	

P15

Control Comb	Net Ult Load (kips)	Punch. Stress (psi)	All Stress (psi)	Rem
9. 0.9Dead + Earthquake NE	1.08	0.33	215.04	

P16

Control Comb	Net Ult Load (kips)	Punch. Stress (psi)	All Stress (psi)	Rem
9. 0.9Dead + Earthquake NE	0.79	0.23	215.04	

P17

Control Comb	Net Ult Load (kips)	Punch. Stress (psi)	All Stress (psi)	Rem
7. 0.9Dead + Earthquake NS	1.01	0.30	215.04	



Project: BGCAPP
Job Number: 743341
Calc. No.: 24915-10-DBC-00-00004
Sheet No.: E-64 of E-80
Sheet Rev.: D

Subject: Gas Bottle Canopy Misc Support Calculations
By: M. Bratt Date: 10/5/2009

P18

Control Comb	Net Ult Load (kips)	Punch. Stress (psi)	All Stress (psi)	Rem
7. 0.9Dead + Earthquake NS	0.56	0.16	215.04	

P19

Control Comb	Net Ult Load (kips)	Punch. Stress (psi)	All Stress (psi)	Rem
9. 0.9Dead + Earthquake NE	1.08	0.33	215.04	

P20

Control Comb	Net Ult Load (kips)	Punch. Stress (psi)	All Stress (psi)	Rem
9. 0.9Dead + Earthquake NE	0.63	0.18	215.04	

P21

Control Comb	Net Ult Load (kips)	Punch. Stress (psi)	All Stress (psi)	Rem
7. 0.9Dead + Earthquake NS	1.01	0.30	215.04	



Project: BGCAPP
 Job Number: 743341
 Calc. No.: 24915-10-DBC-00-00004
 Sheet No.: E-65 of E-80
 Sheet Rev.: D

Subject: Gas Bottle Canopy Misc Support Calculations
 By: M. Bratt Date: 10/5/2009

P22

Control Comb	Net Ult Load (kips)	Punch. Stress (psi)	All Stress (psi)	Rem
7. 0.9Dead + Earthquake NS	0.56	0.16	215.04	

P23

Control Comb	Net Ult Load (kips)	Punch. Stress (psi)	All Stress (psi)	Rem
6. 1.2Dead + Earthquake NE	0.93	0.49	215.04	

P24

Control Comb	Net Ult Load (kips)	Punch. Stress (psi)	All Stress (psi)	Rem
6. 1.2Dead + Earthquake NE	0.95	0.49	215.04	

MAXIMUM SHEAR - X DIRECTION

Load Comb	Left Dist (ft)	Max Shear (kips)	Shear Stress (psi)	All Stress (psi)	Rem
1 - 1.4Dead	2.37	-1.93	1.02	107.52	
2 - 1.2Dead + 1.6Live	2.37	-9.07	4.80	107.52	
3 - 1.2Dead + Live	2.37	-6.29	3.33	107.52	
4 - 1.2Dead + Earthquake NS	26.88	1.65	0.88	107.52	
5 - 1.2Dead + Earthquake EW	12.37	-4.23	2.24	107.52	
6 - 1.2Dead + Earthquake NE	12.37	-3.23	1.71	107.52	
7 - 0.9Dead + Earthquake NS	2.37	-1.24	0.66	107.52	



Project: BGCAPP
 Job Number: 743341
 Calc. No.: 24915-10-DBC-00-00004
 Sheet No.: E-66 of E-80
 Sheet Rev.: D

Subject: Gas Bottle Canopy Misc Support Calculations
 By: M. Bratt Date: 10/5/2009

8 - 0.9Dead + Earthquake EW	12.37	-3.86	2.04	107.52
9 - 0.9Dead + Earthquake NE	12.37	-2.86	1.51	107.52

MAXIMUM SHEAR - Z DIRECTION

Load Comb	Bottom Dist (ft)	Max Shear (kips)	Shear Stress (psi)	All Stress (psi)	Rem
1 - 1.4Dead	3.71	10.40	0.85	107.52	
2 - 1.2Dead + 1.6Live	3.71	48.88	3.98	107.52	
3 - 1.2Dead + Live	3.71	33.89	2.76	107.52	
4 - 1.2Dead + Earthquake NS	3.88	8.71	0.71	107.52	
5 - 1.2Dead + Earthquake EW	0.00	-8.12	0.66	107.52	
6 - 1.2Dead + Earthquake NE	3.88	8.91	0.73	107.52	
7 - 0.9Dead + Earthquake NS	3.88	6.92	0.56	107.52	
8 - 0.9Dead + Earthquake EW	0.00	-6.30	0.51	107.52	
9 - 0.9Dead + Earthquake NE	3.88	7.12	0.58	107.52	

PIER/BASE PLATE DESIGN INFORMATION

	P1	P2	P3	P4	P5	P6	P7
X Dim (ft)	0.50	0.50	0.50	0.50	0.50	0.50	0.50
Z Dim (ft)	0.50	0.50	0.50	0.50	0.50	0.50	0.50
Height (ft)	0.15	0.15	0.15	0.15	0.15	0.15	0.15
X Offset (ft)	0.54	0.54	3.71	3.71	5.54	5.54	8.71
Z Offset (ft)	0.71	3.79	0.71	3.79	0.71	3.79	0.54
Requested Reinf. Ratio	0.0018	0.0018	0.0018	0.0018	0.0018	0.0018	0.0018
Provided Reinf. Ratio	0.0000	0.0000	0.0000	0.0000	0.0000	0.0000	0.0000
Long Bar Size	0	0	0	0	0	0	0
Bars in X Dir	0	0	0	0	0	0	0
Bars in Z Dir	0	0	0	0	0	0	0
Total Long Bars	0	0	0	0	0	0	0
Tie Bar Size	3	3	3	3	3	3	3
Total No. of Ties	0	0	0	0	0	0	0
Major Tie Spacing (in)	-3	-3	-3	-3	-3	-3	-3

	P8	P9	P10	P11	P12	P13	P14
X Dim (ft)	0.50	0.50	0.50	0.50	0.50	0.50	0.50
Z Dim (ft)	0.50	0.50	0.50	0.50	0.50	0.50	0.50
Height (ft)	0.15	0.15	0.15	0.15	0.15	0.15	0.15
X Offset (ft)	8.71	10.54	10.54	13.71	13.71	15.54	15.54
Z Offset (ft)	3.79	0.54	3.79	0.54	3.79	0.54	3.79



Project: BGCAPP
 Job Number: 743341
 Calc. No.: 24915-10-DBC-00-00004
 Sheet No.: E-67 of E-80
 Sheet Rev.: D

Subject: Gas Bottle Canopy Misc Support Calculations
 By: M. Bratt Date: 10/5/2009

Requested Reinf. Ratio	0.0018	0.0018	0.0018	0.0018	0.0018	0.0018	0.0018
Provided Reinf. Ratio	0.0000	0.0000	0.0000	0.0000	0.0000	0.0000	0.0000
Long Bar Size	0	0	0	0	0	0	0
Bars in X Dir	0	0	0	0	0	0	0
Bars in Z Dir	0	0	0	0	0	0	0
Total Long Bars	0	0	0	0	0	0	0
Tie Bar Size	3	3	3	3	3	3	3
Total No. of Ties	0	0	0	0	0	0	0
Major Tie Spacing (in)	-3	-3	-3	-3	-3	-3	-3


	P15	P16	P17	P18	P19	P20	P21
X Dim (ft)	0.50	0.50	0.50	0.50	0.50	0.50	0.50
Z Dim (ft)	0.50	0.50	0.50	0.50	0.50	0.50	0.50
Height (ft)	0.15	0.15	0.15	0.15	0.15	0.15	0.15
X Offset (ft)	18.71	18.71	20.54	20.54	23.71	23.71	25.54
Z Offset (ft)	0.54	3.79	0.54	3.79	0.54	3.79	0.54
Requested Reinf. Ratio	0.0018	0.0018	0.0018	0.0018	0.0018	0.0018	0.0018
Provided Reinf. Ratio	0.0000	0.0000	0.0000	0.0000	0.0000	0.0000	0.0000
Long Bar Size	0	0	0	0	0	0	0
Bars in X Dir	0	0	0	0	0	0	0
Bars in Z Dir	0	0	0	0	0	0	0
Total Long Bars	0	0	0	0	0	0	0
Tie Bar Size	3	3	3	3	3	3	3
Total No. of Ties	0	0	0	0	0	0	0
Major Tie Spacing (in)	-3	-3	-3	-3	-3	-3	-3

	P22	P23	P24
X Dim (ft)	0.50	0.50	0.50
Z Dim (ft)	0.50	0.50	0.50
Height (ft)	0.15	0.15	0.15
X Offset (ft)	25.54	28.71	28.71
Z Offset (ft)	3.79	0.54	3.79
Requested Reinf. Ratio	0.0018	0.0018	0.0018
Provided Reinf. Ratio	0.0000	0.0000	0.0000
Long Bar Size	0	0	0
Bars in X Dir	0	0	0
Bars in Z Dir	0	0	0
Total Long Bars	0	0	0
Tie Bar Size	3	3	3
Total No. of Ties	0	0	0
Major Tie Spacing (in)	-3	-3	-3



Project: BGCAPP
Job Number: 743341
Calc. No.: 24915-10-DBC-00-00004
Sheet No.: E-68 of E-80
Sheet Rev.: D

Subject: Gas Bottle Canopy Misc Support Calculations
By: M. Bratt Date: 10/5/2009

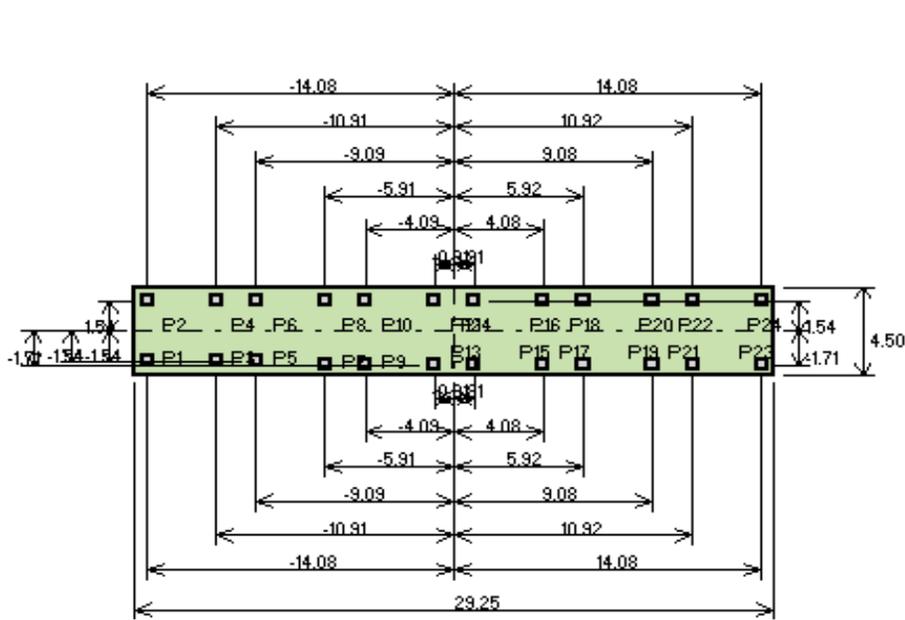

PLAN

FOUNDATION PLAN FOR Multimedia Filter

Subject: Gas Bottle Canopy & Misc Support Calculations
 By: M. Bratt
 Date: 10/5/2009

Seismic Load Calculation - Hydrolysate Heater Module

Operational weight:	$W_t := 12500\text{ lbf}$
Empty weight:	$W_W := 12000\text{ lbf}$
Contents Weight: $W_L := W_t - W_W$	$W_L = 500\text{ lbf}$
COG Height:	$H_t := 66.5\text{ in}$
Distance between Anchor Bolts:	$D_{\text{bolt}} := 99\text{ in}$

Seismic Base Shear and Overturning Moment

Design spectral response acceleration parameters (Sec. 1615.1.3 of IBC2003)

At short period: $S_{DS} := 0.273$ (per BGCAPP Design Criteria and IBC2000)

At long period: $S_{D1} := 0.167$

Seismic Importance Factor: $I_E := 1.0$ (APS, Level = 2, Ref. 4.13)

Response Modification factor (Table 12-6 BGCAPP Design Criteria): 'General Mechanical - Other' $R := 1$

Component amplification factor (Table 12-6 BGCAPP Design Criteria): $a_p := 2.50$

Height in structure at point of attachment of component: $z := 0$

Impulsive seismic force: $F_{P1} := \frac{0.4 \cdot a_p \cdot S_{DS}}{\frac{R}{I_E}} \cdot \left(1 + 2 \cdot \frac{z}{H}\right)$ $F_{P1} = 0$

$F_{Pmax} := 1.6 \cdot S_{DS} \cdot I_E$ $F_{Pmax} = 0$

$F_{Pmin} := 0.3 \cdot S_{DS} \cdot I_E$ $F_{Pmin} = 0$

$F_P := \max(\min(F_{P1}, F_{Pmax}), F_{Pmin})$ $F_P = 0$

Combined seismic coeff.: $C_s := F_P$ $C_s = 0.273$

Lateral base shear force: $V := C_s \cdot (W_t)$ (IBC2000 Eq. 16-34) $V = 3413\text{ lbf}$

Vertical component of EQ: $0.2 \cdot S_{DS} = 0.055$

Overturning Moment: $OTM := C_s \cdot (W_t \cdot H_t)$ $OTM = 19\text{-ft}\cdot\text{kip}$

Subject: Gas Bottle Canopy & Misc Support Calculations
 By: M. Bratt
 Date: 10/5/2009

Seismic Load Calculation - Hydrolysate Heater Module

Gravity Loads Applied on Concrete Pad

Unit self-weight: $W_W = 12 \cdot \text{kip}$

Unit content weight: $W_L = 0.5 \cdot \text{kip}$

Pad thickness: $t_{\text{pad}} := 1 \cdot \text{in}$

Vertical load applied on concrete pad due to self-weight:

$$P_{\text{DLpad}} := \frac{W_W}{4} \quad P_{\text{DLpad}} = 3.000 \cdot \text{kip}$$

Vertical load applied on concrete pad from internal contents:

$$P_{\text{LLpad}} := \frac{W_L}{4} \quad P_{\text{LLpad}} = 0.125 \cdot \text{kip}$$

Overturning Moments Applied on Concrete Pad

Lateral base shear force: $V = 3.41 \cdot \text{kip}$

Overturning moment per tank: $\text{OTM} = 19 \cdot \text{ft} \cdot \text{kip}$

Mat foundation thickness: $t_{\text{mat}} := 2 \text{ft}$

For N-S direction EQ load, assume that the seismic overturning moment of the unit is applied on two anchor points using an upward force and on the remaining two using a downward force.

Overturning moment arm: $a_1 := D_{\text{bolt}}$ $a_1 = 8 \text{ft}$

Pad force from OTM: $P_{\text{xEQpad}} := \frac{\text{OTM}}{a_1 \cdot 2}$ $P_{\text{xEQpad}} = 1.146 \cdot \text{kip}$

Lateral Shear: $V_{\text{pl}} := \frac{V}{4}$ $V_{\text{pl}} = 0.853 \cdot \text{kip}$

For NE direction EQ load, assume that the seismic overturning moment of the unit is applied on one anchor point using an upward force and on the opposite one using a downward force.

Overturning moment arm: $a_2 := D_{\text{bolt}} \cdot \sqrt{2}$ $a_1 = 8 \text{ft}$

Pad force from OTM: $P_{2\text{EQpad}} := \frac{\text{OTM}}{a_2}$ $P_{2\text{EQpad}} = 1.621 \cdot \text{kip}$

Lateral Shear in x & y dir: $V_{\text{pl}} := \frac{V}{4} \cdot \cos(45)$ $V_{\text{pl}} = 0.448 \cdot \text{kip}$



Project: BGCAPP
 Job Number: 743341
 Calc. No.: 24915-10-DBC-00-00004
 Sheet No.: E-71 of E-80
 Sheet Rev.: D

Subject: Gas Bottle Canopy Misc Support Calculations
 By: M. Bratt Date: 10/5/2009

Dimensional Solutions Mat3D	Version	5.1.0	Date	10/7/2009
Foundation Name	Hydrolysate Heater Module Foundation		Time	7:48:11 AM
Designed By:	PARSONS	Engineer	R. Murphy	Checker
Filename:	C:\Documents and Settings\p0045388\My Documents\SCWO\10-DBC-00-00004 Gas Bottle & Misc Concrete\...104 Hydrolysate Heater Module\RO SKID FOUNDATION.m3d			

DETAIL REPORT

PROJECT INFORMATION

Project Name: Gas Bottles canopy, Supports, equip. & misc. fdns Calculations
Project Number: 24915-10-DBC-00-00004
Client:
Project Location
Foundation Description HYDROLYSATE HEATER MODULE FOUNDATION

DESIGN CODE ACI 318 - 1999 **INPUT UNITS** English **OUTPUT UNITS** English

CONCRETE PARAMETERS:

Compressive Strength (psi) 4000.00
 Unit Weight (pcf) 150.00

REINFORCING STEEL PARAMETERS:

Yield Strength (ksi) 60.00
 Unit Weight (pcf) 490.00
 Modulus of Elasticity (ksi) 29000.00

SOIL PARAMETERS:

Allowable Net Bearing Capacity (psf) 3000.00
 Unit Weight (pcf) 120.00

PILE PARAMETERS:

Diameter (in) 0
 Type Drilled Shaft

REBAR PARAMETERS:

Max Long Bar Size 9
 Min Long Bar Size 4
 Max Tie Bar Size 8
 Min Tie Bar Size 3
 Max Ftg Bar Size 9
 Min Ftg Bar Size 4
 Temp & Shrinkage Steel Ratio 0.0018

MINIMUM FOUNDATION CRITERIA:

Depth of Footing Below Grade (ft) 2.00
 Minimum Soil Cover (ft) 0.00



Project: BGCAPP
Job Number: 743341
Calc. No.: 24915-10-DBC-00-00004
Sheet No.: E-72 of E-80
Sheet Rev.: D

Subject: Gas Bottle Canopy Misc Support Calculations
By: M. Bratt Date: 10/5/2009

APPLIED LOADS

P2

Load Case	Axial (kips)	Shear X (kips)	Mom Z (kip ft)	Shear Z (kips)	Mom X (kip ft)
1 - Dead	3.00	0.00	0.00	0.00	0.00
2 - Live	0.13	0.00	0.00	0.00	0.00
3 - EQNS	1.20	0.00	0.00	0.85	0.00
4 - EQEW	-1.20	0.85	0.00	0.00	0.00
5 - EQNE	0.00	0.45	0.00	0.45	0.00

P3

Load Case	Axial (kips)	Shear X (kips)	Mom Z (kip ft)	Shear Z (kips)	Mom X (kip ft)
1 - Dead	3.00	0.00	0.00	0.00	0.00
2 - Live	0.13	0.00	0.00	0.00	0.00
3 - EQNS	-1.20	0.00	0.00	0.85	0.00
4 - EQEW	1.20	0.85	0.00	0.00	0.00
5 - EQNE	0.00	0.45	0.00	0.45	0.00

P4

Load Case	Axial (kips)	Shear X (kips)	Mom Z (kip ft)	Shear Z (kips)	Mom X (kip ft)
1 - Dead	3.00	0.00	0.00	0.00	0.00
2 - Live	0.13	0.00	0.00	0.00	0.00
3 - EQNS	1.20	0.00	0.00	0.85	0.00
4 - EQEW	1.20	0.85	0.00	0.00	0.00
5 - EQNE	1.65	0.45	0.00	0.45	0.00



Project: BGCAPP
 Job Number: 743341
 Calc. No.: 24915-10-DBC-00-00004
 Sheet No.: E-73 of E-80
 Sheet Rev.: D

Subject: Gas Bottle Canopy Misc Support Calculations
 By: M. Bratt Date: 10/5/2009

P1

Load Case	Axial (kips)	Shear X (kips)	Mom Z (kip ft)	Shear Z (kips)	Mom X (kip ft)
1 - Dead	3.00	0.00	0.00	0.00	0.00
2 - Live	0.13	0.00	0.00	0.00	0.00
3 - EQNS	-1.20	0.00	0.00	0.85	0.00
4 - EQEW	-1.20	0.85	0.00	0.00	0.00
5 - EQNE	-1.65	0.45	0.00	0.45	0.00

UNFACTORED (ALLOWABLE) LOAD COMBINATIONS

P2

Load Comb	Axial (kips)	Shear X (kips)	Mom Z (kip ft)	Shear Z (kips)	Mom X (kip ft)
1 - Dead	3.00	0.00	0.00	0.00	0.00
2 - Dead + Live	3.13	0.00	0.00	0.00	0.00
3 - Dead + 0.7EQNS	3.84	0.00	0.00	0.60	0.00
4 - Dead + 0.7EQEW	2.16	0.60	0.00	0.00	0.00
5 - Dead + 0.7EQNE	3.00	0.31	0.00	0.31	0.00

P3

Load Comb	Axial (kips)	Shear X (kips)	Mom Z (kip ft)	Shear Z (kips)	Mom X (kip ft)
1 - Dead	3.00	0.00	0.00	0.00	0.00
2 - Dead + Live	3.13	0.00	0.00	0.00	0.00
3 - Dead + 0.7EQNS	2.16	0.00	0.00	0.60	0.00
4 - Dead + 0.7EQEW	3.84	0.60	0.00	0.00	0.00
5 - Dead + 0.7EQNE	3.00	0.31	0.00	0.31	0.00



Project: BGCAPP
 Job Number: 743341
 Calc. No.: 24915-10-DBC-00-00004
 Sheet No.: E-74 of E-80
 Sheet Rev.: D

Subject: Gas Bottle Canopy Misc Support Calculations
 By: M. Bratt Date: 10/5/2009

P4

Load Comb	Axial (kips)	Shear X (kips)	Mom Z (kip ft)	Shear Z (kips)	Mom X (kip ft)
1 - Dead	3.00	0.00	0.00	0.00	0.00
2 - Dead + Live	3.13	0.00	0.00	0.00	0.00
3 - Dead + 0.7EQNS	3.84	0.00	0.00	0.60	0.00
4 - Dead + 0.7EQEW	3.84	0.60	0.00	0.00	0.00
5 - Dead + 0.7EQNE	4.16	0.31	0.00	0.31	0.00

P1

Load Comb	Axial (kips)	Shear X (kips)	Mom Z (kip ft)	Shear Z (kips)	Mom X (kip ft)
1 - Dead	3.00	0.00	0.00	0.00	0.00
2 - Dead + Live	3.13	0.00	0.00	0.00	0.00
3 - Dead + 0.7EQNS	2.16	0.00	0.00	0.60	0.00
4 - Dead + 0.7EQEW	2.16	0.60	0.00	0.00	0.00
5 - Dead + 0.7EQNE	1.85	0.31	0.00	0.31	0.00

FACTORED (ULTIMATE) LOAD COMBINATIONS

P2

Load Comb	Axial (kips)	Shear X (kips)	Mom Z (kip ft)	Shear Z (kips)	Mom X (kip ft)
1 - 1.4Dead	4.20	0.00	0.00	0.00	0.00
2 - 1.2Dead + 1.6Live	3.80	0.00	0.00	0.00	0.00
3 - 1.2Dead + Live	3.73	0.00	0.00	0.00	0.00
4 - 1.2Dead + EQNS	4.80	0.00	0.00	0.85	0.00
5 - 1.2Dead + EQEW	2.40	0.85	0.00	0.00	0.00
6 - 1.2Dead + EQNE	3.60	0.45	0.00	0.45	0.00



Project: BGCAPP
 Job Number: 743341
 Calc. No.: 24915-10-DBC-00-00004
 Sheet No.: E-75 of E-80
 Sheet Rev.: D

Subject: Gas Bottle Canopy Misc Support Calculations
 By: M. Bratt Date: 10/5/2009

P3

Load Comb	Axial (kips)	Shear X (kips)	Mom Z (kip ft)	Shear Z (kips)	Mom X (kip ft)
1 - 1.4Dead	4.20	0.00	0.00	0.00	0.00
2 - 1.2Dead + 1.6Live	3.80	0.00	0.00	0.00	0.00
3 - 1.2Dead + Live	3.73	0.00	0.00	0.00	0.00
4 - 1.2Dead + EQNS	2.40	0.00	0.00	0.85	0.00
5 - 1.2Dead + EQEW	4.80	0.85	0.00	0.00	0.00
6 - 1.2Dead + EQNE	3.60	0.45	0.00	0.45	0.00

P4

Load Comb	Axial (kips)	Shear X (kips)	Mom Z (kip ft)	Shear Z (kips)	Mom X (kip ft)
1 - 1.4Dead	4.20	0.00	0.00	0.00	0.00
2 - 1.2Dead + 1.6Live	3.80	0.00	0.00	0.00	0.00
3 - 1.2Dead + Live	3.73	0.00	0.00	0.00	0.00
4 - 1.2Dead + EQNS	4.80	0.00	0.00	0.85	0.00
5 - 1.2Dead + EQEW	4.80	0.85	0.00	0.00	0.00
6 - 1.2Dead + EQNE	5.25	0.45	0.00	0.45	0.00

P1

Load Comb	Axial (kips)	Shear X (kips)	Mom Z (kip ft)	Shear Z (kips)	Mom X (kip ft)
1 - 1.4Dead	4.20	0.00	0.00	0.00	0.00
2 - 1.2Dead + 1.6Live	3.80	0.00	0.00	0.00	0.00
3 - 1.2Dead + Live	3.73	0.00	0.00	0.00	0.00
4 - 1.2Dead + EQNS	2.40	0.00	0.00	0.85	0.00
5 - 1.2Dead + EQEW	2.40	0.85	0.00	0.00	0.00
6 - 1.2Dead + EQNE	1.95	0.45	0.00	0.45	0.00



Project: BGCAPP
 Job Number: 743341
 Calc. No.: 24915-10-DBC-00-00004
 Sheet No.: E-76 of E-80
 Sheet Rev.: D

Subject: Gas Bottle Canopy Misc Support Calculations
 By: M. Bratt Date: 10/5/2009

BEARING CAPACITY - LINEAR SOIL PRESSURE METHOD

Load Comb	Max Pressure (ksf)	All Pressure (ksf)	Ecc N/S Dir (ft)	Ecc E/W Dir (ft)	Moment N/S axis (kip-ft)	Moment E/W axis (kip-ft)	Rem
1 - Dead	0.40	3.24	0.00	0.00	0.06	0.00	
2 - Dead + Live	0.40	3.24	0.00	0.00	0.06	0.00	
3 - Dead + 0.7EQNS	0.50	4.24	0.40	0.00	0.06	19.65	
4 - Dead + 0.7EQEW	0.49	4.24	0.00	0.51	25.47	0.00	
5 - Dead + 0.7EQNE	0.52	4.24	0.26	0.34	16.62	12.64	

STABILITY RATIO / SLIDING SAFETY FACTOR

Load Comb	S.R. N/S Dir	S.R. E/W Dir	All S.R.	Sliding FS - N/S	Sliding FS - E/W	All FS	Remarks
1 - Dead	100.00	100.00	1.50	100.00	100.00	1.50	
2 - Dead + Live	100.00	100.00	1.50	100.00	100.00	1.50	
3 - Dead + 0.7EQNS	41.13	100.00	1.50	16.99	100.00	1.50	
4 - Dead + 0.7EQEW	100.00	56.97	1.50	100.00	15.14	1.50	
5 - Dead + 0.7EQNE	79.90	100.00	1.50	32.35	28.84	1.50	

FOOTING DESIGN INFORMATION

X Dim (ft)	13.17
Z Dim (ft)	9.50
Thickness (ft)	2.00

Top Steel

Governing Combination	No of Bars	Bar Size	Bar Spac (in)	Area Prov (sq in/ft)	Area Req (sq in/ft)	Moment (kip ft/ft)	Direction
1. 1.4Dead	5	5	12	0.16	0.03	-2.4	E-W
1. 1.4Dead	7	5	12	0.16	0.02	-1.2	N-S



Project: BGCAPP
 Job Number: 743341
 Calc. No.: 24915-10-DBC-00-00004
 Sheet No.: E-77 of E-80
 Sheet Rev.: D

Subject: Gas Bottle Canopy Misc Support Calculations
 By: M. Bratt Date: 10/5/2009

Bottom Steel

Governing Combination	No of Bars	Bar Size	Bar Spac (in)	Area Prov (sq in/ft)	Area Req (sq in/ft)	Moment (kip ft/ft)	Direction
5. 1.2Dead + EQEW	19	5	6	0.61	0.52	0.34	E-W
4. 1.2Dead + EQNS	26	5	6	0.61	0.52	0.24	N-S

PUNCHING SHEAR

P2

Control Comb	Net Ult Load (kips)	Punch. Stress (psi)	All Stress (psi)	Rem
4. 1.2Dead + EQNS	4.54	6.32	215.04	

P3

Control Comb	Net Ult Load (kips)	Punch. Stress (psi)	All Stress (psi)	Rem
5. 1.2Dead + EQEW	4.54	6.30	215.04	

P4

Control Comb	Net Ult Load (kips)	Punch. Stress (psi)	All Stress (psi)	Rem
6. 1.2Dead + EQNE	4.82	6.68	215.04	



Project: BGCAPP
 Job Number: 743341
 Calc. No.: 24915-10-DBC-00-00004
 Sheet No.: E-78 of E-80
 Sheet Rev.: D

Subject: Gas Bottle Canopy Misc Support Calculations
 By: M. Bratt Date: 10/5/2009

P1

Control Comb	Net Ult Load (kips)	Punch. Stress (psi)	All Stress (psi)	Rem
1. 1.4Dead	3.90	5.43	215.04	

MAXIMUM SHEAR - X DIRECTION

Load Comb	Left Dist (ft)	Max Shear (kips)	Shear Stress (psi)	All Stress (psi)	Rem
1 - 1.4Dead	2.37	-5.38	2.36	107.52	
2 - 1.2Dead + 1.6Live	2.37	-4.87	2.13	107.52	
3 - 1.2Dead + Live	2.37	-4.77	2.09	107.52	
4 - 1.2Dead + EQNS	2.37	-4.61	2.02	107.52	
5 - 1.2Dead + EQEW	2.37	-4.66	2.04	107.52	
6 - 1.2Dead + EQNE	10.79	4.65	2.04	107.52	

MAXIMUM SHEAR - Z DIRECTION

Load Comb	Bottom Dist (ft)	Max Shear (kips)	Shear Stress (psi)	All Stress (psi)	Rem
1 - 1.4Dead	2.29	-4.35	1.38	107.52	
2 - 1.2Dead + 1.6Live	7.21	3.94	1.25	107.52	
3 - 1.2Dead + Live	7.21	3.86	1.22	107.52	
4 - 1.2Dead + EQNS	2.29	-4.58	1.45	107.52	
5 - 1.2Dead + EQEW	2.29	-3.73	1.18	107.52	
6 - 1.2Dead + EQNE	2.29	-4.17	1.32	107.52	

PIER/BASE PLATE DESIGN INFORMATION


	P2	P3	P4	P1
X Dim (ft)	0.25	0.25	0.25	0.25
Z Dim (ft)	0.25	0.25	0.25	0.25



Project: BGCAPP
 Job Number: 743341
 Calc. No.: 24915-10-DBC-00-00004
 Sheet No.: E-79 of E-80
 Sheet Rev.: D

Subject: Gas Bottle Canopy Misc Support Calculations
 By: M. Bratt Date: 10/5/2009

Height (ft)	0.25	0.25	0.25	0.25
X Offset (ft)	0.58	12.58	12.58	0.58
Z Offset (ft)	9.00	0.50	9.00	0.50
Requested Reinf. Ratio	0.0018	0.0018	0.0018	0.0018
Provided Reinf. Ratio	0.0000	0.0000	0.0000	0.0000
Long Bar Size	0	0	0	0
Bars in X Dir	0	0	0	0
Bars in Z Dir	0	0	0	0
Total Long Bars	0	0	0	0
Tie Bar Size	3	3	3	3
Total No. of Ties	0	0	0	0
Major Tie Spacing (in)	-1	-1	-1	-1

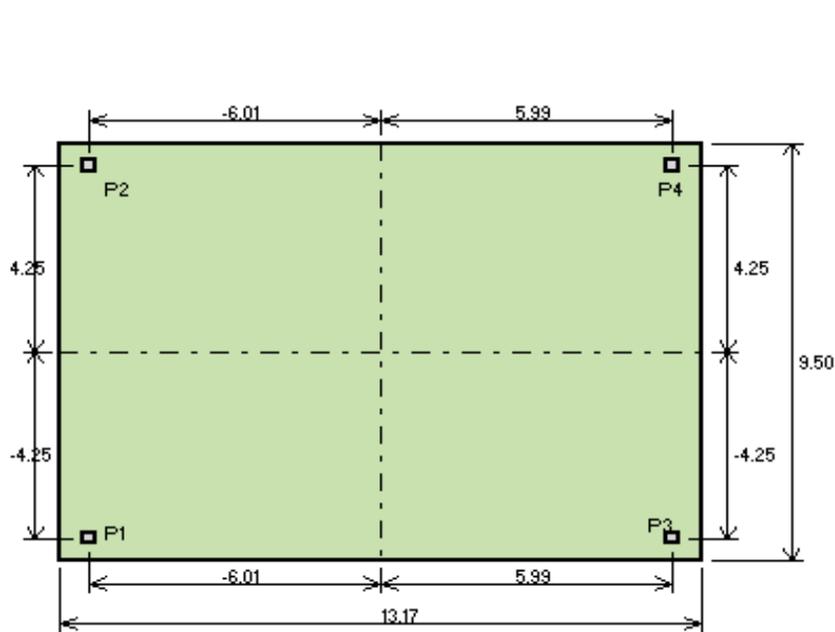

PLAN

FOUNDATION PLAN FOR Hydrogsate Heat



A Joint Venture of Bechtel National, Inc. and Parsons Infrastructure & Technology Group, Inc.

Calculation Sheet

Project:	BGCAPP
Job Number:	743341
Calc. No.	24915-10-DBC-00-00004
Sheet No.	E-80 / E-80
Sheet Rev.	D

Subject: Gas Bottles Canopy, Supports, Equip, & Misc Foundations
 By: M.Bratt Date: 10/06/2009

E.5 Summary

The calculation performed in this appendix includes structural analysis and design of foundations for the Effluent Caustic Day Tank (MV-RO-0101), R.O. Skid (MK-RO-0101), R.O. Multimedia Filters (MK-RO-0101A through MK-RO-0101F), and Hydrolysate Heater Module (MX-SCWO-0042). No soil uplift is observed under worst-case overturning loads, and sliding resistance of the foundations is adequate. A summary of the foundation designs is as follows:

Effluent Caustic Day Tank

Mat Thickness: 2'-3"
 Top Reinforcement: #5 bars @ 12" o.c. both ways
 Bottom Reinforcement: #5 bars @ 6" o.c. both ways

R.O. Skid

Mat Thickness: 2'-3"
 Top Reinforcement: #5 bars @ 12" o.c. both ways
 Bottom Reinforcement: #5 bars @ 6" o.c. both ways

R.O. Multimedia Filters

Mat Thickness: 3'-3"
 Top Reinforcement: #6 bars @ 12" o.c. both ways
 Bottom Reinforcement: #6 bars @ 6" o.c. both ways

Hydrolysate Heater Module

Mat Thickness: 2'-0"
 Top Reinforcement: #5 bars @ 12" o.c. both ways
 Bottom Reinforcement: #5 bars @ 6" o.c. both ways



A Joint Venture of Bechtel National, Inc. and
Parsons Infrastructure & Technology Group Inc.

Calculation Sheet

Project:	BGCAPP
Job Number:	743341
Calc. No.	24915-10-DBC-00-00004
Sheet No.	F-1 / F-5
Sheet Rev.	D

Subject: Gas Bottles Canopy, Supports, Equip, & Misc Foundations
By: R. Murphy Date: 12/16/2007

Appendix F

SPB Floor Slab on Grade

Project:	BGCAPP
Job Number:	743341
Calc. No.	24915-10-DBC-00-00004
Sheet No.	F-2 / F-5
Sheet Rev.	D

Subject: Gas Bottles Canopy, Supports, Equip, & Misc FoundationsBy: R. Murphy Date: 12/16/2007**F.1. Objective**

The calculation performed in this appendix includes an analysis of the SCWO Processing Building (SPB) floor slab on grade.

F.2. Inputs

The slab is 8" thick and is reinforced with #4 bars @ 12" o.c. each way top and bottom.

F.3 Assumptions

A soft soil pocket 4'-6" square is assumed under a portion of the slab and a concentrated load is placed at the center of the pocket. It is assumed that the slab is supported at points 6" outside the perimeter of the soft soil pocket.

F.4 Calculation Body

Maximum allowable concentrated and distributed loads are calculated for the slab in the following MathCAD sheets. The first sheet calculates the maximum allowable loads when there is no soft soil pocket under the slab. The second sheet calculates what the maximum allowable loads are when there is a soft soil pocket under the slab with dimensions equal to 10% of the distance between construction joints.

Subject: Gas Bottles Canopy, Supports, Equip, & Misc Foundations
 By: R. Murphy Date: 12/16/2007

SPB Slab on Grade Calculations

Slab on grade is 8" thick and reinforced with # 4 @ 12 each way T & B
 $t := 8\text{in}$ $d := t - 3.75\text{in}$ $b := 6\text{ft}$
 (K= 150lb/in³ or 1800 psi for 12" wide strip of slab; 7200psi for b = 48')

Mod of subgrade $K_{ww} := 150 \frac{\text{lb}}{\text{in}^3} \cdot b$


$K = 10800.00\text{psi}$

$E := 3000\text{ksi}$ $d = 4.25\text{in}$ $L = L_{\text{aver}}$

$L_{ww} := 6\text{ft}$ $P_i := 20\text{k}$

$I := \frac{b \cdot d^3}{12}$ $I = 460.59\text{in}^4$

$\lambda := \sqrt[4]{\frac{K}{4 \cdot E \cdot I}}$ $\lambda = 0.45 \frac{1}{\text{ft}}$

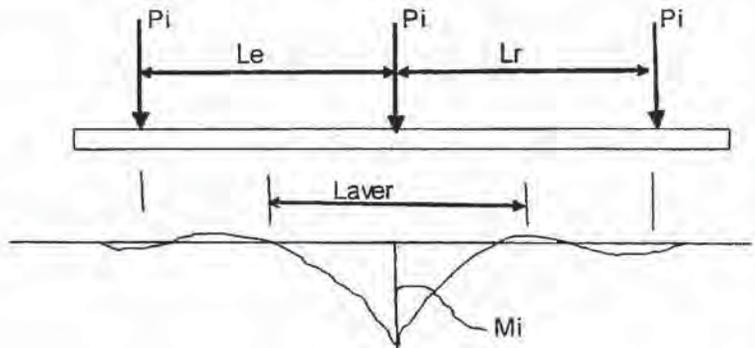

Considering one way strip of slab width, b
 (For one way action; For two way action it is 2Pi = 58k)

$L_{\text{max}} := \frac{3.5}{\lambda}$ $L_{\text{min}} := \frac{1.75}{\lambda}$ $L_{\text{max}} = 7.80\text{ft}$ $L_{\text{min}} = 3.90\text{ft}$

$M_i := \frac{P_i}{4 \cdot \lambda} \cdot (0.24 \cdot \lambda \cdot L + 0.16)$ Ref:-Reinf. Conc Design Bldg.
 By Paul Rogers

7.80 ft > L=6 ft < 3.90ft
 So, assumed span L is O.Kay

$M_i = 8.98\text{ k}\cdot\text{ft}$ (For 1' wide strip moment= Mi/b)

$f_c := 4000\text{psi}$

$\frac{M_i}{b} \cdot 1\text{ft} = 1.50\text{ k}\cdot\text{ft}$ $f_s := 24\text{ksi}$ $j := .875$

$A_s := \frac{\frac{M_i}{b} \cdot 1\text{ft}}{f_s \cdot j \cdot d}$ $A_s = 0.20\text{in}^2$

For two way action , soil press fsoil

$f_{\text{soil}} := \frac{2 \cdot P_i}{b \cdot L}$ $f_{\text{soil}} = 1111.11\text{psf}$

Provided reinf., # 4 @ 12 = 0.20 sq. in

So, 8 "slab w/# 4@12 ea.way T & B is good for
 Uniform Distributed Load of 1111 psf or
 concentrated load $P_i = 20\text{ kips}$

Project:	BGCAPP
Job Number:	743341
Calc. No.	24915-10-DBC-00-00004
Sheet No.	F-4 / F-5
Sheet Rev.	D

Subject: Gas Bottles Canopy, Supports, Equip, & Misc Foundations
By: R. Murphy Date: 12/16/2007

SOFT SOIL POCKET UNDER SLAB ON GR.

As per job standard drawing 24915-000-S0-00-00012, maximum spacing of construction joint is 45 feet. Consider (10% of 45') 4'-6" square soft soil pocket under the slab and a concentrated load P on 12" square plate on the center of the pocket

$f_c' = 4000 \text{ psi}$
 $f_s = 24000 \text{ psi}$
 $f_s := 24000 \text{ psi}$

$P := 16 \text{ k}$ $L_c := 5.5 \text{ ft}$ (Support length @ soil pocket)

Reaction per foot length of periphery, p

$p := \frac{P}{4 \cdot L_c}$ $p = 727.27 \text{ plf}$

M is moment for 1'-0" length of periphery

$M := p \cdot \frac{L_c - 12 \text{ in}}{2} \cdot 1 \text{ ft}$

$M = 1.64 \text{ k} \cdot \text{ft}$ $\lambda_v := .875$ $d_m := 4.75 \text{ in}$

$A_s := \frac{M}{f_s \cdot j \cdot d}$

$A_s = 0.20 \text{ in}^2$

Considering 1' wide strip of soil on periphery, soil pressure f_{soil}

$f_{soil} := \frac{p}{1 \text{ ft}}$ $f_{soil} = 727.27 \text{ psf}$


Also, $f_{soil} := \frac{P}{(4.5 \text{ ft})^2}$

$f_{soil} = 790.12 \text{ psf}$

Soil pressure if no weak soil pocket

$f_{soil \text{ no pocket}} := \frac{P}{(31 \text{ in})^2}$

$f_{soil \text{ no pocket}} = 2397.50 \text{ psf} < 3000 \text{ psf}$ So O.K

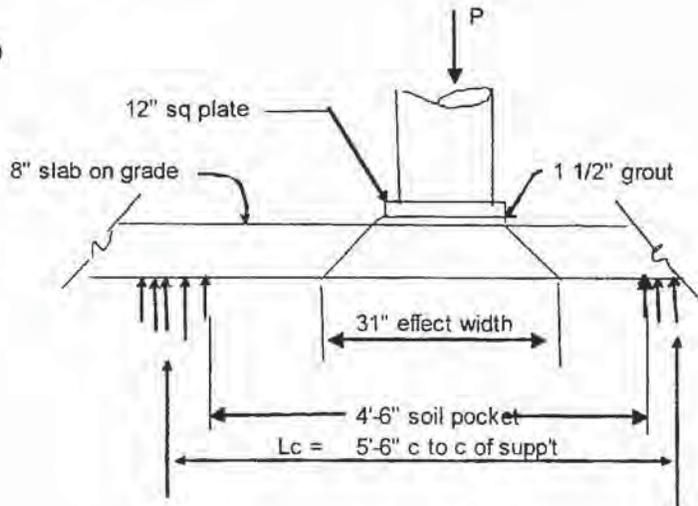

So, 8" slab w/# 4@12 ea. way T & B is good for
Uniform Distributed Load of 727 psf or
concentrated load $P_1 = 16 \text{ kips}$



A Joint Venture of Bechtel National, Inc. and
Parsons Infrastructure & Technology Group LLC

Calculation Sheet

Project:	BGCAPP
Job Number:	743341
Calc. No.	24915-10-DBC-00-00004
Sheet No.	F-5 / F-5
Sheet Rev.	D

Subject: Gas Bottles Canopy, Supports, Equip, & Misc Foundations

By: R. Murphy Date: 12/16/2007

F.5 Summary

The calculation performed in this appendix includes an analysis of the SCWO Processing Building (SPB) floor slab on grade. Calculations were performed to find the maximum allowable uniform and concentrated loads on the slab.

For typical slab on grade with no soft soil pockets, allowable uniform distributed load is 1111 psf. Allowable concentrated load is 20 kips.

For slab on grade with a soft soil pocket with a width of 10% of the distance between construction joints, allowable uniform distributed load is 727 psf. Allowable concentrated load is 16 kips.



A Joint Venture of Bechtel National, Inc. and
Parsons Infrastructure & Technology Group, Inc.

Calculation Sheet

Project:	<u>BGCAPP</u>
Job Number:	<u>743341</u>
Calc. No.	<u>24915-10-DBC-00-00004</u>
Sheet No.	<u>G-1 of G-83</u>
Sheet Rev.	<u>D</u>

Subject:	<u>Gas Bottles Canopy, Supports, Equip, & Misc Foundations</u>	
By:	<u>M. Bratt</u>	Date: <u>10/5/2009</u>

Appendix G

Base Plate and Anchor Bolt Calculations



Calculation Sheet

Project: BGCAPP
 Job Number: 743341
 Calc. No.: 24915-10-DBC-00-00004
 Sheet No.: G-2 / G-83
 Sheet Rev.: D

Subject: Gas Bottle Canopy, Supports, Equip, & Misc. Foundations
 By: M. Bratt
 Date: 10/5/2009

Baseplate and Anchor Bolt Design - W8x31 - Multiple Conditions

This calculation contains designs for anchor bolts at the following locations:

All design will be based off of the standard base plate detail for a W8x31 column (Detail 1, 24915-000-SO-00006)

W8x31 column supports for HVAC ducts (Calculation no. 24915-10-SSC-00-00006, App C4).

W8x31 column supports for Exterior Cable Trays (Calculation no. 24915-10-SSC-00-00006, App B).

Column Reactions

Following are the controlling node outputs from the duct supports and exterior cable trays.
 Units are kips, kip-ft.

Structure	Joint	Load Case	Fx	Fy	Axial	Mx	My
Duct Supports	10 (From App C4)	DL	0.013	0.019	1.953	0.528	0.096
		SNOW	0.011	0.017	1.168	0.45	0.083
		WLEW	0.01	1.208	-0.066	21.943	0.176
		WLNS	0.927	0.182	0.009	4.073	4.414
Cable Trays	13	DL	0	0.81	7.336	0	27.36
		SNOW	0	0	0.9	0	3.813
		WLEW	1.922	0	0	0	26.65
		WLNS	0.267	0.949	-1.33	0	-4.077

Duct support analysis follows with cable tray analysis following on page G-18.

W8x31 - Check Duct Support Loads

Applicable Load Combinations:

1.4D
 1.2D + 1.6S + 0.8W
 1.2D + 1.6W + 0.5S
 0.9D + 1.6W* *Worst case loading

Loads

$$P := 0.9 \cdot 1.953 \text{ kip} - 1.6 \cdot 0.066 \text{ kip} \quad \boxed{P = 1.652 \cdot \text{kip}}$$

$$V := 0.9 \cdot 0.019 \text{ kip} + 1.6 \cdot 1.208 \text{ kip} \quad \boxed{V = 1.95 \cdot \text{kip}}$$

$$M := 0.9 \cdot 0.528 \text{ kip} \cdot \text{ft} + 1.6 \cdot 21.943 \text{ kip} \cdot \text{ft} \quad \boxed{M = 35.58 \cdot \text{kip} \cdot \text{ft}}$$

$$\text{Eccentricity: } e := \frac{M}{P} \quad e = 258.46 \cdot \text{in}$$

Subject: Gas Bottle Canopy, Supports, Equip, & Misc. Foundations
By: M. Bratt
Date: 10/5/2009

Check Duct Supports

Base Plate Properties

Plate Thickness: $t := 1.0\text{in}$

Plate Dimensions: $N_{\text{plate}} := 16\text{in}$

Dist. to plate Neutral Axis: $c_{\text{plate}} := 0.5 \cdot N_{\text{plate}} \quad c_{\text{plate}} = 8 \cdot \text{in}$

Column Depth: $d := 8\text{in}$


Dist. column edge to plate edge: $n := \frac{N_{\text{plate}}}{2} - \frac{0.95 \cdot d}{2} \quad n = 4.2 \cdot \text{in}$

Section Properties: $A := N_{\text{plate}}^2 \quad A = 256 \cdot \text{in}^2 \quad Z_y := \frac{t^2 \cdot 1\text{in}}{6} \quad Z_y = 0.167 \cdot \text{in}^3$


Pedestal Properties

$A_2 := 2\text{ft} \cdot 2\text{ft} \quad A_2 = 576 \cdot \text{in}^2$

$I := \frac{1}{12} \cdot (N_{\text{plate}})^4 \quad I = 5461 \cdot \text{in}^4$

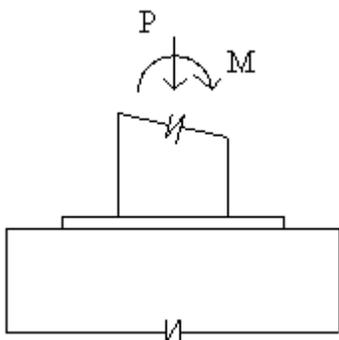


Elevation

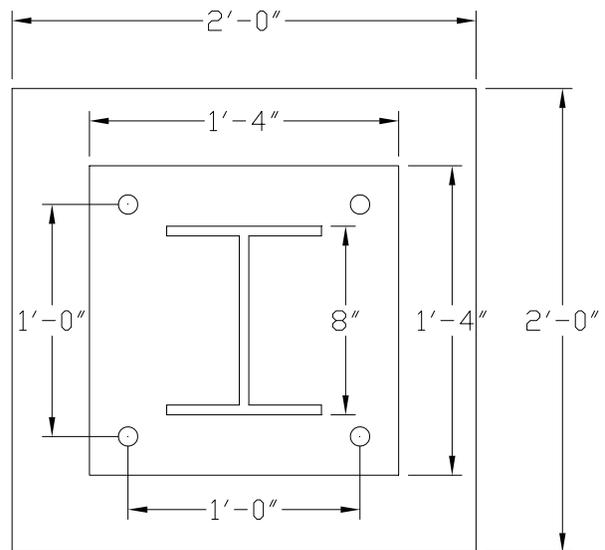

Plan

Subject: Gas Bottle Canopy, Supports, Equip, & Misc. Foundations
 By: M. Bratt
 Date: 10/5/2009

Design Forces

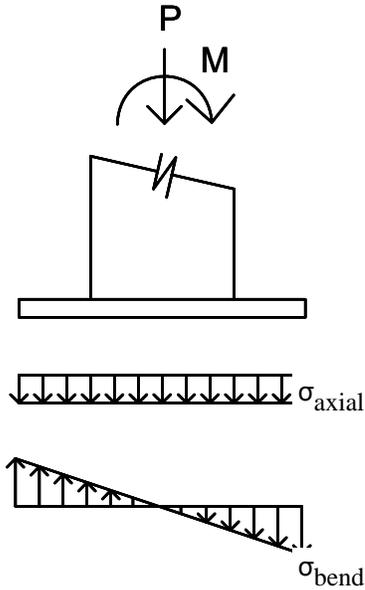


Stress Resultants

if $\sigma_{axial} = \sigma_{bending}$



if $\sigma_{axial} > \sigma_{bending}$

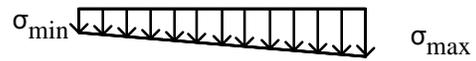

if $\sigma_{axial} < \sigma_{bending}$



Stress Calculations

$$\sigma_{axial} := \frac{P}{A} \qquad \sigma_{axial} = 6.4535 \times 10^{-3} \cdot \text{ksi}$$

$$\sigma_{bend} := |M| \cdot \frac{c_{plate}}{I} \qquad \sigma_{bend} = 0.6255 \cdot \text{ksi}$$


Total Stress

$$\sigma_{max} := \sigma_{axial} + \sigma_{bend} \qquad \sigma_{max} = 0.632 \cdot \text{ksi}$$

$$\sigma_{min} := \sigma_{axial} - \sigma_{bend} \qquad \sigma_{min} = -0.619 \cdot \text{ksi}$$

Subject: Gas Bottle Canopy, Supports, Equip, & Misc. Foundations
By: M. Bratt
Date: 10/5/2009

Calculating Force Resultants

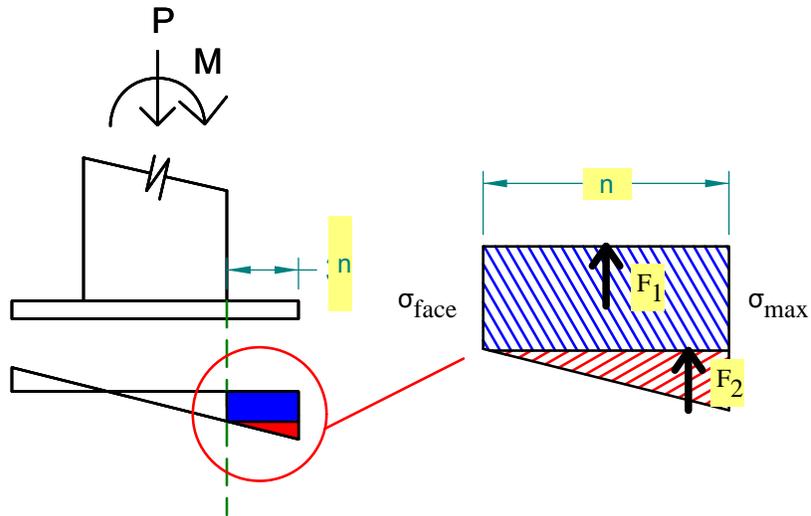

$$\text{stress_slope} := \frac{\sigma_{\max} - \sigma_{\min}}{N_{\text{plate}}}$$

$$\text{stress_slope} = 0.0782 \cdot \frac{\text{kip}}{\text{in}^3}$$

$$\sigma_{\text{face}} := \sigma_{\max} - \text{stress_slope} \cdot (n)$$

$$\sigma_{\text{face}} = 0.3036 \text{ ksi}$$

Rectangular Stress Block Resultants

$$F_{\text{rect}} := \sigma_{\text{face}} \cdot n \cdot 1 \text{ in} \quad F_{\text{rect}} = 1.275 \cdot \text{kip}$$

$$M_{\text{rect}} := F_{\text{rect}} \cdot \frac{n}{2} \quad M_{\text{rect}} = 2.6775 \cdot \text{kip} \cdot \text{in}$$

Triangular Stress Block Resultants

$$F_{\text{tri}} := \frac{(\sigma_{\max} - \sigma_{\text{face}}) \cdot n \cdot 1 \text{ in}}{2} \quad F_{\text{tri}} = 0.6896 \cdot \text{kip}$$

$$M_{\text{tri}} := F_{\text{tri}} \cdot 2 \cdot \frac{n}{3} \quad M_{\text{tri}} = 1.9309 \cdot \text{kip} \cdot \text{in}$$

Total Moment Per Unit Width

$$M_{\text{design}} := M_{\text{rect}} + M_{\text{tri}}$$

$$M_{\text{design}} = 4.6084 \cdot \text{kip} \cdot \text{in}$$

Subject: Gas Bottle Canopy, Supports, Equip, & Misc. Foundations
By: M. Bratt
Date: 10/5/2009

Base Plate Design [AISC-LRFD 2nd ED J9]

1. Concrete Bearing Stress [AISC LRFD-2nd ED J9]

$$f_c := 4 \text{ ksi}$$

$$\Phi_c := .6$$

$$A_{\text{ratio}} := \text{if} \left[\left(\frac{A_2}{A} \right)^{\frac{1}{2}} < 2, \left(\frac{A_2}{A} \right)^{\frac{1}{2}}, 2 \right]$$

$$A_{\text{ratio}} = 1.5$$

$$F_p := \Phi_c \cdot 0.85 \cdot f_c \cdot A_{\text{ratio}} \quad [\text{AISC LRFD-2nd ED J9}]$$

$$F_p = 3.06 \cdot \text{ksi}$$

$$\text{pedestal_design} := \text{if} (\sigma_{\text{max}} < F_p, G_{\text{pedestal}}, \text{NG}_{\text{pedestal}})$$

pedestal_design = "Pedestal design is good"

2. Plate Thickness [AISC LRFD-2nd ED]

$$\Phi_{\text{flex}} := .90 \quad F_y := 36 \text{ ksi}$$

$$t_p := \sqrt[4]{\frac{M_{\text{design}} \cdot l}{\Phi_{\text{flex}} \cdot F_y \cdot 1 \text{ in}}} \quad t_p = 0.7543 \cdot \text{in} \quad [\text{AISC LRFD-2nd ED 14-6}]$$

Plate Bending Strength per unit width

$$M_{\text{strength}} := \Phi_{\text{flex}} \cdot F_y \cdot Z_y \quad M_{\text{strength}} = 5.4 \cdot \text{kip} \cdot \text{in}$$

Design Check

$$\text{base_plate_design} := \text{if} (t > t_p, G_d, \text{NG})$$

base_plate_design = "Base Plate Design is Good"

Subject: Gas Bottle Canopy, Supports, Equip, & Misc. Foundations
 By: M. Bratt
 Date: 10/5/2009

Determining effects of eccentricity [AISC LRFD B.3]

$$e_{\text{kern}} := \frac{N_{\text{plate}}}{6} \quad e_{\text{kern}} = 2.67 \cdot \text{in} \quad [\text{AISC B.3}]$$

$$\text{anchor_tension} := \text{if}(e > e_{\text{kern}}, \text{BT}, \text{NBT})$$

$$\text{anchor_tension} = \text{"Anchor bolts in tension"}$$

Determining Tension in Anchor Bolt [AISC B.4.2]

$$P = 1652 \text{ lbf}$$

$$f_p = 1 \cdot \text{ksi}$$

$$B = 1 \text{ ft}$$

Determining Length of Stress Triangle

$$f' := f_p \cdot N_{\text{plate}} \cdot \frac{N'}{2} \quad f' = 70.7788 \cdot \text{kip}$$

$$A_{\text{plus}} := \frac{f' + \sqrt{f'^2 - 4 \cdot \left(f_p \cdot \frac{B}{6}\right) \cdot (P \cdot A' + M)}}{f_p \cdot \frac{B}{3}} \quad A_{\text{plus}} = 34.535 \cdot \text{in}$$

$$A_{\text{minus}} := \frac{f' - \sqrt{f'^2 - 4 \cdot \left(f_p \cdot \frac{B}{6}\right) \cdot (P \cdot A' + M)}}{f_p \cdot \frac{B}{3}} \quad A_{\text{minus}} = 7.465 \cdot \text{in}$$

$$A_{\text{final}} := \begin{cases} \min(A_{\text{plus}}, A_{\text{minus}}) & \text{if } A_{\text{plus}} > 0 \wedge A_{\text{minus}} > 0 \\ A_{\text{plus}} & \text{if } A_{\text{plus}} > 0 \wedge A_{\text{minus}} < 0 \\ 0 & \text{if } A_{\text{plus}} < 0 \wedge A_{\text{minus}} < 0 \end{cases} \quad A_{\text{final}} = 7.465 \cdot \text{in}$$


Determining Anchor Tension from Equilibrium

$$T_{\text{anchors}} := \frac{f_p \cdot A_{\text{final}} \cdot B}{2} - P \quad T_{\text{anchors}} = 36.087 \cdot \text{kip}$$

$$T_{\text{one_anchor}} := \frac{T_{\text{anchors}}}{2} \quad T_{\text{one_anchor}} = 18.0435 \cdot \text{kip}$$

Subject: Gas Bottle Canopy, Supports, Equip, & Misc. Foundations
 By: M. Bratt
 Date: 10/5/2009

Pedestal and Foundation Cross Section

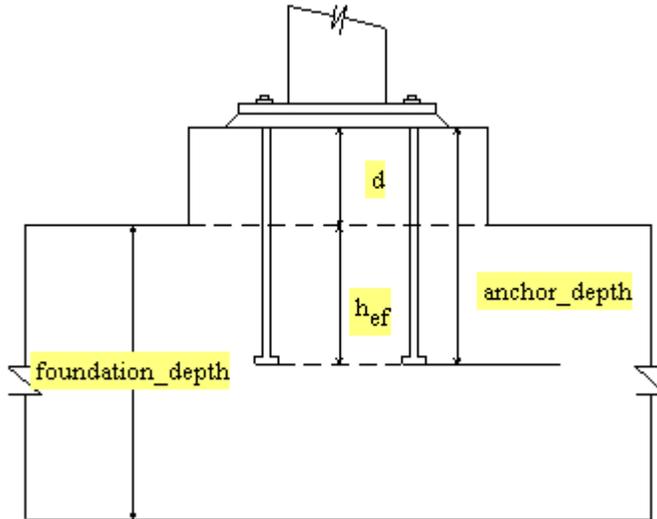

$d :=$ VARIES
 $h_{ef} :=$ 10in (minimum)

To simplify the calculation, the effective embedment depth of the anchor bolt is taken as the length of the bolt that extends beneath the column pedestal. This results in a conservative estimate of the strength of concrete breakout and pryout.

Steel Strength of anchor in tension [ACI 318.05 D.5.1]

NOTE: ACI 318-05 Appendix D was adopted in lieu of ACI 318-02 in order to include the updated ductility requirements.

$$f_{ya} := 36\text{ksi} \quad n_{\text{anch}} := 4$$

$$f_{uta} := \min(1.9 \cdot f_{ya}, 125\text{ksi}, 58\text{ksi})$$

$$f_{uta} = 58000 \text{ psi}$$

Anchor Bolt Diameter: $d_o := 0.875\text{in}$

Net tensile area $A_{se} := 0.462\text{in}^2$ [Ref. 4.17]

$$N_{sa} := n_{\text{anch}} \cdot A_{se} \cdot f_{uta} \quad [\text{ACI 318.05 Eq D-3}]$$

$N_{sa} = 107.184 \cdot \text{kip}$ one anchor



Calculation Sheet

Project: BGCAPP
 Job Number: 743341
 Calc. No.: 24915- 10-DBC-00-00004
 Sheet No.: G-10 / G-83
 Sheet Rev.: D

Subject: Gas Bottle Canopy, Supports, Equip, & Misc. Foundations
 By: M. Bratt
 Date: 10/5/2009

Concrete breakout strength-Tension [ACI 318.05 D.5.2]

Concrete breakout strength based on a grouping of two anchors, since tension due to moment is the only tension present.

$$\begin{aligned} c_{a1} &:= 15\text{in} & s_1 &:= 12\text{in} \\ c_{a2} &:= 15\text{in} & s_2 &:= 12\text{in} \\ c_{a11} &:= 15\text{in} & f_c &= 4000\text{psi} \\ c_{a22} &:= 15\text{in} \end{aligned}$$

Bolts are not located near any edges of concrete.
 Use 15" because it is 1.5*hef

$$c_{amin} := \min(c_{a1}, c_{a11}, c_{a2}, c_{a22})$$

$$n_{anch_ten} := 2$$

Breakout Prism Properties

$$h'_{ef} := h_{ef}$$

$$A_{NCO} := 9 \cdot h'_{ef}{}^2$$

$$A_{NCO} = 900 \cdot \text{in}^2$$

$$A_{NC} := (1.5 \cdot h'_{ef} + s_1 + 1.5 \cdot h'_{ef}) \cdot (1.5 \cdot h'_{ef} + s_2 + 1.5 \cdot h'_{ef})$$

$$A_{NC} = 1764 \cdot \text{in}^2$$

$$A_{NC} := \min(A_{NC}, n_{anch_ten} \cdot A_{NCO})$$

$$A_{NC} = 1764 \cdot \text{in}^2$$

$$\text{anchor_status} := \text{"cast in"}$$

$$k_c := \text{if}(\text{anchor_status} = \text{"cast in"}, 24, 17)$$

$$k_c = 24$$

$$N_b := \begin{cases} 16 \cdot \text{psi}^{.5} \cdot \text{in}^{\frac{1}{3}} \cdot \sqrt{f_c} \cdot h'_{ef}{}^{\frac{5}{3}} & \text{if } 11\text{in} \leq h'_{ef} \leq 25\text{in} & \text{[ACI 318-05 EQ D-7]} \\ k_c \cdot \sqrt{f_c} \cdot h'_{ef}{}^{1.5} \cdot \text{psi}^{.5} \cdot \text{in}^{.5} & \text{otherwise} & \text{[ACI 318-05 EQ D-8]} \end{cases}$$

$$N_b = 48000 \text{ lbf}$$

Subject: Gas Bottle Canopy, Supports, Equip, & Misc. Foundations
 By: M. Bratt
 Date: 10/5/2009

$$e'_N := 6 \text{ in}$$

Assumption that only one row of anchors on one side of the column center line carry tension load. Eccentricity is therefore distance from this row of anchors to the column center line

$$\Psi_{ecN} := \min\left(\frac{1}{1 + \frac{2 \cdot e'_N}{3 \cdot h'_{ef}}}, 1.0\right) \quad [\text{ACI 318-05 EQ D-9}]$$

$$\Psi_{ecN} = 1$$

$$\Psi_{edN} := \begin{cases} 1 & \text{if } c_{amin} \geq 1.5 \cdot h'_{ef} \\ 0.7 + 0.3 \cdot \frac{c_{amin}}{1.5(h'_{ef})} & \text{if } c_{amin} < 1.5 \cdot h'_{ef} \end{cases} \quad \begin{matrix} [\text{ACI 318-05 EQ D-10}] \\ [\text{ACI 318-05 EQ D-11}] \end{matrix}$$

$$\Psi_{edN} = 1$$

$$\Psi_{cN} := \begin{cases} 1.25 & \text{if anchor_status} = \text{"cast in"} \\ 1.4 & \text{otherwise} \end{cases} \quad [\text{ACI 318-05 EQ D.5.2.6}]$$

$$\Psi_{cN} = 1$$

$$\Psi_{cpN} := 1 \quad [\text{ACI 318-05 D5.2.7}]$$

$$N_{cbg} := \frac{A_{NC}}{A_{NCO}} \cdot \Psi_{ecN} \cdot \Psi_{edN} \cdot \Psi_{cN} \cdot \Psi_{cpN} \cdot N_b \quad [\text{ACI 318-05 EQ D-5}]$$

$$N_{cbg} = 84 \cdot \text{kip} \quad \text{Group of two anchors}$$

Pullout Strength of Anchor in Tension [ACI 318-05 D.5.3]

$$A_{brg} := 0.891 \text{ in}^2 \quad \text{crack_status} := \text{"not cracked"} \quad \text{hook_status} := \text{"not hooked"}$$

$$N_p := 8 \cdot A_{brg} \cdot f_c \quad [\text{ACI 318-02 EQ D-15}]$$

$$\Psi_{cP} := \text{if}[(\text{crack_status} = \text{"cracked"}), 1.4, 1.0] \quad [\text{ACI 318-05 D.5.3.6}]$$

$$N_{pn} := \Psi_{cP} \cdot N_p \quad [\text{ACI 318-02 EQ D-14}]$$

$$N_{pn} = 28.512 \cdot \text{kip} \quad \text{One Anchor}$$

Subject: Gas Bottle Canopy, Supports, Equip, & Misc. Foundations
 By: M. Bratt
 Date: 10/5/2009

Concrete side-face blowout strength-Tension [ACI 318.05 D.5.4]

$$c_{a1} = 15 \cdot \text{in}$$

$$N_{sb} := 160 \frac{\text{lbf}}{\text{in}} \cdot c_{a1} \cdot \sqrt{\frac{A_{brg}}{\text{in}^2}} \cdot \sqrt{\frac{f_c}{\text{psi}}} \quad [\text{ACI 318-05 EQ D-17}] \quad A_{brg} = 0.891 \cdot \text{in}^2$$

$$N_{sb} = 143.278 \cdot \text{kip} \quad \text{one anchor}$$

Tension Design Check

$$N_{sa} = 107184 \text{ lbf} \quad \text{one anchor} \quad N_{pn} = 28512 \text{ lbf} \quad \text{one anchor}$$

$$N_{cbg} = 84000 \text{ lbf} \quad \text{two anchors} \quad N_{sb} = 143278 \text{ lbf} \quad \text{one anchor}$$

$$\Phi_{\text{tension}} := 0.85 \quad \text{Anchor governed by concrete breakout, side-face blowout, pullout, or pryout strength. Condition A is met [ACI 318-05 D.4.4]}$$

$$N_{\text{design}} := \Phi_{\text{tension}} \cdot \min\left(N_{sa}, \frac{N_{cbg}}{2}, N_{pn}, N_{sb}\right) \quad [\text{ACI 318-05 D.4.1.1}]$$

$$N_{\text{design}} = 24.235 \cdot \text{kip}$$

$$T_{\text{one_anchor}} = 18.043 \cdot \text{kip}$$

$$\text{tension_design} := \text{if}(T_{\text{one_anchor}} \leq N_{\text{design}}, \text{"Good"}, \text{"Not Good"}) \quad [\text{ACI 318-05 EQ D-1}]$$

$$\text{tension_design} = \text{"Good"}$$



Calculation Sheet

Project: BGCAPP
 Job Number: 743341
 Calc. No.: 24915- 10-DBC-00-00004
 Sheet No.: G-13 / G-83
 Sheet Rev.: D

Subject: Gas Bottle Canopy, Supports, Equip, & Misc. Foundations
 By: M. Bratt
 Date: 10/5/2009

Steel Strength of Anchor in Shear [ACI 318-05 D.6.1]

Anchor Types:

AT1 [ACI 318-05 D.6.1.a]

AT2 [ACI 318-05 D.6.1.b]

AT3 [ACI 318-05 D.6.1.c]

Anchor Type Used:

AT := "AT1"

Grout Pad Factor [ACI 318-05 D.6.1.3]:

grout_pad_used := "yes"

$$c_{\text{pad}} := \begin{cases} 0.8 & \text{if grout_pad_used} = \text{"yes"} \\ 1.0 & \text{otherwise} \end{cases}$$

$c_{\text{pad}} = 1$

Shear Strength:

$$V_{\text{sa}} := \begin{cases} c_{\text{pad}} \cdot n_{\text{anch}} \cdot A_{\text{se}} \cdot f_{\text{uta}} & \text{if AT} = \text{"AT1"} \\ c_{\text{pad}} \cdot n_{\text{anch}} \cdot 0.6 \cdot A_{\text{se}} \cdot f_{\text{uta}} & \text{if AT} = \text{"AT2"} \\ c_{\text{pad}} \cdot n_{\text{anch}} \cdot 0.6 \cdot A_{\text{se}} \cdot f_{\text{uta}} & \text{if AT} = \text{"AT3"} \end{cases}$$

[ACI 318-05 EQ D-19]
 [ACI 318-05 EQ D-20]
 [ACI 318-05 EQ D-20]

$V_{\text{sa}} = 85.747 \cdot \text{kip}$ one anchor



Calculation Sheet

Project: BGCAPP
 Job Number: 743341
 Calc. No.: 24915- 10-DBC-00-00004
 Sheet No.: G-14 / G-83
 Sheet Rev.: D

Subject: Gas Bottle Canopy, Supports, Equip, & Misc. Foundations
 By: M. Bratt
 Date: 10/5/2009

Concrete Breakout Strength-Shear [ACI 318-05 D.6.2]

group_status := "group"

Projected Concrete Failure Area [ACI 318-05 D.6.2.1, RD.6.2.1]

$c_{a1} = 1 \text{ ft}$ Assuming that total shear is critical on one anchor row

$h_a := 6. \text{in}$ Thickness of pedestal

$s_1 = 1 \text{ ft}$ Anchor Bolt Spacing

$c := \begin{cases} 1.5 \cdot c_{a1} & \text{if } 1.5 \cdot c_{a1} < c_{a2} \\ c_{a2} & \text{otherwise} \end{cases}$ $c = 1 \text{ ft}$

$A_{vc} := \begin{cases} [2 \cdot (c) + s_1] \cdot h_a & \text{if } 1.5c_{a1} > h_a \\ 2 \cdot [(c) + s_1] \cdot 1.5 \cdot c_{a1} & \text{otherwise} \end{cases}$ [ACI 318-05 Fig RD.6.2.1(b)]
 Failure area for group of anchors

$$A_{vc} = 2 \text{ ft}^2$$

$$A_{vco} := 4.5 \cdot c_{a1}^2$$

$$A_{vco} = 7 \text{ ft}^2 \quad \text{[ACI 318-05 EQ D-23]}$$

$$A_{vc} := \min(A_{vc}, n_{\text{anch}} \cdot A_{vco})$$

$$A_{vc} = 2 \text{ ft}^2$$

Basic Concrete Breakout Strength [ACI 318-05 D.6.2.2]

$l_e := h_{ef}$ anchor load bearing length

$$V_b := 7 \cdot \left(\frac{l_e}{d_o} \right)^{0.2} \cdot \sqrt{d_o} \cdot \sqrt{f_c} \cdot c_{a1}^{1.5} \cdot \text{psi}^{.5} \quad \text{[ACI 318-05 EQ D.24]}$$

$$V_b = 39162 \text{ lbf}$$

Calculation Sheet

Project: BGCAPP
 Job Number: 743341
 Calc. No.: 24915- 10-DBC-00-00004
 Sheet No.: G-15 / G-83
 Sheet Rev.: D

Subject: Gas Bottle Canopy, Supports, Equip, & Misc. Foundations
 By: M. Bratt
 Date: 10/5/2009

$e'_v := 0 \text{ in}$ Assumption that shear is distributed equal to all anchors and no shear eccentricity results

$$\Psi_{ecV} := \min\left(1, \frac{1}{1 + 2 \cdot \frac{e'_v}{3 \cdot c_{a1}}}\right)$$

$$\Psi_{ecV} = 1$$

$$c_{a2} = 1 \text{ ft}$$

$$\Psi_{edV} := \begin{cases} 1.0 & \text{if } c_{a2} \geq 1.5 \cdot c_{a1} & \text{[ACI 318-05 EQ D-27]} \\ 0.7 + 0.3 \cdot \frac{c_{a2}}{1.5 \cdot c_{a1}} & \text{if } c_{a2} < 1.5 \cdot c_{a1} & \text{[ACI 318-05 EQ D-28]} \end{cases}$$

$$\Psi_{edV} = 1$$

crack_status = "not cracked"

$$\Psi_{cV} := \begin{cases} 1.4 & \text{if crack_status = "not cracked"} \\ 1.0 & \text{if crack_status = "cracked no reinforce"} \\ 1.2 & \text{if crack_status = "cracked with reinforce"} \\ 1.4 & \text{if crack_status = "cracked with reinforce and stirrups"} \end{cases}$$

$$\Psi_{cV} = 1$$

$$V_{cb} := \begin{cases} \frac{A_{vc}}{A_{vco}} \cdot \Psi_{edV} \cdot \Psi_{cV} \cdot V_b & \text{if group_status = "single anchor"} & \text{[ACI 318-05 EQ D-21]} \\ 0 & \text{otherwise} \end{cases}$$

$$V_{cbg} := \begin{cases} \frac{A_{vc}}{A_{vco}} \cdot \Psi_{ecV} \cdot \Psi_{edV} \cdot \Psi_{cV} \cdot V_b & \text{if group_status = "group"} & \text{[ACI 318-05 EQ D-22]} \\ 0 & \text{otherwise} \end{cases}$$

$$V_{cb} = 0 \text{ lbf}$$

$$V_{cbg} = 12 \cdot \text{kip} \quad \text{group of 2 anchors}$$

Subject: Gas Bottle Canopy, Supports, Equip, & Misc. Foundations
 By: M. Bratt
 Date: 10/5/2009

Concrete pryout strength of anchor in shear [ACI 318-05 D.6.3]

$$h_{ef} = 1 \text{ ft}$$

$$k_{cp} := \begin{cases} 1.0 & \text{if } h_{ef} < 2.5 \text{ in} \\ 2.0 & \text{if } h_{ef} \geq 2.5 \text{ in} \end{cases}$$

$$V_{cp} := \begin{cases} k_{cp} \cdot N_{cb} & \text{if group_status} = \text{"single anchor"} \\ 0 & \text{otherwise} \end{cases} \quad [\text{ACI 318-05 EQ D-29}]$$

$$V_{cpg} := \begin{cases} k_{cp} \cdot N_{cbg} & \text{if group_status} = \text{"group"} \\ 0 & \text{otherwise} \end{cases} \quad [\text{ACI 318-05 EQ D-30}]$$

$$V_{cpg} = 168 \cdot \text{kip} \quad \text{group of 2 anchors}$$

Shear Design Check

$$V_{sa} = 85747 \text{ lbf} \quad \text{one anchor}$$

$$V_{cbg} = 12281 \text{ lbf} \quad \text{group of 2 anchors}$$

$$V_{cpg} = 168000 \text{ lbf} \quad \text{group of 2 anchors}$$

$$\Phi_{\text{shear}} := 0.85 \quad \text{Anchor governed by concrete breakout, side-face blowout, pullout, or pryout strength [ACI 318-05 D.4.4]}$$

$$V_{\text{design}} := \Phi_{\text{shear}} \cdot \min(V_{sa} \cdot 4, V_{cbg}, V_{cpg}) \quad [\text{ACI 318-05 D.4.1.1}]$$

$$V_{\text{design}} = 10.439 \cdot \text{kip}$$

$$\text{design_shear} := \text{if}(V \leq V_{\text{design}}, \text{"Design is OK"}, \text{"Design is insufficient"})$$

$$\text{design_shear} = \text{"Design is OK"} \quad [\text{ACI 318-05 EQ D-2}]$$



Calculation Sheet

Project: BGCAPP
Job Number: 743341
Calc. No.: 24915- 10-DBC-00-00004
Sheet No.: G-17 / G-83
Sheet Rev.: D

Subject: Gas Bottle Canopy, Supports, Equip, & Misc. Foundations
By: M. Bratt
Date: 10/5/2009

Interaction of tensile and shear forces [ACI 318-05 D.7]

$$\frac{V}{V_{\text{design}}} + \frac{T_{\text{one_anchor}}}{N_{\text{design}}} = 0.931$$

$$ST_{\text{check}} := \text{if} \left(\frac{V}{V_{\text{design}}} + \frac{T_{\text{one_anchor}}}{N_{\text{design}}} \leq 1.2, \text{"Interaction OK"}, \text{"Interaction Failure"} \right)$$


$$\text{interaction_check_V} := \text{if} \left[\left(V > 0.2 \cdot V_{\text{design}} \wedge T_{\text{one_anchor}} > N_{\text{design}} \right), ST_{\text{check}}, \text{"No check needed"} \right]$$

$$\text{interaction_check_V} = \text{"No check needed"}$$


Subject: Gas Bottle & Misc Support Calculations
By: M. Bratt
Date: 10/5/09

Anchor Bolt and Base Plate Design

Load Sign Convention

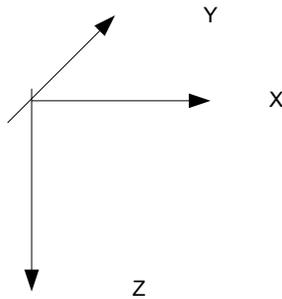

$b_f := 8.0\text{in}$
 $d := 8.0\text{in}$ (ref 4.13)

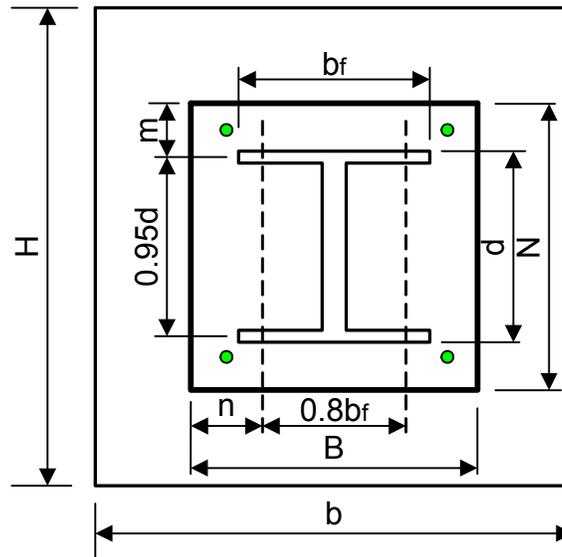

W8x31 beam size

Plate dimension in direction of column major axis

$N := 16\text{in}$

Plate dimension in direction of column minor axis

$B := 16\text{in}$

Per structural typical detail 2
on dwg 000-SO-00-00006

Base Plate thickness

$t_{PL} := 1.0\text{in}$

Base plate strength

$F_y := 50\text{ksi}$

$$m := \frac{N - 0.95 \cdot d}{2} \quad m = 4.2\text{-in}$$

$$n := \frac{N - 0.8 \cdot b_f}{2} \quad n = 4.8\text{-in}$$

Footing Dimensions

Pier Height: $h_p := 6.5\text{in}$

Footing Pad Thickness: $t_p := 2.0\text{ft}$

Pier Cross-sectional dimensions: $h := 24\text{in}$ $b := 24\text{in}$

Subject: Gas Bottle & Misc Support Calculations
By: M. Bratt
Date: 10/5/09

Anchor Bolt Design

Length of anchor Bolt embedded in concrete: $L_{\text{bolt}} := 15\text{in}$

$s_1 := 12\text{in}$ $s_2 := 12\text{in}$ Spacing between anchor bolts

Is the anchor bolt failure plane truncated by pier dimensions?

$$\text{breakout}_{\text{cone.}} := \text{if} \left[L_{\text{bolt}} > h_p + \left(\frac{\text{if}(b < h, b, h) - \text{if}(b < h, s_2, s_1)}{2} \right) \cdot \left(\frac{1}{1.5} \right), \text{"by embedment depth"}, \text{"by pier dimensions"} \right]$$

$\text{breakout}_{\text{cone.}} = \text{"by embedment depth"}$


The second term in the check shown here is used to determine if, even though the anchor is embedded in the pad, whether the failure plane would extend back up into the area of the pier.

$$c_{a1} := \frac{b - s_1}{2} \quad c_{a1} = 6\text{-in}$$

$$c_{a11} := \frac{b - s_1}{2} \quad c_{a11} = 6\text{-in}$$

$$c_{a2} := \frac{h - s_2}{2} \quad c_{a2} = 6\text{-in}$$

$$c_{a22} := \frac{h - s_2}{2} \quad c_{a22} = 6\text{-in}$$

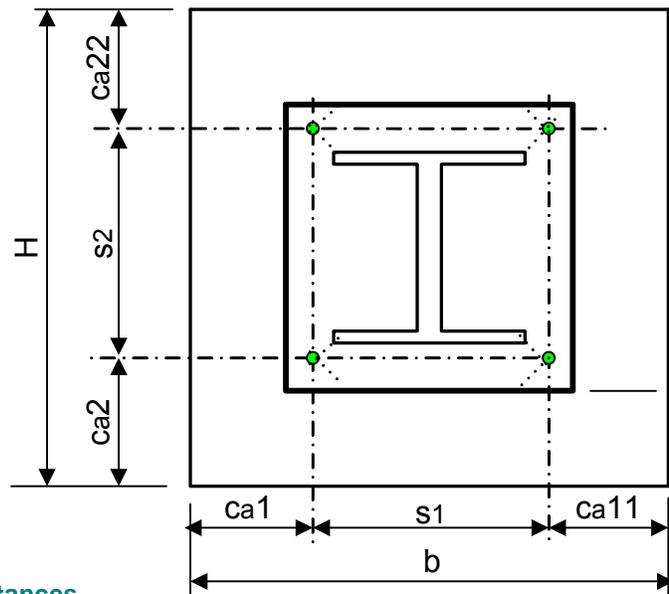

Pier Edge Distances

Subject: Gas Bottle & Misc Support Calculations
By: M. Bratt
Date: 10/5/09

To determine the effective depth of the anchor bolts:

Per ACI 318 section D.5.2.3, if the anchors are located less than $1.5h_{ef}$ from three or more edges,

$$h'_{ef} := \max\left(\frac{\max(c_{a1}, c_{a11}, c_{a2}, c_{a22})}{1.5}, \frac{1}{3} \cdot \max(s_1, s_2)\right) \quad h'_{ef} = 4 \cdot \text{in}$$

$$h_{ef} := \begin{cases} h'_{ef} & \text{if } h_p \geq L_{\text{bolt}} \\ L_{\text{bolt}} - h_p & \text{otherwise} \end{cases}$$

$$h_{ef} = 8.5 \cdot \text{in}$$

Adjust breakout cone dimensions if failure plane is not truncated by pier dimensions.
If pier truncates breakout cone, edge distances will stay the same.

$$c_{a1} := \text{if } \left[h_p \geq h_{ef}, \left(\frac{b - s_1}{2} \right), 1.5 \cdot h_{ef} \right] \quad c_{a1} = 12.75 \cdot \text{in}$$

$$c_{a11} := \text{if } \left[h_p \geq h_{ef}, \left(\frac{b - s_1}{2} \right), 1.5 \cdot h_{ef} \right] \quad c_{a11} = 12.75 \cdot \text{in}$$

$$c_{a2} := \text{if } \left[h_p \geq h_{ef}, \left(\frac{h - s_2}{2} \right), 1.5 \cdot h_{ef} \right] \quad c_{a2} = 12.75 \cdot \text{in}$$

$$c_{a22} := \text{if } \left[h_p \geq h_{ef}, \left(\frac{h - s_2}{2} \right), 1.5 \cdot h_{ef} \right] \quad c_{a22} = 12.75 \cdot \text{in}$$


Subject: Gas Bottle & Misc Support Calculations
 By: M. Bratt
 Date: 10/5/09

Total depth of footing: $h_a := h_p + t_p$ $h_a = 30.5\text{-in}$

Concrete strength: $f'_c := 4000\text{psi}$

Number of anchors used:

$no := 4$ Type ASTM F1554 Bolt Grade 36
 Per 24915-000-S0-00-00005 Rev 0

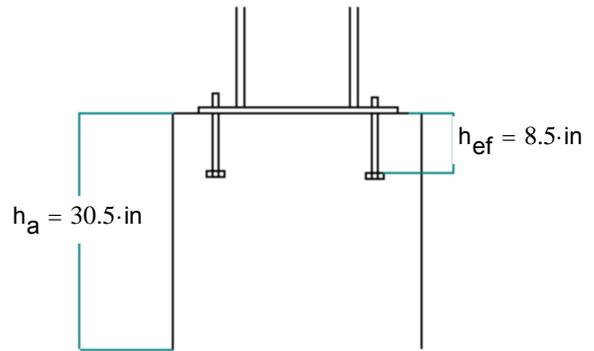

Anchor Bolt Properties:

Bolt diameter $d_b := \left(\frac{7}{8}\right)\text{in}$

Effective Area: $A_{se} = (0.462) \cdot \text{in}^2$ [Ref 4.5 Table 34-2]

Yield Strength: $f_{ya} := 36000\text{psi}$

Ultimate Strength: $f_{uta} := 58000\text{psi}$

$f_{uta} := \min(f_{uta}, 1.9 \cdot f_{ya}, 125000\text{psi})$ [Ref 4.5, Sec D.5.1]

$f_{uta} = 58\text{-ksi}$

Subject: Gas Bottle & Misc Support Calculations
By: M. Bratt
Date: 10/5/09

Steel Strength of anchor group in tension

$$N_{sa} := n \cdot A_{se} \cdot f_{uta}$$

$$N_{sa} = (107.2) \cdot \text{kip}$$

Concrete breakout strength of anchor group in tension

$$A_{Nco} := 9 \cdot h_{ef}^2 \quad (D-6)$$

$$A_{Nco} = 650.25 \cdot \text{in}^2$$

Per ACI 318 section D.5.2.1 A_{Nc} must be less than $n \cdot A_{Nco}$

$$A_{Nc} := (\min(1.5 \cdot h_{ef}, c_{a1}) + s_1 + \min(1.5 \cdot h_{ef}, c_{a1})) \cdot (\min(1.5 \cdot h_{ef}, c_{a2}) + s_2 + \min(1.5 \cdot h_{ef}, c_{a2}))$$

$$A_{Nc} = 1406.25 \cdot \text{in}^2$$

$$\text{Check}_{Anc} := \text{if}(A_{Nc} < n \cdot A_{Nco}, \text{"OK"}, \text{"NOT OK"})$$

$$\text{Check}_{Anc} = \text{"OK"}$$

$$N_b := \begin{cases} 16 \cdot \sqrt{\frac{f_c}{\text{psi}}} \cdot \frac{h_{ef}^{\frac{5}{3}}}{\text{in}^{\frac{5}{3}}} \cdot \text{lbf} & \text{if } 25 \text{in} \geq h_{ef} \geq 11 \text{in} \\ 24 \cdot \sqrt{\frac{f_c}{\text{psi}}} \cdot \frac{h_{ef}^{1.5}}{\text{in}^{1.5}} \cdot \text{lbf} & \text{otherwise} \end{cases} \quad (D-7)$$

$$N_b = 37.62 \cdot \text{kip}$$

eccentricity of tension force on a group of bolts

$$e_{N'} := 0 \quad \begin{array}{l} \text{For concentric braced frames only.} \\ \text{Otherwise input a value of } e_N \end{array}$$

$$\Psi_{ec_N} := \begin{cases} \frac{1}{1 + \frac{2 \cdot e_{N'}}{3 \cdot h_{ef}}} & \text{if } \frac{1}{1 + \frac{2 \cdot e_{N'}}{3 \cdot h_{ef}}} < 1.0 \\ 1.0 & \text{otherwise} \end{cases} \quad (D-9)$$

$$\Psi_{ec_N} = 1$$

Subject: Gas Bottle & Misc Support Calculations
By: M. Bratt
Date: 10/5/09

$$\psi_{ed_N} := \begin{cases} 1 & \text{if } \min(c_{a1}, c_{a11}, c_{a2}, c_{a22}) > 1.5 \cdot h_{ef} \\ 0.7 + 0.3 \cdot \frac{\min(c_{a1}, c_{a11}, c_{a2}, c_{a22})}{1.5 h_{ef}} & \text{otherwise} \end{cases} \quad (D-10)$$

$$(D-11) \quad \psi_{ed_N} = 1$$

Per ACI 318 section D.5.2.6 $\psi_{c_N} =$

1.25 for cast in anchors

1.4 for post installed anchors, where the value of k_c is 17

$$\psi_{c_N} := 1.25$$

$$\psi_{c_N} = 1.25$$

$$N_{cbg} := \frac{A_{Nc}}{A_{Nco}} \cdot \psi_{ec_N} \cdot \psi_{ed_N} \cdot \psi_{c_N} \cdot N_b$$

$$N_{cbg} = 101.7 \cdot \text{kip}$$

Pullout strength of anchor in tension

$$A_{brg} = (0.891) \cdot \text{in}^2 \quad [\text{Ref 4.17 Table 34-2}]$$

$$N_p := 8 \cdot A_{brg} \cdot f_c \quad (D-15)$$

$$N_p = (28.51) \cdot \text{kip}$$

$$\psi_{c_P} := 1.0 \quad \begin{array}{l} \text{Use 1.0 if cracked} \\ 1.4 \text{ if uncracked} \end{array} \quad (D.5.3.6)$$

$$N_{pn} := n_0 \cdot \psi_{c_P} \cdot N_p$$

$$N_{pn} = (114) \cdot \text{kip}$$

Concrete side face blowout strength of headed anchor in tension

$$N_{sb} := \begin{cases} \left(160 \cdot \min(c_{a1}, c_{a11}, c_{a2}, c_{a22}) \cdot \sqrt{\frac{A_{brg}}{\text{in}^2}} \cdot \sqrt{\frac{f_c}{\text{psi}}} \right) \cdot \text{psi} \cdot \text{in} & \text{if } \min(c_{a1}, c_{a11}, c_{a2}, c_{a22}) < 0.4 h_{ef} \\ \text{"tension does not control"} & \text{otherwise} \end{cases} \quad (D-15)$$

If $\min(c_{a1}, c_{a11}, c_{a2}, c_{a22}) > 0.4 h_{ef}$, then the blowout strength of the headed anchor in tension does not control.

$$N_{sbg} := \begin{cases} \left(1 + \frac{\min(s_1, s_2)}{6 \cdot \min(c_{a1}, c_{a11}, c_{a2}, c_{a22})} \right) \cdot N_{sb} & \text{if } N_{sb} \neq \text{"tension does not control"} \\ \text{"tension does not control"} & \text{otherwise} \end{cases}$$

$$N_{sbg} = \text{"tension does not control"}$$

Subject: Gas Bottle & Misc Support Calculations
By: M. Bratt
Date: 10/5/09

Steel strength of anchor group in shear

$$V_{sa} := 0.6n_o \cdot A_{se} \cdot f_{uta}$$

$$V_{sa} = (64.3) \cdot \text{kip}$$

Concrete breakout strength of anchor in shear

Per ACI 318 section D.6.2.4, since the anchors are located less than $1.5c_{a1}$ from three of more edges

$$c_1 := \min\left(c_{a1}, \max\left(\frac{\max(c_{a2}, c_{a22})}{1.5}, \frac{1}{3} \cdot \max(s_1, s_2), \frac{h_a}{1.5}\right)\right)$$

$$c_1 = 12.75 \cdot \text{in}$$

$$A_{Vco} := 4.5 \cdot \min(c_1)^2 \quad (\text{D-22})$$

$$A_{Vco} = 731.53 \cdot \text{in}^2$$

Per ACI 318 section D.6.2.1, V_{Nc} must be less than $n \cdot V_{Nco}$

$$A_{Vc} := (\min(1.5 \cdot c_1, c_{a1}) + s_1 + \min(1.5c_1, c_{a11})) \cdot (\min(1.5c_1, h_a))$$

$$A_{Vc} := \begin{cases} n_o \cdot A_{Vco} & \text{if } A_{Vc} > n_o \cdot A_{Vco} \\ A_{Vc} & \text{otherwise} \end{cases}$$

$$A_{Vc} = 717.19 \cdot \text{in}^2$$

$$l_e := \min(8 \cdot d_b, h_{ef}, 25 \cdot \text{in})$$

$$l_e = 7 \cdot \text{in}$$

$$V_b := 7 \left(\frac{l_e}{d_b}\right)^{0.2} \cdot \sqrt{d_b} \cdot \sqrt{\frac{f_c}{\text{psi}}} \cdot \min(c_1)^{1.5} \cdot \text{psi} \quad (\text{D-23})$$

$$V_b = 28.58 \cdot \text{kip}$$

eccentricity of shear force on a group of bolts

$$e_v := 0 \quad \begin{array}{l} \text{For concentric braced frames only.} \\ \text{Otherwise input value of } e_v \end{array}$$

Subject: Gas Bottle & Misc Support Calculations
 By: M. Bratt
 Date: 10/5/09

$$\psi_{ec_V} := \begin{cases} \frac{1}{1 + \frac{2 \cdot e_V}{3 \cdot \min(c_1)}} & \text{if } \frac{1}{2 \cdot e_V} < 1.0 \\ 1.0 & \text{otherwise} \end{cases} \quad (D-25)$$

$$\psi_{ec_V} = 1$$

$$\psi_{ed_V} := \begin{cases} 1 & \text{if } \min(c_{a2}, c_{a22}) > 1.5 \cdot \min(c_1) \\ 0.7 + 0.3 \cdot \frac{\min(c_{a2}, c_{a22})}{1.5 \min(c_1)} & \text{otherwise} \end{cases}$$

$$\psi_{ed_V} = 0.9$$

Per ACI318 section D.6.2.7 $\psi_{c_V} =$

1.0 for anchors in cracked concrete with no edge reinforcement.

1.2 for anchors with No. 4 or greater bars between the anchor and the edge.

1.4 for anchors with No. 4 or greater bars between the anchor and the edge, and with stirrups enclosing the supplemental steel.

$$\psi_{c_V} := 1.2$$

$$\psi_{c_V} = 1.2$$

$$V_{cbg} := \frac{A_{Vc}}{A_{Vco}} \cdot \psi_{ec_V} \cdot \psi_{ed_V} \cdot \psi_{c_V} \cdot V_b$$

$$V_{cbg} = 30.3 \cdot \text{kip}$$

Concrete pryout strength of anchor in shear

$$k_{cp} := \begin{cases} 1.0 & \text{if } h_{ef} < 2.5 \text{in} \\ 2.0 & \text{if } h_{ef} > 2.5 \text{in} \end{cases}$$

$$k_{cp} = 2$$

$$V_{cpg} := k_{cp} \cdot N_{cbg}$$

$$V_{cpg} = 203.4 \cdot \text{kip}$$



Calculation Sheet

Anchor Bolt Design

Project: BGCAPP
 Job Number: 743341
 Calc. No.: 24915-10-DBC-00-00004
 Sheet No.: G-26 of G-83
 Sheet Rev.: D

Subject: Gas Bottle & Misc Support Calculations
 By: M. Bratt
 Date: 10/5/09

Limit States of Anchors Under Shear and Tension Loading

Tensile Limit States Summary

Steel Strength of Anchor Group: $N_{sa} = (107.18) \cdot \text{kip}$

Concrete Breakout Strength of Group: $N_{cbg} = 101.69 \cdot \text{kip}$

Concrete Side-face Blowout Strength of Group: $N_{sbg} = \text{"tension does not control"}$

Pullout Strength of Anchor Group: $N_{pn} = (114.05) \cdot \text{kip}$

Design Tensile Allowable:
$$N_n := \begin{cases} \min(N_{sa}, N_{cbg}, N_{sbg}, N_{pn}) & \text{if } N_{sb} \neq \text{"tension does not control"} \\ \min(N_{sa}, N_{cbg}, N_{pn}) & \text{otherwise} \end{cases}$$

$N_n = 101.69 \cdot \text{kip}$

Shear Limit States Summary

Steel Strength of Anchor Group: $V_{sa} = (64.31) \cdot \text{kip}$

Concrete Breakout Strength of Group: $V_{cbg} = 30.26 \cdot \text{kip}$

Concrete Pryout Strength of Group: $V_{cpg} = 203.37 \cdot \text{kip}$

Design Shear Allowable: $V_n := \min(V_{sa}, V_{cbg}, V_{cpg})$

$V_n = 30.26 \cdot \text{kip}$



Calculation Sheet

Anchor Bolt Design

Project: BGCAPP
 Job Number: 743341
 Calc. No.: 24915-10-DBC-00-00004
 Sheet No.: G-27 of G-83
 Sheet Rev.: D

Subject: Gas Bottle & Misc Support Calculations
 By: M. Bratt
 Date: 10/5/09

Loads from Calc. 24915-10-SSC-00-00006 [Ref. 4.18]

Service Axial Loads

Dead Load $N_D := 7.34 \text{ kip}$
 Live Load $N_L := 0 \text{ kip}$
 Roof Live Load $N_{Lr} := 0 \text{ kip}$
 Snow Load $N_S := 0.81 \text{ kip}$
 Wind Load $N_W := 1.333 \text{ kip}$
 Seismic Load $N_E := 0 \text{ kip}$

Service Shear Loads

Dead Load $V_D := 0.81 \text{ kip}$
 Live Load $V_L := 0 \text{ kip}$
 Roof Live Load $V_{Lr} := 0 \text{ kip}$
 Snow Load $V_S := 0 \text{ kip}$
 Wind Load $V_W := 1.93 \text{ kip}$
 Seismic Load $V_E := 0 \text{ kip}$

Service Moments

$M_D := 27.37 \text{ kip-ft}$
 $M_W := 26.65 \text{ kip-ft}$
 $M_E := \max(M_D, M_W)$

ASCE 7 Load Combinations [Ref 4.4]

$P_1 := 1.4 \cdot N_D$		
$P_2 := 1.2N_D + 1.6 \cdot N_L + 0.5N_{Lr}$	$P_{11} := 1.2N_D - 1.6 \cdot N_W + 0.5N_L + 0.5N_S$	
$P_3 := 1.2N_D + 1.6 \cdot N_L + 0.5N_S$	$P_{12} := 1.2N_D + 1.6 \cdot N_W + 0.5N_L + 0.5N_{Lr}$	10.28
$P_4 := 1.2N_D + 1.6N_{Lr} + 0.5N_L$	$P_{13} := 1.2N_D - 1.6 \cdot N_W + 0.5N_L + 0.5N_{Lr}$	8.81
$P_5 := 1.2N_D + 1.6N_{Lr} + 0.8N_W$	$P_{14} := 1.2N_D + 1.0N_E + 0.5N_L + 0.2N_S$	9.21
$P_6 := 1.2N_D + 1.6N_{Lr} - 0.8N_W$	$P_{15} := 1.2N_D - 1.0N_E + 0.5N_L + 0.2N_S$	8.81
$P_7 := 1.2N_D + 1.6N_S + 0.5N_L$	$P_{16} := 0.9N_D + 1.6N_W$	9.87
$P_8 := 1.2N_D + 1.6N_S + 0.8N_W$	$P_{17} := 0.9N_D - 1.6N_W$	7.74
$P_9 := 1.2N_D + 1.6N_S - 0.8N_W$	$P_{18} := 0.9N_D + 1.0N_E$	10.1
$P_{10} := 1.2N_D + 1.6 \cdot N_W + 0.5N_L + 0.5N_S$	$P_{19} := 0.9N_D - 1.0N_E$	11.17
		9.04
		$P = 11.35 \cdot \text{kip}$
		7.08
		10.94
$P_{\max} := \max(P)$	$P_{\max} = 11.35 \cdot \text{kip}$	6.68
		8.97
$P_{\min} := \min(P)$	$P_{\min} = 4.47 \cdot \text{kip}$	8.97
		8.74
$N_{ua} := \begin{cases} P_{\min} & \text{if } P_{\min} \leq 0 \\ 0 & \text{otherwise} \end{cases}$	$N_{ua} = 0 \cdot \text{kip}$	4.47
		6.61
		6.61



Calculation Sheet

Anchor Bolt Design

Project: BGCAPP
 Job Number: 743341
 Calc. No.: 24915-10-DBC-00-00004
 Sheet No.: G-28 of G-83
 Sheet Rev.: D

Subject: Gas Bottle & Misc Support Calculations
 By: M. Bratt
 Date: 10/5/09

ASCE 7 Load Combinations [Ref 4.4]

$V_1 := 1.4 \cdot V_D$	$V_{10} := 1.2V_D + 1.6 \cdot V_W + 0.5V_L + 0.5V_S$
$V_2 := 1.2V_D + 1.6 \cdot V_L + 0.5V_{Lr}$	$V_{11} := 1.2V_D - 1.6 \cdot V_W + 0.5V_L + 0.5V_S$
$V_3 := 1.2V_D + 1.6 \cdot V_L + 0.5V_S$	$V_{12} := 1.2V_D + 1.6 \cdot V_W + 0.5V_L + 0.5V_{Lr}$
$V_4 := 1.2V_D + 1.6V_{Lr} + 0.5V_L$	$V_{13} := 1.2V_D - 1.6 \cdot V_W + 0.5V_L + 0.5V_{Lr}$
$V_5 := 1.2V_D + 1.6V_{Lr} + 0.8V_W$	$V_{14} := 1.2V_D + 1.0V_E + 0.5V_L + 0.2V_S$
$V_6 := 1.2V_D + 1.6V_{Lr} - 0.8V_W$	$V_{15} := 1.2V_D - 1.0V_E + 0.5V_L + 0.2V_S$
$V_7 := 1.2V_D + 1.6V_S + 0.5V_L$	$V_{16} := 0.9V_D + 1.6V_W$
$V_8 := 1.2V_D + 1.6V_S + 0.8V_W$	$V_{17} := 0.9V_D - 1.6V_W$
$V_9 := 1.2V_D + 1.6V_S - 0.8V_W$	$V_{18} := 0.9V_D + 1.0V_E$
	$V_{19} := 0.9V_D - 1.0V_E$

$V_i := \text{if}[V_i < 0 \text{ kip}, (-V)_i, V_i]$ **convert negative values into positive**

$V_{\max} := \max(V)$ $V_{\max} = 4.06 \cdot \text{kip}$

1.13
0.97
0.97
0.97
2.52
0.57
0.97
2.52
0.57
4.06 · kip
2.12
4.06
2.12
0.97
0.97
3.82
2.36
0.73
(0.73)

$P_{\text{seism}} := \begin{pmatrix} P_{14} \\ P_{15} \\ P_{18} \\ P_{19} \end{pmatrix}$	$P_{\text{seism}} = \begin{pmatrix} 8970 \\ 8970 \\ 6606 \\ 6606 \end{pmatrix} \text{ lb}$
--	--

condition := $\begin{cases} \text{"tension"} & \text{if } M_E \neq 0 \text{ kip} \\ \text{"compression"} & \text{otherwise} \end{cases}$

condition = "tension"

Subject: Gas Bottle & Misc Support Calculations
 By: M. Bratt
 Date: 10/5/09

Base plate under condition = "tension"

Moments at the center line of column

$$e := \frac{M_E}{P_{seism}}$$

$$e^T = (36.62 \quad 36.62 \quad 49.72 \quad 49.72) \cdot \text{in}$$

$$e_{min} := \min(e) \quad e_{min} = 36.62 \cdot \text{in}$$

Ref 4.19, pg.56

$$\text{check}\left(\frac{N}{6} < e_{min} < \frac{N}{2}\right) = \text{"Not Ok!"}$$

Use following large eccentricities procedure

Tension in bolt due to tension load

$$T_1 := \frac{N_{ua}}{2} \quad T_1 = 0 \text{ lb}$$

Tension in bolt due to moment

$$T_2 := \frac{M_E}{2 \cdot s_2} \quad T_2 = 13.69 \cdot \text{kip}$$


$$T := T_1 + T_2 \quad T = 13.69 \cdot \text{kip}$$

Moment in the plate 1" strip

$$M_u := \frac{T \cdot (s_2 - d)}{2 \cdot (s_2 - d)}$$

$$t_{min} := \sqrt{\frac{4 \cdot |M_u|}{0.9 \cdot F_y}} \quad t_{min} = 0.78 \cdot \text{in}$$

$$\text{check}(t_{PL} > t_{min}) = \text{"Ok!"}$$

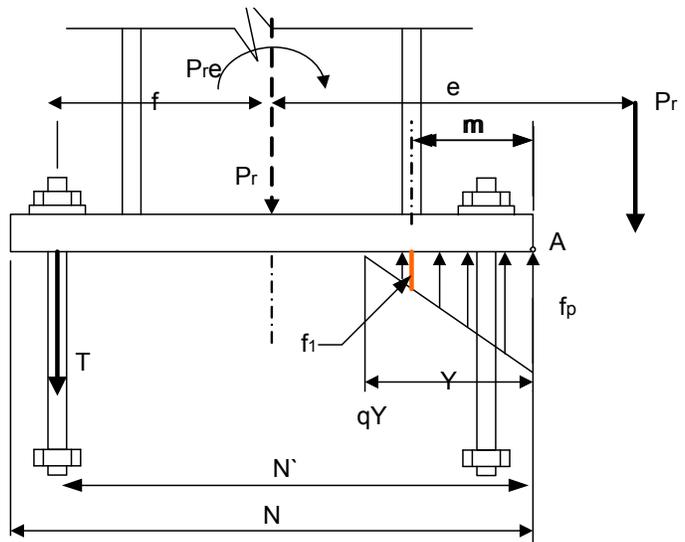



Calculation Sheet

Anchor Bolt Design

Project: BGCAPP
 Job Number: 743341
 Calc. No.: 24915-10-DBC-00-00004
 Sheet No.: G-31 of G-83
 Sheet Rev.: D

Subject: Gas Bottle & Misc Support Calculations
 By: M. Bratt
 Date: 10/5/09

strength reduction factors,

$$\phi_V := 0.65$$

$$\phi_N := 0.75$$

ASTM F1554 anchors are considered to be ductile
 Therefore Condition A load factors are used

OSHA check on Anchor Bolts [Ref 4.19 Sec 3.0]

$$P_{\text{worker}} := 300\text{ lbf} \quad \text{at} \quad e := 18\text{ in} + \frac{d}{2}$$

$$M_{\text{OSHA}} := P_{\text{worker}} \cdot e$$

$$M_{\text{OSHA}} = 0.55 \cdot \text{ft} \cdot \text{kip}$$

$$N_{\text{OSHA}} := \frac{M_{\text{OSHA}}}{\min(s_1, s_2)}$$

$$N_{\text{OSHA}} = 0.55 \cdot \text{kip}$$

$$\left| \frac{N_{\text{OSHA}}}{\phi_N \cdot N_n} \right| = 0.01$$

$$\text{test} := \begin{cases} \text{"OK"} & \text{if } \left| \frac{N_{\text{OSHA}}}{\phi_N \cdot N_n} \right| \leq 1.0 \\ \text{"NO GOOD"} & \text{otherwise} \end{cases}$$

$$\text{test} = \text{"OK"}$$



Calculation Sheet

Anchor Bolt Design

Project: BGCAPP
 Job Number: 743341
 Calc. No.: 24915-10-DBC-00-00004
 Sheet No.: G-32 of G-83
 Sheet Rev.: D

Subject: Gas Bottle & Misc Support Calculations
 By: M. Bratt
 Date: 10/5/09

Column with Tensile Load and Shear Load (D-7)

$$N_n = 101.69 \cdot \text{kip}$$

$$V_n = 30.26 \cdot \text{kip}$$

$$V_{\max} = 4.06 \cdot \text{kip}$$

$$N_{ua} := \max(T, N_{ua})$$

$$N_{ua} = 13.69 \cdot \text{kip}$$

Tension load

Individual Shear and Tension Checks

Tension interaction ratio check

$$\frac{N_{ua}}{\phi N_n} = 0.36$$

since moment is present, consider only 2 bolts will resist tension

$$\text{Tension}_{\text{chk}} := \text{if} \left[\left(\frac{N_{ua}}{\phi N_n} \right) < 1.0, \text{"OK"}, \text{"failure"} \right]$$

$$\text{Tension}_{\text{chk}} = \text{"OK"}$$

Shear interaction ratio check

$$\frac{V}{\phi V_n} =$$

(0.12)
0.1
0.1
0.1
0.26
0.06
0.1
0.26
0.06
0.41
0.22
0.41
0.22
0.1
0.1
0.39
0.24
0.07
(0.07)

Subject: Gas Bottle & Misc Support Calculations
By: M. Bratt
Date: 10/5/09

Find minimum embedment

$$g := c_{a1} - 1.5\text{in} - \frac{d_b}{2} - 0.5\text{in}$$

$$g = 10.31\text{in}$$

$$L_e := L_{\text{bolt}} - \frac{g}{1.5} - 1.5\text{in}$$

$$L_e = 6.62\text{in}$$

$$L_e := \text{if}(h_{\text{ef}} > L_e, L_e, h_{\text{ef}})$$

$$L_e = 6.62\text{in}$$

use size 7 rebar

$$d_r := 0.875\text{in} \quad n_{\text{bars}} := 8$$

$$A_s = (0.6) \cdot \text{in}^2$$

Development Length in Tension

$$F_{y_rebar} := 60\text{ksi}$$

Location factor : $\alpha := 1.0$ (bottom reinforcement)

Coating factor : $\beta := 1.0$ (no-epoxy coating)

Normal weight concrete factor : $\lambda := 1.0$ (normal weight concrete)

$$d_b = 0.875\text{in}$$

Bar diameter:

[Ref 4.5, Section 12.2.2]

$$L_{db} := \left[\frac{3 \cdot \left(\frac{F_{y_rebar}}{\text{psi}} \cdot \alpha \cdot \beta \cdot \lambda \right)}{40 \cdot \left(\sqrt{\frac{f_c}{\text{psi}}} \cdot 2.5 \right)} \right] \cdot d_r \quad \text{if } d_r \geq 0.875\text{in}$$

$$\left[\frac{F_{y_rebar} \cdot \alpha \cdot \beta \cdot \lambda}{25 \cdot \sqrt{f_c \cdot \text{psi}}} \right] \cdot d_r \quad \text{otherwise}$$

[for # 7 and larger bars]

[for # 6 and smaller bars]


$$L_{db} = 24.9\text{in}$$

Find L_e needed to transfer uplift

Use Class B splice factor=1.3

$$L_e := \frac{1.3 \cdot L_{db} \cdot N_{ua}}{n_{\text{bars}} \cdot A_s \cdot 0.9 \cdot F_{y_rebar}}$$

$$L_e = (1.71) \cdot \text{in}$$

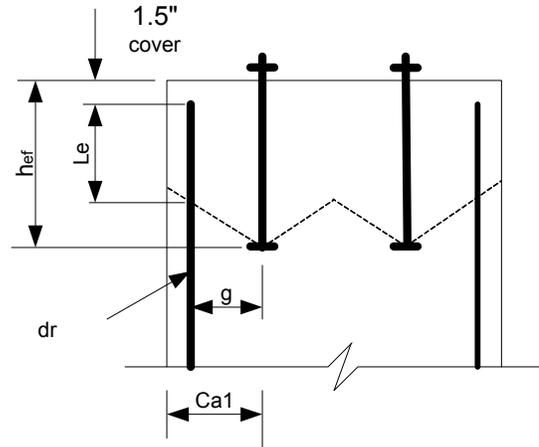

Subject: Gas Bottle & Misc Support Calculations
By: M. Bratt
Date: 10/5/09

Tensile capacity of fully developed rebars:

$$N_{h_max} := 0.9 \left[(n_{o_bars}) \cdot (A_s) \cdot F_{y_rebar} \right]$$

$$N_{h_max} = (259.2) \cdot \text{kip}$$

Tensile capacity in the potential failure plan

$$N_h := \text{if} \left[L_e > L_{bolt}, N_{h_max}, \left(\frac{L_e}{L_{db}} \right) \cdot N_{h_max} \right]$$

$$N_h = (68.96) \cdot \text{kip}$$

Shear Capacity of Concrete Pedestal

$$N_{ua} = 13.69 \cdot \text{kip}$$

Distance from tension steel to the extreme compression fiber

$$d_c := h - 2in - \frac{d_r}{2} - 0.5in$$

$$A_g := b \cdot h$$

$$\phi V_c := 0.75 \cdot 2 \cdot \left[\left(1 + \frac{N_{ua} \cdot \text{in}^2}{500 \cdot b \cdot h \cdot \text{lb}_f} \right) \cdot \sqrt{\frac{f'_c}{\text{psi}}} \cdot \text{psi} \cdot b \cdot d_c \right]$$

$$\phi V_c = 50.23 \cdot \text{kip}$$


$$\phi V_s := 0.75 \cdot \frac{2.0 \cdot 0.2 \text{in}^2 \cdot F_{y_rebar} \cdot d_c}{6.0 \text{in}}$$

$$\phi V_s = 63.19 \cdot \text{kip}$$

$$\phi V_c + \phi V_s = 113.42 \cdot \text{kip}$$

Replace V_{cbg} with $\phi V_c + \phi V_s$ in shear limit states summary.

Using #4 ties spaced at 6" on center

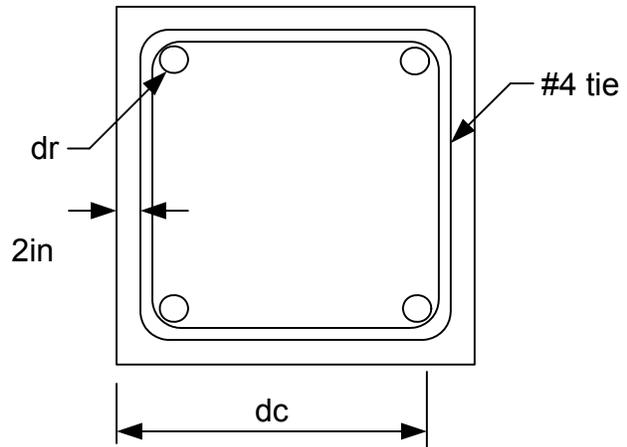



Calculation Sheet

Anchor Bolt Design

Project: BGCAPP
 Job Number: 743341
 Calc. No.: 24915-10-DBC-00-00004
 Sheet No.: G-37 of G-83
 Sheet Rev.: D

Subject: Gas Bottle & Misc Support Calculations
 By: M. Bratt
 Date: 10/5/09

Connection Ductility Summary

Anchor bolt or Shear Lug strength $\max(V_{sa}) = 64 \cdot \text{kip}$ which is less than $\min(\phi V_c + \phi V_s, V_{cpg}) = 113 \cdot \text{kip}$
 Therefore the failure will be in shear lug or bolts not concrete and there will be a ductile mode of failure.

Tensile strength of anchor bolts $N_{sa} = (107) \cdot \text{kip}$ $\min(N_h + N_{cbg}, N_{pn}) = 114 \cdot \text{kip}$

Note: N_{sbg} not included

Anchors under combined shear and tension loading

Tensile Limit States Summary

Steel Strength of Anchor Group: $N_{sa} = (107.18) \cdot \text{kip}$
 Concrete Breakout Strength of Group: (steel + concrete) $N_h + N_{cbg} = (170.64) \cdot \text{kip}$
 Concrete Side-face Blowout Strength of Group: $N_{sbg} = \text{"tension does not control"} \cdot \text{kip}$
 Pullout Strength of Anchor Group: $N_{pn} = (114.05) \cdot \text{kip}$
 Design Tensile Allowable: $N_n := \min(N_{sa}, N_h + N_{cbg}, N_{pn})$ $N_n = 107 \cdot \text{kip}$

Shear Limit States Summary

Steel Strength of Anchor Group: $V_{sa} = (64.31) \cdot \text{kip}$
 Concrete Breakout Strength of Group: $\phi V_c + \phi V_s = 113.42 \cdot \text{kip}$
 Concrete Pryout Strength of Group: $V_{cpg} = 203.37 \cdot \text{kip}$
 Design Shear Allowable: $V_n := \min(V_{sa}, \phi V_c + \phi V_s, V_{cpg})$ $V_n = 64 \cdot \text{kip}$



Calculation Sheet

Anchor Bolt Design

Project: BGCAPP
 Job Number: 743341
 Calc. No.: 24915-10-DBC-00-00004
 Sheet No.: G-39 of G-83
 Sheet Rev.: D

Subject: Gas Bottle & Misc Support Calculations
 By: M. Bratt
 Date: 10/5/09

Design Summary

Anchor Bolts

Number of anchor bolts: **no = 4**

Bolt Diameter: **$d_b = \frac{7}{8}$ in**

Bolt Embed Depth: **$L_{bolt} = 15$ in**

Spacing of anchor bolts: **$s_1 = 12$ in $s_2 = 12$ in**

Max interaction ratio

$$IR := \max \left(\frac{N_{ua}}{\phi_N \cdot \frac{N_n}{2}} + \frac{V}{\phi_V \cdot \frac{V_n}{2}} \right)$$

IR = 0.53

Baseplate Thickness: **$t_{PL} = 1$ in** $t_{min} = 0.78$ in

DCR for AB's

$$\frac{N_{ua}}{\phi_N \cdot \frac{N_n}{2}} = 0.34$$

$$\frac{V}{\phi_V \cdot \frac{V_n}{2}} = (0.05 \quad 0.05 \quad 0.05 \quad 0.05 \quad 0.12 \quad 0.03 \quad 0.05 \quad 0.12 \quad 0.03 \quad 0.19 \quad 0.1 \quad 0.19 \quad 0.1 \quad 0.05 \quad 0.05 \quad 0.18 \quad 0.11 \quad 0.03 \quad 0.03)$$



Calculation Sheet

Project: BGCAPP
 Job Number: 743341
 Calc. No.: 24915- 10-DBC-00-00004
 Sheet No.: G-40 / G-83
 Sheet Rev.: D

Subject: Gas Bottle Canopy, Supports, Equip, & Misc. Foundations
 By: R. Murphy
 Date: 2/25/2008

Baseplate and Anchor Bolt Design - W8x24 - Duct Support

This calculation contains designs for anchor bolts at the following locations:

All design will be based off of the standard base plate detail for a W8x24 column (Detail 1, 24915-000-SO-00006)

W8x24 column supports for HVAC ducts (Calculation no. 24915-10-SSC-00-00006, App C3).

Column Reactions

Following are the controlling node outputs from the duct supports and Filter structure. Units are kips, kip-ft.

Structure	Joint	Load Case	Fx	Fy	Axial	Mx	My
Duct Supports	46 (From App C3)	DL	0	0	0.542	0.369	0.054
		WLEW	0.07	0.647	0.018	6.935	0.894
		WLNS	0.751	0.042	0.036	0.646	8.508

Duct supports are checked for worst case overturning.
 Filter structure is checked for worst case bearing.

W8x24 - Check Duct Support Loads

Applicable Load Combinations:

1.4D
 1.2D + 1.6S + 0.8W
 1.2D + 1.6W + 0.5S
 0.9D + 1.6W* *Worst case loading

Loads

$$P := 0.9 \cdot 0.542 \text{ kip} - 1.6 \cdot 0.036 \text{ kip} \quad \boxed{P = 0.43 \cdot \text{kip}}$$

$$V := 0.9 \cdot 0 \text{ kip} + 1.6 \cdot 0.751 \text{ kip} \quad \boxed{V = 1.202 \cdot \text{kip}}$$

$$M := 0.9 \cdot 0.054 \text{ kip} \cdot \text{ft} + 1.6 \cdot 8.508 \text{ kip} \cdot \text{ft} \quad \boxed{M = 13.66 \cdot \text{kip} \cdot \text{ft}}$$

$$\text{Eccentricity: } e := \frac{M}{P} \quad e = 381.07 \cdot \text{in}$$

Subject: Gas Bottle Canopy, Supports, Equip, & Misc. Foundations
 By: R. Murphy
 Date: 2/25/2008

Check Duct Supports

Base Plate Properties

Plate Thickness: $t := 1.0\text{in}$

Plate Dimensions: $N_{\text{plate}} := 16\text{in}$

Dist. to plate Neutral Axis: $c_{\text{plate}} := 0.5 \cdot N_{\text{plate}} \quad c_{\text{plate}} = 8 \cdot \text{in}$

Column Depth: $d := 7.875\text{in}$


Dist. column edge to plate edge: $n := \frac{N_{\text{plate}}}{2} - \frac{0.95 \cdot d}{2} \quad n = 4.26 \cdot \text{in}$

Section Properties: $A := N_{\text{plate}}^2 \quad A = 256 \cdot \text{in}^2 \quad Z_y := \frac{t^2 \cdot 1\text{in}}{6} \quad Z_y = 0.167 \cdot \text{in}^3$


Pedestal Properties

$A_2 := 2\text{ft} \cdot 2\text{ft} \quad A_2 = 576 \cdot \text{in}^2$

$I := \frac{1}{12} \cdot (N_{\text{plate}})^4 \quad I = 5461 \cdot \text{in}^4$

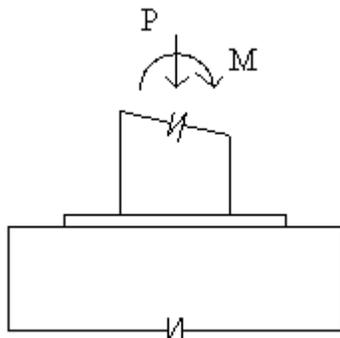


Elevation

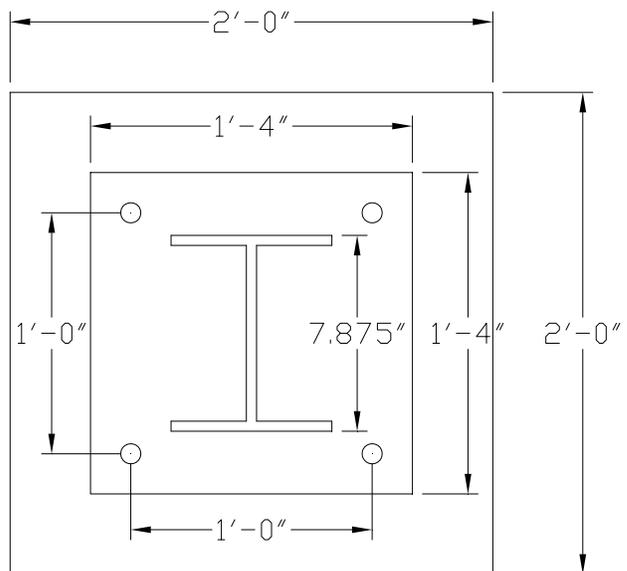

Plan

Subject: Gas Bottle Canopy, Supports, Equip, & Misc. Foundations
 By: R. Murphy
 Date: 2/25/2008

Design Forces

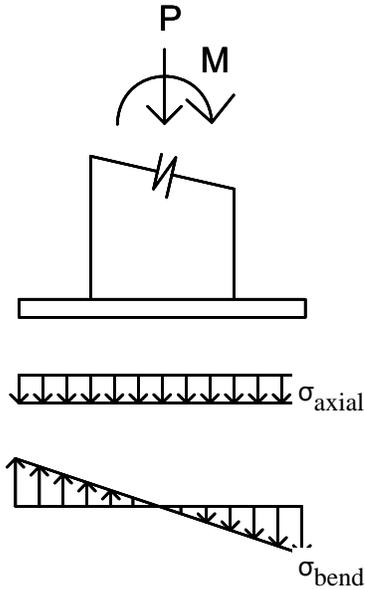


Stress Resultants

if $\sigma_{axial} = \sigma_{bending}$



if $\sigma_{axial} > \sigma_{bending}$

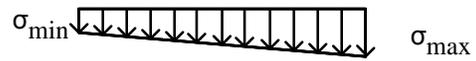

if $\sigma_{axial} < \sigma_{bending}$



Stress Calculations

$$\sigma_{axial} := \frac{P}{A} \qquad \sigma_{axial} = 1.6805 \times 10^{-3} \cdot \text{ksi}$$

$$\sigma_{bend} := |M| \cdot \frac{c_{plate}}{I} \qquad \sigma_{bend} = 0.2401 \cdot \text{ksi}$$


Total Stress

$$\sigma_{max} := \sigma_{axial} + \sigma_{bend} \qquad \sigma_{max} = 0.2418 \cdot \text{ksi}$$

$$\sigma_{min} := \sigma_{axial} - \sigma_{bend} \qquad \sigma_{min} = -0.2385 \cdot \text{ksi}$$

Subject: Gas Bottle Canopy, Supports, Equip, & Misc. Foundations
By: R. Murphy
Date: 2/25/2008

Calculating Force Resultants

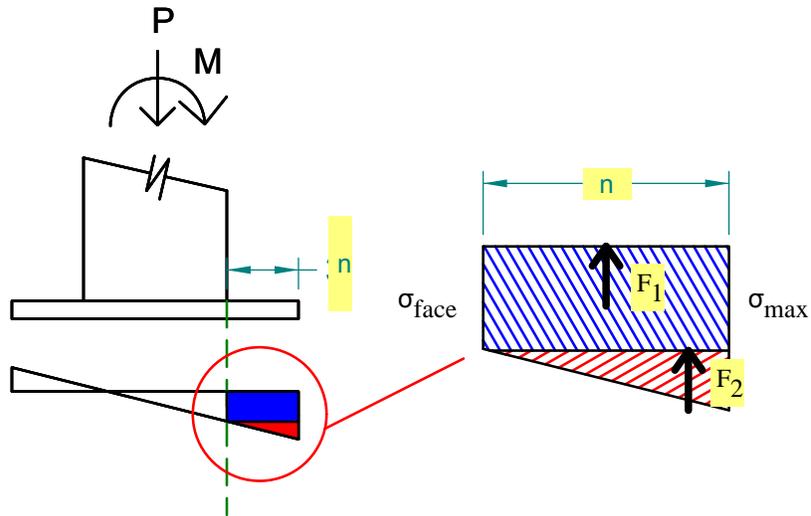

$$\text{stress_slope} := \frac{\sigma_{\max} - \sigma_{\min}}{N_{\text{plate}}}$$

$$\text{stress_slope} = 0.03 \cdot \frac{\text{kip}}{\text{in}^3}$$

$$\sigma_{\text{face}} := \sigma_{\max} - \text{stress_slope} \cdot (n)$$

$$\sigma_{\text{face}} = 0.114 \cdot \text{ksi}$$

Rectangular Stress Block Resultants

$$F_{\text{rect}} := \sigma_{\text{face}} \cdot n \cdot 1 \text{ in} \quad F_{\text{rect}} = 0.4854 \cdot \text{kip}$$

$$M_{\text{rect}} := F_{\text{rect}} \cdot \frac{n}{2} \quad M_{\text{rect}} = 1.0338 \cdot \text{kip} \cdot \text{in}$$

Triangular Stress Block Resultants

$$F_{\text{tri}} := \frac{(\sigma_{\max} - \sigma_{\text{face}}) \cdot n \cdot 1 \text{ in}}{2} \quad F_{\text{tri}} = 0.2723 \cdot \text{kip}$$

$$M_{\text{tri}} := F_{\text{tri}} \cdot 2 \cdot \frac{n}{3} \quad M_{\text{tri}} = 0.7732 \cdot \text{kip} \cdot \text{in}$$

Total Moment Per Unit Width

$$M_{\text{design}} := M_{\text{rect}} + M_{\text{tri}}$$

$$M_{\text{design}} = 1.807 \cdot \text{kip} \cdot \text{in}$$

Subject: Gas Bottle Canopy, Supports, Equip, & Misc. Foundations
By: R. Murphy
Date: 2/25/2008

Base Plate Design [AISC-LRFD 2nd ED J9]

1. Concrete Bearing Stress [AISC LRFD-2nd ED J9]

$$f_c := 4 \text{ ksi}$$

$$\Phi_c := .6$$

$$A_{\text{ratio}} := \text{if} \left[\left(\frac{A_2}{A} \right)^{\frac{1}{2}} < 2, \left(\frac{A_2}{A} \right)^{\frac{1}{2}}, 2 \right]$$

$$A_{\text{ratio}} = 1.5$$

$$F_p := \Phi_c \cdot 0.85 \cdot f_c \cdot A_{\text{ratio}} \quad [\text{AISC LRFD-2nd ED J9}]$$

$$F_p = 3.06 \cdot \text{ksi}$$

$$\text{pedestal_design} := \text{if} (\sigma_{\text{max}} < F_p, G_{\text{pedestal}}, \text{NG}_{\text{pedestal}})$$

pedestal_design = "Pedestal design is good"

2. Plate Thickness [AISC LRFD-2nd ED]

$$\Phi_{\text{flex}} := .90 \quad F_y := 36 \text{ ksi}$$

$$t_p := \sqrt[4]{\frac{M_{\text{design}} \cdot l}{\Phi_{\text{flex}} \cdot F_y \cdot 1 \text{ in}}} \quad t_p = 0.4723 \cdot \text{in} \quad [\text{AISC LRFD-2nd ED 14-6}]$$

Plate Bending Strength per unit width

$$M_{\text{strength}} := \Phi_{\text{flex}} \cdot F_y \cdot Z_y \quad M_{\text{strength}} = 5.4 \cdot \text{kip} \cdot \text{in}$$

Design Check


$$\text{base_plate_design} := \text{if} (t > t_p, G_d, \text{NG})$$

base_plate_design = "Base Plate Design is Good"

Subject: Gas Bottle Canopy, Supports, Equip, & Misc. Foundations
By: R. Murphy
Date: 2/25/2008

Anchor Bolt Design References:

- AISC LRFD 2nd ed. Steel Design Guide:Base Plate and Anchor Rod Design
- ACI 318-02

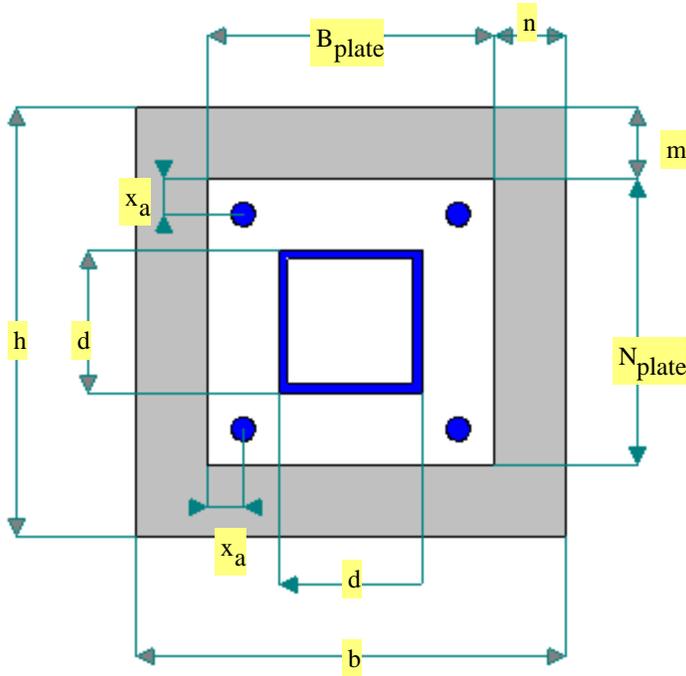

$$N_{plate} = 16 \cdot \text{in}$$

$$x_a := 2 \text{in}$$

$$N' := N_{plate} - x_a$$

$$N' = 14 \cdot \text{in}$$

$$B := N_{plate}$$

$$B = 16 \cdot \text{in}$$


$$f_p := \sigma_{max}$$

$$e = 381.071 \cdot \text{in}$$


Tension in Anchor Bolt due to Moment

[AISC Design Guide Appendix B]

if $e < e_{kern}$

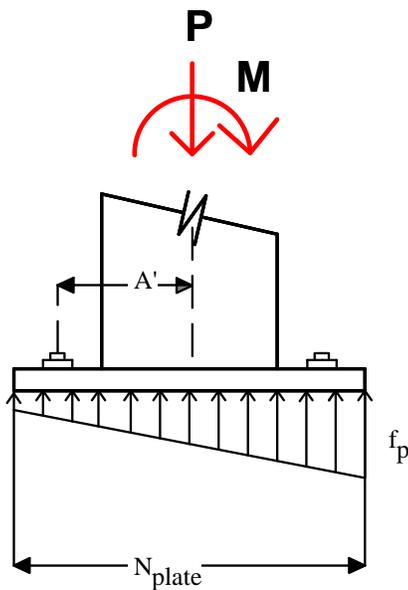

if $e > e_{kern}$

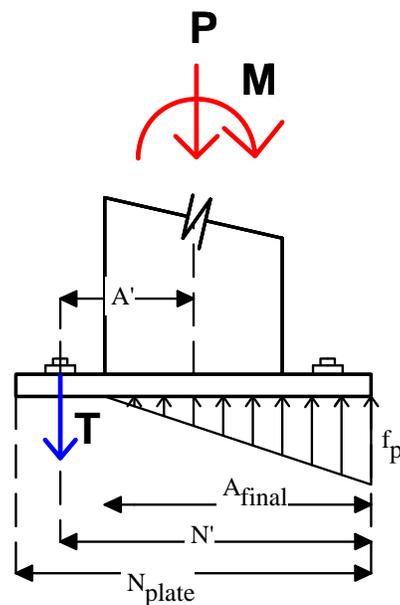

Subject: Gas Bottle Canopy, Supports, Equip, & Misc. Foundations
 By: R. Murphy
 Date: 2/25/2008

Determining effects of eccentricity [AISC LRFD B.3]

$$e_{\text{kern}} := \frac{N_{\text{plate}}}{6} \quad e_{\text{kern}} = 2.67 \cdot \text{in} \quad [\text{AISC B.3}]$$

$$\text{anchor_tension} := \text{if}(e > e_{\text{kern}}, \text{BT}, \text{NBT})$$

$$\text{anchor_tension} = \text{"Anchor bolts in tension"}$$

Determining Tension in Anchor Bolt [AISC B.4.2]

$$P = 430 \text{ lbf}$$

$$f_p = 0 \text{ ksi}$$

$$B = 1 \text{ ft}$$

Determining Length of Stress Triangle

$$f' := f_p \cdot N_{\text{plate}} \cdot \frac{N'}{2} \quad f' = 27.0841 \cdot \text{kip}$$

$$A_{\text{plus}} := \frac{f' + \sqrt{f'^2 - 4 \cdot \left(f_p \cdot \frac{B}{6}\right) \cdot (P \cdot A' + M)}}{f_p \cdot \frac{B}{3}} \quad A_{\text{plus}} = 34.556 \cdot \text{in}$$

$$A_{\text{minus}} := \frac{f' - \sqrt{f'^2 - 4 \cdot \left(f_p \cdot \frac{B}{6}\right) \cdot (P \cdot A' + M)}}{f_p \cdot \frac{B}{3}} \quad A_{\text{minus}} = 7.444 \cdot \text{in}$$

$$A_{\text{final}} := \begin{cases} \min(A_{\text{plus}}, A_{\text{minus}}) & \text{if } A_{\text{plus}} > 0 \wedge A_{\text{minus}} > 0 \\ A_{\text{plus}} & \text{if } A_{\text{plus}} > 0 \wedge A_{\text{minus}} < 0 \\ 0 & \text{if } A_{\text{plus}} < 0 \wedge A_{\text{minus}} < 0 \end{cases} \quad A_{\text{final}} = 7.444 \cdot \text{in}$$


Determining Anchor Tension from Equilibrium

$$T_{\text{anchors}} := \frac{f_p \cdot A_{\text{final}} \cdot B}{2} - P \quad T_{\text{anchors}} = 13.97 \cdot \text{kip}$$

$$T_{\text{one_anchor}} := \frac{T_{\text{anchors}}}{2} \quad T_{\text{one_anchor}} = 6.985 \cdot \text{kip}$$

Subject: Gas Bottle Canopy, Supports, Equip, & Misc. Foundations
 By: R. Murphy
 Date: 2/25/2008

Pedestal and Foundation Cross Section

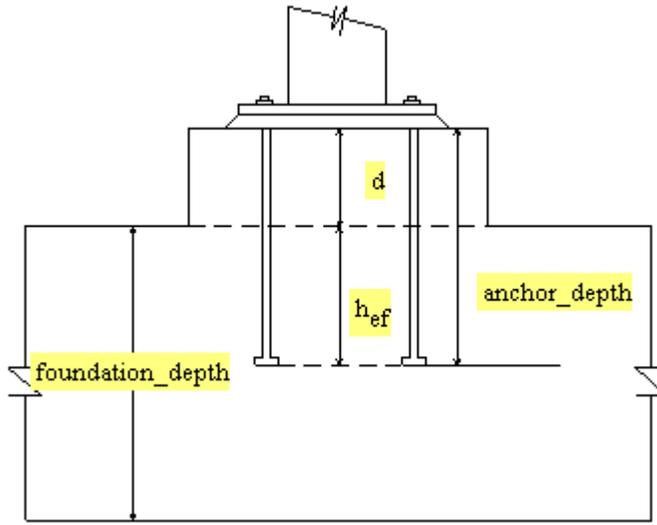

d := VARIES
 $h_{ef} := 10\text{in}$ (minimum)

To simplify the calculation, the effective embedment depth of the anchor bolt is taken as the length of the bolt that extends beneath the column pedestal. This results in a conservative estimate of the strength of concrete breakout and pryout.

Steel Strength of anchor in tension [ACI 318.05 D.5.1]

NOTE: ACI 318-05 Appendix D was adopted in lieu of ACI 318-02 in order to include the updated ductility requirements.

$$f_{ya} := 36\text{ksi} \quad n_{\text{anch}} := 4$$

$$f_{uta} := \min(1.9 \cdot f_{ya}, 125\text{ksi}, 58\text{ksi})$$

$$f_{uta} = 58000 \text{ psi}$$

Anchor Bolt Diameter: $d_o := 0.75\text{in}$

Net tensile area $A_{se} := 0.334\text{in}^2$ [Ref. 4.17]

$$N_{sa} := n_{\text{anch}} \cdot A_{se} \cdot f_{uta} \quad [\text{ACI 318.05 Eq D-3}]$$

$N_{sa} = 77.488 \cdot \text{kip}$ one anchor



Calculation Sheet

Project: BGCAPP
 Job Number: 743341
 Calc. No.: 24915- 10-DBC-00-00004
 Sheet No.: G-48 / G-83
 Sheet Rev.: D

Subject: Gas Bottle Canopy, Supports, Equip, & Misc. Foundations
 By: R. Murphy
 Date: 2/25/2008

Concrete breakout strength-Tension [ACI 318.05 D.5.2]

Concrete breakout strength based on a grouping of two anchors, since tension due to moment is the only tension present.

$$\begin{aligned} c_{a1} &:= 15\text{in} & s_1 &:= 12\text{in} \\ c_{a2} &:= 15\text{in} & s_2 &:= 12\text{in} \\ c_{a11} &:= 15\text{in} & f_c &= 4000\text{psi} \\ c_{a22} &:= 15\text{in} \end{aligned}$$

Bolts are not located near any edges of concrete.
 Use 15" because it is 1.5*hef

$$c_{amin} := \min(c_{a1}, c_{a11}, c_{a2}, c_{a22})$$

$$n_{anch_ten} := 2$$

Breakout Prism Properties

$$h'_{ef} := h_{ef}$$

$$A_{NCO} := 9 \cdot h'_{ef}{}^2$$

$$A_{NCO} = 900 \cdot \text{in}^2$$

$$A_{NC} := (1.5 \cdot h'_{ef} + s_1 + 1.5 \cdot h'_{ef}) \cdot (1.5 \cdot h'_{ef} + s_2 + 1.5 \cdot h'_{ef})$$

$$A_{NC} = 1764 \cdot \text{in}^2$$

$$A_{NC} := \min(A_{NC}, n_{anch_ten} \cdot A_{NCO})$$

$$A_{NC} = 1764 \cdot \text{in}^2$$

$$\text{anchor_status} := \text{"cast in"}$$

$$k_c := \text{if}(\text{anchor_status} = \text{"cast in"}, 24, 17)$$

$$k_c = 24$$

$$N_b := \begin{cases} 16 \cdot \text{psi}^{.5} \cdot \text{in}^{\frac{1}{3}} \cdot \sqrt{f_c} \cdot h'_{ef}{}^{\frac{5}{3}} & \text{if } 11\text{in} \leq h'_{ef} \leq 25\text{in} \\ k_c \cdot \sqrt{f_c} \cdot h'_{ef}{}^{1.5} \cdot \text{psi}^{.5} \cdot \text{in}^{.5} & \text{otherwise} \end{cases}$$

[ACI 318-05 EQ D-7]
 [ACI 318-05 EQ D-8]

$$N_b = 48000 \text{ lbf}$$

Subject: Gas Bottle Canopy, Supports, Equip, & Misc. Foundations
 By: R. Murphy
 Date: 2/25/2008

$$e'_N := 6\text{in}$$

Assumption that only one row of anchors on one side of the column center line carry tension load. Eccentricity is therefore distance from this row of anchors to the column center line

$$\Psi_{ecN} := \min\left(\frac{1}{1 + \frac{2 \cdot e'_N}{3 \cdot h'_{ef}}}, 1.0\right) \quad [\text{ACI 318-05 EQ D-9}]$$

$$\Psi_{ecN} = 1$$

$$\Psi_{edN} := \begin{cases} 1 & \text{if } c_{amin} \geq 1.5 \cdot h'_{ef} \\ 0.7 + 0.3 \cdot \frac{c_{amin}}{1.5(h'_{ef})} & \text{if } c_{amin} < 1.5 \cdot h'_{ef} \end{cases} \quad \begin{matrix} [\text{ACI 318-05 EQ D-10}] \\ [\text{ACI 318-05 EQ D-11}] \end{matrix}$$

$$\Psi_{edN} = 1$$

$$\Psi_{cN} := \begin{cases} 1.25 & \text{if anchor_status} = \text{"cast in"} \\ 1.4 & \text{otherwise} \end{cases} \quad [\text{ACI 318-05 EQ D.5.2.6}]$$

$$\Psi_{cN} = 1$$

$$\Psi_{cpN} := 1 \quad [\text{ACI 318-05 D5.2.7}]$$

$$N_{cbg} := \frac{A_{NC}}{A_{NCO}} \cdot \Psi_{ecN} \cdot \Psi_{edN} \cdot \Psi_{cN} \cdot \Psi_{cpN} \cdot N_b \quad [\text{ACI 318-05 EQ D-5}]$$

$$N_{cbg} = 84 \cdot \text{kip} \quad \text{Group of two anchors}$$

Pullout Strength of Anchor in Tension [ACI 318-05 D.5.3]

$$A_{brg} := 0.654\text{in}^2 \quad \text{crack_status} := \text{"not cracked"} \quad \text{hook_status} := \text{"not hooked"}$$

$$N_p := 8 \cdot A_{brg} \cdot f_c \quad [\text{ACI 318-02 EQ D-15}]$$

$$\Psi_{cP} := \text{if}[(\text{crack_status} = \text{"cracked"}), 1.4, 1.0] \quad [\text{ACI 318-05 D.5.3.6}]$$

$$N_{pn} := \Psi_{cP} \cdot N_p \quad [\text{ACI 318-02 EQ D-14}]$$

$$N_{pn} = 20.928 \cdot \text{kip} \quad \text{One Anchor}$$

Subject: Gas Bottle Canopy, Supports, Equip, & Misc. Foundations
 By: R. Murphy
 Date: 2/25/2008

Concrete side-face blowout strength-Tension [ACI 318.05 D.5.4]

$$c_{a1} = 15 \cdot \text{in}$$

$$N_{sb} := 160 \frac{\text{lbf}}{\text{in}} \cdot c_{a1} \cdot \sqrt{\frac{A_{brg}}{\text{in}^2}} \cdot \sqrt{\frac{f_c}{\text{psi}}} \quad [\text{ACI 318-05 EQ D-17}] \quad A_{brg} = 0.654 \cdot \text{in}^2$$

$$N_{sb} = 122.752 \cdot \text{kip} \quad \text{one anchor}$$

Tension Design Check

$$N_{sa} = 77488 \text{ lbf} \quad \text{one anchor} \quad N_{pn} = 20928 \text{ lbf} \quad \text{one anchor}$$

$$N_{cbg} = 84000 \text{ lbf} \quad \text{two anchors} \quad N_{sb} = 122752 \text{ lbf} \quad \text{one anchor}$$

$$\Phi_{\text{tension}} := 0.85 \quad \text{Anchor governed by concrete breakout, side-face blowout, pullout, or pryout strength. Condition A is met [ACI 318-05 D.4.4]}$$

$$N_{\text{design}} := \Phi_{\text{tension}} \cdot \min\left(N_{sa}, \frac{N_{cbg}}{2}, N_{pn}, N_{sb}\right) \quad [\text{ACI 318-05 D.4.1.1}]$$

$$N_{\text{design}} = 17.789 \cdot \text{kip}$$

$$T_{\text{one_anchor}} = 6.985 \cdot \text{kip}$$

$$\text{tension_design} := \text{if}(T_{\text{one_anchor}} \leq N_{\text{design}}, \text{"Good"}, \text{"Not Good"}) \quad [\text{ACI 318-05 EQ D-1}]$$

$$\text{tension_design} = \text{"Good"}$$



Calculation Sheet

Project: BGCAPP
 Job Number: 743341
 Calc. No.: 24915- 10-DBC-00-00004
 Sheet No.: G-51 / G-83
 Sheet Rev.: D

Subject: Gas Bottle Canopy, Supports, Equip, & Misc. Foundations
 By: R. Murphy
 Date: 2/25/2008

Steel Strength of Anchor in Shear [ACI 318-05 D.6.1]

Anchor Types:

AT1 [ACI 318-05 D.6.1.a]

AT2 [ACI 318-05 D.6.1.b]

AT3 [ACI 318-05 D.6.1.c]

Anchor Type Used:

AT := "AT1"

Grout Pad Factor [ACI 318-05 D.6.1.3]:

grout_pad_used := "yes"

$$c_{\text{pad}} := \begin{cases} 0.8 & \text{if grout_pad_used} = \text{"yes"} \\ 1.0 & \text{otherwise} \end{cases}$$

$c_{\text{pad}} = 1$

Shear Strength:

$$V_{\text{sa}} := \begin{cases} c_{\text{pad}} \cdot n_{\text{anch}} \cdot A_{\text{se}} \cdot f_{\text{uta}} & \text{if AT} = \text{"AT1"} & \text{[ACI 318-05 EQ D-19]} \\ c_{\text{pad}} \cdot n_{\text{anch}} \cdot 0.6 \cdot A_{\text{se}} \cdot f_{\text{uta}} & \text{if AT} = \text{"AT2"} & \text{[ACI 318-05 EQ D-20]} \\ c_{\text{pad}} \cdot n_{\text{anch}} \cdot 0.6 \cdot A_{\text{se}} \cdot f_{\text{uta}} & \text{if AT} = \text{"AT3"} & \text{[ACI 318-05 EQ D-20]} \end{cases}$$

$V_{\text{sa}} = 61.99 \cdot \text{kip}$ one anchor

Subject: Gas Bottle Canopy, Supports, Equip, & Misc. Foundations
 By: R. Murphy
 Date: 2/25/2008

Concrete Breakout Strength-Shear [ACI 318-05 D.6.2]

group_status := "group"

Projected Concrete Failure Area [ACI 318-05 D.6.2.1, RD.6.2.1]

$c_{a1} = 1 \text{ ft}$ Assuming that total shear is critical on one anchor row

$h_a = 6. \text{in}$ Thickness of pedestal

$s_1 = 1 \text{ ft}$ Anchor Bolt Spacing

$$c := \begin{cases} 1.5 \cdot c_{a1} & \text{if } 1.5 \cdot c_{a1} < c_{a2} \\ c_{a2} & \text{otherwise} \end{cases} \quad c = 1 \text{ ft}$$

$$A_{vc} := \begin{cases} [2 \cdot (c) + s_1] \cdot h_a & \text{if } 1.5c_{a1} > h_a \\ 2 \cdot [(c) + s_1] \cdot 1.5 \cdot c_{a1} & \text{otherwise} \end{cases} \quad \begin{array}{l} \text{[ACI 318-05 Fig RD.6.2.1(b)]} \\ \text{Failure area for group of anchors} \end{array}$$

$$A_{vc} = 2 \text{ ft}^2$$

$$A_{vco} := 4.5 \cdot c_{a1}^2$$

$$A_{vco} = 7 \text{ ft}^2 \quad \text{[ACI 318-05 EQ D-23]}$$

$$A_{vc} := \min(A_{vc}, n_{\text{anch}} \cdot A_{vco})$$

$$A_{vc} = 2 \text{ ft}^2$$

Basic Concrete Breakout Strength [ACI 318-05 D.6.2.2]

$l_e := h_{ef}$ anchor load bearing length

$$V_b := 7 \cdot \left(\frac{l_e}{d_o} \right)^{0.2} \cdot \sqrt{d_o} \cdot \sqrt{f_c} \cdot c_{a1}^{1.5} \cdot \text{psi}^{.5} \quad \text{[ACI 318-05 EQ D.24]}$$

$$V_b = 37392 \text{ lbf}$$



Calculation Sheet

Project: BGCAPP
 Job Number: 743341
 Calc. No.: 24915- 10-DBC-00-00004
 Sheet No.: G-53 / G-83
 Sheet Rev.: D

Subject: Gas Bottle Canopy, Supports, Equip, & Misc. Foundations
 By: R. Murphy
 Date: 2/25/2008

$e'_v := 0 \text{ in}$ Assumption that shear is distributed equal to all anchors and no shear eccentricity results

$$\Psi_{ecV} := \min\left(1, \frac{1}{1 + 2 \cdot \frac{e'_v}{3 \cdot c_{a1}}}\right)$$

$$\Psi_{ecV} = 1$$

$$c_{a2} = 1 \text{ ft}$$

$$\Psi_{edV} := \begin{cases} 1.0 & \text{if } c_{a2} \geq 1.5 \cdot c_{a1} & \text{[ACI 318-05 EQ D-27]} \\ 0.7 + 0.3 \cdot \frac{c_{a2}}{1.5 \cdot c_{a1}} & \text{if } c_{a2} < 1.5 \cdot c_{a1} & \text{[ACI 318-05 EQ D-28]} \end{cases}$$

$$\Psi_{edV} = 1$$

crack_status = "not cracked"

$$\Psi_{cV} := \begin{cases} 1.4 & \text{if crack_status = "not cracked"} \\ 1.0 & \text{if crack_status = "cracked no reinforce"} \\ 1.2 & \text{if crack_status = "cracked with reinforce"} \\ 1.4 & \text{if crack_status = "cracked with reinforce and stirrups"} \end{cases}$$

$$\Psi_{cV} = 1$$

$$V_{cb} := \begin{cases} \frac{A_{vc}}{A_{vco}} \cdot \Psi_{edV} \cdot \Psi_{cV} \cdot V_b & \text{if group_status = "single anchor"} & \text{[ACI 318-05 EQ D-21]} \\ 0 & \text{otherwise} \end{cases}$$

$$V_{cbg} := \begin{cases} \frac{A_{vc}}{A_{vco}} \cdot \Psi_{ecV} \cdot \Psi_{edV} \cdot \Psi_{cV} \cdot V_b & \text{if group_status = "group"} & \text{[ACI 318-05 EQ D-22]} \\ 0 & \text{otherwise} \end{cases}$$

$$V_{cb} = 0 \text{ lbf}$$

$$V_{cbg} = 12 \cdot \text{kip} \quad \text{group of 2 anchors}$$

Subject: Gas Bottle Canopy, Supports, Equip, & Misc. Foundations
 By: R. Murphy
 Date: 2/25/2008

Concrete pryout strength of anchor in shear [ACI 318-05 D.6.3]

$$h_{ef} = 1 \text{ ft}$$

$$k_{cp} := \begin{cases} 1.0 & \text{if } h_{ef} < 2.5\text{in} \\ 2.0 & \text{if } h_{ef} \geq 2.5\text{in} \end{cases}$$

$$V_{cp} := \begin{cases} k_{cp} \cdot N_{cb} & \text{if group_status} = \text{"single anchor"} \\ 0 & \text{otherwise} \end{cases} \quad [\text{ACI 318-05 EQ D-29}]$$

$$V_{cpg} := \begin{cases} k_{cp} \cdot N_{cbg} & \text{if group_status} = \text{"group"} \\ 0 & \text{otherwise} \end{cases} \quad [\text{ACI 318-05 EQ D-30}]$$

$$V_{cpg} = 168 \cdot \text{kip} \quad \text{group of 2 anchors}$$

Shear Design Check

$$V_{sa} = 61990 \text{ lbf} \quad \text{one anchor}$$

$$V_{cbg} = 11726 \text{ lbf} \quad \text{group of 2 anchors}$$

$$V_{cpg} = 168000 \text{ lbf} \quad \text{group of 2 anchors}$$

$$\Phi_{\text{shear}} := 0.85 \quad \text{Anchor governed by concrete breakout, side-face blowout, pullout, or pryout strength [ACI 318-05 D.4.4]}$$

$$V_{\text{design}} := \Phi_{\text{shear}} \cdot \min(V_{sa} \cdot 4, V_{cbg}, V_{cpg}) \quad [\text{ACI 318-05 D.4.1.1}]$$

$$V_{\text{design}} = 9.967 \cdot \text{kip}$$

$$\text{design_shear} := \text{if}(V \leq V_{\text{design}}, \text{"Design is OK"}, \text{"Design is insufficient"})$$

$$\text{design_shear} = \text{"Design is OK"} \quad [\text{ACI 318-05 EQ D-2}]$$



Calculation Sheet

Project: BGCAPP
Job Number: 743341
Calc. No.: 24915- 10-DBC-00-00004
Sheet No.: G-55 / G-83
Sheet Rev.: D

Subject: Gas Bottle Canopy, Supports, Equip, & Misc. Foundations
By: R. Murphy
Date: 2/25/2008

Interaction of tensile and shear forces [ACI 318-05 D.7]

$$\frac{V}{V_{\text{design}}} + \frac{T_{\text{one_anchor}}}{N_{\text{design}}} = 0.513$$

$$ST_{\text{check}} := \text{if} \left(\frac{V}{V_{\text{design}}} + \frac{T_{\text{one_anchor}}}{N_{\text{design}}} \leq 1.2, \text{"Interaction OK"} , \text{"Interaction Failure"} \right)$$

$$\text{interaction_check_V} := \text{if} \left[\left(V > 0.2 \cdot V_{\text{design}} \wedge T_{\text{one_anchor}} > N_{\text{design}} \right), ST_{\text{check}}, \text{"No check needed"} \right]$$

$$\text{interaction_check_V} = \text{"No check needed"}$$



Calculation Sheet

Project: BGCAPP
 Job Number: 743341
 Calc. No.: 24915-10-DBC-00-00004
 Sheet No.: G-56 / G-83
 Sheet Rev.: D

Subject: Gas Bottle Canopy, Supports, Equip, & Misc. Foundations
 By: M. Bratt
 Date: 10/5/2009

Baseplate and Anchor Bolt Design - W14x43

This calculation contains designs for anchor bolts at the following locations:

All design will be based off of the standard base plate detail for a W14x43 column (Detail 1, 24915-000-SO-00006)
 W14x43 column support for HVAC ducts (Calculation no. 24915-10-SSC-00-00006, App C4).

Column Reactions

Following is the controlling node output from the duct support in App. C4.
 Units are kips, kip-ft.

Structure	Joint	Load Case	Fx	Fy	Axial	Mx	My
Duct Support	15 (From App C4)	DL	0.038	0.001	2.314	0.024	0.207
		SNOW	0.033	0.001	1.153	0.02	0.177
		WLEW	0.104	2.692	0.007	53.474	2.19
		WLNS	1.018	0.015	0.033	0.326	7.113

By inspection, the worst case loading is wind overturning.

Applicable Load Combinations:

- 1.4D
- 1.2D + 1.6S + 0.8W
- 1.2D + 1.6W + 0.5S
- 0.9D + 1.6W* *Worst case loading

Loads

$$P := 0.9 \cdot 2.314 \text{kip} - 1.6 \cdot 0.007 \text{kip} \quad \boxed{P = 2.071 \cdot \text{kip}}$$

$$V := 0.9 \cdot 0.038 \text{kip} + 1.6 \cdot 2.692 \text{kip} \quad \boxed{V = 4.341 \cdot \text{kip}}$$

$$M := 0.9 \cdot 0.024 \text{kip} \cdot \text{ft} + 1.6 \cdot 53.474 \text{kip} \cdot \text{ft} \quad \boxed{M = 85.58 \cdot \text{kip} \cdot \text{ft}}$$

$$\text{Eccentricity: } e := \frac{M}{P} \quad e = 495.78 \cdot \text{in}$$

Subject: Gas Bottle Canopy, Supports, Equip, & Misc. Foundations
 By: M. Bratt
 Date: 10/5/2009

Base Plate Properties

Plate Thickness: $t := 1.5\text{in}$

Plate Dimensions: $N_{\text{plate}} := 26\text{in}$

Dist. to plate Neutral Axis: $c_{\text{plate}} := 0.5 \cdot N_{\text{plate}} \quad c_{\text{plate}} = 13\text{in}$


Column Depth: $d := 13.625\text{in}$

Dist. column edge to plate edge: $n := \frac{N_{\text{plate}}}{2} - \frac{0.95 \cdot d}{2} \quad n = 6.53\text{in}$


Section Properties: $A := N_{\text{plate}}^2 \quad A = 676\text{in}^2 \quad Z_y := \frac{t^2 \cdot 1\text{in}}{6} \quad Z_y = 0.375\text{in}^3$
 $I := \frac{1}{12} \cdot (N_{\text{plate}})^4 \quad I = 38081\text{in}^4$

Pedestal Properties

$A_2 := 2.5\text{ft} \cdot 2.5\text{ft} \quad A_2 = 900\text{in}^2$

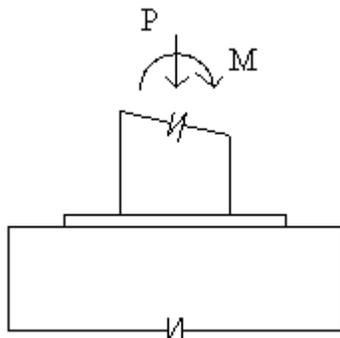


Elevation

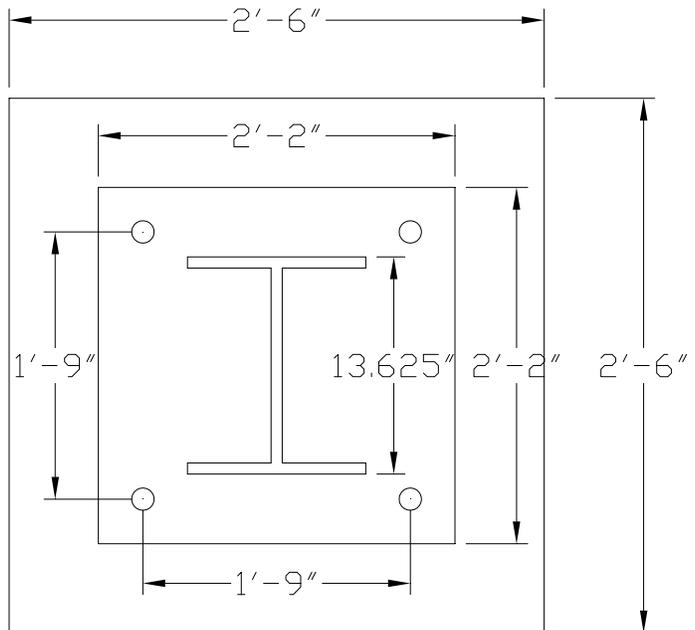

Plan

Subject: Gas Bottle Canopy, Supports, Equip, & Misc. Foundations
 By: M. Bratt
 Date: 10/5/2009

Design Forces

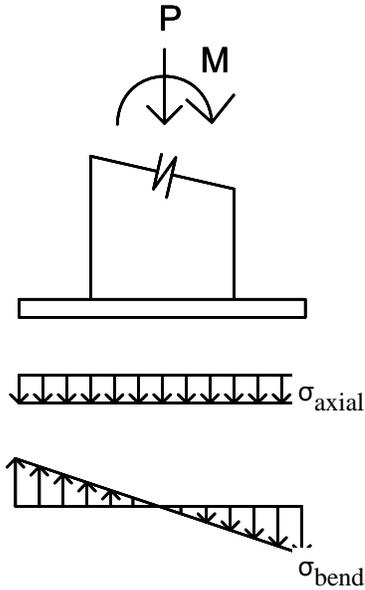


Stress Resultants

if $\sigma_{axial} = \sigma_{bending}$



if $\sigma_{axial} > \sigma_{bending}$

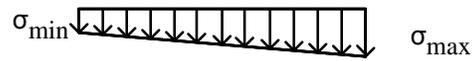

if $\sigma_{axial} < \sigma_{bending}$



Stress Calculations

$$\sigma_{axial} := \frac{P}{A} \qquad \sigma_{axial} = 3.0642 \times 10^{-3} \cdot \text{ksi}$$

$$\sigma_{bend} := |M| \cdot \frac{c_{plate}}{I} \qquad \sigma_{bend} = 0.3506 \cdot \text{ksi}$$


Total Stress

$$\sigma_{max} := \sigma_{axial} + \sigma_{bend} \qquad \sigma_{max} = 0.3536 \cdot \text{ksi}$$

$$\sigma_{min} := \sigma_{axial} - \sigma_{bend} \qquad \sigma_{min} = -0.3475 \cdot \text{ksi}$$

Subject: Gas Bottle Canopy, Supports, Equip, & Misc. Foundations
 By: M. Bratt
 Date: 10/5/2009

Calculating Force Resultants

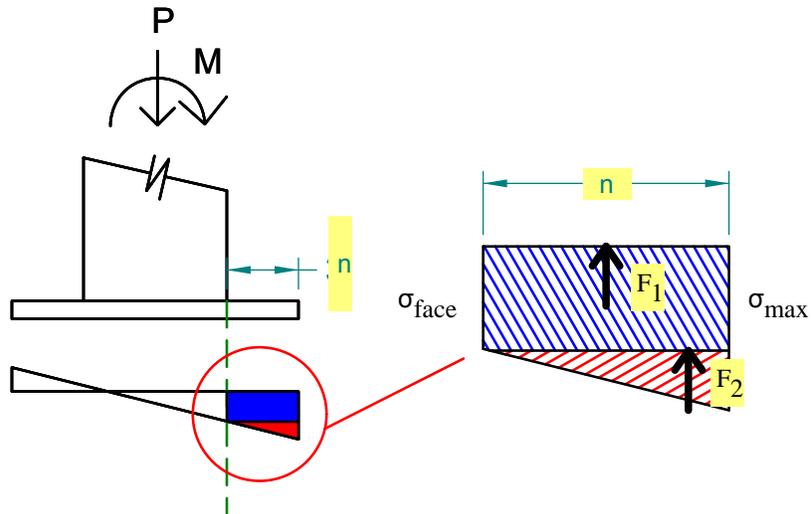

$$\text{stress_slope} := \frac{\sigma_{max} - \sigma_{min}}{N_{plate}}$$

$$\text{stress_slope} = 0.027 \cdot \frac{\text{kip}}{\text{in}^3}$$

$$\sigma_{face} := \sigma_{max} - \text{stress_slope} \cdot (n)$$

$$\sigma_{face} = 0.1776 \cdot \text{ksi}$$

Rectangular Stress Block Resultants

$$F_{rect} := \sigma_{face} \cdot n \cdot 1 \text{ in} \quad F_{rect} = 1.1594 \cdot \text{kip}$$

$$M_{rect} := F_{rect} \cdot \frac{n}{2} \quad M_{rect} = 3.7842 \cdot \text{kip} \cdot \text{in}$$

Triangular Stress Block Resultants

$$F_{tri} := \frac{(\sigma_{max} - \sigma_{face}) \cdot n \cdot 1 \text{ in}}{2} \quad F_{tri} = 0.5746 \cdot \text{kip}$$

$$M_{tri} := F_{tri} \cdot 2 \cdot \frac{n}{3} \quad M_{tri} = 2.5008 \cdot \text{kip} \cdot \text{in}$$

Total Moment Per Unit Width

$$M_{design} := M_{rect} + M_{tri}$$

$$M_{design} = 6.2851 \cdot \text{kip} \cdot \text{in}$$

Subject: Gas Bottle Canopy, Supports, Equip, & Misc. Foundations
 By: M. Bratt
 Date: 10/5/2009

Base Plate Design [AISC-LRFD 2nd ED J9]

1. Concrete Bearing Stress [AISC LRFD-2nd ED J9]

$$f_c := 4 \text{ ksi}$$

$$\Phi_c := .6$$

$$A_{\text{ratio}} := \text{if} \left[\left(\frac{A_2}{A} \right)^{\frac{1}{2}} < 2, \left(\frac{A_2}{A} \right)^{\frac{1}{2}}, 2 \right]$$

$$A_{\text{ratio}} = 1.2$$

$$F_p := \Phi_c \cdot 0.85 \cdot f_c \cdot A_{\text{ratio}} \quad [\text{AISC LRFD-2nd ED J9}]$$

$$F_p = 2.35 \cdot \text{ksi}$$

$$\text{pedestal_design} := \text{if} (\sigma_{\text{max}} < F_p, G_{\text{pedestal}}, \text{NG}_{\text{pedestal}})$$

pedestal_design = "Pedestal design is good"

2. Plate Thickness [AISC LRFD-2nd ED]

$$\Phi_{\text{flex}} := .90 \quad F_y := 36 \text{ ksi}$$

$$t_p := \sqrt[4]{4 \cdot \frac{M_{\text{design}} \cdot l}{\Phi_{\text{flex}} \cdot F_y \cdot 1 \text{ in}}} \quad t_p = 0.8809 \cdot \text{in} \quad [\text{AISC LRFD-2nd ED 14-6}]$$

Plate Bending Strength per unit width

$$M_{\text{strength}} := \Phi_{\text{flex}} \cdot F_y \cdot Z_y \quad M_{\text{strength}} = 12.15 \cdot \text{kip} \cdot \text{in}$$

Design Check


$$\text{base_plate_design} := \text{if} (t > t_p, G_d, \text{NG})$$

base_plate_design = "Base Plate Design is Good"

Subject: Gas Bottle Canopy, Supports, Equip, & Misc. Foundations
By: M. Bratt
Date: 10/5/2009

Anchor Bolt Design References:

- AISC LRFD 2nd ed. Steel Design Guide:Base Plate and Anchor Rod Design
- ACI 318-02

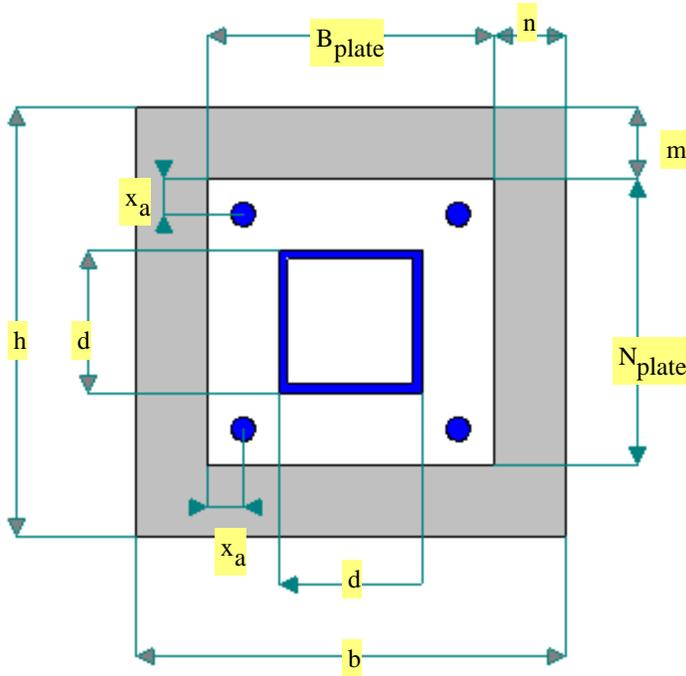

$$N_{plate} = 26 \cdot \text{in}$$

$$x_a := 2 \text{ in}$$

$$N' := N_{plate} - x_a$$

$$N' = 24 \cdot \text{in}$$

$$B := N_{plate}$$

$$B = 26 \cdot \text{in}$$


$$f_p := \sigma_{max}$$

$$e = 495.781 \cdot \text{in}$$


Tension in Anchor Bolt due to Moment

[AISC Design Guide Appendix B]

if $e < e_{kern}$

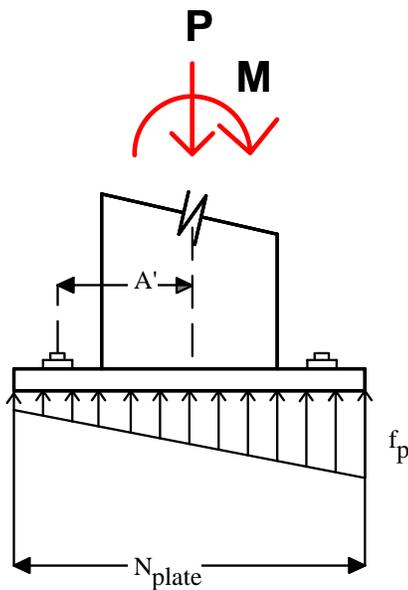

if $e > e_{kern}$

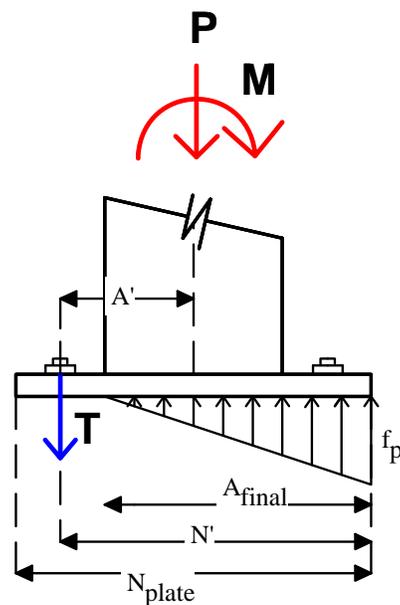

Subject: Gas Bottle Canopy, Supports, Equip, & Misc. Foundations
 By: M. Bratt
 Date: 10/5/2009

Determining effects of eccentricity [AISC LRFD B.3]

$$e_{\text{kern}} := \frac{N_{\text{plate}}}{6} \quad e_{\text{kern}} = 4.33 \cdot \text{in} \quad [\text{AISC B.3}]$$

$$\text{anchor_tension} := \text{if}(e > e_{\text{kern}}, \text{BT}, \text{NBT})$$

$$\text{anchor_tension} = \text{"Anchor bolts in tension"}$$

Determining Tension in Anchor Bolt [AISC B.4.2]

$$P = 2071 \text{ lbf}$$

$$f_p = 0 \text{ ksi}$$

$$B = 2 \text{ ft}$$

Determining Length of Stress Triangle

$$f' := f_p \cdot N_{\text{plate}} \cdot \frac{N'}{2} \quad f' = 110.3364 \cdot \text{kip}$$

$$A_{\text{plus}} := \frac{f' + \sqrt{f'^2 - 4 \cdot \left(f_p \cdot \frac{B}{6}\right) \cdot (P \cdot A' + M)}}{f_p \cdot \frac{B}{3}} \quad A_{\text{plus}} = 60.895 \cdot \text{in}$$

$$A_{\text{minus}} := \frac{f' - \sqrt{f'^2 - 4 \cdot \left(f_p \cdot \frac{B}{6}\right) \cdot (P \cdot A' + M)}}{f_p \cdot \frac{B}{3}} \quad A_{\text{minus}} = 11.105 \cdot \text{in}$$

$$A_{\text{final}} := \begin{cases} \min(A_{\text{plus}}, A_{\text{minus}}) & \text{if } A_{\text{plus}} > 0 \wedge A_{\text{minus}} > 0 \\ A_{\text{plus}} & \text{if } A_{\text{plus}} > 0 \wedge A_{\text{minus}} < 0 \\ 0 & \text{if } A_{\text{plus}} < 0 \wedge A_{\text{minus}} < 0 \end{cases} \quad A_{\text{final}} = 11.105 \cdot \text{in}$$


Determining Anchor Tension from Equilibrium

$$T_{\text{anchors}} := \frac{f_p \cdot A_{\text{final}} \cdot B}{2} - P \quad T_{\text{anchors}} = 48.9809 \cdot \text{kip}$$

$$T_{\text{one_anchor}} := \frac{T_{\text{anchors}}}{2} \quad T_{\text{one_anchor}} = 24.4905 \cdot \text{kip}$$

Subject: Gas Bottle Canopy, Supports, Equip, & Misc. Foundations
 By: M. Bratt
 Date: 10/5/2009

Pedestal and Foundation Cross Section

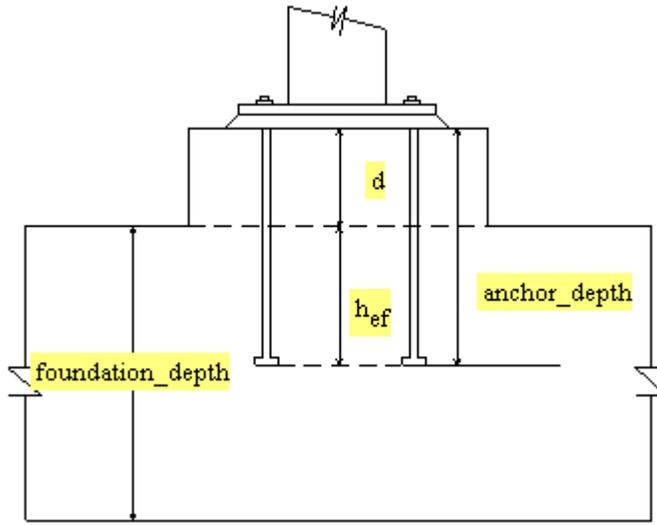

d := VARIES
 $h_{ef} := 10\text{in}$ (minimum)

To simplify the calculation, the effective embedment depth of the anchor bolt is taken as the length of the bolt that extends beneath the column pedestal. This results in a conservative estimate of the strength of concrete breakout and pryout.

Steel Strength of anchor in tension [ACI 318.05 D.5.1]

NOTE: ACI 318-05 Appendix D was adopted in lieu of ACI 318-02 in order to include the updated ductility requirements.

$$f_{ya} := 36\text{ksi} \quad n_{\text{anch}} := 6$$

$$f_{uta} := \min(1.9 \cdot f_{ya}, 125\text{ksi}, 58\text{ksi})$$

$$f_{uta} = 58000 \text{ psi}$$

Anchor Bolt Diameter: $d_o := 1.375\text{in}$

Net tensile area $A_{se} := 1.160\text{in}^2$ [Ref. 4.17]

$$N_{sa} := n_{\text{anch}} \cdot A_{se} \cdot f_{uta} \quad [\text{ACI 318.05 Eq D-3}]$$

$N_{sa} = 403.68 \cdot \text{kip}$ one anchor



Calculation Sheet

Project: BGCAPP
 Job Number: 743341
 Calc. No.: 24915-10-DBC-00-00004
 Sheet No.: G-64 / G-83
 Sheet Rev.: D

Subject: Gas Bottle Canopy, Supports, Equip, & Misc. Foundations
 By: M. Bratt
 Date: 10/5/2009

Concrete breakout strength-Tension [ACI 318.05 D.5.2]

Concrete breakout strength based on a grouping of two anchors, since tension due to moment is the only tension present.

$$\begin{aligned} c_{a1} &:= 15\text{in} & s_1 &:= 21\text{in} \\ c_{a2} &:= 15\text{in} & s_2 &:= 21\text{in} \\ c_{a11} &:= 15\text{in} & f_c &= 4000\text{psi} \\ c_{a22} &:= 15\text{in} \end{aligned}$$

$$c_{amin} := \min(c_{a1}, c_{a11}, c_{a2}, c_{a22})$$

$$n_{anch_ten} := 2$$

Breakout Prism Properties

$$h'_{ef} := h_{ef}$$

$$A_{NCO} := 9 \cdot h'_{ef}{}^2$$

$$A_{NCO} = 1 \cdot \text{in}^2$$

$$A_{NC} := (1.5 \cdot h'_{ef} + s_1 + 1.5 \cdot h'_{ef}) \cdot (1.5 \cdot h'_{ef} + s_2 + 1.5 \cdot h'_{ef})$$

$$A_{NC} = 2601 \cdot \text{in}^2$$

$$A_{NC} := \min(A_{NC}, n_{anch_ten} \cdot A_{NCO})$$

$$A_{NC} = 1800 \cdot \text{in}^2$$

$$\text{anchor_status} := \text{"cast in"}$$

$$k_c := \text{if}(\text{anchor_status} = \text{"cast in"}, 24, 17)$$

$$k_c = 24$$

$$N_b := \begin{cases} 16 \cdot \text{psi} \cdot \text{in}^{\frac{1}{3}} \cdot \sqrt{f_c} \cdot h'_{ef}{}^{\frac{5}{3}} & \text{if } 11\text{in} \leq h'_{ef} \leq 25\text{in} & \text{[ACI 318-05 EQ D-7]} \\ k_c \cdot \sqrt{f_c} \cdot h'_{ef}{}^{1.5} \cdot \text{psi} \cdot \text{in}^{\frac{5}{3}} & \text{otherwise} & \text{[ACI 318-05 EQ D-8]} \end{cases}$$

$$N_b = 48000 \text{ lbf}$$

Subject: Gas Bottle Canopy, Supports, Equip, & Misc. Foundations
 By: M. Bratt
 Date: 10/5/2009

$e'_N := 10.5\text{in}$ Assumption that only one row of anchors on one side of the column center line carry tension load. Eccentricity is therefore distance from this row of anchors to the column center line

$$\Psi_{ecN} := \min\left(\frac{1}{1 + \frac{2 \cdot e'_N}{3 \cdot h'_{ef}}}, 1.0\right) \quad [\text{ACI 318-05 EQ D-9}]$$

$$\Psi_{ecN} = 1$$

$$\Psi_{edN} := \begin{cases} 1 & \text{if } c_{amin} \geq 1.5 \cdot h'_{ef} & [\text{ACI 318-05 EQ D-10}] \\ 0.7 + 0.3 \cdot \frac{c_{amin}}{1.5(h'_{ef})} & \text{if } c_{amin} < 1.5 \cdot h'_{ef} & [\text{ACI 318-05 EQ D-11}] \end{cases}$$

$$\Psi_{edN} = 1$$

$$\Psi_{cN} := \begin{cases} 1.25 & \text{if anchor_status} = \text{"cast in"} & [\text{ACI 318-05 EQ D.5.2.6}] \\ 1.4 & \text{otherwise} \end{cases}$$

$$\Psi_{cN} = 1$$

$$\Psi_{cpN} := 1 \quad [\text{ACI 318-05 D5.2.7}]$$

$$N_{cbg} := \frac{A_{NC}}{A_{NCO}} \cdot \Psi_{ecN} \cdot \Psi_{edN} \cdot \Psi_{cN} \cdot \Psi_{cpN} \cdot N_b \quad [\text{ACI 318-05 EQ D-5}]$$

$$N_{cbg} = 70.588 \cdot \text{kip} \quad \text{Group of two anchors}$$

Pullout Strength of Anchor in Tension [ACI 318-05 D.5.3]

$$A_{brg} := 2.199\text{in}^2 \quad \text{crack_status} := \text{"not cracked"} \quad \text{hook_status} := \text{"not hooked"}$$

$$N_p := 8 \cdot A_{brg} \cdot f_c \quad [\text{ACI 318-02 EQ D-15}]$$

$$\Psi_{cP} := \text{if}[(\text{crack_status} = \text{"cracked"}), 1.4, 1.0] \quad [\text{ACI 318-05 D.5.3.6}]$$

$$N_{pn} := \Psi_{cP} \cdot N_p \quad [\text{ACI 318-02 EQ D-14}]$$

$$N_{pn} = 70.368 \cdot \text{kip} \quad \text{One Anchor}$$

Subject: Gas Bottle Canopy, Supports, Equip, & Misc. Foundations
 By: M. Bratt
 Date: 10/5/2009

Concrete side-face blowout strength-Tension [ACI 318.05 D.5.4]

$$c_{a1} = 15 \cdot \text{in}$$

$$N_{sb} := 160 \frac{\text{lbf}}{\text{in}} \cdot c_{a1} \cdot \sqrt{\frac{A_{brg}}{\text{in}^2}} \cdot \sqrt{\frac{f_c}{\text{psi}}} \quad [\text{ACI 318-05 EQ D-17}] \quad A_{brg} = 2.199 \cdot \text{in}^2$$

$$N_{sb} = 225.089 \cdot \text{kip} \quad \text{one anchor}$$

Tension Design Check

$$N_{sa} = 403680 \text{ lbf} \quad \text{one anchor}$$

$$N_{pn} = 70368 \text{ lbf} \quad \text{one anchor}$$

$$N_{cbg} = 70588 \text{ lbf} \quad \text{two anchors}$$

$$N_{sb} = 225089 \text{ lbf} \quad \text{one anchor}$$

$$\Phi_{\text{tension}} := 0.85$$

Anchor governed by concrete breakout, side-face blowout, pullout, or pryout strength. Condition A is met [ACI 318-05 D.4.4]

$$N_{\text{design}} := \Phi_{\text{tension}} \cdot \min\left(N_{sa}, \frac{N_{cbg}}{2}, N_{pn}, N_{sb}\right) \quad [\text{ACI 318-05 D.4.1.1}]$$

$$N_{\text{design}} = 30 \cdot \text{kip}$$

$$T_{\text{one_anchor}} = 24490 \text{ lbf}$$

$$\text{tension_design} := \text{if}(T_{\text{one_anchor}} \leq N_{\text{design}}, \text{"Good"}, \text{"Not Good"}) \quad [\text{ACI 318-05 EQ D-1}]$$

$$\text{tension_design} = \text{"Good"}$$



Calculation Sheet

Project: BGCAPP
 Job Number: 743341
 Calc. No.: 24915-10-DBC-00-00004
 Sheet No.: G-67 / G-83
 Sheet Rev.: D

Subject: Gas Bottle Canopy, Supports, Equip, & Misc. Foundations
 By: M. Bratt
 Date: 10/5/2009

Steel Strength of Anchor in Shear [ACI 318-05 D.6.1]

Anchor Types:

AT1 [ACI 318-05 D.6.1.a]

AT2 [ACI 318-05 D.6.1.b]

AT3 [ACI 318-05 D.6.1.c]

Anchor Type Used:

AT := "AT1"

Grout Pad Factor [ACI 318-05 D.6.1.3]:

grout_pad_used := "yes"

$$c_{\text{pad}} := \begin{cases} 0.8 & \text{if grout_pad_used} = \text{"yes"} \\ 1.0 & \text{otherwise} \end{cases}$$

$c_{\text{pad}} = 1$

Shear Strength:

$$V_{\text{sa}} := \begin{cases} c_{\text{pad}} \cdot n_{\text{anch}} \cdot A_{\text{se}} \cdot f_{\text{uta}} & \text{if AT} = \text{"AT1"} \\ c_{\text{pad}} \cdot n_{\text{anch}} \cdot 0.6 \cdot A_{\text{se}} \cdot f_{\text{uta}} & \text{if AT} = \text{"AT2"} \\ c_{\text{pad}} \cdot n_{\text{anch}} \cdot 0.6 \cdot A_{\text{se}} \cdot f_{\text{uta}} & \text{if AT} = \text{"AT3"} \end{cases}$$

[ACI 318-05 EQ D-19]
 [ACI 318-05 EQ D-20]
 [ACI 318-05 EQ D-20]

$V_{\text{sa}} = 322.944 \cdot \text{kip}$ one anchor

Subject: Gas Bottle Canopy, Supports, Equip, & Misc. Foundations
 By: M. Bratt
 Date: 10/5/2009

Concrete Breakout Strength-Shear [ACI 318-05 D.6.2]

group_status := "group"

Projected Concrete Failure Area [ACI 318-05 D.6.2.1, RD.6.2.1]

$c_{a1} = 15 \cdot \text{in}$ Assuming that total shear is critical on one anchor row

$h_a = 6 \cdot \text{in}$ Thickness of pedestal

$s_1 = 2 \cdot \text{ft}$ Anchor Bolt Spacing

$$c := \begin{cases} 1.5 \cdot c_{a1} & \text{if } 1.5 \cdot c_{a1} < c_{a2} \\ c_{a2} & \text{otherwise} \end{cases} \quad c = 1 \cdot \text{ft}$$

$$A_{vc} := \begin{cases} [2 \cdot (c) + s_1] \cdot h_a & \text{if } 1.5c_{a1} > h_a \\ 2 \cdot [(c) + s_1] \cdot 1.5 \cdot c_{a1} & \text{otherwise} \end{cases} \quad \begin{array}{l} \text{[ACI 318-05 Fig RD.6.2.1(b)]} \\ \text{Failure area for group of anchors} \end{array}$$

$$A_{vc} = 2 \cdot \text{ft}^2$$

$$A_{vco} := 4.5 \cdot c_{a1}^2$$

$$A_{vco} = 7 \cdot \text{ft}^2 \quad \text{[ACI 318-05 EQ D-23]}$$

$$A_{vc} := \min(A_{vc}, n_{\text{anch}} \cdot A_{vco})$$

$$A_{vc} = 2 \cdot \text{ft}^2$$

Basic Concrete Breakout Strength [ACI 318-05 D.6.2.2]

$l_e := h_{ef}$ anchor load bearing length

$$V_b := 7 \cdot \left(\frac{l_e}{d_o} \right)^{0.2} \cdot \sqrt{d_o} \cdot \sqrt{f_c} \cdot c_{a1}^{1.5} \cdot \text{psi}^{.5} \quad \text{[ACI 318-05 EQ D.24]}$$

$$V_b = 44849 \cdot \text{lbf}$$

Subject: Gas Bottle Canopy, Supports, Equip, & Misc. Foundations
 By: M. Bratt
 Date: 10/5/2009

$e'_v := 0 \text{ in}$ Assumption that shear is distributed equal to all anchors and no shear eccentricity results

$$\Psi_{ecV} := \min \left(1, \frac{1}{1 + 2 \cdot \frac{e'_v}{3 \cdot c_{a1}}} \right)$$

$$\Psi_{ecV} = 1$$

$$c_{a2} = 1 \text{ ft}$$

$$\Psi_{edV} := \begin{cases} 1.0 & \text{if } c_{a2} \geq 1.5 \cdot c_{a1} & \text{[ACI 318-05 EQ D-27]} \\ 0.7 + 0.3 \cdot \frac{c_{a2}}{1.5 \cdot c_{a1}} & \text{if } c_{a2} < 1.5 \cdot c_{a1} & \text{[ACI 318-05 EQ D-28]} \end{cases}$$

$$\Psi_{edV} = 1$$

crack_status = "not cracked"

$$\Psi_{cV} := \begin{cases} 1.4 & \text{if crack_status = "not cracked"} \\ 1.0 & \text{if crack_status = "cracked no reinforce"} \\ 1.2 & \text{if crack_status = "cracked with reinforce"} \\ 1.4 & \text{if crack_status = "cracked with reinforce and stirrups"} \end{cases}$$

$$\Psi_{cV} = 1$$

$$V_{cb} := \begin{cases} \frac{A_{vc}}{A_{vco}} \cdot \Psi_{edV} \cdot \Psi_{cV} \cdot V_b & \text{if group_status = "single anchor"} & \text{[ACI 318-05 EQ D-21]} \\ 0 & \text{otherwise} \end{cases}$$

$$V_{cbg} := \begin{cases} \frac{A_{vc}}{A_{vco}} \cdot \Psi_{ecV} \cdot \Psi_{edV} \cdot \Psi_{cV} \cdot V_b & \text{if group_status = "group"} & \text{[ACI 318-05 EQ D-22]} \\ 0 & \text{otherwise} \end{cases}$$

$$V_{cb} = 0 \text{ lbf}$$

$V_{cbg} = 17 \cdot \text{kip}$ group of 2 anchors

Subject: Gas Bottle Canopy, Supports, Equip, & Misc. Foundations
 By: M. Bratt
 Date: 10/5/2009

Concrete pryout strength of anchor in shear [ACI 318-05 D.6.3]

$$h_{ef} = 1 \text{ ft}$$

$$k_{cp} := \begin{cases} 1.0 & \text{if } h_{ef} < 2.5 \text{ in} \\ 2.0 & \text{if } h_{ef} \geq 2.5 \text{ in} \end{cases}$$

$$V_{cp} := \begin{cases} k_{cp} \cdot N_{cb} & \text{if group_status} = \text{"single anchor"} \\ 0 & \text{otherwise} \end{cases} \quad [\text{ACI 318-05 EQ D-29}]$$

$$V_{cpg} := \begin{cases} k_{cp} \cdot N_{cbg} & \text{if group_status} = \text{"group"} \\ 0 & \text{otherwise} \end{cases} \quad [\text{ACI 318-05 EQ D-30}]$$

$$V_{cpg} = 141.176 \cdot \text{kip} \quad \text{group of 2 anchors}$$

Shear Design Check

$$V_{sa} = 322944 \text{ lbf} \quad \text{one anchor}$$

$$V_{cbg} = 17079 \text{ lbf} \quad \text{group of 2 anchors}$$

$$V_{cpg} = 141176 \text{ lbf} \quad \text{group of 2 anchors}$$

$$\Phi_{\text{shear}} := 0.85 \quad \text{Anchor governed by concrete breakout, side-face blowout, pullout, or pryout strength [ACI 318-05 D.4.4]}$$

$$V_{\text{design}} := \Phi_{\text{shear}} \cdot \min(V_{sa} \cdot 4, V_{cbg}, V_{cpg}) \quad [\text{ACI 318-05 D.4.1.1}]$$

$$V_{\text{design}} = 14.517 \cdot \text{kip}$$

$$\text{design_shear} := \text{if}(V \leq V_{\text{design}}, \text{"Design is OK"}, \text{"Design is insufficient"})$$

$$\text{design_shear} = \text{"Design is OK"} \quad [\text{ACI 318-05 EQ D-2}]$$



Calculation Sheet

Project: BGCAPP
Job Number: 743341
Calc. No.: 24915-10-DBC-00-00004
Sheet No.: G-71 / G-83
Sheet Rev.: D

Subject: Gas Bottle Canopy, Supports, Equip, & Misc. Foundations
By: M. Bratt
Date: 10/5/2009

Interaction of tensile and shear forces [ACI 318-05 D.7]

$$\frac{V}{V_{\text{design}}} + \frac{T_{\text{one_anchor}}}{N_{\text{design}}} = 1.115$$

$$ST_{\text{check}} := \text{if} \left(\frac{V}{V_{\text{design}}} + \frac{T_{\text{one_anchor}}}{N_{\text{design}}} \leq 1.2, \text{"Interaction OK"}, \text{"Interaction Failure"} \right)$$

$$\text{interaction_check_V} := \text{if} \left[\left(V > 0.2 \cdot V_{\text{design}} \wedge T_{\text{one_anchor}} > N_{\text{design}} \right), ST_{\text{check}}, \text{"No check needed"} \right]$$

$$\text{interaction_check_V} = \text{"No check needed"}$$

Subject: Gas Bottle Canopy, Supports, Equip, & Misc. Foundations
 By: M. Bratt
 Date: 10/5/2009

Anchor Bolt Design - Equipment

Worst case Equipment Loads:

Multimedia Filter Tension: $T := 3.651 \text{ kip}$

(See App. E)

Hydrolysate Heater Module Shear: $V := 0.853 \text{ kip}$

Steel Strength of anchor in tension [ACI 318.05 D.5.1]

NOTE: ACI 318-05 Appendix D was adopted in lieu of ACI 318-02 in order to include the updated ductility requirements.

$$f_{ya} := 36 \text{ ksi} \quad n_{\text{anch}} := 4$$


$$f_{uta} := \min(1.9 \cdot f_{ya}, 125 \text{ ksi}, 58 \text{ ksi})$$

$$f_{uta} = 58000 \text{ psi}$$

Minimum bolt diameter: $d_o := 0.5 \text{ in}$

Minimum embedment into slab $h_{ef} := 6 \text{ in}$

$$A_{se} := 0.142 \text{ in}^2 \quad [\text{Ref. 4.17}]$$

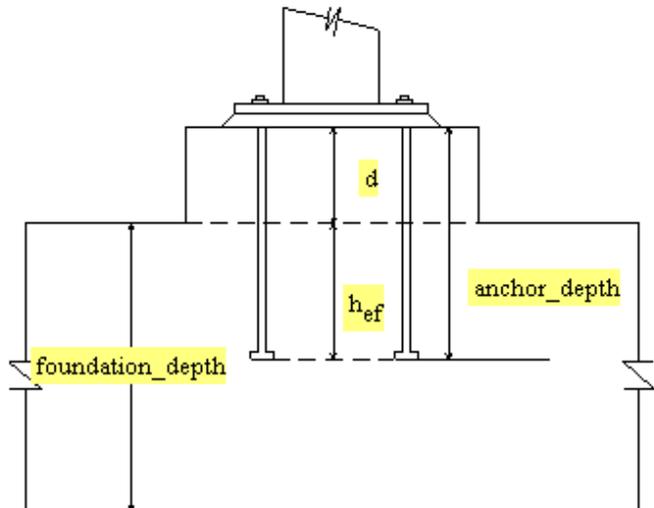

$$N_{sa} := n_{\text{anch}} \cdot A_{se} \cdot f_{uta} \quad [\text{ACI 318.05 Eq D-3}]$$

$$N_{sa} = 32.944 \text{ kip} \quad \text{one anchor}$$



Calculation Sheet

Project: BGCAPP
 Job Number: 743341
 Calc. No.: 24915-10-DBC-00-00004
 Sheet No.: G-73 / G-83
 Sheet Rev.: D

Subject: Gas Bottle Canopy, Supports, Equip, & Misc. Foundations
 By: M. Bratt
 Date: 10/5/2009

Steel Strength of Anchor in Shear [ACI 318-05 D.6.1]

Anchor Types:

AT1 [ACI 318-05 D.6.1.a]

AT2 [ACI 318-05 D.6.1.b]

AT3 [ACI 318-05 D.6.1.c]

Anchor Type Used:

AT := "AT1"

Grout Pad Factor [ACI 318-05 D.6.1.3]:

grout_pad_used := "yes"

$$c_{\text{pad}} := \begin{cases} 0.8 & \text{if grout_pad_used} = \text{"yes"} \\ 1.0 & \text{otherwise} \end{cases}$$

$c_{\text{pad}} = 1$

Shear Strength:

$$V_{\text{sa}} := \begin{cases} c_{\text{pad}} \cdot n_{\text{anch}} \cdot A_{\text{se}} \cdot f_{\text{uta}} & \text{if AT} = \text{"AT1"} & \text{[ACI 318-05 EQ D-19]} \\ c_{\text{pad}} \cdot n_{\text{anch}} \cdot 0.6 \cdot A_{\text{se}} \cdot f_{\text{uta}} & \text{if AT} = \text{"AT2"} & \text{[ACI 318-05 EQ D-20]} \\ c_{\text{pad}} \cdot n_{\text{anch}} \cdot 0.6 \cdot A_{\text{se}} \cdot f_{\text{uta}} & \text{if AT} = \text{"AT3"} & \text{[ACI 318-05 EQ D-20]} \end{cases}$$

$V_{\text{sa}} = 26.355 \cdot \text{kip}$ one anchor



Calculation Sheet

Project: BGCAPP
 Job Number: 743341
 Calc. No.: 24915-10-DBC-00-00004
 Sheet No.: G-74 / G-83
 Sheet Rev.: D

Subject: Gas Bottle Canopy, Supports, Equip, & Misc. Foundations
 By: M. Bratt
 Date: 10/5/2009

Concrete breakout strength-Tension [ACI 318.05 D.5.2]

Breakout Prism Properties

$$A_{NCO} := 9 \cdot h'_{ef}{}^2$$

$$A_{NCO} = 900 \cdot \text{in}^2$$

$$A_{NC} := \frac{(n_{\text{anch_ten}} \cdot A_{NCO})}{3} \quad (\text{Assume severe edge constraints for conservatism. Side blowout is not an issue because the concrete is confined})$$

$$A_{NC} = 600 \cdot \text{in}^2$$

$$\text{anchor_status} := \text{"cast in"}$$

$$k_c := \text{if}(\text{anchor_status} = \text{"cast in"}, 24, 17)$$

$$k_c = 24$$

$$N_b := \begin{cases} 16 \cdot \text{psi}^{.5} \cdot \text{in}^{\frac{1}{3}} \cdot \sqrt{f_c} \cdot h'_{ef}{}^{\frac{5}{3}} & \text{if } 11 \text{in} \leq h'_{ef} \leq 25 \text{in} & [\text{ACI 318-05 EQ D-7}] \\ k_c \cdot \sqrt{f_c} \cdot h'_{ef}{}^{1.5} \cdot \text{psi}^{.5} \cdot \text{in}^{.5} & \text{otherwise} & [\text{ACI 318-05 EQ D-8}] \end{cases}$$

$$N_b = 48000 \text{ lbf}$$

Subject: Gas Bottle Canopy, Supports, Equip, & Misc. Foundations
 By: M. Bratt
 Date: 10/5/2009

$$e'_N := 0 \text{ in}$$

Assumption that only one row of anchors on one side of the column center line carry tension load. Eccentricity is therefore distance from this row of anchors to the column center line

$$\Psi_{ecN} := \min\left(\frac{1}{1 + \frac{2 \cdot e'_N}{3 \cdot h'_{ef}}}, 1.0\right) \quad [\text{ACI 318-05 EQ D-9}]$$

$$\Psi_{ecN} = 1$$

$$\Psi_{edN} := \begin{cases} 1 & \text{if } c_{amin} \geq 1.5 \cdot h'_{ef} & [\text{ACI 318-05 EQ D-10}] \\ 0.7 + 0.3 \cdot \frac{c_{amin}}{1.5(h'_{ef})} & \text{if } c_{amin} < 1.5 \cdot h'_{ef} & [\text{ACI 318-05 EQ D-11}] \end{cases}$$

$$\Psi_{edN} = 1$$

$$\Psi_{cN} := \begin{cases} 1.25 & \text{if anchor_status} = \text{"cast in"} & [\text{ACI 318-05 EQ D.5.2.6}] \\ 1.4 & \text{otherwise} \end{cases}$$

$$\Psi_{cN} = 1$$

$$\Psi_{cpN} := 1 \quad [\text{ACI 318-05 D5.2.7}]$$

$$N_{cbg} := \frac{A_{NC}}{A_{NCO}} \cdot \Psi_{ecN} \cdot \Psi_{edN} \cdot \Psi_{cN} \cdot \Psi_{cpN} \cdot N_b \quad [\text{ACI 318-05 EQ D-5}]$$

$$N_{cbg} = 40 \cdot \text{kip} \quad \text{Group of two anchors}$$

Pullout Strength of Anchor in Tension [ACI 318-05 D.5.3]

$$A_{brg} := 0.291 \text{ in}^2 \quad \text{crack_status} := \text{"not cracked"} \quad \text{hook_status} := \text{"not hooked"}$$

$$N_p := 8 \cdot A_{brg} \cdot f_c \quad [\text{ACI 318-02 EQ D-15}]$$

$$\Psi_{cP} := \text{if}[(\text{crack_status} = \text{"cracked"}), 1.4, 1.0] \quad [\text{ACI 318-05 D.5.3.6}]$$

$$N_{pn} := \Psi_{cP} \cdot N_p \quad [\text{ACI 318-02 EQ D-14}]$$

$$N_{pn} = 9.312 \cdot \text{kip}$$

One Anchor

Therefore using one minimum 1/2" diameter anchor bolt with minimum 6" embedment is OK.

Subject: Gas Bottle & Misc Support Calculation
 By: M. Bratt
 Date: 10/5/2009

Base Plate Weld Design - Duct Support W8x31

Weld reduction factor: $\phi_{vw} := 0.75$

Weld tensile strength: $F_{exx} := 70\text{ksi}$ for E70 electrodes

Weld thickness: $t_{weld} := \frac{5}{16}\text{in}$

Flange Thickness: $t_f := 0.435\text{in}$

Web Thickness: $t_w := 0.285\text{in}$

Flange Width: $b_f := 8.0\text{in}$

Beam Depth: $d := 8.0\text{in}$

Axial Tension Load: $P := 1.652\text{kip}$


Shear Load: $V := 1.95\text{kip}$

Service Moment: $M := 35.58\text{kip}\cdot\text{ft}$

Length of the weld: $l_{weld} := 2 \cdot (2b_f + d) - 2(t_w + 2 \cdot t_f)$ $l_{weld} = 45.69 \cdot \text{in}$

Axial Stress: $\sigma_p := \frac{P}{l_{weld}}$ $\sigma_p = 0.04 \cdot \frac{\text{kip}}{\text{in}}$

Shear Stress: $\sigma_v := \frac{V}{l_{weld}}$ $\sigma_v = 0.04 \cdot \frac{\text{kip}}{\text{in}}$

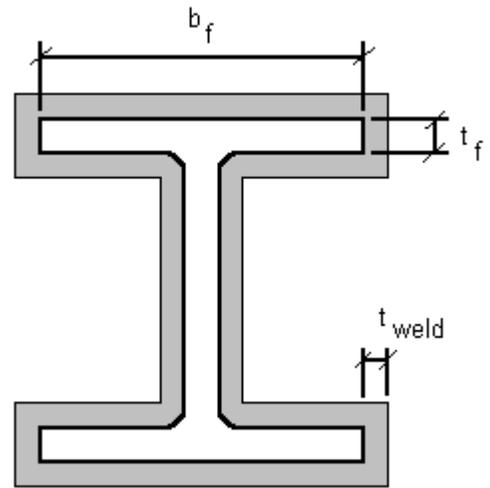

[Ref. 4.13]

Subject: Gas Bottle & Misc Support Calculation
 By: M. Bratt
 Date: 10/5/2009

Moment Stress:

$$I_{z_{weld}} := \frac{3 \cdot d^2 \cdot b_f + (d - 2t_f)^2 [3(b_f - t_w) + (d - 2t_f)]}{6} \quad I_{z_{weld}} = 512.51 \cdot \text{in}^3$$

$$S_{z_{weld}} := \frac{2 \cdot I_{z_{weld}}}{d} \quad S_{z_{weld}} = 128.13 \cdot \text{in}^2$$

Resultant Stress:

$$\sigma_u := \sqrt{\left(\sigma_p + \frac{M}{S_{z_{weld}}} \right)^2 + \sigma_v^2} \quad \sigma_u = 3.37 \cdot \frac{\text{kip}}{\text{in}}$$

Weld Capacity:

$$R_{n1} := \phi_{vw} \cdot \frac{\sqrt{2}}{2} \cdot 0.6 F_{exx} \cdot t_{weld} \quad R_{n1} = 6.96 \cdot \frac{\text{kip}}{\text{in}}$$


$$\text{Check}_{weld} := \text{if}(\sigma_u < R_{n1}, \text{"OK"}, \text{"NO GOOD"}) \quad \text{Check}_{weld} = \text{"OK"}$$

Subject: Gas Bottle & Misc Support Calculation
By: M. Bratt
Date: 10/5/2009

Base Plate Weld Design - Cable Tray W8x31

- Weld reduction factor: $\phi_{vw} := 0.75$
- Weld tensile strength: $F_{exx} := 70\text{ksi}$ for E70 electrodes
- Weld thickness: $t_{weld} := \frac{5}{16}\text{in}$
- Flange Thickness: $t_f := 0.435\text{in}$
- Web Thickness: $t_w := 0.285\text{in}$
- Flange Width: $b_f := 8.0\text{in}$
- Beam Depth: $d := 8.0\text{in}$

[Ref. 4.13]

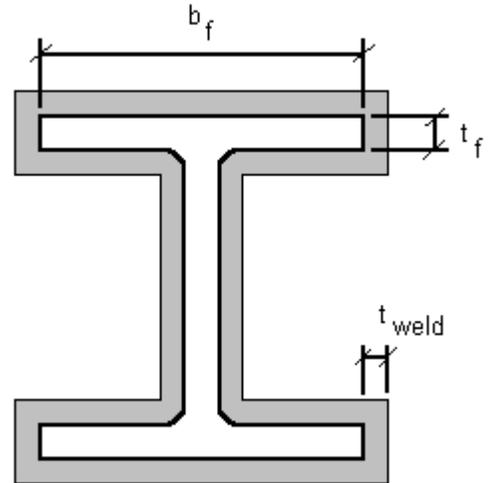

Axial Tension Load: $P := 11.35\text{kip}$ Shear Load: $V := 4.06\text{kip}$

Service Moment: $M := 67.27\text{kip}\cdot\text{ft}$

Length of the weld: $l_{weld} := 2 \cdot (2b_f + d) - 2(t_w + 2 \cdot t_f)$ $l_{weld} = 45.69 \cdot \text{in}$

Axial Stress: $\sigma_p := \frac{P}{l_{weld}}$ $\sigma_p = 0.25 \cdot \frac{\text{kip}}{\text{in}}$

Shear Stress: $\sigma_v := \frac{V}{l_{weld}}$ $\sigma_v = 0.09 \cdot \frac{\text{kip}}{\text{in}}$

Calculation Sheet

Project: BGCAPP
 Job Number: 743341
 Calc. No.: 24915-10-DBC-00-00004
 Sheet No.: G-79 / G-83
 Sheet Rev.: D

Subject: Gas Bottle & Misc Support Calculation
 By: M. Bratt
 Date: 10/5/2009

Moment Stress:

$$I_{z_{weld}} := \frac{3 \cdot d^2 \cdot b_f + (d - 2t_f)^2 [3(b_f - t_w) + (d - 2t_f)]}{6} \quad I_{z_{weld}} = 512.51 \cdot \text{in}^3$$

$$S_{z_{weld}} := \frac{2 \cdot I_{z_{weld}}}{d} \quad S_{z_{weld}} = 128.13 \cdot \text{in}^2$$

Resultant Stress:

$$\sigma_u := \sqrt{\left(\sigma_p + \frac{M}{S_{z_{weld}}} \right)^2 + \sigma_v^2} \quad \sigma_u = 6.55 \cdot \frac{\text{kip}}{\text{in}}$$

Weld Capacity:

$$R_{n1} := \phi_{vw} \cdot \frac{\sqrt{2}}{2} \cdot 0.6 F_{exx} \cdot t_{weld} \quad R_{n1} = 6.96 \cdot \frac{\text{kip}}{\text{in}}$$


$$\text{Check}_{weld} := \text{if}(\sigma_u < R_{n1}, \text{"OK"}, \text{"NO GOOD"}) \quad \text{Check}_{weld} = \text{"OK"}$$

Subject: Gas Bottle & Misc Support Calculation
 By: M. Bratt
 Date: 10/5/2009

Base Plate Weld Design - Duct Support W8x24

- Weld reduction factor: $\phi_{vw} := 0.75$
- Weld tensile strength: $F_{exx} := 70\text{ksi}$ for E70 electrodes
- Weld thickness: $t_{weld} := \frac{5}{16}\text{in}$
- Flange Thickness: $t_f := 0.40\text{in}$
- Web Thickness: $t_w := 0.245\text{in}$
- Flange Width: $b_f := 6.5\text{in}$
- Beam Depth: $d := 8.0\text{in}$

[Ref. 4.13]

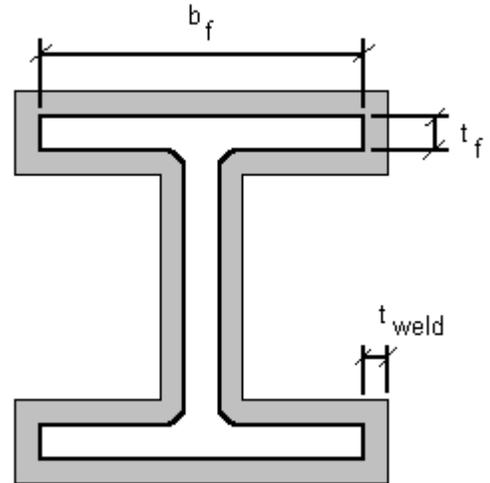

- Axial Tension Load: $P := 0.43\text{kip}$
- Shear Load: $V := 1.202\text{kip}$
- Applied Moment: $M := 13.66\text{kip}\cdot\text{ft}$

Length of the weld: $l_{weld} := 2 \cdot (2b_f + d) - 2(t_w + 2 \cdot t_f)$ $l_{weld} = 39.91 \cdot \text{in}$

Axial Stress: $\sigma_p := \frac{P}{l_{weld}}$ $\sigma_p = 0.01 \cdot \frac{\text{kip}}{\text{in}}$

Shear Stress: $\sigma_v := \frac{V}{l_{weld}}$ $\sigma_v = 0.03 \cdot \frac{\text{kip}}{\text{in}}$

Calculation Sheet

Project: BGCAPP
 Job Number: 743341
 Calc. No.: 24915-10-DBC-00-00004
 Sheet No.: G-81 / G-83
 Sheet Rev.: D

Subject: Gas Bottle & Misc Support Calculation
 By: M. Bratt
 Date: 10/5/2009

Moment Stress:

$$I_{z_{weld}} := \frac{3 \cdot d^2 \cdot b_f + (d - 2t_f)^2 [3(b_f - t_w) + (d - 2t_f)]}{6} \quad I_{z_{weld}} = 432.34 \cdot \text{in}^3$$

$$S_{z_{weld}} := \frac{2 \cdot I_{z_{weld}}}{d} \quad S_{z_{weld}} = 108.08 \cdot \text{in}^2$$

Resultant Stress:

$$\sigma_u := \sqrt{\left(\sigma_p + \frac{M}{S_{z_{weld}}} \right)^2 + \sigma_v^2} \quad \sigma_u = 1.53 \cdot \frac{\text{kip}}{\text{in}}$$

Weld Capacity:

$$R_{n1} := \phi_{vw} \cdot \frac{\sqrt{2}}{2} \cdot 0.6 F_{exx} \cdot t_{weld} \quad R_{n1} = 6.96 \cdot \frac{\text{kip}}{\text{in}}$$


$$\text{Check}_{weld} := \text{if}(\sigma_u < R_{n1}, \text{"OK"}, \text{"NO GOOD"}) \quad \text{Check}_{weld} = \text{"OK"}$$

Subject: Gas Bottle & Misc Support Calculation
By: M. Bratt
Date: 10/5/2009

Base Plate Weld Design - Duct Support W14x43

- Weld reduction factor: $\phi_{vw} := 0.75$
- Weld tensile strength: $F_{exx} := 70\text{ksi}$ for E70 electrodes
- Weld thickness: $t_{weld} := \frac{7}{16}\text{in}$
- Flange Thickness: $t_f := 0.530\text{in}$
- Web Thickness: $t_w := 0.305\text{in}$
- Flange Width: $b_f := 8.0\text{in}$
- Beam Depth: $d := 13.7\text{in}$

[Ref. 4.13]

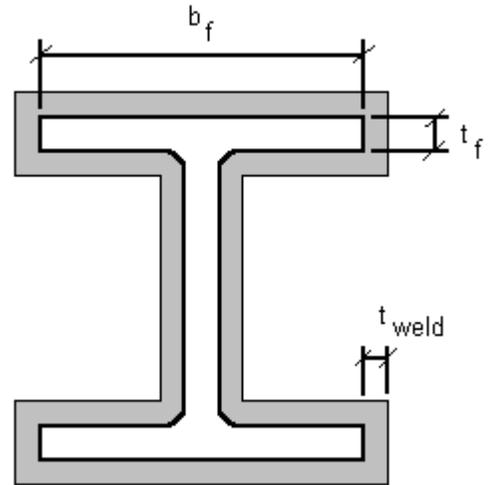

Axial Tension Load: $P := 2.071\text{kip}$ Shear Load: $V := 4.341\text{kip}$

Applied Moment: $M := 85.58\text{kip}\cdot\text{ft}$

Length of the weld: $l_{weld} := 2 \cdot (2b_f + d) - 2(t_w + 2 \cdot t_f)$ $l_{weld} = 56.67\text{in}$

Axial Stress: $\sigma_p := \frac{P}{l_{weld}}$ $\sigma_p = 0.04 \cdot \frac{\text{kip}}{\text{in}}$

Shear Stress: $\sigma_v := \frac{V}{l_{weld}}$ $\sigma_v = 0.08 \cdot \frac{\text{kip}}{\text{in}}$

Calculation Sheet

Project: BGCAPP
 Job Number: 743341
 Calc. No.: 24915-10-DBC-00-00004
 Sheet No.: G-83 / G-83
 Sheet Rev.: D

Subject: Gas Bottle & Misc Support Calculation
 By: M. Bratt
 Date: 10/5/2009

Moment Stress:

$$I_{z_{weld}} := \frac{3 \cdot d^2 \cdot b_f + (d - 2t_f)^2 [3(b_f - t_w) + (d - 2t_f)]}{6} \quad I_{z_{weld}} = 1702.05 \cdot \text{in}^3$$

$$S_{z_{weld}} := \frac{2 \cdot I_{z_{weld}}}{d} \quad S_{z_{weld}} = 248.48 \cdot \text{in}^2$$

Resultant Stress:

$$\sigma_u := \sqrt{\left(\sigma_p + \frac{M}{S_{z_{weld}}} \right)^2 + \sigma_v^2} \quad \sigma_u = 4.17 \cdot \frac{\text{kip}}{\text{in}}$$

Weld Capacity:

$$R_{n1} := \phi_{vw} \cdot \frac{\sqrt{2}}{2} \cdot 0.6 F_{exx} \cdot t_{weld} \quad R_{n1} = 9.74 \cdot \frac{\text{kip}}{\text{in}}$$

$$\text{Check}_{weld} := \text{if}(\sigma_u < R_{n1}, \text{"OK"}, \text{"NO GOOD"} \quad \text{Check}_{weld} = \text{"OK"}$$



A Joint Venture of Bechtel National, Inc. and
Parsons Infrastructure & Technology Group, Inc.

Calculation Sheet

Project:	<u>BGCAPP</u>
Job Number:	<u>743341</u>
Calc. No.	<u>24915-10-DBC-00-00004</u>
Sheet No.	<u>H-1 / H-8</u>
Sheet Rev.	<u>D</u>

Subject:	<u>Gas Bottles Canopy, Supports, Equip, & Misc Foundations</u>	
By:	<u>M. Bratt</u>	Date: <u>1/25/2010</u>

Appendix H

Containment and Retention Calculations

1/25/2010**SCWO Retention Capacity Summary**

Morgan Bratt

No	Area ID	Area Boundary	(Net) Area Sq. Ft.	Area Volume Capacity		Largest Vessel/Tank in Area		Air Volume of Largest Vessel/Tank in Area		Remarks
				Cu. Ft.	Gallons	Capacity Cu. Ft.	Capacity Gallons	Capacity Cu. Ft.	Capacity Gallons	
1	(Dwg 10-DB-06) Acid Tank	Between Ln A to B.2 and Ln 1 thru 3.2	1,017.50	573.94	4,293	113	845	125	935	Inside SPB
2	(Dwg 10-DB-07) AFS Filtrate and Feed Tank	Between Ln B.2 to F and Ln 1 thru 3.2	2,030.15	1,133.83	8,480	554	4,144	640	4,787	Inside SPB
3	(Dwg 10-DB-09) Hydrolysate Blend and Holding Tank	Between Ln A to B.1 and Ln 4 thru 8	1,643.80	913.18	6,830	650	4,862	860	6,432	Inside SPB
4	(Dwg 10-DB-09) Emergency Relief Tank	Between Ln A to C and Ln 8 thru 9	738.50	1,337.23	10,002	1,388	10,381	N/A	N/A	* Inside SPB
5	(Dwg 10-DB-50) STA Tanks	South of Ln J and Ln 1 thru 9	6,483.48	21,504.40	160,841	8,757	65,497	** 15,406	** 115,230	Outside SPB

* The containment volume requirement does not apply to this area. The Emergency relief tank, which is the only vessel in this containment area is not a liquid storage tank. It is used only to capture vapors and liquids that would be released in case of the emergency opening of the pressure relief in the SCWO reactors. Per General Atomics calculations, the liquid resulting from such a relief opening is less than 10% of the tank volume. The balance is gas.

** The Air Volume of Largest Vessel/Tank in Area includes the 25 year, 24 hour rainfall event.

Tank air volume = 11,372 cu. ft. Rainwater volume = 4,034 cu. ft. (see pg. H-7)

Note: Sump capacity shown on following pages is calculated based on Detail 2/24915-000-S0-00-00010.

$$(L \times W \times H) = 2'-3" \times 2'-3" \times 2'-3" = 11.4 \text{ ft}^3$$



Subject: Gas Bottles Canopy, Supports, Equip, Misc Foundations
 By: M. Bratt
 Date: 1/25/2010

Project: BGCAPP
 Job Number: 743341
 Calc. No.: 24915-10-DBC-00-00004
 Sheet No.: H-3 of H-8
 Sheet Rev.: D

Area 10-01 Dwg 10-DB-06

Room size L x B = L B
46.500 26.500 , = 1,232.250 sq.ft

Gross area = 1,232.250 sq.ft

Pad size	w1 x b1 =	No of pads	w	b	, =	
	w1 x b1 =	1.000	5.700	5.800	, =	33.060
	w2 x b2 =	2.000	4.900	4.900	, =	48.020
	w3 x b3 =	1.000	4.700	20.200	, =	94.940
Col	w4 x b4 =	9.000	2.000	1.400	, =	25.200
	w5 x b5 =	1.000	1.500	9.000	, =	13.500
Pump pad	w6 x b6 =				, =	0.000

Total pad area = 214.720 sq.ft

Net area, Anet= Gross area - Total pad area
 , = 1,017.530 sq.ft

Curb height @ door = 6.500 in
 diff in floor elevation = HP EL - LP EL
 , = 0.000 in

Accum wtr ht. Hwtr = (Curb ht. @ door + Diff in floor elevation/2)/12
 Hwtr = 0.542

Sump vol, Vsump =	11.391 cu.ft	No. of Sumps, n =	2.000
Trench vol, Vtrench =	Trench lngth x aver depth x width in ft		
Trench lngth, =	0.000 ft	Width, =	1.000 ft
aver depth in ft =	0.000 ft		
Vtrench =	0.000		

I Room Containm't Cap., Vcap = Anet x Hwtr + n x Vsump + Vtrench
 Vcap = 573.943 cu.ft

II Zone Room Containm'nt Cap

Accum zone wtr ht. = Hzwtr = (6.5+Diff in floor elevation/2)/12
 Hzwtr = 0.542
 Vzcap = Anet x Hzwtr + n x Vsump + Vtrench
 Vzcap = 573.943 cu.ft



Subject: Gas Bottles Canopy, Supports, Equip, Misc Foundations
 By: M. Bratt
 Date: 1/25/2010

Project: BGCAPP
 Job Number: 743341
 Calc. No.: 24915-10-DBC-00-00004
 Sheet No.: H-4 of H-8
 Sheet Rev.: D

Area 10-02 Dwg 10-DB-07

Room size L x B = L B
75.000 46.500 , = 3,487.500 sq.ft

Gross area = 3,487.500 sq.ft

Pad size	w1 x b1 =	No of pads	w	b	
	w1 x b1 =	1.000	10.000	7.500	, = 75.000
	w2 x b2 =	1.000	13.000	12.500	, = 162.500
	w3 x b3 =	1.000	25.500	16.000	, = 408.000
	w4 x b4 =	1.000	25.500	17.900	, = 456.450
	w5 x b5 =	1.000	23.500	9.000	, = 211.500
	w6 x b6 =	2.000	6.200	5.800	, = 71.920
Col	w7 x b7 =	15.000	2.000	1.000	30.000
	w8 x b8 =	6.000	2.000	2.000	24.000
	w9 x b9 =	8.000	1.500	1.500	18.000

Total pad area = 1,457.370 sq.ft

Net area, **Anet** = Gross area - Total pad area
 , = 2,030.130 sq.ft

Curb height @ door = 6.500 in
 diff in floor elevation = HP EL - LP EL
 , = 0.000 in

Accum wtr ht. Hwtr = (Curb ht. @ door + Diff in floor elevation/2)/12
 Hwtr = 0.542

Sump vol, Vsump = 11.391 cu.ft No. of Sumps, n = 3.000
 Trench vol, Vtrench = Trench lngth x aver depth x width in ft
 Trench lngth, = 0.000 ft Width, = 1.000 ft
 aver depth in ft = 0.000 ft
 Vtrench = 0.000

I Room Containm't Cap., Vcap = Anet x Hwtr + n x Vsump + Vtrench
 Vcap = 1,133.826 cu.ft

II Zone Room Containm't Cap

Accum zone wtr ht. = Hzwtr = (6.5 + Diff in floor elevation/2)/12
 Hzwtr = 0.542
 Vzcap = Anet x Hzwtr + n x Vsump + Vtrench
 Vzcap = 1,133.826 cu.ft



Subject: Gas Bottles Canopy, Supports, Equip, Misc Foundations
 By: M. Bratt
 Date: 1/25/2010

Project: BGCAPP
 Job Number: 743341
 Calc. No.: 24915-10-DBC-00-00004
 Sheet No.: H-5 of H-8
 Sheet Rev.: D

Area	10-04	Dwg 10-DB-09	Line 4-8		
			L	B	
Room size	L x B =		77.000	24.000	,= 1,848.000 sq.ft
	L1 x B1 =		77.000	11.000	847.000
			Gross area =		2,695.000 sq.ft
Pad size	w1 x b1 =	No of pads	w	b	
	w2 x b2 =	1.000	33.300	13.000	,= 432.900
	w3 x b3 =	1.000	8.800	5.900	,= 51.920
	w4 x b4 =	1.000	19.500	6.000	,= 117.000
	w5 x b5 =	1.000	11.200	6.000	,= 67.200
	w6 x b6 =	1.000	5.200	4.200	,= 21.840
	w7 x b7 =	1.000	14.200	9.200	,= 130.640
	w8 x b8 =	1.000	14.200	10.800	153.360
	w9 x b9 =	1.000	9.500	6.000	57.000
	w10 x b10 =	0.000	0.000	0.000	0.000
	w11 x b11 =	1.000	1.833	4.000	7.332
Col	w12 x b12 =	3.000	2.000	2.000	12.000
		0.000	0.000	0.000	0.000
			Total pad area =		1,051.192 sq.ft
			Net area, Anet=		Gross area - Total pad area
			, =		1,643.808 sq.ft
Curb height @ door =			6.500	in	
diff in floor elevation =			HP EL - LP EL		
			,= 0.000	in	
Accum wtr ht. Hwtr =			(Curb ht. @ door + Diff in floor elevation/2)/12		
			Hwtr =	0.542	
Sump vol, Vsump =			11.391	cu.ft	No.of Sumps,n= 2.000
Trench vol, Vtrench =			Trench lngth x aver depth x width in ft		
Trench lngth, =			0.000	ft	Width,= 1.000 ft
aver depth in ft =			0.600	ft	
			Vtrench =	0.000	
I Room Containm't Cap., Vcap =			Anet x Hwtr + n x Vsump + Vtrench		
			Vcap =	913.177	cu.ft
II Zone Room Containm't Cap					
Accum zone wtr ht. =Hwtr =			(6.5+Diff in floor elevation/2)/12		
			Hwtr =	0.542	
			Vzcap =	Anet x Hwtr +n x Vsump +Vtrench	
			Vzcap =	913.177	cu.ft



Subject: Gas Bottles Canopy, Supports, Equip, Misc Foundations
 By: M. Bratt
 Date: 1/25/2010

Project: BGCAPP
 Job Number: 743341
 Calc. No.: 24915-10-DBC-00-00004
 Sheet No.: H-7 of H-8
 Sheet Rev.: D

Area	10-15 & 10-16	Dwg 10-DB-50	Line 1-9					
Wall height =		32.000 in						
diff in floor elevation =		HP EL - LP EL						
		= 4.000 in						
Accum wtr ht. Hwtr =		(Wall ht. + Diff in floor elevation / 2)						
Hwtr =		34.000 in		2.833 ft				
Madison County 25-yr, 24 hour rain event, Hrain =		5.300 in		0.442 ft				
		L	B	Ht				
Room size L x B =		156.400	58.400	2.833	= 25,878.987 cu. ft			
Rain Water Volume =		156.400	58.400	0.442	= 4,034.077 cu. ft			
		Gross volume =			25,878.987 cu. ft			
		No of pads	w	b	ht	Volume	Area	
Pump pad size	w1 x b1 =	2.000	5.500	2.333	2.167	= 55.620	25.667	
	w2 x b2 =	2.000	4.583	2.000	2.167	= 39.728	18.333	
	w3 x b3 =	4.000	4.000	2.000	2.167	= 69.344	32.000	
	w4 x b4 =	2.000	4.583	2.000	2.167	= 39.728	18.333	
	w5 x b5 =	1.000	1.333	1.333	2.167	= 3.852	1.778	
Col	w7 x b7 =	20.000	2.000	2.000	0.500	= 40.000	80.000	
	w8 x b8 =	17.000	2.667	2.667	2.392	= 289.239	120.919	
		No of tanks	diameter	ht				
Tank immersion	w9 x ht9 =	2.000	21.000	1.667		= 1,154.766	692.721	
	w10 x ht10 =	2.000	20.000	1.667		= 1,047.407	628.319	
	w11 x ht11 =	1.000	18.500	1.667		= 448.094	268.803	
	w12 x ht12 =	3.000	18.000	1.667		= 1,272.599	763.407	
Tank pad volume, V _{tank} =		477.170 sq. ft x 1'-0"		8 pads		3,817.360 cu. ft		
(Calc. 24915-10-DBC-00-00002, Ref. 4-18)								
(see pg. H-8)								
				Total pad volume =		4,460.378 cu. ft		
				Total pad area =		2,650.279 sq. ft		
				Net volume, V_{net} =		Gross volume - Total pad volume		
				, =		21,418.609 cu. ft		
				Net area, A_{net} =		L x B - Total pad area		
				, =		6,483.481 sq. ft		
Sump vol, V _{sump} =		11.391 cu. ft		No. of Sumps, n=		1.000		
Trench vol, V _{trench} =		Trench length x aver depth x width in ft						
Trench length, =		124.000 ft		Width, =		1.000 ft		
aver depth in ft =		0.600 ft						
V _{trench} =		74.400 cu. ft						
Largest Tank Air Volume =		11,372.000 cu. ft						
I Room Containment Cap., V_{cap} =		V_{net} + n x V_{sump} + V_{trench}						
		V _{cap} =	21,504.400 cu. ft					
II Room Required Containment, V_{req} =		Rain Water Volume + Largest Tank Air Volume						
		V _{req} =	15,406.077 cu. ft					

Subject: Gas Bottle Canopy, Supports, Equip, Misc Foundations

By: M. Bratt

Date: 1/25/2010

Exerpt from Calc. 24915-10-DBC-00-00002 pg. B9 [Ref 4.18]

Live Loads Applied Outside Concrete Pad

LL := 250 • psf

[Ref. 4.2]

Dead Loads Applied on Concrete Pad

Area of a regular octagon:

Width of Pad: $S := 24 \bullet \text{ft}$

Side edge length: $a := \frac{S}{1 + \sqrt{2}} \quad a = 9.94 \text{ ft}$


Octagon tank pad area: $A_{\text{pad}} := S^2 - a^2 \quad A_{\text{pad}} = 477.17 \text{ ft}^2$

Tank self-weight: $W_S = 36.37 \bullet \text{kip}$

Tank content weight: $W_L = 685.84 \bullet \text{kip}$

Pad thickness:~ $t_{\text{pad}} := 12 \bullet \text{in}$

Density of Concrete: $\rho_C := 150 \text{ pcf}$

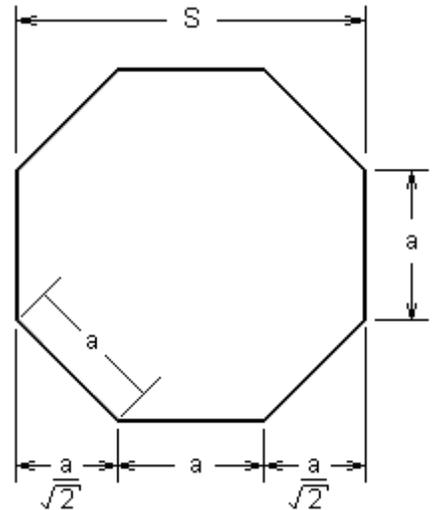

Pressure applied on concrete Mat due to Deadweight of empty Tank + Pad + Platform:

$$PDL_{\text{pad}} := \frac{W_S + W_R}{\pi \cdot \left(\frac{D_t}{2}\right)^2} + t_{\text{pad}} \cdot \rho_C = 263.25 \bullet \text{psf} \quad + 28 \text{ psf Say } 300 \text{ psf}$$

(28 psf added to incorporate Snow/Ice loads, see Sheet B11) <--SAFE input

Pressure applied on concrete pad due to tank liquid content with LL on Slab, (250 psf) deducted + LL on Platform, (100 psf) added:


$$P_{LL\text{pad}} := \frac{W_L}{\pi \cdot \left(\frac{D_t}{2}\right)^2} - LL = 1730.15 \bullet \text{psf} \quad \text{Say } 1750 \text{ psf} \quad \text{<--SAFE input}$$

MK-RO-0104
 MULTIMEDIA FILTER SKID
 MK-RO-0101A/B/C
 MULTIMEDIA FILTERS
 DESIGN PRESSURE : 150 PSIG
 DESIGN TEMPERATURE : 150 °F
 MATERIAL OF CONST : CARBON STEEL

- GENERAL NOTES:
- FOR SYMBOLS AND LEGEND, SEE DRAWINGS 24915-00-M6-00-00010 THRU 00015.
 - DRAWING NUMBERS IN OFF-PAGE CONNECTORS ARE TRUNCATED BY SUPPRESSING PROJECT NUMBER "24915" AND DOCUMENTS TYPE "M6". TWO LEADING ZEROS IN SEQUENCE NUMBER ARE NOT SHOWN.
 - ALL EQUIPMENT NUMBERS, INSTRUMENT TAG NUMBERS AND VALVE NUMBERS ARE PREFIXED "10" UNLESS OTHERWISE NOTED.
 - ALL WATER RECOVERY SYSTEMS INCLUDING CHEMICAL INJECTION SKIDS, MULTIMEDIA FILTERS: MK-RO-0101A/B/C/D/E/F, PREFILTERS: MK-RO-0102/0202/0302 AND RO UNITS: ML-RO-0101/0201/0301 TO SHARE ONE COMMON CONTAINMENT AREA.
 - MULTIMEDIA FILTERS BACKWASH WILL OCCUR FOR AT LEAST 10 MINUTES/CYCLE.
 - DASHED LINES DEFINE MODULE BOUNDARY. ALL DESIGN, PROCUREMENT AND FABRICATION INSIDE, SOLID LINES IS VENDOR SCOPE.

This document has been reviewed for ITAR/EAR and no ITAR/EAR sensitive information was found. 17 Dec 2013

This document has been reviewed for OPSEC material, and none was found. 17 Dec 2013

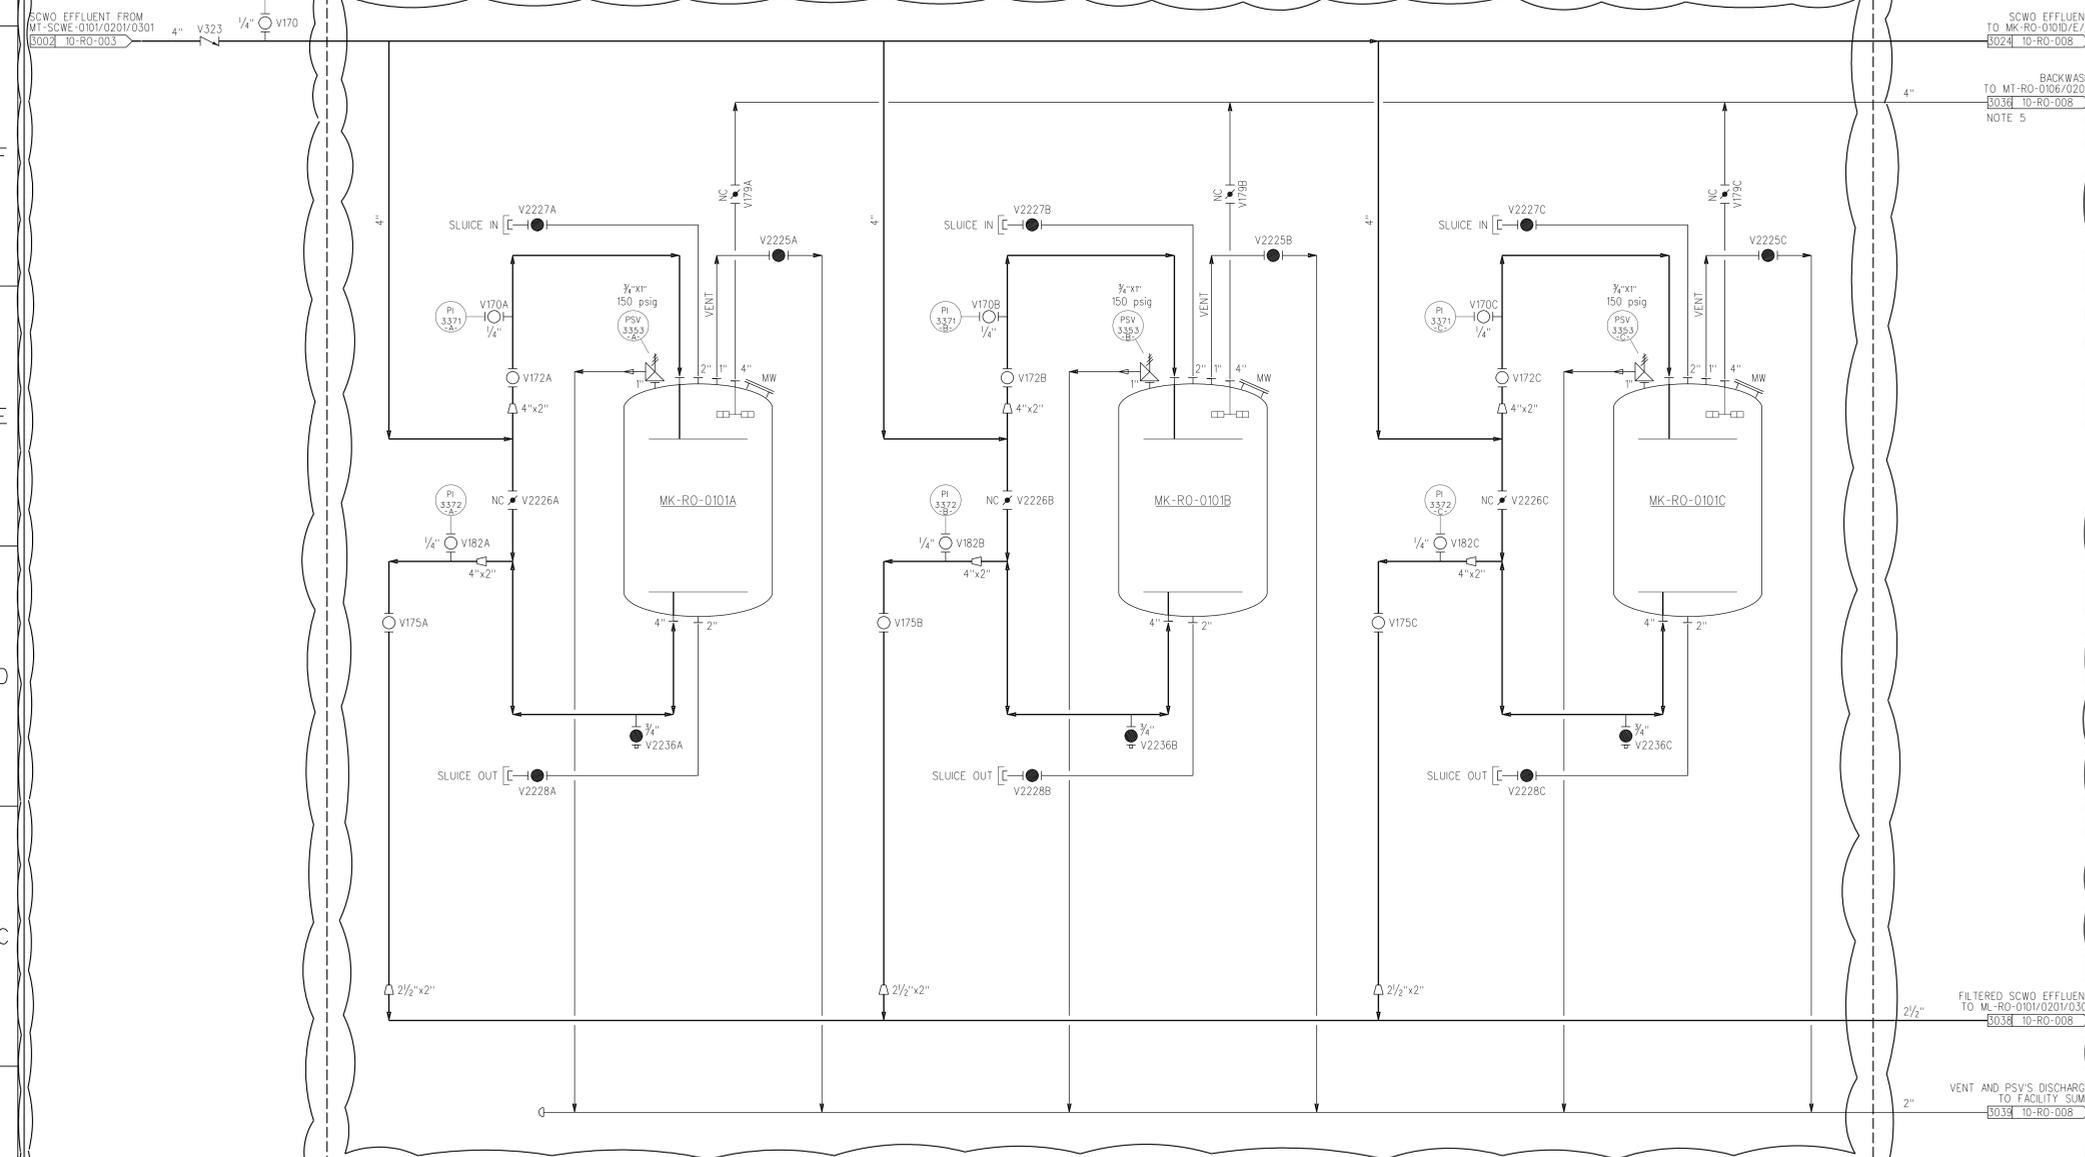

BASED ON BLUE GRASS PFD 24915-10-M6-RO-00001 REV.6
 BASED ON BLUE GRASS MSD 24915-10-NO-RO-00001 REV.2

REFERENCE DRAWINGS

VENT AND PSV'S DISCHARGE TO FACILITY SUMP
 15034 10-RO-008

NO.	DATE	DESCRIPTION	DR	CK	DL	PE	APVD
1	07/26/11	IFC, INCORPORATED DCN-464	JAW	PEB	SA	BBB	BBB
2	08/21/09	IFC, INCORPORATED REVISED DESIGN REQUIREMENTS	JLL	PEB	BM	BBB	BBB
3	08/15/07	ISSUED FOR CONSTRUCTION (IFC), TREND *00193	YWC	JP	PEB	RSA	BBB

BECHTEL PARSONS
 BLUE GRASS
 DOD PROGRAM MANAGER FOR ASSEMBLED CHEMICAL WEAPONS ASSESSMENT EDGEWOOD, MARYLAND
 US ARMY ENGINEERING AND SUPPORT CENTER, HUNTSVILLE, ALABAMA

BLUE GRASS CHEMICAL AGENT DESTRUCTION PILOT PLANT PROJECT (BGCAPP)
 RICHMOND, KENTUCKY
 DAAA09-03-D-0023

CONTRACT NO. | SCWO PROCESSING BUILDING MULTIMEDIA FILTERS PIPING & INSTRUMENT DIAGRAM

DRAWING NUMBER 24915-10-M6-RO-00007 SHEET 1 OF 1 REV 2




10MRO0007.ppt 07/28/11
 DESIGN FILE: DONSPEC
 PLOTTED BY: USER4 ON DATE: 07/28/11 AT 5:11 PM USING COLOR: 15034 10-RO-008

MX-RO-0104
 MULTIMEDIA FILTER SKID
 MK-RO-0101D/E/F
 MULTIMEDIA FILTERS
 DESIGN PRESSURE : 150 PSIG
 DESIGN TEMPERATURE : 150 °F
 MATERIAL OF CONST : CARBON STEEL

- GENERAL NOTES:
- FOR SYMBOLS AND LEGEND, SEE DRAWINGS 24915-00-M6-00-00010 THRU 00015.
 - DRAWING NUMBERS IN OFF-PAGE CONNECTORS ARE TRUNCATED BY SUPPRESSING PROJECT NUMBER "24915" AND DOCUMENTS TYPE "M6". TWO LEADING ZEROS IN SEQUENCE NUMBER ARE NOT SHOWN.
 - ALL EQUIPMENT NUMBERS, INSTRUMENT TAG NUMBERS AND VALVE NUMBERS ARE PREFIXED "10" UNLESS OTHERWISE NOTED.
 - ALL WATER RECOVERY SYSTEMS INCLUDING CHEMICAL INJECTION SKIDS, MULTIMEDIA FILTERS: MK-RO-0101A/B/C/D/E/F, PREFILTERS: MK-RO-0101/0201/0301 TO SHARE ONE COMMON CONTAINMENT AREA.
 - MULTIMEDIA FILTERS BACKWASH WILL OCCUR FOR AT LEAST 10 MINUTES/CYCLE.
 - DASHED LINES DEFINE MODULE BOUNDARY. ALL DESIGN, PROCUREMENT AND FABRICATION INSIDE, SOLID LINES IS VENDOR SCOPE.

This document has been reviewed for ITAR/EAR and no ITAR/EAR sensitive information was found. 17 Dec 2013

This document has been reviewed for OPSEC material, and none was found. 17 Dec 2013

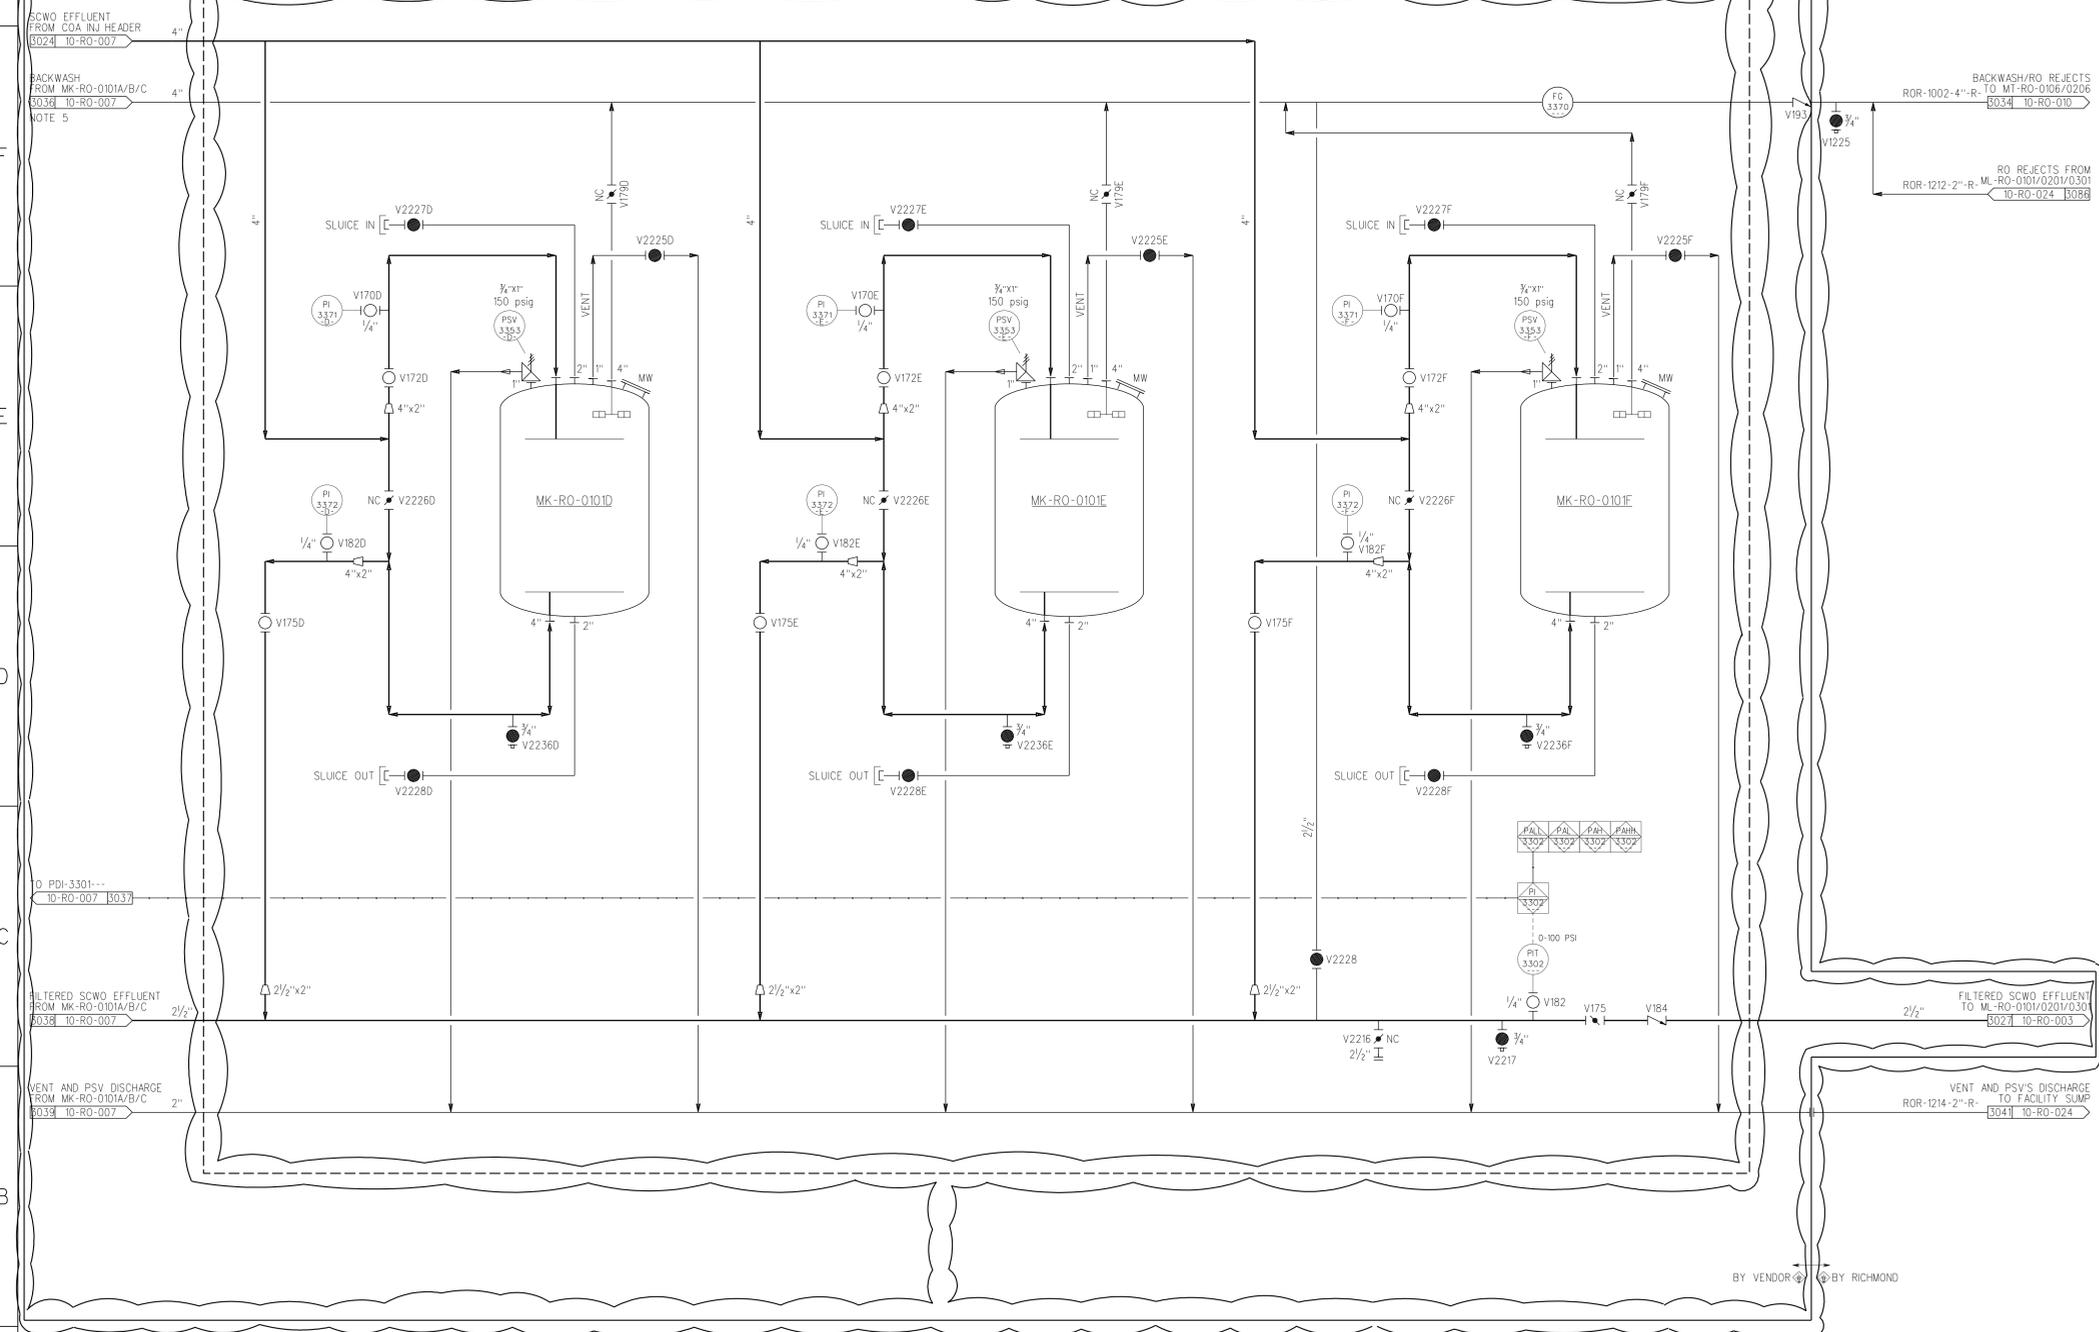

BASED ON BLUE GRASS PFD 24915-10-M6-RO-00001 REV.6
 BASED ON BLUE GRASS MSD 24915-10-NO-RO-00001 REV.2

REFERENCE DRAWINGS

VENT AND PSV'S DISCHARGE TO FACILITY SUMP
 ROR-1214-2"-R-5041 10-RO-024

NO.	DATE	DESCRIPTION	DR	CK	DL	PE	APVD
1	07/26/11	IFC, INCORPORATED DCN-464	JAW	PEB	SA	BBB	BBB
2	08/21/09	IFC, INCORPORATED REVISED DESIGN REQUIREMENTS	JLL	PEB	BM	BBB	BBB
3	08/15/07	ISSUED FOR CONSTRUCTION (IFC), TREND *00193	YWC	JP	PEB	RSA	BBB

BECHTEL PARSONS
 BLUE GRASS
 DOD PROGRAM MANAGER FOR ASSEMBLED CHEMICAL WEAPONS ASSESSMENT EDGEWOOD, MARYLAND
 US ARMY ENGINEERING AND SUPPORT CENTER, HUNTSVILLE HUNTSVILLE, ALABAMA

BLUE GRASS CHEMICAL AGENT DESTRUCTION PILOT PLANT PROJECT (BGCAPP)
 RICHMOND, KENTUCKY
 DAAA09-03-D-0023

CONTRACT NO. |
 SCWO PROCESSING BUILDING MULTIMEDIA FILTERS PIPING & INSTRUMENT DIAGRAM

DRAWING NUMBER 24915-10-M6-RO-00008 SHEET 1 OF 1 REV 2




10MRO0106.pid 07/28/11
 DESIGN FILE: DONSPENCER
 PLOTTED BY: USER4 ON DATE: 07/28/11 AT 11:58:58 AM
 AT SYTIME USING COLOR: 07/28/11 11:58:58 AM

This document has been reviewed for ITAR/EAR and no ITAR/EAR sensitive information was found. 17 Dec 2013

This document has been reviewed for OPSEC material, and none was found. 17 Dec 2013

- GENERAL NOTES:**
- FOR SYMBOLS AND LEGEND, SEE DRAWINGS 24915-00-M6-00-00010 THRU 00015.
 - DRAWING NUMBERS IN OFF-PAGE CONNECTORS ARE TRUNCATED BY SUPPRESSING PROJECT NUMBER "24915" AND DOCUMENTS TYPE "M6". TWO LEADING ZEROS IN SEQUENCE NUMBER ARE NOT SHOWN.
 - ALL EQUIPMENT NUMBERS, INSTRUMENT TAG NUMBERS AND VALVE NUMBERS ARE PREFIXED "10" UNLESS OTHERWISE NOTED.
 - MOTOR FAILURE OF RUNNING PUMP TO AUTOMATICALLY START STANDBY PUMP AND ALARM.
 - IF THE PUMP DISCHARGE PRESSURE FALLS BELOW NORMAL FOR MORE THAN 1 SECOND WHILE THE "LEAD" PUMP IS RUNNING, THE "STANDBY" PUMP WILL AUTOMATICALLY START. ONCE THE "STANDBY" PUMP HAS STARTED AND IF PRESSURE DOES NOT RETURN TO NORMAL WITHIN 5 SECONDS, BOTH THE "LEAD" AND "STANDBY" PUMPS WILL STOP. IF THE "LEAD" PUMP BECOMES DE-ENERGIZED, THE "STANDBY" WILL AUTOMATICALLY START WITHOUT WAITING FOR THE PRESSURE TO FALL BELOW NORMAL. BOTH PUMPS TO BE SHUTDOWN VIA LALL-0483-A- AND -B- ARE ACTIVATED.
 - PUMPS TO BE LOCATED OUTDOORS. PUMPS, ASSOCIATED PIPING AND INSTRUMENTS TO BE ELECTRIC HEAT TRACED TO 40°F AND INSULATED FOR FREEZE PROTECTION.
 - SCWO EFFLUENT TANKS MT-SCWO-0101/0201/0301, PROCESS WATER TANK MT-PWS-0101, RO PERMEATE TANKS MT-SWS-0101/0201 AND THEIR ASSOCIATED PUMPS ARE LOCATED INSIDE THE SAME CURBED CONTAINMENT AREA.
 - UNLESS OTHERWISE NOTED, FCS INTERLOCK NUMBERS ARE PREFIXED WITH "10-RO-".

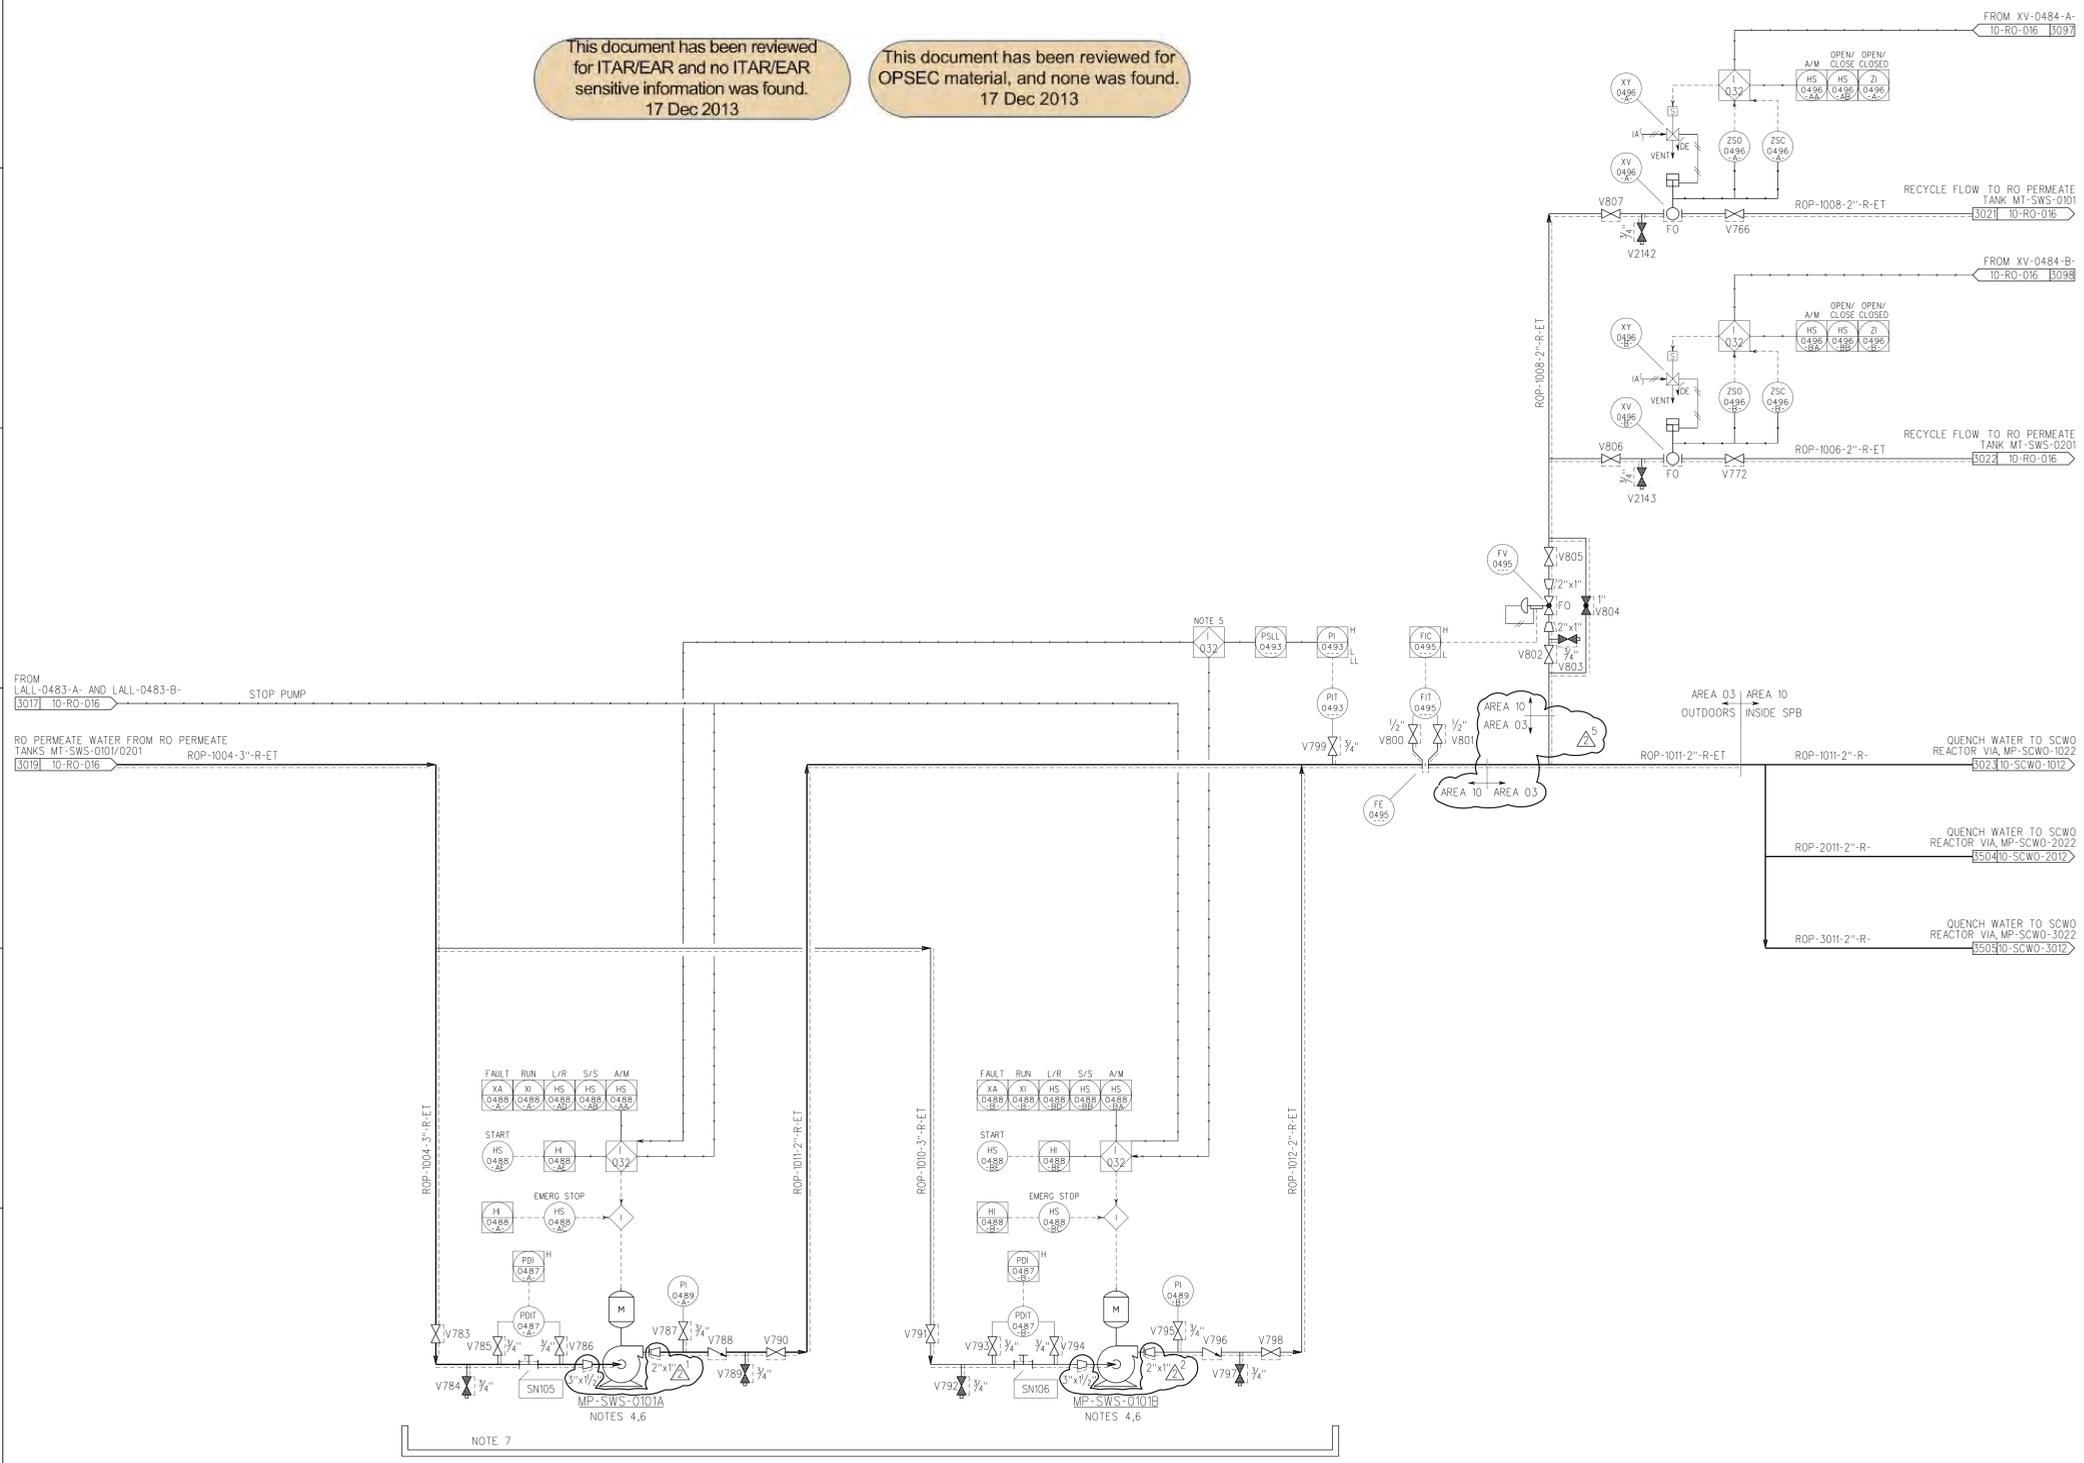


MV-RO-0101
 SCWO EFFLUENT CAUSTIC DAY TANK
 WORKING VOLUME : 350 GAL
 I.D. : 4.0 FT
 T-T : 7.0 FT
 DESIGN PRESSURE : 14.9 PSIG
 DESIGN TEMPERATURE : 125 °F
 MATERIAL OF CONST : CS
 TRIM : TRIM-1161-0"-AD

This document has been reviewed for ITAR/EAR and no ITAR/EAR sensitive information was found. 17 Dec 2013

This document has been reviewed for OPSEC material, and none was found. 17 Dec 2013

- GENERAL NOTES:
- FOR SYMBOLS AND LEGEND, SEE DRAWINGS 24915-00-M6-00-00010 THRU 00015.
 - DRAWING NUMBERS IN OFF-PAGE CONNECTORS ARE TRUNCATED BY SUPPRESSING PROJECT NUMBER "24915" AND DOCUMENTS TYPE "M6". TWO LEADING ZEROS IN SEQUENCE NUMBER ARE NOT SHOWN.
 - ALL EQUIPMENT NUMBERS, INSTRUMENT TAG NUMBERS AND VALVE NUMBERS ARE PREFIXED "10" UNLESS OTHERWISE NOTED.
 - RESTRICTION ORIFICE TO MAINTAIN BACK PRESSURE FROM THE 18X CAUSTIC TRANSFERRING SYSTEM.
 - THERMOWELL CONNECTION BELOW LLLL.
 - METERING PUMP SHALL BE EQUIPPED WITH CALIBRATION TUBE BY VENDOR.
 - DELETED.
 - TANK AND PUMPS ARE LOCATED INSIDE THE SCWO EFFLUENT CAUSTIC DAY TANK CONTAINMENT AREA INSIDE THE SPB.
 - DELETED.
 - LEAK-PROOF POSITIVE SHUT-OFF VALVE IS OPENED ONLY BEFORE THE START OF THE CAUSTIC INJECTION PUMP.
 - UNLESS OTHERWISE NOTED, FCS INTERLOCK NUMBERS ARE PREFIXED WITH "10-RO-".
 - METERING PUMPS WILL HAVE THE CAPABILITY TO BE CONTROLLED FROM THE CONTROL ROOM.
 - DELETED.
 - FIT0317A-- IS SELECTED BY DEFAULT. IF FIT0317A-- FAILS THEN FIT0317B-- IS SELECTED.

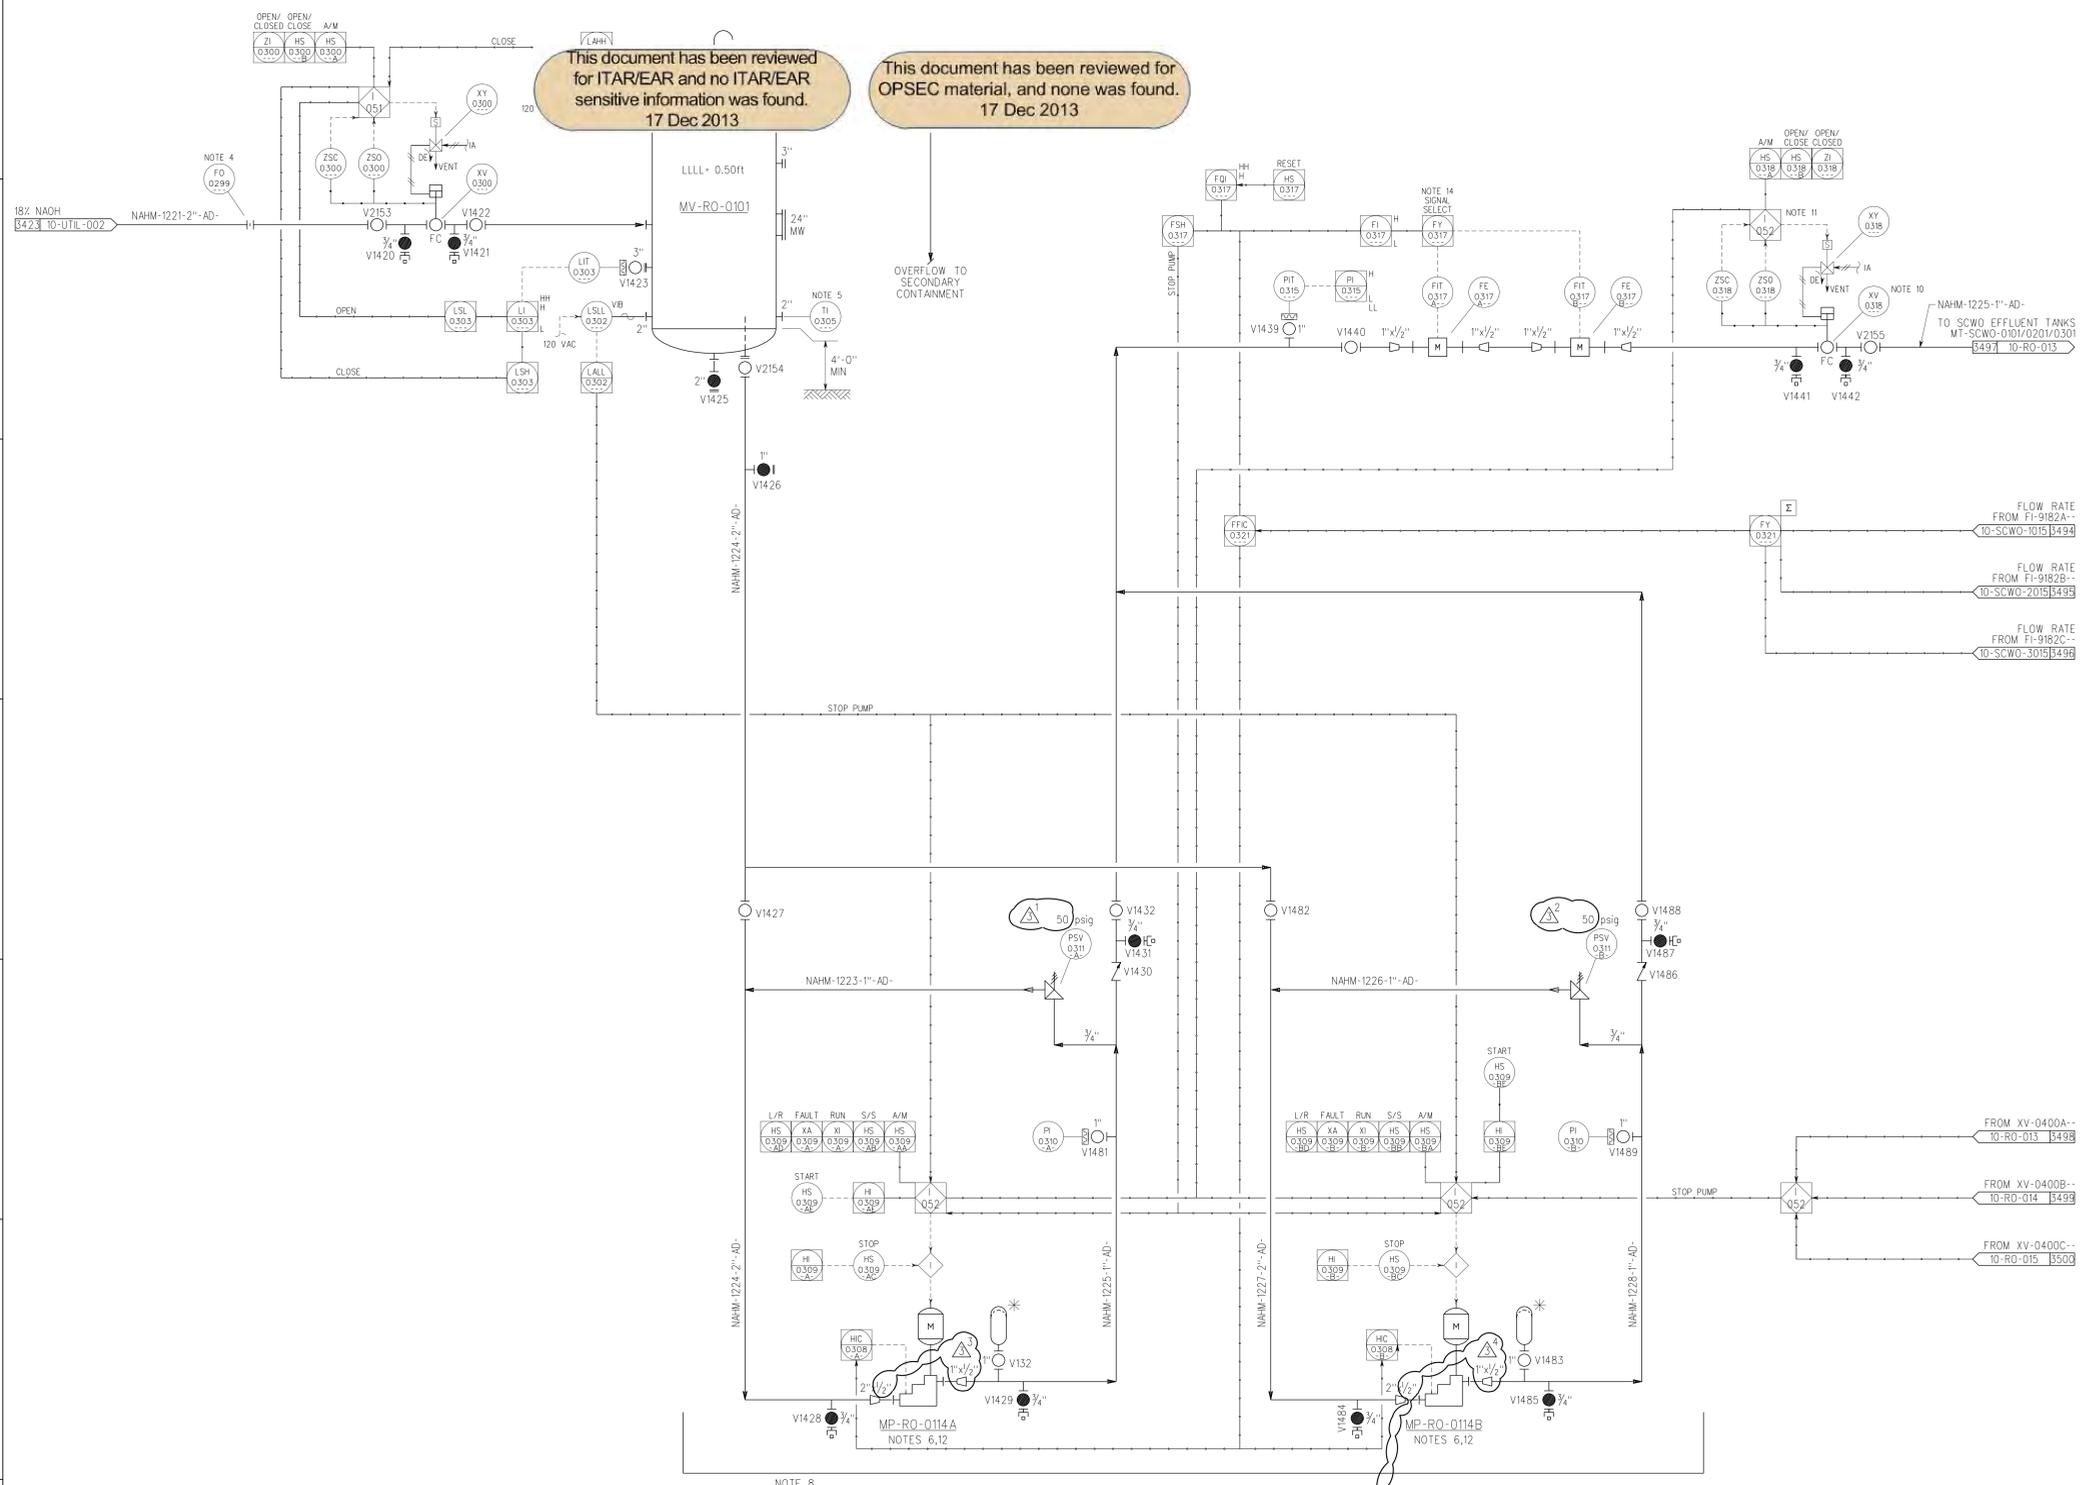

BASED ON BLUE GRASS PFD 24915-10-M6-RO-00002 REV. 7
BASED ON BLUE GRASS MSD 24915-10-NO-RO-00002 REV. 2
REFERENCE DRAWINGS
FROM XV-0400A-- 10-RO-013 [5498]
FROM XV-0400B-- 10-RO-014 [5498]
FROM XV-0400C-- 10-RO-015 [5500]

NO.	DATE	DESCRIPTION	DR	CK	DL	PE	APVD
1	03/22/12	IFC, INCORPORATED DCN-552 AND -711	JAW	JDC	SA	BBB	BBB
2	08/21/09	IFC, HTL-937, ADDED REVISED DESIGN REQUIREMENTS	JLL	PEB	BM	BBB	BBB
3	08/13/07	ISSUED FOR CONSTRUCTION (IFC), GA CONTROL INPUT	YWC	JLL	PEB	RSA	BBB
4	05/02/07	ISSUED FOR DESIGN (IFD)	YWC	JLL	PEB	RSA	BBB

QUALITY	<input type="checkbox"/> Non-0
BECHTEL PARSONS	DDO PROGRAM MANAGER FOR ASSEMBLED CHEMICAL WEAPONS ASSESSMENT EDgewood, MARYLAND
BLUE GRASS	US ARMY ENGINEERING AND SUPPORT CENTER, HUNTSVILLE HUNTSVILLE, ALABAMA

BLUE GRASS CHEMICAL AGENT DESTRUCTION PILOT PLANT PROJECT (BGCAPP) RICHMOND, KENTUCKY


CONTRACT NO. DAAA09-03-D-0023

SCWO PROCESSING BUILDING SCWO EFFLUENT CAUSTIC DAY TK & PUMP PIPING & INSTRUMENT DIAGRAM

DRAWING NUMBER	24915-10-M6-RO-00021	SHEET	1 OF 1	REV	3
----------------	----------------------	-------	--------	-----	---



10MRO021.dwg 05/17/12
 DESIGN FILE: DONSPEC AT SYTIME USING COLOR...
 PLOTTED BY: USER ON DATE...

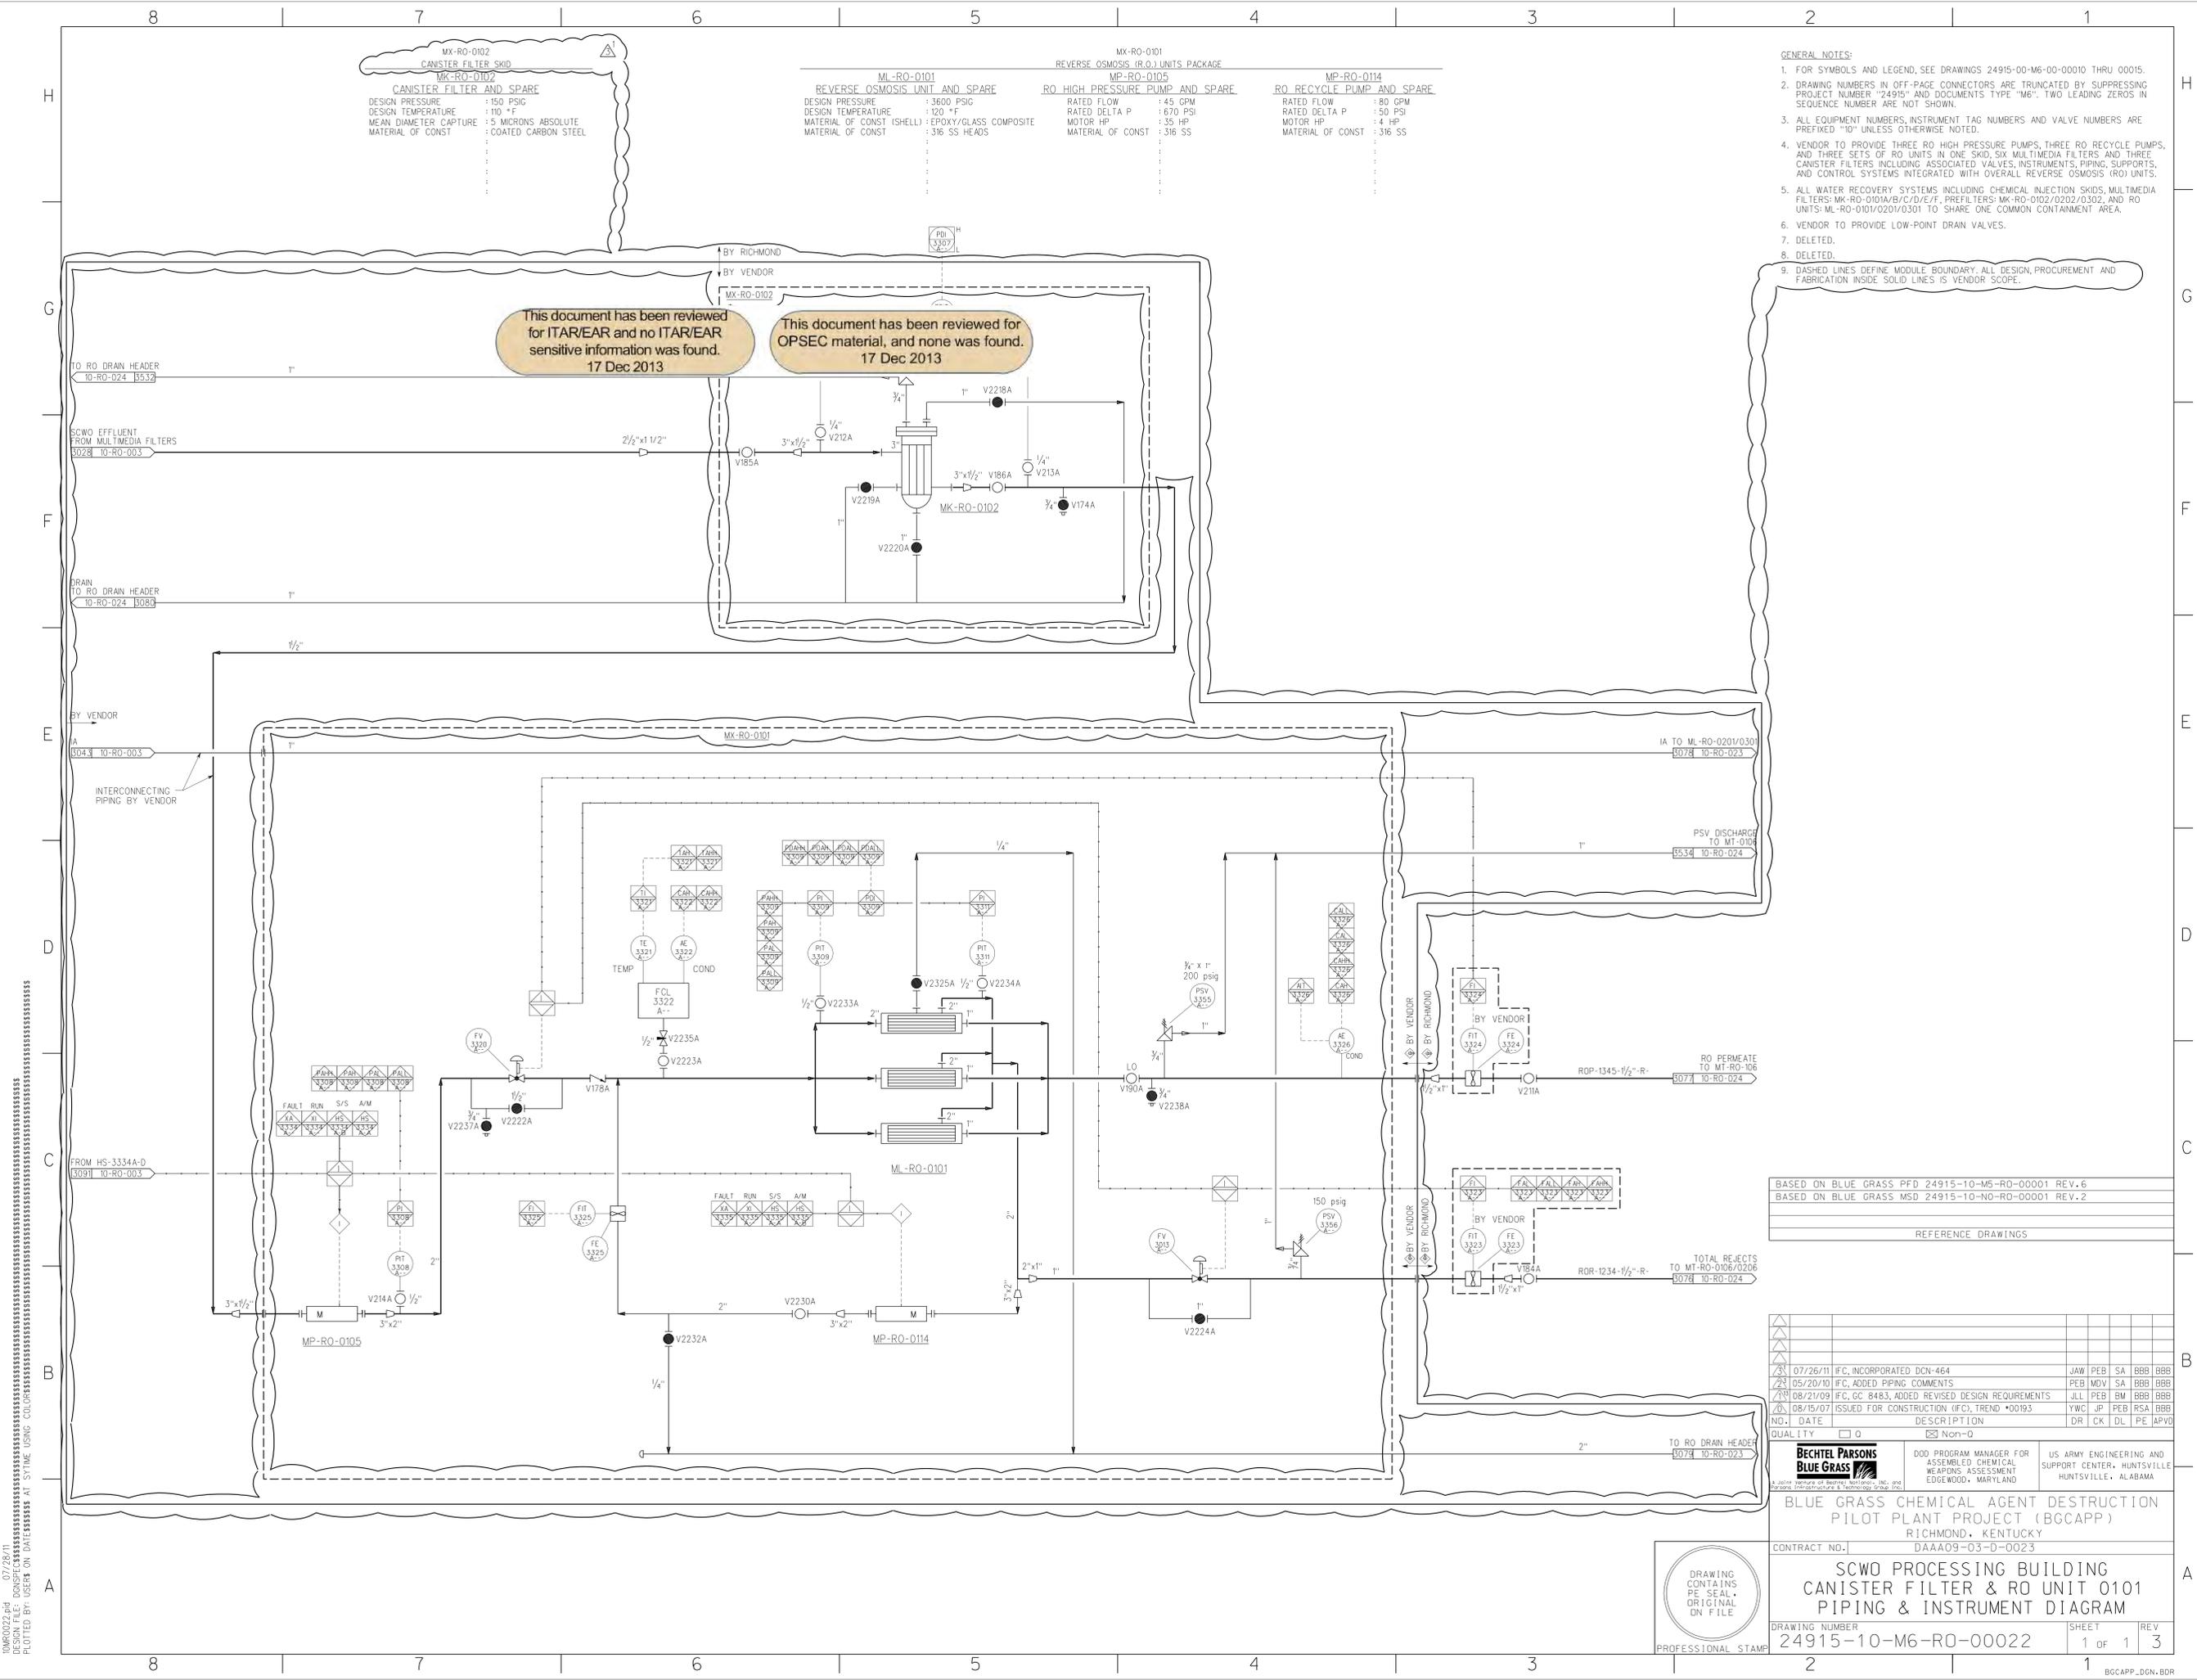

MX-RO-002
 CANISTER FILTER SKID
 MK-RO-0102
 CANISTER FILTER AND SPARE
 DESIGN PRESSURE : 150 PSIG
 DESIGN TEMPERATURE : 110 °F
 MEAN DIAMETER CAPTURE : 5 MICRONS ABSOLUTE
 MATERIAL OF CONST : COATED CARBON STEEL

ML-RO-0101
 REVERSE OSMOSIS UNIT AND SPARE
 DESIGN PRESSURE : 3600 PSIG
 DESIGN TEMPERATURE : 120 °F
 MATERIAL OF CONST (SHELL) : EPOXY/GLASS COMPOSITE
 MATERIAL OF CONST : 316 SS HEADS

MX-RO-001
 REVERSE OSMOSIS (R.O.) UNITS PACKAGE
 MP-RO-0105
 RO HIGH PRESSURE PUMP AND SPARE
 RATED FLOW : 45 GPM
 RATED DELTA P : 670 PSI
 MOTOR HP : 35 HP
 MATERIAL OF CONST : 316 SS

MP-RO-0114
 RO RECYCLE PUMP AND SPARE
 RATED FLOW : 80 GPM
 RATED DELTA P : 50 PSI
 MOTOR HP : 4 HP
 MATERIAL OF CONST : 316 SS

- GENERAL NOTES:
- FOR SYMBOLS AND LEGEND, SEE DRAWINGS 24915-00-M6-00-00010 THRU 00015.
 - DRAWING NUMBERS IN OFF-PAGE CONNECTORS ARE TRUNCATED BY SUPPRESSING PROJECT NUMBER "24915" AND DOCUMENTS TYPE "M6". TWO LEADING ZEROS IN SEQUENCE NUMBER ARE NOT SHOWN.
 - ALL EQUIPMENT NUMBERS, INSTRUMENT TAG NUMBERS AND VALVE NUMBERS ARE PREFIXED "10" UNLESS OTHERWISE NOTED.
 - VENDOR TO PROVIDE THREE RO HIGH PRESSURE PUMPS, THREE RO RECYCLE PUMPS, AND THREE SETS OF RO UNITS IN ONE SKID, SIX MULTIMEDIA FILTERS AND THREE CANISTER FILTERS INCLUDING ASSOCIATED VALVES, INSTRUMENTS, PIPING, SUPPORTS, AND CONTROL SYSTEMS INTEGRATED WITH OVERALL REVERSE OSMOSIS (RO) UNITS.
 - ALL WATER RECOVERY SYSTEMS INCLUDING CHEMICAL INJECTION SKIDS, MULTIMEDIA FILTERS: MK-RO-0101A/B/C/D/E/F, PREFILTERS: MK-RO-0102/0202/0302, AND RO UNITS: ML-RO-0101/0201/0301 TO SHARE ONE COMMON CONTAINMENT AREA.
 - VENDOR TO PROVIDE LOW-POINT DRAIN VALVES.
 - DELETED.
 - DELETED.
 - DASHED LINES DEFINE MODULE BOUNDARY. ALL DESIGN, PROCUREMENT AND FABRICATION INSIDE SOLID LINES IS VENDOR SCOPE.

This document has been reviewed for ITAR/EAR and no ITAR/EAR sensitive information was found. 17 Dec 2013


This document has been reviewed for OPSEC material, and none was found. 17 Dec 2013


BASED ON BLUE GRASS PFD 24915-10-M6-RO-00001 REV.6
 BASED ON BLUE GRASS MSD 24915-10-NO-RO-00001 REV.2
 REFERENCE DRAWINGS

NO.	DATE	DESCRIPTION	DR	CK	DL	PE	APVD
3	07/26/11	I/C, INCORPORATED DCN-464	JAW	PEB	SA	BBB	BBB
2	05/20/10	I/C, ADDED PIPING COMMENTS	PEB	MDV	SA	BBB	BBB
1	08/21/09	I/C, GC 8483, ADDED REVISED DESIGN REQUIREMENTS	JLL	PEB	BM	BBB	BBB
0	08/15/07	ISSUED FOR CONSTRUCTION (I/C), TREND *00193	YWC	JP	PEB	RSA	BBB

BECHTEL PARSONS
 BLUE GRASS
 DOD PROGRAM MANAGER FOR ASSEMBLED CHEMICAL WEAPONS ASSESSMENT EDGEWOOD, MARYLAND
 US ARMY ENGINEERING AND SUPPORT CENTER, HUNTSVILLE HUNTSVILLE, ALABAMA
 BLUE GRASS CHEMICAL AGENT DESTRUCTION PILOT PLANT PROJECT (BCAPP)
 RICHMOND, KENTUCKY
 DAAA09-03-D-0023
 SCWO PROCESSING BUILDING CANISTER FILTER & RO UNIT 0101 PIPING & INSTRUMENT DIAGRAM
 CONTRACT NO. 24915-10-M6-RO-00022
 DRAWING NUMBER 24915-10-M6-RO-00022 SHEET 1 OF 1 REV 3

10MRO0102.ppt 07/28/11
 DESIGN FILE: DONSPEC
 PLOTTED BY: USER4 ON DATE: 7/28/2011 9:40:08 AM

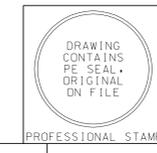

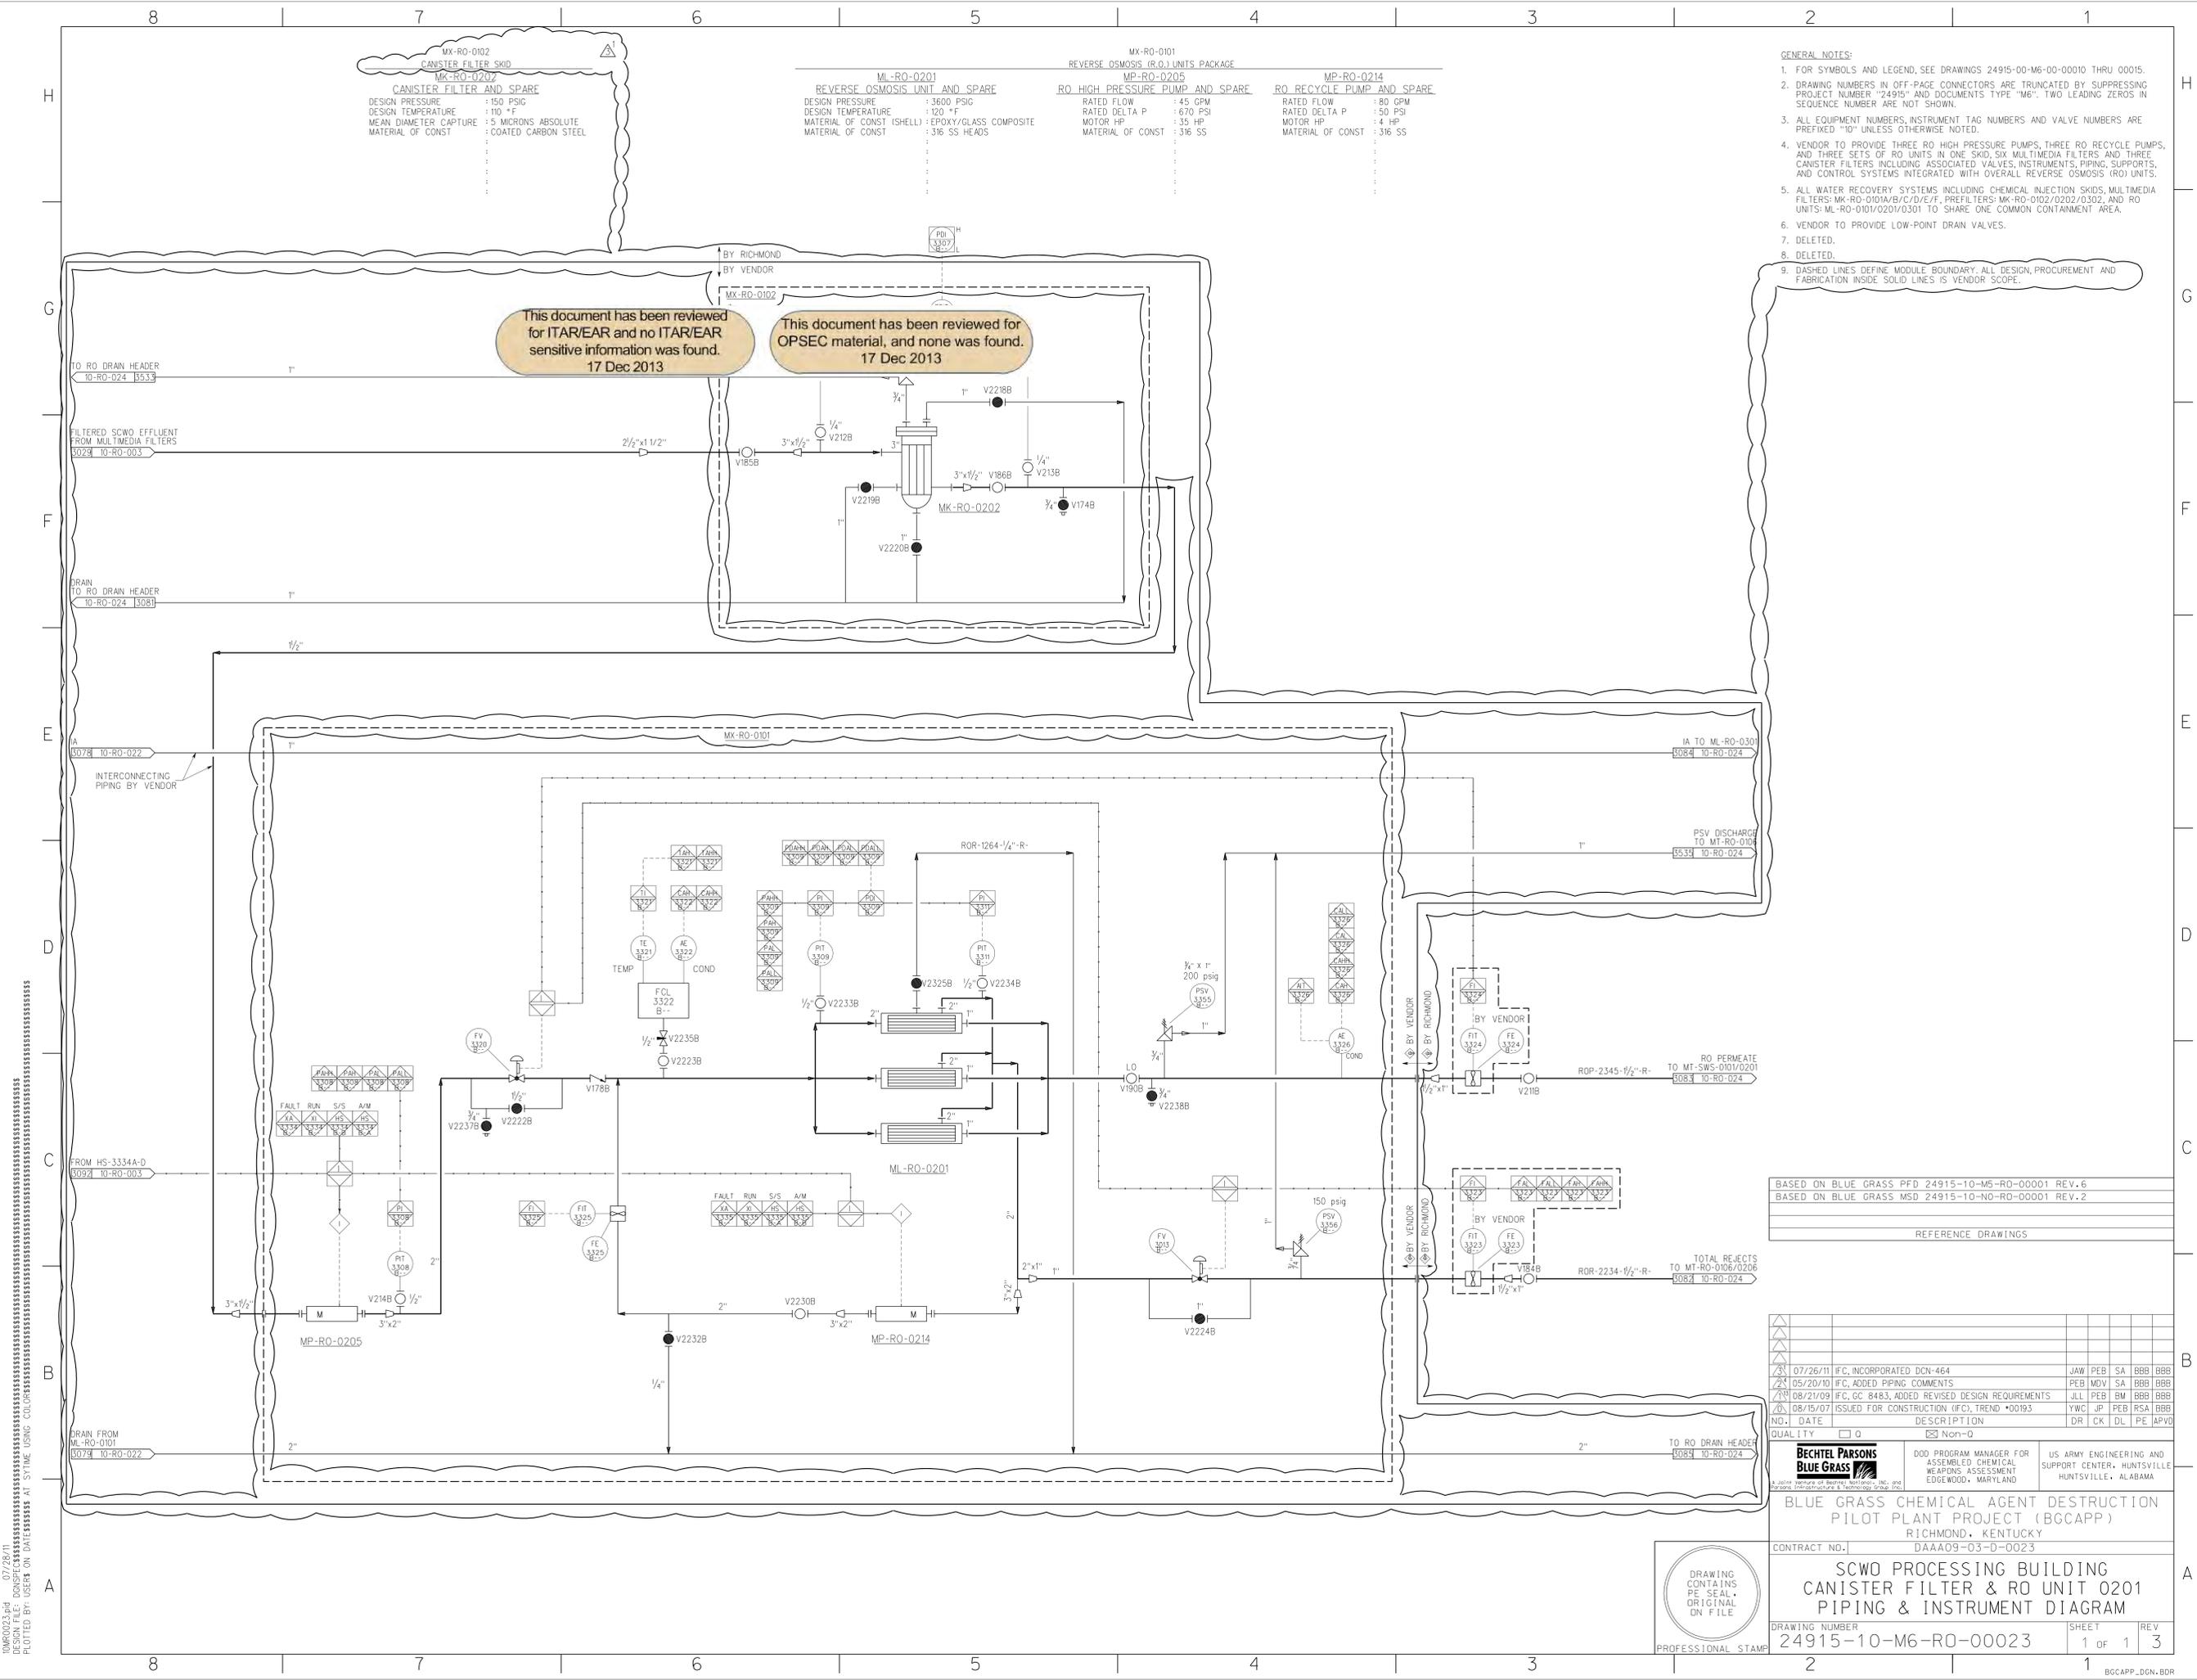

This document has been reviewed for ITAR/EAR and no ITAR/EAR sensitive information was found. 17 Dec 2013

This document has been reviewed for OPSEC material, and none was found. 17 Dec 2013

- GENERAL NOTES:
- FOR SYMBOLS AND LEGEND, SEE DRAWINGS 24915-00-M6-00-00010 THRU 00015.
 - DRAWING NUMBERS IN OFF-PAGE CONNECTORS ARE TRUNCATED BY SUPPRESSING PROJECT NUMBER "24915" AND DOCUMENTS TYPE "M6". TWO LEADING ZEROS IN SEQUENCE NUMBER ARE NOT SHOWN.
 - ALL EQUIPMENT NUMBERS, INSTRUMENT TAG NUMBERS AND VALVE NUMBERS ARE PREFIXED "10" UNLESS OTHERWISE NOTED.
 - VENDOR TO PROVIDE THREE RO HIGH PRESSURE PUMPS, THREE RO RECYCLE PUMPS, AND THREE SETS OF RO UNITS IN ONE SKID, SIX MULTIMEDIA FILTERS AND THREE CANISTER FILTERS INCLUDING ASSOCIATED VALVES, INSTRUMENTS, PIPING, SUPPORTS, AND CONTROL SYSTEMS INTEGRATED WITH OVERALL REVERSE OSMOSIS (RO) UNITS.
 - ALL WATER RECOVERY SYSTEMS INCLUDING CHEMICAL INJECTION SKIDS, MULTIMEDIA FILTERS: MK-RO-0101A/B/C/D/E/F, PREFILTERS: MK-RO-0102/0202/0302, AND RO UNITS: ML-RO-0101/0201/0301 TO SHARE ONE COMMON CONTAINMENT AREA.
 - VENDOR TO PROVIDE LOW-POINT DRAIN VALVES.
 - DELETED.
 - DELETED.
 - DASHED LINES DEFINE MODULE BOUNDARY. ALL DESIGN, PROCUREMENT AND FABRICATION INSIDE SOLID LINES IS VENDOR SCOPE.

BASED ON BLUE GRASS PFD 24915-10-M6-RO-00001 REV. 6
 BASED ON BLUE GRASS MSD 24915-10-M6-RO-00001 REV. 2

REFERENCE DRAWINGS

NO.	DATE	DESCRIPTION	DR	CK	DL	PE	APVD
3	07/26/11	I/C, INCORPORATED DCN-464	JAW	PEB	SA	BBB	BBB
2	05/20/10	I/C, ADDED PIPING COMMENTS	PEB	MDV	SA	BBB	BBB
1	08/21/09	I/C, GC 8483, ADDED REVISED DESIGN REQUIREMENTS	JLL	PEB	BM	BBB	BBB
0	08/15/07	ISSUED FOR CONSTRUCTION (I/C), TREND *00193	YWC	JP	PEB	RSA	BBB

BECHTEL PARSONS
 BLUE GRASS
 DOD PROGRAM MANAGER FOR ASSEMBLED CHEMICAL WEAPONS ASSESSMENT EDGEWOOD, MARYLAND
 US ARMY ENGINEERING AND SUPPORT CENTER, HUNTSVILLE HUNTSVILLE, ALABAMA


BLUE GRASS CHEMICAL AGENT DESTRUCTION PILOT PLANT PROJECT (BCAPP)
 RICHMOND, KENTUCKY
 DAAA09-03-D-0023

SCWO PROCESSING BUILDING
 CANISTER FILTER & RO UNIT 0201
 PIPING & INSTRUMENT DIAGRAM

DRAWING NUMBER: 24915-10-M6-RO-00023
 SHEET: 1 OF 1
 REV: 3



10M60023.pid 07/28/11
 DESIGN FILE: DONSPEC
 PLOTTED BY USER ON DATE: 7/28/2011 9:41:08 AM

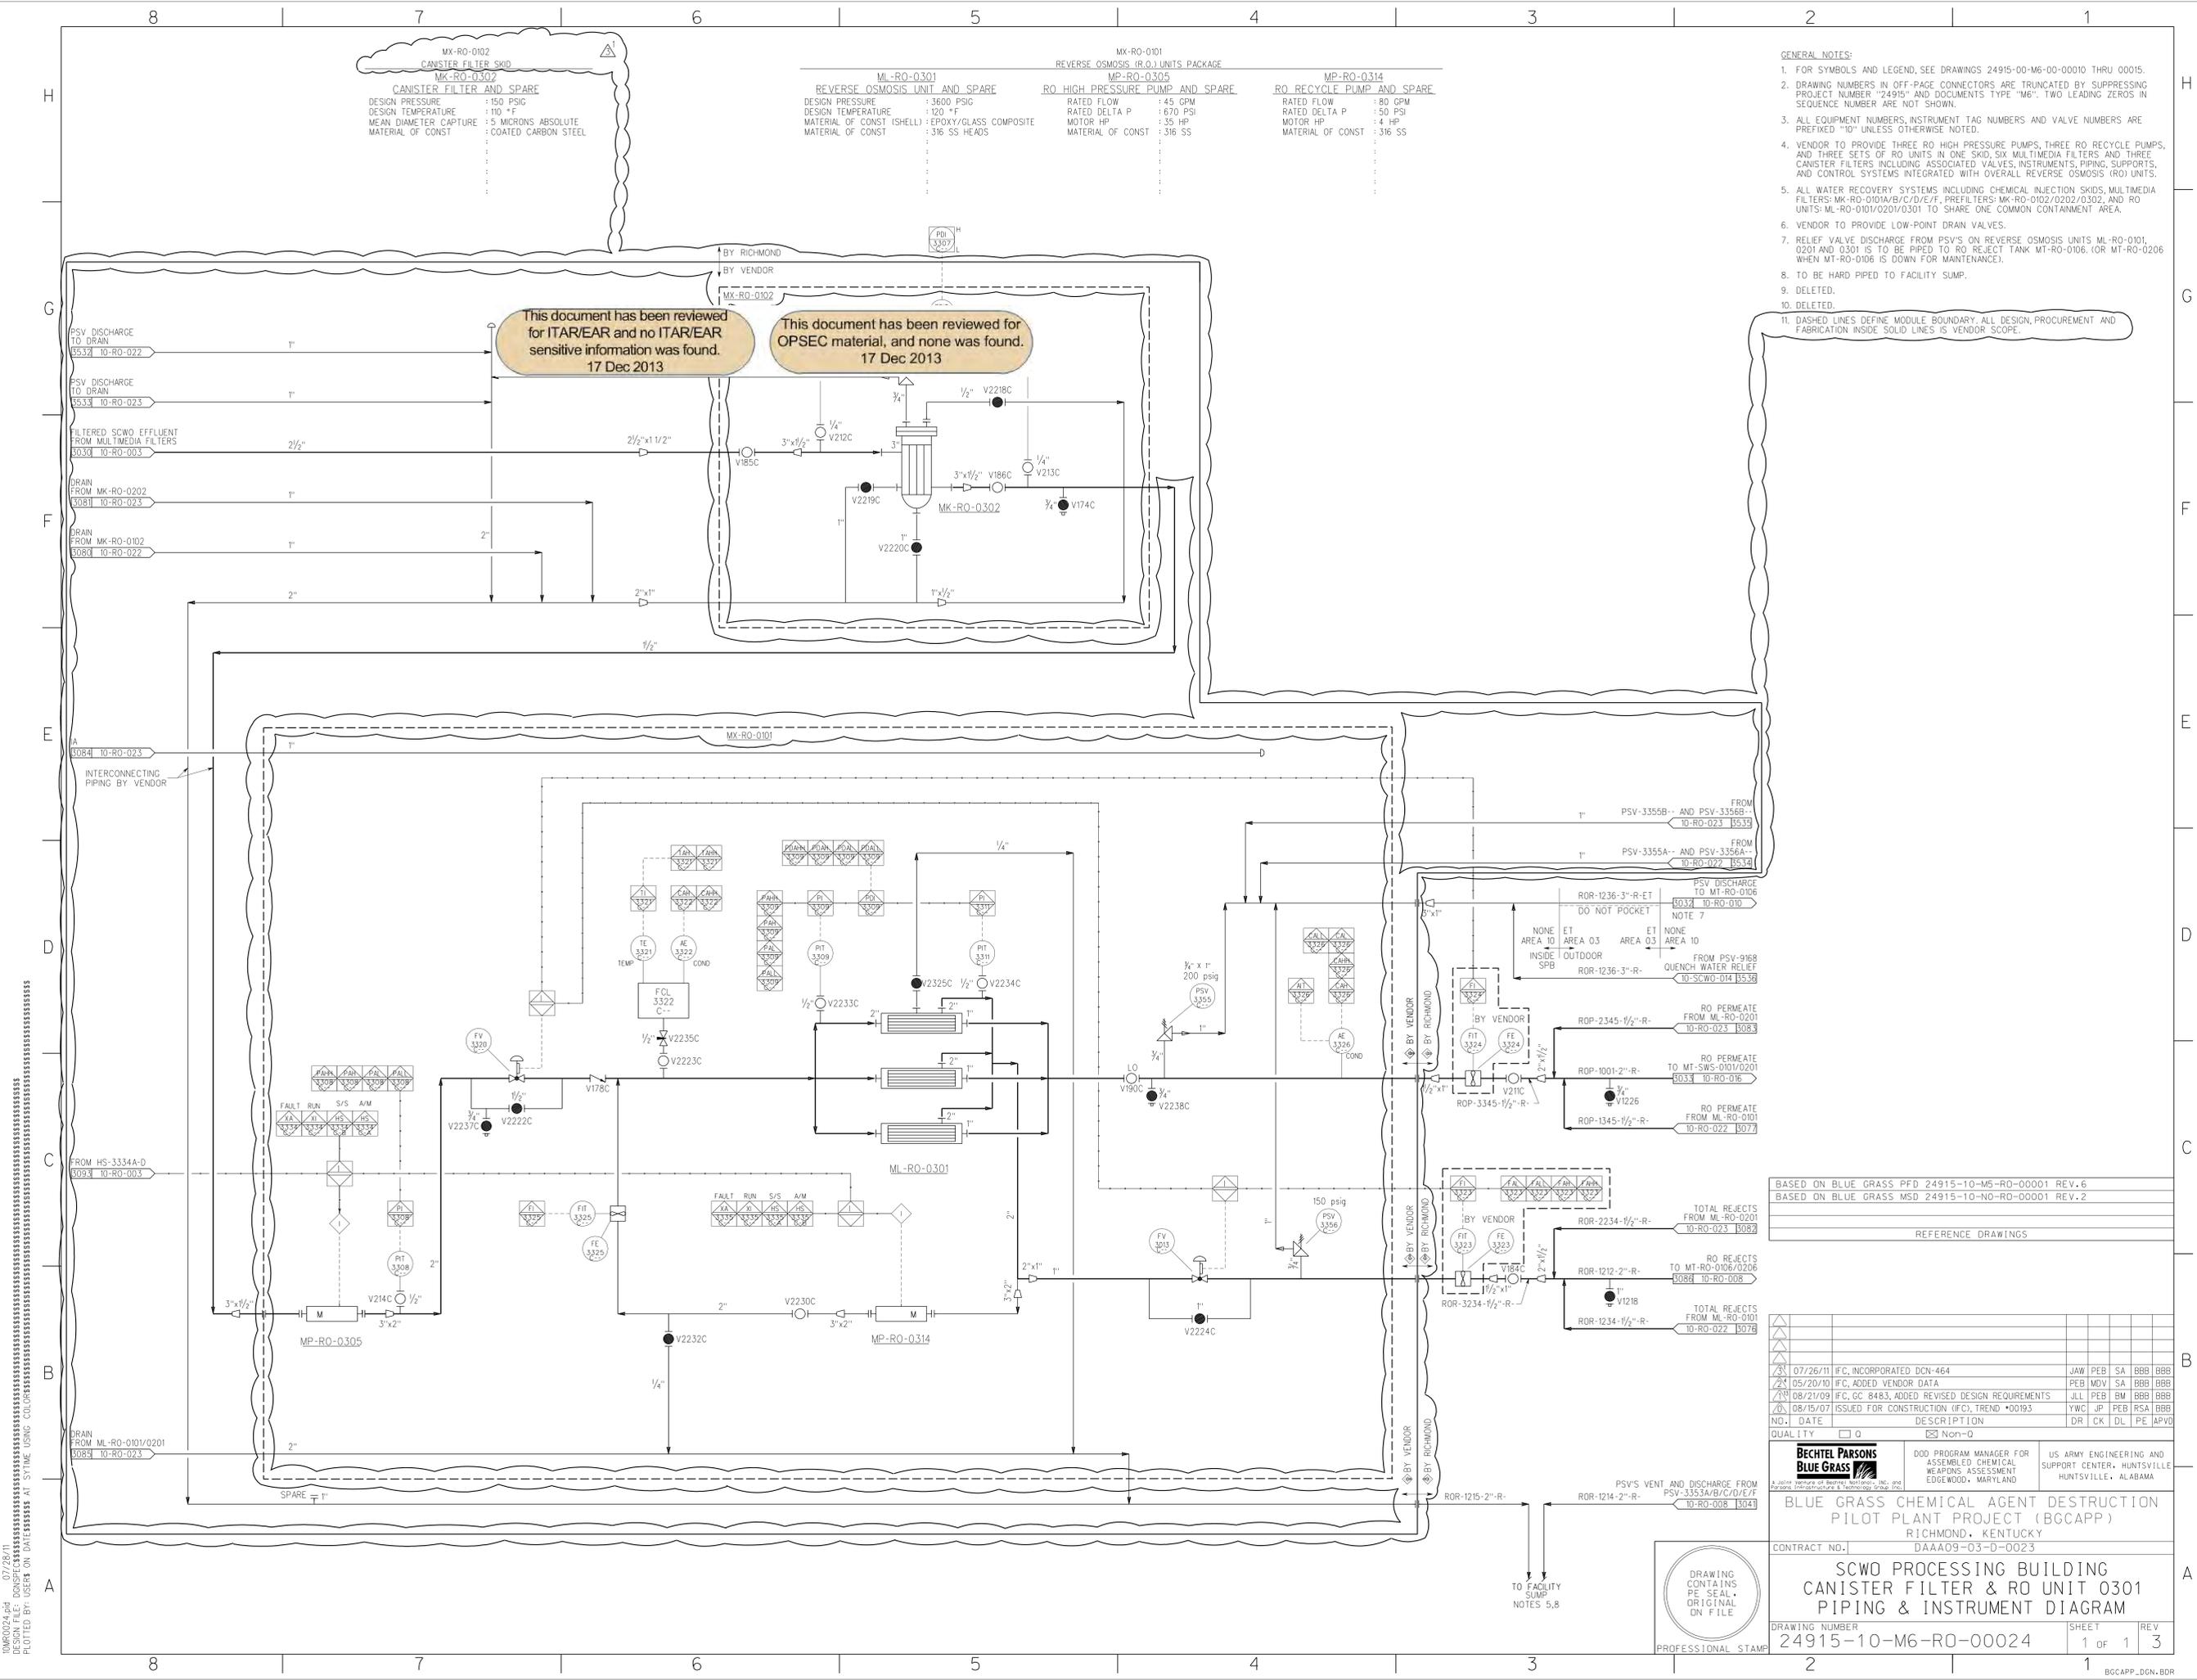

**MX-RO-002
CANISTER FILTER SKID
MK-RO-0302**
CANISTER FILTER AND SPARE
DESIGN PRESSURE : 150 PSIG
DESIGN TEMPERATURE : 110 °F
MEAN DIAMETER CAPTURE : 5 MICRONS ABSOLUTE
MATERIAL OF CONST : COATED CARBON STEEL

**ML-RO-0301
REVERSE OSMOSIS UNIT AND SPARE**
DESIGN PRESSURE : 3600 PSIG
DESIGN TEMPERATURE : 120 °F
MATERIAL OF CONST (SHELL) : EPOXY/GLASS COMPOSITE
MATERIAL OF CONST : 316 SS HEADS

**MX-RO-001
REVERSE OSMOSIS (R.O.) UNITS PACKAGE
MP-RO-0305**
RO HIGH PRESSURE PUMP AND SPARE
RATED FLOW : 45 GPM
RATED DELTA P : 670 PSI
MOTOR HP : 35 HP
MATERIAL OF CONST : 316 SS

**MP-RO-0314
RO RECYCLE PUMP AND SPARE**
RATED FLOW : 80 GPM
RATED DELTA P : 50 PSI
MOTOR HP : 4 HP
MATERIAL OF CONST : 316 SS

- GENERAL NOTES:**
- FOR SYMBOLS AND LEGEND, SEE DRAWINGS 24915-00-M6-00-00010 THRU 00015.
 - DRAWING NUMBERS IN OFF-PAGE CONNECTORS ARE TRUNCATED BY SUPPRESSING PROJECT NUMBER "24915" AND DOCUMENTS TYPE "M6". TWO LEADING ZEROS IN SEQUENCE NUMBER ARE NOT SHOWN.
 - ALL EQUIPMENT NUMBERS, INSTRUMENT TAG NUMBERS AND VALVE NUMBERS ARE PREFIXED "10" UNLESS OTHERWISE NOTED.
 - VENDOR TO PROVIDE THREE RO HIGH PRESSURE PUMPS, THREE RO RECYCLE PUMPS, AND THREE SETS OF RO UNITS IN ONE SKID, SIX MULTIMEDIA FILTERS AND THREE CANISTER FILTERS INCLUDING ASSOCIATED VALVES, INSTRUMENTS, PIPING, SUPPORTS, AND CONTROL SYSTEMS INTEGRATED WITH OVERALL REVERSE OSMOSIS (RO) UNITS.
 - ALL WATER RECOVERY SYSTEMS INCLUDING CHEMICAL INJECTION SKIDS, MULTIMEDIA FILTERS: MK-RO-0101A/B/C/D/E/F, PREFILTERS: MK-RO-0102/0202/0302, AND RO UNITS: ML-RO-0101/0201/0301 TO SHARE ONE COMMON CONTAINMENT AREA.
 - VENDOR TO PROVIDE LOW-POINT DRAIN VALVES.
 - RELIEF VALVE DISCHARGE FROM PSV'S ON REVERSE OSMOSIS UNITS ML-RO-0101, 0201 AND 0301 IS TO BE PIPED TO RO REJECT TANK MT-RO-0106. (OR MT-RO-0206 WHEN MT-RO-0106 IS DOWN FOR MAINTENANCE).
 - TO BE HARD PIPED TO FACILITY SUMP.
 - DELETED.
 - DELETED.
 - DASHED LINES DEFINE MODULE BOUNDARY. ALL DESIGN, PROCUREMENT AND FABRICATION INSIDE SOLID LINES IS VENDOR SCOPE.

This document has been reviewed for ITAR/EAR and no ITAR/EAR sensitive information was found. 17 Dec 2013

This document has been reviewed for OPSEC material, and none was found. 17 Dec 2013

BASED ON BLUE GRASS PFD 24915-10-M6-RO-00001 REV. 6
BASED ON BLUE GRASS MSD 24915-10-NO-RO-00001 REV. 2

REFERENCE DRAWINGS

NO.	DATE	DESCRIPTION	DR	CK	DL	PE	APVD
3	07/26/11	I/C, INCORPORATED DCN-464	JAW	PEB	SA	BBB	BBB
2	05/20/10	I/C, ADDED VENDOR DATA	PEB	MDV	SA	BBB	BBB
1	08/21/09	I/C, GC 8483, ADDED REVISED DESIGN REQUIREMENTS	JLL	PEB	BM	BBB	BBB
0	08/15/07	ISSUED FOR CONSTRUCTION (I/C), TREND *00193	YWC	JP	PEB	RSA	BBB

BECHTEL PARSONS BLUE GRASS
A joint venture of Bechtel Technology, Inc. and Parsons Infrastructure & Technology Group, Inc.
DOD PROGRAM MANAGER FOR ASSEMBLED CHEMICAL WEAPONS ASSESSMENT EDWOOD, MARYLAND
US ARMY ENGINEERING AND SUPPORT CENTER, HUNTSVILLE, ALABAMA

BLUE GRASS CHEMICAL AGENT DESTRUCTION PILOT PLANT PROJECT (BCAPP)
RICHMOND, KENTUCKY
DAAA09-03-D-0023

SCWO PROCESSING BUILDING CANISTER FILTER & RO UNIT 0301 PIPING & INSTRUMENT DIAGRAM

CONTRACT NO. | DRAWING NUMBER | SHEET | REV
24915-10-M6-RO-00024 | 1 OF 1 | 3



10M60024.ppt 07/28/11 DESIGN FILE: DONSPEC... PLOTTED BY USER ON DATE... AT SYTIME USING COLOR...


MX-SCWO-002
SCWO SOLIDS FEED ADDITIVE MODULE

- MH-SCWO-0001 FEED ADDITIVE WEIGH HOPPER
WORKING VOLUME : 7 CU FT
DIAMETER : 36 IN
HEIGHT : 34 IN
MATERIAL OF CONST : 316/316L
- MD-SCWO-0001 SLIDE GATE VALVE
RATED FLOW : 900 LB/HR
DIAMETER : 6 IN
MATERIAL OF CONST : 316/316L
- MF-SCWO-0012 FLOOR HOPPER AGITATOR
MOTOR HP : 0.5 HP
MATERIAL OF CONST : 316
- MH-SCWO-0002 FEED ADDITIVE SCREW CONVEYOR NO.1
MOTOR HP : 3 HP
LENGTH : 25 FT
RATED FLOW : 900 LB/HR
MATERIAL OF CONST : 316/316L
- MD-SCWO-0002 SLIDE GATE VALVE
RATED FLOW : 900 LB/HR
DIAMETER : 6 IN
MATERIAL OF CONST : 316/316L
- MF-SCWO-0013 FLOOR HOPPER VIBRATOR
PNEUMATIC
MATERIAL OF CONST : MANUF. STD
- MH-SCWO-0003 FEED ADDITIVE SCREW CONVEYOR NO.2
MOTOR HP : 3 HP
LENGTH : 20 FT
RATED FLOW : 900 LB/HR
MATERIAL OF CONST : 316/316L
- MD-SCWO-0003 FEED ADDITIVE DIVERTER VALVE
RATED FLOW : 900 LB/HR
DIAMETER : 6 IN ROUND
MATERIAL OF CONST : 316/316L
- MF-SCWO-0014 WEIGH HOPPER AGITATOR
MOTOR HP : 0.25 HP
MATERIAL OF CONST : 316
- MH-SCWO-0004 BULK BAG UNLOADER
CAPACITY : 2000 LBS BAG
LENGTH (BASE) : 60 IN
WIDTH / DIMENSION : 60 IN
HEIGHT : 199 IN
MATERIAL OF CONST : MANUF. STD
- MD-SCWO-0004 AIR LOCK ROTARY VALVE
RATED FLOW : 900 LB/HR
MOTOR HP : 0.5 HP
DIAMETER : 6 IN
MATERIAL OF CONST : 316/316L
- MH-SCWO-0012 BULK BAG HOIST/TROLLEY
MOTOR HP : 2.5/0.5 HP
MATERIAL OF CONST : MANUF. STD
CAPACITY : 2000 LB
- MH-SCWO-0005 AUTOMATED BULK BAG ADAPTER DISPENSER
CAPACITY : 5.5 CU FT
LENGTH : 30 IN
WIDTH : 30 IN
HEIGHT : 42 IN
MATERIAL OF CONST : 316/316L
- MD-SCWO-0006 SLIDE GATE VALVE
RATED FLOW : 900 LB/HR
DIAMETER : 6 IN
MATERIAL OF CONST : 316/316L
- MH-SCWO-0002 MH-SCWO-0003
- MF-SCWO-0015 WEIGH HOPPER VIBRATOR
PNEUMATIC
MATERIAL OF CONST : MANUF. STD

- GENERAL NOTES:
- FOR SYMBOLS AND LEGEND, SEE DRAWINGS
24915-00-M6-00-00010
24915-00-M6-00-00011
24915-00-M6-00-00012
24915-00-M6-00-00013
24915-00-M6-00-00014
24915-00-M6-00-00015
 - HARD CONNECTION DUCT TO TOP OF ASSOCIATED BLEND TANK.
 - PROGRAM AN INTERLOCK BETWEEN MD-SCWO-0001 AND MD-SCWO-0002 TO ENSURE THAT BOTH VALVES ARE NOT OPEN AT THE SAME TIME.
 - * DENOTES VENDOR SUPPLIED.
 - ELECTRICAL AREA CLASSIFICATION: UNCLASSIFIED (PER DIRECTION FROM GOVERNMENT 5/4/06 CORRESPONDENCE)
 - ALL CONNECTIONS TO WEIGH HOPPER INCLUDING INSTRUMENT AIR LINE TO WEIGH HOPPER BIN DISCHARGER) TO BE FLEXIBLE, WEIGH HOPPER TO BE OF CYLINDRICAL DESIGN WITH THREE LEGGED SUPPORT STRUCTURE.
 - VENDOR RESPONSIBLE FOR DUST CONTROL SYSTEM.
 - MH-SCWO-0005 TO INCLUDE VENDOR SUPPLIED DE-LUMING SCREEN, TO BE USED FOR SALT TRANSPORT ONLY (NOT REQUIRED FOR SULFUR TRANSPORT).
 - MH-SCWO-0004 TO INCLUDE SMALL CRANE FOR LIFTING BAG ONTO FRAME.
 - PROGRAM AN INTERLOCK TO OPEN MD-SCWO-0006 WHEN CONVEYOR MH-SCWO-0002 AND MH-SCWO-0003 ARE RUNNING, AND TO CLOSE MD-SCWO-0006 WHEN WOSH-9136 SIGNALS A HIGH OR COMPLETED WEIGHT LOAD AS WELL AS STOP CONVEYORS MH-SCWO-0002 AND MH-SCWO-0003.
 - SULFUR SUPERSACKS SHALL BE GROUNDED.
 - PROGRAM AN INTERLOCK TO ENSURE THAT ROTARY VALVE MD-SCWO-0004 CANNOT OPERATE UNLESS EITHER SLIDE GATE VALVE MD-SCWO-0001 OR -0002 IS OPEN.
 - CONVEYORS MH-SCWO-0002 AND MH-SCWO-0003 UTILIZE A ROUND WIRE SPIRAL CONFIGURATION FOR CONVEYING SOLID SULFUR DURING GB CAMPAIGN. SPIRAL MUST BE CHANGED TO A FLAT WIRE CONFIGURATION FOR CONVEYING SALT DURING VX AND H CAMPAIGNS.
 - FLOOR HOPPER AGITATOR MF-SCWO-0012, FLOOR HOPPER VIBRATOR MF-SCWO-0013, AND TRANSITION DISCHARGE ADAPTER VIBRATOR MF-SCWO-0016 ARE PROGRAMMED TO OPERATE DURING SALT TRANSPORT ONLY. THEY ARE NOT USED FOR SULFUR TRANSPORT.
 - NOTES 3, 4, 5, 8, 9, 10, 13, 14, 15, 20 AND 21 ARE DELETED.

This document has been reviewed for ITAR/EAR and no ITAR/EAR sensitive information was found. 17 Dec 2013

This document has been reviewed for OPSEC material, and none was found. 17 Dec 2013

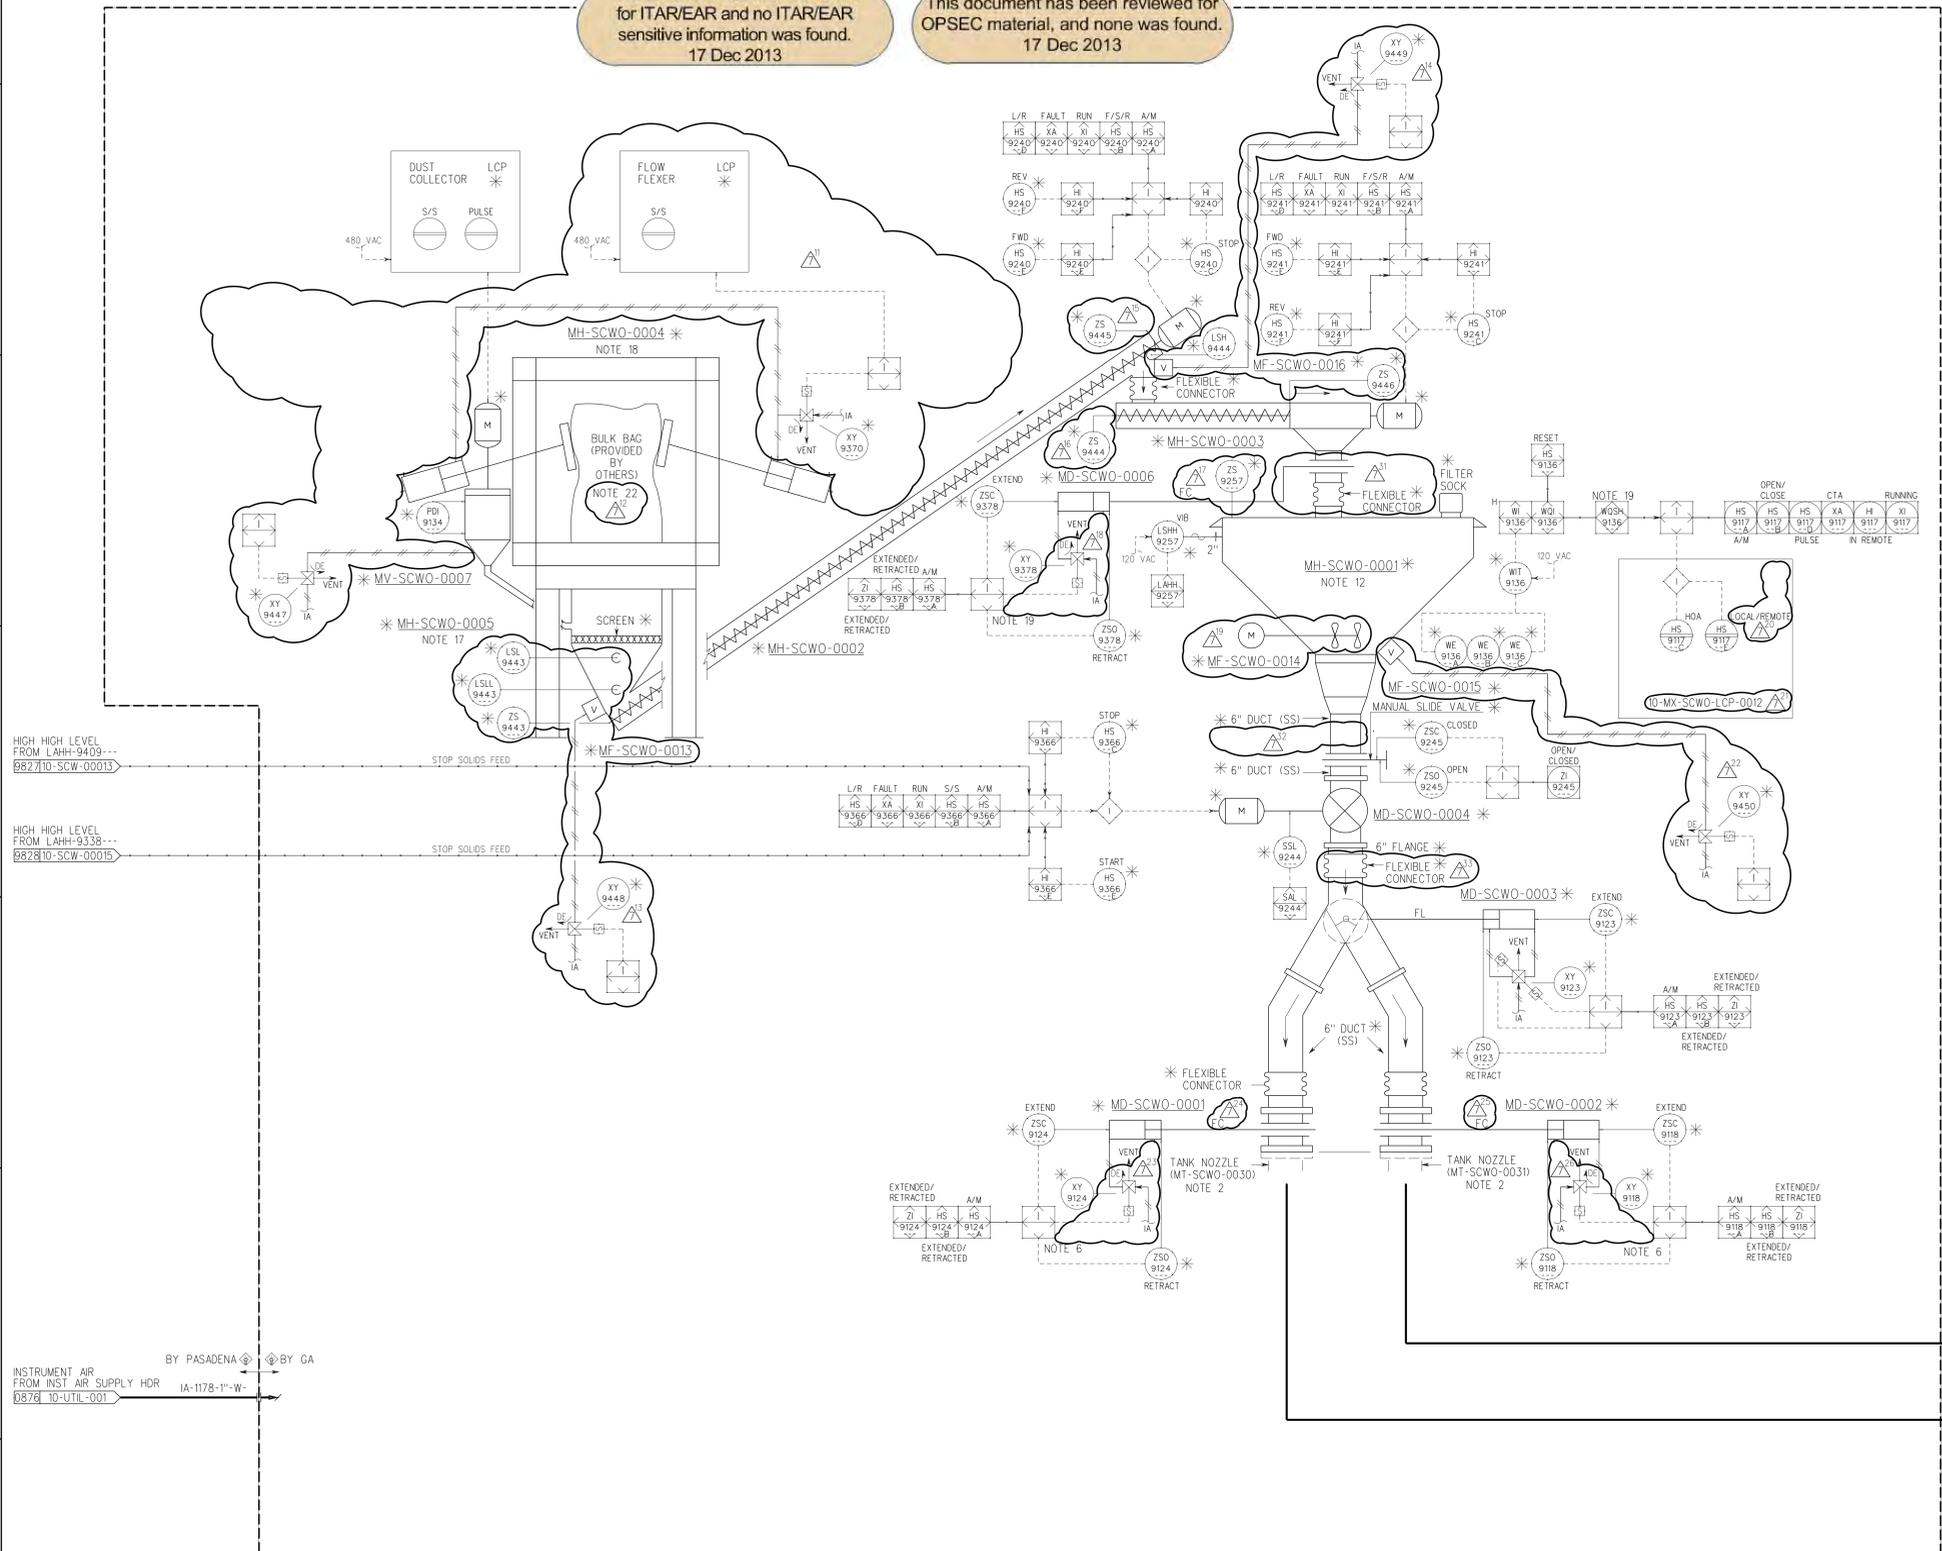


MX-SCWO-0034
SCWO FEED ADDITIVES MODULE
MP-SCWO-0034A/B
HCL SCWO FEED ADDITIVE METERING PUMP
RATED FLOW 1.5 GPM
RATED DELTA P 15 PSIG
MOTOR HP 0.5 HP
MATERIAL OF CONST HASTELLOY C

- GENERAL NOTES:
- FOR SYMBOLS AND LEGEND, SEE DRAWINGS
 - 24915-00-M6-00-00010
24915-00-M6-00-00011
24915-00-M6-00-00012
24915-00-M6-00-00013
24915-00-M6-00-00014
24915-00-M6-00-00015
 - NO POCKETS. NO RESTRICTIONS IN LINE.
 - TO BE HARD PIPED TO FACILITY SUMP.
 - PROGRAM AN INTERLOCK BETWEEN VALVES XV-9165--- AND XV-9166--- TO ENSURE THAT NO MORE THAN ONE VALVE IS OPEN AT ANY TIME.
 - PROGRAM AN INTERLOCK BETWEEN VALVES XV-9138---, XV-9157--- AND XV-9435--- TO ENSURE THAT NO MORE THAN ONE VALVE IS OPEN AT ANY TIME.
 - FQI-9189--- AND FQI-9306 TO BE PROGRAMMED TO AUTOMATICALLY RESET TO ZERO UPON INITIALIZING "ADDITIVE FEED".
 - ⊕ DENOTES DESIGN RESPONSIBILITY LABEL.
 - DESIGN SHALL INCLUDE WELDED PIPE (JOINTS) TO MAXIMUM EXTENT PRACTICAL. FLANGE SHIELDS AROUND FLANGED FITTINGS, AND DRIP-PROOF TRAYS BELOW FITTINGS AND OTHER POTENTIAL LEAK SOURCES. DESIGN TO INCLUDE SECONDARY CONTAINMENT TO CAPTURE FLANGE AND VALVE LEAKS.
 - COMMON INSTRUMENT AIR HEADER SERVICES COMPONENTS ON THIS PID AS WELL AS COMPONENTS ON PID 24915-10-M6-SCWO-00023.
 - OPERATIONS TO THROTTLE GLOBE VALVE V7091 TO OBTAIN THE REQUIRED FLOW TO MT-SCWO-0030 OR MT-SCWO-0031. FIT-9306 IS TO BE READABLE BY THE OPERATOR WHEN THROTTLING V7091. MANUAL VALVE LOCATED IN NAHM-1030-1"-AD TO BE USED TO ISOLATE MODULE FOR MAINTENANCE PURPOSES.
 - IF THE PUMP DISCHARGE PRESSURE FALLS BELOW LOW LOW PRESSURE FOR MORE THAN 1 SECOND WHILE THE "LEAD" PUMP IS RUNNING, THE "STANDBY" PUMP WILL AUTOMATICALLY START. ONCE THE "STANDBY" PUMP HAS STARTED AND IF PRESSURE RETURNS TO NORMAL WITHIN 10 SECONDS, THE "LEAD" PUMP WILL STOP. IF THE "STANDBY" PUMP DOES NOT REACH THE NORMAL SET POINT WITHIN ANOTHER 5 SECONDS, BOTH THE "LEAD" AND "STANDBY" PUMPS WILL STOP. IF THE "LEAD" PUMP BECOMES DE-ENERGIZED, THE "STANDBY" PUMP WILL AUTOMATICALLY START, WITHOUT WAITING FOR PRESSURE TO FALL BELOW NORMAL.
 - VERIFY THE STRAIGHT RUN BETWEEN REDUCERS CONFORMS TO FLOW METER MANUFACTURER'S REQUIREMENTS.
 - NOTES 3, 5, 6, 12, 14 AND 16 ARE DELETED.

This document has been reviewed for ITAR/EAR and no ITAR/EAR sensitive information was found. 17 Dec 2013

This document has been reviewed for OPSEC material, and none was found. 17 Dec 2013

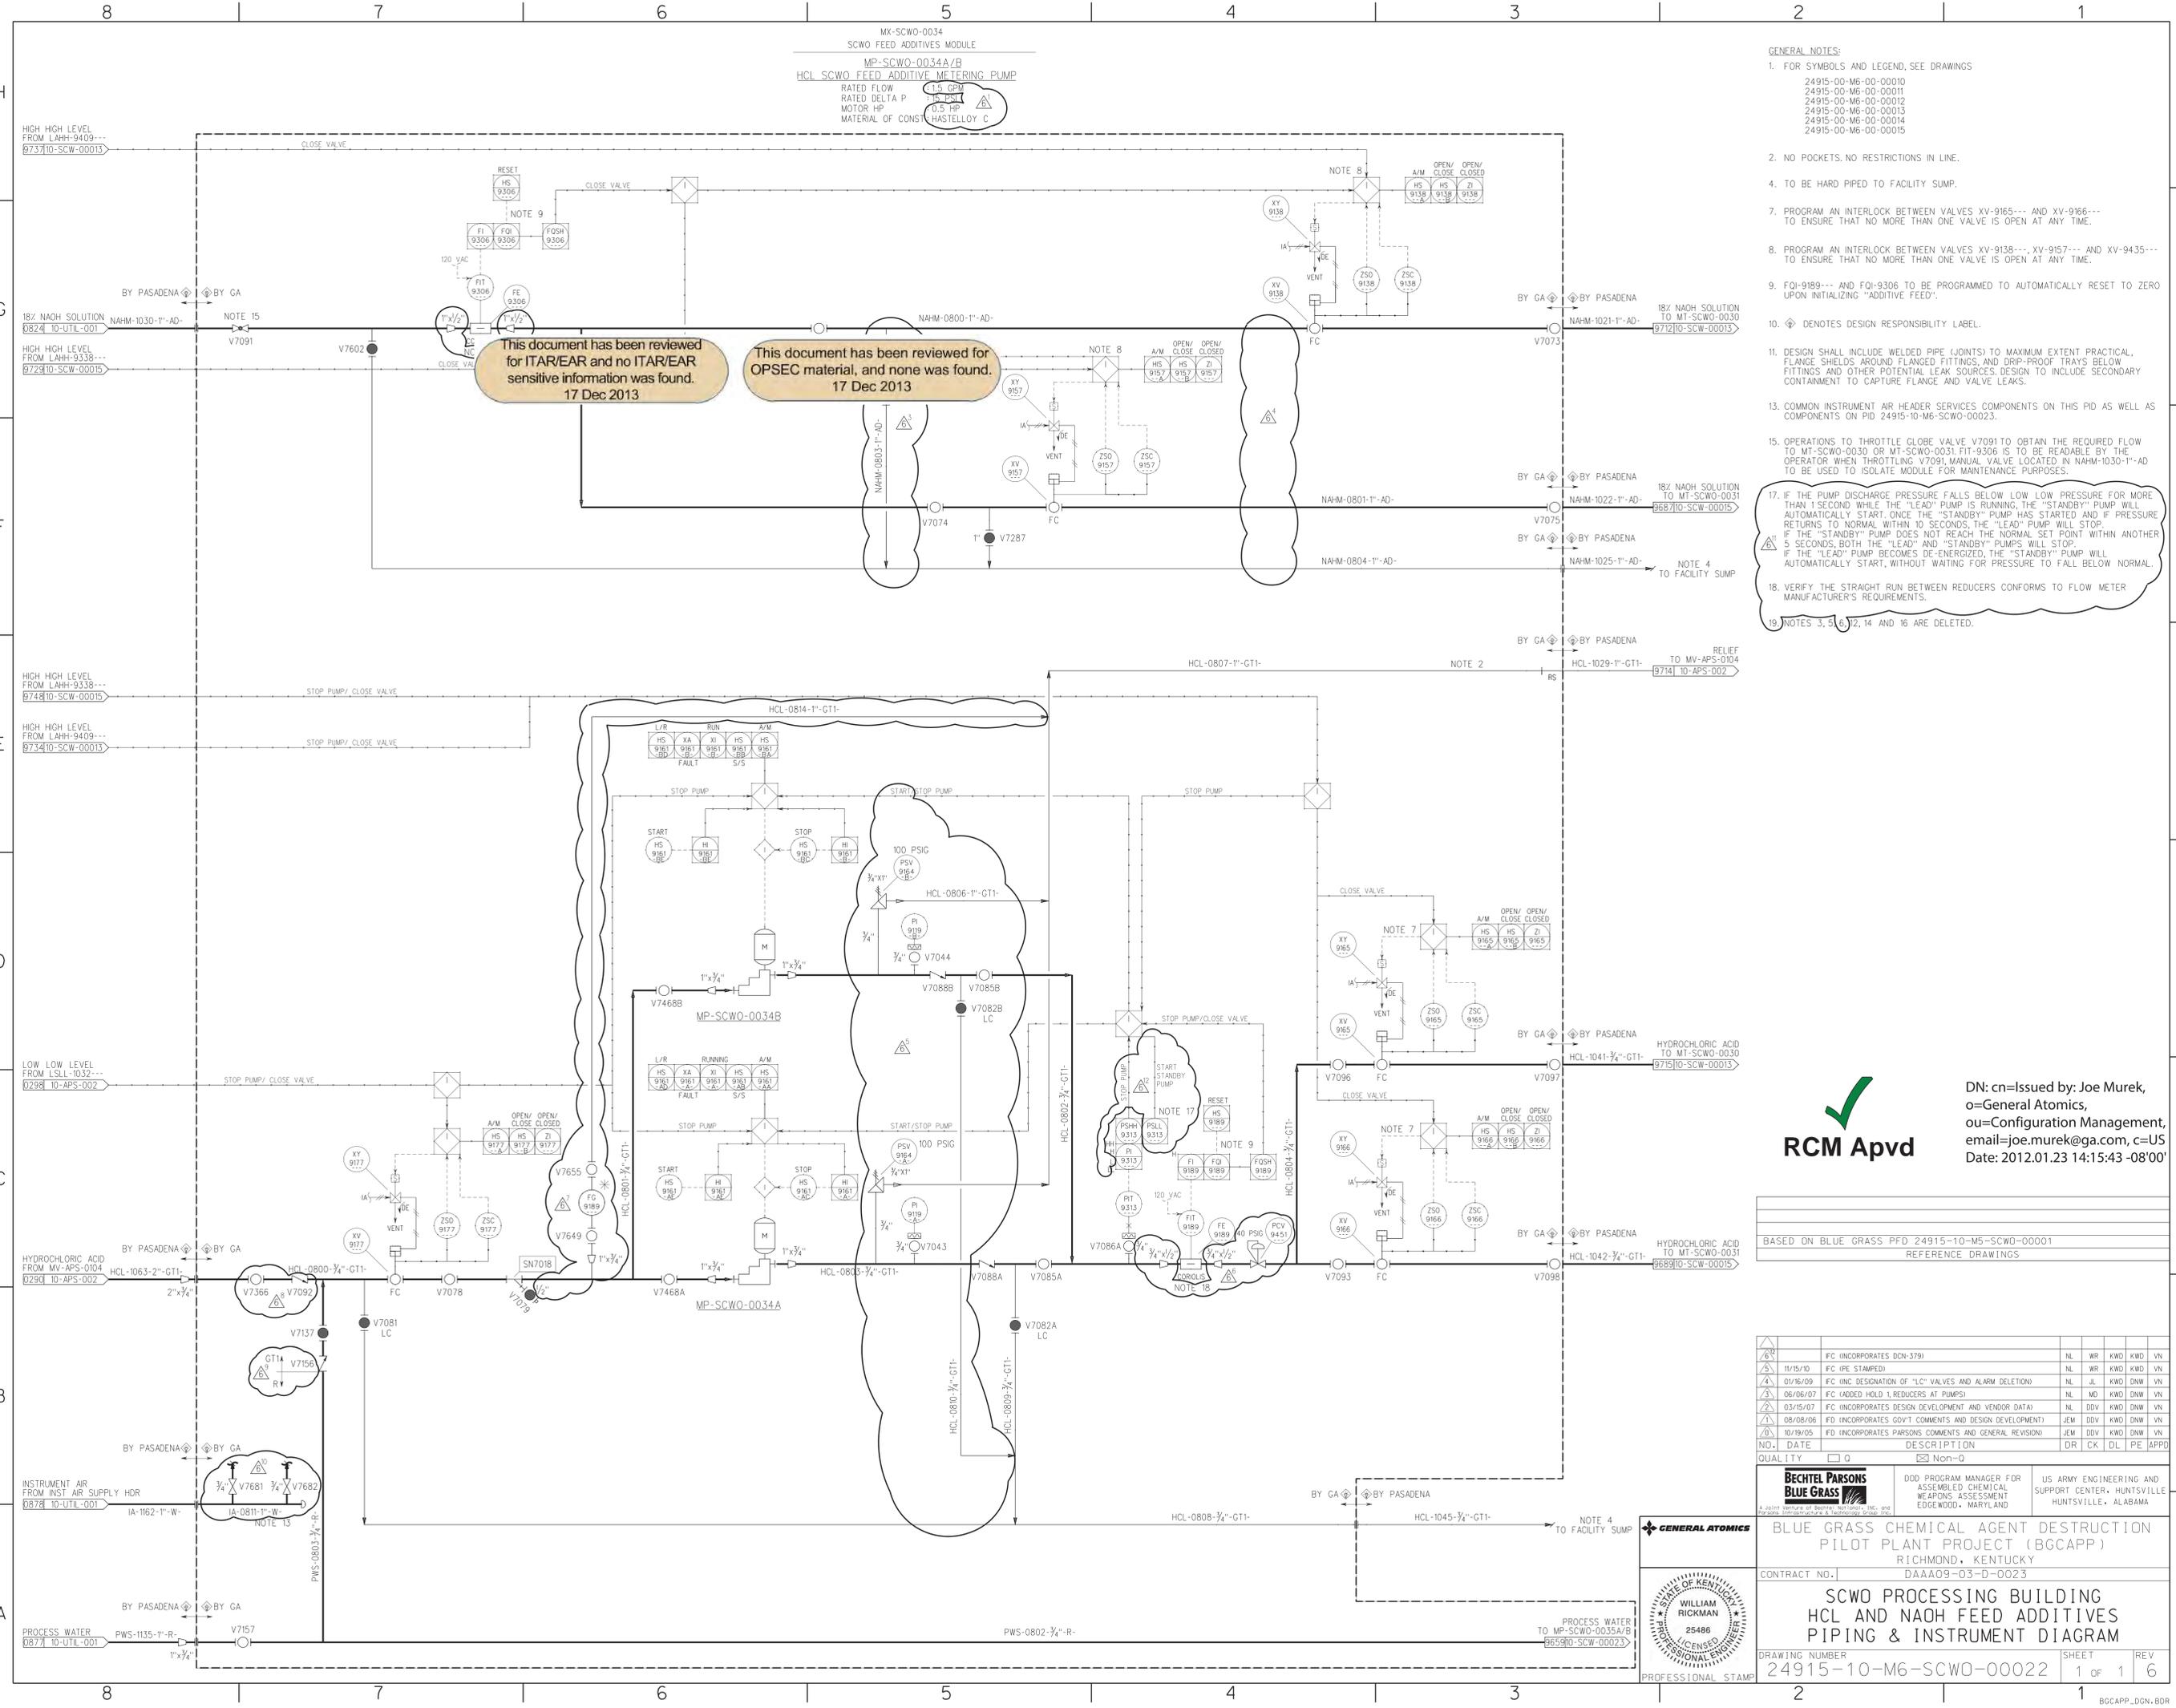

RCM Apvd

DN: cn=Issued by: Joe Murek,
o=General Atomics,
ou=Configuration Management,
email=joe.murek@ga.com, c=US
Date: 2012.01.23 14:15:43 -08'00'

BASED ON BLUE GRASS PFD 24915-10-M6-SCWO-00001
REFERENCE DRAWINGS

NO.	DATE	DESCRIPTION	DR	CK	DL	PE	APPD
6	11/15/10	FC (INCORPORATES DCN-379)	NL	WR	KWD	KWD	VN
5	11/15/10	FC (PE STAMPED)	NL	WR	KWD	KWD	VN
4	01/16/09	FC (INC DESIGNATION OF "LC" VALVES AND ALARM DELETION)	NL	JL	KWD	DNN	VN
3	06/06/07	FC (ADDED HOLD IN REDUCERS AT PUMPS)	NL	MD	KWD	DNN	VN
2	03/15/07	FC (INCORPORATES DESIGN DEVELOPMENT AND VENDOR DATA)	NL	DDV	KWD	DNN	VN
1	08/08/06	FD (INCORPORATES GOV'T COMMENTS AND DESIGN DEVELOPMENT)	JEM	DDV	KWD	DNN	VN
0	10/19/05	FD (INCORPORATES PARSONS COMMENTS AND GENERAL REVISIONS)	JEM	DDV	KWD	DNN	VN

QUALITY 0 Non-0

BECHTEL PARSONS BLUE GRASS

DOD PROGRAM MANAGER FOR ASSEMBLED CHEMICAL WEAPONS ASSESSMENT EDGEWOOD, MARYLAND

US ARMY ENGINEERING AND SUPPORT CENTER, HUNTSVILLE, ALABAMA

GENERAL ATOMICS

BLUE GRASS CHEMICAL AGENT DESTRUCTION PILOT PLANT PROJECT (BGCAPP)
RICHMOND, KENTUCKY
DAAA09-03-D-0023

SCWO PROCESSING BUILDING HCL AND NAOH FEED ADDITIVES PIPING & INSTRUMENT DIAGRAM

CONTRACT NO. DAAA09-03-D-0023

DRAWING NUMBER 24915-10-M6-SCWO-00022 SHEET 1 of 1 REV 6

PROFESSIONAL STAMP: WILLIAM RICKMAN, 25486, LICENSED PROFESSIONAL ENGINEER, STATE OF KENTUCKY


10MSCW00022.ppt 07/29/11

MX-SCWO-0034
 SCWO FEED ADDITIVES MODULE
 MP-SCWO-0035A/B
 H2SO4 SCWO FEED ADDITIVE METRING PUMP
 RATED FLOW 0.5 GPM
 RATED DELTA P 74 PSI
 MOTOR HP 0.5 HP
 MATERIAL OF CONST: UNS N08020 OR PVDF

- GENERAL NOTES:**
- FOR SYMBOLS AND LEGEND, SEE DRAWINGS
 24915-00-M6-00-00010
 24915-00-M6-00-00011
 24915-00-M6-00-00012
 24915-00-M6-00-00013
 24915-00-M6-00-00014
 24915-00-M6-00-00015
 - DO NOT POCKET. NO RESTRICTIONS IN LINE.
 - TO BE HARD PIPED TO FACILITY SUMP.
 - PROGRAM AN INTERLOCK FOR VALVES XV-9191---AND XV-9192--- TO ENSURE THAT NOT MORE THAN ONE VALVE IS OPEN AT ANY TIME.
 - DESIGN SHALL INCLUDE WELDED PIPE (JOINTS) TO MAXIMUM EXTENT PRACTICAL. FLANGE SHIELDS AROUND FLANGED FITTINGS, AND DRIP-PROOF TRAYS BELOW FITTINGS AND OTHER POTENTIAL LEAK SOURCES. DESIGN TO INCLUDE SECONDARY CONTAINMENT TO CAPTURE FLANGE AND VALVE LEAKS.
 - FQI-9178--- TO BE PROGRAMMED TO AUTOMATICALLY RESET TO ZERO UPON INITIALIZING "ADDITIVE FEED".
 - ◇ DENOTES DESIGN RESPONSIBILITY LABEL.
 - IF THE PUMP DISCHARGE PRESSURE FALLS BELOW LOW LOW PRESSURE FOR MORE THAN 1 SECOND WHILE THE "LEAD" PUMP IS RUNNING, THE "STANDBY" PUMP WILL AUTOMATICALLY START. ONCE THE "STANDBY" PUMP HAS STARTED AND IF PRESSURE RETURNS TO NORMAL WITHIN 10 SECONDS, THE "LEAD" PUMP WILL STOP. IF THE "STANDBY" PUMP DOES NOT REACH THE NORMAL SET POINT WITHIN ANOTHER 5 SECONDS, BOTH THE "LEAD" AND "STANDBY" PUMPS WILL STOP. IF THE "LEAD" PUMP BECOMES DE-ENERGIZED, THE "STANDBY" PUMP WILL AUTOMATICALLY START, WITHOUT WAITING FOR PRESSURE TO FALL BELOW NORMAL.
 - VERIFY THE STRAIGHT RUN BETWEEN REDUCERS CONFORMS TO FLOW METER MANUFACTURER'S REQUIREMENTS.
 - NOTES 3, 5, 6, 11, 12 AND 13 ARE DELETED.

This document has been reviewed for ITAR/EAR and no ITAR/EAR sensitive information was found. 17 Dec 2013

This document has been reviewed for OPSEC material, and none was found. 17 Dec 2013

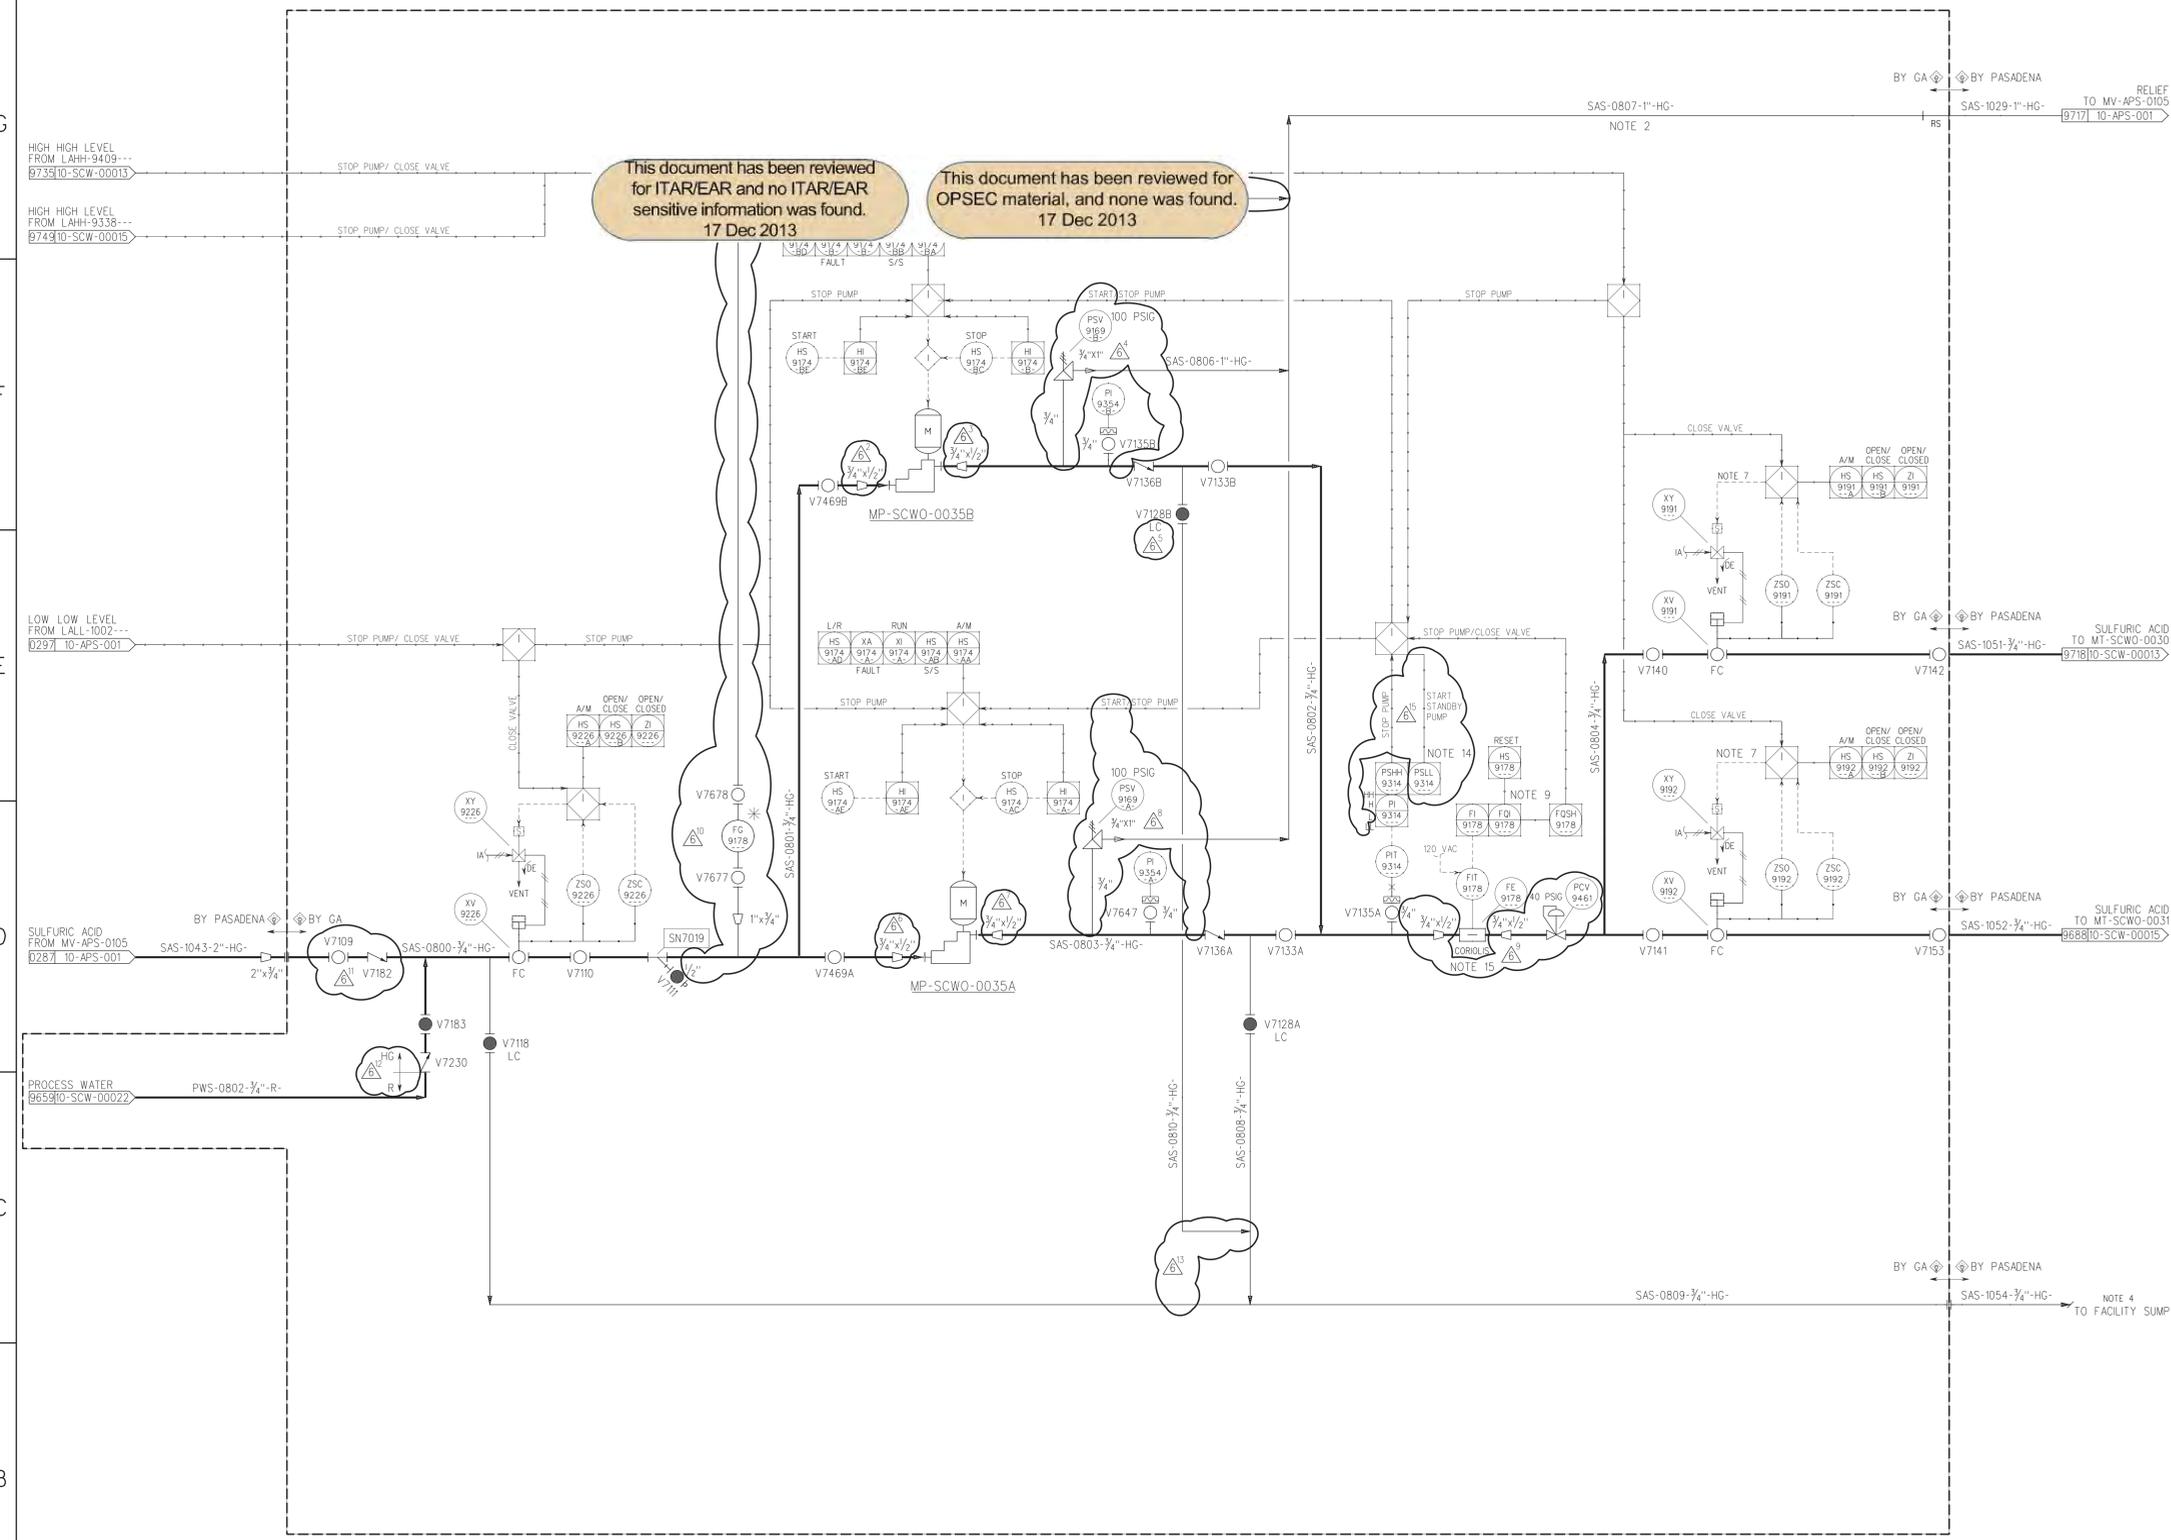

cn=ISSUED by Jordan Finkelstein, o=Records and Configuration Mgmt, ou=General Atomics, email=jordan.finkelstein@ga.com, c=US 2012.01.23 15:31:47 -08'00'

RCM Apvd

BASED ON BLUE GRASS PFD 24915-10-M5-SCWO-00001 REFERENCE DRAWINGS

NO.	DATE	DESCRIPTION	DR	CK	DL	PE	APPD
6/8		FC (INCORPORATES DCN-379)	NL	WR	KWD	KWD	VN
11/15/10		FC (IPE STAMPED)	NL	WR	KWD	KWD	VN
01/16/09		FC (INCORPORATES DESIGNATION OF "LC" VALVES)	NL	JL	KWD	DNW	VN
06/06/07		FC (ADDED HOLD L REDUCERS AT PUMPS)	NL	MD	KWD	DNW	VN
03/15/07		FC (INCORPORATES DESIGN DEVELOPMENT AND VENDOR DATA)	NL	DDV	KWD	DNW	VN
08/08/06		FD (INCORPORATES GOV'T COMMENTS AND DESIGN DEVELOPMENT)	JEM	DDV	KWD	DNW	VN
10/19/05		FD (INCORPORATES PARSONS COMMENTS AND GENERAL REVISIONS)	JEM	DDV	KWD	DNW	VN

QUALITY 0 Non-0

BECHTEL PARSONS BLUE GRASS
 A JOINT VENTURE OF BECHTEL CORPORATION, INC. and PARSONS BRINCKERHOFF & TERRY INC.

DD PROGRAM MANAGER FOR ASSEMBLED CHEMICAL WEAPONS ASSESSMENT EDGEWOOD, MARYLAND

US ARMY ENGINEERING AND SUPPORT CENTER, HUNTSVILLE HUNTSVILLE, ALABAMA

GENERAL ATOMICS
 BLUE GRASS CHEMICAL AGENT DESTRUCTION PILOT PLANT PROJECT (BGCAPP)
 RICHMOND, KENTUCKY
 CONTRACT NO. DAAA09-03-D-0023

SCWO PROCESSING BUILDING H2SO4 FEED ADDITIVES PIPING & INSTRUMENT DIAGRAM

DRAWING NUMBER 24915-10-M6-SCWO-00023 SHEET 1 of 1 REV 6

WILLIAM RICKMAN 25486 LICENSED PROFESSIONAL ENGINEER PROFESSIONAL STAMP

10MSCW00023.ppt 07/29/11


MX-SCWO-0021
 SCWO FLUSH WATER HEATER MODULE
 MS-SCWO-0020
 FLUSH WATER HEATER
 DUTY : 80 KW (RATING)
 DESIGN PRESSURE : 150 PSIG
 DESIGN TEMPERATURE : 160 °F
 MATERIAL OF CONST : MFR. STD.
 TRM : TRM-0817-0"-R-HC
 ASME CODE STAMPED VESSEL

GENERAL NOTES:

- FOR SYMBOLS AND LEGEND, SEE DRAWINGS
- 24915-00-M6-00-00010
24915-00-M6-00-00011
24915-00-M6-00-00012
24915-00-M6-00-00013
24915-00-M6-00-00014
24915-00-M6-00-00015
- FLUSH WATER HEATER SIZED TO SUPPORT TWO OPERATING SCWO TRAINS.
- * DENOTES VENDOR SUPPLIED.
- ◇ DENOTES DESIGN RESPONSIBILITY LABEL.
- ELECTRICAL AREA CLASSIFICATION: UNCLASSIFIED (PER DIRECTION FROM GOVERNMENT 5/4/06 CORRESPONDENCE)
- NOTES 2, 3, 6 AND 9 ARE DELETED. HOLD 1 HAS BEEN RESOLVED.

This document has been reviewed for ITAR/EAR and no ITAR/EAR sensitive information was found. 17 Dec 2013

This document has been reviewed for OPSEC material, and none was found. 17 Dec 2013

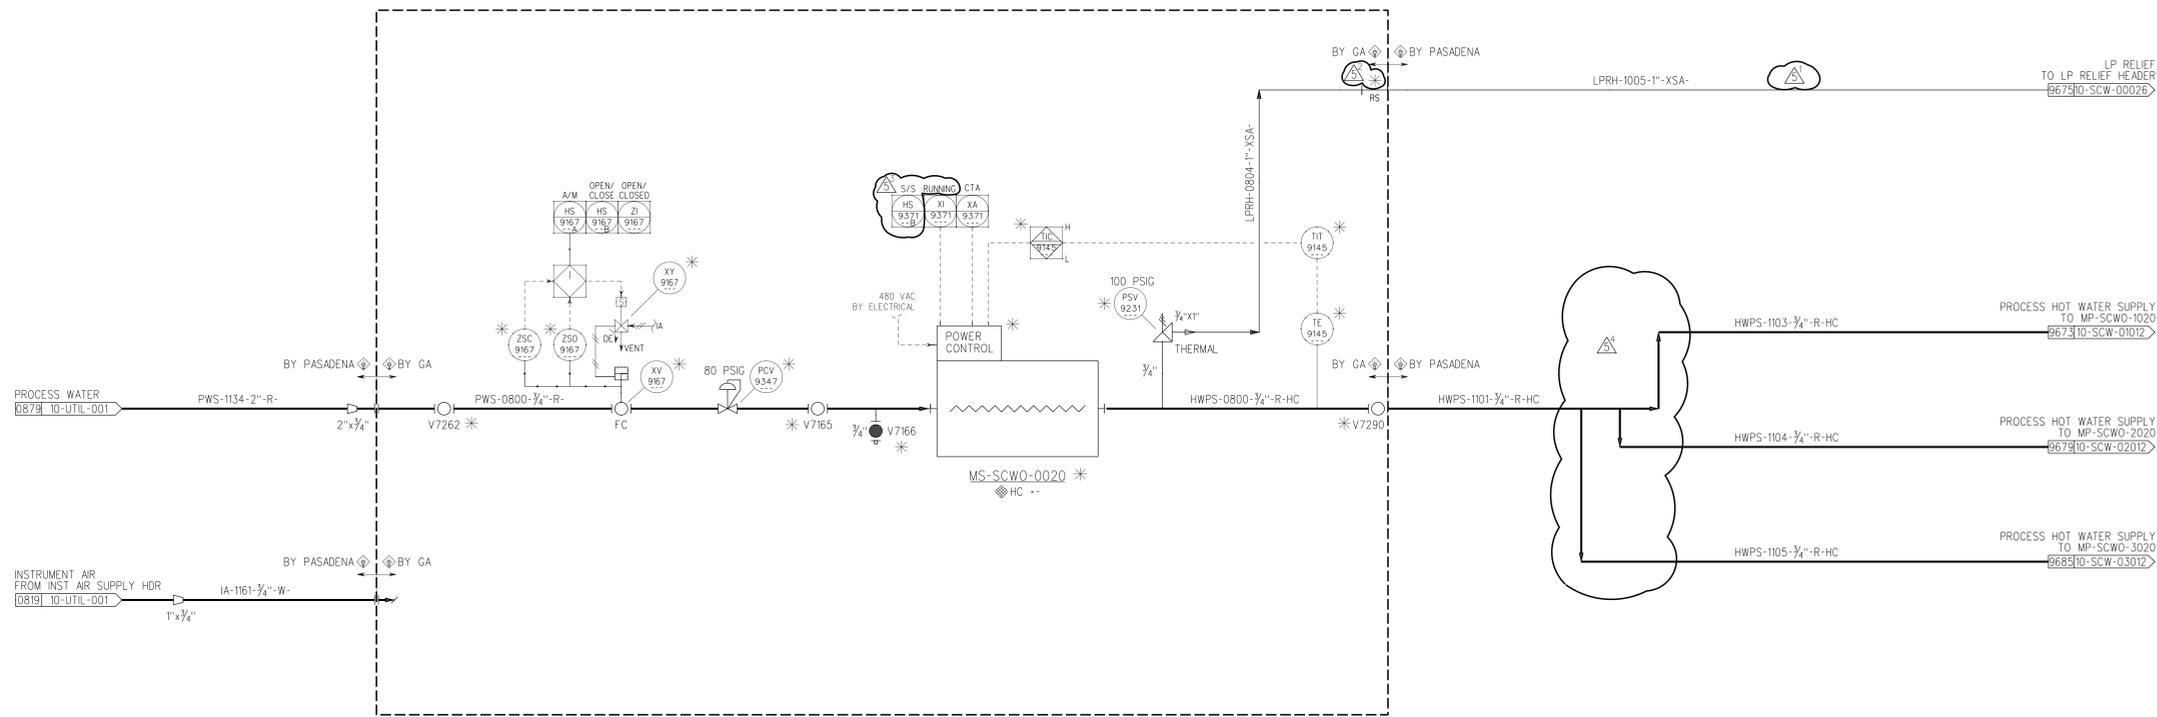

BASED ON BLUE GRASS PFD 24915-10M5-SCWO-00001
 REFERENCE DRAWINGS

RCM Apvd
 cn=Issued By Norbil Espiritu, o=General Atomics, ou=Configuration Management, email=Norbil.Espiritu@ga.com, c=US 2012.01.23 15:05:10 -08'00'

NO.	DATE	DESCRIPTION	DR	CK	DL	PE	APPD
1	10/19/05	FD (INCORPORATES PARSONS COMMENTS AND GENERAL REVISIONS)	JEM	DDV	KWD	DNN	VN
2	08/08/06	FD (INCORPORATES GOV'T COMMENTS AND DESIGN DEVELOPMENT)	JEM	DDV	KWD	DNN	VN
3	03/14/07	FC (INCORPORATES DESIGN DEVELOPMENT AND VENDOR DATA)	NL	DDV	KWD	DNN	VN
4	06/06/07	FC (REMOVED HOLD 1)	JEM	MD	KWD	DNN	VN
5	11/15/10	FC (PE STAMPED)	NL	WR	KWD	DNN	VN
6	11/15/10	FC (INC DGN-380)	NL	WR	KWD	DNN	VN

QUALITY 0 Non-0
 BECHTEL PARSONS BLUE GRASS
 DOD PROGRAM MANAGER FOR ASSEMBLED CHEMICAL WEAPONS ASSESSMENT EDGEWOOD, MARYLAND
 US ARMY ENGINEERING AND SUPPORT CENTER, HUNTSVILLE HUNTSVILLE, ALABAMA

GENERAL ATOMICS
 BLUE GRASS CHEMICAL AGENT DESTRUCTION PILOT PLANT PROJECT (BGCAPP)
 RICHMOND, KENTUCKY
 CONTRACT NO. DAAA09-03-D-0023
SCWO PROCESSING BUILDING FLUSH WATER HEATER PIPING & INSTRUMENT DIAGRAM
 DRAWING NUMBER 24915-10-M6-SCWO-00024 SHEET 1 of 1 REV 5
 WILLIAM RICKMAN 25486 LICENSED PROFESSIONAL ENGINEER


10MSCWO0024.ppt 01/07/12

ME-SCWO-0004
 GAS EFFLUENT DUCT HEATER
 DUTY: 20 KW
 DESIGN PRESSURE: 30 PSIG
 DESIGN TEMPERATURE: 190 °F
 MATERIAL OF CONST: 316/316L WELDED PARTS

This document has been reviewed for ITAR/EAR and no ITAR/EAR sensitive information was found. 17 Dec 2013

This document has been reviewed for OPSEC material, and none was found. 17 Dec 2013

- GENERAL NOTES:
- FOR SYMBOLS AND LEGEND, SEE DRAWINGS
 24915-00-M6-00-00010
 24915-00-M6-00-00011
 24915-00-M6-00-00012
 24915-00-M6-00-00013
 24915-00-M6-00-00014
 24915-00-M6-00-00015
 - VENT LINE FINAL POINT OF CONNECTION TO SPB HVAC SYSTEM NOT TO BE HARD PIPED.
 - DUCT HEATER DIMENSIONS DEPENDENT UPON FINAL VENDOR SELECTION.
 - GA TO SUPPLY DUCT HEATER WITH INSTRUMENTATION AND PIT-9242-... PASADENA TO INSTALL THESE ITEMS AS WELL AS SUPPLY AND INSTALL INSULATION SUPPORTS AND ASSOCIATED PIPING.
 - HEATER VENDOR RECOMMENDS MECHANICALLY STRENGTHENING CONNECTING PIPING (e.g. ANGLE IRONS, CHAINS, ETC.) AND INSULATING PIPING IN IMMEDIATE AREA OF HEATER TO PREVENT EXCESSIVE HEAT LOSS.
 - HEATER TO BE INSTALLED IN ELECTRICALLY UNCLASSIFIED AREA.
 - NOTES 7, 8, 9 AND 10 ARE DELETED. HOLD 1 HAS BEEN RESOLVED.

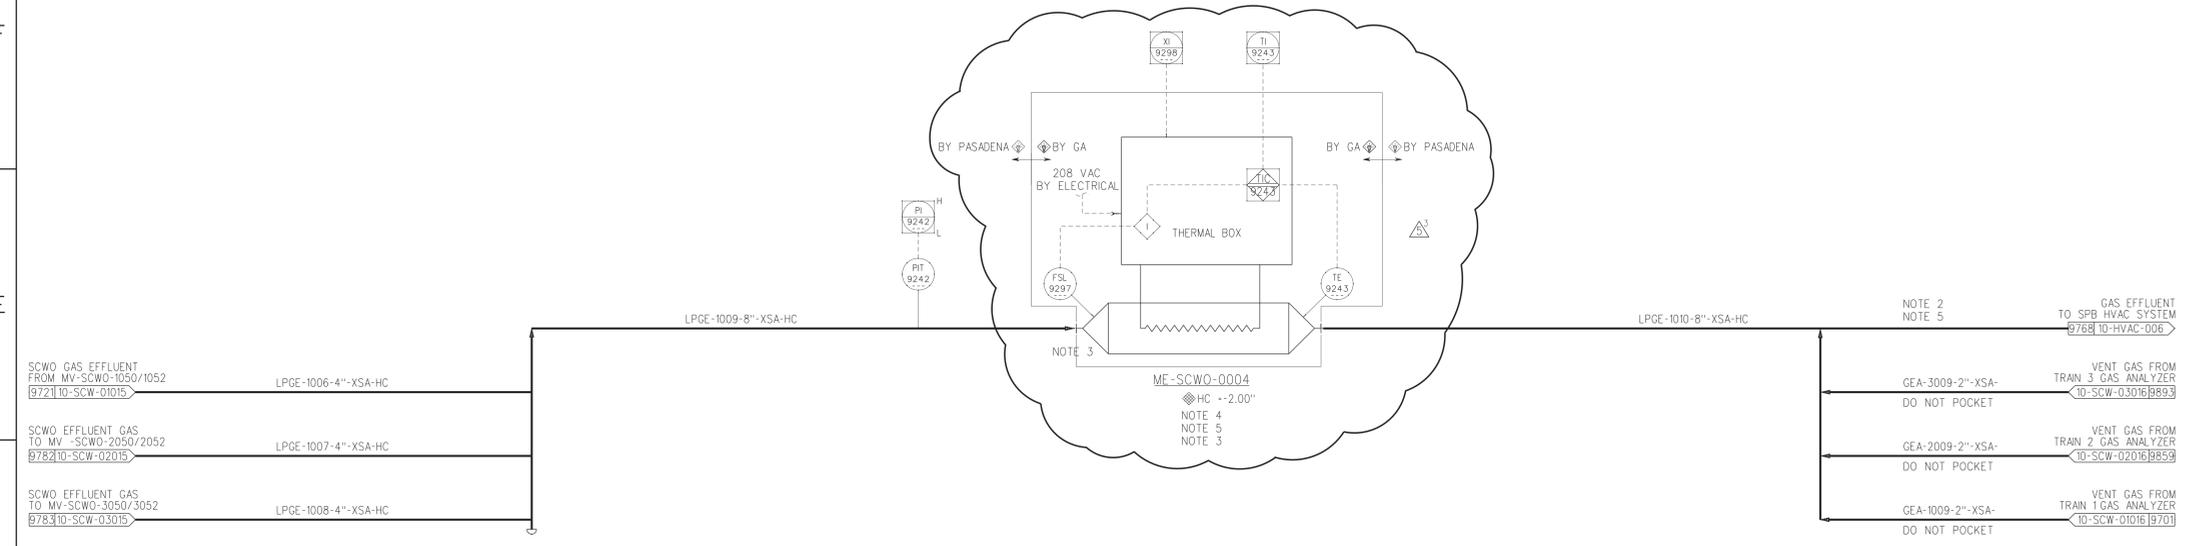

BASED ON BLUE GRASS PFD 24915-10-M5-SCWO-00001
 REFERENCE DRAWINGS

RCM Apvd
 DNI: cr-Issued by Mike Batolabato, o-General
 Atomics, ou=Configuration Management,
 email=Miguel.Batolabato@gsa.com, cn=US
 Date: 2012.10.02 09:44:22 -0700'

NO.	DATE	DESCRIPTION	DR	CK	DL	PE	APPD
1	11/15/10	FC (INCORPORATES DCN-679)	NL	WR	KWD	KWD	DJ
2	06/06/07	FC (INCORPORATES DCN-679)	NL	WR	KWD	KWD	DJ
3	03/14/07	FC (REMOVED HOLD 1, GAS ANALYZERS CONND TO LPGE-1010 LINE1)	JEM	MD	KWD	NW	DJ
4	08/07/06	FC (INCORPORATES DESIGN DEVELOPMENT AND VENDOR DATA)	NL	DDV	KWD	NW	DJ
5	10/21/05	FD (INCORPORATES PARSONS COMMENTS AND GENERAL REVISIONS)	JEM	DDV	KWD	NW	DJ

BECHTEL PARSONS BLUE GRASS
 DOD PROGRAM MANAGER FOR ASSEMBLED CHEMICAL WEAPONS ASSESSMENT EDGEMOOD, MARYLAND
 US ARMY ENGINEERING AND SUPPORT CENTER, HUNTSVILLE HUNTSVILLE, ALABAMA

GENERAL ATOMICS
 BLUE GRASS CHEMICAL AGENT DESTRUCTION PILOT PLANT PROJECT (BGCAPP)
 RICHMOND, KENTUCKY
 CONTRACT NO. DAAA09-03-D-0023

STATE OF KENTUCKY
 WILLIAM RICKMAN
 25486
 LICENSED PROFESSIONAL ENGINEER

SCWO PROCESSING BUILDING GAS EFFLUENT DUCT HEATER PIPING & INSTRUMENT DIAGRAM
 DRAWING NUMBER: 24915-10-M6-SCWO-00027
 SHEET: 1 of 1
 REV: 5


MX-SCWO-1020
SCWO REACTOR 1 FEED MODULE
MP-SCWO-1010
HP FUEL PUMP
RATED FLOW : 0.1/1 GPM
RATED DELTA P : 4300 PSI
MOTOR HP : 7.5 HP
MATERIAL OF CONST : 316/316L

GENERAL NOTES:

- FOR SYMBOLS AND LEGEND, SEE DRAWINGS
24915-00-M6-00-00010
24915-00-M6-00-00011
24915-00-M6-00-00012
24915-00-M6-00-00013
24915-00-M6-00-00014
24915-00-M6-00-00015
- ELECTRICAL AREA CLASSIFICATION: CLASS 1, DIVISION 2, GROUP D.
- HP RELIEF PIPING TO BE ADEQUATELY ANCHORED, SLOPED TOWARDS FUEL TANK, AND WITH NO POCKETS.
- INTERCONNECTING (FUEL: IPA) PIPING BY GA, HPF-0100-3/8"-XHT SHALL BE DOUBLE CONTAINED WITHIN A 3/4" PIPE (MIN) XSA SHALL BE THIS PIPE'S DESIGNATION.
- SYSTEM SHUTDOWN UPON OPENING OF CLASSIFIED COMPARTMENT DOOR (AFTER SPECIFIED TIME DELAY).
- SHUTDOWN HP FUEL PUMP UPON LOW LOW PRESSURE ALARM WHEN PUMP IS RUNNING. IN ADDITION, FIRE ALARM CONTROL SYSTEM PER P.M. ACWA.
- FUEL PIPING IS ALL WELDED TO MAXIMUM PRACTICAL EXTENT.
- HIGH PRESSURE SERVICE PIPING IN BETWEEN SKIDS SHALL BE PROVIDED WITH ADDITIONAL SHIELDING AND ROUTED TO MINIMIZE OPERATOR EXPOSURE TO POTENTIAL VALVE OR FITTING LEAKS. USE WELDED CONSTRUCTION TO MAXIMUM PRACTICAL EXTENT IN THE HIGH PRESSURE PIPING ON AND IN BETWEEN THE SCWO SKIDS. ADDITIONAL SHIELDING TO BE ADDED WHEN PIPING IS INSTALLED AT BGCAPP.
- PROVIDE PROTECTION AROUND HIGH PRESSURE FUEL VALVES, FLANGES, AND FITTINGS TO PREVENT POTENTIAL IGNITION AT EXPOSED SURFACE. PROVIDE CONTAINMENT AROUND EXPOSED HIGH PRESSURE FUEL PIPING.
- DEDICATED SKID VENTILATION (ELECTRICAL CLASSIFICATION AREA CLASS 1, DIVISION 2, GROUP D) IS REQUIRED TO PREVENT CROSS-VENTILATION OF POTENTIAL HAZARDOUS FUEL (IPA) VAPORS INTO UNCLASSIFIED AREAS.
- CONTROL PANELS ARE TO BE LOCATED OFF-BOARD FROM THE MODULE IN AN UNCLASSIFIED (NON-HAZARDOUS) AREA.
- Ⓢ DENOTES DESIGN RESPONSIBILITY LABEL.
- NO VALVES, RESTRICTIONS AND NO POCKETS ARE TO BE ALLOWED IN THIS LINE.
- THE FOLLOWING VALVE(S) ARE NORMALLY CLOSED:
XV-9133A--
- VFD TO BE PROVIDED BY PASADENA.
- * DENOTES VENDOR SUPPLIED.
- PSV-9128A-- RELIEF VALVE INCREASED IN SIZE (FROM RELIEF VALVE SIZING DOCUMENT) DUE TO REQUIREMENT FOR PIPING INSTALLATION.
- COMMON INSTRUMENT AIR HEADER SERVICES SCWO REACTOR 1 FEED MODULE COMPONENTS ON THIS PID AND SCWO PID 24915-10-M6-SCWO-01012.
- DOUBLE MANUAL BLOCK VALVE ON INLET TO FEED SKID PER PRELIMINARY HAZARD ANALYSIS FOR SCWO FIRE & ELECTRICAL AREA CLASSIFICATION.
- XV-9133A-- SHALL BE PROGRAMMED SO THAT IT CANNOT OPEN WHILE IPA FUEL IS FEEDING THE SCWO REACTOR THROUGH XV-9389A-- IN ADDITION, AS A PERMISSIVE FUNCTION THE IPA FUEL FLOW TO THE SCWO REACTOR THROUGH XV-9389A-- CANNOT START IF XV-9133A-- IS OPEN.
- FPS SHUTDOWN SWITCH TO BE LOCATED AT GRADE, NEAR WEST END OF SCWO FEED SKID.
- NOTES 3, 6, 7, 8, 9, 16, 18, 25, 27 AND 28 ARE DELETED.

This document has been reviewed for ITAR/EAR and no ITAR/EAR sensitive information was found. 17 Dec 2013

This document has been reviewed for OPSEC material, and none was found. 17 Dec 2013

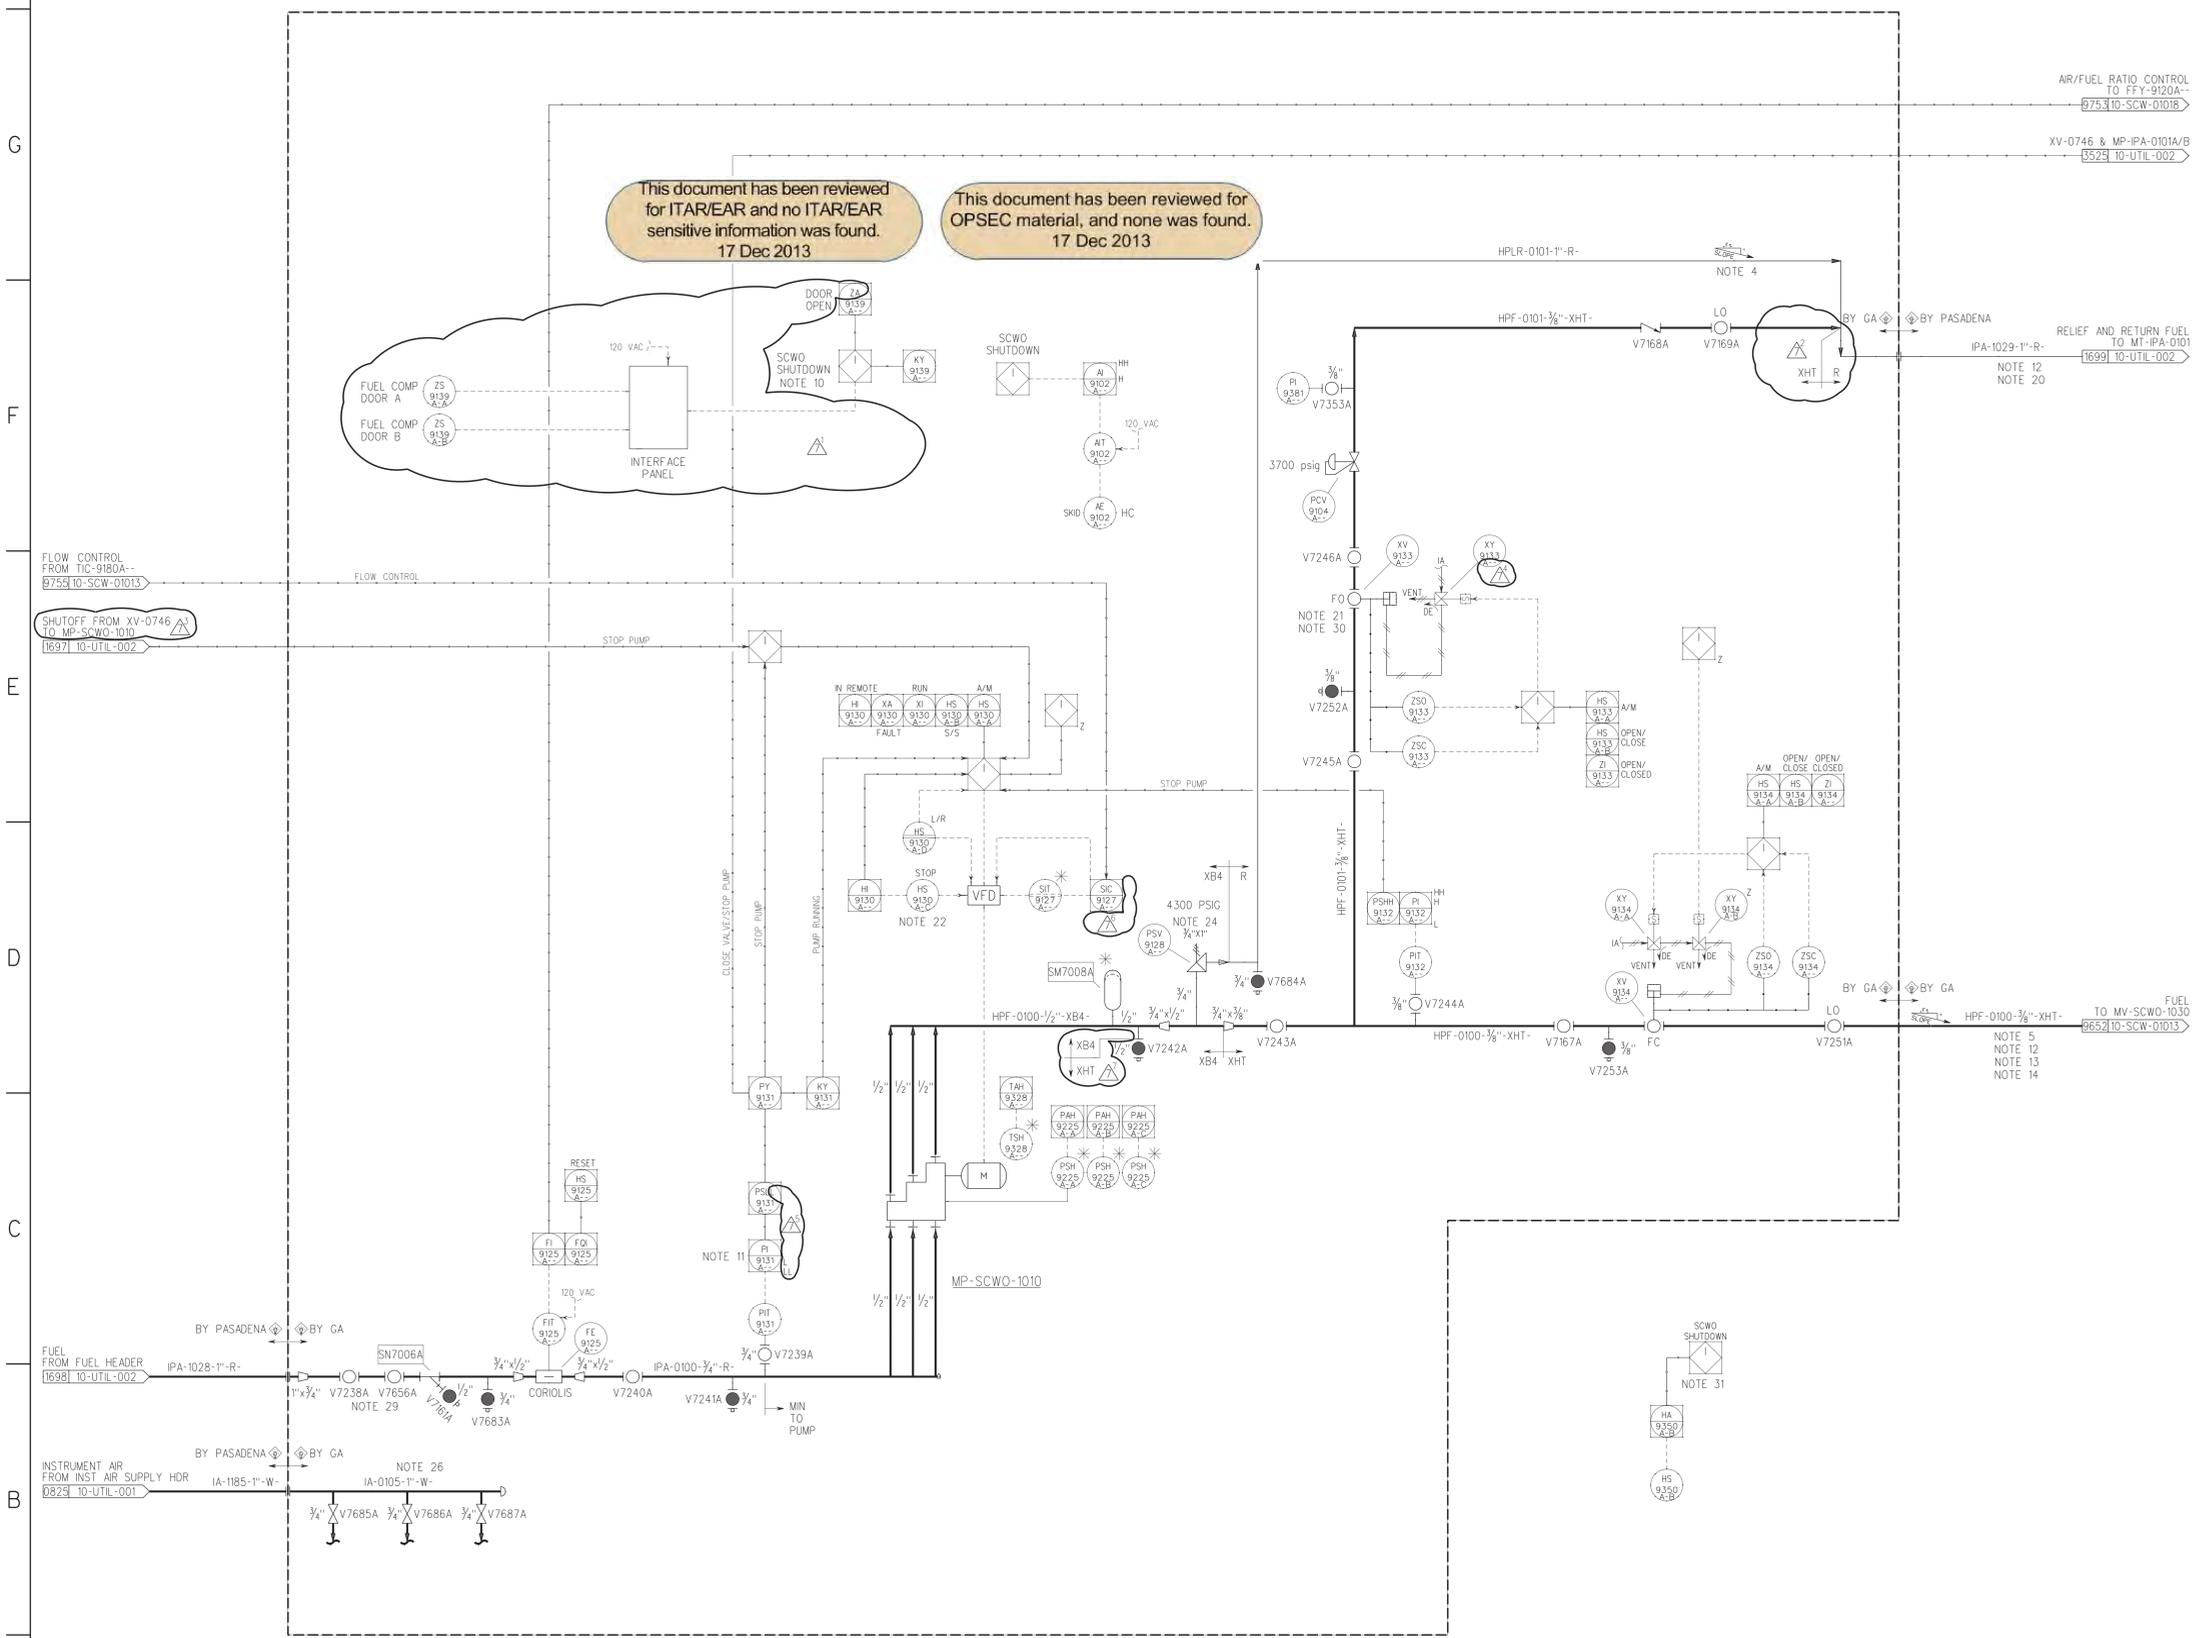

BASED ON BLUE GRASS PFD 24915-10-M5-SCWO-00001
REFERENCE DRAWINGS

cn=ISSUED by Judy Dishon, o=General Atomics, ou=Configuration / Data Management, email=Judy.dishon@ga.com, c=US 2013.06.18 09:31:26 -0700

NO.	DATE	DESCRIPTION	DR	CK	DL	PE	APPD
28		FC (INCORPORATES DCN-1040)	NL	WR	KWD	KWD	VN
6	01-23-12	FC (INCORPORATES DCN-381)	NL	WR	KWD	KWD	VN
5	11-16-10	FC (IPE STAMPED)	NL	WR	KWD	KWD	VN
4	01-15-09	FC (INCORPORATES BPBGT COMMENTS)	NL	JL	KWD	DNN	VN
3	06-04-07	FC (INCORPORATES TRAIN 2 & TRAIN 3 DRAWINGS)	JEM	MD	KWD	DNN	VN
2	03-16-07	FC (INCORPORATES DESIGN DEVELOPMENT AND VENDOR DATA)	NL	DDV	KWD	DNN	VN
1	08-08-06	FD (INCORPORATES GOV'T COMMENTS AND DESIGN DEVELOPMENT)	JEM	DDV	KWD	DNN	VN
0	10-21-05	FD (INCORPORATES PARSONS COMMENTS AND GENERAL REVISIONS)	JEM	DDV	KWD	DNN	VN

QUALITY 0 Non-0

BECHTEL PARSONS BLUE GRASS

DOD PROGRAM MANAGER FOR ASSEMBLED CHEMICAL WEAPONS ASSESSMENT EDGEWOOD, MARYLAND

US ARMY ENGINEERING AND SUPPORT CENTER, HUNTSVILLE HUNTSVILLE, ALABAMA

GENERAL ATOMICS


STATE OF KENTUCKY
WILLIAM RICKMAN
25486
LICENSED PROFESSIONAL ENGINEER

BLUE GRASS CHEMICAL AGENT DESTRUCTION PILOT PLANT PROJECT (BGCAPP)
RICHMOND, KENTUCKY
DAAA09-03-D-0023

SCWO PROCESSING BUILDING TRAIN 1 REACTOR FUEL FEED PIPING & INSTRUMENT DIAGRAM

DRAWING NUMBER: 24915-10-M6-SCWO-01011
SHEET: 1 of 1
REV: 7

10MS-CWO-01011.ppt 03/15/13

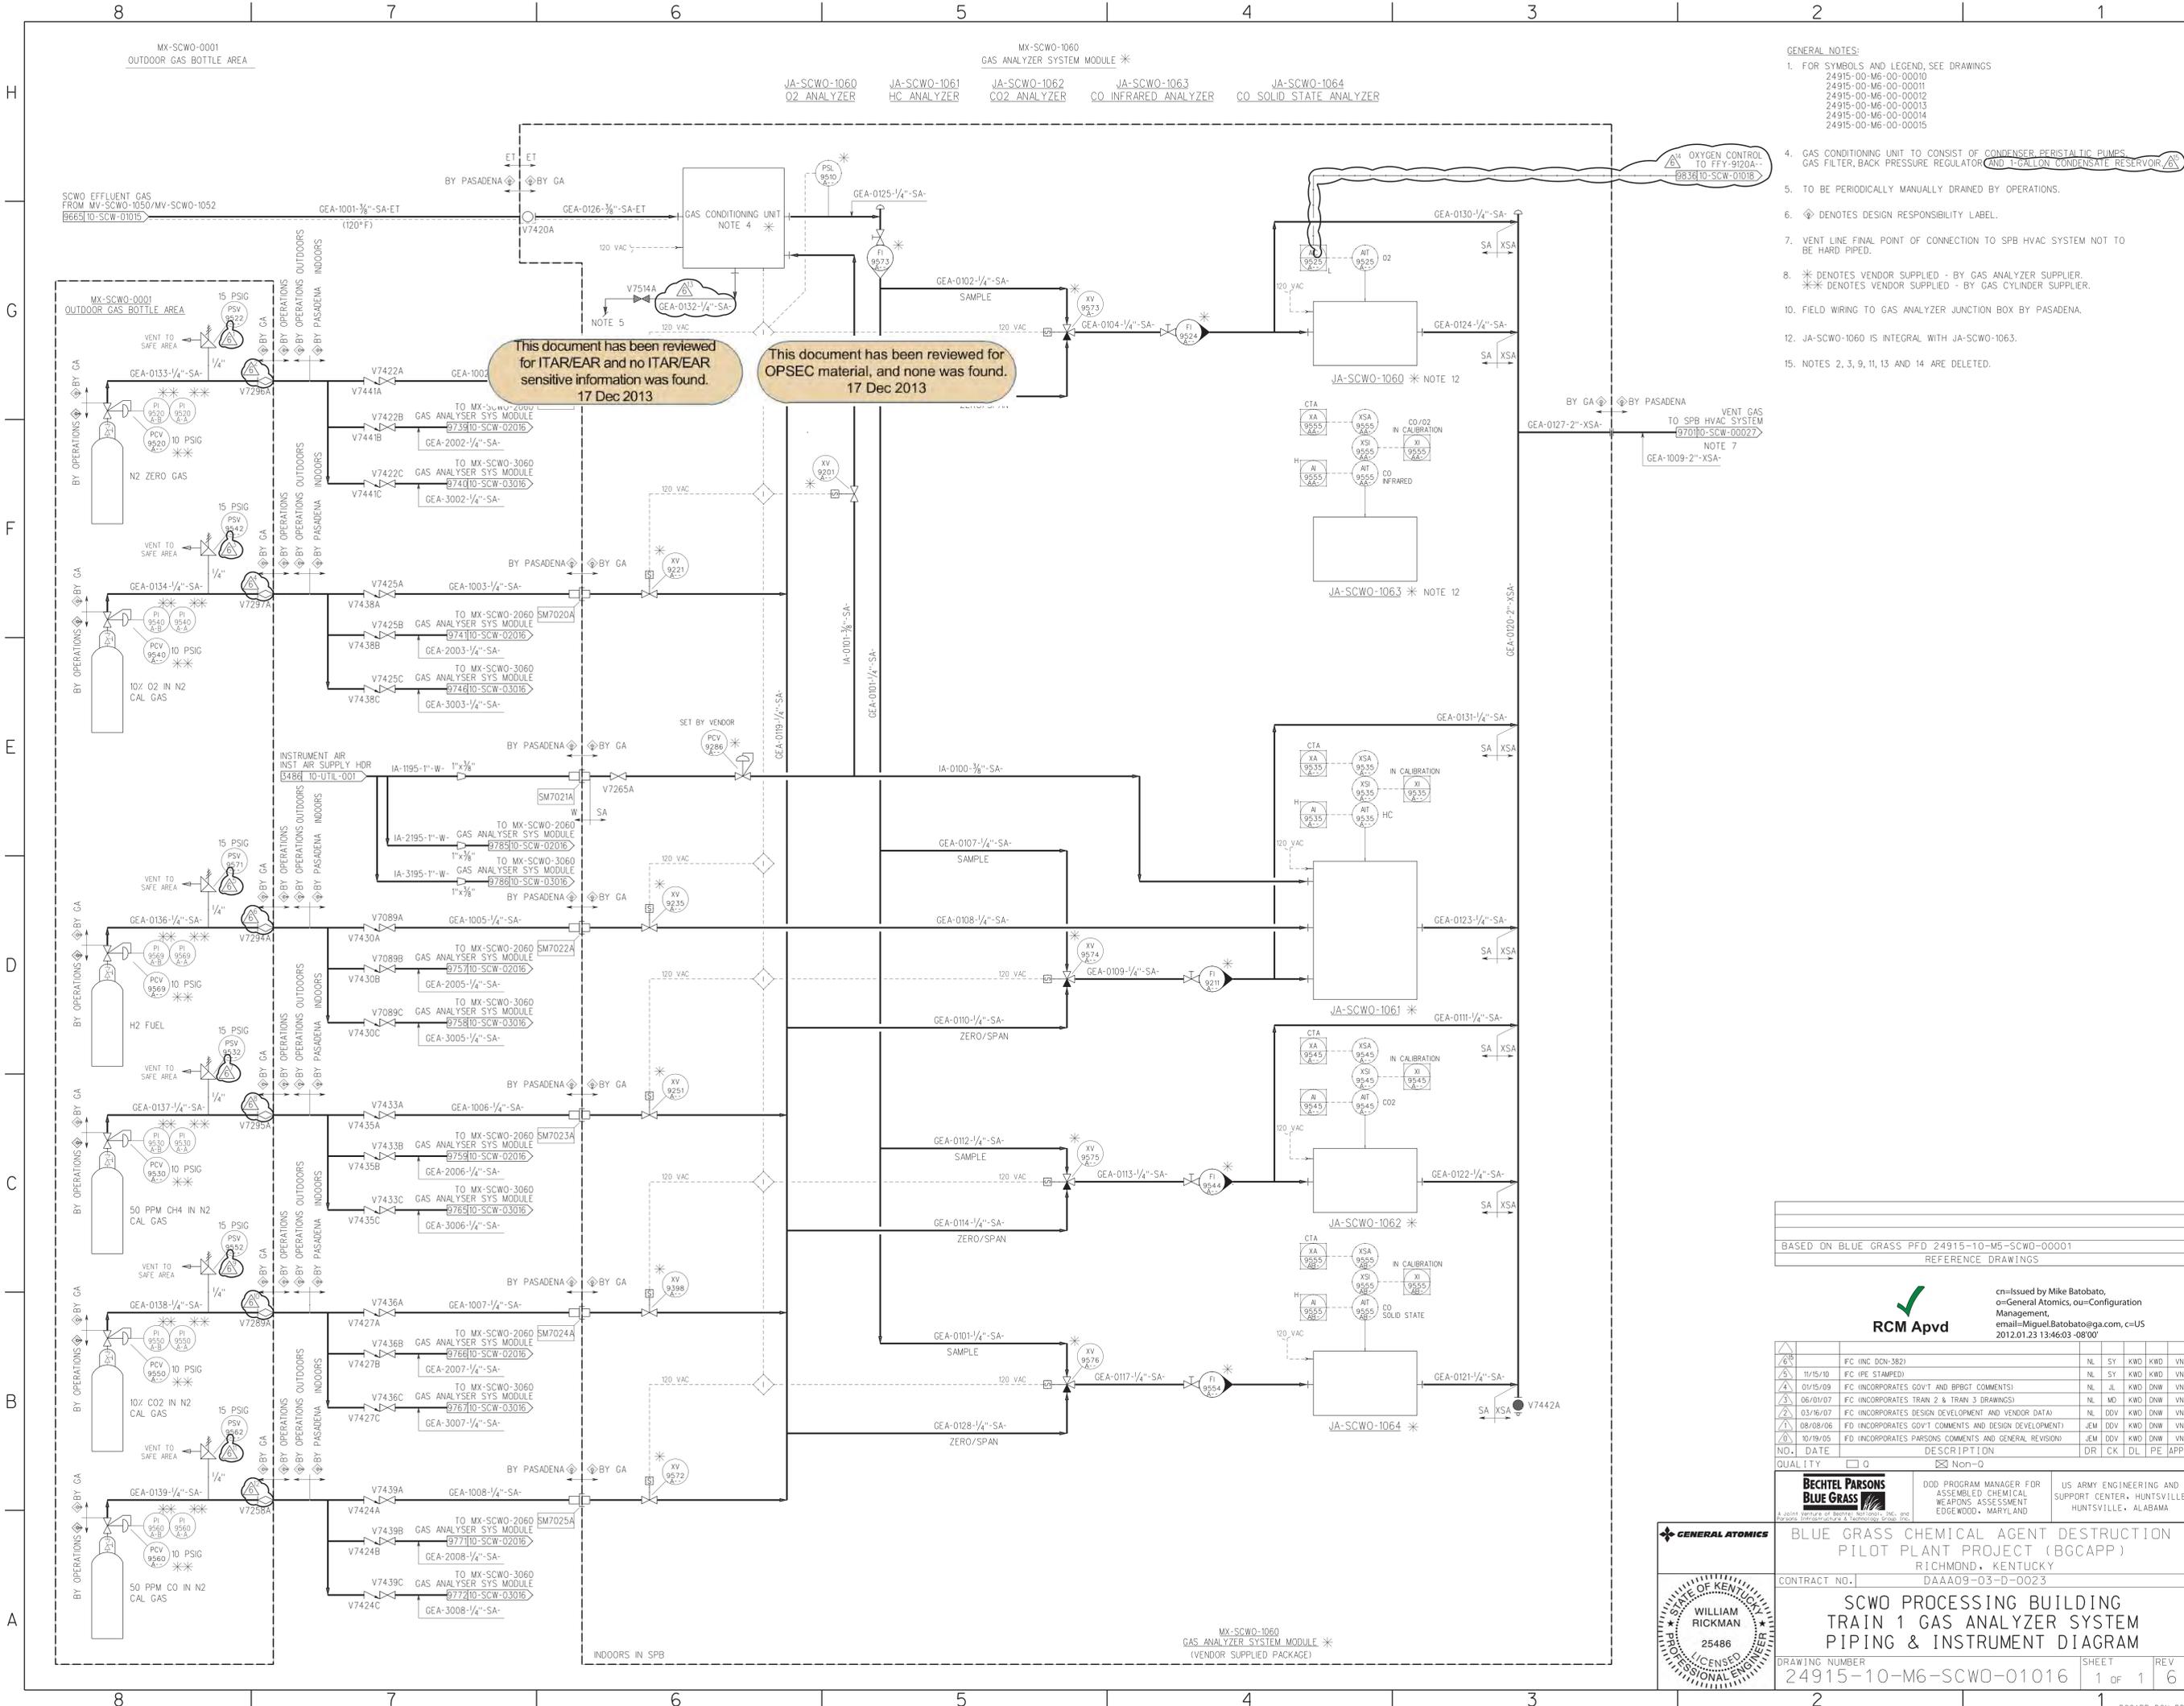

- GENERAL NOTES:**
- FOR SYMBOLS AND LEGEND, SEE DRAWINGS
 24915-00-M6-00-00010
 24915-00-M6-00-00011
 24915-00-M6-00-00012
 24915-00-M6-00-00013
 24915-00-M6-00-00014
 24915-00-M6-00-00015
 - GAS CONDITIONING UNIT TO CONSIST OF CONDENSER, PERISTALTIC PUMPS, GAS FILTER, BACK PRESSURE REGULATOR AND 1-GALLON CONDENSATE RESERVOIR.
 - TO BE PERIODICALLY MANUALLY DRAINED BY OPERATIONS.
 - Ⓢ DENOTES DESIGN RESPONSIBILITY LABEL.
 - VENT LINE FINAL POINT OF CONNECTION TO SPB HVAC SYSTEM NOT TO BE HARD PIPED.
 - * DENOTES VENDOR SUPPLIED - BY GAS ANALYZER SUPPLIER.
 ** DENOTES VENDOR SUPPLIED - BY GAS CYLINDER SUPPLIER.
 - FIELD WIRING TO GAS ANALYZER JUNCTION BOX BY PASADENA.
 - JA-SCWO-1060 IS INTEGRAL WITH JA-SCWO-1063.
 - NOTES 2, 3, 9, 11, 13 AND 14 ARE DELETED.

This document has been reviewed for ITAR/EAR and no ITAR/EAR sensitive information was found. 17 Dec 2013

This document has been reviewed for OPSEC material, and none was found. 17 Dec 2013

BASED ON BLUE GRASS PFD 24915-10-M5-SCWO-00001
 REFERENCE DRAWINGS

cn-issued by Mike Batobato,
 c=General Atomics, ou=Configuration Management,
 email=Miguel.Batobato@ga.com, c=US
 2012.01.23 13:46:03 -08'00'

RCM Apvd

NO.	DATE	DESCRIPTION	DR	CK	DL	PE	APPD
1	10/19/05	FD INCORPORATES PARSONS COMMENTS AND GENERAL REVISIONS	JEM	DDV	KWD	DNN	VN
2	08/08/06	FD INCORPORATES GOV'T COMMENTS AND DESIGN DEVELOPMENT	JEM	DDV	KWD	DNN	VN
3	03/16/07	FC INCORPORATES TRAIN 2 & TRAIN 3 DRAWINGS	NL	MD	KWD	DNN	VN
4	06/01/07	FC INCORPORATES GOV'T AND BPBGT COMMENTS	NL	JL	KWD	DNN	VN
5	11/15/10	FC (IPE STAMPED)	NL	SY	KWD	DNN	VN
6	11/15/10	FC (INC DCN-382)	NL	SY	KWD	DNN	VN

QUALITY 0 Non-0

BECHTEL PARSONS BLUE GRASS

DOD PROGRAM MANAGER FOR ASSEMBLED CHEMICAL WEAPONS ASSESSMENT EDGEWOOD, MARYLAND

US ARMY ENGINEERING AND SUPPORT CENTER, HUNTSVILLE HUNTSVILLE, ALABAMA

BLUE GRASS CHEMICAL AGENT DESTRUCTION PILOT PLANT PROJECT (BGCAPP)
 RICHMOND, KENTUCKY
 DAAA09-03-D-0023


SCWO PROCESSING BUILDING TRAIN 1 GAS ANALYZER SYSTEM PIPING & INSTRUMENT DIAGRAM

CONTRACT NO. DAAA09-03-D-0023

DRAWING NUMBER: 24915-10-M6-SCWO-01016

SHEET: 1 of 1

REV: 6

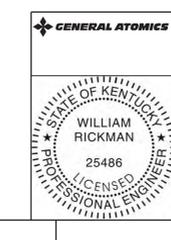

10mscow01016.ppt 07/29/11

MX-SCWO-1020
SCWO REACTOR 1 FEED MODULE

MP-SCWO-1021
FEED WATER PUMP


RATED FLOW : 0.2/1.2 GPM
RATED DELTA P : 4300 PSIG
MOTOR HP : 10 HP
MATERIAL OF CONST : 316/316L

MX-SCWO-1030
SCWO REACTOR 1 MODULE

MS-SCWO-1021
FEED WATER PREHEATER


DUTY : 370 KW (RATING)
DESIGN PRESSURE : 4300 PSIG
DESIGN TEMPERATURE : 225 °F
MATERIAL OF CONST : UNS N08811 (HEATER COIL)
TRIM : TRIM-0805-0"-XHN-HC
ASME CODE STAMPED VESSEL

- GENERAL NOTES:
- FOR SYMBOLS AND LEGEND, SEE DRAWINGS
 - THE FOLLOWING VALVES ARE NORMALLY CLOSED:
XV-9156A--
 - HP RELIEF PIPING TO BE ADEQUATELY ANCHORED, SLOPED TOWARDS EMERGENCY RELIEF TANK, AND WITH NO POCKETS.
 - INTERCONNECTING PIPING BY GA.
 - * DENOTES VENDOR SUPPLIED.
 - CONTROL PANELS ARE TO BE LOCATED OFF-BOARD FROM THE MODULE IN UNCLASSIFIED (PER DIRECTION FROM GOVERNMENT 5/4/06 CORRESPONDENCE)
 - ADDITIONAL INSTRUMENT AIR, INSTRUMENTATION OR PIPING WILL BE ADDED AS REQUIRED AFTER EQUIPMENT IS SPECIFIED BY VENDOR.
 - SHUT-OFF FEED WATER PUMP UPON LOW LOW ALARM WHEN PUMP IS RUNNING.
 - HIGH PRESSURE SERVICE PIPING IN BETWEEN SKIDS SHALL BE PROVIDED WITH ADDITIONAL SHIELDING AND ROUTED TO MINIMIZE OPERATOR EXPOSURE TO POTENTIAL VALVE OR FITTING LEAKS. USE WELDED CONSTRUCTION TO MAXIMUM PRACTICAL EXTENT IN THE HIGH PRESSURE PIPING ON AND IN BETWEEN THE SCWO SKIDS. ADDITIONAL SHIELDING TO BE ADDED WHEN PIPING IS INSTALLED AT BCCAPP.
 - ◇ DENOTES DESIGN RESPONSIBILITY LABEL.
 - ELECTRICAL CLASSIFICATION AREA: UNCLASSIFIED (PER DIRECTION FROM GOVERNMENT 5/4/06 CORRESPONDENCE)
 - VFD'S TO BE PROVIDED BY PASADENA.
 - UPON HIGH-HIGH FEED WATER TEMPERATURE ALARM, THE PRE-HEATER AND SCWO SYSTEM SHALL SHUT DOWN.
 - VENDOR SHALL PROVIDE A ROSEMOUNT SMART "RAIL MOUNT" (M/N 644B) TEMPERATURE TRANSMITTER. VENDOR SHALL PROVIDE THREE-WIRE 100 OHM RTD'S.
 - PASADENA TO PROVIDE POWER CABLE TO THE PREHEATER CONTROLLER. ALSO, PASADENA TO PROVIDE POWER CABLE FROM PREHEATER CONTROLLER TO THE PREHEATER UNIT ON THE MODULE AS WELL AS INSTRUMENT AND CONTROL WIRING AND CONDUIT.
 - ORIENT RELIEF VALVE VERTICALLY TO PRECLUDE PARTICULATE BUILD-UP.
 - PCV-9155A SETPOINT IS FOR PUMP CALIBRATION ONLY. SETPOINT TO BE ADJUSTED DOWN FOR OPERATION TO ALLOW PUMP RE-START AT NO LOAD.
 - NOTES 3, 6, 7, 8, 9, 10, 11, 15, 19, 20, 21, 25, 27 AND 29 ARE DELETED.

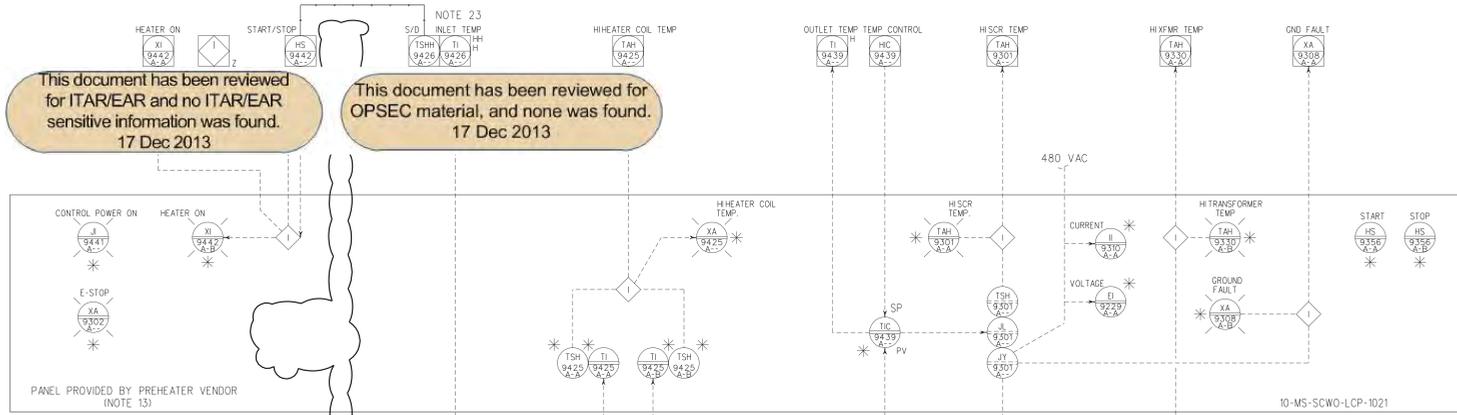

This document has been reviewed for ITAR/EAR and no ITAR/EAR sensitive information was found. 17 Dec 2013

This document has been reviewed for OPSEC material, and none was found. 17 Dec 2013

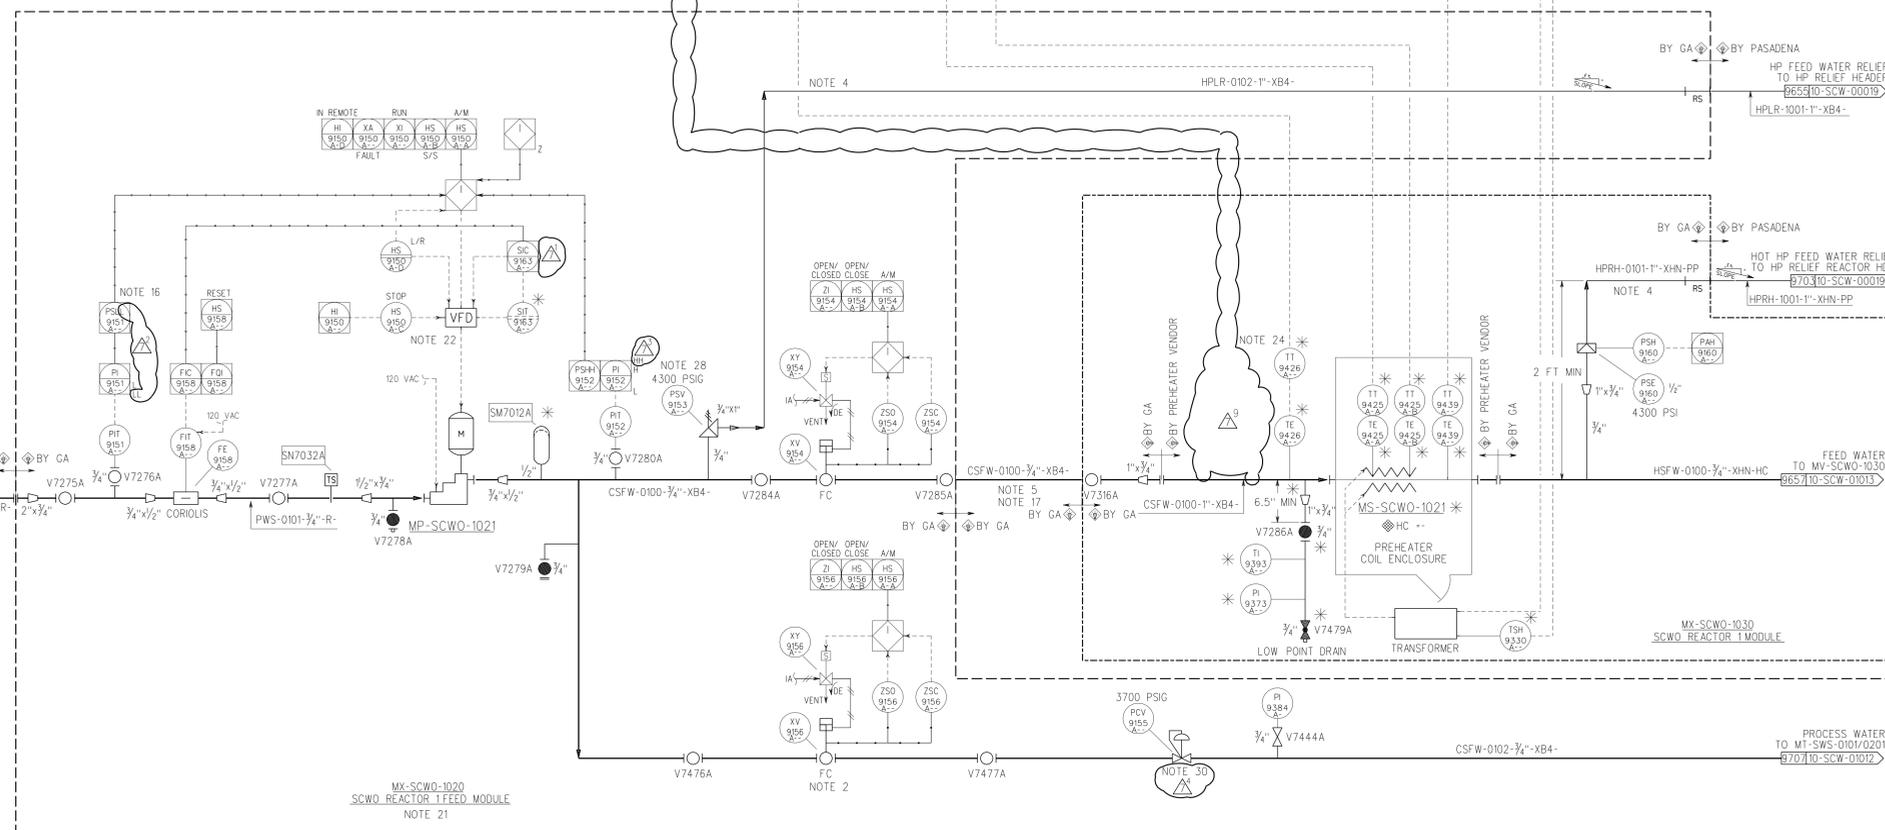


MX-SCWO-2020
 SCWO REACTOR 2 FEED MODULE
 MP-SCWO-2010
 HP FUEL PUMP
 RATED FLOW : 0.1/1 GPM
 RATED DELTA P : 4300 PSI
 MOTOR HP : 7.5 HP
 MATERIAL OF CONST : 316/316L

- GENERAL NOTES:**
- FOR SYMBOLS AND LEGEND, SEE DRAWINGS
 24915-00-M6-00-00010
 24915-00-M6-00-00011
 24915-00-M6-00-00012
 24915-00-M6-00-00013
 24915-00-M6-00-00014
 24915-00-M6-00-00015
 - ELECTRICAL AREA CLASSIFICATION: CLASS 1, DIVISION 2, GROUP D.
 - HP RELIEF PIPING TO BE ADEQUATELY ANCHORED, SLOPED TOWARDS FUEL TANK, AND WITH NO POCKETS.
 - INTERCONNECTING (FUEL: IPA) PIPING BY GA, HPF-0200-3/8"-XHT SHALL BE DOUBLE CONTAINED WITHIN A 3/4" PIPE (MIN) XSA SHALL BE THIS PIPE'S DESIGNATION.
 - SYSTEM SHUTDOWN UPON OPENING OF CLASSIFIED COMPARTMENT DOOR (AFTER SPECIFIED TIME DELAY).
 - SHUTDOWN HP FUEL PUMP UPON LOW-LOW PRESSURE ALARM WHEN PUMP IS RUNNING. IN ADDITION, FIRE ALARM CONTROL SYSTEM PER P.M. ACWA.
 - FUEL PIPING IS ALL WELDED TO MAXIMUM PRACTICAL EXTENT.
 - HIGH PRESSURE SERVICE PIPING IN BETWEEN SKIDS SHALL BE PROVIDED WITH ADDITIONAL SHIELDING AND ROUTED TO MINIMIZE OPERATOR EXPOSURE TO POTENTIAL VALVE OR FITTING LEAKS. USE WELDED CONSTRUCTION TO MAXIMUM PRACTICAL EXTENT IN THE HIGH PRESSURE PIPING ON AND IN BETWEEN THE SCWO SKIDS. ADDITIONAL SHIELDING TO BE ADDED WHEN PIPING IS INSTALLED AT BGCAPP.
 - PROVIDE PROTECTION AROUND HIGH PRESSURE FUEL VALVES, FLANGES, AND FITTINGS TO PREVENT POTENTIAL IGNITION AT EXPOSED SURFACE. PROVIDE CONTAINMENT AROUND EXPOSED HIGH PRESSURE FUEL PIPING.
 - DEDICATED SKID VENTILATION (ELECTRICAL CLASSIFICATION AREA CLASS 1, DIVISION 2, GROUP D) IS REQUIRED TO PREVENT CROSS-VENTILATION OF POTENTIAL HAZARDOUS FUEL (IPA) VAPORS INTO UNCLASSIFIED AREAS.
 - CONTROL PANELS ARE TO BE LOCATED OFF-BOARD FROM THE MODULE IN AN UNCLASSIFIED (NON-HAZARDOUS) AREA.
 - Ⓢ DENOTES DESIGN RESPONSIBILITY LABEL.
 - NO VALVES, RESTRICTIONS AND NO POCKETS ARE TO BE ALLOWED IN THIS LINE.
 - THE FOLLOWING VALVE(S) ARE NORMALLY CLOSED:
 XV-9133B--
 - VFD TO BE PROVIDED BY PASADENA.
 - * DENOTES VENDOR SUPPLIED.
 - PSV-9128B-- RELIEF VALVE INCREASED IN SIZE (FROM RELIEF VALVE SIZING DOCUMENT) DUE TO REQUIREMENT FOR PIPING INSTALLATION.
 - COMMON INSTRUMENT AIR HEADER SERVICES SCWO REACTOR 2 FEED MODULE COMPONENTS ON THIS PID AND SCWO PID 24915-10-M6-SCWO-02012.
 - DOUBLE MANUAL BLOCK VALVE ON INLET TO FEED SKID PER PRELIMINARY HAZARD ANALYSIS FOR SCWO FIRE & ELECTRICAL AREA CLASSIFICATION.
 - XV-9133B-- SHALL BE PROGRAMMED SO THAT IT CANNOT OPEN WHILE IPA FUEL IS FEEDING THE SCWO REACTOR THROUGH XV-9389B-- IN ADDITION, AS A PERMISSIVE FUNCTION THE IPA FUEL FLOW TO THE SCWO REACTOR THROUGH XV-9389B-- CANNOT START IF XV-9133B-- IS OPEN.
 - FPS SHUTDOWN SWITCH TO BE LOCATED AT GRADE, NEAR WEST END OF SCWO FEED SKID.
 - NOTES 3, 6, 7, 8, 9, 16, 18, 25, 27 AND 28 ARE DELETED.

This document has been reviewed for ITAR/EAR and no ITAR/EAR sensitive information was found. 17 Dec 2013

This document has been reviewed for OPSEC material, and none was found. 17 Dec 2013

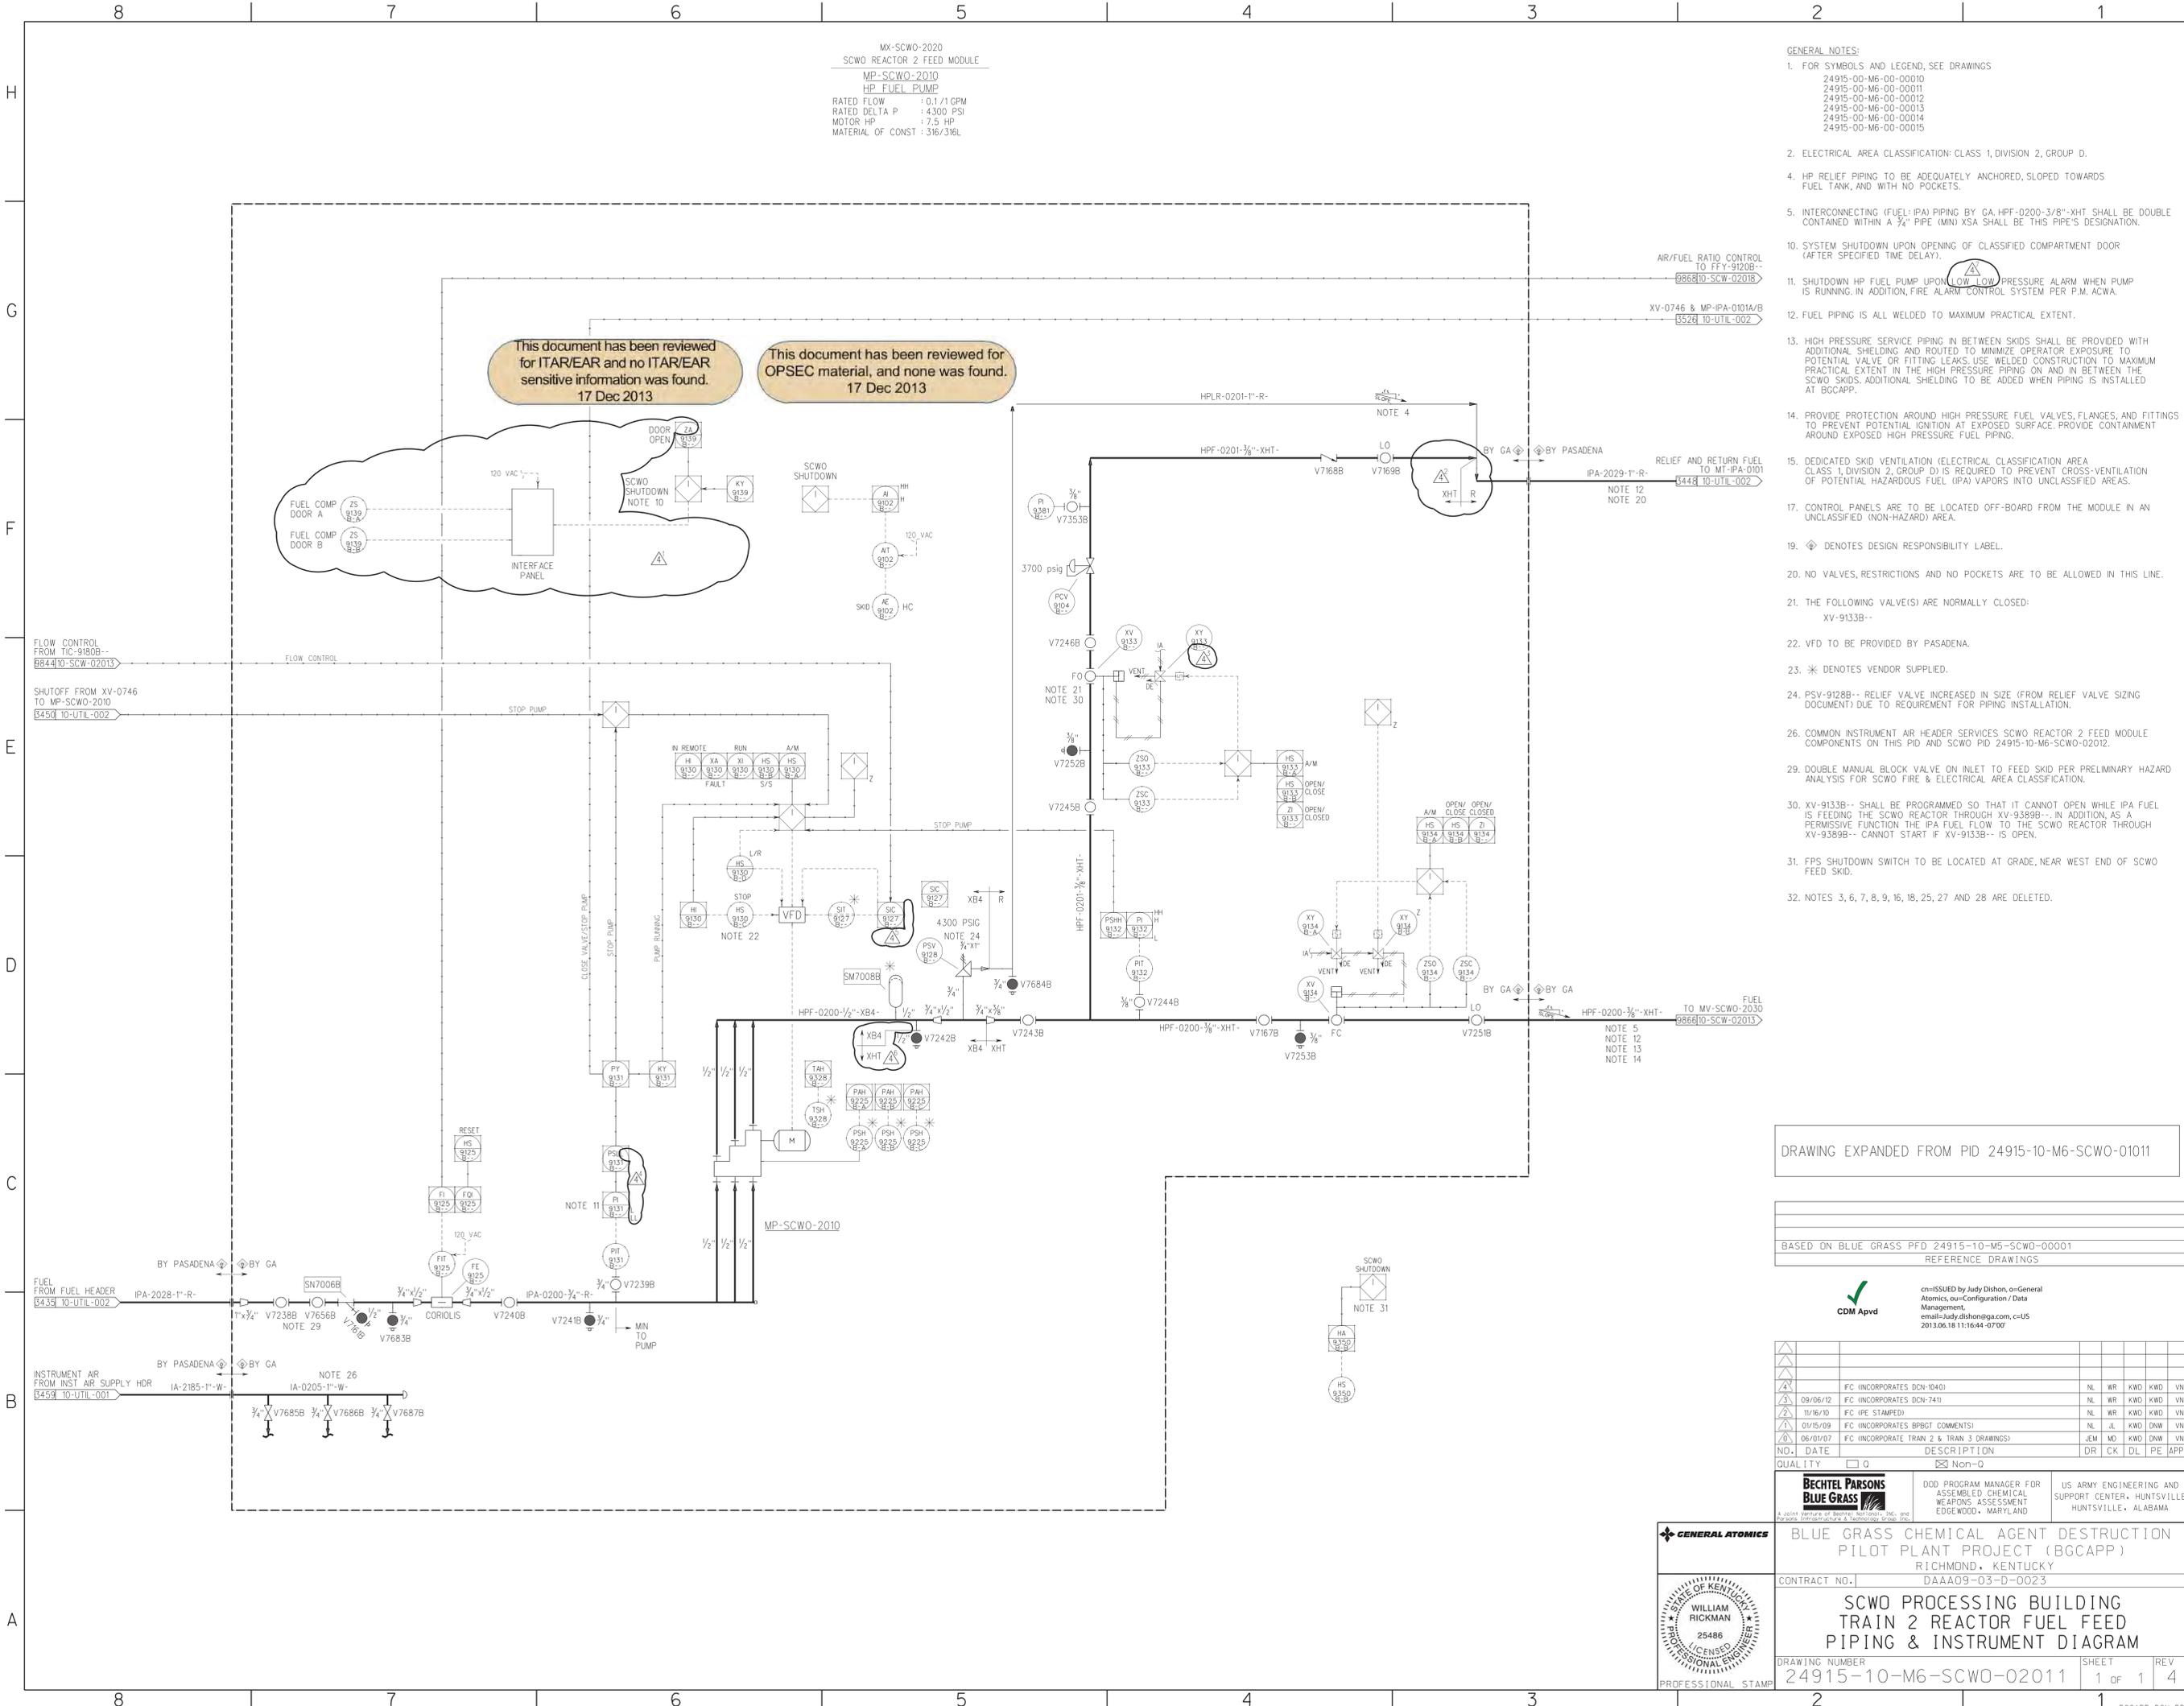

DRAWING EXPANDED FROM PID 24915-10-M6-SCWO-01011

BASED ON BLUE GRASS PFD 24915-10-M6-SCWO-00001
 REFERENCE DRAWINGS

CDM Apvd

NO.	DATE	DESCRIPTION	DR	CK	DL	PE	APPD

BECHTEL PARSONS BLUE GRASS

DOD PROGRAM MANAGER FOR ASSEMBLED CHEMICAL WEAPONS ASSESSMENT EDGEWOOD, MARYLAND


US ARMY ENGINEERING AND SUPPORT CENTER, HUNTSVILLE, ALABAMA

BLUE GRASS CHEMICAL AGENT DESTRUCTION PILOT PLANT PROJECT (BGCAPP)
 RICHMOND, KENTUCKY
 DAAA09-03-D-0023

SCWO PROCESSING BUILDING TRAIN 2 REACTOR FUEL FEED PIPING & INSTRUMENT DIAGRAM


DRAWING NUMBER 24915-10-M6-SCWO-02011 SHEET 1 of 1 REV 4

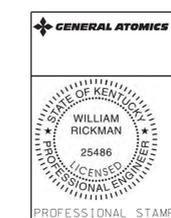

10mscwo2010.ppt 03/15/13


MX-SCWO-3020
 SCWO REACTOR 3 FEED MODULE
 MP-SCWO-3010
 HP FUEL PUMP
 RATED FLOW : 0.1/1 GPM
 RATED DELTA P : 4300 PSI
 MOTOR HP : 7.5 HP
 MATERIAL OF CONST : 316/316L

GENERAL NOTES:

- FOR SYMBOLS AND LEGEND, SEE DRAWINGS
 24915-00-M6-00-0010
 24915-00-M6-00-0011
 24915-00-M6-00-0012
 24915-00-M6-00-0013
 24915-00-M6-00-0014
 24915-00-M6-00-0015
- ELECTRICAL AREA CLASSIFICATION: CLASS 1, DIVISION 2, GROUP D.
- HP RELIEF PIPING TO BE ADEQUATELY ANCHORED, SLOPED TOWARDS FUEL TANK, AND WITH NO POCKETS.
- INTERCONNECTING (FUEL:IPA) PIPING BY GA, HPF-0300-3/8"-XHT SHALL BE DOUBLE CONTAINED WITHIN A 3/4" PIPE (MIN) XSA SHALL BE THIS PIPE'S DESIGNATION.
- SYSTEM SHUTDOWN UPON OPENING OF CLASSIFIED COMPARTMENT DOOR (AFTER SPECIFIED TIME DELAY).
- SHUTDOWN HP FUEL PUMP UPON LOW-LOW PRESSURE ALARM WHEN PUMP IS RUNNING. IN ADDITION, FIRE ALARM CONTROL SYSTEM PER P.M. ACWA.
- FUEL PIPING IS ALL WELDED TO MAXIMUM PRACTICAL EXTENT.
- HIGH PRESSURE SERVICE PIPING IN BETWEEN SKIDS SHALL BE PROVIDED WITH ADDITIONAL SHIELDING AND ROUTED TO MINIMIZE OPERATOR EXPOSURE TO POTENTIAL VALVE OR FITTING LEAKS. USE WELDED CONSTRUCTION TO MAXIMUM PRACTICAL EXTENT IN THE HIGH PRESSURE PIPING ON AND IN BETWEEN THE SCWO SKIDS. ADDITIONAL SHIELDING TO BE ADDED WHEN PIPING IS INSTALLED AT BGCAPP.
- PROVIDE PROTECTION AROUND HIGH PRESSURE FUEL VALVES, FLANGES, AND FITTINGS TO PREVENT POTENTIAL IGNITION AT EXPOSED SURFACE. PROVIDE CONTAINMENT AROUND EXPOSED HIGH PRESSURE FUEL PIPING.
- DEDICATED SKID VENTILATION (ELECTRICAL CLASSIFICATION AREA CLASS 1, DIVISION 2, GROUP D) IS REQUIRED TO PREVENT CROSS-VENTILATION OF POTENTIAL HAZARDOUS FUEL (IPA) VAPORS INTO UNCLASSIFIED AREAS.
- CONTROL PANELS ARE TO BE LOCATED OFF-BOARD FROM THE MODULE IN AN UNCLASSIFIED (NON-HAZARDOUS) AREA.
- Ⓢ DENOTES DESIGN RESPONSIBILITY LABEL.
- NO VALVES, RESTRICTIONS AND NO POCKETS ARE TO BE ALLOWED IN THIS LINE.
- THE FOLLOWING VALVE(S) ARE NORMALLY CLOSED:
 XV-9133C--
- VFD TO BE PROVIDED BY PASADENA.
- * DENOTES VENDOR SUPPLIED.
- PSV-9128C-- RELIEF VALVE INCREASED IN SIZE (FROM RELIEF VALVE SIZING DOCUMENT) DUE TO REQUIREMENT FOR PIPING INSTALLATION.
- COMMON INSTRUMENT AIR HEADER SERVICES SCWO REACTOR 3 FEED MODULE COMPONENTS ON THIS PID AND SCWO PID 24915-10-M6-SCWO-03012.
- DOUBLE MANUAL BLOCK VALVE ON INLET TO FEED SKID PER PRELIMINARY HAZARD ANALYSIS FOR SCWO FIRE & ELECTRICAL AREA CLASSIFICATION.
- XV-9133C-- SHALL BE PROGRAMMED SO THAT IT CANNOT OPEN WHILE IPA FUEL IS FEEDING THE SCWO REACTOR THROUGH XV-9389C-- IN ADDITION, AS A PERMISSIVE FUNCTION THE IPA FUEL FLOW TO THE SCWO REACTOR THROUGH XV-9389C-- CANNOT START IF XV-9133C-- IS OPEN.
- FPS SHUTDOWN SWITCH TO BE LOCATED AT GRADE, NEAR WEST END OF SCWO FEED SKID.
- NOTES 3, 6, 7, 8, 9, 16, 18, 25, 27 AND 28 ARE DELETED.

This document has been reviewed for ITAR/EAR and no ITAR/EAR sensitive information was found. 17 Dec 2013

This document has been reviewed for OPSEC material, and none was found. 17 Dec 2013

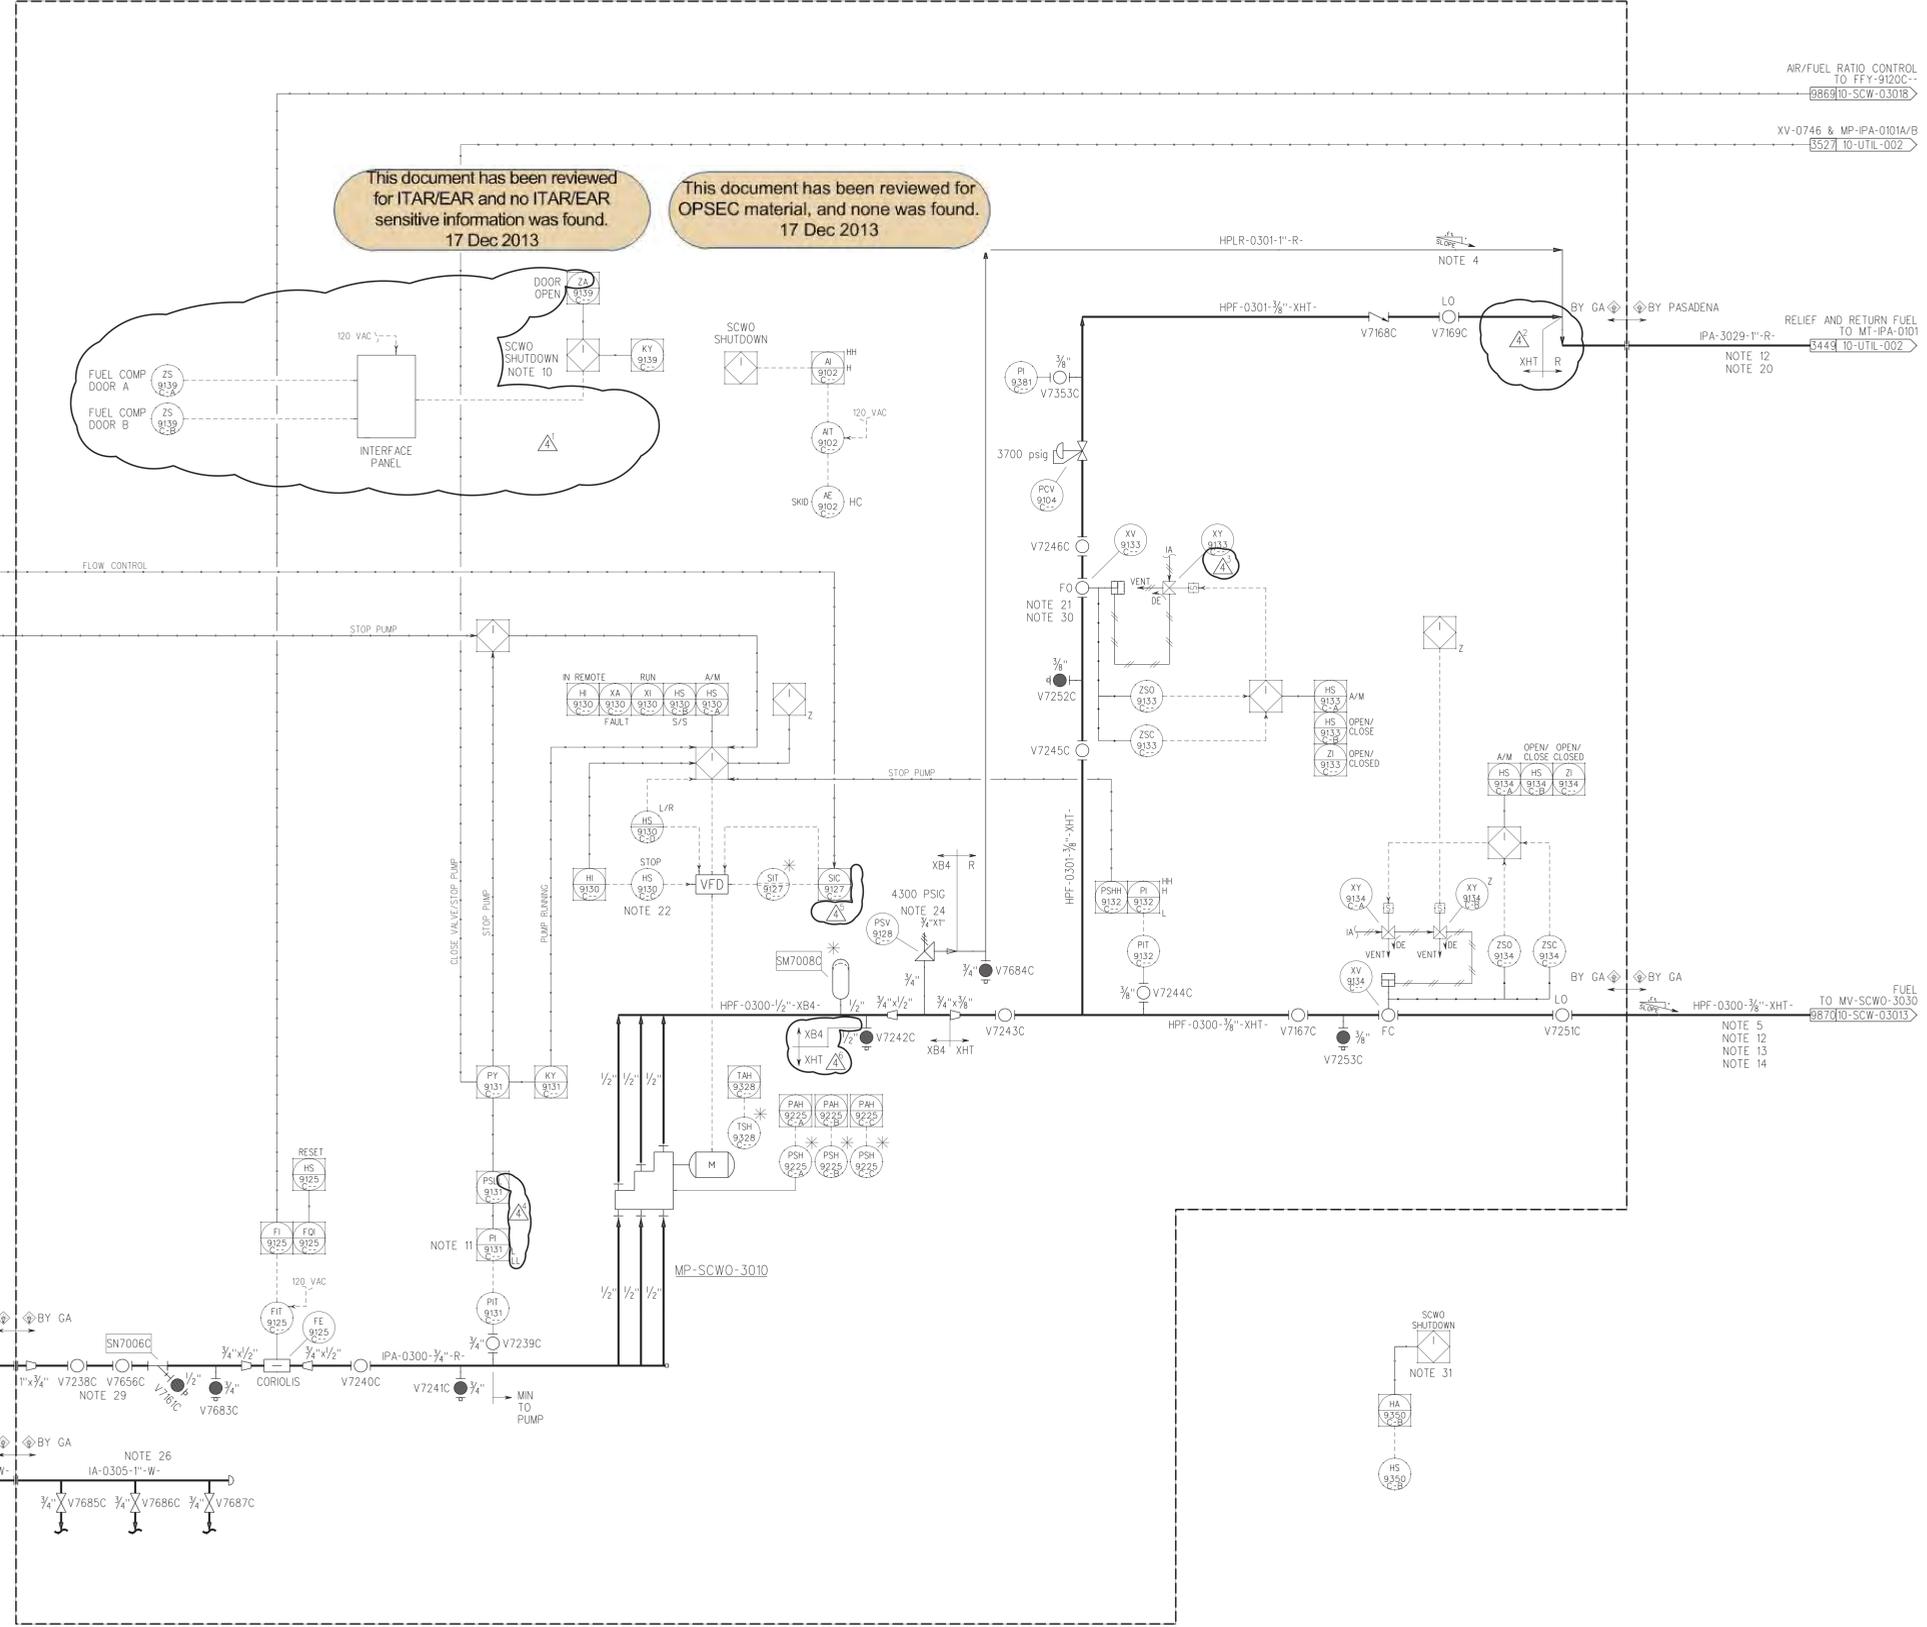

DRAWING EXPANDED FROM PID 24915-10-M6-SCWO-01011

BASED ON BLUE GRASS PFD 24915-10-M6-SCWO-00001
 REFERENCE DRAWINGS


NO.	DATE	DESCRIPTION	DR	CK	DL	PE	APPD
1	06/01/07	FC (INCORPORATES TRAIN 2 & TRAIN 3 DRAWINGS)	JEM	MD	KWD	DNN	VN
2	01/15/09	FC (INCORPORATES PBPGT COMMENTS)	NL	JL	KWD	DNN	VN
3	11/16/10	FC (PE STAMPED)	NL	WR	KWD	KWD	VN
4	09/06/12	FC (INCORPORATES DCN-741)	NL	WR	KWD	KWD	VN
5	09/06/12	FC (INCORPORATES DCN-1040)	NL	WR	KWD	KWD	VN

QUALITY 0 Non-0

BECHTEL PARSONS BLUE GRASS
 DOD PROGRAM MANAGER FOR ASSEMBLED CHEMICAL WEAPONS ASSESSMENT EDGEWOOD, MARYLAND
 US ARMY ENGINEERING AND SUPPORT CENTER, HUNTSVILLE HUNTSVILLE, ALABAMA

GENERAL ATOMICS
 BLUE GRASS CHEMICAL AGENT DESTRUCTION PILOT PLANT PROJECT (BGCAPP)
 RICHMOND, KENTUCKY
 CONTRACT NO. DAAA09-03-D-0023

SCWO PROCESSING BUILDING TRAIN 3 REACTOR FUEL FEED PIPING & INSTRUMENT DIAGRAM
 DRAWING NUMBER: 24915-10-M6-SCWO-03011
 SHEET: 1 of 1
 REV: 4

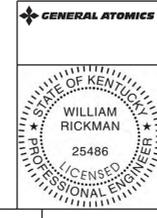

Issued by Mike Batobato, General Atomics, Configuration Management, email: Mike.Batobato@ga.com, c-US 2013.06.18 13:21:52 -0700

CDM Apvd

10mscwo3010.ppt 03/15/13



A Joint Venture of Bechtel National, Inc. and Parsons Infrastructure & Technology Group Inc.

Calculation Cover Sheet

Project Blue Grass Chemical Agent Destruction Pilot Plant		Job No. 743341	Calc No. 24915-11-DBC-00-00002	Sheet 1 of 3	
Subject HSA Mat Foundation Containment Capacity Evaluation		Group Structural	
Calculation Status Designation	Preliminary <input type="checkbox"/>	Committed Preliminary <input checked="" type="checkbox"/>	Confirmed <input type="checkbox"/>	Superseded <input type="checkbox"/>	
Computer Program/Type	SCP <input type="checkbox"/>	Mainframe <input type="checkbox"/>	PC <input checked="" type="checkbox"/>	Program No. MATHCAD Version/Release No. Version 15	
Program Validated:		<input checked="" type="checkbox"/> Yes	<input type="checkbox"/> No	Program validation is available in PPCP/InfoWorks	
Notes/comments	
<p>The HSA Area Tanks and Pipe Rack Foundation is a slab-on-grade supporting (5) Storage Tanks, a Steel Rack for the Pipes and Cable-trays and Pumps serving the HSA facility. The reinforced concrete foundation is 2' – 6" thick slab with 10" thick reinforced wall around the perimeter. The wall serves as containment in case of accidental spillage of the contents of the largest tank.</p> <p>The 2' 6" thick Slab has a sloped top and bottom. The sloped top surface drains the spilled effluent into a trench located along the South-side. The top elevation of the wall is at the same elevation all-around the perimeter of the mat Foundation.</p> <p>The Accidental spillage is considered as the contents of the largest Tank's air-volume, plus the occurrence of maximum expected rainfall.</p> <p>This calculation concludes that the containment capacity is adequate.</p> <p>Reason for revision A to B: Incorporate comment by Environmental group. See Sheet B5</p> <p>Reason For revision B to C: Incorporate Environmental comments and incorporate DCN-260, DCN-324 and DCN-438. Revised Appendix A and added Extracts of DCN-260, -324 and -438 to Attachment C.</p>	
QUALITY LEVEL: <input type="checkbox"/> Q <input checked="" type="checkbox"/> Non-Q	
<table border="1" style="width: 100%; border-collapse: collapse;"> <tr> <td style="width: 10%;"></td> <td style="width: 20%;"></td> <td style="width: 10%;"></td> </tr> <tr> <td>C</td> <td>Issued for Approval (IFA)</td> <td>28</td> <td>3</td> <td>AFR</td> <td>MB</td> <td>HC</td> <td>7/9/12</td> </tr> <tr> <td>B</td> <td>Issued for Approval (IFA)</td> <td>21</td> <td>3</td> <td>AFR</td> <td>MB</td> <td>HC</td> <td>9-22-10</td> </tr> <tr> <td>A</td> <td>Issued for Approval (IFA)</td> <td>20</td> <td>3</td> <td>AFR</td> <td>MB</td> <td>HC</td> <td>4-19-2010</td> </tr> <tr> <td>No.</td> <td>Reason for Revision</td> <td>Total No. of Sheets</td> <td>Last Sheet No.</td> <td>By</td> <td>Checked</td> <td>Approved/ Accepted</td> <td>Date</td> </tr>
RECORD OF REVISIONS	



A Joint Venture of Bechtel National, Inc. and Parsons Infrastructure & Technology Group, Inc.

Calculation Sheet

HSA Mat Foundation Containment Capacity Evaluation

Subject: _____

By: AFR Date: 7/5/2012

Project:	<u>BGCAPP</u>
Job Number:	<u>743341</u>
Calc. No.	<u>24915-11-DBC-00-00002</u>
Sheet No.	<u>2 of 3</u>
Sheet Rev.	<u>C</u>

Table of Contents

Page

Calculation Cover Sheet	1
Table of Contents	2
1. Objective.....	3
2. Input.....	3
3. Assumptions	3
4. References	3
5. Calculation Body	3
6. Summary	3
7. Appendices/Attachments	
Appendix A : Tank Foundation Volumetric Containment Capacity.....A1 to A4
Attachment B: Input Information.....B1 to B5
Attachment C: HSA Area Foundation Design Drawings & DCN ExtractsC1 to C16



A Joint Venture of Bechtel National, Inc. and Parsons Infrastructure & Technology Group, Inc.

Calculation Sheet

HSA Mat Foundation Containment Capacity Evaluation

Subject: _____

By: AFR Date: 7/5/2012

Project:	<u>BGCAPP</u>
Job Number:	<u>743341</u>
Calc. No.	<u>24915-11-DBC-00-00002</u>
Sheet No.	<u>3 of 3</u>
Sheet Rev.	<u>C</u>

1. Objective

This calculation performs evaluation that the HSA Mat containment volume capacity is adequate to contain the accidental spillage of the largest Tank's contents.

2. Input

- 2.1 HSA foundation drawings, 24915-11-DB-00-00001 thru -00011 and DCNS # 24915-00-30E-G01-00260, -00324 and -00438. See Attachment C.
- 2.2 E-mail from Process, Volume capacity of the largest Tank. See Attachment B, sheet B2.
- 2.3 E-mail for rainfall considerations. See Attachment B, sheet B3.

3. Assumptions

The Tank information is based on preliminary Tank data sheets and requires confirmation.

4. References

- 4.1 Tank data sheets, 24915-11-MTD-HSS-00001 thru -00003 (project folders)
- 4.2 Pump data sheets, 24915-000- V2A-MPCA-00019, -00023, -00024 and -00025
24915-000-V1A-MPP0-00017
- 4.3 DCN 24915-24915-00-30E-G01-00260, -00324 and -00438

5. Calculation Body

See Appendix A

6. Summary of Results

Volume available = 83131 cu. Ft > Containment capacity required = 83122 cu. Ft.

7. Appendices/Attachments

- Appendix A, Tank Foundation Volumetric Containment Capacity
- Attachment B, Input Information
- Attachment C, HSA Area Foundation design drawings and Extracts from associated Design Change Notices.



Calculation Sheet

Project: BGCAPP
Job Number: 743341
Calc. No.: 24915- 11-DBC-00-00002
Sheet No.: A1 / A4
Sheet Rev.: C

Subject: HSA Mat Foundation Containment Capacity Evaluation
By: AFR
Date: 7/3/2012

APPENDIX A

Tank Foundation Volumetric Containment Capacity



Calculation Sheet

Project: BGCAPP
Job Number: 743341
Calc. No.: 24915- 11-DBC-00-00002
Sheet No.: A2 / A4
Sheet Rev.: C

Subject: HSA Mat Foundation Containment Capacity Evaluation
By: AFR
Date: 7/3/2012

Body of Calculation

Mat with Wall height from 4' at north-end to 5' - 4" at south-end, average height $h_{avg} := 4ft + 8in = 4.67 ft$

Mat net north-south dimension, 258' - 4" minus (2), 10" walls $L_{ns} := 256ft + 8in = 256.67 ft$

Mat net east-west dimension, 90' minus (2), 10" walls $W_{ew} := 88ft + 4in = 88.33 ft$

use Free-board $h_{fb} := 1 \cdot ft$ conservative

Case 1 available volume with free-board $V_{avail} := [(h_{avg} - h_{fb}) \cdot L_{ns} \cdot W_{ew}] = 83131 \cdot ft^3$



Calculation Sheet

Project: BGCAPP
 Job Number: 743341
 Calc. No.: 24915- 11-DBC-00-00002
 Sheet No.: A3 / A4
 Sheet Rev.: C

Subject: HSA Mat Foundation Containment Capacity Evaluation
 By: AFR
 Date: 7/3/2012

Tank contents spill volume as the largest Tank air-vol [Ref. 4.1]

Tank No	Diameter (ft)	Tank Ht (ft)	Air-Vol (ft ³)
MT-HSS-0704	37	42.33	45520
MT-HSS-0604	37	42.33	45520
MT-HSS-0105	38.5	42.33	49285 <--largest
MT-HSS-0104	24	35	15836
MT-HSS-0205	38.5	42.33	49285

$$V_{\text{spill}} := 49285 \cdot \text{ft}^3$$

Tank-pad vol based on Diameter of Tank \approx Diameter of pad x submerged height \approx average height of wall.

Tank No	Diameter (ft)	Submerge avg Ht (ft)	Vol (ft ³)
MT-HSS-0704	37	4.67	5022
MT-HSS-0604	37	4.67	5022
MT-HSS-0105	38.5	4.67	5437
MT-HSS-0104	24	4.67	2113
MT-HSS-0205	38.5	4.67	5437
total			23031 ft ³

$$V_{\text{tkpad}} := 23031 \cdot \text{ft}^3$$

Pump Pads, with top of Pad elevation \sim 911' - 1" conservatively for all pump-pads, the height varies from 1' -7" to 2' - 11" gives 2' - 2" average, use \approx 2.25' conservatively to derive Volume as follows, [Ref. 4.3]

Pump No	Pump Description	Pad Size (in)	Total Area (ft ²)	Average Height (ft)	Volume (ft ³)
MP-HSS-0604A/B	Energetics Hydrolysate	27x52	19.5	2.67	52.07
MP-HSS-0704A/B	Energetics Hydrolysate	27x52	19.5	2.67	52.07
MP-HSS-0605A/B	Energetics Hydrolysate Recirc	30x60	25	2.67	66.75
MP-HSS-0705A/B	Energetics Hydrolysate Recirc	30x60	25	2.67	66.75
MP-HSS-0108A/B	Aqueous Hydrolysate	30x60	25	2.67	66.75
MP-HSS-0208A/B	Aqueous Hydrolysate	24x46	15.3	2.67	40.94
MP-HSS-0107A/B	Aqueous Hydrolysate	24x46	15.3	2.67	40.94
MP-HSS-0104A/B	Organic Hydrolysate	24x48	16	2.67	42.72
MP-HSS-0105A/B	Organic Hydrolysate	24x48	16	2.67	42.72
MP-HSS-0205A/B	Organic Hydrolysate	24x48	16	2.67	42.72
MP-HSS-0101	Agent Hydrolysate TK Area Sump	21x19	2.8	2.67	7.40
sub-total					522 ft ³

$$V_{\text{pump}} := 522 \cdot \text{ft}^3$$



Calculation Sheet

Project: BGCAPP
 Job Number: 743341
 Calc. No.: 24915- 11-DBC-00-00002
 Sheet No.: A4 / A4
 Sheet Rev.: C

Subject: HSA Mat Foundation Containment Capacity Evaluation
 By: AFR
 Date: 7/3/2012

Pipe and Cable-tray Rack Piers, with top of concrete elevation of ~ 910' - 6", the height varies from 6" to 1' - 10" gives Volume as follows, [Ref. 2.4]

(26) Rack Piers x 2' - 6" square Pier x average height 1' - 2" =

$$V_{\text{rackp}} := 26 \cdot 2.5\text{ft} \cdot 2.5\text{ft} \cdot 1.167\text{ft} = 190 \text{ft} \cdot \text{ft}^2$$

(5) Stair-case stoops x 4' - 0" x 1' - 7" with average height 1' - 6" =

(10) Stair-case pedestals x 18" x 18" with average height 1' - 6" =

$$V_{\text{stairp}} := (5 \cdot 4\text{ft} \cdot 1.583\text{ft} \cdot 1.5\text{ft}) + (10 \cdot 1.5\text{ft} \cdot 1.5\text{ft} \cdot 1.5\text{ft}) = 81 \text{ft}^3$$

Volume due to 5.3 in of Rainfall

$$V_{\text{rain}} := 5.3\text{in} \cdot L_{\text{ns}} \cdot W_{\text{ew}} = 10014 \text{ft}^3$$

[See Attachment B]

Total Volume required

$$V_{\text{reqd}} := V_{\text{tkpad}} + V_{\text{rain}} + V_{\text{pump}} + V_{\text{rackp}} + V_{\text{stairp}} + V_{\text{spill}} = 83122 \text{ft}^3$$

Therefore

$$V_{\text{avail}} = 83131 \text{ft}^3 > V_{\text{reqd}} = 83122 \text{ft}^3 \quad \leftarrow \text{O.K}$$

Note that conservatism in using 100% of Air Volume of the Tank, 1 ft of free-board and conservative height of the pump-pads is included in the above results.

Also the coincidence of maximum Rainfall-event, of 5.3in and Spill-event is incorporated.



A Joint Venture of Bechtel National, Inc. and
Parsons Infrastructure & Technology Group, Inc.

Calculation Sheet

Project: BGCAPP

Job Number: 743341

Calc. No. 24915-11-DBC-00-00002

Sheet No. B1 of B5

Sheet Rev. C

Subject: HSA Mat Foundation Containment Capacity Evaluation

By: AFR Date: 7/03/2012

ATTACHMENT B :

Input Information



A Joint Venture of Bechtel National, Inc. and
Parsons Infrastructure & Technology Group, Inc.

Calculation Sheet

Project:	BGCAPP
Job Number:	743341
Calc. No.	24915-11-DBC-00-00002
Sheet No.	B2 of B5
Sheet Rev.	C

Subject: HSA Mat Foundation Containment Capacity Evaluation

By: AFR Date: 7/03/2012

From: Bartok, Philip
Sent: Tuesday, October 20, 2009 10:18 AM
To: Rahim, Abdulaziz
Cc: Cruz, Chona
Subject: RE: HSA Client Comments

Thank you. I will answer the comment that we will change the volume of the dike to 125% of the largest tank plus rainfall.
 Phil

From: Rahim, Abdulaziz
Sent: Tuesday, October 20, 2009 9:54 AM
To: Bartok, Philip
Cc: Cruz, Chona
Subject: HSA Client Comments

Phil Bartok,

Comment #s 9837 and 9838 are specifically addressed to Process documents and needs your reply. However, the containment calculation will be done in the next revision of Calc. 24915-11-DBC-00-00001, HSA Tank Foundation design. The containment capacity will be based on 125% of the largest Tank in the HSA farm with rainfall allowance.

FYI,
 Thanks,
 Azee Rahim

125% ← Superseded by e-mail (see Sheet B4)

Azee Rahim
 859-625-6251



A Joint Venture of Bechtel National, Inc. and Parsons Infrastructure & Technology Group, Inc.

Calculation Sheet

Project:	<u>BGCAPP</u>
Job Number:	<u>743341</u>
Calc. No.	<u>24915-11-DBC-00-00002</u>
Sheet No.	<u>B3 of B5</u>
Sheet Rev.	<u>C</u>

Subject: HSA Mat Foundation Containment Capacity Evaluation

By: AFR Date: 7/03/2012

From: Cruz, Chona
Sent: Thursday, September 10, 2009 4:55 PM
To: Rahim, Abdulaziz
Subject: FW: Structural HSA Area Calcs - Issued for Approval - IFA 091009

see comments on calculation from environmental

From: Regan, Kevin
Sent: Thursday, September 10, 2009 4:49 PM
To: Cruz, Chona; Costales, Henry; Moore, Caryn
Subject: FW: Structural HSA Area Calcs - Issued for Approval - IFA 091009

Please see comments below. Thanks.

Regards,

Kevin Regan
Environmental Manager
(859) 625-5417

From: Weitzman, Leo
Sent: Thursday, September 10, 2009 4:23 PM
To: 'Kevin Regan (kregan@bechtel.com)'
Subject: FW: Structural HSA Area Calcs - Issued for Approval - IFA 091009

These documents address the structural requirements of the HSA pads and foundations but we were unable to find the calculation demonstration is also necessary to verify the adequacy of the containment volume of the HSA areas. Please add these calculations to one or the other of these two documents.

When performing these calculations, please take into account the following requirements. The HSA is outdoors and not under roof. Per 40 CFR §296.193(e), the containment volume for hazardous waste tanks that are outdoors, must be adequate to fully contain the total "contained air" volume of the largest tank plus 5.3 inches, which is the 25-year, 24-hour rainfall event for Madison County, KY.

Leo Weitzman, PhD
Permitting Manager
Bechtel Parsons Blue Grass
830 Eastern Bypass, Suite 106
Richmond, KY 40475
E-mail: lweitzma@bechtel.com
859-625-1277 Richmond Office
859-361-6362 Cell
859-625-9918 FAX

From: Talbert, Susan (OWAPF)

1/27/2010



A Joint Venture of Bechtel National, Inc. and
Parsons Infrastructure & Technology Group, Inc.

Calculation Sheet

Project: BGCAPP
Job Number: 743341
Calc. No. 24915-11-DBC-00-00002
Sheet No. B4 of B5
Sheet Rev. C

Subject: HSA Mat Foundation Containment Capacity Evaluation
By: AFR Date: 7/03/2012

From: Bartok, Philip
Sent: Friday, March 19, 2010 7:28 AM
To: Rahim, Abdulaziz
Cc: Costales, Henry; Ahrens, Ron
Subject: ~~RE: HSA Tank Spill Volume~~

I approached Ron Ahrens about the problem. I asked if we could change our response to Gov. Comment 9837 to

Concur. Will revise note 10 on P&ID 11-M6-HSS-00001, as well as on P&IDs HSS-00004, -00007, -00010, and -00012, to change to 100% of largest tank and rainfall, plus 1'-0" freeboard. This is over 130% without the freeboard.

He will get back to me early next week with an answer.

Phil

From: Rahim, Abdulaziz
Sent: Thursday, March 18, 2010 6:10 PM
To: Bartok, Philip
Cc: Costales, Henry
Subject: HSA Tank Spill Volume

Phil Bartok,

Please provide your finalized input for the HSA tank spill volume.

Thanks
Azee Rahim
859-779-7612



A Joint Venture of Bechtel National, Inc. and Parsons Infrastructure & Technology Group, Inc.

Calculation Sheet

Project:	<u>BGCAPP</u>
Job Number:	<u>743341</u>
Calc. No.	<u>24915-11-DBC-00-00002</u>
Sheet No.	<u>B5 of B5</u>
Sheet Rev.	<u>C</u>

Subject: HSA Mat Foundation Containment Capacity Evaluation

By: AFR Date: 7/03/2012

From: Weitzman, Leo
Sent: Monday, August 30, 2010 10:28 AM
To: Costales, Henry
Cc: Regan, Kevin; Danley, Gary N; Rowden, Scott (Parsons)
Subject: FW: HAS TAR
Importance: High

Henry,
Please could you please let me know whether Charlie Sturdivant of Franklin Engineering is correct or not? If he is, please have the referenced document corrected. This is a potentially serious matter that is very likely to impact our hazardous waste permit.

Leo Weitzman, PhD
Permitting Manager
Bechtel Parsons Blue Grass
830 Eastern Bypass, Suite 106
Richmond, KY 40475
E-mail: lweitzma@bechtel.com
859-625-1277 Richmond Office
859-361-6362 Cell
859-625-9918 FAX

From: Charlie Sturdivant [<mailto:csturdivant@franklinengineering.com>]
Sent: Monday, August 30, 2010 10:16 AM
To: Weitzman, Leo
Subject: HAS TAR

Leo:
During the review for the HSA TAR we found a minor discrepancy in a containment capacity. In Calc. No. 24915-11-DBC-00-00002, Rev. A, Appendix A, page A2, the east-west inside dimension of the containment area is incorrectly calculated. The calculation is given as follows:

Mat net east-west dimension, 90' minus (2), 10" walls => $W_{ew} = 88ft + 8in$ The correct result of subtracting 20" from 90' is 88ft + 4in.

This error propagates through several of the calculations used to determine both the Available Volume and the Required Volume but the containment is adequate anyway.

Also, the calculations for volume use an average depth for the containment area of 4.67 ft. This depth is calculated by taking the average of the depths from each end of the containment area shown on drawing number 24915-11-DB-00-00008, Rev. 0, found in appendix C, sheet C9, of the same calculation sheet. This depth is based on the difference between the elevation of the top of the containment wall versus the elevations inside the area on each end. The drawing shown on sheet C9 has a hand written notation to revise this elevation from 913' up to 914'. The calculations use the hand written value of 914'. If this mark-up does not get picked up and the structure gets built as drawn then the containment volume would not meet the design criteria.

Charlie



A Joint Venture of Bechtel National, Inc. and
Parsons Infrastructure & Technology Group, Inc.


Calculation Sheet


Project: BGCAPP
Job Number: 743341
Calc. No. 24915-11-DBC-00-00002
Sheet No. C1 of C16
Sheet Rev. C


Subject: HSA Mat Foundation Containment Capacity Evaluation
By: AFR Date: 7/03/2012


ATTACHMENT C :

HSA Area Foundations Design Drawings

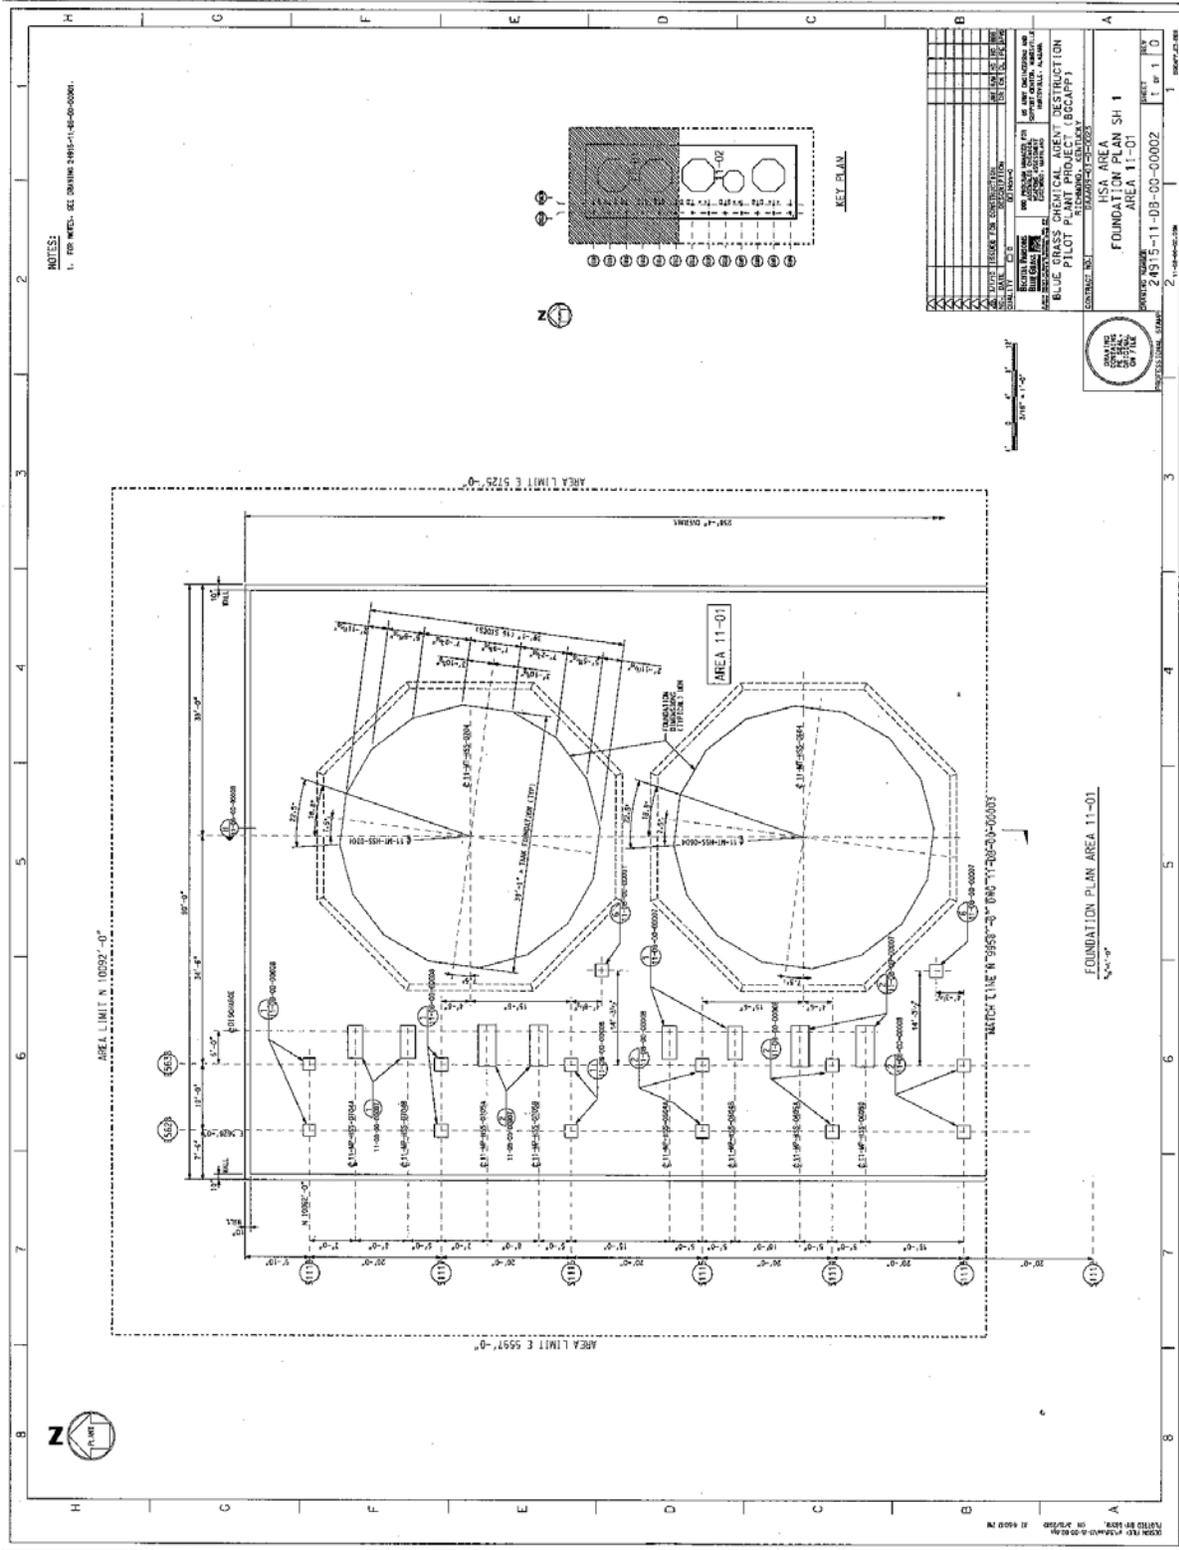

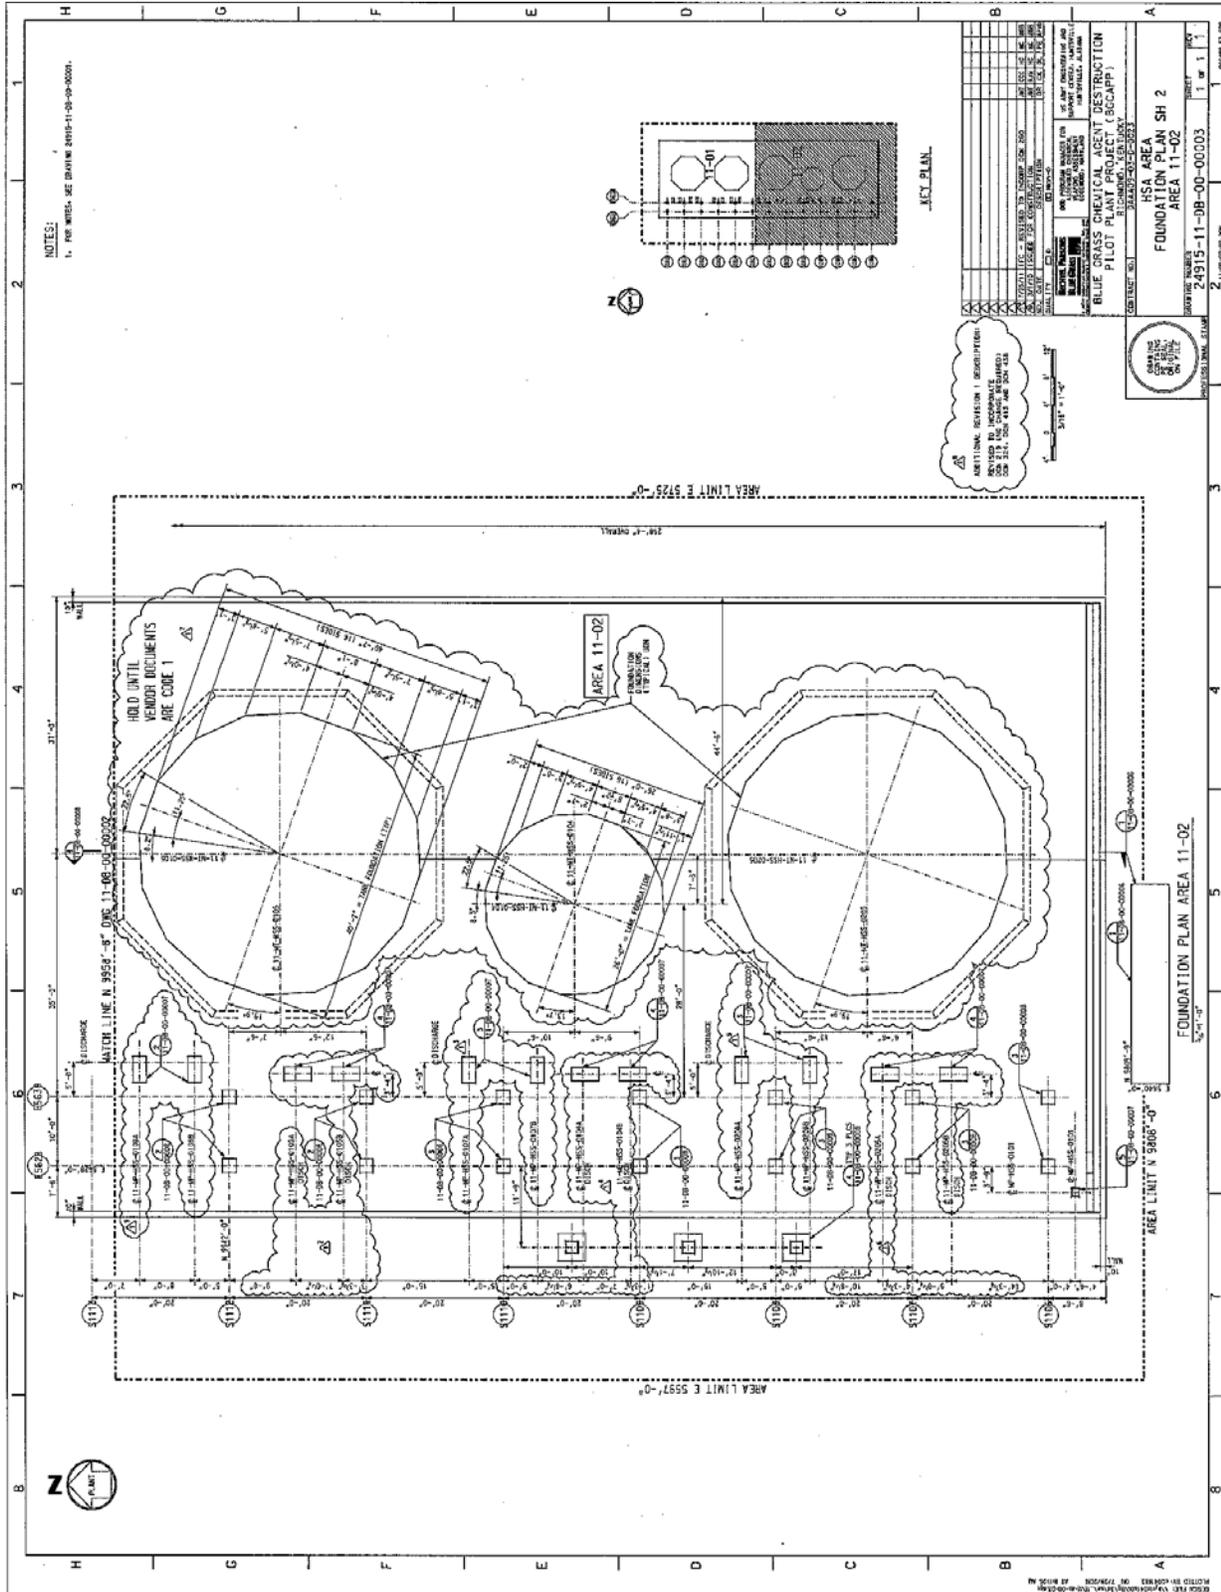


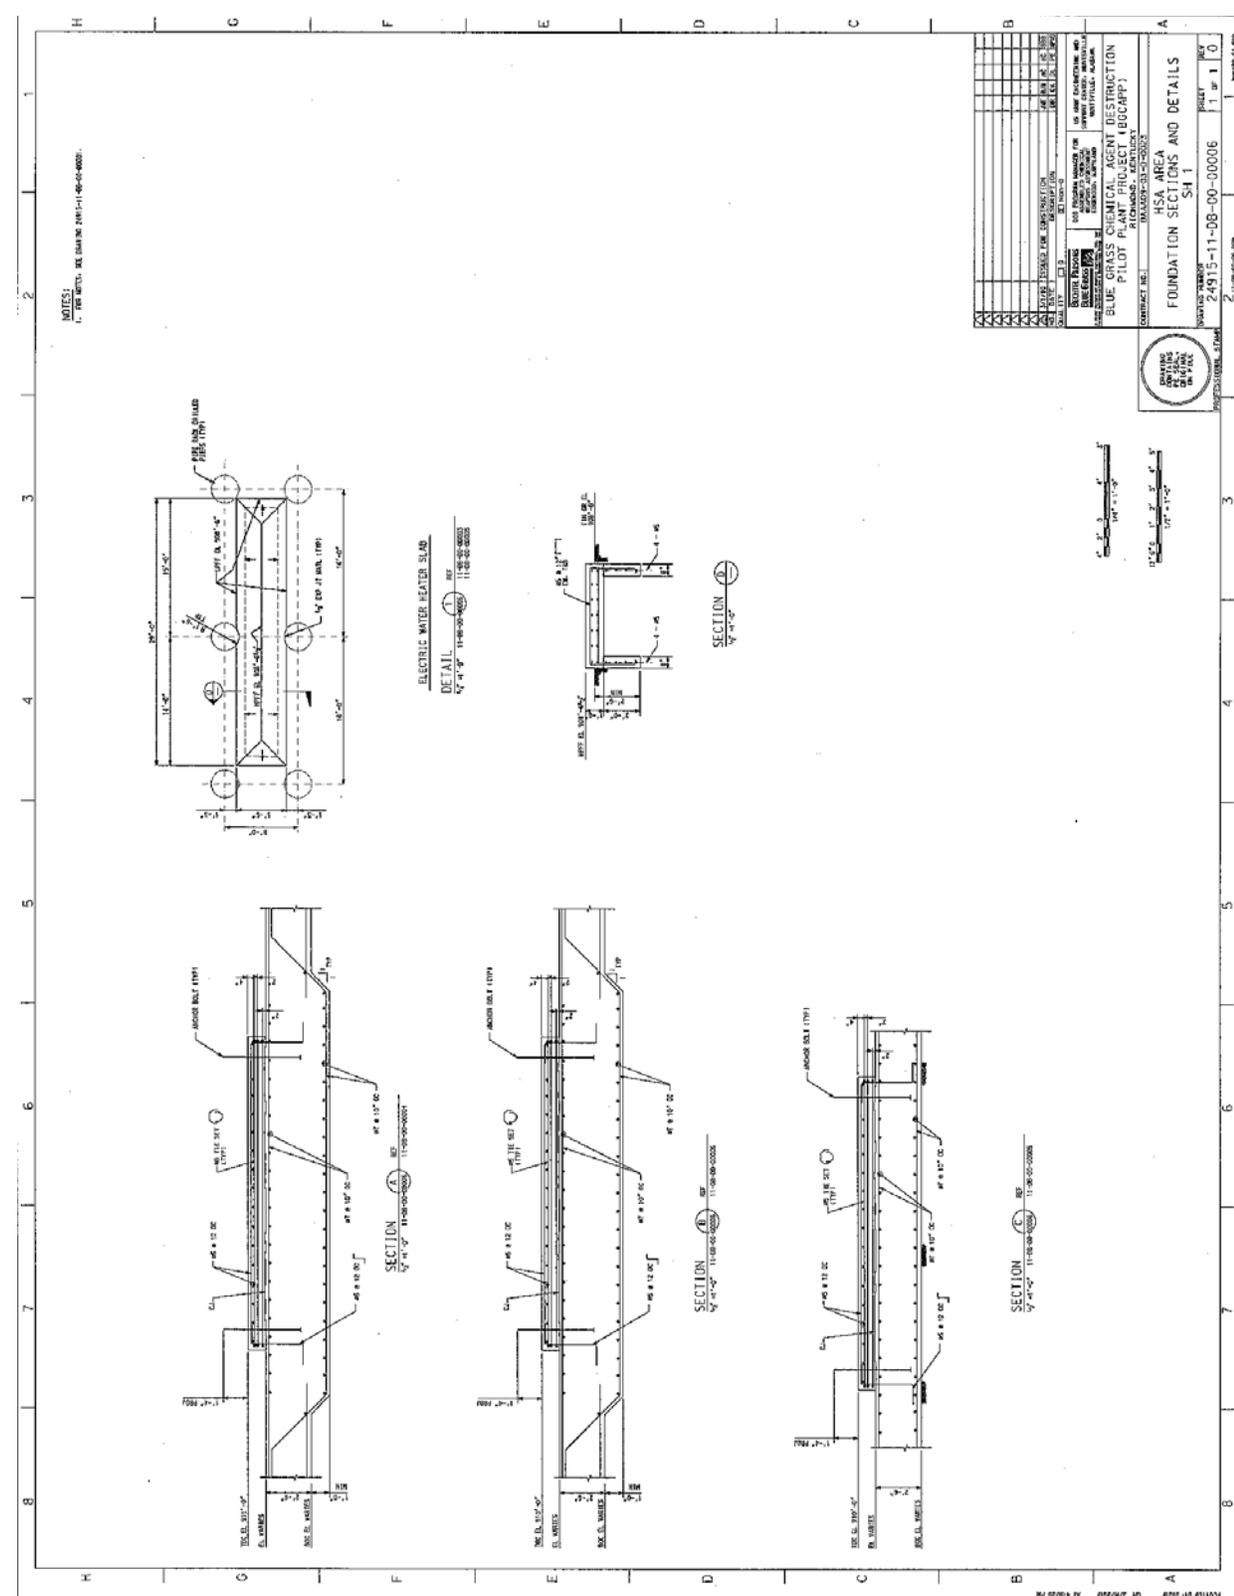

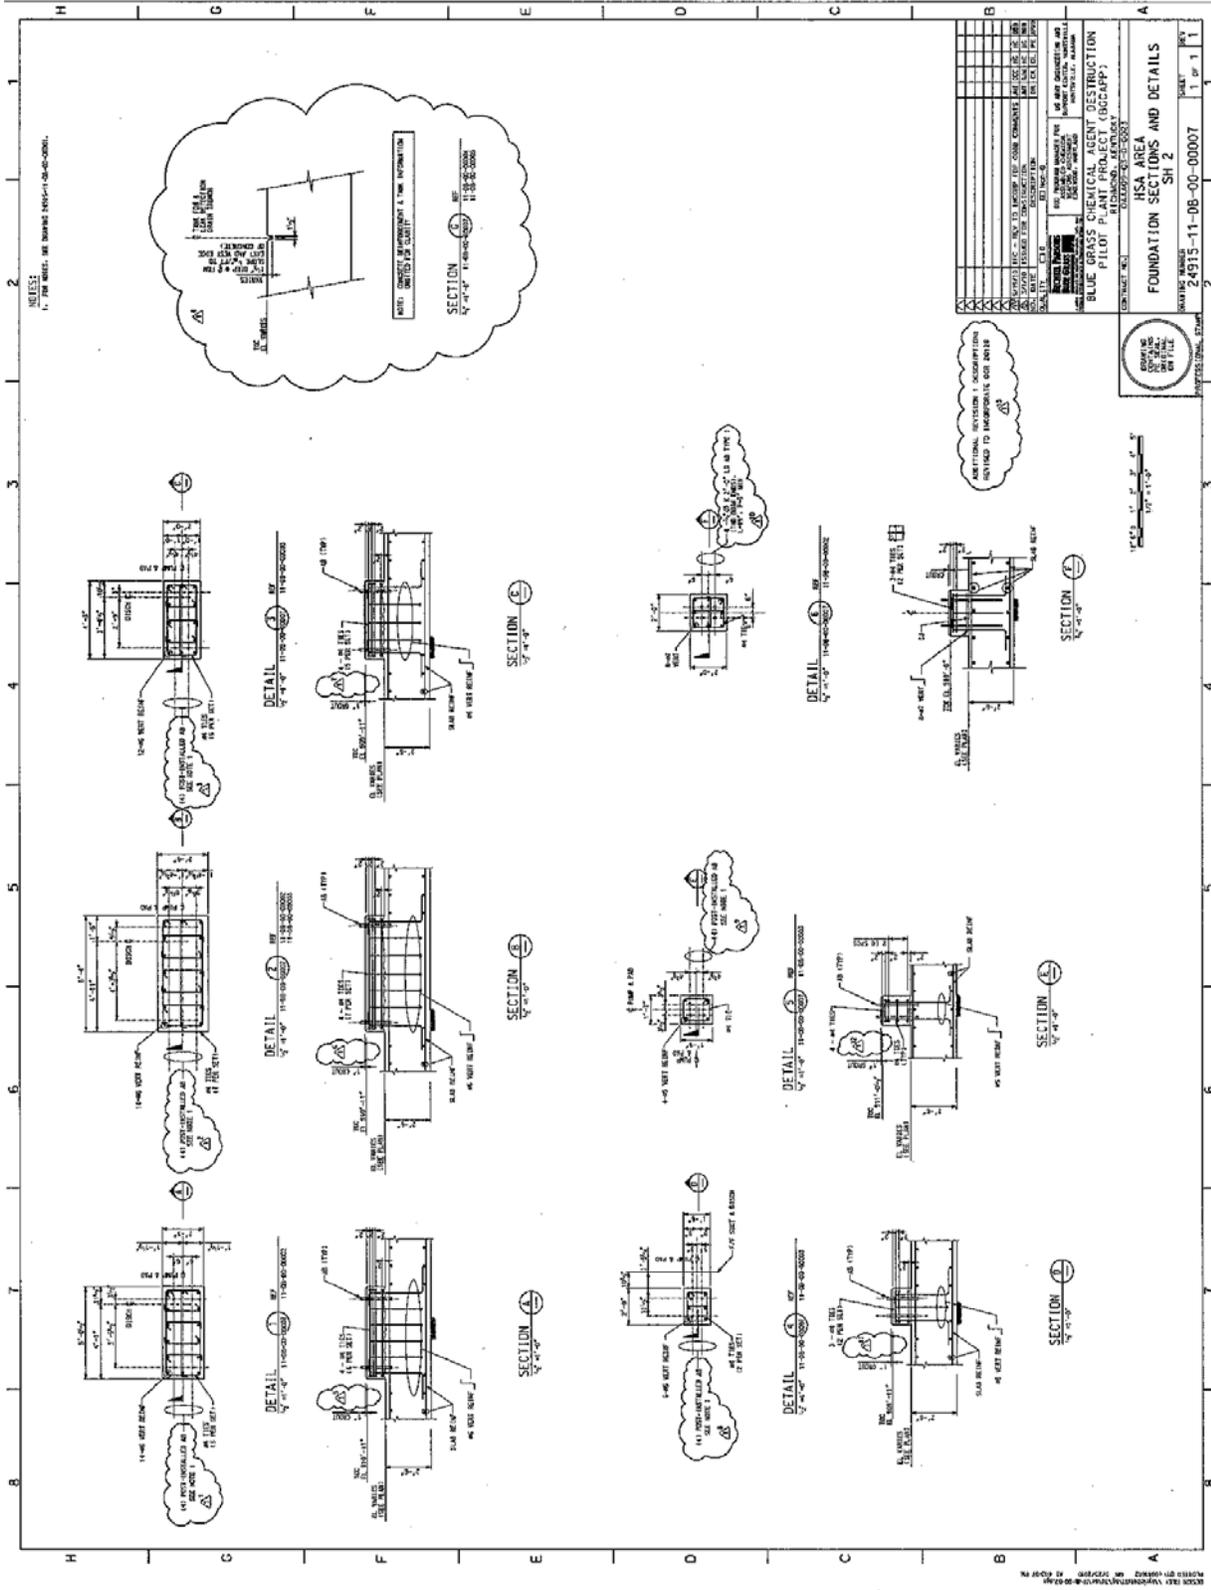

Project: BGCAPP
 Job Number: 743341
 Calc. No. 24915-11-DBC-00-00002
 Sheet No. C12 of C16
 Sheet Rev. C

Subject: HSA Mat Foundation Containment Capacity Evaluation
 By: AFR Date: 7/03/2012

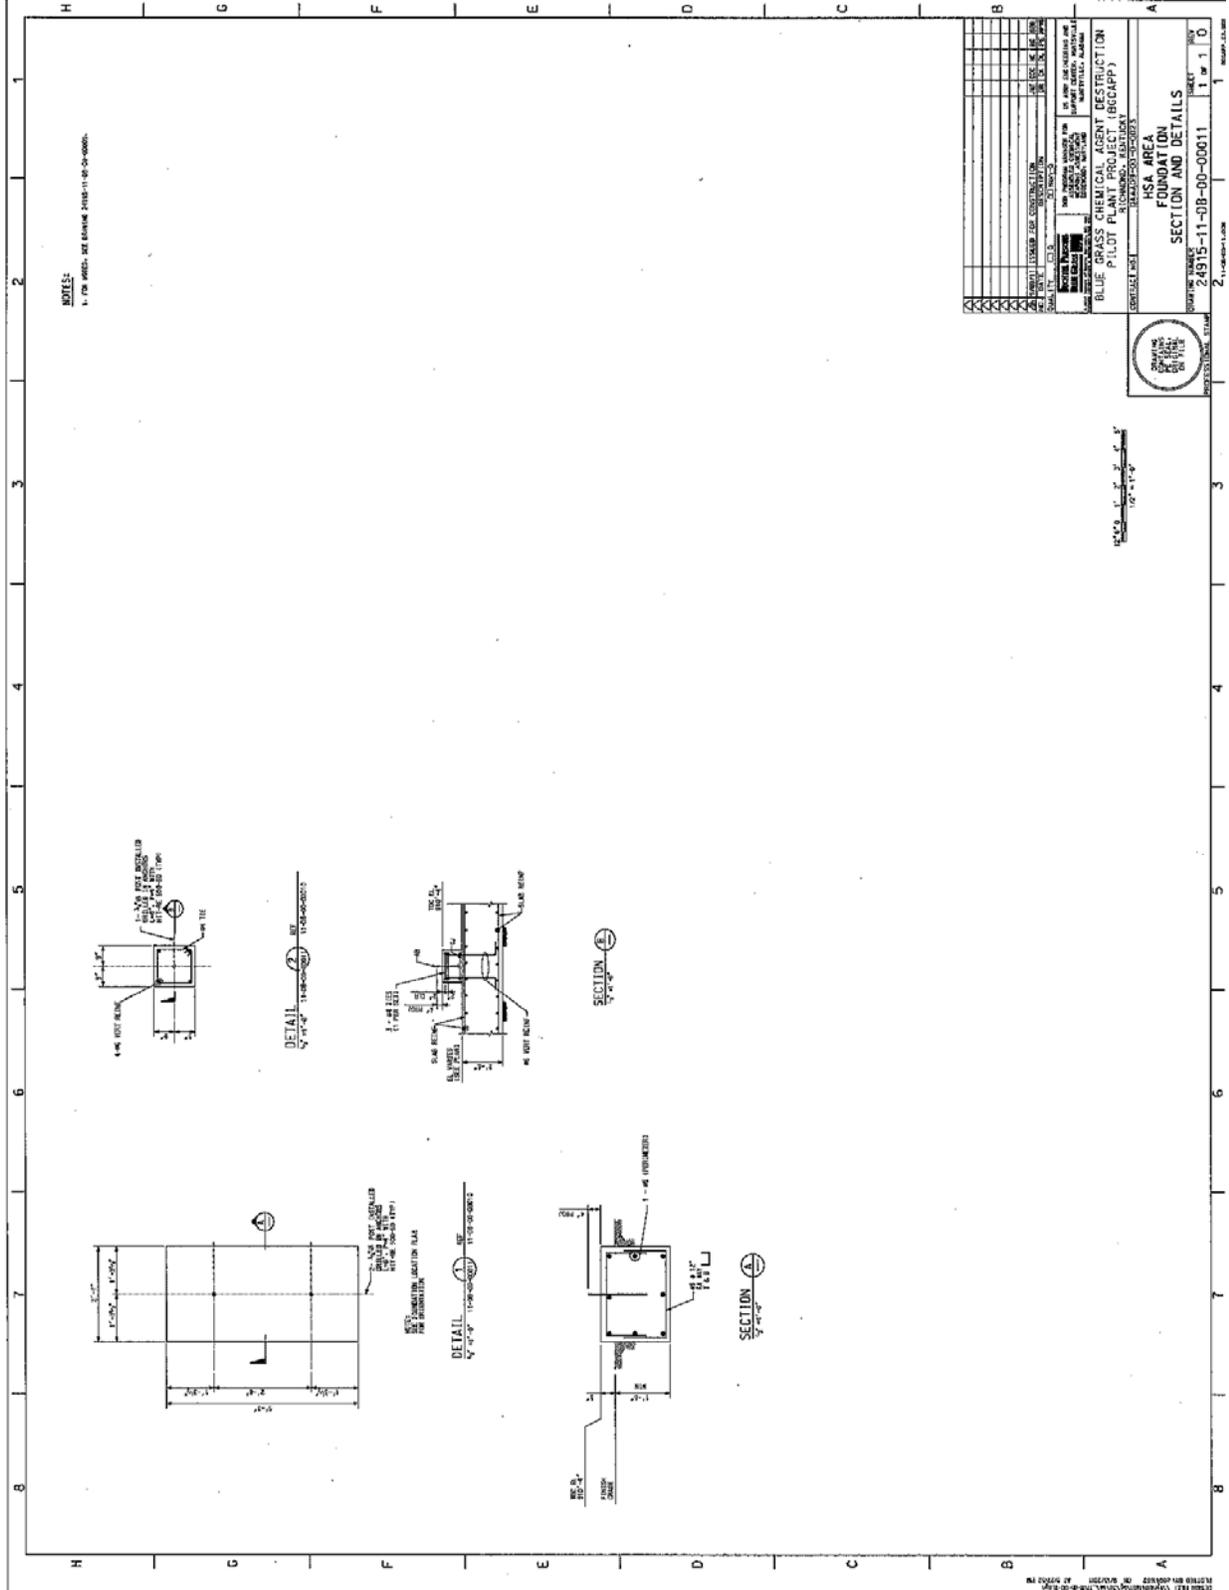



A Joint Venture of Bechtel National, Inc. and Parsons Infrastructure & Technology Group, Inc.

Calculation Sheet

Project: BGCAPP
 Job Number: 743341
 Calc. No. 24915-11-DBC-00-00002
 Sheet No. C13 of C16
 Sheet Rev. C

Subject: HSA Mat Foundation Containment Capacity Evaluation
 By: AFR Date: 7/03/2012

DCN-260 (Extract)

Description of change:

Tag Number	Vendor Submittal	CHANGE TO:		Structural Calculations	CURRENT:		
		Vendor Dwg. Pad Size (LxW, ftxft)			Structural Dwg. Pad Size (LxW, ftxft)		
		L (in)	W (in)		L (in)	W (in)	
10-MP-APS-0103A	24915-000-V1A-MPP0-00018	36	12	24915-10-DB-00-00006	18	16	
10-MP-APS-0103B		36	12		18	16	
10-MP-APS-0103C		36	12		18	16	
10-MP-APS-0104A	24915-000-V1A-MPP0-00016	56	36		18	16	
10-MP-APS-0104B		56	36		18	16	
10-MP-APS-0104C		56	36		18	16	
10-MP-APS-0105A	24915-000-V1A-MPP0-00019	36	12		18	16	
10-MP-APS-0105B		36	12		18	16	
10-MP-APS-0105C		36	12		18	16	
10-MP-RO-0114A	24915-000-V1A-MPP0-00020	28	12		24915-10-DB-00-00019	18	18
10-MP-RO-0114B		28	12			18	18
11-MP-HSS-0104A	24915-000-V1A-MPP0-00017	36	12		24915-11-DB-00-00003/7	24	18
11-MP-HSS-0104B		36	12	24		18	
11-MP-HSS-0105A		36	12	24		18	
11-MP-HSS-0105B		36	12	24		18	
11-MP-HSS-0205A		36	12	24		18	
11-MP-HSS-0205B		36	12	24		18	

Pump Pads will be modified to accommodate the baseplate dimensional changes in table above from vendor submittals.

DCN 228 shall be superseded based on these new vendor dimensions for SPB and HSS pumps.


Concrete foundation modification sketch is attached to show how construction will proceed in modifying the existing concrete foundation based on new vendor information as described above.

The vendor submittals (see table above for list) are Code Status 1 (i.e. as shown in Appendix A).

Originator: <i>[Signature]</i>	Checked By: <i>[Signature]</i>	Discipline Lead: <i>[Signature]</i>	FDM / REM: <i>[Signature]</i>	Date: <i>11/2/2012</i>
<input type="checkbox"/> Mechan'/Process:	<input checked="" type="checkbox"/> Plant Design:	<input type="checkbox"/> Electrical:	<input type="checkbox"/> Operations:	
<input checked="" type="checkbox"/> Civil/Struct/Arch:	<input type="checkbox"/> Control Sys:	<input type="checkbox"/> Environ:	<input type="checkbox"/> Safety:	
<input type="checkbox"/>	<input type="checkbox"/>	<input type="checkbox"/>	<input type="checkbox"/> Gov't/COE:	
CCB Approval Required: Yes <input type="checkbox"/> No <input checked="" type="checkbox"/>				
BCR Reference Number:		Disposition Requested By (date):		
<input type="checkbox"/> CCB Approved <input type="checkbox"/> CCB Approved with Comments <input type="checkbox"/> CCB Disapproved				
CCB:			Date:	

C

DCN-438 (Extract)

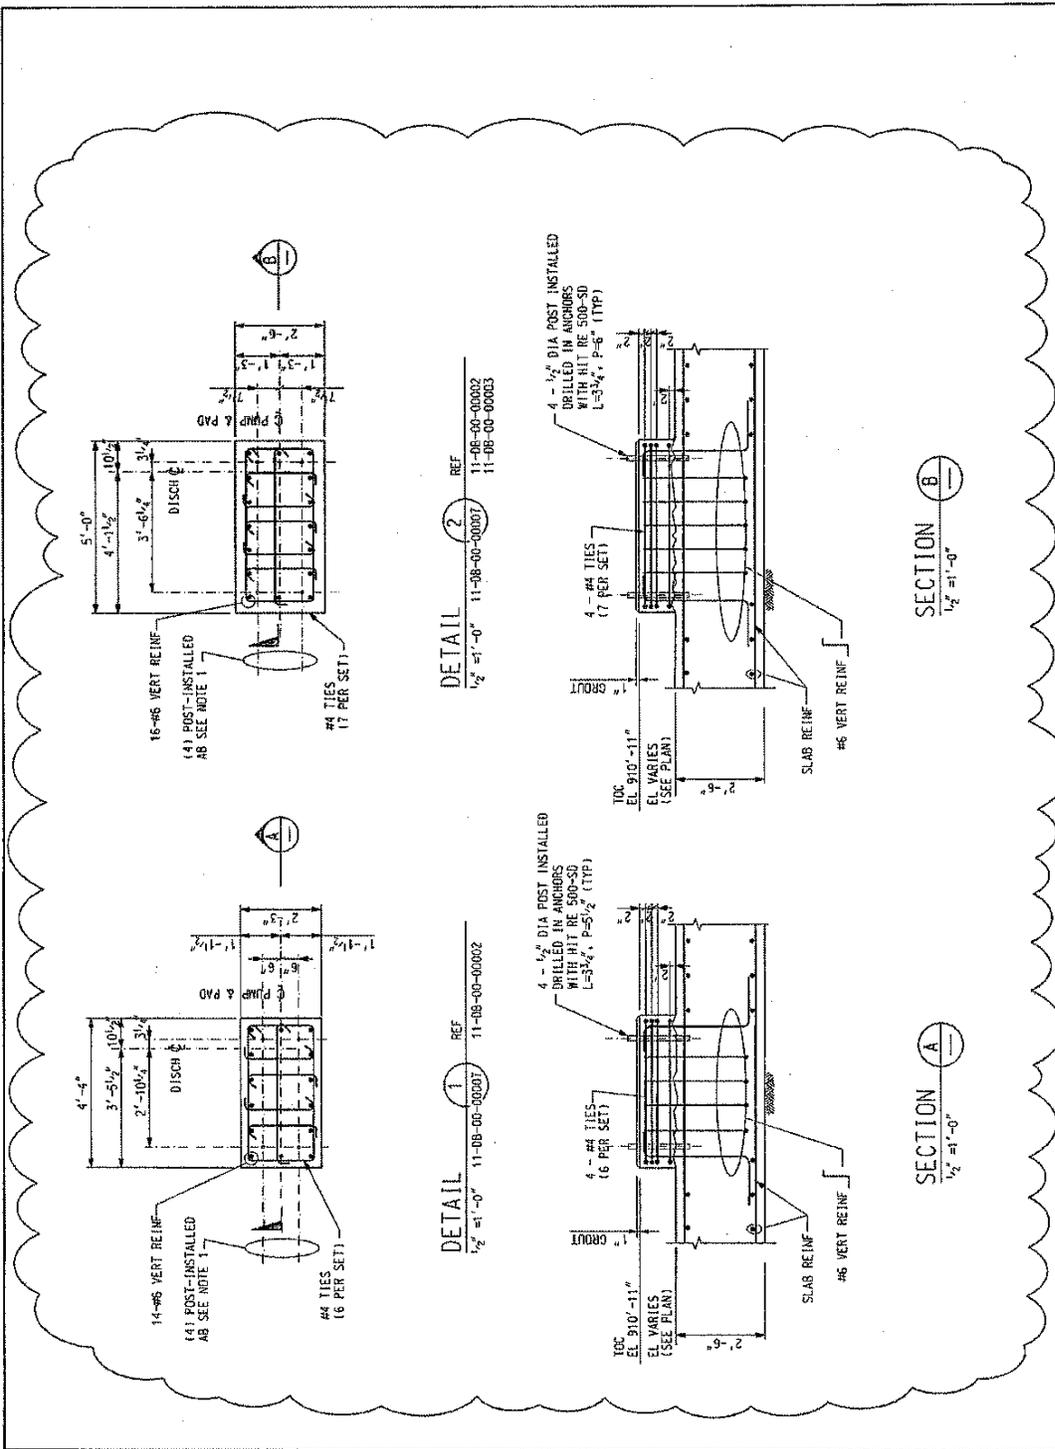

CONTRACT NO.	DAAA09-03-D-0023
DCN No.:	24915-00-3DE-001-00438
REFERENCE DRAWING	
REV	PAGE
24915-11-DB-00-00007	1
	9 of 20

HSA AREA
FOUNDATION SECTIONS AND DETAILS
SH 2


US ARMY ENGINEERING AND
SUPPORT CENTER, HUNTSVILLE
HUNTSVILLE, ALABAMA

OOD PROGRAM MANAGER FOR
ASSEMBLED CHEMICAL
WEAPONS ASSESSMENT
EDGEWOOD, MARYLAND



BGCAPP_E3-RICK.BRR

PROJECT FILE: \\ARMY\HSD\BGCAPP\743341\11-DB-00-0023.dwg
PLOTTER BY: ESM/MSZ ON 07/27/11 AT 03:15 AM

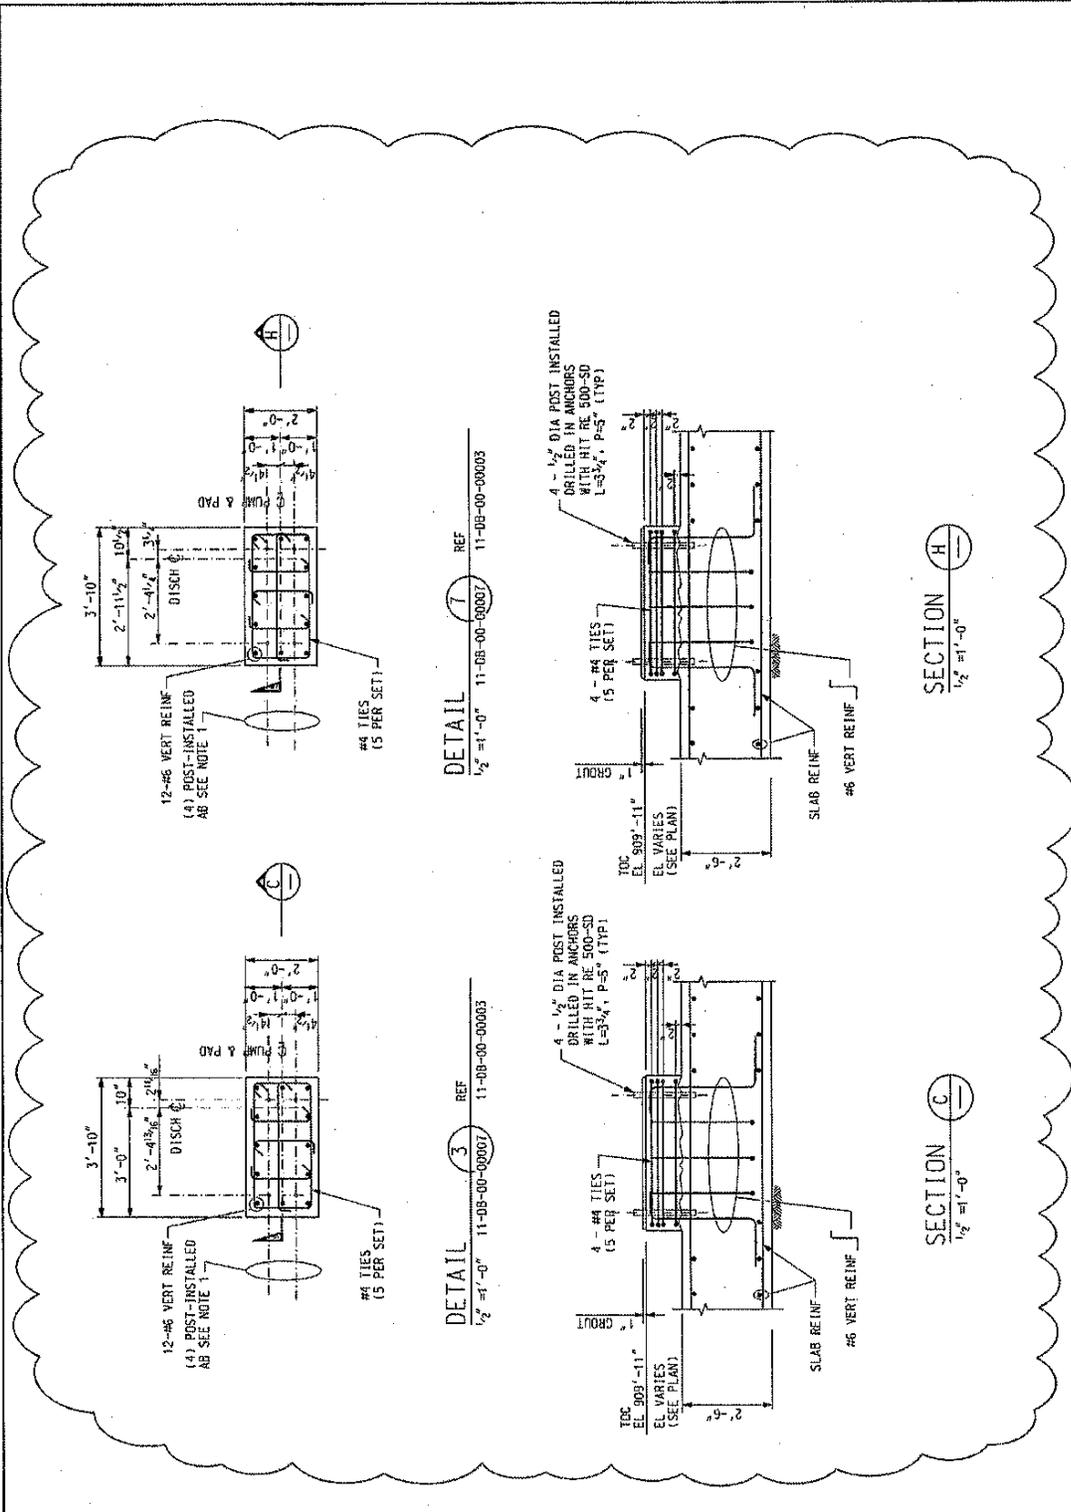

CONTRACT NO.	DAAA09-03-D-0023
DCN NO.	24915-00-30E-G01-00438
REFERENCE DRAWING	REV PAGE
	24915-11-DB-00-00007 1 10 of 20

HSA AREA
FOUNDATION SECTIONS AND DETAILS
SH 2

US ARMY ENGINEERING AND
SUPPORT CENTER, HUNTSVILLE
HUNTSVILLE, ALABAMA

DDD PROGRAM MANAGER FOR
EDGEWOOD, MARYLAND




BGCAPP-E3-GEN-B08

PRINTED BY: 0001862 ON 07/27/2012 AT 09:43:33 AM
DESIGN FILE: W:\BCH\11\BGCAPP\11-DB-00-00002

This document has been reviewed for ITAR/EAR and no ITAR/EAR sensitive information was found. 17 Dec 2013

This document has been reviewed for OPSEC material, and none was found. 17 Dec 2013

- GENERAL NOTES:
- FOR SYMBOLS AND LEGEND, SEE DRAWINGS 24915-00-M6-00-00010 THRU 00015.
 - DRAWING NUMBERS IN OFF-PAGE CONNECTORS ARE TRUNCATED BY SUPPRESSING PROJECT NUMBER "24915" AND DOCUMENTS TYPE "M6". TWO LEADING ZEROS IN SEQUENCE NUMBER ARE NOT SHOWN.
 - ALL EQUIPMENT NUMBERS, INSTRUMENT TAG NUMBERS AND VALVE NUMBERS ARE PREFIXED "11" UNLESS OTHERWISE NOTED.
 - LOCATE VENDOR FURNISHED PULSATION DAMPENER MINIMUM DISTANCE FROM PUMP DISCHARGE NOZZLE.
 - DELETED.
 - THE ORGANIC AND AQUEOUS AGENT HYDROLYSATE PUMPS (ONE OPERATING AND ONE SPARE EACH) SHALL BE DESIGNED TO PROVIDE THE FOLLOWING:
 - A) DELETED
 - B) STOP PUMPS IF INLET TO BLEND TANK IS SHUT OFF
 - C) DELETED
 - D) THE ORGANIC HYDROLYSATE PUMP FLOWRATE IS SET PROPORTIONAL TO THE AQUEOUS HYDROLYSATE BLEND TANK DELIVERY AT 1% TO 5% RATIO.
 - SUMP IS A SINGLE WALL SUMP.
 - COVER SUMP WITH SCREEN TO MINIMIZE SOLID ACCUMULATION.
 - * FURNISHED BY PUMP MANUFACTURER.
 - DELETED.
 - SUMP PUMPOUT IS MANUAL START ONLY. SUMP CONTENTS TO BE SAMPLED PRIOR TO PUMPOUT.
 - PROVIDE ELECTRIC TRACING TO MAINTAIN A MINIMUM TEMPERATURE OF 40°F AND INSULATION FOR FREEZE PROTECTION OF THE HORIZONTAL PORTION OF THE SUCTION PIPING, AND ALL THE DISCHARGE PIPING.
 - FCS INTERLOCK NUMBERS ARE PREFIXED WITH "11-HSS-".
 - PCV SET POINT BASED ON VENDOR INFORMATION. FINAL PCV SET POINT TO BE DETERMINED IN FIELD.
 - IF THE PUMP DISCHARGE PRESSURE FALLS BELOW LOW LOW PRESSURE FOR MORE THAN "1" SECOND WHILE THE "LEAD" PUMP IS RUNNING, THE "STANDBY" PUMP WILL AUTOMATICALLY START. IF PRESSURE DOES NOT RETURN TO NORMAL WITHIN "5" SECONDS, BOTH THE "LEAD" AND STANDBY PUMPS WILL STOP. ONCE THE STANDBY PUMP HAS STARTED AND PRESSURE RETURNS TO NORMAL WITHIN "10" SECONDS, THE "LEAD" PUMP WILL STOP. IF THE "LEAD" PUMP BECOMES DEENERGIZED, THE "STANDBY" PUMP WILL AUTOMATICALLY START, WITHOUT WAITING FOR THE PRESSURE TO FALL BELOW NORMAL.

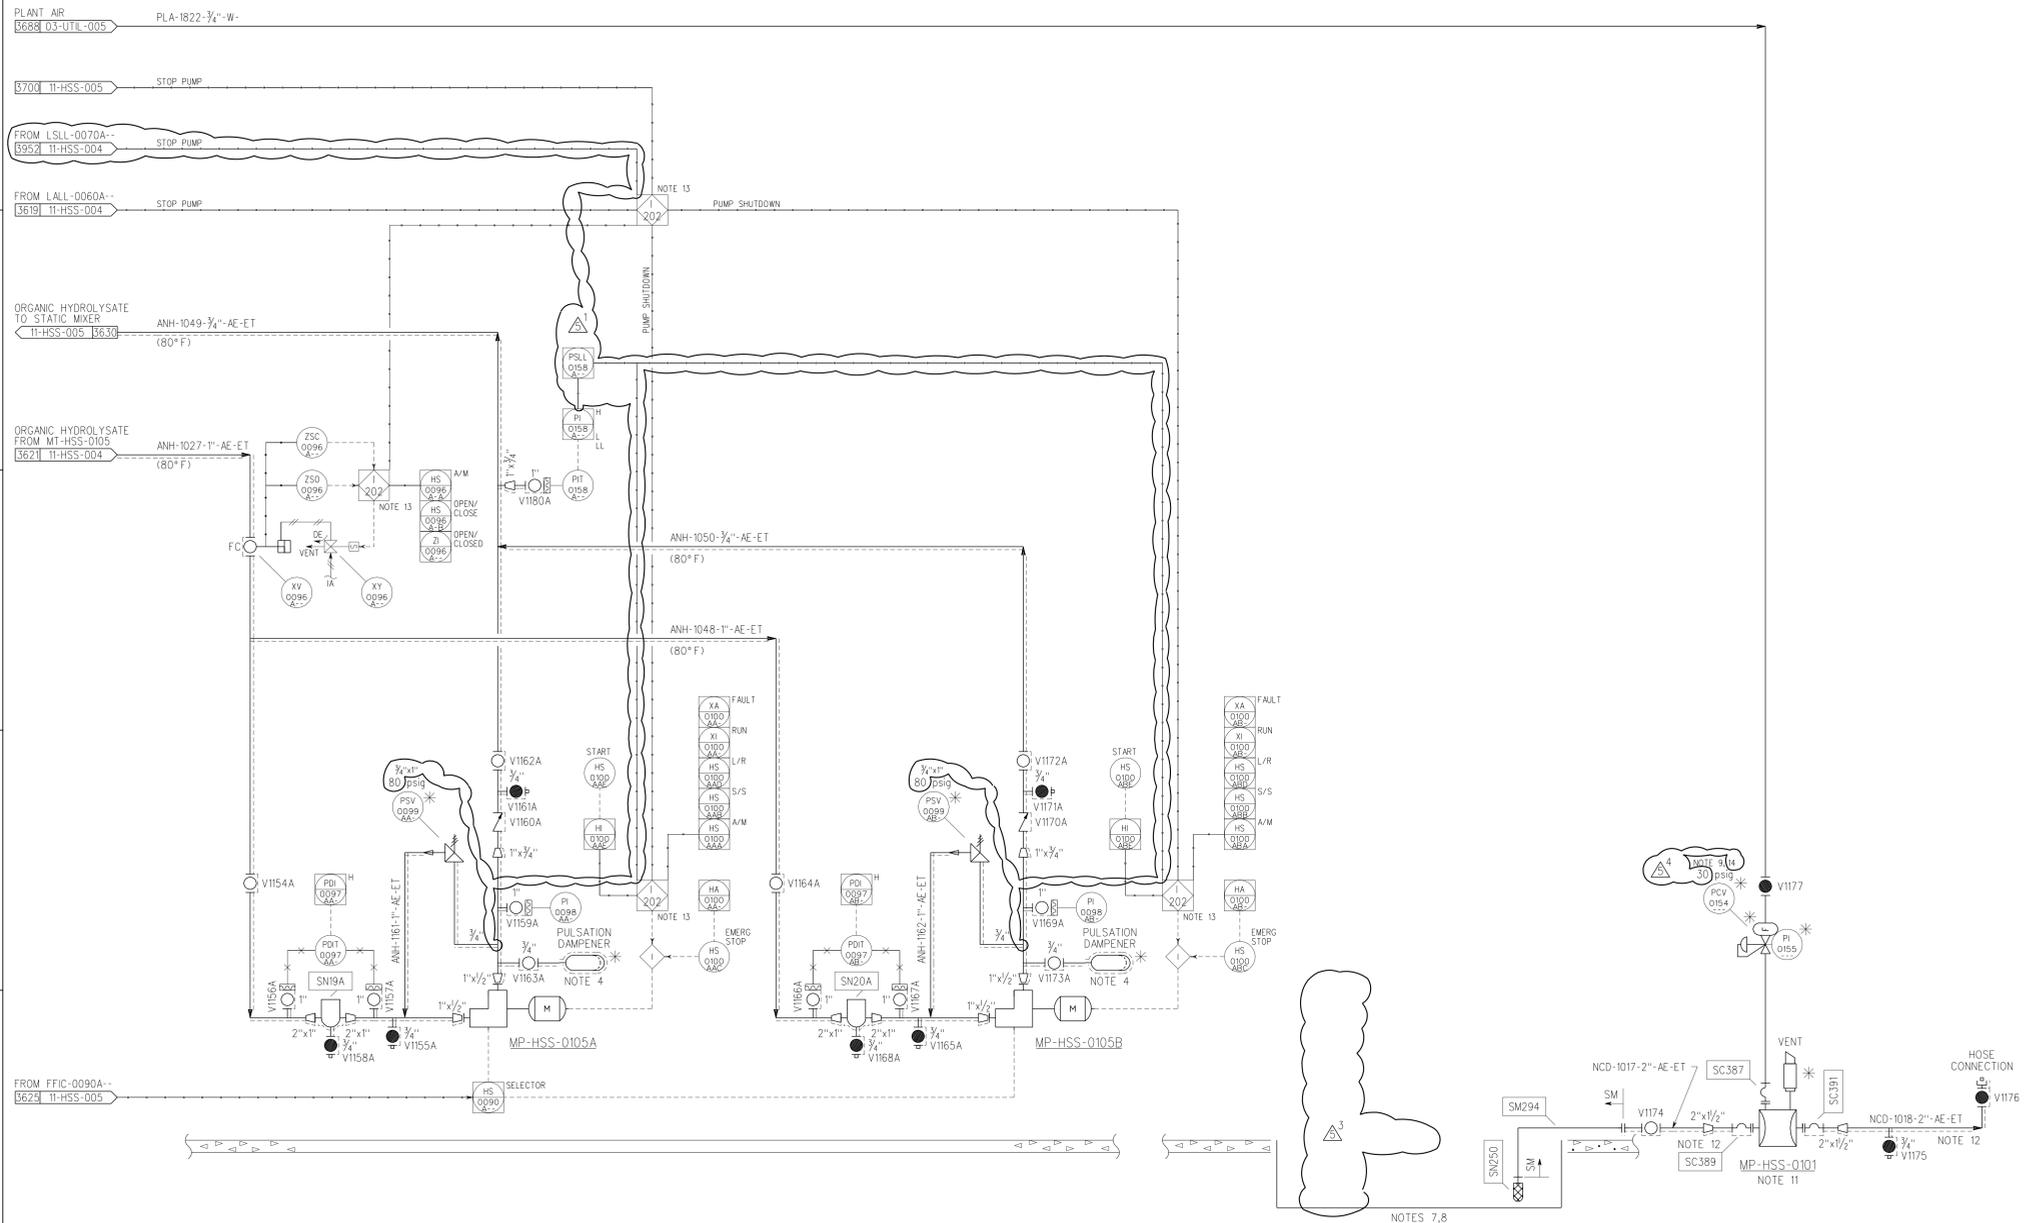

MP-HSS-0105A
ORGANIC HYDROLYSATE PUMP
RATED FLOW : 1.2 GPM
RATED DELTA P : 62.5 PSI
MOTOR HP : 1.0 HP
MATERIAL OF CONST : 316 SS

MP-HSS-0105B
ORGANIC HYDROLYSATE PUMP (SPARE)
RATED FLOW : 1.2 GPM
RATED DELTA P : 62.5 PSI
MOTOR HP : 1.0 HP
MATERIAL OF CONST : 316 SS

MP-HSS-0101
AGT HYDROLYSATE TANK AREA SUMP PUMP
RATED FLOW : 22 GPM
RATED DELTA P : 24.2 PSI
MATERIAL OF CONST : 316 SS

BASED ON BLUE GRASS PFD 24915-11-M6-HSS-00001 REV.5
BASED ON BLUE GRASS MSD 24915-11-NO-HSS-00001 REV.2

REFERENCE DRAWINGS

NO.	DATE	DESCRIPTION	DR	CK	DL	PE	APVD
53	05/23/12	IFC, INCORPORATED DCN-530, -673, -735, -745, -790	JDC	SC	SA	KMR	KMR
41	04/29/11	IFC, REVISED PUMP NOZZLES & MATERIAL PER VENDOR	BM	PEB	SA	BBB	BBB
31	12/15/09	IFC, GC 9838	JLL	PEB	SA	BBB	BBB
23	02/16/09	IFC, REVISED PMP DIFF HEAD, SPECIALTY NO, ADD REDUCER	JLL	PEB	BM	BBB	BBB
19	12/20/07	IFC, CORRECTED INSTRUMENTATION, ADDED I-NO'S	CGD	JLL	PEB	JB	BBB
16	11/26/07	ISSUED FOR DESIGN (IFD)	CGD	JLL	PEB	JB	BBB

BECHTEL PARSONS BLUE GRASS
DOD PROGRAM MANAGER FOR ASSEMBLED CHEMICAL WEAPONS ASSESSMENT EDgewood, MARYLAND
US ARMY ENGINEERING AND SUPPORT CENTER, HUNTSVILLE, ALABAMA

BLUE GRASS CHEMICAL AGENT DESTRUCTION PILOT PLANT PROJECT (BCAPP)
RICHMOND, KENTUCKY
DAAA09-03-D-0023

HYDROLYSATE STORAGE AREA
ORG HYDRO PUMPS & SUMP PUMP TR-1
PIPING & INSTRUMENT DIAGRAM

DRAWING NUMBER: 24915-11-M6-HSS-00006
SHEET: 1 OF 1
REV: 5



05/31/12
 TMHSS0006.ppt
 DESIGN FILE: DONSPEC
 PLOTTED BY: USER ON DATE: 5/31/12 8:00:14 AM


This document has been reviewed for ITAR/EAR and no ITAR/EAR sensitive information was found.
17 Dec 2013

This document has been reviewed for OPSEC material, and none was found.
17 Dec 2013

This document has been reviewed for ITAR/EAR and no ITAR/EAR sensitive information was found.
17 Dec 2013

This document has been reviewed for OPSEC material, and none was found.
17 Dec 2013

- GENERAL NOTES:
- FOR SYMBOLS AND LEGEND, SEE DRAWINGS 24915-00-M6-00-00010 THRU 00015.
 - DRAWING NUMBERS IN OFF-PAGE CONNECTORS ARE TRUNCATED BY SUPPRESSING PROJECT NUMBER "24915" AND DOCUMENTS TYPE "M6". TWO LEADING ZEROS IN SEQUENCE NUMBER ARE NOT SHOWN.
 - ALL EQUIPMENT NUMBERS, INSTRUMENT TAG NUMBERS AND VALVE NUMBERS ARE PREFIXED "11" UNLESS OTHERWISE NOTED.
 - LOCATE VENDOR FURNISHED PULSATION DAMPENER MINIMUM DISTANCE FROM PUMP DISCHARGE NOZZLE.
 - DELETED.
 - THE ORGANIC AND AQUEOUS AGENT HYDROLYSATE PUMPS (ONE OPERATING AND ONE SPARE EACH) SHALL BE DESIGNED TO PROVIDE THE FOLLOWING:
 - A) DELETED
 - B) STOP PUMPS IF INLET TO BLEND TANK IS SHUT OFF
 - C) DELETED
 - D) THE ORGANIC HYDROLYSATE PUMP FLOWRATE IS SET PROPORTIONAL TO THE AQUEOUS HYDROLYSATE BLEND TANK DELIVERY AT 1% TO 5% RATIO.
 - DELETED.
 - DELETED.
 - * FURNISHED BY PUMP MANUFACTURER.
 - DELETED.
 - DELETED.
 - DELETED.
 - FCS INTERLOCK NUMBERS ARE PREFIXED WITH "11-HSS-".
 - IF THE PUMP DISCHARGE PRESSURE FALLS BELOW LOW LOW PRESSURE FOR MORE THAN "1" SECOND WHILE THE "LEAD" PUMP IS RUNNING, THE "STANDBY" PUMP WILL AUTOMATICALLY START. IF PRESSURE DOES NOT RETURN TO NORMAL WITHIN "5" SECONDS, BOTH THE "LEAD" AND "STANDBY" PUMPS WILL STOP. ONCE THE "STANDBY" PUMP HAS STARTED AND PRESSURE RETURNS TO NORMAL WITHIN "10" SECONDS, THE "LEAD" PUMP WILL STOP. IF THE "LEAD" PUMP BECOMES DEENERGIZED, THE "STANDBY" PUMP WILL AUTOMATICALLY START, WITHOUT WAITING FOR THE PRESSURE TO FALL BELOW NORMAL.

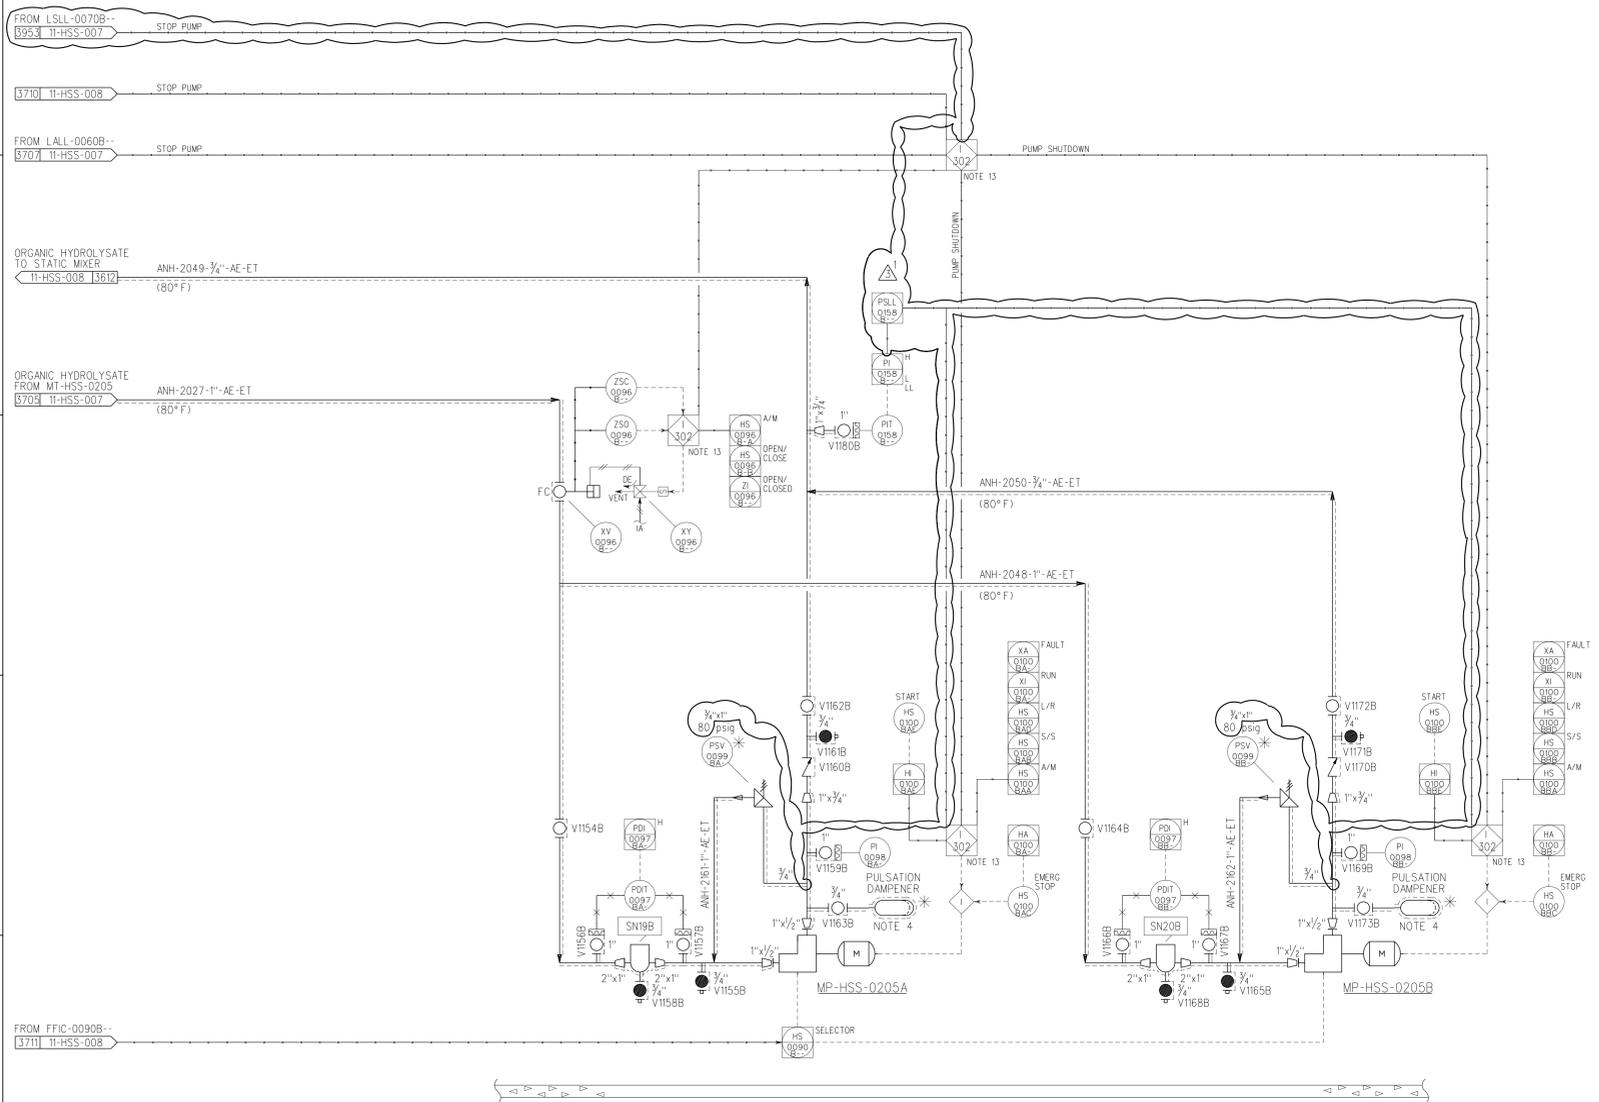

MP-HSS-0205A
ORGANIC HYDROLYSATE PUMP
RATED FLOW : 1.2 GPM
RATED DELTA P : 62.5 PSI
MOTOR HP : 1.0 HP
MATERIAL OF CONST : 316 SS

MP-HSS-0205B
ORGANIC HYDROLYSATE PUMP (SPARE)
RATED FLOW : 1.2 GPM
RATED DELTA P : 62.5 PSI
MOTOR HP : 1.0 HP
MATERIAL OF CONST : 316 SS

BASED ON BLUE GRASS PFD 24915-11-M6-HSS-00001 REV.5
BASED ON BLUE GRASS MSD 24915-11-NO-HSS-00001 REV.2
REFERENCE DRAWINGS

05/23/12	IFC, INCORPORATED DCN-673, -745, -790	JDC	SC	SA	KMR	KMR
04/29/11	IFC, REVISED PUMP NOZZLES & MATERIAL PER VENDOR	BM	PEB	SA	BBB	BBB
02/16/09	IFC, ADD REDUCER	JLL	PEB	BM	BBB	BBB
12/28/07	ISSUED FOR CONSTRUCTION (IFC)	CGD	JP	PEB	JB	BBB
NO. DATE	DESCRIPTION	DR	CK	DL	PE	APVD
QUALITY	<input type="checkbox"/> 0	<input checked="" type="checkbox"/> Non-0				

BECHTEL PARSONS A joint venture of Bechtel Corporation, Inc. and Parsons Infrastructure & Technology Group, Inc.	DOD PROGRAM MANAGER FOR ASSEMBLED CHEMICAL WEAPONS ASSESSMENT EDGWOOD, MARYLAND	US ARMY ENGINEERING AND SUPPORT CENTER, HUNTSVILLE HUNTSVILLE, ALABAMA
--	---	--


BLUE GRASS CHEMICAL AGENT DESTRUCTION PILOT PLANT PROJECT (BGCAPP)
RICHMOND, KENTUCKY
DAAA09-03-D-0023

HYDROLYSATE STORAGE AREA
ORGANIC HYDROLYSATE PUMPS TRAIN 2
PIPING & INSTRUMENT DIAGRAM

DRAWING NUMBER	SHEET	REV
24915-11-M6-HSS-00009	1 OF 1	3



05/29/12
 TMHSS009.dwg
 DESIGN FILE: DONSPEC
 PLOTTED BY: USER ON DATE: 5/29/12 3:50:37 PM

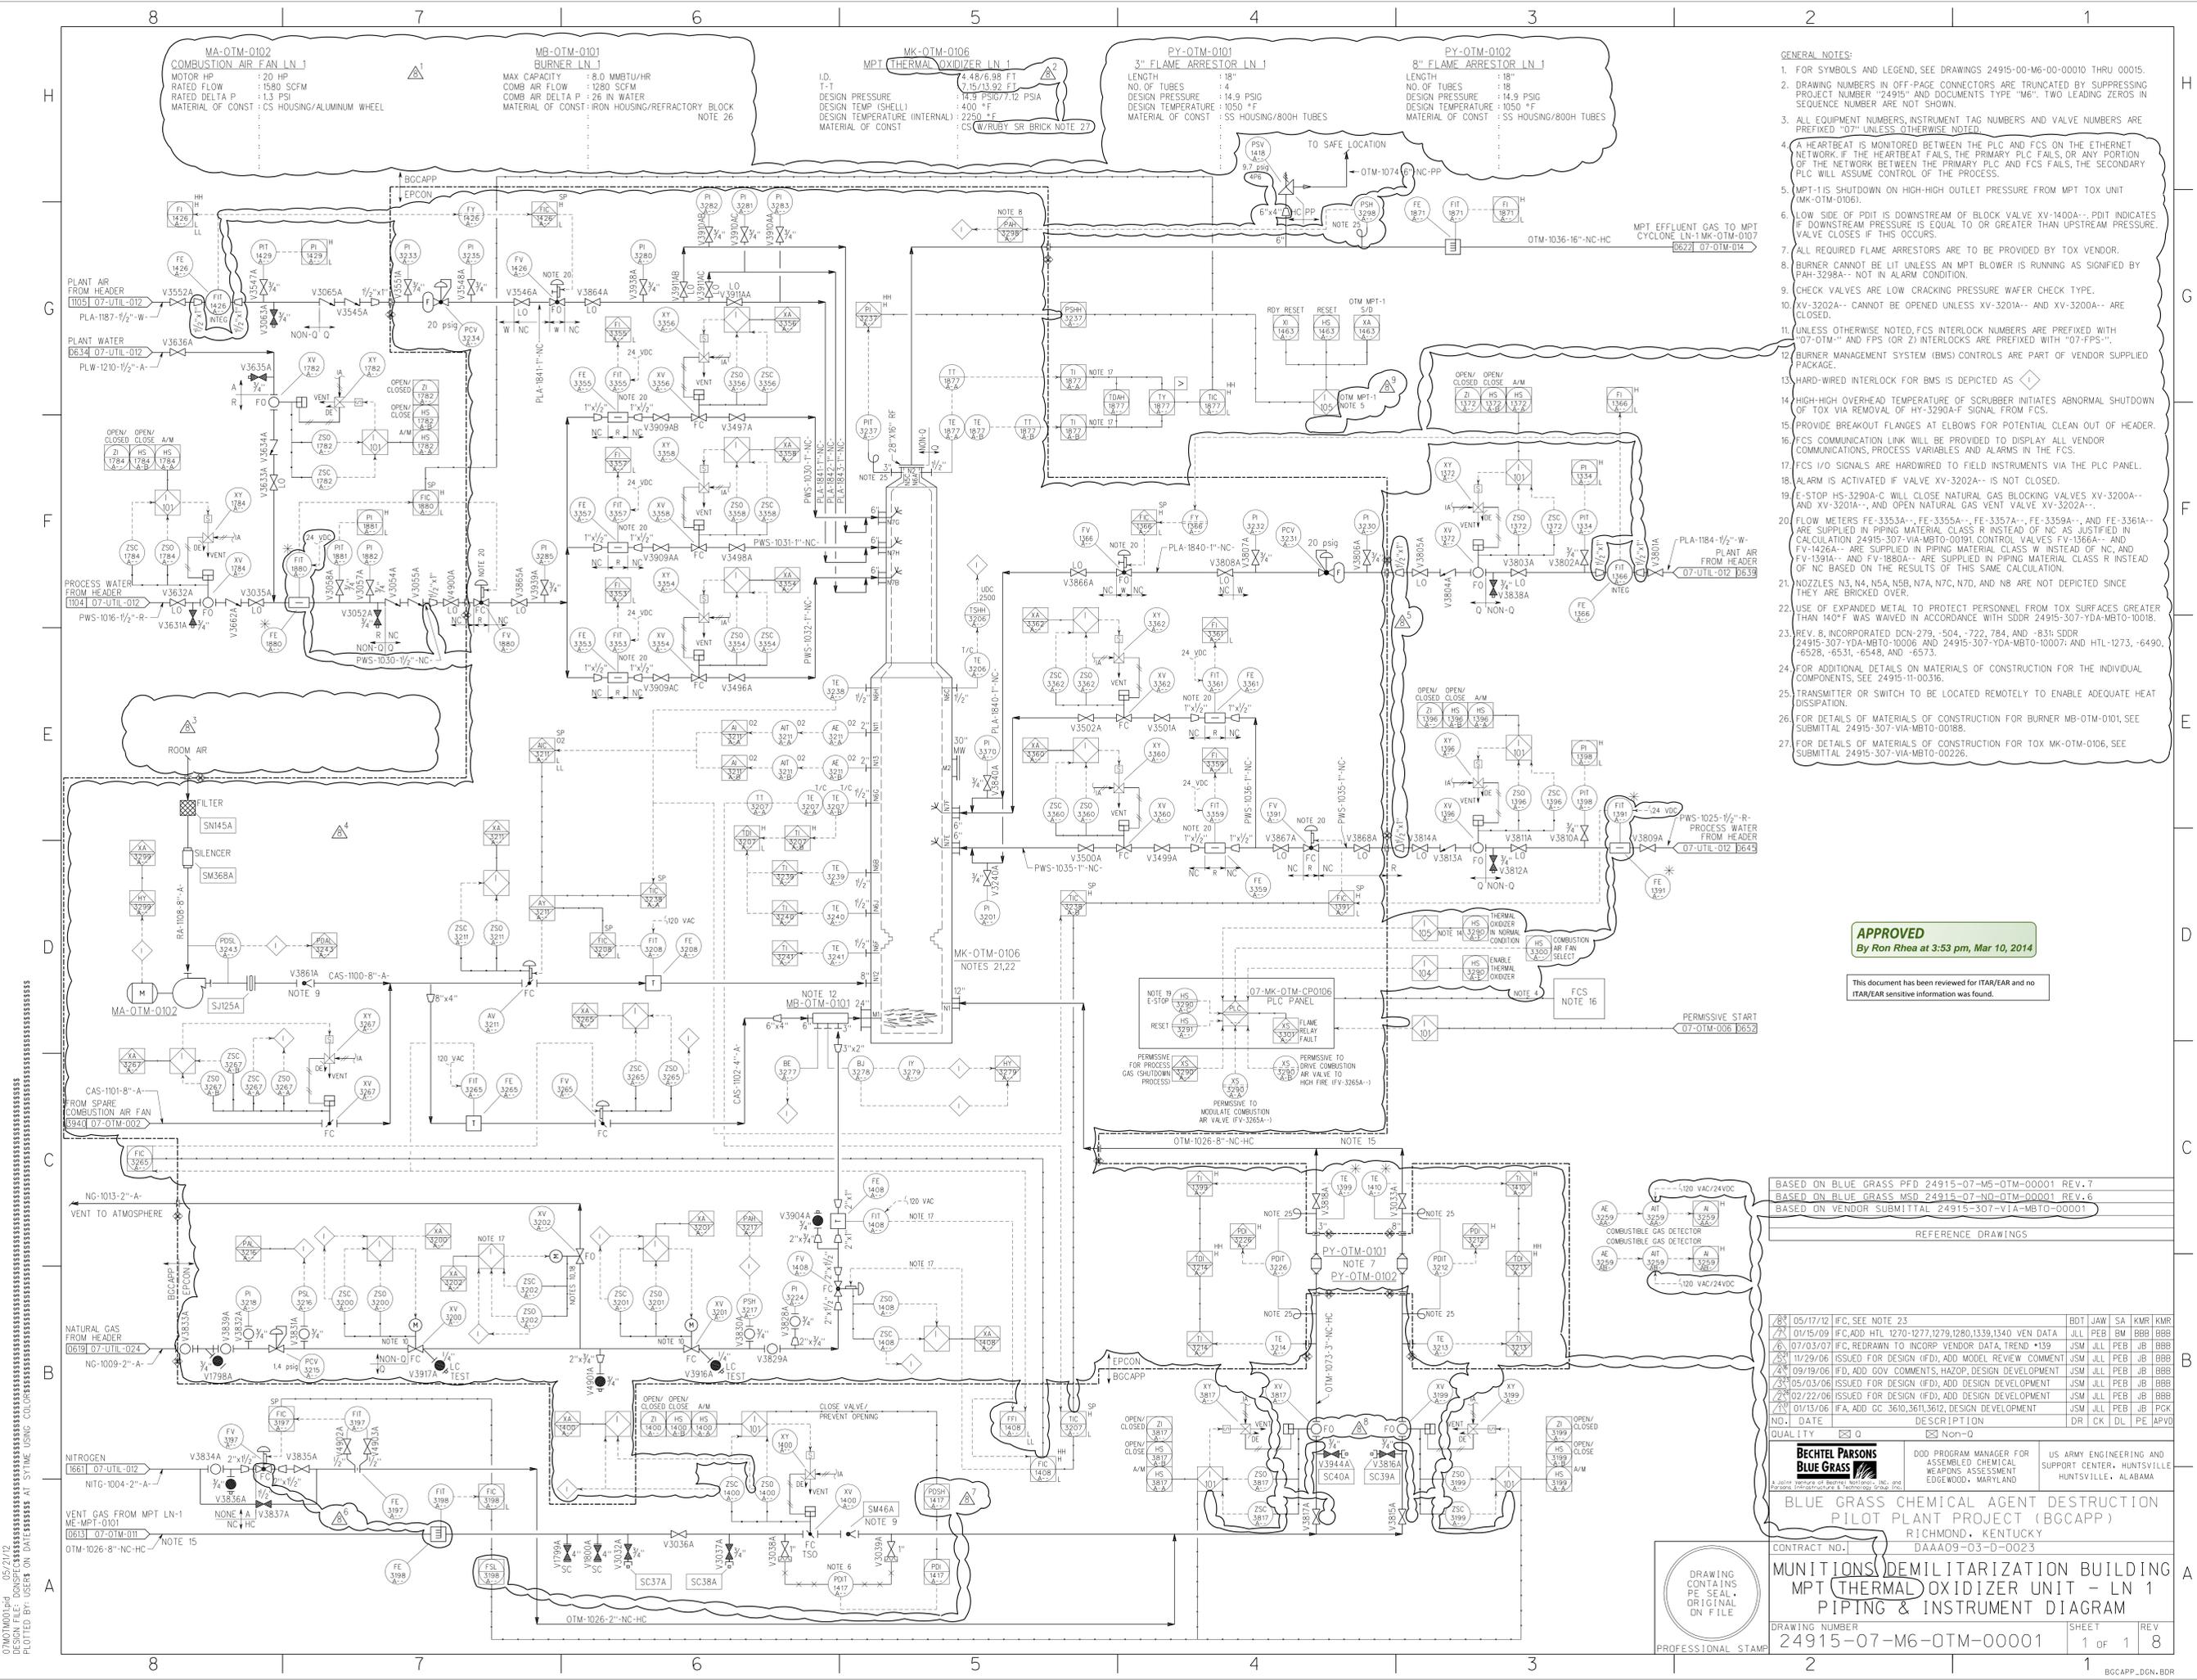

- GENERAL NOTES:
- FOR SYMBOLS AND LEGEND, SEE DRAWINGS 24915-00-M6-00-00010 THRU 00015.
 - DRAWING NUMBERS IN OFF-PAGE CONNECTORS ARE TRUNCATED BY SUPPRESSING PROJECT NUMBER "24915" AND DOCUMENTS TYPE "M6". TWO LEADING ZEROS IN SEQUENCE NUMBER ARE NOT SHOWN.
 - ALL EQUIPMENT NUMBERS, INSTRUMENT TAG NUMBERS AND VALVE NUMBERS ARE PREFIXED "07" UNLESS OTHERWISE NOTED.
 - A HEARTBEAT IS MONITORED BETWEEN THE PLC AND FCS ON THE ETHERNET NETWORK. IF THE HEARTBEAT FAILS, THE PRIMARY PLC FAILS, OR ANY PORTION OF THE NETWORK BETWEEN THE PRIMARY PLC AND FCS FAILS, THE SECONDARY PLC WILL ASSUME CONTROL OF THE PROCESS.
 - MPT-1 IS SHUTDOWN ON HIGH-HIGH OUTLET PRESSURE FROM MPT TOX UNIT (MK-OTM-0106).
 - LOW SIDE OF PDIT IS DOWNSTREAM OF BLOCK VALVE XV-1400A--. PDIT INDICATES IF DOWNSTREAM PRESSURE IS EQUAL TO OR GREATER THAN UPSTREAM PRESSURE. VALVE CLOSURE IS THIS OCCURS.
 - ALL REQUIRED FLAME ARRESTORS ARE TO BE PROVIDED BY TOX VENDOR.
 - BURNER CANNOT BE LIT UNLESS AN MPT BLOWER IS RUNNING AS SIGNIFIED BY PAH-3298A-- NOT IN ALARM CONDITION.
 - CHECK VALVES ARE LOW CRACKING PRESSURE WAIVER CHECK TYPE.
 - XV-3202A-- CANNOT BE OPENED UNLESS XV-3201A-- AND XV-3200A-- ARE CLOSED.
 - UNLESS OTHERWISE NOTED, FCS INTERLOCK NUMBERS ARE PREFIXED WITH "07-OTM" AND FFS (OR Z) INTERLOCKS ARE PREFIXED WITH "07-FFS".
 - BURNER MANAGEMENT SYSTEM (BMS) CONTROLS ARE PART OF VENDOR SUPPLIED PACKAGE.
 - HARD-WIRED INTERLOCK FOR BMS IS DEPICTED AS
 - HIGH-HIGH OVERHEAD TEMPERATURE OF SCRUBBER INITIATES ABNORMAL SHUTDOWN OF TOX VIA REMOVAL OF HY-3290A-F SIGNAL FROM FCS.
 - PROVIDE BREAKOUT FLANGES AT ELBOWS FOR POTENTIAL CLEAN OUT OF HEADER.
 - FCS COMMUNICATION LINK WILL BE PROVIDED TO DISPLAY ALL VENDOR COMMUNICATIONS, PROCESS VARIABLES AND ALARMS IN THE FCS.
 - FCS I/O SIGNALS ARE HARDWIRED TO FIELD INSTRUMENTS VIA THE PLC PANEL.
 - ALARM IS ACTIVATED IF VALVE XV-3202A-- IS NOT CLOSED.
 - STOP HS-3290A-C WILL CLOSE NATURAL GAS BLOCKING VALVES XV-3200A-- AND XV-3201A--, AND OPEN NATURAL GAS VENT VALVE XV-3202A--.
 - FLOW METERS FE-3353A--, FE-3355A--, FE-3357A--, FE-3359A--, AND FE-3361A-- ARE SUPPLIED IN PIPING MATERIAL CLASS R INSTEAD OF NC AS JUSTIFIED IN CALCULATION 24915-307-VIA-MBTO-0091. CONTROL VALVES FV-1366A-- AND FV-1406A-- ARE SUPPLIED IN PIPING MATERIAL CLASS W INSTEAD OF NC, AND FV-1391A-- AND FV-1880A-- ARE SUPPLIED IN PIPING MATERIAL CLASS R INSTEAD OF NC BASED ON THE RESULTS OF THIS SAME CALCULATION.
 - NOZZLES N3, N4, N5A, N5B, N7A, N7C, N7D, AND N8 ARE NOT DEPICTED SINCE THEY ARE BRICKED OVER.
 - USE OF EXPANDED METAL TO PROTECT PERSONNEL FROM TOX SURFACES GREATER THAN 140°F WAS WAIVED IN ACCORDANCE WITH SDDR 24915-307-YDA-MBTO-0018.
 - REV. B, INCORPORATED DCC-279, -504, -722, 784, AND -831; SDDR 24915-307-YDA-MBTO-10006 AND 24915-307-YDA-MBTO-10007; AND HTL-1273, -6490, -6526, -6531, -6548, AND -6573.
 - FOR ADDITIONAL DETAILS ON MATERIALS OF CONSTRUCTION FOR THE INDIVIDUAL COMPONENTS, SEE 24915-11-00316.
 - TRANSMITTER OR SWITCH TO BE LOCATED REMOTELY TO ENABLE ADEQUATE HEAT DISSIPATION.
 - FOR DETAILS OF MATERIALS OF CONSTRUCTION FOR BURNER MB-OTM-0101, SEE SUBMITTAL 24915-307-VIA-MBTO-00188.
 - FOR DETAILS OF MATERIALS OF CONSTRUCTION FOR TOX MK-OTM-0106, SEE SUBMITTAL 24915-307-VIA-MBTO-00226.

APPROVED
By Ron Rhea at 3:53 pm, Mar 10, 2014

This document has been reviewed for ITR/EAR and no ITR/EAR sensitive information was found.

BASED ON BLUE GRASS PFD 24915-07-M5-OTM-00001 REV. 7
 BASED ON BLUE GRASS MSD 24915-07-ND-OTM-00001 REV. 6
 BASED ON VENDOR SUBMITTAL 24915-307-VIA-MBTO-00001

REFERENCE DRAWINGS

NO.	DATE	DESCRIPTION	DR	CK	DL	PE	APVD
1	05/17/12	IFC, SEE NOTE 23	BOT	JAW	SA	KMR	KMR
2	01/15/09	IFC, ADD HTL 1270-1277, 1279, 1280, 1339, 1340 VEN DATA	JLL	PEB	BM	BBB	BBB
3	07/03/07	IFC, REDRAWN TO INCORP VENDOR DATA, TREND *139	JSM	JLL	PEB	JB	BBB
4	11/29/06	ISSUED FOR DESIGN (IFD), ADD MODEL REVIEW COMMENT	JSM	JLL	PEB	JB	BBB
5	09/19/06	IFD, ADD GOV COMMENTS, HAZOP, DESIGN DEVELOPMENT	JSM	JLL	PEB	JB	BBB
6	05/03/06	ISSUED FOR DESIGN (IFD), ADD DESIGN DEVELOPMENT	JSM	JLL	PEB	JB	BBB
7	02/22/06	ISSUED FOR DESIGN (IFD), ADD DESIGN DEVELOPMENT	JSM	JLL	PEB	JB	BBB
8	01/15/06	IFC, ADD GC 3610, 3611, 3612, DESIGN DEVELOPMENT	JSM	JLL	PEB	JB	PKG

BECHTEL PARSONS
BLUE GRASS
 A joint venture of Bechtel Corporation, Inc. and Parsons Brinckerhoff & Technology Group, Inc.

DDO PROGRAM MANAGER FOR ASSEMBLED CHEMICAL SUPPORT CENTER, HUNTSVILLE EDGEMOOD, MARYLAND

US ARMY ENGINEERING AND SUPPORT CENTER, HUNTSVILLE HUNTSVILLE, ALABAMA


BLUE GRASS CHEMICAL AGENT DESTRUCTION PILOT PLANT PROJECT (BGCAPP)
 RICHMOND, KENTUCKY
 CONTRACT NO. DAAA09-03-D-0023

MUNITIONS DEMILITARIZATION BUILDING
MPT (THERMAL) OXIDIZER UNIT - LN 1
PIPING & INSTRUMENT DIAGRAM

DRAWING NUMBER: 24915-07-M6-OTM-00001
 SHEET: 1 OF 1
 REV: 8



07MOTM01.dwg 05/21/12
 DESIGN FILE: DONSPEC
 PLOTTED BY: USER AT SYTIME USING COLORPLOT

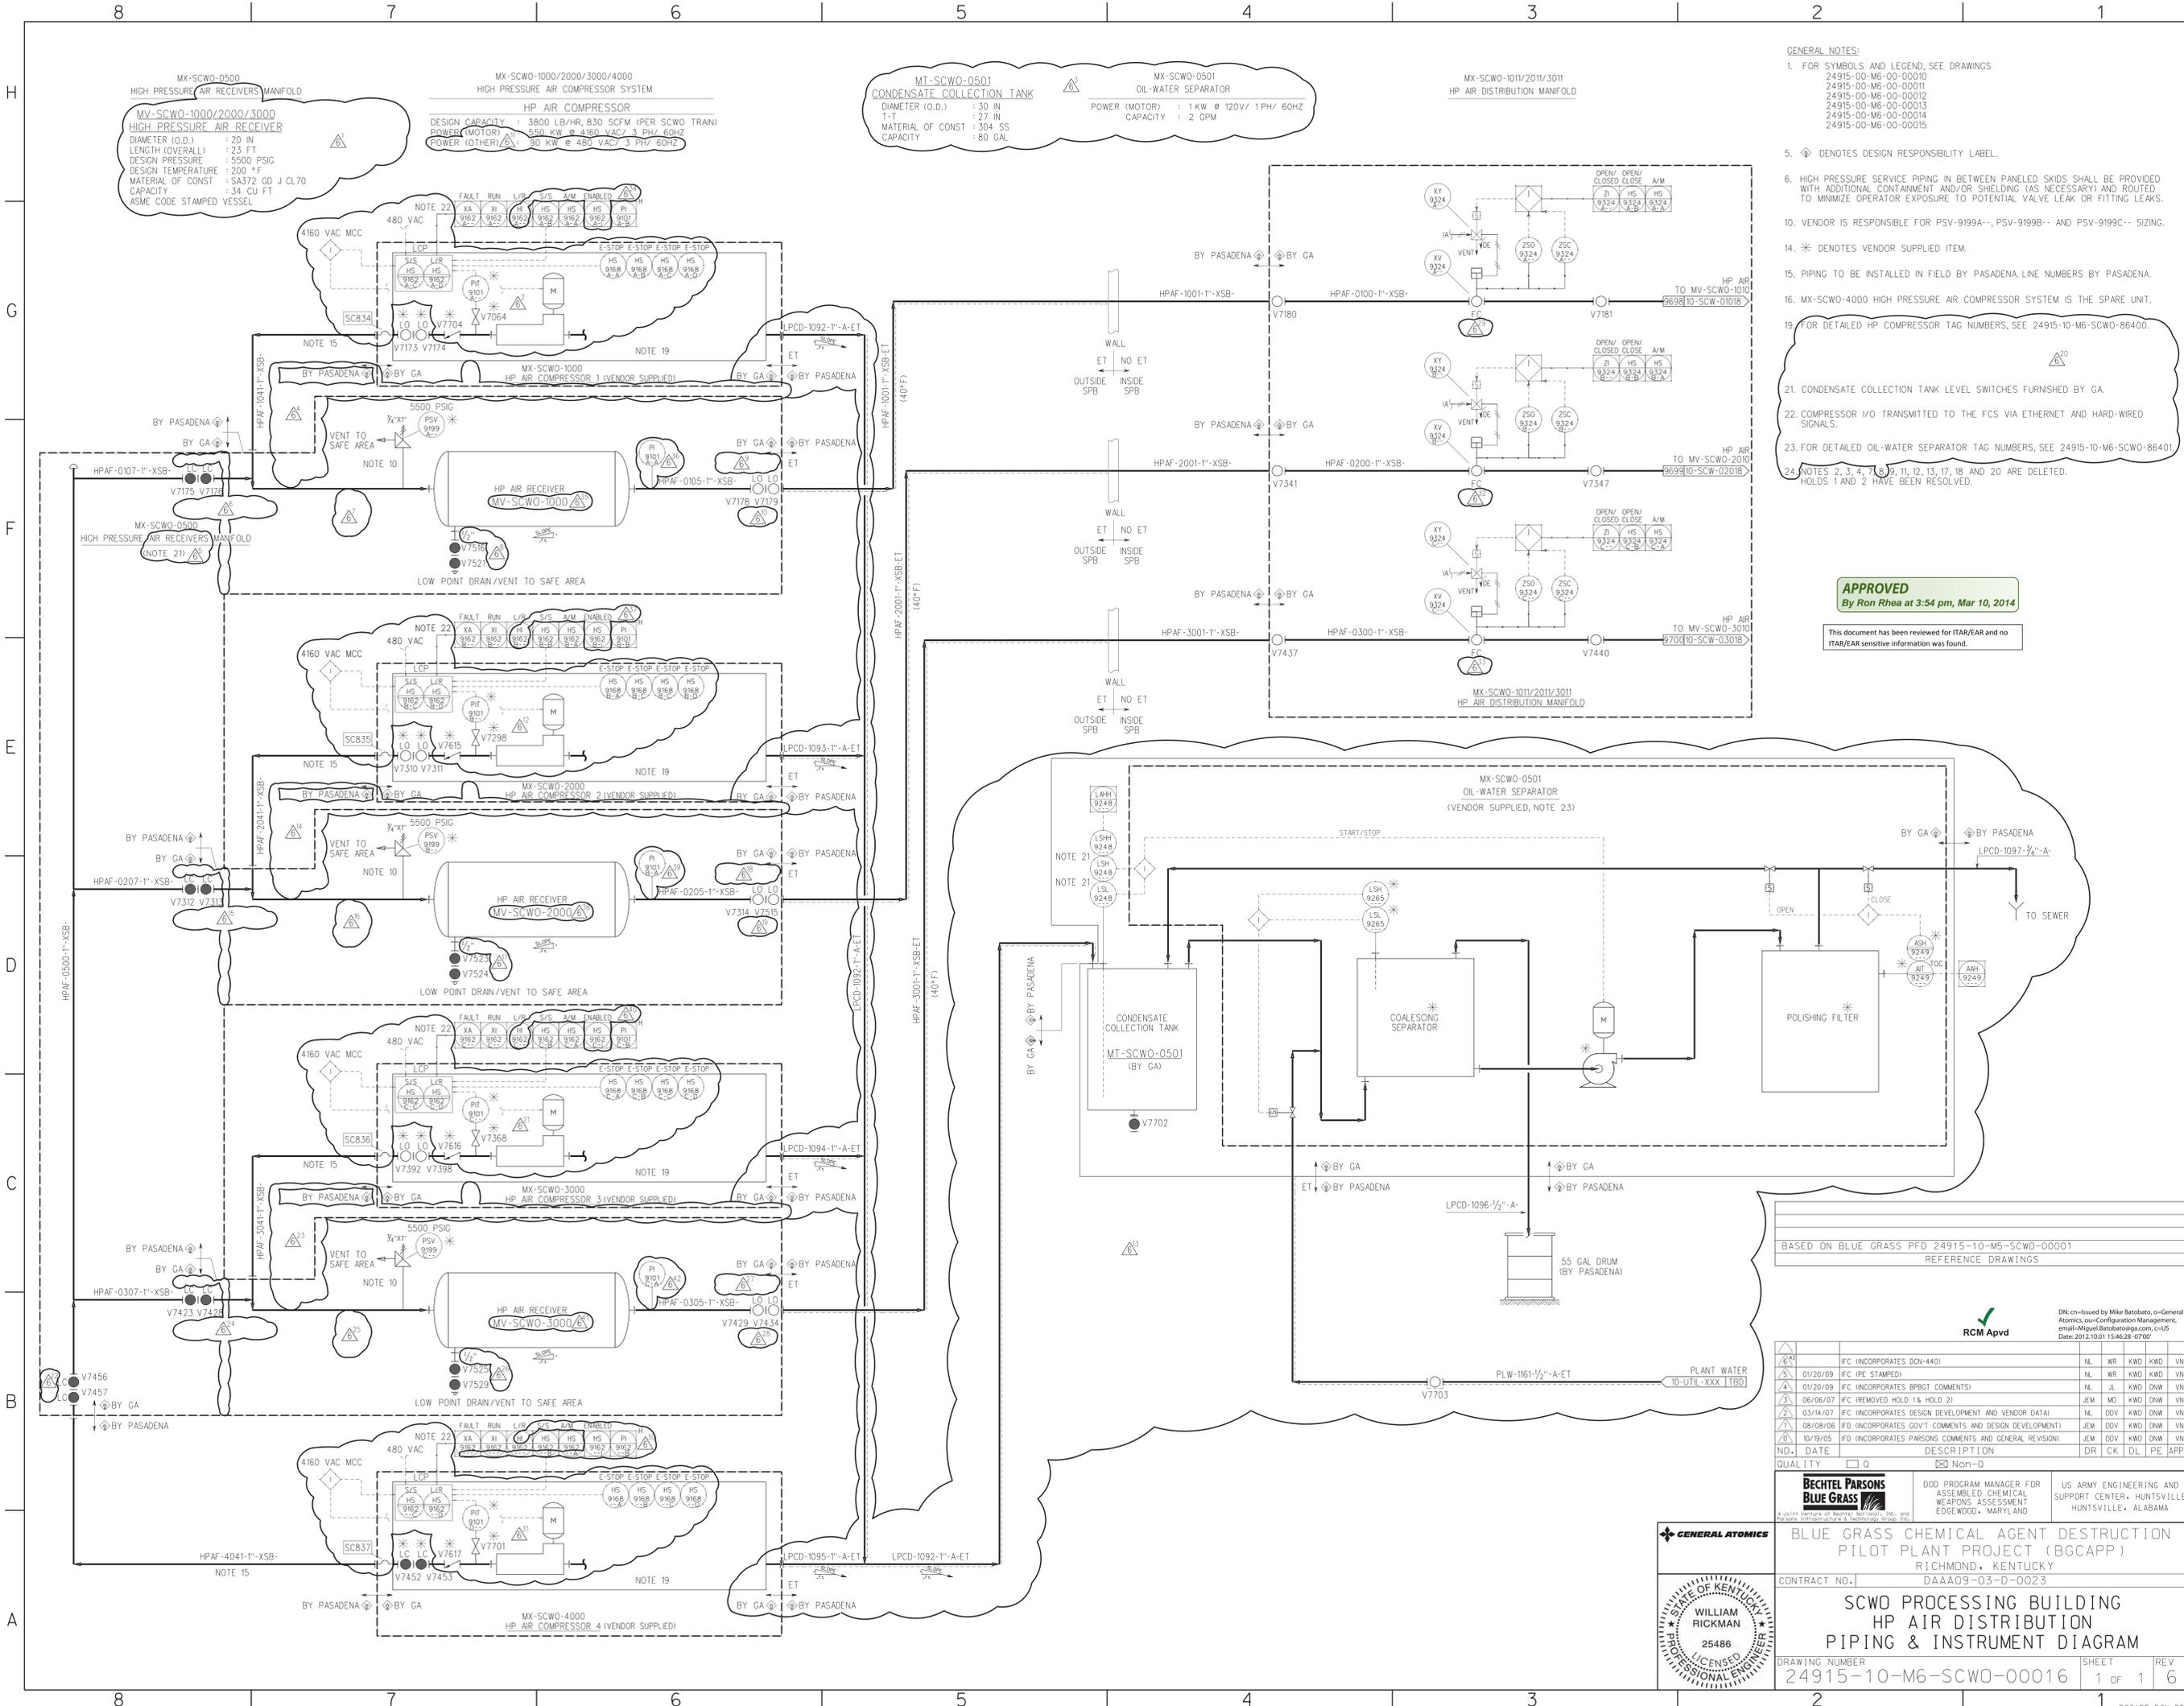

- GENERAL NOTES:**
- FOR SYMBOLS AND LEGEND, SEE DRAWINGS
24915-00-M6-00-00010
24915-00-M6-00-00011
24915-00-M6-00-00012
24915-00-M6-00-00013
24915-00-M6-00-00014
24915-00-M6-00-00015
 - ♦ DENOTES DESIGN RESPONSIBILITY LABEL.
 - HIGH PRESSURE SERVICE PIPING IN BETWEEN PANELED SKIDS SHALL BE PROVIDED WITH ADDITIONAL CONTAINMENT AND/OR SHIELDING (AS NECESSARY) AND ROUTED TO MINIMIZE OPERATOR EXPOSURE TO POTENTIAL VALVE LEAK OR FITTING LEAKS.
 - VENDOR IS RESPONSIBLE FOR PSV-9199A-, PSV-9199B- AND PSV-9199C- SIZING.
 - * DENOTES VENDOR SUPPLIED ITEM.
 - PIPING TO BE INSTALLED IN FIELD BY PASADENA LINE NUMBERS BY PASADENA.
 - MX-SCWO-4000 HIGH PRESSURE AIR COMPRESSOR SYSTEM IS THE SPARE UNIT.
 - FOR DETAILED HP COMPRESSOR TAG NUMBERS, SEE 24915-10-M6-SCWO-86400.
 - CONDENSATE COLLECTION TANK LEVEL SWITCHES FURNISHED BY GA.
 - COMPRESSOR I/O TRANSMITTED TO THE FCS VIA ETHERNET AND HARD-WIRED SIGNALS.
 - FOR DETAILED OIL-WATER SEPARATOR TAG NUMBERS, SEE 24915-10-M6-SCWO-86401.
 - NOTES 2, 3, 4, 6, 7, 8, 9, 11, 12, 13, 17, 18 AND 20 ARE DELETED. HOLDS 1 AND 2 HAVE BEEN RESOLVED.

APPROVED
By Ron Rhea at 3:54 pm, Mar 10, 2014

This document has been reviewed for ITR/EAR and no ITR/EAR sensitive information was found.

BASED ON BLUE GRASS PFD 24915-10-M5-SCWO-00001
REFERENCE DRAWINGS

DN- Issued by Mike Batobato, o-General Atomic, ou-Configuration Management, email-MikeBatobato@ga.com, c-05 Date: 2012.10.01 15:46:28 -0700'

RCM Apvd

NO.	DATE	DESCRIPTION	DR	CK	DL	PE	APPD
69		FC INCORPORATES DGN-440	NL	WR	KWD	KWD	VN
68	01/20/09	FC IPE STAMPED	NL	WR	KWD	KWD	VN
67	01/20/09	FC INCORPORATES BRPT COMMENTS	NL	JL	KWD	DNN	VN
66	06/06/07	FC (REMOVED HOLD 1 & HOLD 2)	JEM	MD	KWD	DNN	VN
65	03/14/07	FC INCORPORATES DESIGN DEVELOPMENT AND VENDOR DATA	NL	DDV	KWD	DNN	VN
64	08/08/06	FD INCORPORATES GOV'T COMMENTS AND DESIGN DEVELOPMENT	JEM	DDV	KWD	DNN	VN
63	10/19/05	FD INCORPORATES PARSONS COMMENTS AND GENERAL REVISION	JEM	DDV	KWD	DNN	VN

QUALITY 0 Non-0

BECHTEL PARSONS
A joint venture of Bechtel, Inc. and Parsons Brinckerhoff, Inc.

GENERAL ATOMICS
WILLIAM RICKMAN
25486
LICENSED PROFESSIONAL ENGINEER

DOD PROGRAM MANAGER FOR ASSEMBLED CHEMICAL WEAPONS ASSESSMENT EDGEWOOD, MARYLAND

US ARMY ENGINEERING AND SUPPORT CENTER, HUNTSVILLE HUNTSVILLE, ALABAMA


BLUE GRASS CHEMICAL AGENT DESTRUCTION PILOT PLANT PROJECT (BGCAPP)
RICHMOND, KENTUCKY
DAAA09-03-D-0023

SCWO PROCESSING BUILDING HP AIR DISTRIBUTION PIPING & INSTRUMENT DIAGRAM

CONTRACT NO. 24915-10-M6-SCWO-00016
DRAWING NUMBER 1 of 1
SHEET 1 of 1
REV 6

BCCAPP_DGN_BDR

10MSCW0016.ppt 09/04/12

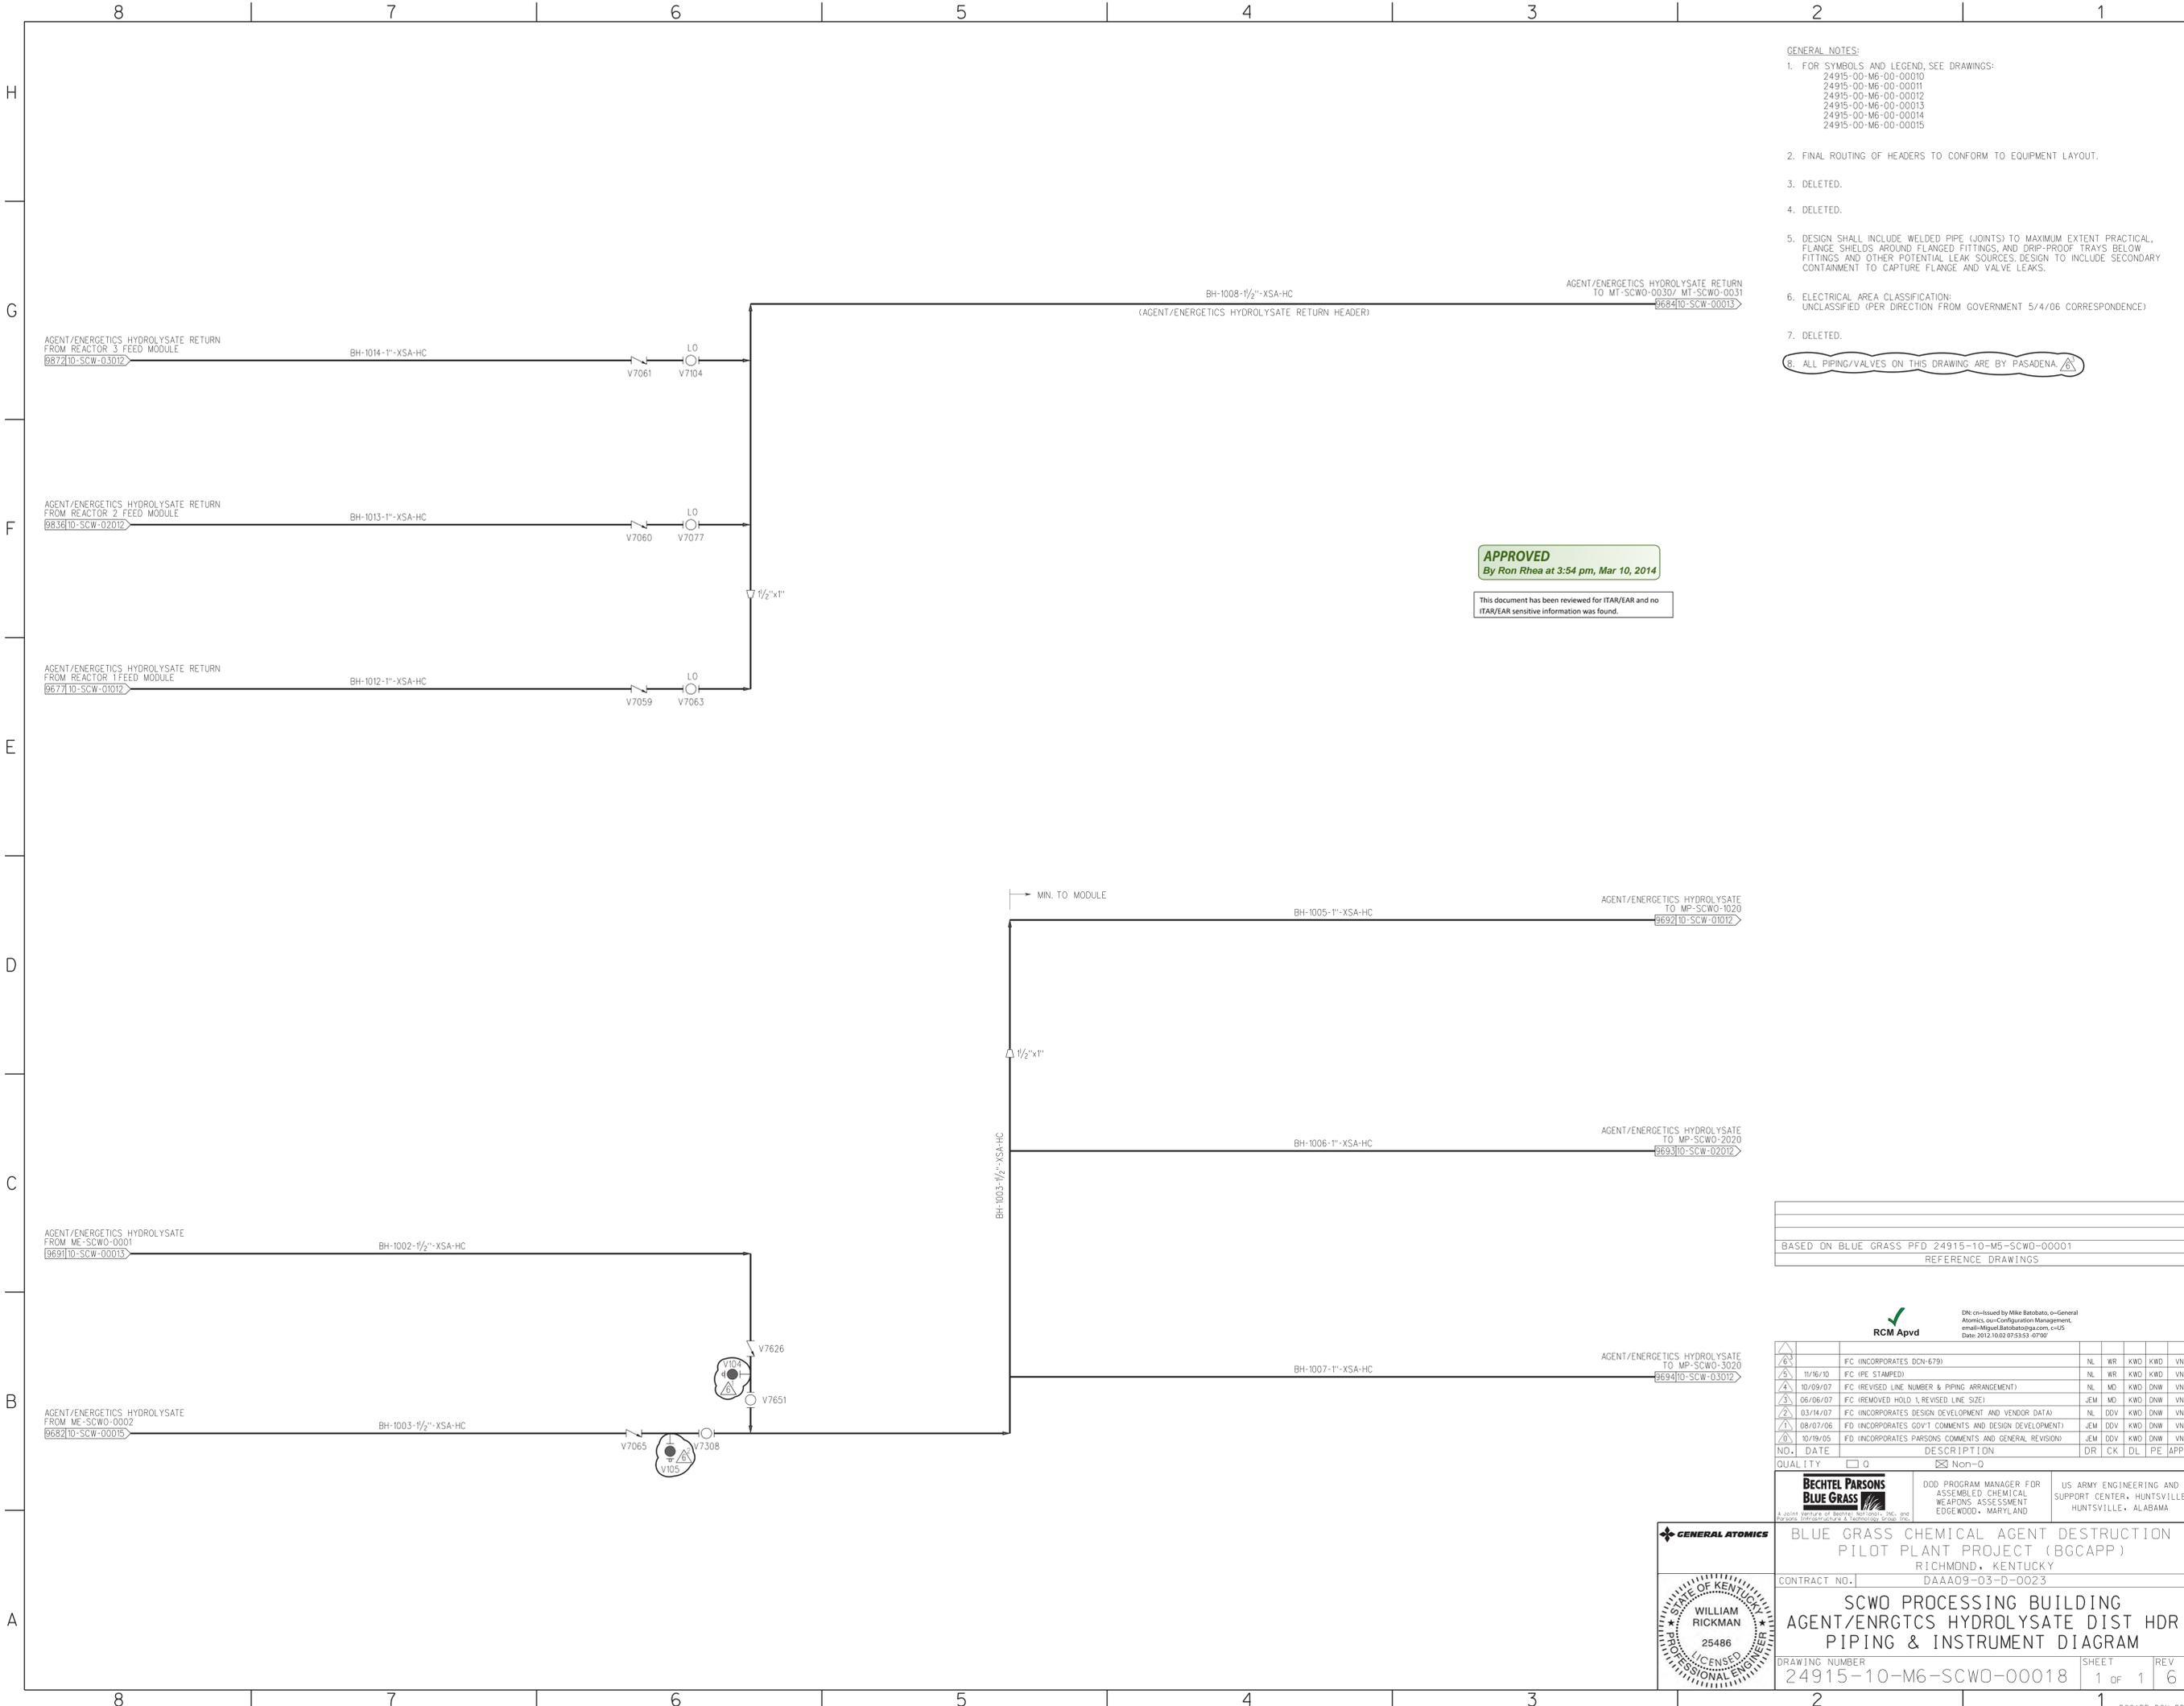

- GENERAL NOTES:**
- FOR SYMBOLS AND LEGEND, SEE DRAWINGS:
 24915-00-M6-00-00010
 24915-00-M6-00-00011
 24915-00-M6-00-00012
 24915-00-M6-00-00013
 24915-00-M6-00-00014
 24915-00-M6-00-00015
 - FINAL ROUTING OF HEADERS TO CONFORM TO EQUIPMENT LAYOUT.
 - DELETED.
 - DELETED.
 - DESIGN SHALL INCLUDE WELDED PIPE (JOINTS) TO MAXIMUM EXTENT PRACTICAL. FLANGE SHIELDS AROUND FLANGED FITTINGS, AND DRIP-PROOF TRAYS BELOW FITTINGS AND OTHER POTENTIAL LEAK SOURCES. DESIGN TO INCLUDE SECONDARY CONTAINMENT TO CAPTURE FLANGE AND VALVE LEAKS.
 - ELECTRICAL AREA CLASSIFICATION:
 UNCLASSIFIED (PER DIRECTION FROM GOVERNMENT 5/4/06 CORRESPONDENCE)
 - DELETED.
 - ALL PIPING/VALVES ON THIS DRAWING ARE BY PASADENA.

APPROVED
 By Ron Rhea at 3:54 pm, Mar 10, 2014

This document has been reviewed for ITAR/EAR and no ITAR/EAR sensitive information was found.

BASED ON BLUE GRASS PFD 24915-10-M6-SCWO-00001
 REFERENCE DRAWINGS

RCM Apvd
 DDC on-issued by Mike Barabato, o-General Atomic, ou-Configuration Management, email=Mike.Barabato@iga.com, c=US Date: 2012.10.02 07:53:53 -0700'

NO.	DATE	DESCRIPTION	DR	CK	DL	PE	APPD

QUALITY 0 Non-0

BECHTEL PARSONS BLUE GRASS
 DOD PROGRAM MANAGER FOR ASSEMBLED CHEMICAL WEAPONS ASSESSMENT EDGEMOOD, MARYLAND
 US ARMY ENGINEERING AND SUPPORT CENTER, HUNTSVILLE HUNTSVILLE, ALABAMA


GENERAL ATOMICS
 WILLIAM RICKMAN
 25486
 LICENSED PROFESSIONAL ENGINEER

BLUE GRASS CHEMICAL AGENT DESTRUCTION PILOT PLANT PROJECT (BGCAPP)
 RICHMOND, KENTUCKY
 CONTRACT NO. DAAA09-03-D-0023

SCWO PROCESSING BUILDING AGENT/ENRGTCS HYDROLYSATE DIST HDR PIPING & INSTRUMENT DIAGRAM

DRAWING NUMBER: 24915-10-M6-SCWO-00018
 SHEET: 1 of 1
 REV: 6

10mscow018.ppt 07/23/12

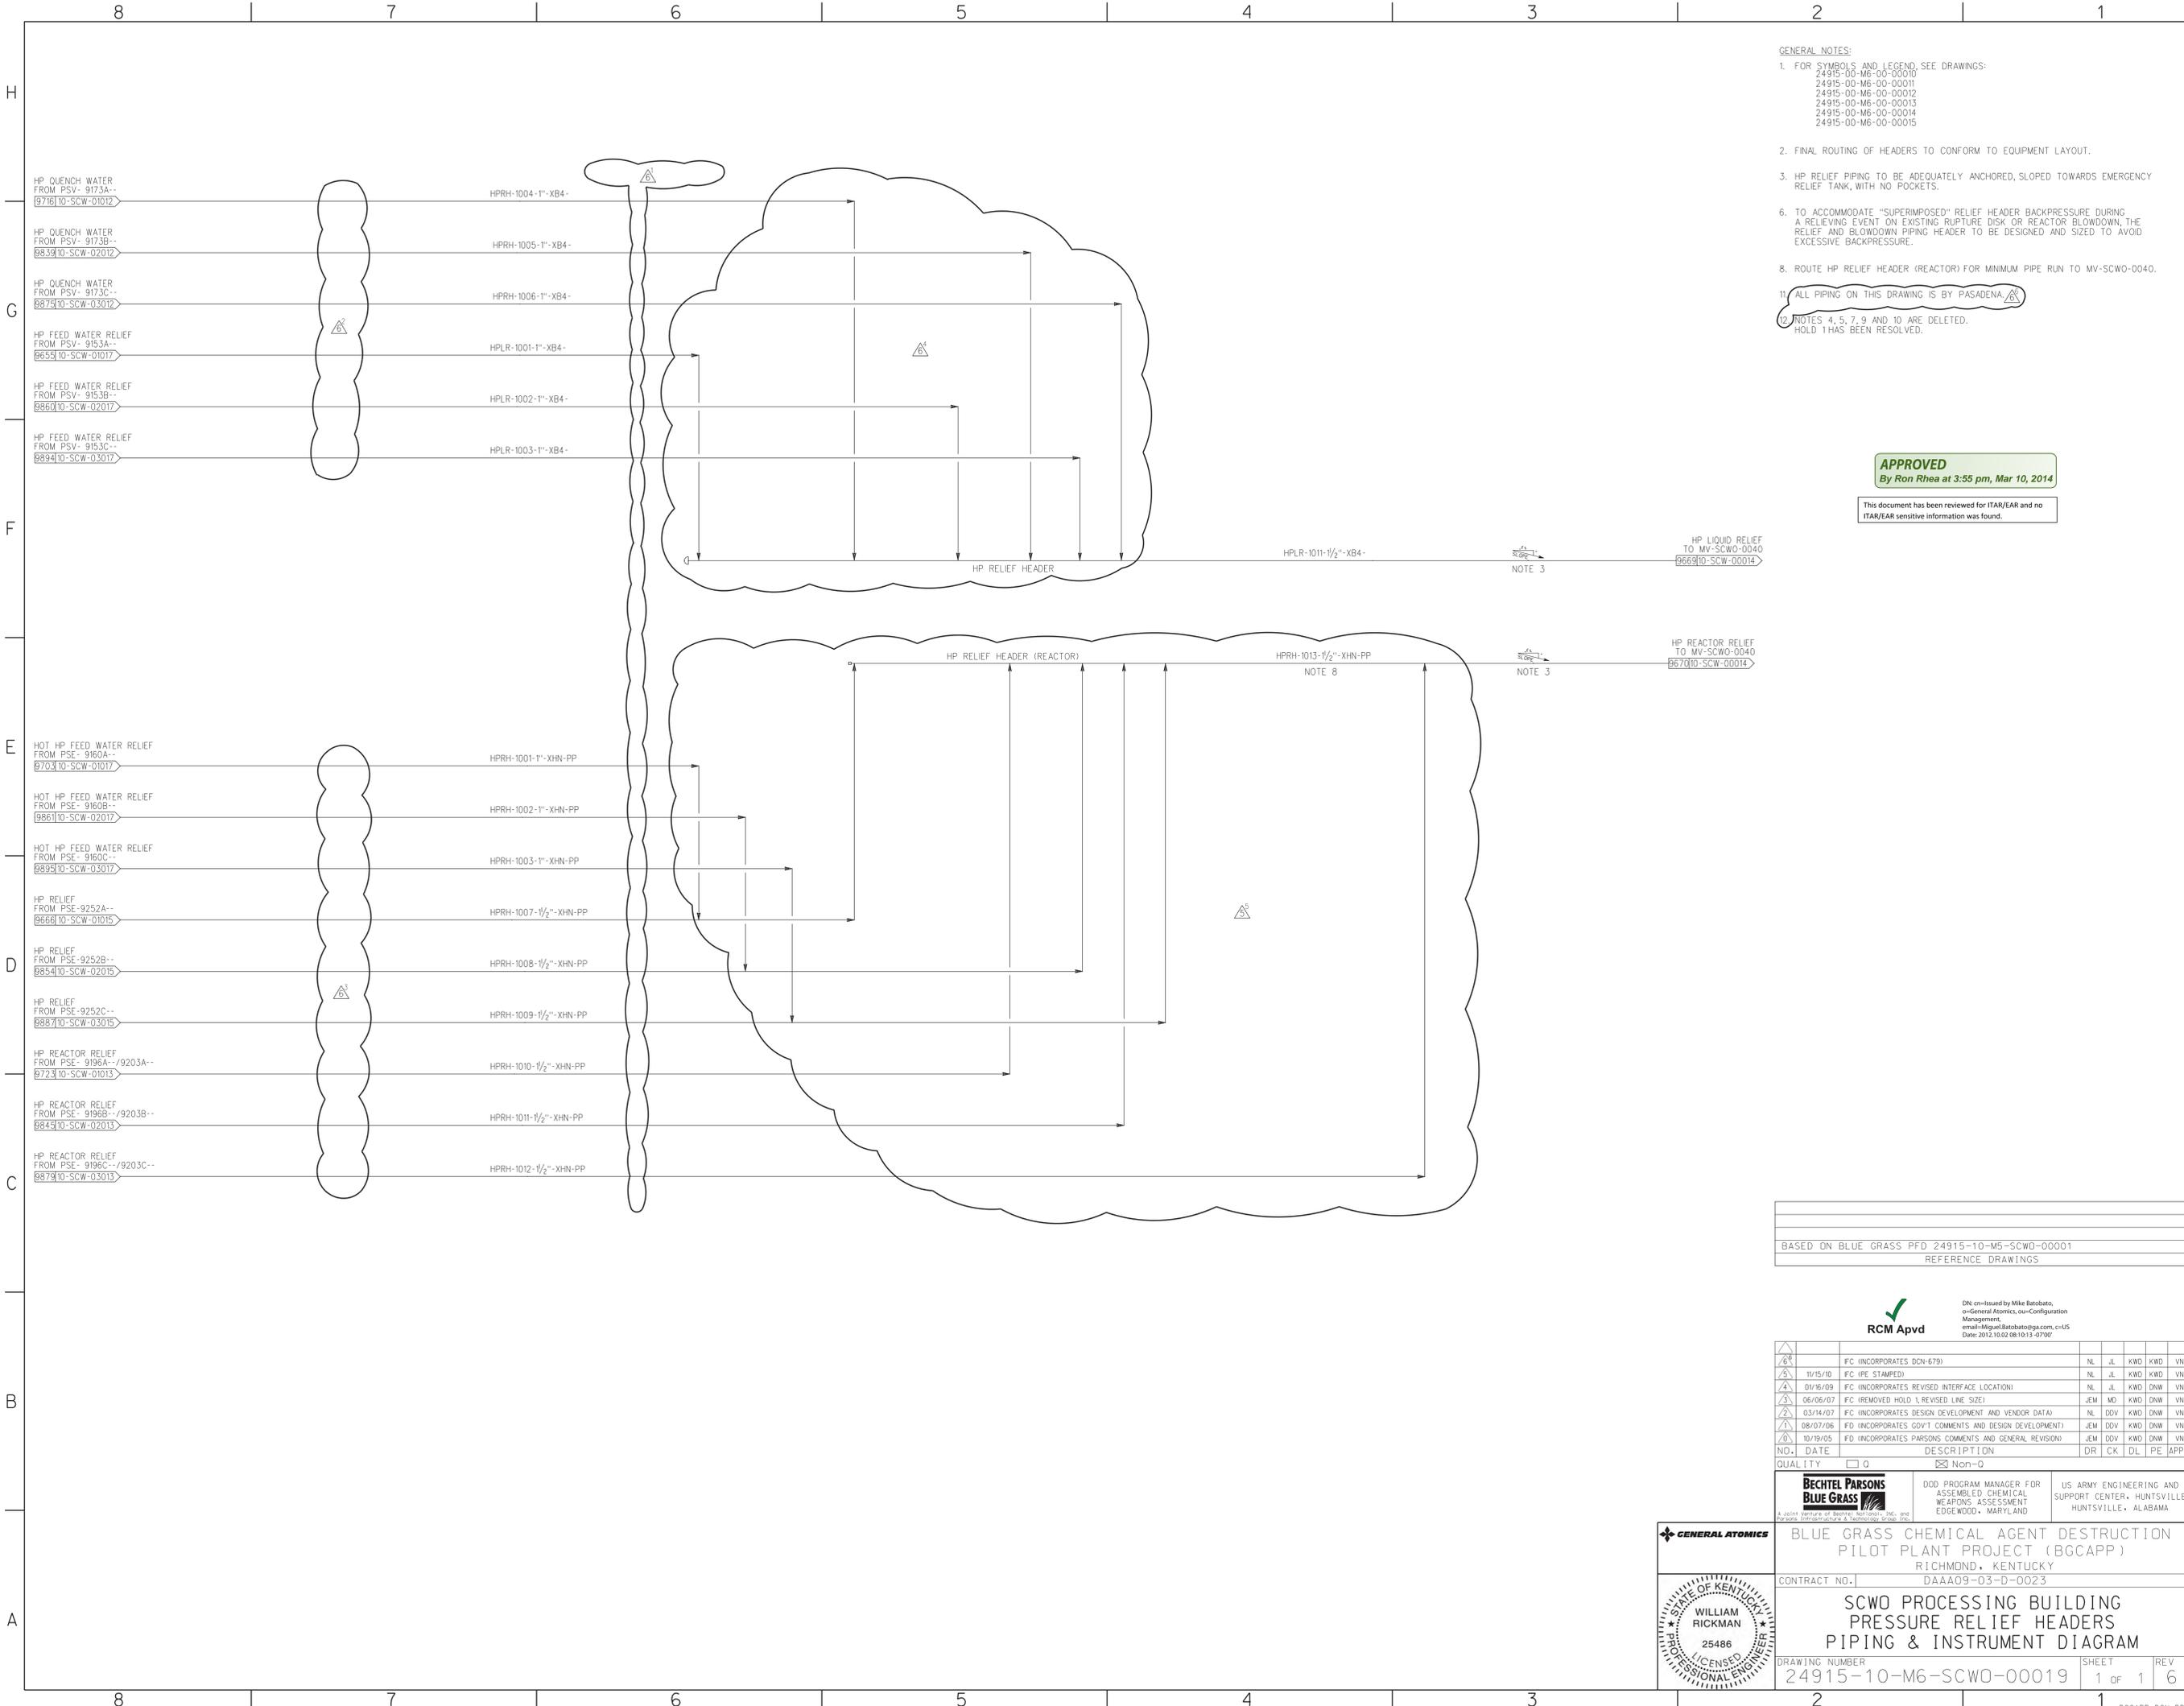

- GENERAL NOTES:**
- FOR SYMBOLS AND LEGEND, SEE DRAWINGS:
 24915-00-M6-00-00010
 24915-00-M6-00-00011
 24915-00-M6-00-00012
 24915-00-M6-00-00013
 24915-00-M6-00-00014
 24915-00-M6-00-00015
 - FINAL ROUTING OF HEADERS TO CONFORM TO EQUIPMENT LAYOUT.
 - HP RELIEF PIPING TO BE ADEQUATELY ANCHORED, SLOPED TOWARDS EMERGENCY RELIEF TANK, WITH NO POCKETS.
 - TO ACCOMMODATE "SUPERIMPOSED" RELIEF HEADER BACKPRESSURE DURING A RELIEVING EVENT ON EXISTING RUPTURE DISK OR REACTOR BLOWDOWN, THE RELIEF AND BLOWDOWN PIPING HEADER TO BE DESIGNED AND SIZED TO AVOID EXCESSIVE BACKPRESSURE.
 - ROUTE HP RELIEF HEADER (REACTOR) FOR MINIMUM PIPE RUN TO MV-SCWO-0040.
 - ALL PIPING ON THIS DRAWING IS BY PASADENA.
 - NOTES 4, 5, 7, 9 AND 10 ARE DELETED.
HOLD 1 HAS BEEN RESOLVED.

APPROVED
 By Ron Rhea at 3:55 pm, Mar 10, 2014

This document has been reviewed for ITAR/EAR and no ITAR/EAR sensitive information was found.

HPLR-1011-1/2"-XB4-
 HP LIQUID RELIEF TO MV-SCWO-0040
 NOTE 3

HPRH-1013-1/2"-XHN-PP
 HP REACTOR RELIEF TO MV-SCWO-0040
 NOTE 8

BASED ON BLUE GRASS PFD 24915-10-M5-SCWO-00001
 REFERENCE DRAWINGS

RCM Apvd
 DDC on-issued by Mike Barabato,
 on-General Atomics, on-Configuration
 Management
 email=rlgual.Barabato@gsa.com, c=US
 Date: 2012.10.02 08:10:13 -0700

NO.	DATE	DESCRIPTION	DR	CK	DL	PE	APPD


QUALITY 0 Non-0

BECHTEL PARSONS BLUE GRASS
 DOD PROGRAM MANAGER FOR ASSEMBLED CHEMICAL WEAPONS ASSESSMENT EDGEWOOD, MARYLAND
 US ARMY ENGINEERING AND SUPPORT CENTER, HUNTSVILLE HUNTSVILLE, ALABAMA

BLUE GRASS CHEMICAL AGENT DESTRUCTION PILOT PLANT PROJECT (BGCAPP)
 RICHMOND, KENTUCKY
 CONTRACT NO. DAAA09-03-D-0023

SCWO PROCESSING BUILDING PRESSURE RELIEF HEADERS PIPING & INSTRUMENT DIAGRAM

DRAWING NUMBER: 24915-10-M6-SCWO-00019
 SHEET: 1 of 1
 REV: 6

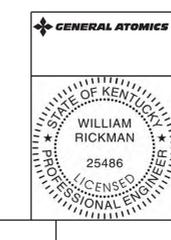

10MSCWO019.ppt 01/20/12


MX-SCWO-0010
CONDENSATE COLLECTION POT MODULE
MV-SCWO-0010
HP CONDENSATE COLLECTION POT
CAPACITY (WORKING) : 20 GAL
DIAMETER (O.D.) : 20 IN
T-T : 30 IN
DESIGN PRESSURE : 150 PSIG
DESIGN TEMPERATURE : 125 °F
MATERIAL OF CONST : CARBON STEEL
TRIM : TRIM-0818-01-A
ASME CODE STAMPED VESSEL

APPROVED
By Ron Rhea at 3:55 pm, Mar 10, 2014

This document has been reviewed for ITRAR/EAR and no ITRAR/EAR sensitive information was found.

GENERAL NOTES:

- FOR SYMBOLS AND LEGEND, SEE DRAWINGS.
24915-00-M6-00-00010
24915-00-M6-00-00011
24915-00-M6-00-00012
24915-00-M6-00-00013
24915-00-M6-00-00014
24915-00-M6-00-00015
- STAGGER AND DELAY TIMERS ON THE CONDENSATE DRAIN SYSTEM SO THAT XV-9256-- IS NOT OPEN WHEN XV-9256A-- , XV-9256B-- , XV9256C-- (SEE PIDS 24915-10-M6-SCWO-01018, -02018 & -03018) ARE OPEN AND THAT MV-SCWO-0010 IS EMPTIED IN ACCORDANCE WITH EACH SCWO TRAIN WHICH DRAINS AT DIFFERENT TIMES.
- VENT OUTDOORS, THROUGH THE SPB WALL.
- INTERCONNECTING PIPING BY GA.
- ⊕ DENOTES DESIGN RESPONSIBILITY LABEL.
- HLL IS 50% OF VESSEL HEIGHT, NLL IS 25% OF VESSEL HEIGHT. LIQUID LEVEL IS MEASURED FROM POT'S BOTTOM TANGENT LINE.
- COMMON INSTRUMENT AIR HEADER, AS SHOWN ON PID 24915-10-M6-SCWO-01018, SERVICES COMPONENTS ON THIS DRAWING.
- THE CHECK VALVE (SM7046) IS TO BE DESIGNED TO OPEN UPON AN OVER PRESSURIZATION EVENT IF PIT-9256 FAILS TO RESPOND IN TIME TO CLOSE THE RESPECTIVE VALVE (XV-9256A-- , XV-9256B-- OR XV-9256C--) OR WHEN VAPOR ENTERS THE VESSEL WHEN LIQUID CONDENSATE DRAINS. THIS IS LIKELY BECAUSE THE CONDENSATE DRAIN CONTROLS ARE BASED UPON SEASONAL PRE-DETERMINED STAGGERED TIME SET POINTS AND NOT ON ACTUAL LIQUID MEASUREMENT.
- CONDENSATE COLLECTION POT MODULE MX-SCWO-0010 IS MOUNTED WITHIN AIR DISTRIBUTION MANIFOLD MX-SCWO-1011, P&ID 24915-10-M6-SCWO-01018.
- NOTES 3, 5, 7, 10, 11, 14 AND 15 ARE DELETED. HOLDS 1 AND 2 HAVE BEEN RESOLVED.

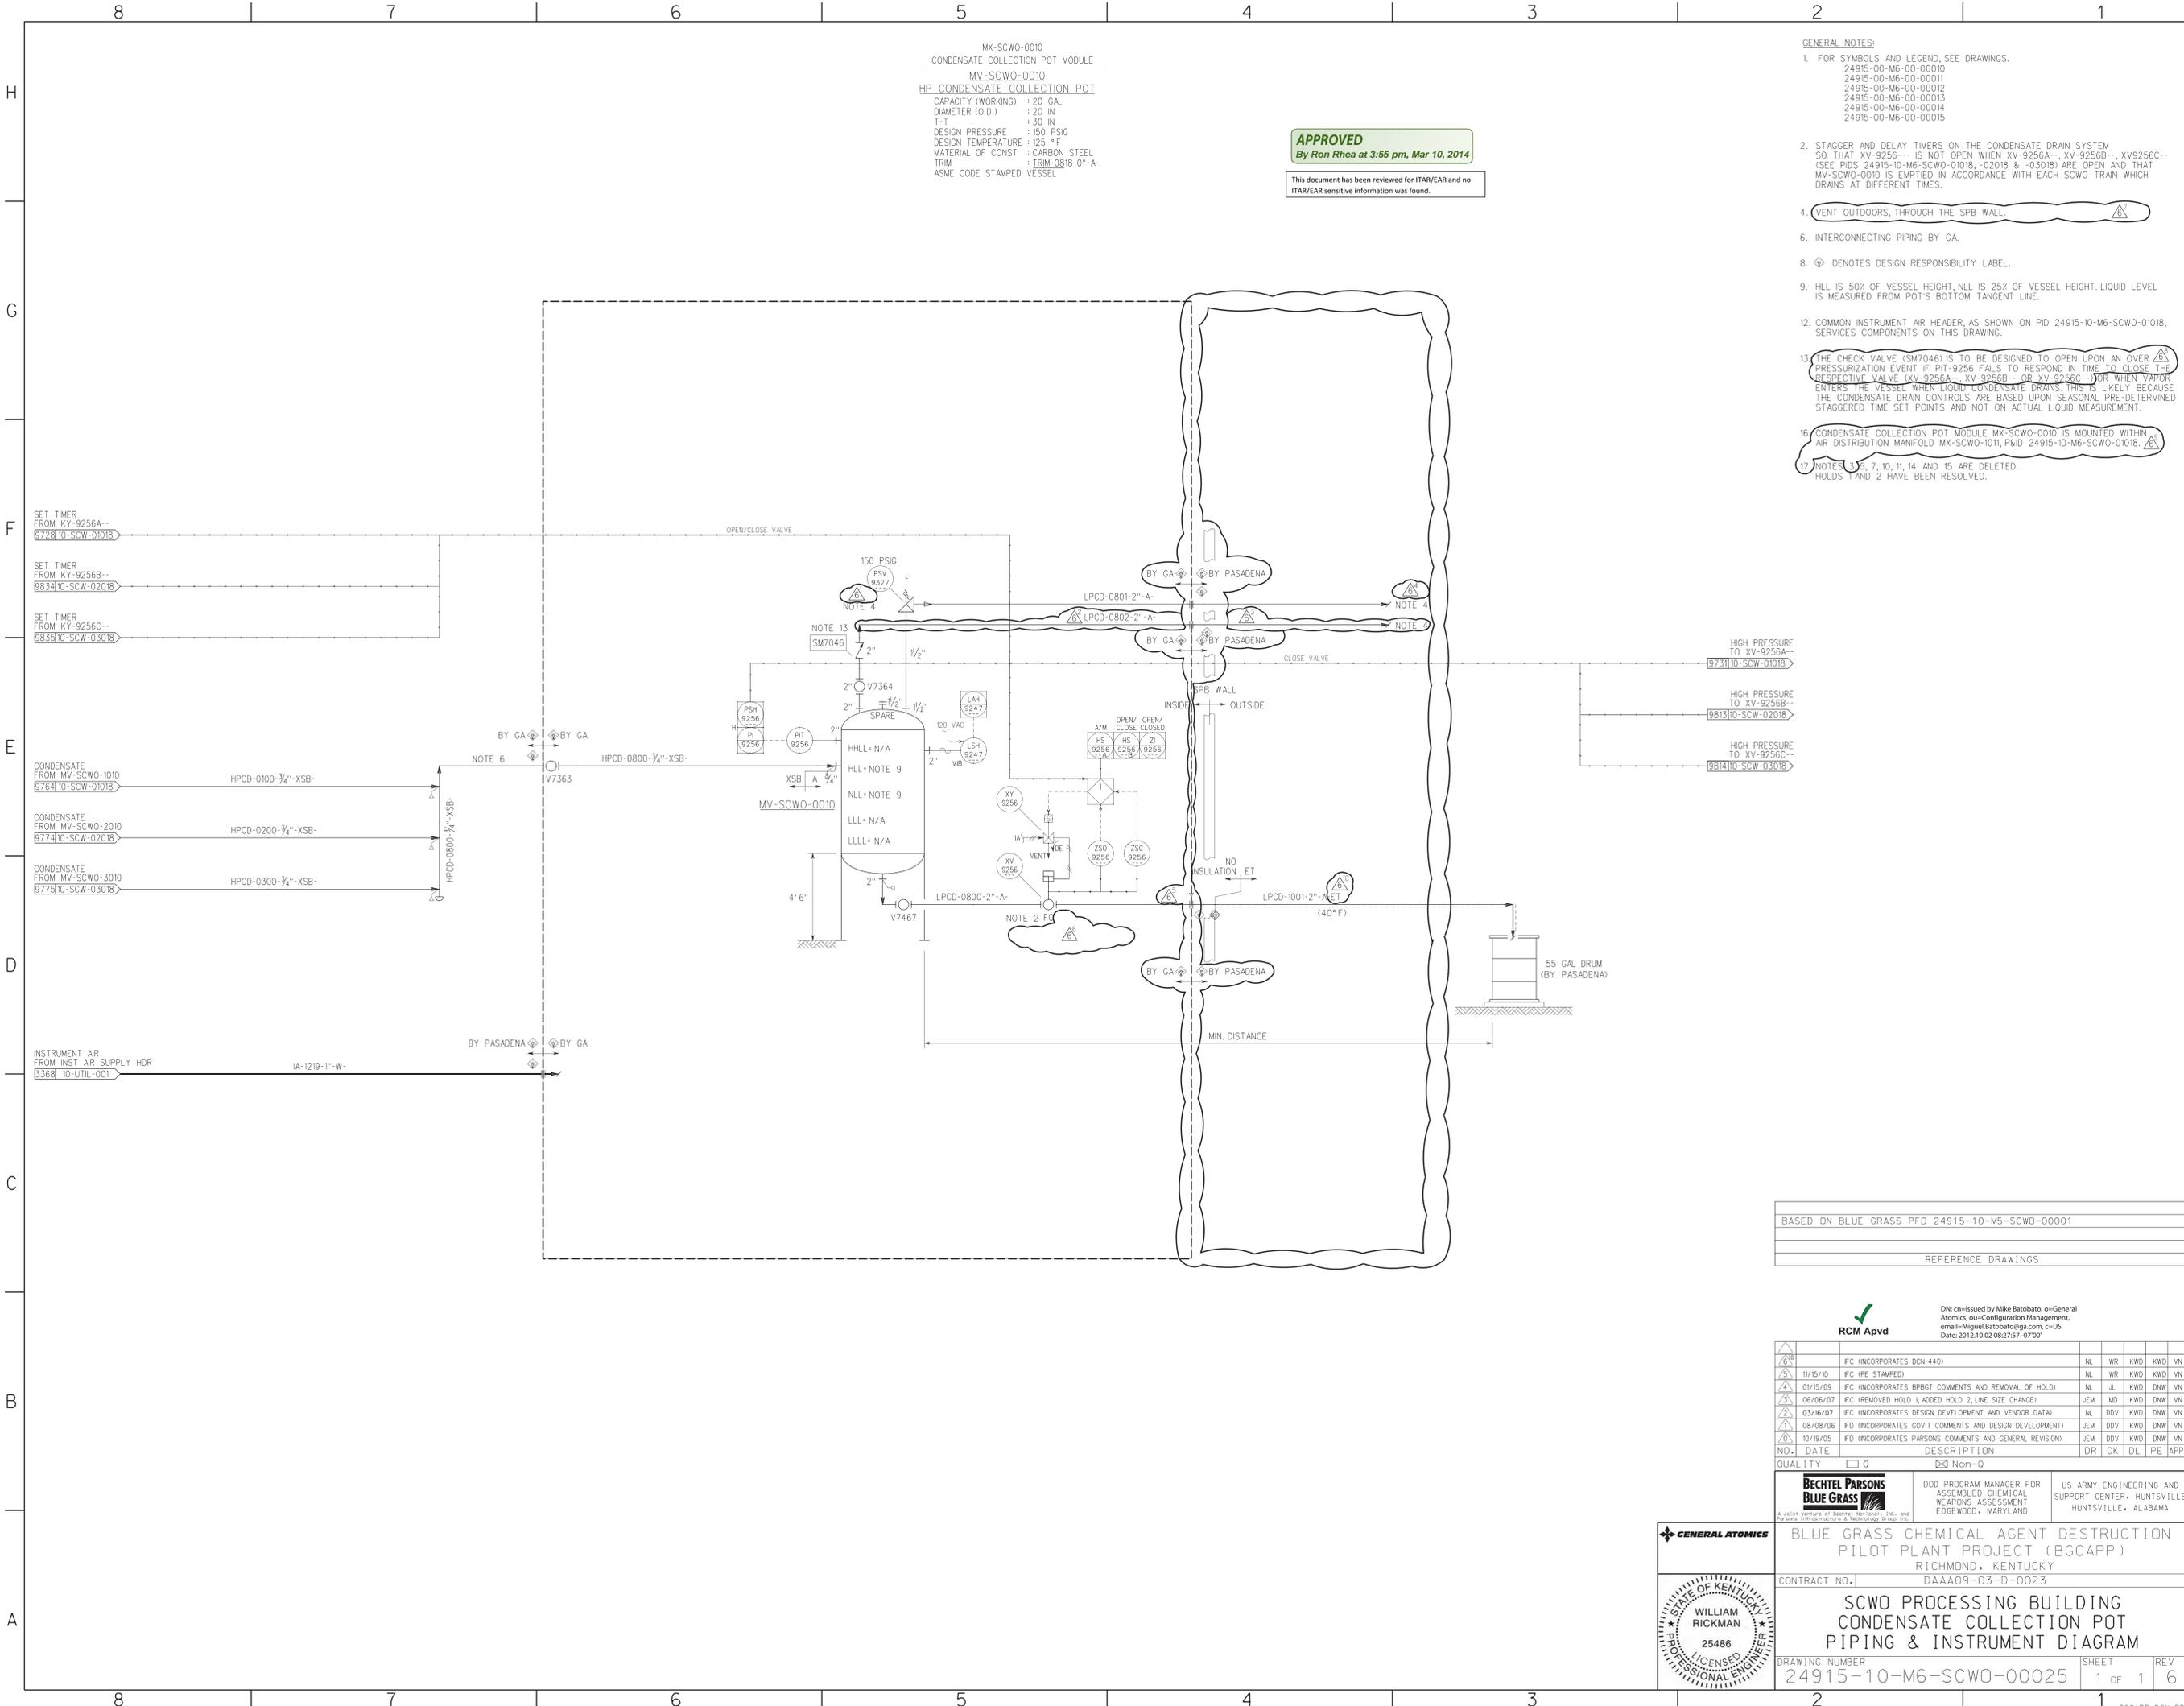

BASED ON BLUE GRASS PFD 24915-10-M5-SCWO-00001
REFERENCE DRAWINGS

RCM Apvd

DN: cn=Issued by Mike Batobato, o=General Atomics, ou=Configuration Management, email=Miguel.Batobato@ga.com, c=US
Date: 2012.10.02 08:27:57 -0700

NO.	DATE	DESCRIPTION	DR	CK	DL	PE	APPD
6	11/15/10	FC (INCORPORATES DCN-440)	NL	WR	KWD	KWD	VN
5	01/15/09	FC (INCORPORATES BPBGT COMMENTS AND REMOVAL OF HOLD)	NL	WR	KWD	KWD	VN
4	06/06/07	FC (REMOVED HOLD 1, ADDED HOLD 2, LINE SIZE CHANGE)	JEM	MD	KWD	DNW	VN
3	03/16/07	FC (INCORPORATES DESIGN DEVELOPMENT AND VENDOR DATA)	NL	DDV	KWD	DNW	VN
2	08/08/06	FD (INCORPORATES GOV'T COMMENTS AND DESIGN DEVELOPMENT)	JEM	DDV	KWD	DNW	VN
1	10/19/05	FD (INCORPORATES PARSONS COMMENTS AND GENERAL REVISIONS)	JEM	DDV	KWD	DNW	VN

QUALITY 0 Non-0

BECHTEL PARSONS BLUE GRASS

DOD PROGRAM MANAGER FOR ASSEMBLED CHEMICAL WEAPONS ASSESSMENT EDGEWOOD, MARYLAND

US ARMY ENGINEERING AND SUPPORT CENTER, HUNTSVILLE, ALABAMA

BLUE GRASS CHEMICAL AGENT DESTRUCTION PILOT PLANT PROJECT (BGCAPP)
RICHMOND, KENTUCKY
CONTRACT NO. DAAA09-03-D-0023

SCWO PROCESSING BUILDING CONDENSATE COLLECTION POT PIPING & INSTRUMENT DIAGRAM

DRAWING NUMBER: 24915-10-M6-SCWO-00025
SHEET: 1 of 1
REV: 6


WILLIAM RICKMAN
25486
LICENSED PROFESSIONAL ENGINEER

10mscwo0025.ppt 09/04/12

- GENERAL NOTES:
- FOR SYMBOLS AND LEGEND, SEE DRAWINGS:
24915-00-M6-00-0000
24915-00-M6-00-0001
24915-00-M6-00-0002
24915-00-M6-00-0003
24915-00-M6-00-0004
24915-00-M6-00-0005
 - FINAL ROUTING OF HEADERS TO CONFORM TO EQUIPMENT LAYOUT.
 - HP REACTOR BLOWDOWN PIPING TO BE ADEQUATELY ANCHORED, SLOPED TOWARDS EMERGENCY RELIEF TANK, WITH NO POCKETS.
 - TO ACCOMMODATE "SUPERIMPOSED" RELIEF HEADER BACKPRESSURE DURING A RELIEVING EVENT, THE RELIEF PIPING HEADER WILL BE DESIGNED TO AVOID EXCESSIVE BACKPRESSURE.
 - ALL PIPING ON THIS DRAWING IS BY PASADENA
 - NOTES 4, 5, 7, 8 AND 9 ARE DELETED.
HOLD 1 HAS BEEN RESOLVED.

APPROVED
By Ron Rhea at 3:56 pm, Mar 10, 2014

This document has been reviewed for ISTAR/EAR and no ISTAR/EAR sensitive information was found.

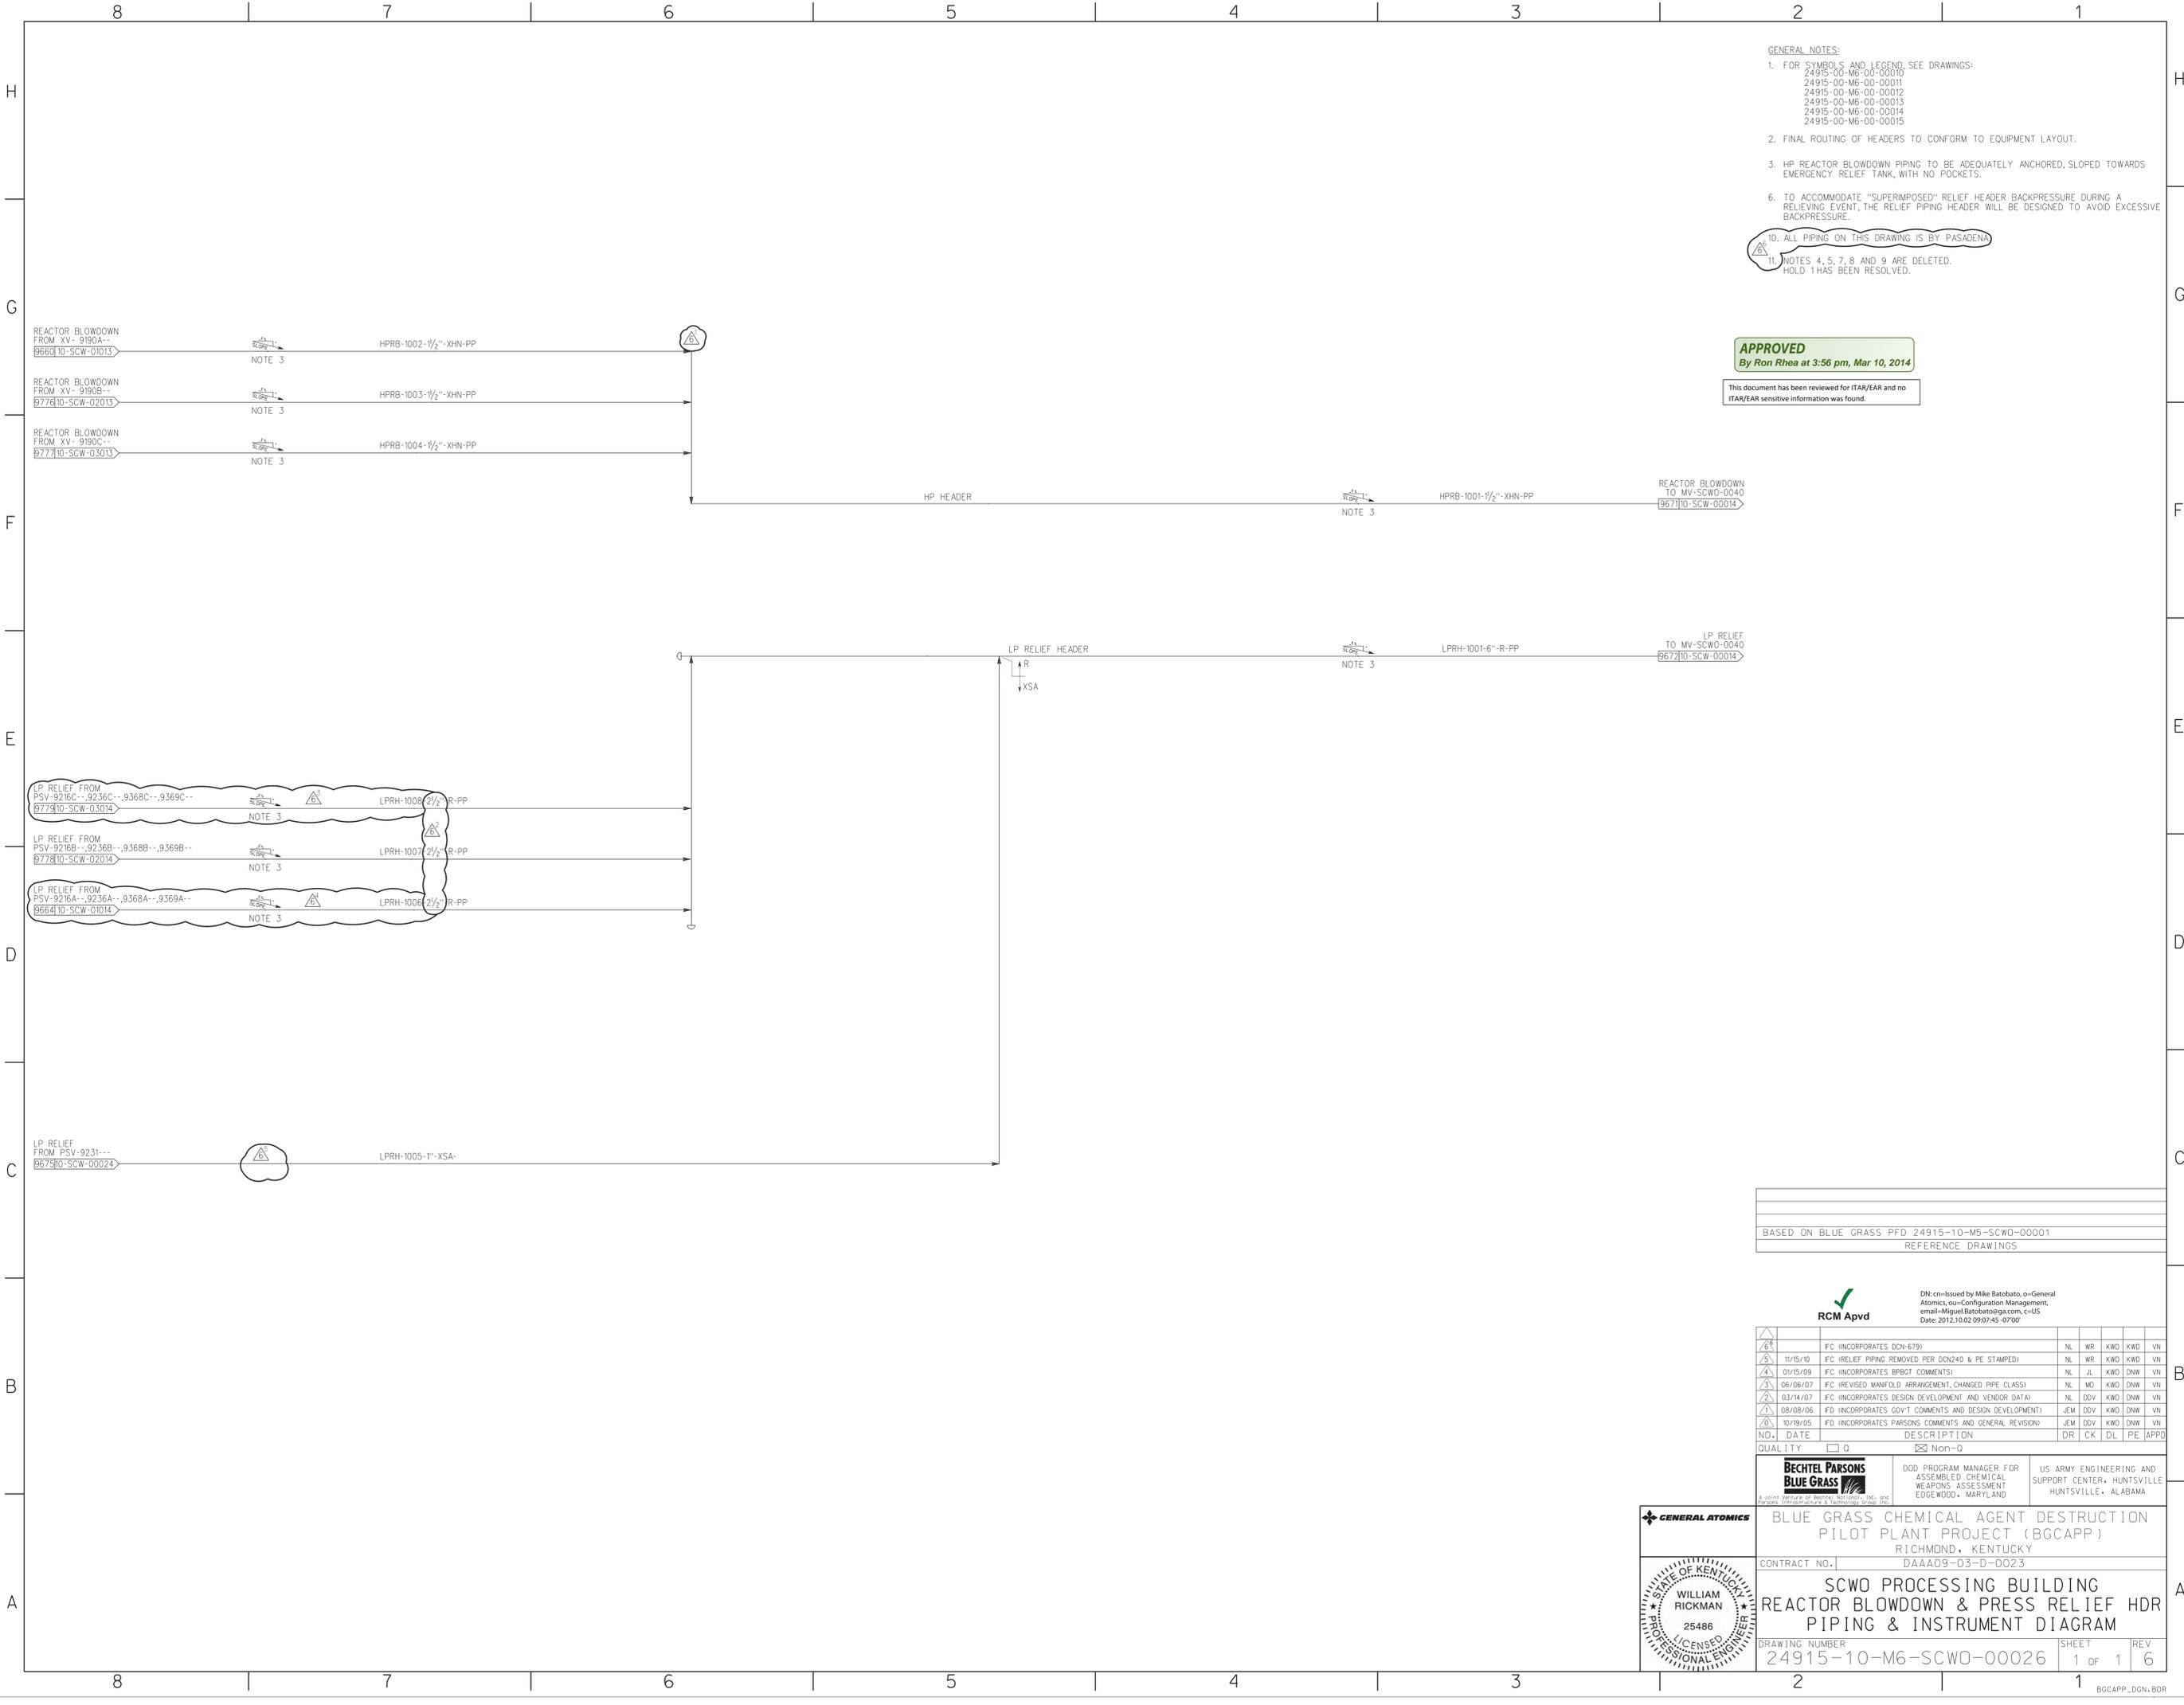

BASED ON BLUE GRASS PFD 24915-10-M5-SCWO-00001
REFERENCE DRAWINGS


RCM Apvd
Date: 2012.10.02 09:07:45 -0700

NO.	DATE	DESCRIPTION	DR	CK	DL	PE	APPD
6	11/15/10	FC (INCORPORATES DCN-679)	NL	WR	KWD	KWD	VN
5	01/15/09	FC (RELIEF PIPING REMOVED PER DCN240 & PE STAMPED)	NL	WR	KWD	KWD	VN
4	01/15/09	FC (INCORPORATES BPBGT COMMENTS)	NL	JL	KWD	DNN	VN
3	06/06/07	FC (REVISED MANIFOLD ARRANGEMENT, CHANGED PIPE CLASS)	NL	MD	KWD	DNN	VN
2	03/14/07	FC (INCORPORATES DESIGN DEVELOPMENT AND VENDOR DATA)	NL	DDV	KWD	DNN	VN
1	08/08/06	FD (INCORPORATES GOV'T COMMENTS AND DESIGN DEVELOPMENT)	JEM	DDV	KWD	DNN	VN
0	10/19/05	FD (INCORPORATES PARSONS COMMENTS AND GENERAL REVISIONS)	JEM	DDV	KWD	DNN	VN

QUALITY 0 Non-0

BECHTEL PARSONS BLUE GRASS
DOD PROGRAM MANAGER FOR ASSEMBLED CHEMICAL WEAPONS ASSESSMENT EDGEWOOD, MARYLAND
US ARMY ENGINEERING AND SUPPORT CENTER, HUNTSVILLE HUNTSVILLE, ALABAMA

BLUE GRASS CHEMICAL AGENT DESTRUCTION PILOT PLANT PROJECT (BGCAPP)
RICHMOND, KENTUCKY
CONTRACT NO. DAAA09-03-D-0023
SCWO PROCESSING BUILDING REACTOR BLOWDOWN & PRESS RELIEF HDR PIPING & INSTRUMENT DIAGRAM
DRAWING NUMBER 24915-10-M6-SCWO-00026 SHEET 1 OF 1 REV 6

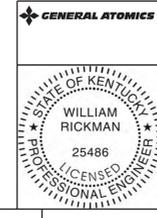

10mscow0026.ppt 01/20/12


MX-SCWO-0042
 HYDROLYSATE BLEND/BATCH TANKS HEATER MODULE
 MF-SCWO-0003
 BATCH HYDROLYSATE HOLDING TANK HTR
 DUTY : 720,000 BTU/HR
 DESIGN PRESS (SHELL) : 150 PSIG/FV
 DESIGN TEMP (SHELL) : 375 °F
 DESIGN PRESS (TUBE) : 150 PSIG
 DESIGN TEMP (TUBE) : 200 °F
 MATERIAL OF CONST (SHELL) : CARBON STEEL
 MATERIAL OF CONST (TUBE) : 316/316L SS
 TRIM (SHELL) : TRIM-0820-0"-A-HC
 TRIM (TUBE) : TRIM-0821-0"-XSA-HC
 ASME CODE STAMP HEAT EXCHANGER

GENERAL NOTES:

- FOR SYMBOLS AND LEGEND, SEE DRAWINGS
 24915-00-M6-00-0010
 24915-00-M6-00-0011
 24915-00-M6-00-0012
 24915-00-M6-00-0013
 24915-00-M6-00-0014
 24915-00-M6-00-0015
- COMMON INSTRUMENT AIR HEADER SERVICES COMPONENTS ON THIS PID AS WELL AS COMPONENTS ON PID 24915-10-M6-SCWO-00030.
- STEAM TRAP YARWAY 721 OR EQUAL WITH INTEGRAL Y-STRAINER AND BLOWOFF VALVE.
- FLOAT AND THERMOSTATIC STEAM TRAP.
- NOTES 2, 3 AND 6 ARE DELETED.

APPROVED
 By Ron Rhea at 3:56 pm, Mar 10, 2014

This document has been reviewed for ISTAR/EAR and no ISTAR/EAR sensitive information was found.

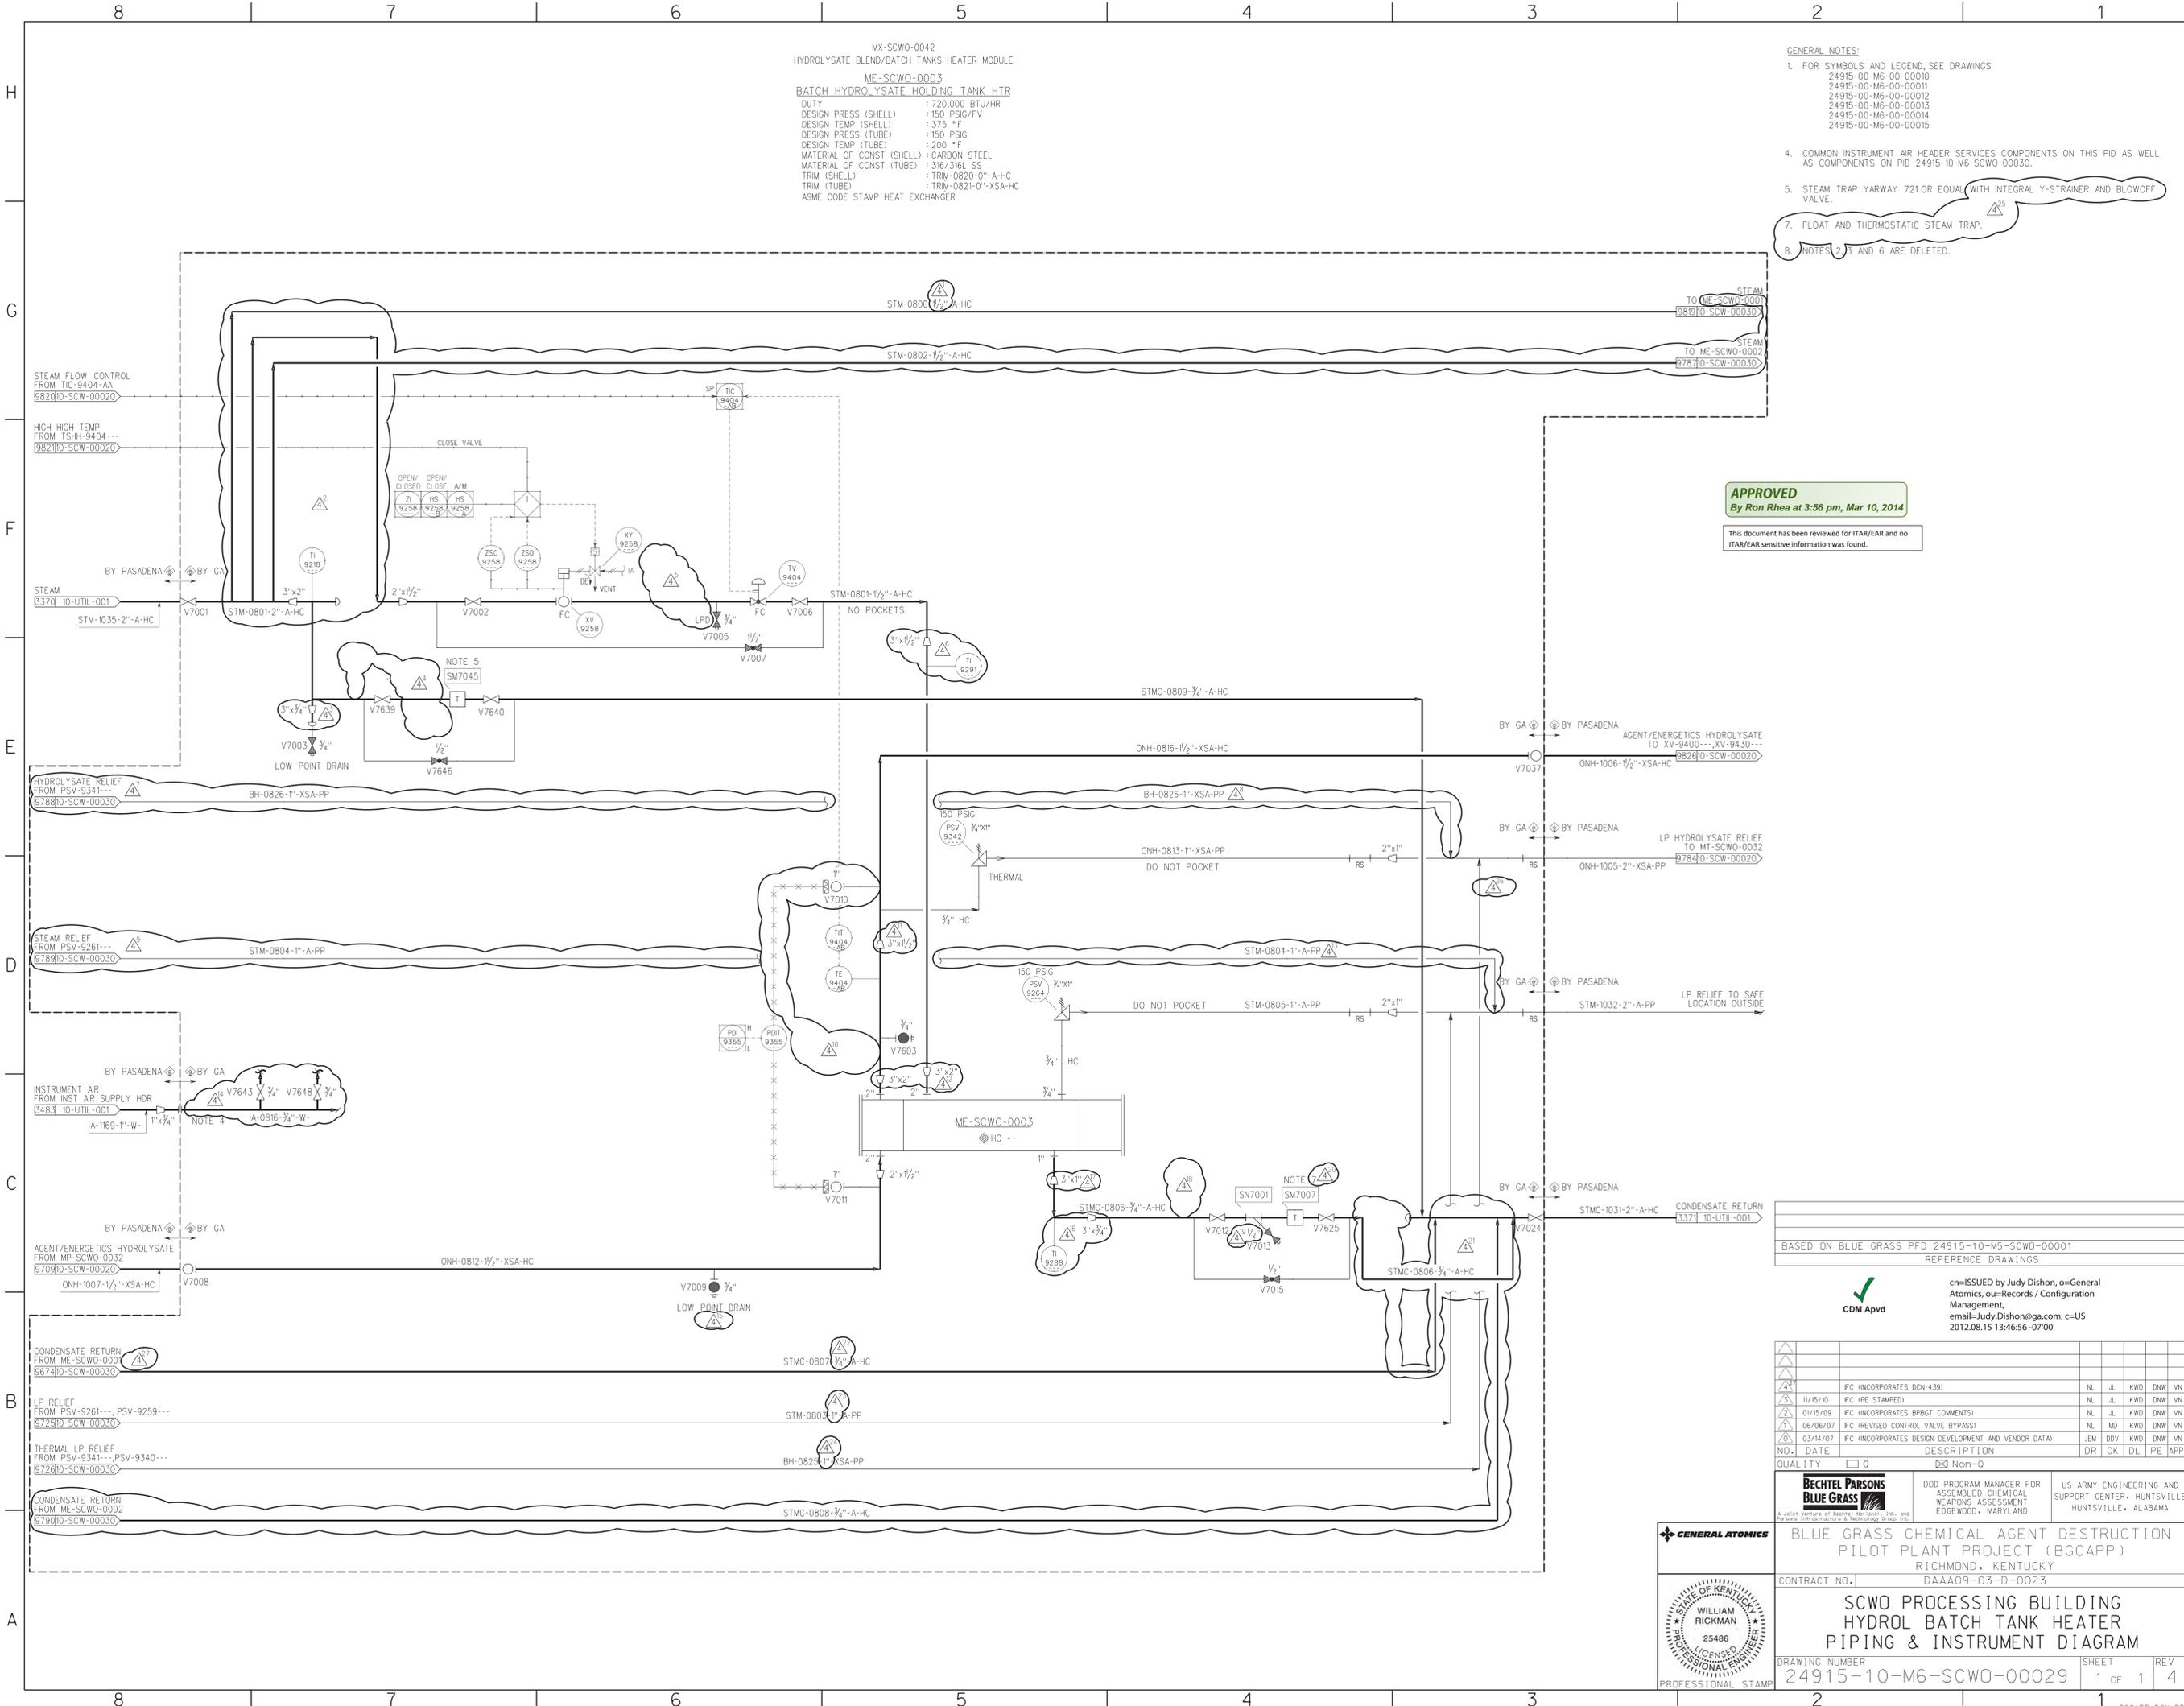


BASED ON BLUE GRASS PFD 24915-10-M6-SCWO-00001
 REFERENCE DRAWINGS

cn=ISSUED by Judy Dishon, o=General
 Atomics, ou=Records / Configuration
 Management,
 email=Judy.Dishon@ga.com, c=US
 2012.08.15 13:46:56 -0700

NO.	DATE	DESCRIPTION	DR	CK	DL	PE	APPD
1	03/14/07	FC (INCORPORATES DESIGN DEVELOPMENT AND VENDOR DATA)	JEM	DDV	KWO	DNW	VN
2	06/06/07	FC (REVISED CONTROL VALVE BYPASS)	NL	MD	KWO	DNW	VN
3	01/15/09	FC (INCORPORATES BPBG COMMENTS)	NL	JL	KWO	DNW	VN
4	11/15/10	FC (IPE STAMPED)	NL	JL	KWO	DNW	VN
5	11/15/10	FC (INCORPORATES DCN-4391)	NL	JL	KWO	DNW	VN

QUALITY 0 Non-0

BECHTEL PARSONS BLUE GRASS
 DOD PROGRAM MANAGER FOR ASSEMBLED CHEMICAL WEAPONS ASSESSMENT EDGEWOOD, MARYLAND
 US ARMY ENGINEERING AND SUPPORT CENTER, HUNTSVILLE HUNTSVILLE, ALABAMA

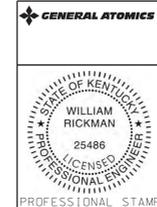


GENERAL ATOMICS
 BLUE GRASS CHEMICAL AGENT DESTRUCTION PILOT PLANT PROJECT (BGCAPP)
 RICHMOND, KENTUCKY
 CONTRACT NO. DAAA09-03-D-0023
SCWO PROCESSING BUILDING HYDROL BATCH TANK HEATER PIPING & INSTRUMENT DIAGRAM
 DRAWING NUMBER 24915-10-M6-SCWO-00029 SHEET 1 of 1 REV 4

10MSCWO0029.ppt 02/06/12

MX-SCWO-0042
HYDROLYSATE BLEND/BATCH TANKS HEATERS MODULE

<p>ME-SCWO-0001 HYDROLYSATE BLEND TANK 1 HTR</p> <p>DUTY : 720,000 BTU/HR DESIGN PRESS (SHELL) : 150 PSIG/FFV DESIGN TEMP (SHELL) : 375 °F DESIGN PRESS (TUBE) : 150 PSIG DESIGN TEMP (TUBE) : 200 °F MATERIAL OF CONST (SHELL) : CARBON STEEL MATERIAL OF CONST (TUBE) : 316/316L SS TRIM (SHELL) : TRIM-0823-0"-A-HC TRIM (TUBE) : TRIM-0823-0"-XSA-HC ASME CODE STAMP HEAT EXCHANGER</p>	<p>ME-SCWO-0002 HYDROLYSATE BLEND TANK 2 HTR</p> <p>DUTY : 720,000 BTU/HR DESIGN PRESS (SHELL) : 150 PSIG/FFV DESIGN TEMP (SHELL) : 375 °F DESIGN PRESS (TUBE) : 150 PSIG DESIGN TEMP (TUBE) : 200 °F MATERIAL OF CONST (SHELL) : CARBON STEEL MATERIAL OF CONST (TUBE) : 316/316L SS TRIM (SHELL) : TRIM-0824-0"-A-HC TRIM (TUBE) : TRIM-0825-0"-XSA-HC ASME CODE STAMP HEAT EXCHANGER</p>
--	--

- GENERAL NOTES:
- FOR SYMBOLS AND LEGEND, SEE DRAWINGS
 - 24915-00-M6-00-00010
24915-00-M6-00-00011
24915-00-M6-00-00012
24915-00-M6-00-00013
24915-00-M6-00-00014
24915-00-M6-00-00015
 - FLOAT AND THERMOSTATIC STEAM TRAP
 - NOTE 2 AND 4 ARE DELETED.

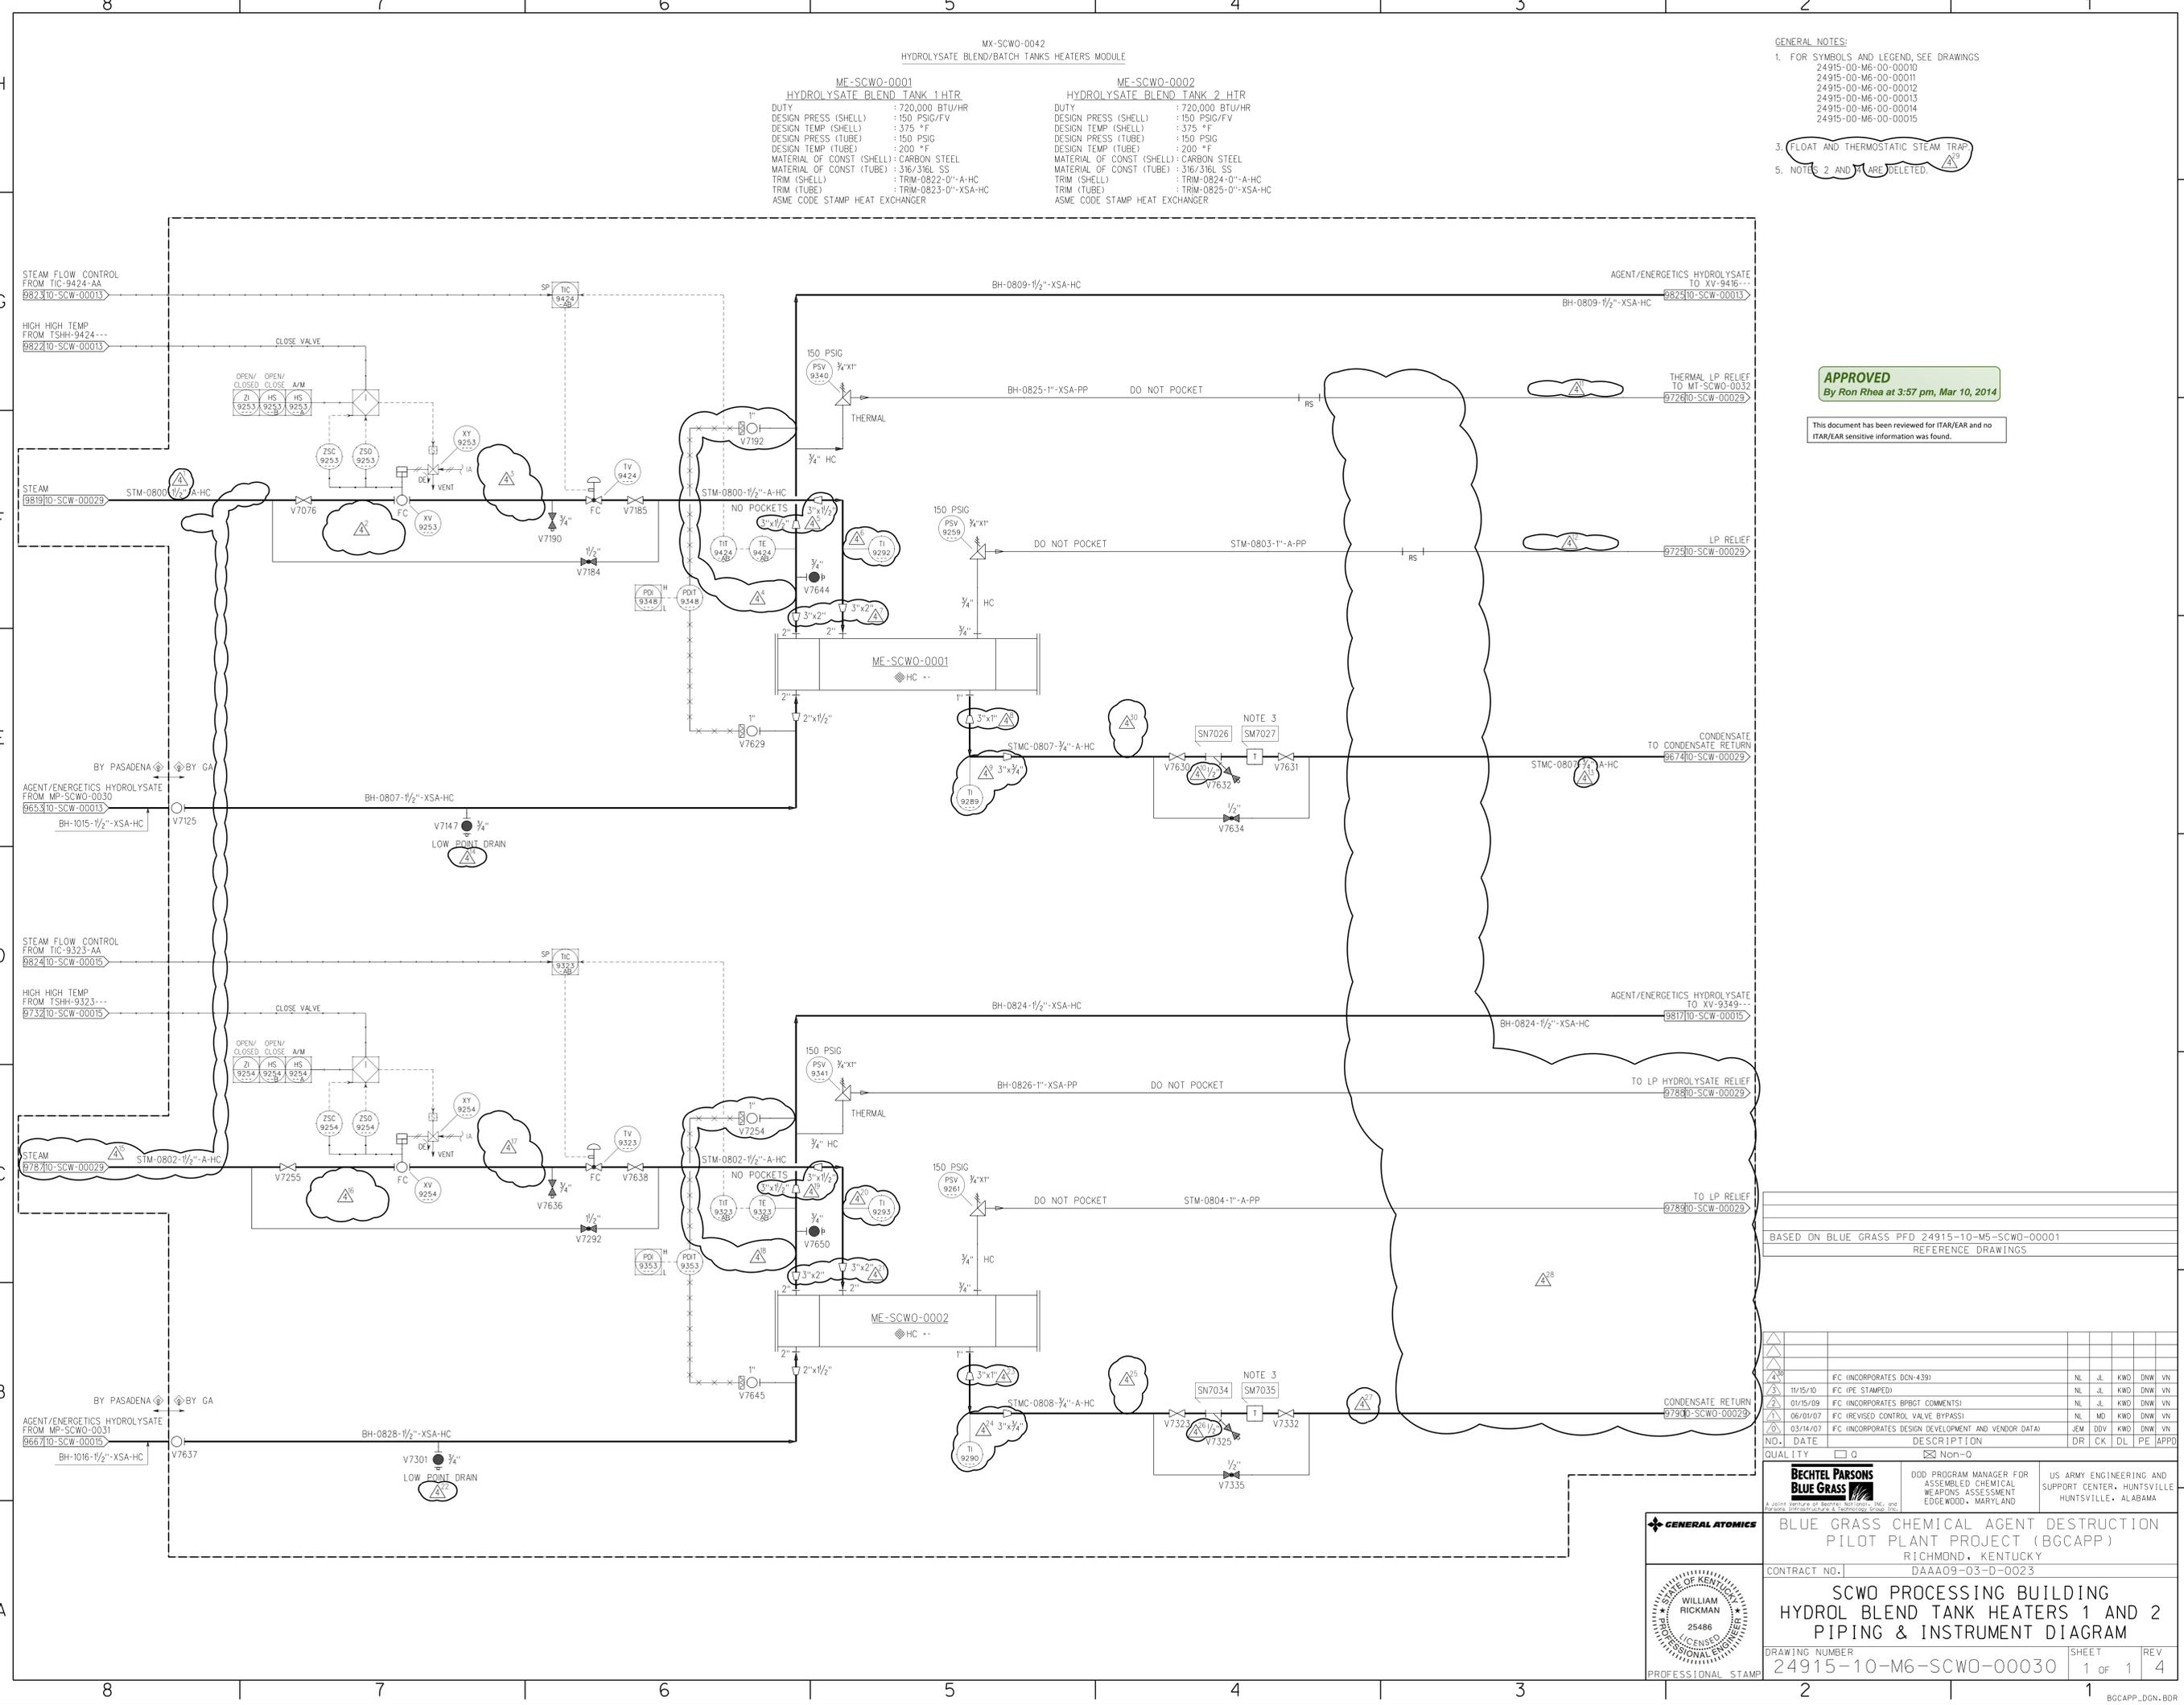

APPROVED
By Ron Rhea at 3:57 pm, Mar 10, 2014

This document has been reviewed for ITR/EAR and no ITR/EAR sensitive information was found.


BASED ON BLUE GRASS PFD 24915-10-M5-SCWO-00001
REFERENCE DRAWINGS

NO.	DATE	DESCRIPTION	DR	CK	DL	PE	APPD
1	03/14/07	FC (INCORPORATES DESIGN DEVELOPMENT AND VENDOR DATA)	JEM	DDV	KWD	DNW	VN
2	06/01/07	FC (REVISED CONTROL VALVE BYPASS)	NL	MD	KWD	DNW	VN
3	01/15/09	FC (INCORPORATES BPBG COMMENTS)	NL	JL	KWD	DNW	VN
4	11/15/10	FC (INCORPORATES DCN-4391)	NL	JL	KWD	DNW	VN

QUALITY 0 Non-0

BECHTEL PARSONS

DOD PROGRAM MANAGER FOR ASSEMBLED CHEMICAL WEAPONS ASSESSMENT EDGWOOD, MARYLAND
US ARMY ENGINEERING AND SUPPORT CENTER, HUNTSVILLE HUNTSVILLE, ALABAMA

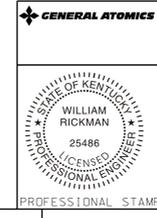

BLUE GRASS CHEMICAL AGENT DESTRUCTION PILOT PLANT PROJECT (BGCAPP)
RICHMOND, KENTUCKY
DAAA09-03-D-0023

SCWO PROCESSING BUILDING HYDROL BLEND TANK HEATERS 1 AND 2 PIPING & INSTRUMENT DIAGRAM

CONTRACT NO. | DRAWING NUMBER | SHEET | REV
24915-10-M6-SCWO-00030 | 1 of 1 | 4

10MSCWO0030.ppt 07/02/12

MX-SCWO-1020
SCWO REACTOR 1 FEED MODULE

MP-SCWO-1020
HP HYDROLYSATE FEED PUMP
RATED FLOW : 1.7 / 3.5 GPM
RATED DELTA P : 4300 PSI
MOTOR HP : 20 HP
MATERIAL OF CONST : PTFE AND C-276/TISS

MP-SCWO-1022
QUENCH WATER PUMP
RATED FLOW : 3 / 33 GPM
RATED DELTA P : 4300 PSI
MOTOR HP : 125 HP
MATERIAL OF CONST : 316/316L

- GENERAL NOTES:
- FOR SYMBOLS AND LEGEND, SEE DRAWINGS
24915-00-M6-00-0010
24915-00-M6-00-0011
24915-00-M6-00-0012
24915-00-M6-00-0013
24915-00-M6-00-0014
24915-00-M6-00-0015
 - THE FOLLOWING VALVES ARE NORMALLY CLOSED:
XV-9143A--
XV-9176A--
 - HP RELIEF PIPING TO BE ADEQUATELY ANCHORED, SLOPED TOWARDS EMERGENCY RELIEF TANK OR BLEND TANK, AND WITH NO POCKETS.
 - INTERCONNECTING PIPING BY GA.
 - ELECTRICAL AREA CLASSIFICATION:
UNCLASSIFIED (PER DIRECTION FROM GOVERNMENT 5/4/06 CORRESPONDENCE)
 - PROGRAM AN INTERLOCK FOR XV-9148A-- TO ENSURE THAT IT CANNOT BE OPENED WHILE XV-9147A-- IS OPEN.
 - SHUT-OFF HP PUMP (HYDROLYSATE OR QUENCH WATER) UPON Δ LOW-LOW ALARM WHEN PUMP IS RUNNING.
 - HIGH PRESSURE SERVICE PIPING IN BETWEEN SKIDS SHALL BE PROVIDED WITH ADDITIONAL SHIELDING AND ROUTED TO MINIMIZE OPERATOR EXPOSURE TO POTENTIAL VALVE OR FITTING LEAKS. USE WELDED CONSTRUCTION TO MAXIMUM PRACTICAL EXTENT IN THE HIGH PRESSURE PIPING ON AND IN BETWEEN THE SCWO SKIDS. ADDITIONAL SHIELDING TO BE ADDED WHEN PIPING IS INSTALLED AT BGCAPP.
 - \diamond DENOTES DESIGN RESPONSIBILITY LABEL.
 - FLOW CHECK VALVE TO BE OPERATED AT LOW PRESSURE (i.e. PRESSURES < 30 PSIG OR LESS)
 - VFD TO BE PROVIDED BY PASADENA.
 - PROGRAM AN INTERLOCK BETWEEN XV-9143A-- AND XV-9222A-- (SEE SCWO PID - 01013) TO ENSURE BOTH VALVES ARE NOT OPEN AT THE SAME TIME.
 - PROGRAM AN INTERLOCK BETWEEN XV-9176A-- AND XV-9198A-- (SEE SCWO PID - 01013) TO ENSURE BOTH VALVES ARE NOT OPEN AT THE SAME TIME.
 - * DENOTES SUPPLIED BY VENDOR.
 - PCV-9175A-- SETPOINT IS FOR PUMP CALIBRATION ONLY. SETPOINT TO BE ADJUSTED DOWN FOR OPERATION TO ALLOW PUMP RE-START AT NO LOAD.
 - RELIEVE INTO QUENCH PUMP DRIP PAN.
 - NOTES 6, 8, 9, 10, 11, 12, 16, 21, 23, 24, 25, 26 AND 27 ARE DELETED.

APPROVED
By Ron Rhea at 3:58 pm, Mar 10, 2014

This document has been reviewed for ITR/EAR and no ITR/EAR sensitive information was found.

BASED ON BLUE GRASS PFD 24915-10-M5-SCWO-00001
REFERENCE DRAWINGS

cn=ISSUED by Judy Dishon, o=General Atomics, ou=Configuration / Data Management, email=Judy.dishon@ga.com, c=US 2013.06.18 09:56:21 -0700

CDM Apvd

NO.	DATE	DESCRIPTION	DR	CK	DL	PE	APPD
1	10/19/05	FD INCORPORATES PARSONS COMMENTS AND GENERAL REVISIONS	JEM	DDV	KWD	DNN	VN
2	08/07/06	FD INCORPORATES GOV'T COMMENTS AND DESIGN DEVELOPMENT	JEM	DDV	KWD	DNN	VN
3	03/16/07	FC INCORPORATES TRAIN 2 & TRAIN 3 DRAWINGS	JEM	MD	KWD	DNN	VN
4	06/01/07	FC INCORPORATES BPGT COMMENTS	NL	JL	KWD	DNN	VN
5	11/15/10	FC (PE STAMPED)	NL	WR	KWD	KWD	VN
6	01/24/12	FC INCORPORATES DCN-381	NL	WR	KWD	KWD	VN
7	01/24/12	FC INCORPORATES DCN-1040	NL	WR	KWD	KWD	VN


QUALITY 0 Non-0

BECHTEL PARSONS BLUE GRASS
DOD PROGRAM MANAGER FOR ASSEMBLED CHEMICAL WEAPONS ASSESSMENT EDGEWOOD, MARYLAND
US ARMY ENGINEERING AND SUPPORT CENTER, HUNTSVILLE, ALABAMA

BLUE GRASS CHEMICAL AGENT DESTRUCTION PILOT PLANT PROJECT (BGCAPP)
RICHMOND, KENTUCKY
DAAA09-03-D-0023

SCWO PROCESSING BUILDING
TRAIN 1 QUENCH WATER AND HYDROL FEED PIPING & INSTRUMENT DIAGRAM


DRAWING NUMBER 24915-10-M6-SCWO-01012 SHEET 1 of 1 REV 7

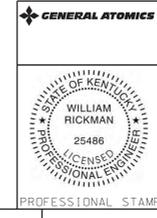

10MSCW0102.ppt 03/15/13

...wvgjlipid10mscow1012.ppt 3/15/2013 8:40:18 AM

BGCAPP_DGN_BDR

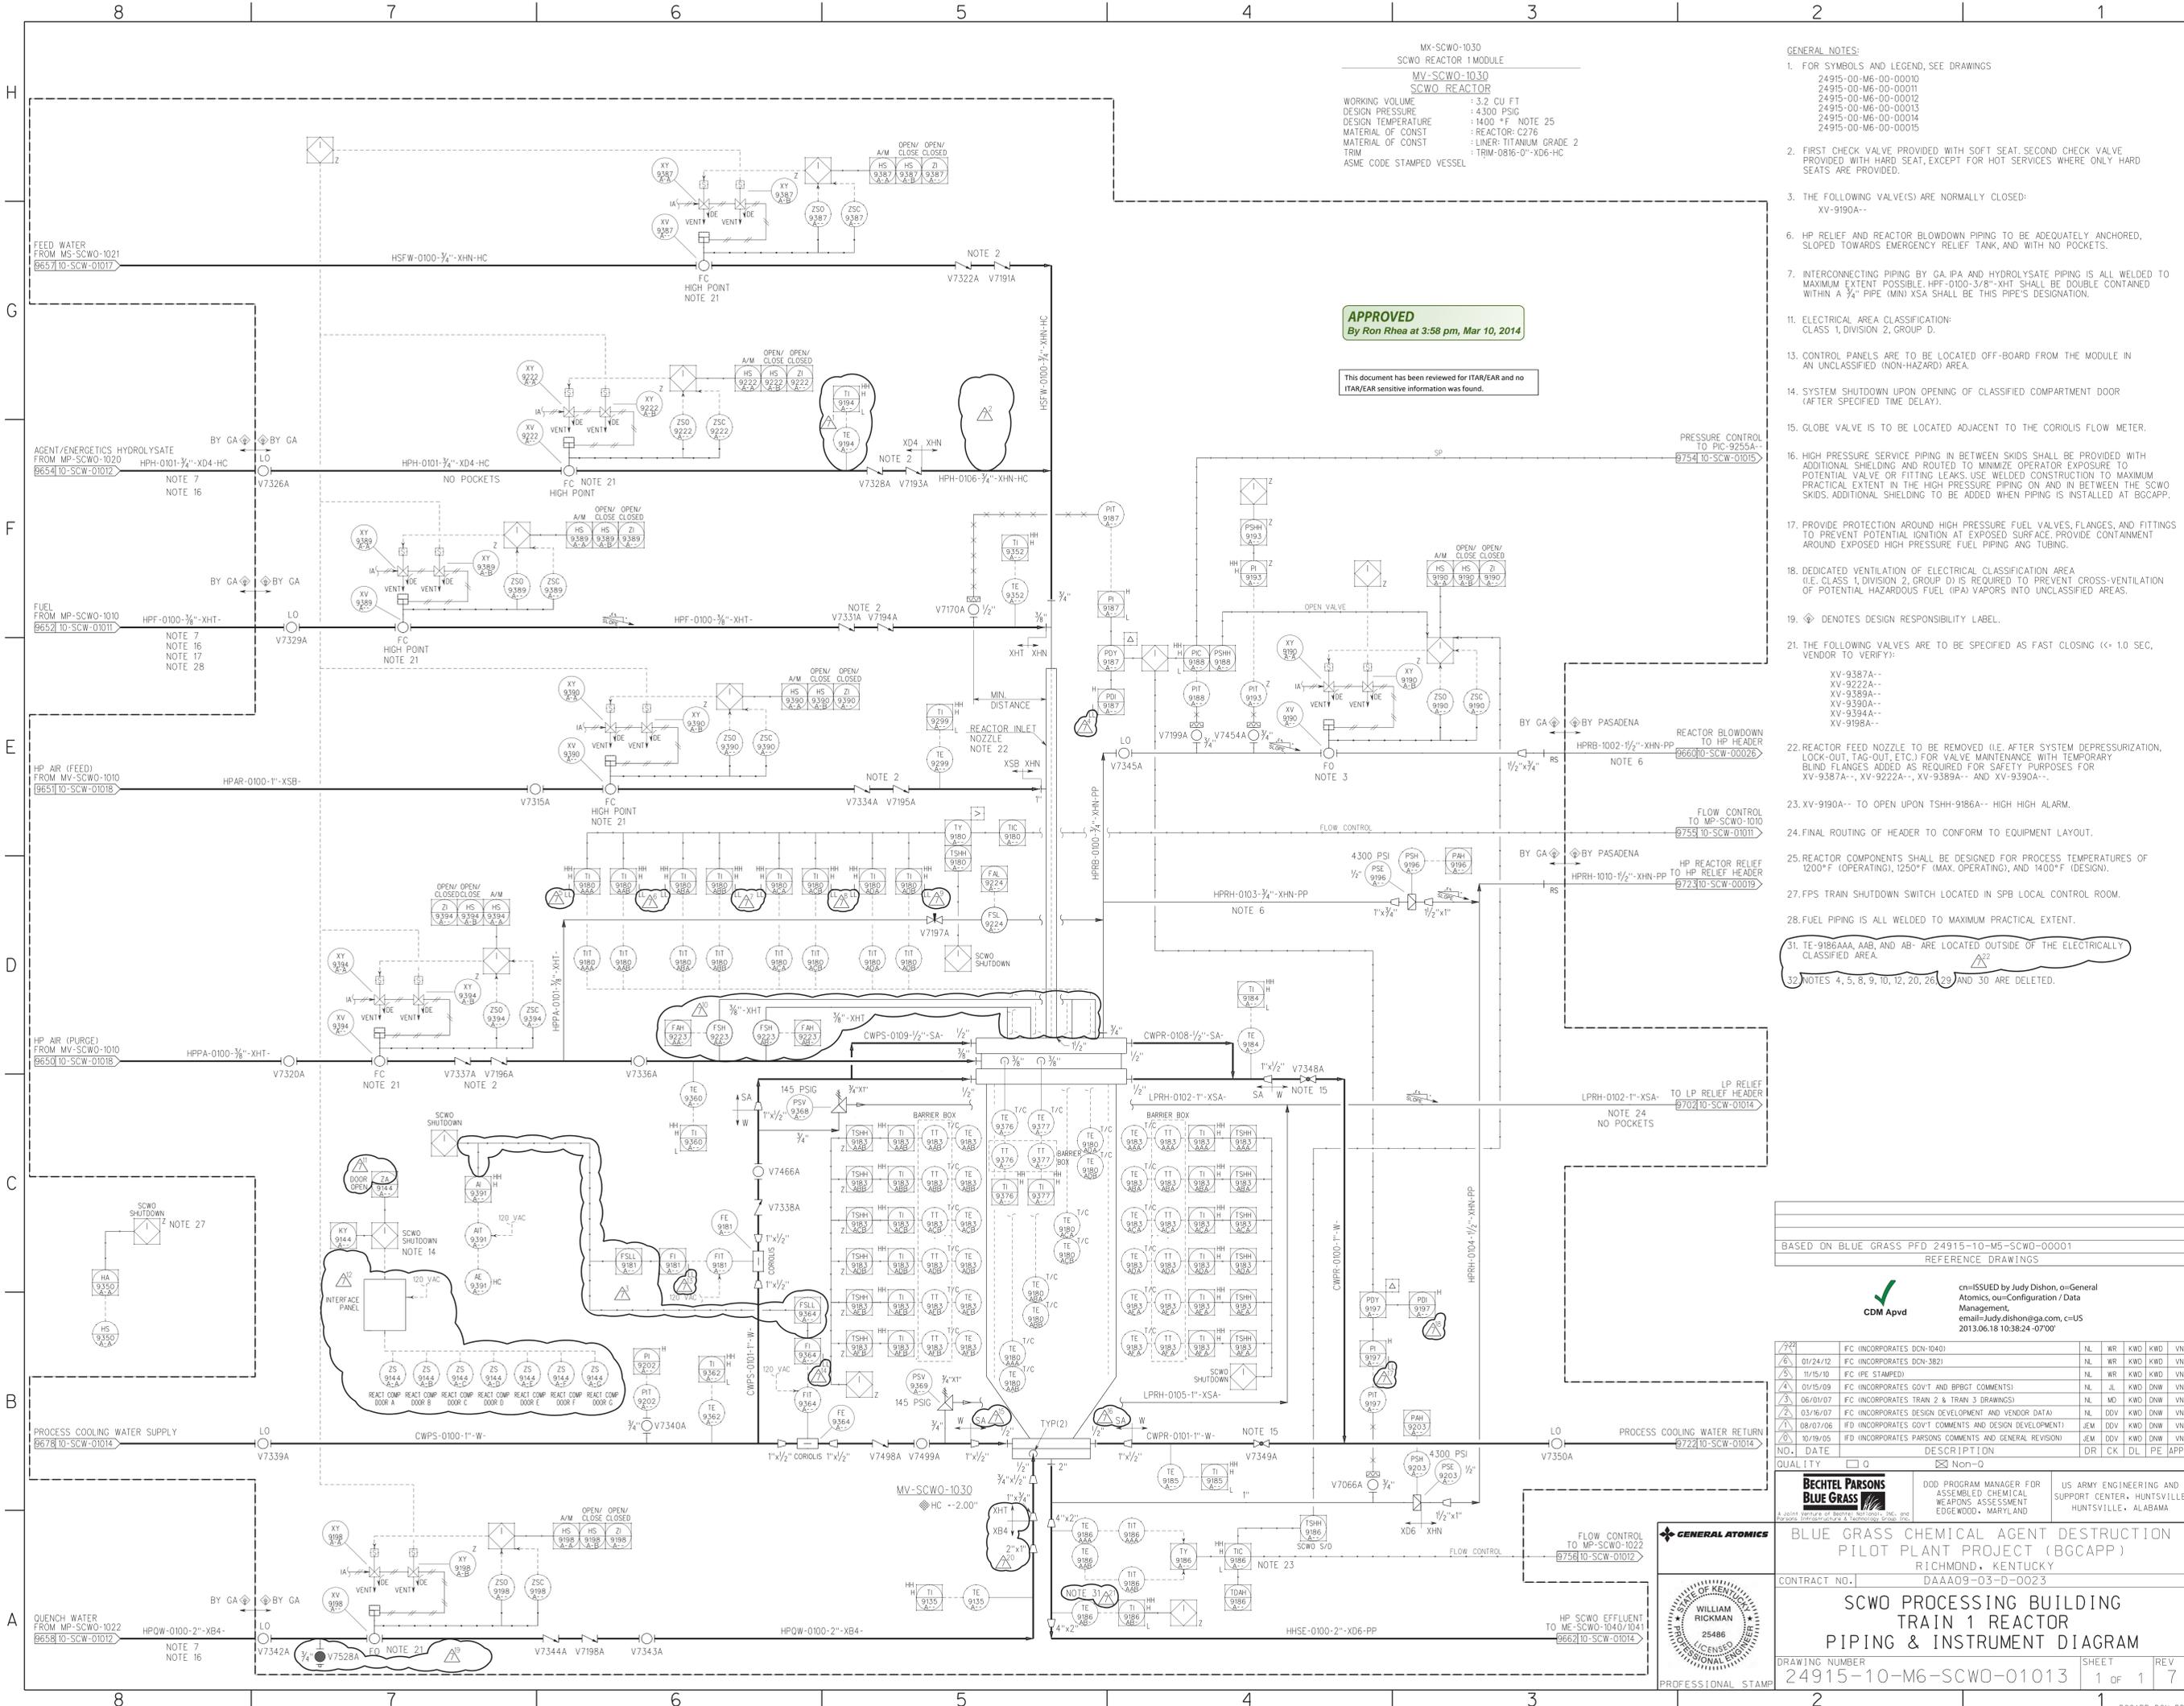

APPROVED
By Ron Rhea at 3:58 pm, Mar 10, 2014

This document has been reviewed for ISTAR/EAR and no ISTAR/EAR sensitive information was found.

- GENERAL NOTES:**
- FOR SYMBOLS AND LEGEND, SEE DRAWINGS
 - 24915-00-M6-00-00010
24915-00-M6-00-00011
24915-00-M6-00-00012
24915-00-M6-00-00013
24915-00-M6-00-00014
24915-00-M6-00-00015
 - FIRST CHECK VALVE PROVIDED WITH SOFT SEAT, SECOND CHECK VALVE PROVIDED WITH HARD SEAT, EXCEPT FOR HOT SERVICES WHERE ONLY HARD SEATS ARE PROVIDED.
 - THE FOLLOWING VALVE(S) ARE NORMALLY CLOSED:
XV-9190A--
 - HP RELIEF AND REACTOR BLOWDOWN PIPING TO BE ADEQUATELY ANCHORED, SLOPED TOWARDS EMERGENCY RELIEF TANK, AND WITH NO POCKETS.
 - INTERCONNECTING PIPING BY GA, IPA AND HYDROLYSATE PIPING IS ALL WELDED TO MAXIMUM PRACTICAL EXTENT. HPF-0100-3/8"-XHT SHALL BE DOUBLE CONTAINED WITHIN A 3/4" PIPE (MIN) XSA SHALL BE THIS PIPE'S DESIGNATION.
 - ELECTRICAL AREA CLASSIFICATION:
CLASS 1, DIVISION 2, GROUP D.
 - CONTROL PANELS ARE TO BE LOCATED OFF-BOARD FROM THE MODULE IN AN UNCLASSIFIED (NON-HAZARD) AREA.
 - SYSTEM SHUTDOWN UPON OPENING OF CLASSIFIED COMPARTMENT DOOR (AFTER SPECIFIED TIME DELAY).
 - GLOBE VALVE IS TO BE LOCATED ADJACENT TO THE CORIOLIS FLOW METER.
 - HIGH PRESSURE SERVICE PIPING IN BETWEEN SKIDS SHALL BE PROVIDED WITH ADDITIONAL SHIELDING AND ROUTED TO MINIMIZE OPERATOR EXPOSURE TO POTENTIAL VALVE OR FITTING LEAKS. USE WELDED CONSTRUCTION TO MAXIMUM PRACTICAL EXTENT IN THE HIGH PRESSURE PIPING AND IN BETWEEN THE SCWO SKIDS, ADDITIONAL SHIELDING TO BE ADDED WHEN PIPING IS INSTALLED AT BGCAPP.
 - PROVIDE PROTECTION AROUND HIGH PRESSURE FUEL VALVES, FLANGES, AND FITTINGS TO PREVENT POTENTIAL IGNITION AT EXPOSED SURFACE, PROVIDE CONTAINMENT AROUND EXPOSED HIGH PRESSURE FUEL PIPING AND TUBING.
 - DEDICATED VENTILATION OF ELECTRICAL CLASSIFICATION AREA (I.E. CLASS 1, DIVISION 2, GROUP D) IS REQUIRED TO PREVENT CROSS-VENTILATION OF POTENTIAL HAZARDOUS FUEL (IPA) VAPORS INTO UNCLASSIFIED AREAS.
 - Ⓢ DENOTES DESIGN RESPONSIBILITY LABEL.
 - THE FOLLOWING VALVES ARE TO BE SPECIFIED AS FAST CLOSING (< 1.0 SEC, VENDOR TO VERIFY):
XV-9387A--
XV-9222A--
XV-9389A--
XV-9390A--
XV-9394A--
XV-9198A--
 - REACTOR FEED NOZZLE TO BE REMOVED (I.E. AFTER SYSTEM DEPRESSURIZATION, LOCK-OUT, TAG-OUT, ETC.) FOR VALVE MAINTENANCE WITH TEMPORARY BLIND FLANGES ADDED AS REQUIRED FOR SAFETY PURPOSES FOR XV-9387A-- , XV-9222A-- , XV-9389A-- AND XV-9390A-- .
 - XV-9190A-- TO OPEN UPON TSHH-9186A-- HIGH HIGH ALARM.
 - FINAL ROUTING OF HEADER TO CONFORM TO EQUIPMENT LAYOUT.
 - REACTOR COMPONENTS SHALL BE DESIGNED FOR PROCESS TEMPERATURES OF 1200°F (OPERATING), 1250°F (MAX. OPERATING), AND 1400°F (DESIGN).
 - FPS TRAIN SHUTDOWN SWITCH LOCATED IN SPB LOCAL CONTROL ROOM.
 - FUEL PIPING IS ALL WELDED TO MAXIMUM PRACTICAL EXTENT.
 - TE-9186AAA, AAB, AND AB- ARE LOCATED OUTSIDE OF THE ELECTRICALLY CLASSIFIED AREA.
 - NOTES 4, 5, 8, 9, 10, 12, 20, 26, 29 AND 30 ARE DELETED.

BASED ON BLUE GRASS PFD 24915-10-M5-SCWO-00001
REFERENCE DRAWINGS

ISSUED BY Judy Dishon, c=General
Atomics, ou=Configuration / Data
Management,
email=Judy.dishon@ga.com, c=US
2013.06.18 10:38:24 -0700

CDM Apvd

NO.	DATE	DESCRIPTION	DR	CK	DL	PE	APPD
729		FC INCORPORATES DCN-1040	NL	WR	KWD	KWD	VN
6	01/24/12	FC INCORPORATES DCN-3821	NL	WR	KWD	KWD	VN
5	11/15/10	FC (P/STAMPED)	NL	WR	KWD	KWD	VN
4	01/15/09	FC INCORPORATES GOVT AND BPBGT COMMENTS	NL	JL	KWD	DNN	VN
3	06/01/07	FC INCORPORATES TRAIN 2 & TRAIN 3 DRAWINGS	NL	MD	KWD	DNN	VN
2	03/16/07	FC INCORPORATES DESIGN DEVELOPMENT AND VENDOR DATA	NL	DDV	KWD	DNN	VN
1	08/07/06	IFD INCORPORATES GOVT COMMENTS AND DESIGN DEVELOPMENT	JEM	DDV	KWD	DNN	VN
0	10/19/05	IFD INCORPORATES PARSONS COMMENTS AND GENERAL REVISIONS	JEM	DDV	KWD	DNN	VN

BECHTEL PARSONS BLUE GRASS

DOD PROGRAM MANAGER FOR ASSEMBLED CHEMICAL WEAPONS ASSESSMENT EDGEWOOD, MARYLAND

US ARMY ENGINEERING AND SUPPORT CENTER, HUNTSVILLE HUNTSVILLE, ALABAMA

BLUE GRASS CHEMICAL AGENT DESTRUCTION PILOT PLANT PROJECT (BGCAPP)
RICHMOND, KENTUCKY
DAAA09-03-D-0023

SCWO PROCESSING BUILDING TRAIN 1 REACTOR PIPING & INSTRUMENT DIAGRAM

CONTRACT NO. DAAA09-03-D-0023

DRAWING NUMBER: 24915-10-M6-SCWO-01013

SHEET: 1 of 1

REV: 7


QUALITY: 0 Non-0

GENERAL ATOMICS
WILLIAM RICKMAN
LICENSED PROFESSIONAL ENGINEER
STATE OF KENTUCKY
25486

10mscw01013.ppt 03/15/13

MX-SCWO-1030 SCWO REACTOR 1 MODULE	
ME-SCWO-1040 EFFLUENT HEAT EXCHANGER 1	
DUTY	: 1,710,000 BTU/HR
DESIGN PRESS (SHELL)	: 150 PSIG
DESIGN TEMP (SHELL)	: 185 °F
DESIGN PRESS (TUBE)	: 4,300 PSIG
DESIGN TEMP (TUBE)	: 750 °F
MATERIAL OF CONST (SHELL)	: CARBON STEEL
MATERIAL OF CONST (TUBE)	: C276
TRM (SHELL)	: TRM-0808-0"-W-
TRM (TUBE)	: TRM-0809-0"-XD6-PP
ASME CODE STAMPED VESSEL	
ME-SCWO-1041 EFFLUENT HEAT EXCHANGER 2	
DUTY	: 1,710,000 BTU/HR
DESIGN PRESS (SHELL)	: 150 PSIG
DESIGN TEMP (SHELL)	: 185 °F
DESIGN PRESS (TUBE)	: 4,300 PSIG
DESIGN TEMP (TUBE)	: 750 °F
MATERIAL OF CONST (SHELL)	: CARBON STEEL
MATERIAL OF CONST (TUBE)	: C276
TRM (SHELL)	: TRM-0810-0"-W-
TRM (TUBE)	: TRM-0811-0"-XD6-PP
ASME CODE STAMPED VESSEL	

- GENERAL NOTES:
- FOR SYMBOLS AND LEGEND, SEE DRAWINGS
24915-00-M6-00-00010
24915-00-M6-00-00011
24915-00-M6-00-00012
24915-00-M6-00-00013
24915-00-M6-00-00014
24915-00-M6-00-00015
 - CONTROL PANELS ARE TO BE LOCATED OFF-BOARD FROM THE MODULE IN UNCLASSIFIED (NON-HAZARD) AREA.
 - SCWO REACTOR TO SHUT DOWN ON HIGH-HIGH COOLING WATER DISCHARGE TEMPERATURE OR HIGH-HIGH EFFLUENT TEMPERATURE.
 - Ⓢ DENOTES DESIGN RESPONSIBILITY LABEL.
 - FINAL ROUTING OF RELIEF HEADER TO CONFORM TO EQUIPMENT LAYOUT.
 - NOTES 2, 3, 4, 5, 8, 10, 12, 13, 14 AND 15 ARE DELETED.

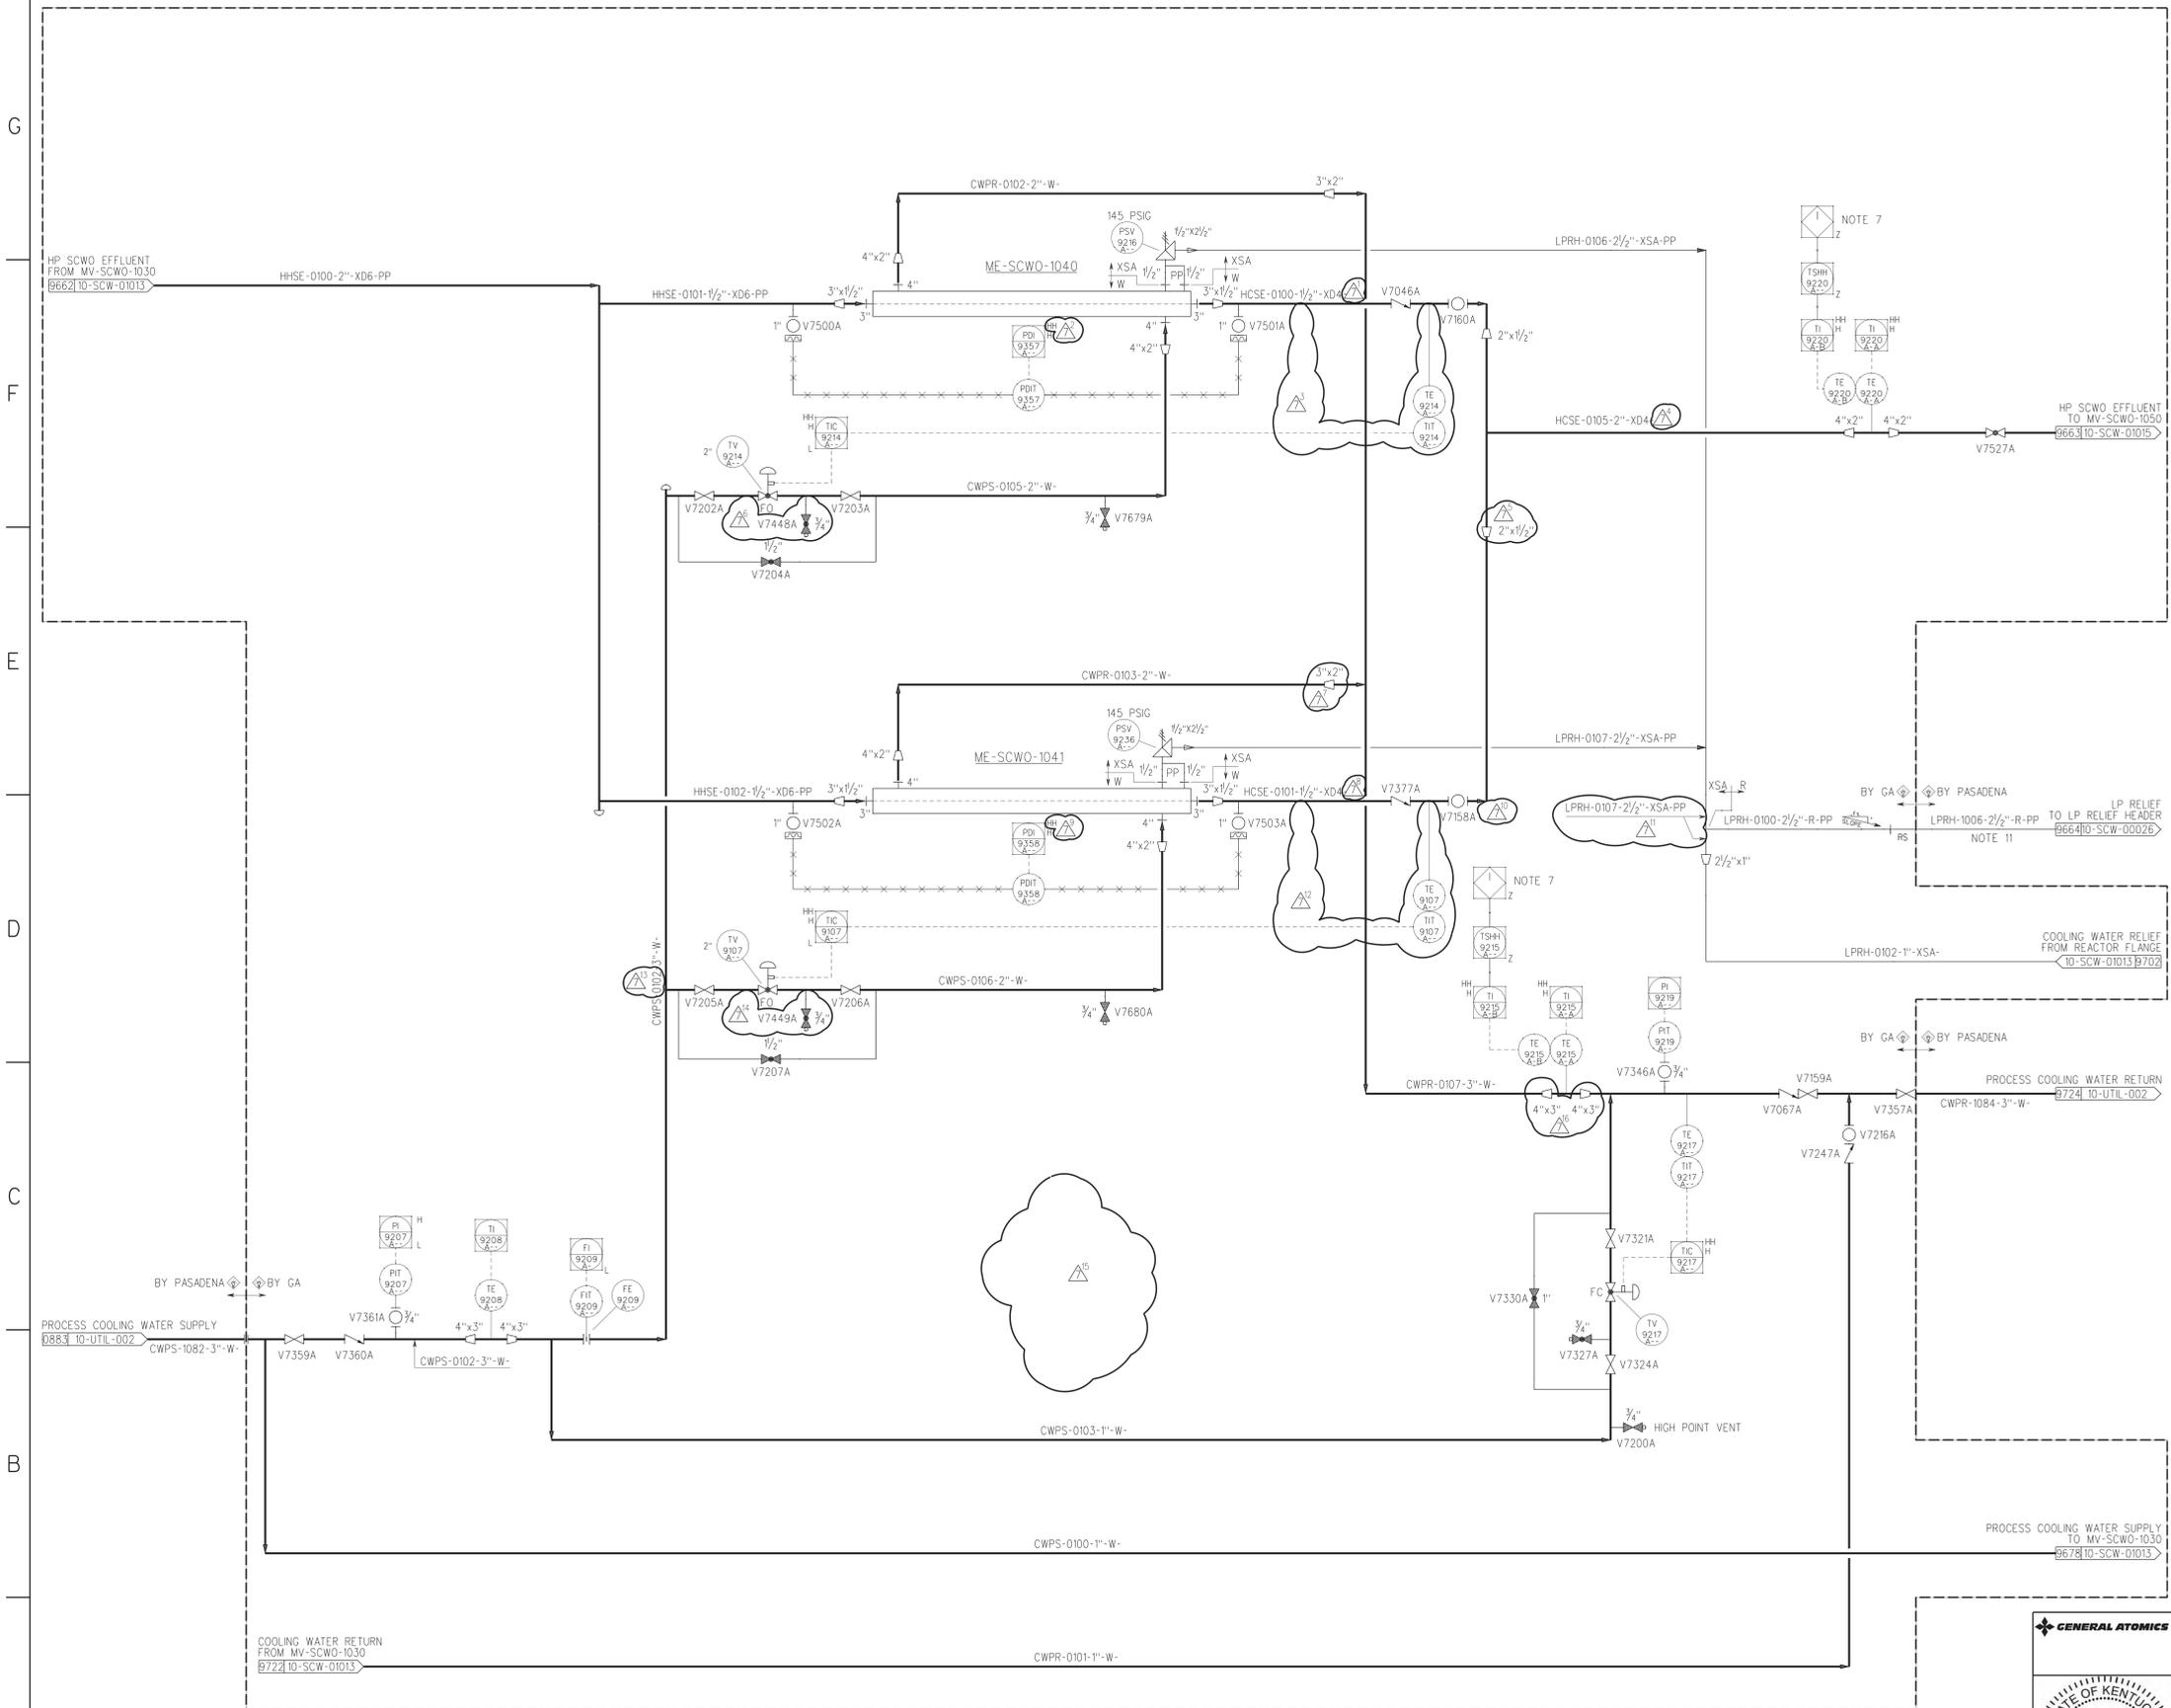

APPROVED
By Ron Rhea at 3:59 pm, Mar 10, 2014

This document has been reviewed for ITAR/EAR and no ITAR/EAR sensitive information was found.

BASED ON BLUE GRASS PFD 24915-10-M5-SCWO-00001
REFERENCE DRAWINGS

CDM Apvd

Issued by Mike Batobato, o=General Atomics, ou=Configuration Management, email=Miguel.Batobato@ga.com, c=US, 2013.06.18 09:55:25 -0700

NO.	DATE	DESCRIPTION	DR	CK	DL	PE	APPD
1	01/23/12	FC (INC DCN-1040)	NL	WR	KWD	KWD	YN
2	01/23/12	FC (INC DCN-382)	NL	WR	KWD	KWD	YN
3	11/15/10	FC (PE STAMPED)	NL	WR	KWD	KWD	YN
4	01/20/09	FC (INCORPORATES BPBG COMMENTS)	NL	JL	KWD	DNN	YN
5	06/01/07	FC (INCORPORATES TRAIN 2 & TRAIN 3 DRAWINGS)	NL	MD	KWD	DNN	YN
6	03/16/07	FC (INCORPORATES DESIGN DEVELOPMENT AND VENDOR DATA)	NL	DDV	KWD	DNN	YN
7	08/08/06	FD (INCORPORATES GOV'T COMMENTS AND DESIGN DEVELOPMENT)	JEM	DDV	KWD	DNN	YN
8	10/19/05	FD (INCORPORATES PARSONS COMMENTS AND GENERAL REVISIONS)	JEM	DDV	KWD	DNN	YN

QUALITY 0 Non-0

BECHTEL PARSONS BLUE GRASS

US ARMY ENGINEERING AND SUPPORT CENTER, HUNTSVILLE, ALABAMA

BLUE GRASS CHEMICAL AGENT DESTRUCTION PILOT PLANT PROJECT (BGCAPP)
RICHMOND, KENTUCKY
DAAA09-03-D-0023

SCWO PROCESSING BUILDING TRAIN 1 EFFLUENT COOLING PIPING & INSTRUMENT DIAGRAM

CONTRACT NO. 24915-10-M6-SCWO-01014 SHEET 1 OF 1 REV 7

GENERAL ATOMICS
WILLIAM RICKMAN
25486
LICENSED PROFESSIONAL ENGINEER

10MSW0104.pdf 03/15/13

BCCAPP_DGN_BDR



MX-SCWO-1031
TOC SAMPLER ANALYZER MODULE

GENERAL NOTES:

- FOR SYMBOLS AND LEGEND, SEE DRAWINGS
24915-00-M6-00-00010
24915-00-M6-00-00011
24915-00-M6-00-00012
24915-00-M6-00-00013
24915-00-M6-00-00014
24915-00-M6-00-00015
- CONTROL PANELS AND TOC SAMPLE ANALYZERS ARE TO BE LOCATED OFF-BOARD FROM THE MODULE IN UNCLASSIFIED (NON-HAZARDOUS) AREA.
- TOC ANALYZER SAMPLE PUMP(S) SHALL BE SIZED WITH HEAD GREATER THAN LIQUID EFFLUENT PUMP.
- ◇ DENOTES DESIGN RESPONSIBILITY LABEL.
- * DENOTES SUPPLIED BY VENDOR.
- SUMP PUMP TURNS ON UPON HIGH RESERVOIR LIQUID LEVEL. SUMP PUMP TURNS OFF UPON LOW AND LOW LOW RESERVOIR LIQUID LEVEL.
- VALVE LV-9421A-- OPENS WHEN SUMP PUMP TURNS ON AND CLOSES WHEN SUMP PUMP TURNS OFF.
- NOTE 8 IS DELETED.

APPROVED
By Ron Rhea at 4:00 pm, Mar 10, 2014

This document has been reviewed for ITR/EAR and no ITR/EAR sensitive information was found.

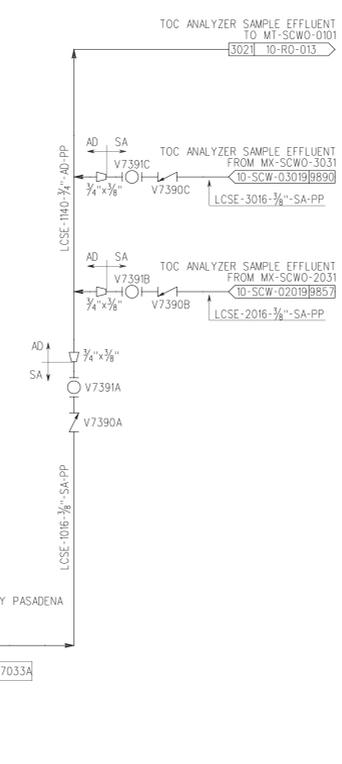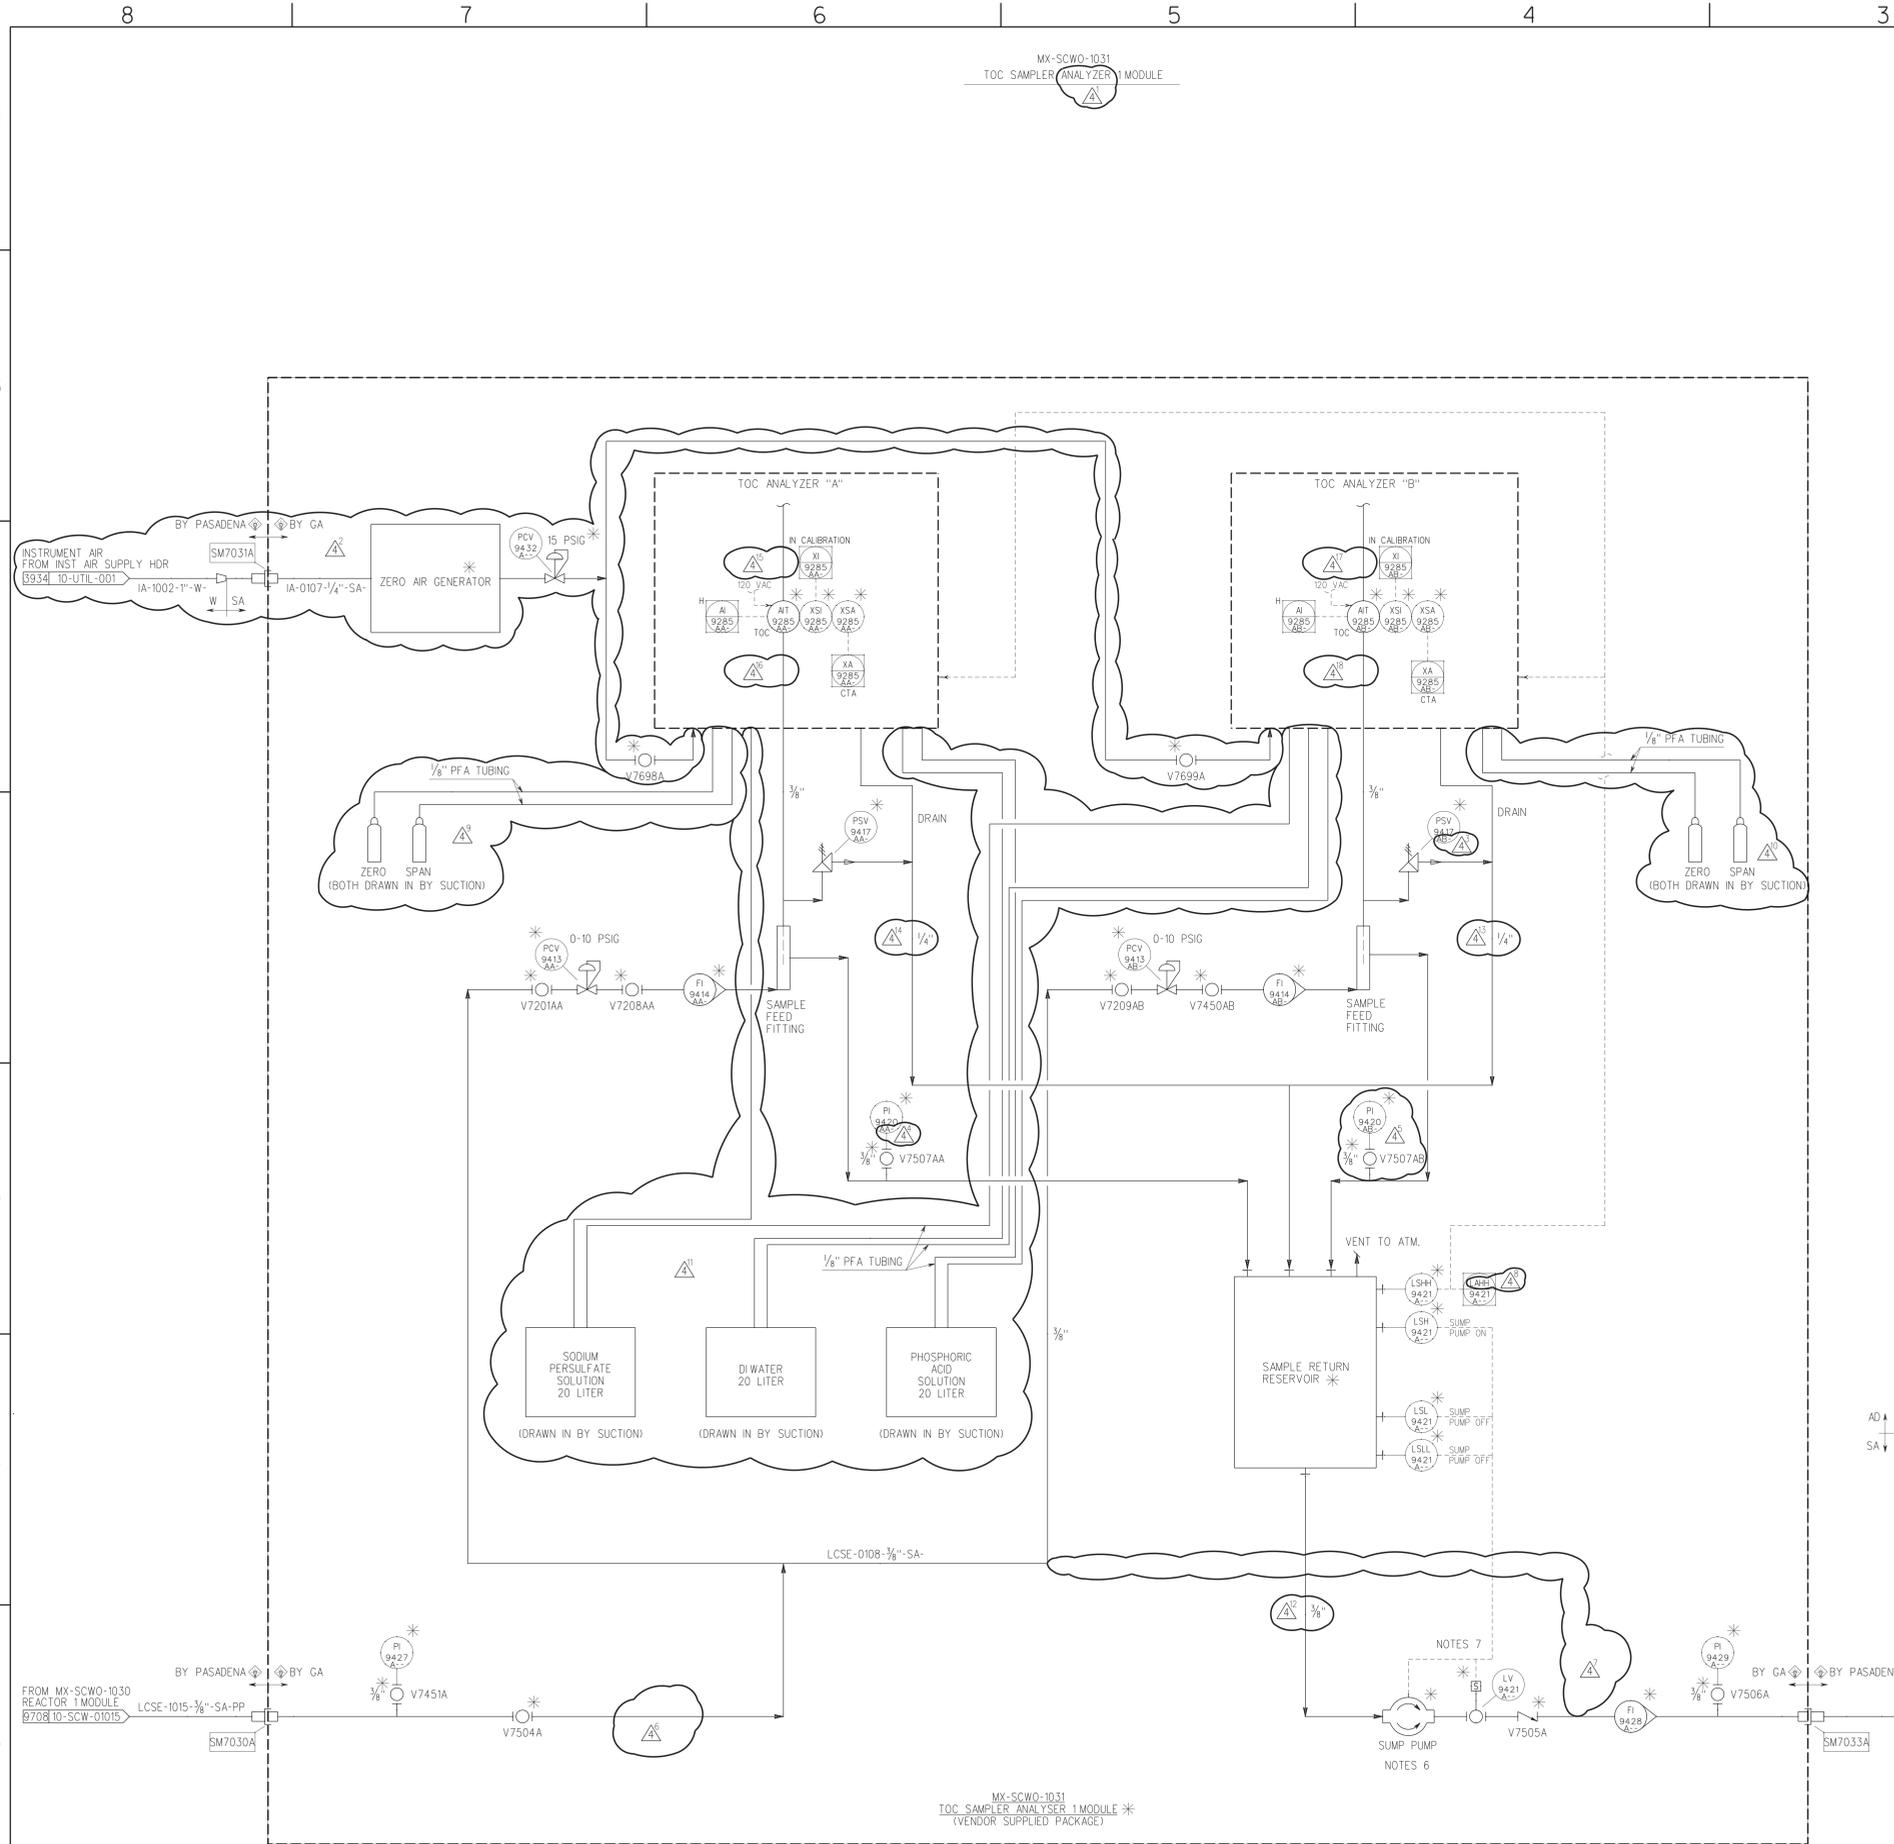

BASED ON BLUE GRASS PFD 24915-10-M5-SCWO-00001
REFERENCE DRAWINGS

RCM Apvd
DN: cn=Issued by Mike Batobato, o=General Atomics, ou=Configuration Management, email=Miguel.Batobato@ga.com, c=US
Date: 2012.10.02 10:00:56 -0700

NO.	DATE	DESCRIPTION	DR	CK	DL	PE	APPD
1	03/14/07	FC (INCORPORATES DESIGN DEVELOPMENT AND VENDOR DATA)	NL	DDV	KWD	DNN	VN
2	06/01/07	FC (INCORPORATES TRAIN 2 & TRAIN 3 DRAWINGS)	JEM	MD	KWD	DNN	VN
3	11/15/10	FC (INCORPORATES BPBG COMMENTS)	NL	JL	KWD	DNN	VN
4	11/15/10	FC (INCORPORATES DCN-441)	NL	WR	KWD	DNN	VN

QUALITY 0 Non-0


BECHTEL PARSONS BLUE GRASS
DOD PROGRAM MANAGER FOR ASSEMBLED CHEMICAL WEAPONS ASSESSMENT
EDGEWOOD, MARYLAND

US ARMY ENGINEERING AND SUPPORT CENTER, HUNTSVILLE
HUNTSVILLE, ALABAMA

BLUE GRASS CHEMICAL AGENT DESTRUCTION PILOT PLANT PROJECT (BGCAPP)
RICHMOND, KENTUCKY
DAAA09-03-D-0023

SCWO PROCESSING BUILDING TRAIN 1 TOC SAMPLER ANALYZER PIPING & INSTRUMENT DIAGRAM

CONTRACT NO. []
DRAWING NUMBER 24915-10-M6-SCWO-01019
SHEET 1 of 1
REV 4

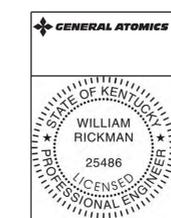


10MS-CWO-01019.ppt 07/27/12

MX-SCWO-2030
SCWO REACTOR 2 MODULE
MV-SCWO-2030
SCWO REACTOR
WORKING VOLUME : 3.2 CU FT
DESIGN PRESSURE : 4.300 PSIG
DESIGN TEMPERATURE : 1400 °F NOTE 25
MATERIAL OF CONST : REACTOR: C276
LINER: TITANIUM GRADE 2
TRIM : TRIM-0916-0-XD6-HC
ASME CODE STAMPED VESSEL

GENERAL NOTES:

- FOR SYMBOLS AND LEGEND, SEE DRAWINGS
- 24915-00-M6-00-00010
24915-00-M6-00-00011
24915-00-M6-00-00012
24915-00-M6-00-00013
24915-00-M6-00-00014
24915-00-M6-00-00015
- FIRST CHECK VALVE PROVIDED WITH SOFT SEAT. SECOND CHECK VALVE PROVIDED WITH HARD SEAT, EXCEPT FOR HOT SERVICES WHERE ONLY HARD SEATS ARE PROVIDED.
- THE FOLLOWING VALVE(S) ARE NORMALLY CLOSED:
XV-9190B--
- HP RELIEF AND REACTOR BLOWDOWN PIPING TO BE ADEQUATELY ANCHORED, SLOPED TOWARDS EMERGENCY RELIEF TANK, AND WITH NO POCKETS.
- INTERCONNECTING PIPING BY GA, IPA AND HYDROLYSATE PIPING IS ALL WELDED TO MAXIMUM EXTENT POSSIBLE. HPF-0200-3/8"-XHT SHALL BE DOUBLE CONTAINED WITHIN A 3/4" PIPE (MIN) XSA SHALL BE THIS PIPE'S DESIGNATION.
- ELECTRICAL AREA CLASSIFICATION:
CLASS 1, DIVISION 2, GROUP D.
- CONTROL PANELS ARE TO BE LOCATED OFF-BOARD FROM THE MODULE IN AN UNCLASSIFIED (NON-HAZARD) AREA.
- SYSTEM SHUTDOWN UPON OPENING OF CLASSIFIED COMPARTMENT DOOR (AFTER SPECIFIED TIME DELAY).
- GLOBE VALVE IS TO BE LOCATED ADJACENT TO THE CORIOLIS FLOW METER.
- HIGH PRESSURE SERVICE PIPING IN BETWEEN SKIDS SHALL BE PROVIDED WITH ADDITIONAL SHIELDING AND ROUTED TO MINIMIZE OPERATOR EXPOSURE TO POTENTIAL FUEL OR FITTING LEAKS. USE WELDED CONSTRUCTION TO MAXIMUM PRACTICAL EXTENT IN THE HIGH PRESSURE PIPING AND IN BETWEEN THE SCWO SKIDS. ADDITIONAL SHIELDING TO BE ADDED WHEN PIPING IS INSTALLED AT BGCAPP.
- PROVIDE PROTECTION AROUND HIGH PRESSURE FUEL VALVES, FLANGES, AND FITTINGS TO PREVENT POTENTIAL IGNITION AT EXPOSED SURFACE. PROVIDE CONTAINMENT AROUND EXPOSED HIGH PRESSURE FUEL PIPING AND TUBING.
- DEDICATED VENTILATION OF ELECTRICAL CLASSIFICATION AREA (I.E. CLASS 1, DIVISION 2, GROUP D) IS REQUIRED TO PREVENT CROSS-VENTILATION OF POTENTIAL HAZARDOUS FUEL (IPA) VAPORS INTO UNCLASSIFIED AREAS.
- Ⓢ DENOTES DESIGN RESPONSIBILITY LABEL.
- THE FOLLOWING VALVES ARE TO BE SPECIFIED AS FAST CLOSING (< 1.0 SEC. VENDOR TO VERIFY):
XV-9387B--
XV-9222B--
XV-9390B--
XV-9390B--
XV-9394B--
XV-9198B--
- REACTOR FEED NOZZLE TO BE REMOVED (I.E. AFTER SYSTEM DEPRESSURIZATION, LOCK-OUT, TAG-OUT, ETC.) FOR VALVE MAINTENANCE WITH TEMPORARY BLIND FLANGES ADDED AS REQUIRED FOR SAFETY PURPOSES FOR XV-9387B--, XV-9222B--, XV-9389B-- AND XV-9390B--.
- XV-9190B-- TO OPEN UPON TSHH-9186B-- HIGH HIGH ALARM.
- FINAL ROUTING OF HEADER TO CONFORM TO EQUIPMENT LAYOUT.
- REACTOR COMPONENTS SHALL BE DESIGNED FOR PROCESS TEMPERATURES OF 1200°F (OPERATING), 1250°F (MAX. OPERATING), AND 1400°F (DESIGN).
- FPS TRAIN SHUTDOWN SWITCH LOCATED IN SPB LOCAL CONTROL ROOM.
- FUEL PIPING IS ALL WELDED TO MAXIMUM PRACTICAL EXTENT.
- TE-9186BAA, BAB, AND BB- ARE LOCATED OUTSIDE OF THE ELECTRICALLY CLASSIFIED AREA.
- NOTES 4, 5, 8, 9, 10, 12, 20, 26, 29 AND 30 ARE DELETED.

APPROVED
By Ron Rhea at 4:01 pm, Mar 10, 2014
This document has been reviewed for ITR/EAR and no ITR/EAR sensitive information was found.

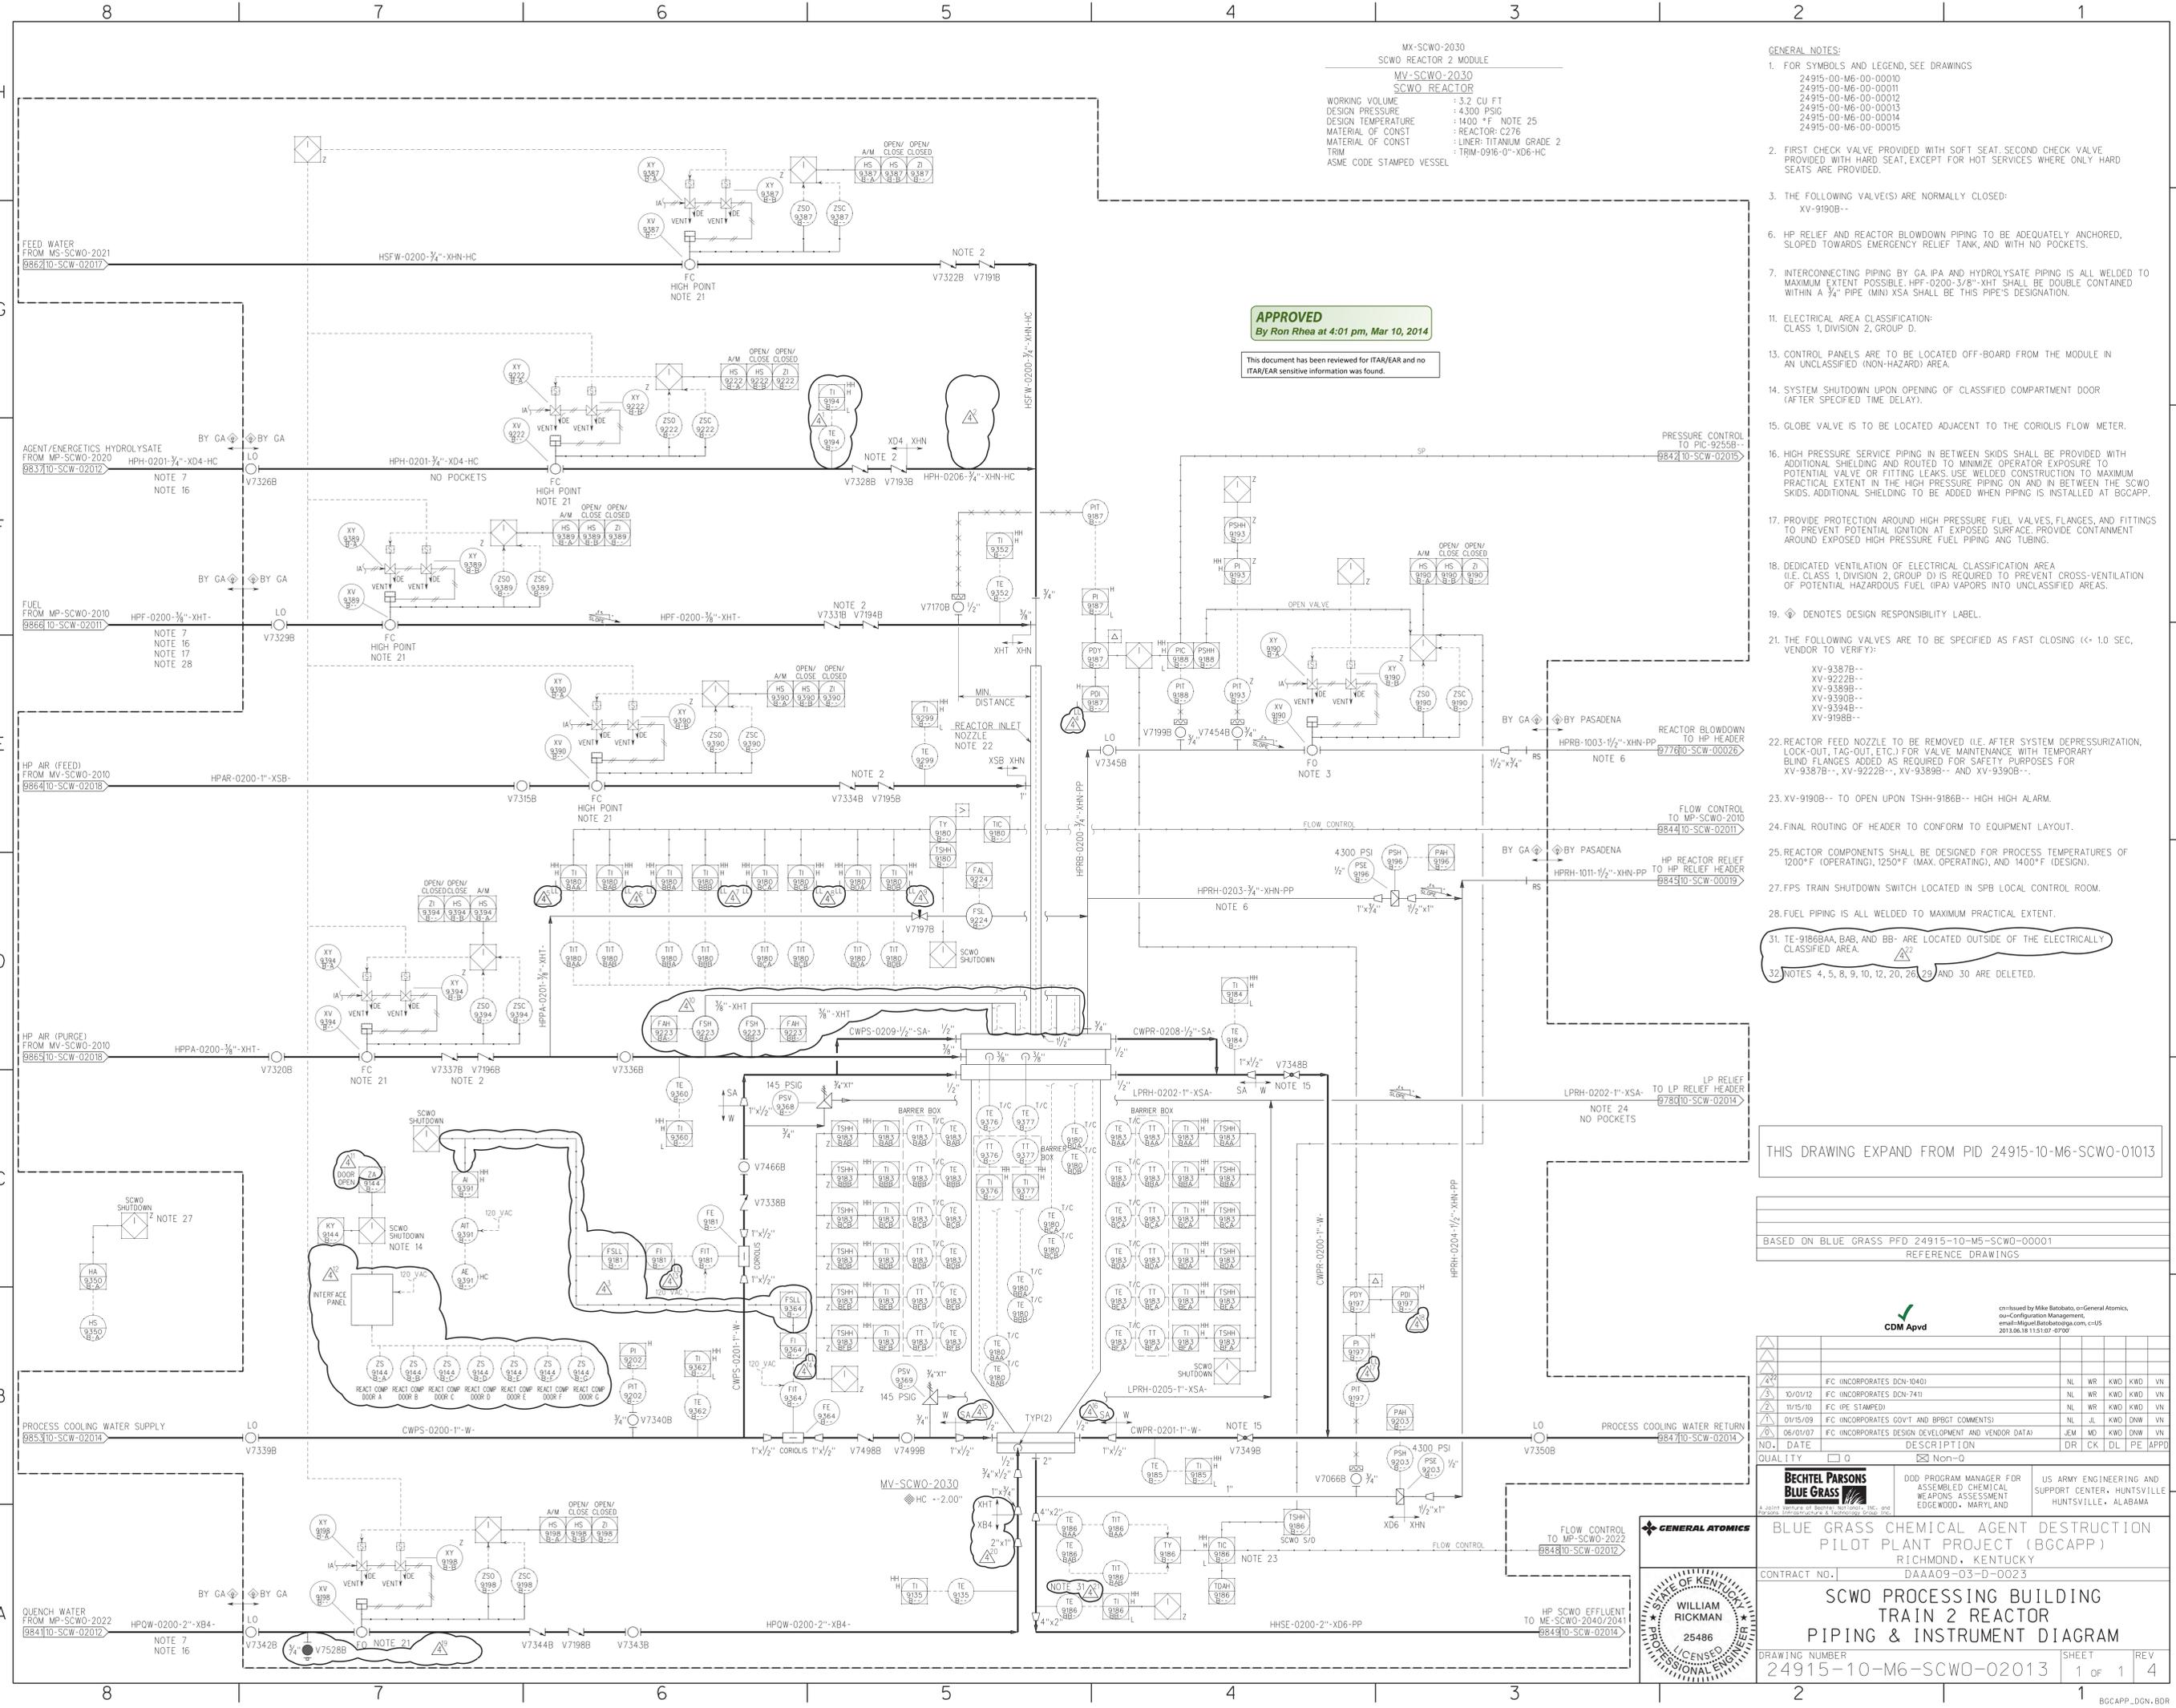

THIS DRAWING EXPAND FROM PID 24915-10-M6-SCWO-01013

BASED ON BLUE GRASS PFD 24915-10-M5-SCWO-00001
REFERENCE DRAWINGS

NO.	DATE	DESCRIPTION	DR	CK	DL	PE	APPD
1	06/01/07	FC INCORPORATES DESIGN DEVELOPMENT AND VENDOR DATA	JEM	MD	KWD	DNW	YN
2	09/15/09	FC INCORPORATES GOVT AND BPBGT COMMENTS	NL	JL	KWD	DNW	YN
3	11/15/10	FC (PE STAMPED)	NL	WR	KWD	KWD	YN
4	10/01/12	FC INCORPORATES DCN-7411	NL	WR	KWD	KWD	YN
5	02/01/14	FC INCORPORATES DCN-1040	NL	WR	KWD	KWD	YN

BECHTEL PARSONS BLUE GRASS
DOD PROGRAM MANAGER FOR ASSEMBLED CHEMICAL WEAPONS ASSESSMENT EDGEWOOD, MARYLAND
US ARMY ENGINEERING AND SUPPORT CENTER, HUNTSVILLE HUNTSVILLE, ALABAMA

GENERAL ATOMICS
WILLIAM RICKMAN
LICENSED PROFESSIONAL ENGINEER
25486

BLUE GRASS CHEMICAL AGENT DESTRUCTION PILOT PLANT PROJECT (BGCAPP)
RICHMOND, KENTUCKY
DAAA09-03-D-0023

SCWO PROCESSING BUILDING TRAIN 2 REACTOR PIPING & INSTRUMENT DIAGRAM

DRAWING NUMBER: 24915-10-M6-SCWO-02013
SHEET: 1 of 1
REV: 4

10mscow2015.pdf 03/15/13


MX-SCWO-2031
TOC SAMPLER ANALYZER 2 MODULE

GENERAL NOTES:

- FOR SYMBOLS AND LEGEND, SEE DRAWINGS
24915-00-M6-00-00010
24915-00-M6-00-00011
24915-00-M6-00-00012
24915-00-M6-00-00013
24915-00-M6-00-00014
24915-00-M6-00-00015
- CONTROL PANELS AND TOC SAMPLE ANALYZERS ARE TO BE LOCATED OFF-BOARD FROM THE MODULE IN UNCLASSIFIED (NON-HAZARDOUS) AREA.
- TOC ANALYZER SAMPLE PUMP(S) SHALL BE SIZED WITH HEAD GREATER THAN LIQUID EFFLUENT PUMP.
- Ⓢ DENOTES DESIGN RESPONSIBILITY LABEL.
- * DENOTES SUPPLIED BY VENDOR.
- SUMP PUMP TURNS ON UPON HIGH RESERVOIR LIQUID LEVEL. SUMP PUMP TURNS OFF UPON LOW AND LOW LOW RESERVOIR LIQUID LEVEL.
- VALVE LV-9421B-- OPENS WHEN SUMP PUMP TURNS ON AND CLOSES WHEN SUMP PUMP TURNS OFF.
- NOTE 8 IS DELETED.

APPROVED
By Ron Rhea at 4:03 pm, Mar 10, 2014

This document has been reviewed for ISTAR/EAR and no ISTAR/EAR sensitive information was found.

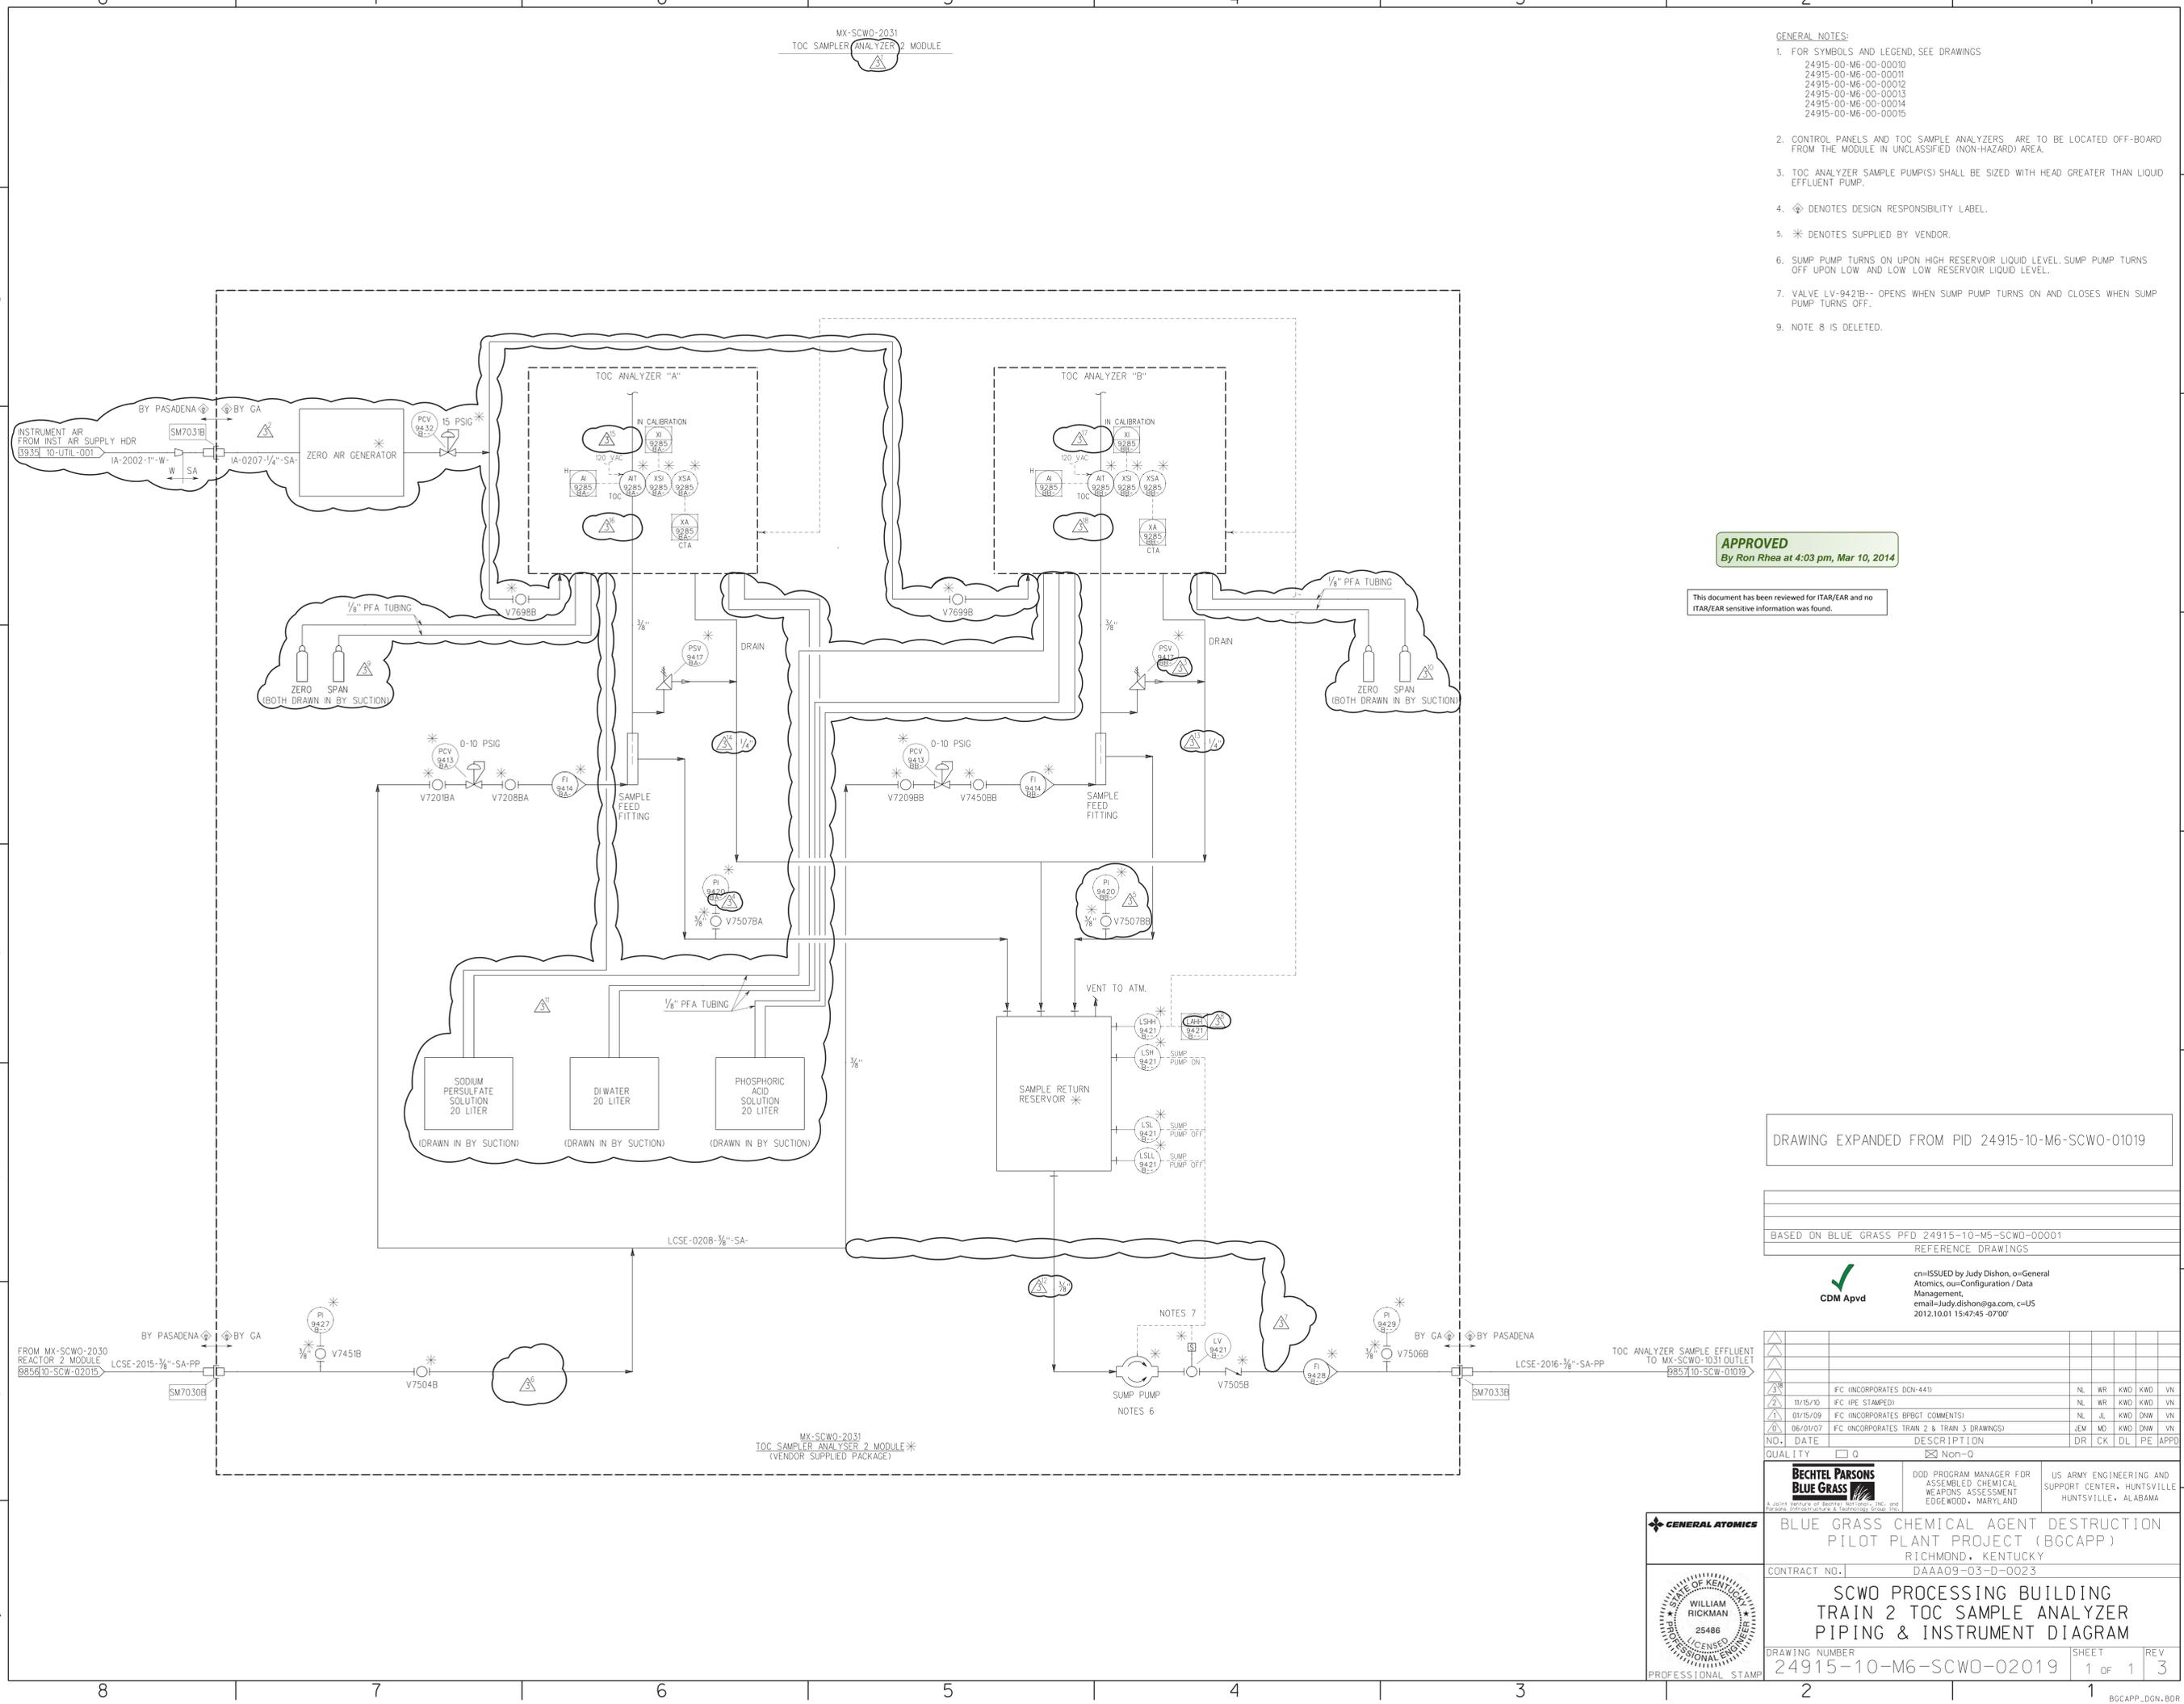

DRAWING EXPANDED FROM PID 24915-10-M6-SCWO-01019


BASED ON BLUE GRASS PFD 24915-10-M6-SCWO-00001
REFERENCE DRAWINGS

CDM Apvd
cn=ISSUED by Judy Dishon, ou=General
Atomsics, ou=Configuration / Data
Management,
email=judydishon@ga.com, c=US
2012.10.01 15:47:45 -0700'

NO.	DATE	DESCRIPTION	DR	CK	DL	PE	APPD
1	06/01/07	FC (INCORPORATES TRAIN 2 & TRAIN 3 DRAWINGS)	JEM	MD	KWD	DNN	VN
2	01/15/09	FC (INCORPORATES BFBGT COMMENTS)	NL	JL	KWD	DNN	VN
3	11/15/10	FC (PE STAMPED)	NL	WR	KWD	KWD	VN
4	11/15/10	FC (INCORPORATES DCN-441)	NL	WR	KWD	KWD	VN

QUALITY 0 Non-0

BECHTEL PARSONS BLUE GRASS	DOD PROGRAM MANAGER FOR ASSEMBLED CHEMICAL WEAPONS ASSESSMENT EDGEWOOD, MARYLAND	US ARMY ENGINEERING AND SUPPORT CENTER, HUNTSVILLE HUNTSVILLE, ALABAMA
BLUE GRASS CHEMICAL AGENT DESTRUCTION PILOT PLANT PROJECT (BGCAPP) RICHMOND, KENTUCKY DAAA09-03-D-0023		
CONTRACT NO.		
SCWO PROCESSING BUILDING TRAIN 2 TOC SAMPLER ANALYZER PIPING & INSTRUMENT DIAGRAM		
DRAWING NUMBER 24915-10-M6-SCWO-02019	SHEET 1 of 1	REV 3

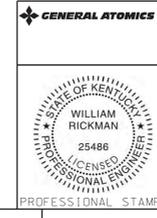

10MS-CWO-2019.ppt 07/27/12

MX-SCWO-3020
SCWO REACTOR 3 FEED MODULE

MP-SCWO-3020
HP HYDROLYSATE FEED PUMP
RATED FLOW : 1.7 / 3.5 GPM
RATED DELTA P : 4300 PSI
MOTOR HP : 20 HP
MATERIAL OF CONST : PTFE AND C-276/TISS

MP-SCWO-3022
QUENCH WATER PUMP
RATED FLOW : 3 / 33 GPM
RATED DELTA P : 4300 PSI
MOTOR HP : 125 HP
MATERIAL OF CONST : 316/316L

- GENERAL NOTES:
- FOR SYMBOLS AND LEGEND, SEE DRAWINGS
24915-00-M6-00-00010
24915-00-M6-00-00011
24915-00-M6-00-00012
24915-00-M6-00-00013
24915-00-M6-00-00014
24915-00-M6-00-00015
 - THE FOLLOWING VALVES ARE NORMALLY CLOSED:
XV-9143C--
XV-9176C--
 - HP RELIEF PIPING TO BE ADEQUATELY ANCHORED, SLOPED TOWARDS EMERGENCY RELIEF TANK OR BLEND TANK, AND WITH NO POCKETS.
 - INTERCONNECTING PIPING BY GA.
 - ELECTRICAL AREA CLASSIFICATION:
UNCLASSIFIED (PER DIRECTION FROM GOVERNMENT 5/4/06 CORRESPONDENCE)
 - PROGRAM AN INTERLOCK FOR XV-9148C-- TO ENSURE THAT IT CANNOT BE OPENED WHILE XV-9147C-- IS OPEN.
 - SHUT-OFF HP PUMP (HYDROLYSATE OR QUENCH WATER) UPON LOW-LOW ALARM WHEN PUMP IS RUNNING.
 - HIGH PRESSURE SERVICE PIPING IN BETWEEN SKIDS SHALL BE PROVIDED WITH ADDITIONAL SHIELDING AND ROUTED TO MINIMIZE OPERATOR EXPOSURE TO POTENTIAL VALVE OR FITTING LEAKS. USE WELDED CONSTRUCTION TO MAXIMUM PRACTICAL EXTENT IN THE HIGH PRESSURE PIPING ON AND IN BETWEEN THE SCWO SKIDS. ADDITIONAL SHIELDING TO BE ADDED WHEN PIPING IS INSTALLED AT BGCAPP.
 - Ⓢ DENOTES DESIGN RESPONSIBILITY LABEL.
 - FLOW CHECK VALVE TO BE OPERATED AT LOW PRESSURE (i.e. PRESSURES ~ 30 PSIG OR LESS)
 - VFD TO BE PROVIDED BY PASADENA.
 - PROGRAM AN INTERLOCK BETWEEN XV-9143C-- AND XV-9222C-- (SEE SCWO PID - 03013) TO ENSURE BOTH VALVES ARE NOT OPEN AT THE SAME TIME.
 - PROGRAM AN INTERLOCK BETWEEN XV-9176C-- AND XV-9198C-- (SEE SCWO PID - 03013) TO ENSURE BOTH VALVES ARE NOT OPEN AT THE SAME TIME.
 - * DENOTES SUPPLIED BY VENDOR.
 - PCV-9175C-- SETPOINT IS FOR PUMP CALIBRATION ONLY. SETPOINT TO BE ADJUSTED DOWN FOR OPERATION TO ALLOW PUMP RE-START AT NO LOAD.
 - RELIEVE INTO QUENCH PUMP DRIP PAN.
 - NOTES 6, 8, 9, 10, 11, 12, 16, 21, 23, 24, 25, 26 AND 27 ARE DELETED.

APPROVED
By Ron Rhea at 4:03 pm, Mar 10, 2014

This document has been reviewed for ITR/EAR and no ITR/EAR sensitive information was found.

DRAWING EXPANDED FROM PID 24915-10-M6-SCWO-01012

BASED ON BLUE GRASS PFD 24915-10-M5-SCWO-00001
REFERENCE DRAWINGS

CDM Apvd
Issued by Mike Batobato, o=General Atomics, ou=Configuration Management, email=Miguel.Batobato@ga.com, c=US 2013.06.18 13:11:00 -0700

NO.	DATE	DESCRIPTION	DR	CK	DL	PE	APPD
1	09/06/12	FC (INCORPORATES DCN-1040)	NL	WR	KWD	KWD	VN
2	11/15/10	FC (INCORPORATES DCN-741)	NL	WR	KWD	KWD	VN
3	01/15/09	FC (INCORPORATES BPGT COMMENTS)	NL	JL	KWD	DNN	VN
4	06/01/07	FC (INCORPORATES TRAIN 2 & TRAIN 3 DRAWINGS)	JEM	MD	KWD	DNN	VN


BECHTEL PARSONS
BLUE GRASS CHEMICAL AGENT DESTRUCTION PILOT PLANT PROJECT (BGCAPP)
RICHMOND, KENTUCKY
DAAA09-03-D-0023

SCWO PROCESSING BUILDING
TRAIN 3 QUENCH WATER AND HYDROL FEED PIPING & INSTRUMENT DIAGRAM

CONTRACT NO. 24915-10-M6-SCWO-03012
DRAWING NUMBER 1 of 1
SHEET 1 of 4
REV 4

US ARMY ENGINEERING AND SUPPORT CENTER, HUNTSVILLE, ALABAMA


GENERAL ATOMICS
WILLIAM RICKMAN
25486
LICENSED PROFESSIONAL ENGINEER

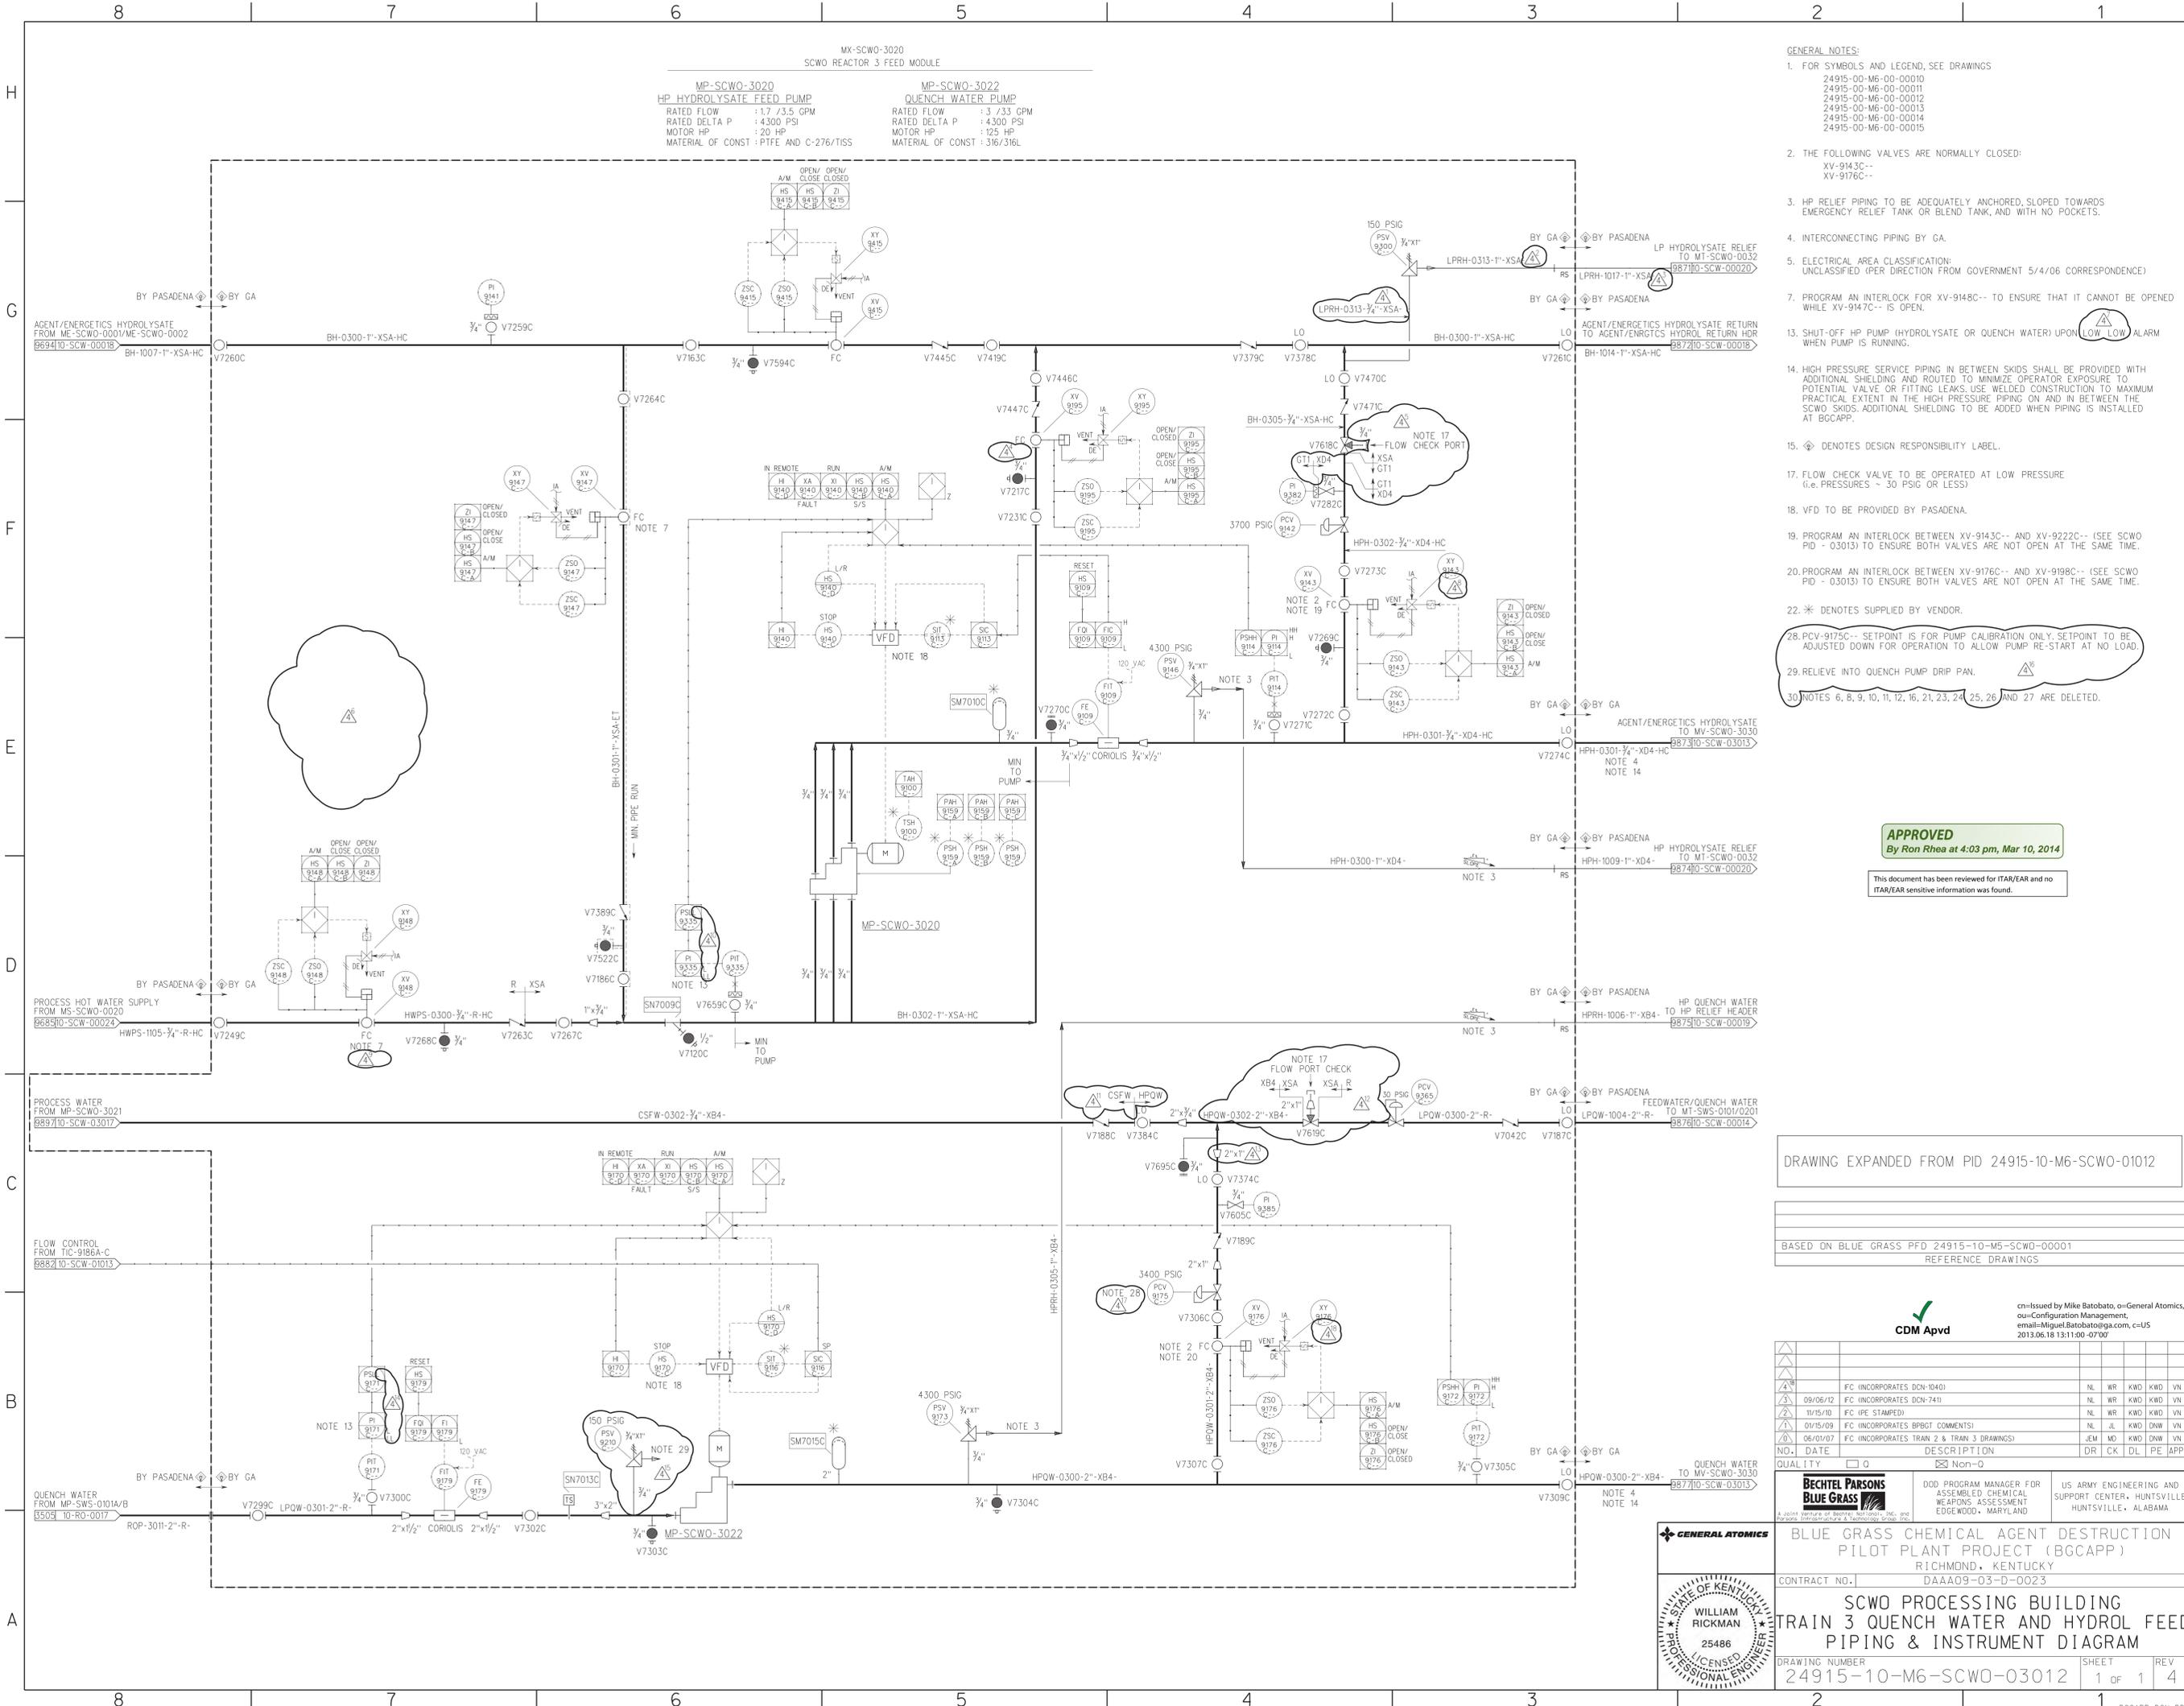

10mscwo3020.pfd 03/15/13

10mscwo3020.pfd 3/15/2013 8:35:10 AM

BGCAPP_DGN_BDR

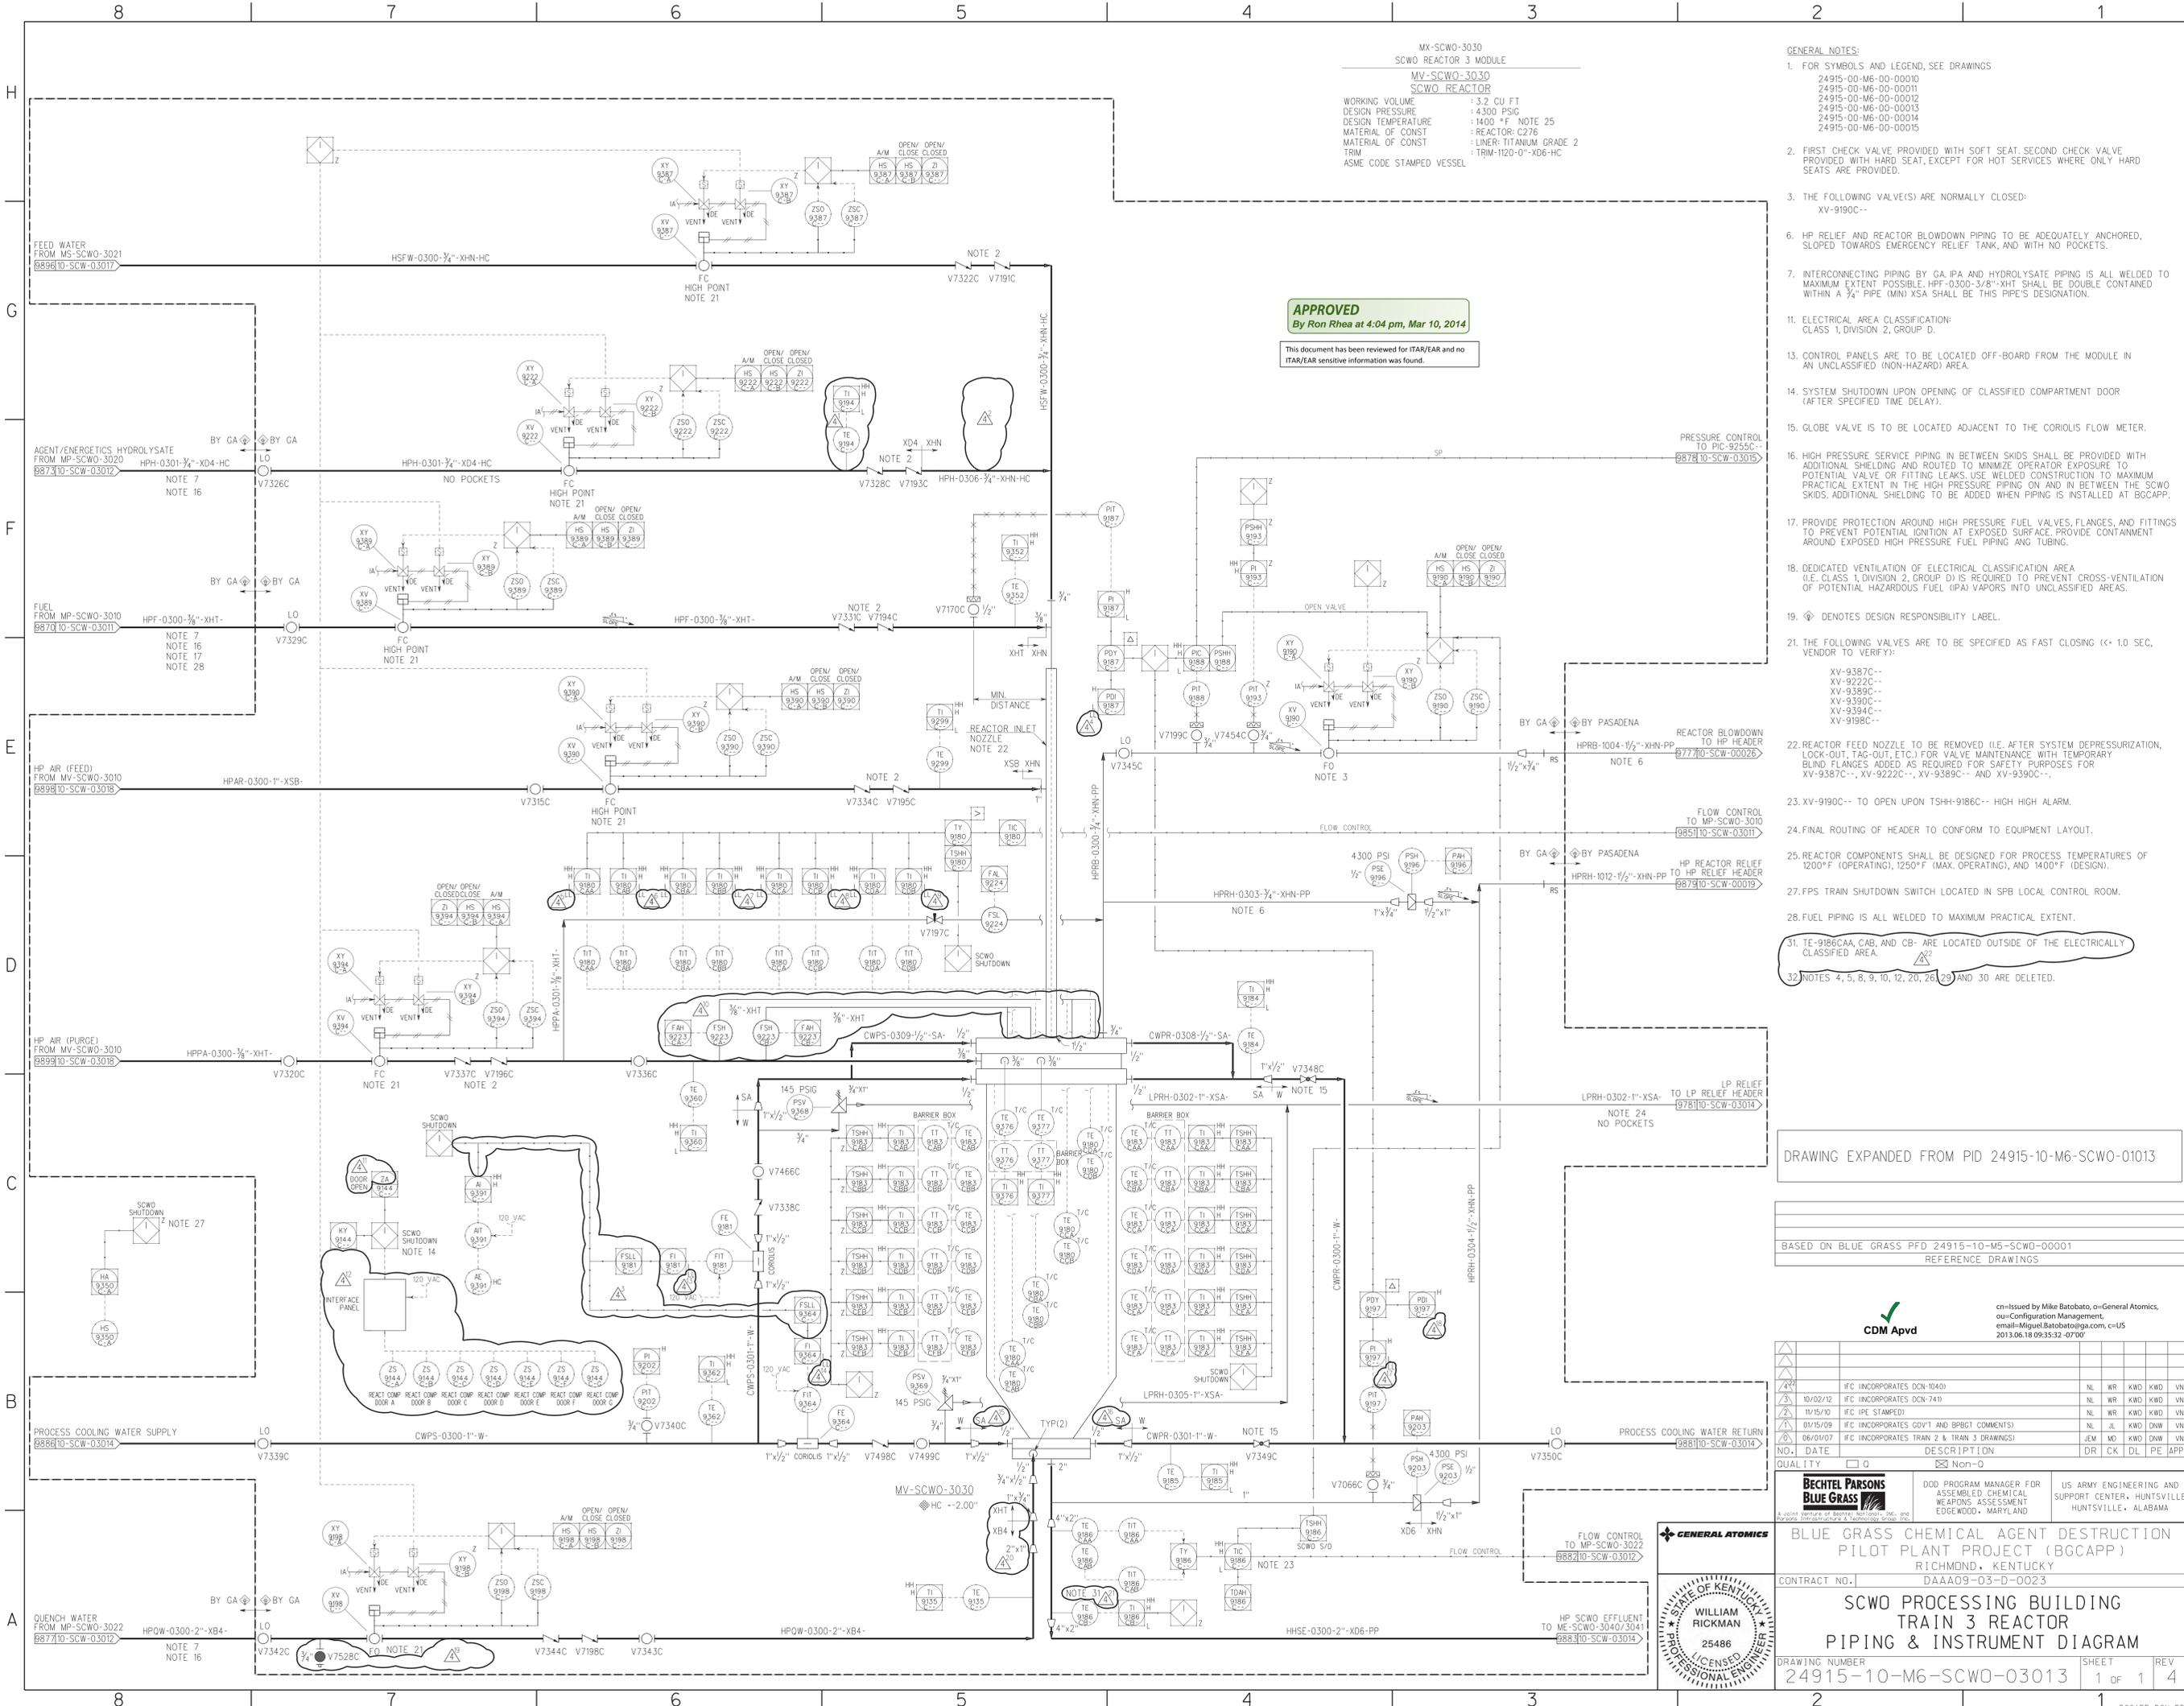

MX-SCWO-3030
 SCWO REACTOR 3 MODULE
 MV-SCWO-3030
 SCWO REACTOR
 WORKING VOLUME : 3.2 CU FT
 DESIGN PRESSURE : 4.300 PSIG
 DESIGN TEMPERATURE : 1400 °F NOTE 25
 MATERIAL OF CONST : REACTOR: C276
 LNER: TITANIUM GRADE 2
 TRIM : TRIM-1120-01-XD6-HC
 ASME CODE STAMPED VESSEL

APPROVED
 By Ron Rhea at 4:04 pm, Mar 10, 2014
 This document has been reviewed for ITR/EAR and no ITR/EAR sensitive information was found.

- GENERAL NOTES:**
- FOR SYMBOLS AND LEGEND, SEE DRAWINGS
 - FIRST CHECK VALVE PROVIDED WITH SOFT SEAT, SECOND CHECK VALVE PROVIDED WITH HARD SEAT, EXCEPT FOR HOT SERVICES WHERE ONLY HARD SEATS ARE PROVIDED.
 - THE FOLLOWING VALVE(S) ARE NORMALLY CLOSED:
XV-9190C--
 - HP RELIEF AND REACTOR BLOWDOWN PIPING TO BE ADEQUATELY ANCHORED, SLOPED TOWARDS EMERGENCY RELIEF TANK, AND WITH NO POCKETS.
 - INTERCONNECTING PIPING BY GA, IPA AND HYDROLYSATE PIPING IS ALL WELDED TO MAXIMUM EXTENT POSSIBLE. HPF-0300-3/8"-XHT SHALL BE DOUBLE CONTAINED WITHIN A 3/4" PIPE (MIN) XSA SHALL BE THIS PIPE'S DESIGNATION.
 - ELECTRICAL AREA CLASSIFICATION:
CLASS 1, DIVISION 2, GROUP D.
 - CONTROL PANELS ARE TO BE LOCATED OFF-BOARD FROM THE MODULE IN AN UNCLASSIFIED (NON-HAZARD) AREA.
 - SYSTEM SHUTDOWN UPON OPENING OF CLASSIFIED COMPARTMENT DOOR (AFTER SPECIFIED TIME DELAY).
 - GLOBE VALVE IS TO BE LOCATED ADJACENT TO THE CORIOLIS FLOW METER.
 - HIGH PRESSURE SERVICE PIPING IN BETWEEN SKIDS SHALL BE PROVIDED WITH ADDITIONAL SHIELDING AND ROUTED TO MINIMIZE OPERATOR EXPOSURE TO POTENTIAL VALVE OR FITTING LEAKS. USE WELDED CONSTRUCTION TO MAXIMUM PRACTICAL EXTENT IN THE HIGH PRESSURE PIPING AND IN BETWEEN THE SCWO SKIDS. ADDITIONAL SHIELDING TO BE ADDED WHEN PIPING IS INSTALLED AT BGCAPP.
 - PROVIDE PROTECTION AROUND HIGH PRESSURE FUEL VALVES, FLANGES, AND FITTINGS TO PREVENT POTENTIAL IGNITION AT EXPOSED SURFACE. PROVIDE CONTAINMENT AROUND EXPOSED HIGH PRESSURE FUEL PIPING AND TUBING.
 - DEDICATED VENTILATION OF ELECTRICAL CLASSIFICATION AREA (I.E. CLASS 1, DIVISION 2, GROUP D) IS REQUIRED TO PREVENT CROSS-VENTILATION OF POTENTIAL HAZARDOUS FUEL (IPA) VAPORS INTO UNCLASSIFIED AREAS.
 - ◇ DENOTES DESIGN RESPONSIBILITY LABEL.
 - THE FOLLOWING VALVES ARE TO BE SPECIFIED AS FAST CLOSING (< 1.0 SEC. VENDOR TO VERIFY):
XV-9387C--
XV-9222C--
XV-9390C--
XV-9394C--
XV-9198C--
 - REACTOR FEED NOZZLE TO BE REMOVED (I.E. AFTER SYSTEM DEPRESSURIZATION, LOCK-OUT, TAG-OUT, ETC.) FOR VALVE MAINTENANCE WITH TEMPORARY BLIND FLANGES ADDED AS REQUIRED FOR SAFETY PURPOSES FOR XV-9387C--, XV-9222C--, XV-9389C-- AND XV-9390C--.
 - XV-9190C-- TO OPEN UPON TSSH-9186C-- HIGH HIGH ALARM.
 - FINAL ROUTING OF HEADER TO CONFORM TO EQUIPMENT LAYOUT.
 - REACTOR COMPONENTS SHALL BE DESIGNED FOR PROCESS TEMPERATURES OF 1200°F (OPERATING), 1250°F (MAX. OPERATING), AND 1400°F (DESIGN).
 - FPS TRAIN SHUTDOWN SWITCH LOCATED IN SPB LOCAL CONTROL ROOM.
 - FUEL PIPING IS ALL WELDED TO MAXIMUM PRACTICAL EXTENT.
 - TE-9186CAA, CAB, AND CB- ARE LOCATED OUTSIDE OF THE ELECTRICALLY CLASSIFIED AREA.
 - NOTES 4, 5, 8, 9, 10, 12, 20, 26, 29 AND 30 ARE DELETED.

DRAWING EXPANDED FROM PID 24915-10-M6-SCWO-01013

BASED ON BLUE GRASS PFD 24915-10-M5-SCWO-00001
 REFERENCE DRAWINGS

NO.	DATE	DESCRIPTION	DR	CK	DL	PE	APPD
1							
2							
QUALITY 0 Non-0

BECHTEL PARSONS BLUE GRASS
 DOD PROGRAM MANAGER FOR ASSEMBLED CHEMICAL WEAPONS ASSESSMENT EDGEWOOD, MARYLAND
 US ARMY ENGINEERING AND SUPPORT CENTER, HUNTSVILLE HUNTSVILLE, ALABAMA

GENERAL ATOMICS
 WILLIAM RICKMAN
 LICENSED PROFESSIONAL ENGINEER
 25486

BLUE GRASS CHEMICAL AGENT DESTRUCTION PILOT PLANT PROJECT (BGCAPP)
 RICHMOND, KENTUCKY
 DAAA09-03-D-0023
SCWO PROCESSING BUILDING TRAIN 3 REACTOR PIPING & INSTRUMENT DIAGRAM
 DRAWING NUMBER: 24915-10-M6-SCWO-03013 SHEET: 1 of 1 REV: 4


10mscwo3013.pdf 03/15/13

MX-SCWO-3030 SCWO-REACTOR 3 MODULE	
ME-SCWO-3040 EFFLUENT HEAT EXCHANGER 1	ME-SCWO-3041 EFFLUENT HEAT EXCHANGER 2
DUTY : 1,710,000 BTU/HR	DUTY : 1,710,000 BTU/HR
DESIGN PRESS (SHELL) : 150 PSIG	DESIGN PRESS (SHELL) : 150 PSIG
DESIGN TEMP (SHELL) : 185 °F	DESIGN TEMP (SHELL) : 185 °F
DESIGN PRESS (TUBE) : 4,300 PSIG	DESIGN PRESS (TUBE) : 4,300 PSIG
DESIGN TEMP (TUBE) : 750 °F	DESIGN TEMP (TUBE) : 750 °F
MATERIAL OF CONST (SHELL) : CARBON STEEL	MATERIAL OF CONST (SHELL) : CARBON STEEL
MATERIAL OF CONST (TUBE) : C276	MATERIAL OF CONST (TUBE) : C276
TRM (SHELL) : TRM-1008-0"-W	TRM (SHELL) : TRM-1112-0"-W
TRM (TUBE) : TRM-1095-0"-XD6-PP	TRM (TUBE) : TRM-1011-0"-XD6-PP
ASME CODE STAMPED VESSEL	ASME CODE STAMPED VESSEL

- GENERAL NOTES:**
- FOR SYMBOLS AND LEGEND, SEE DRAWINGS
24915-00-M6-00-00010
24915-00-M6-00-00011
24915-00-M6-00-00012
24915-00-M6-00-00013
24915-00-M6-00-00014
24915-00-M6-00-00015
 - CONTROL PANELS ARE TO BE LOCATED OFF-BOARD FROM THE MODULE IN UNCLASSIFIED (NON-HAZARD) AREA.
 - SCWO REACTOR TO SHUT DOWN ON HIGH-HIGH COOLING WATER DISCHARGE TEMPERATURE OR HIGH-HIGH EFFLUENT TEMPERATURE.
 - Ⓢ DENOTES DESIGN RESPONSIBILITY LABEL.
 - FINAL ROUTING OF RELIEF HEADER TO CONFORM TO EQUIPMENT LAYOUT.
 - NOTES 2, 3, 4, 5, 8, 10, 12, 13, 14 AND 15 ARE DELETED.

APPROVED
By Ron Rhea at 4:04 pm, Mar 10, 2014

This document has been reviewed for ITAR/EAR and no ITAR/EAR sensitive information was found.

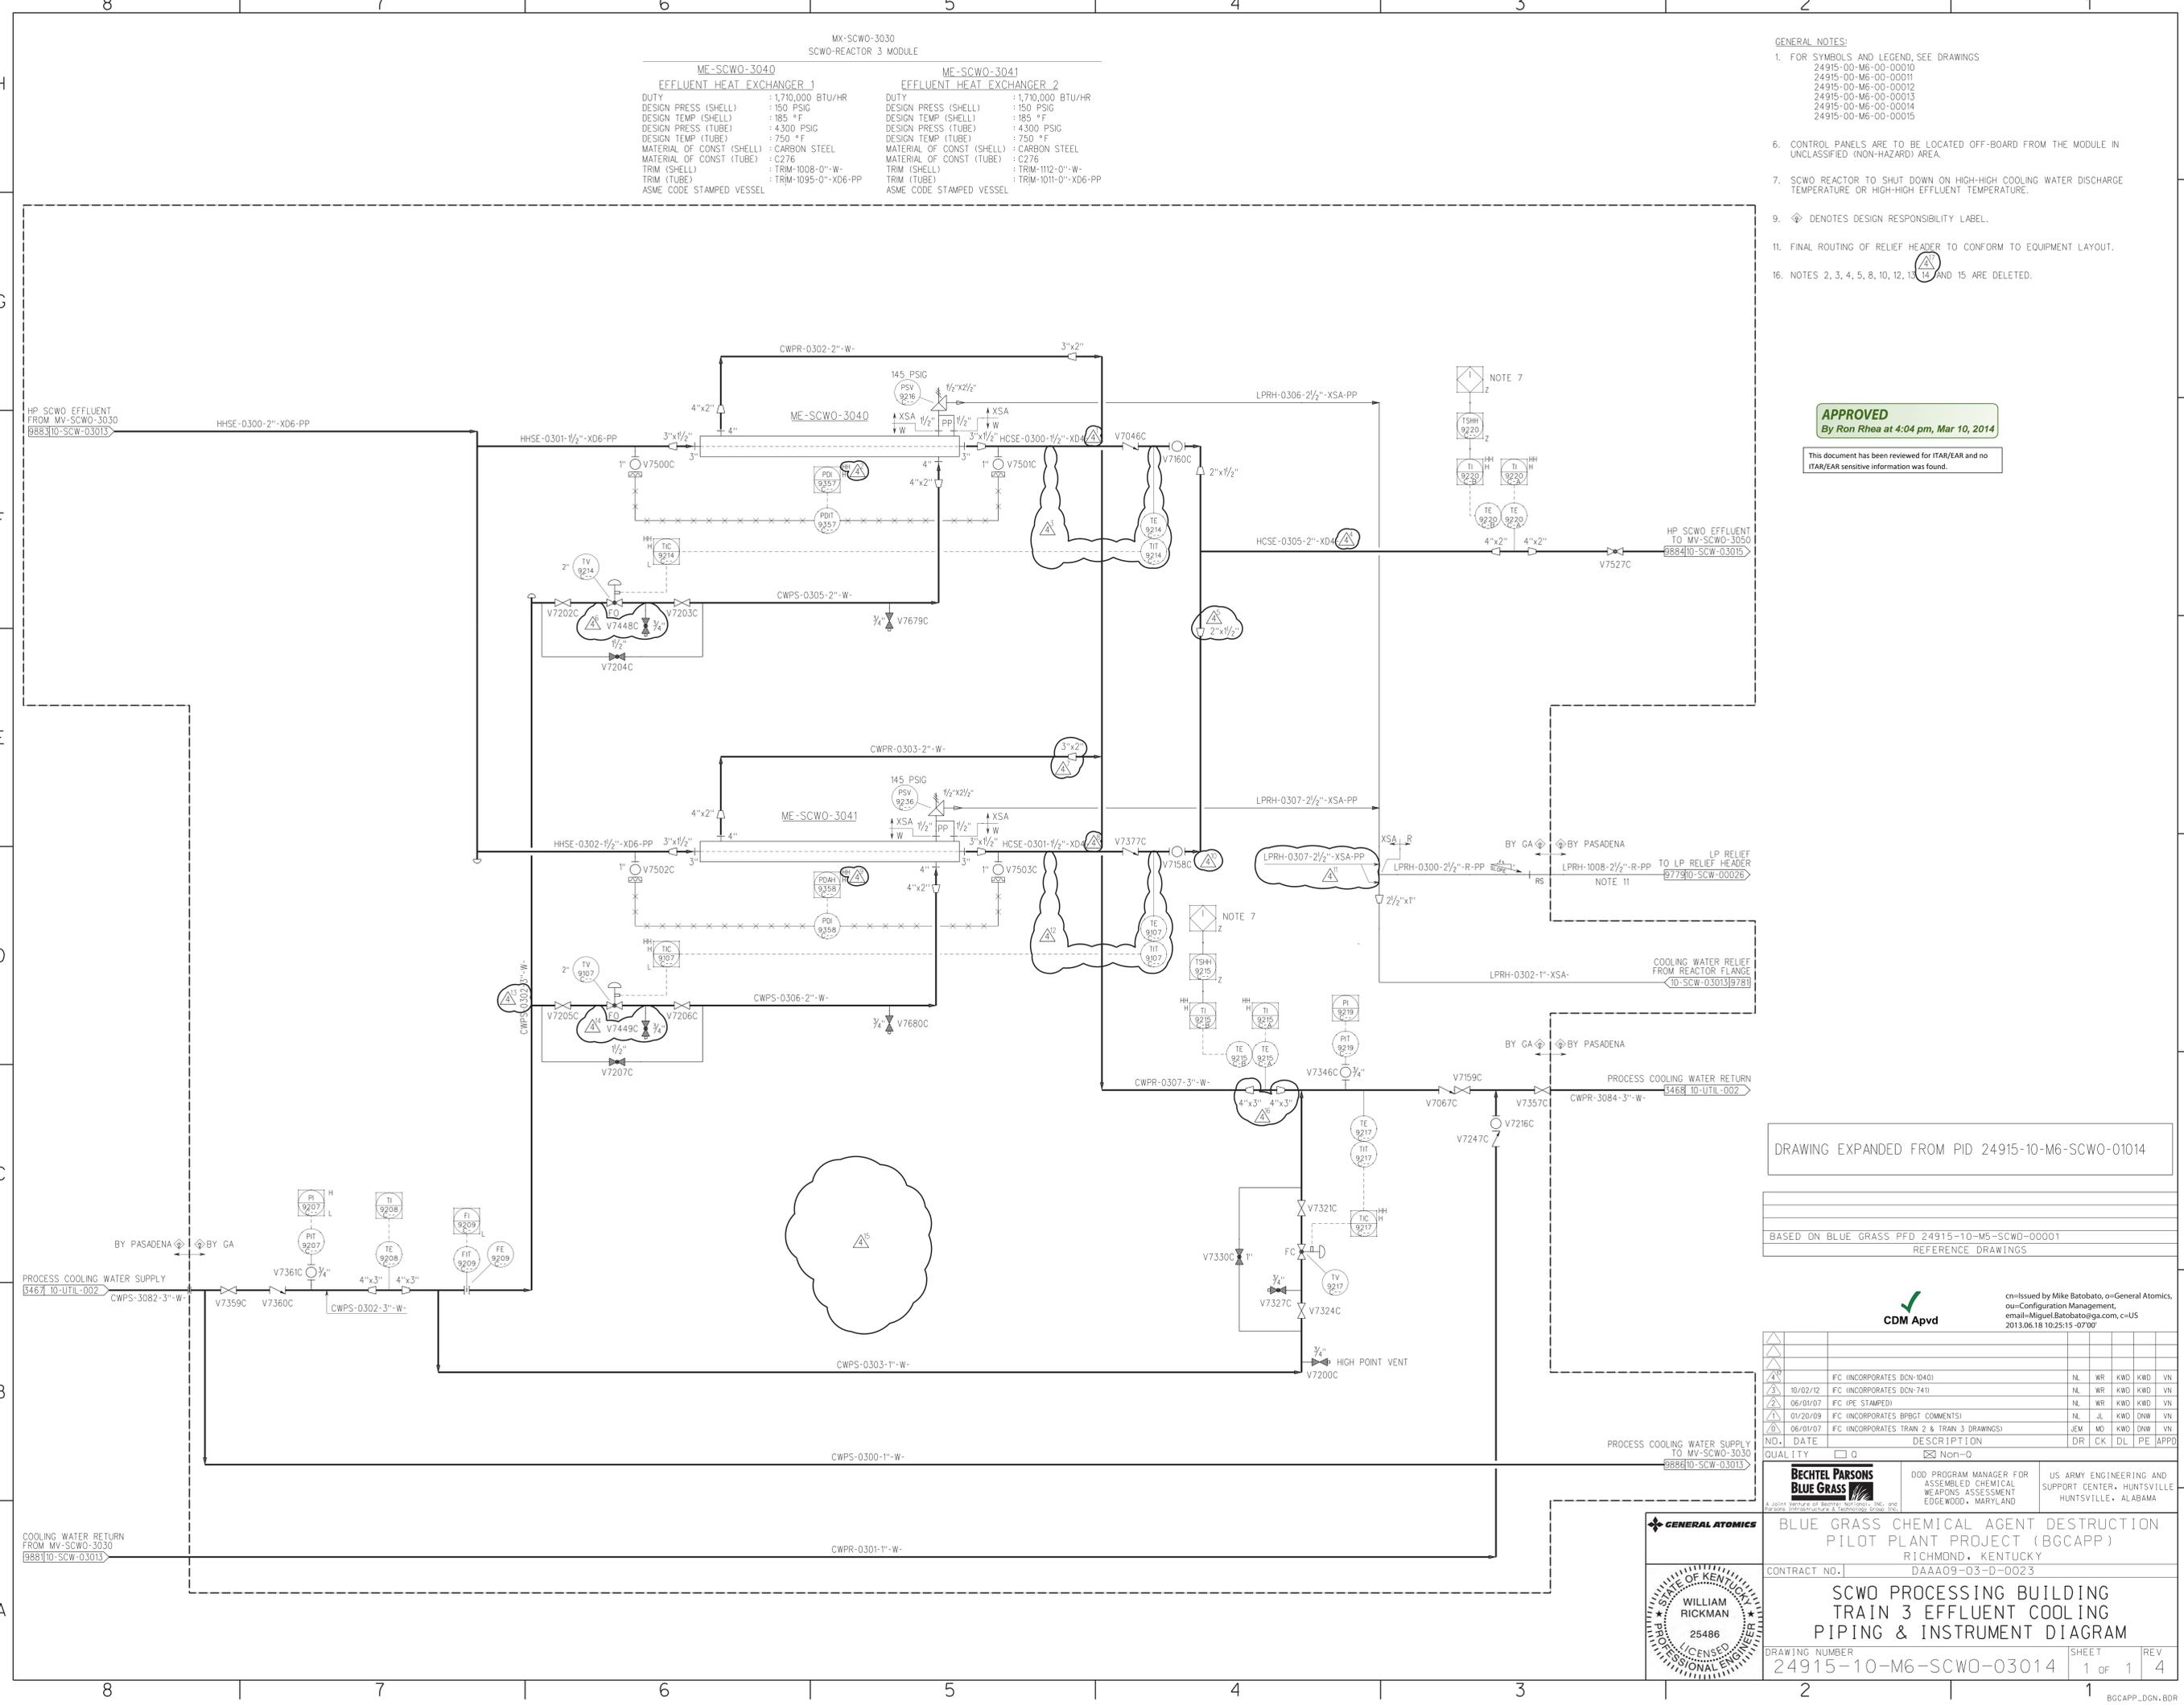

DRAWING EXPANDED FROM PID 24915-10-M6-SCWO-01014

BASED ON BLUE GRASS PFD 24915-10-M6-SCWO-00001
REFERENCE DRAWINGS

Issued by Mike Batobato, Configuration Management, email=Miguel.Batobato@ga.com, c=US 2013.06.18 10:25:15 -0700

NO.	DATE	DESCRIPTION	DR	CK	DL	PE	APPD


QUALITY Non-Q Non-Q

BECHTEL PARSONS BLUE GRASS
DOD PROGRAM MANAGER FOR ASSEMBLED CHEMICAL WEAPONS ASSESSMENT EDGEWOOD, MARYLAND
US ARMY ENGINEERING AND SUPPORT CENTER, HUNTSVILLE HUNTSVILLE, ALABAMA

BLUE GRASS CHEMICAL AGENT DESTRUCTION PILOT PLANT PROJECT (BGCAPP)
RICHMOND, KENTUCKY
DAAA09-03-D-0023

SCWO PROCESSING BUILDING TRAIN 3 EFFLUENT COOLING PIPING & INSTRUMENT DIAGRAM

DRAWING NUMBER: 24915-10-M6-SCWO-03014 SHEET: 1 of 1 REV: 4

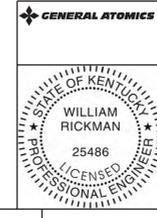

10MS-CWO-3014.ppt 03/15/13

BGCAPP_DGN_BDR


MX-SCWO-3031
TOC SAMPLER ANALYZER 3 MODULE

GENERAL NOTES:

- FOR SYMBOLS AND LEGEND, SEE DRAWINGS
24915-00-M6-00-00010
24915-00-M6-00-00011
24915-00-M6-00-00012
24915-00-M6-00-00013
24915-00-M6-00-00014
24915-00-M6-00-00015
- CONTROL PANELS AND TOC SAMPLER ANALYZERS ARE TO BE LOCATED OFF-BOARD FROM THE MODULE IN UNCLASSIFIED (NON-HAZARDOUS) AREA.
- TOC ANALYZER SAMPLE PUMP(S) SHALL BE SIZED WITH HEAD GREATER THAN LIQUID EFFLUENT PUMP.
- Ⓢ DENOTES DESIGN RESPONSIBILITY LABEL.
- * DENOTES SUPPLIED BY VENDOR.
- SUMP PUMP TURNS ON UPON HIGH RESERVOIR LIQUID LEVEL. SUMP PUMP TURNS OFF UPON LOW AND LOW LOW RESERVOIR LIQUID LEVEL.
- VALVE LV-9421C-- OPENS WHEN SUMP PUMP TURNS ON AND CLOSES WHEN SUMP PUMP TURNS OFF.
- NOTE 8 IS DELETED.

APPROVED
By Ron Rhea at 4:06 pm, Mar 10, 2014

This document has been reviewed for ITR/EAR and no ITR/EAR sensitive information was found.

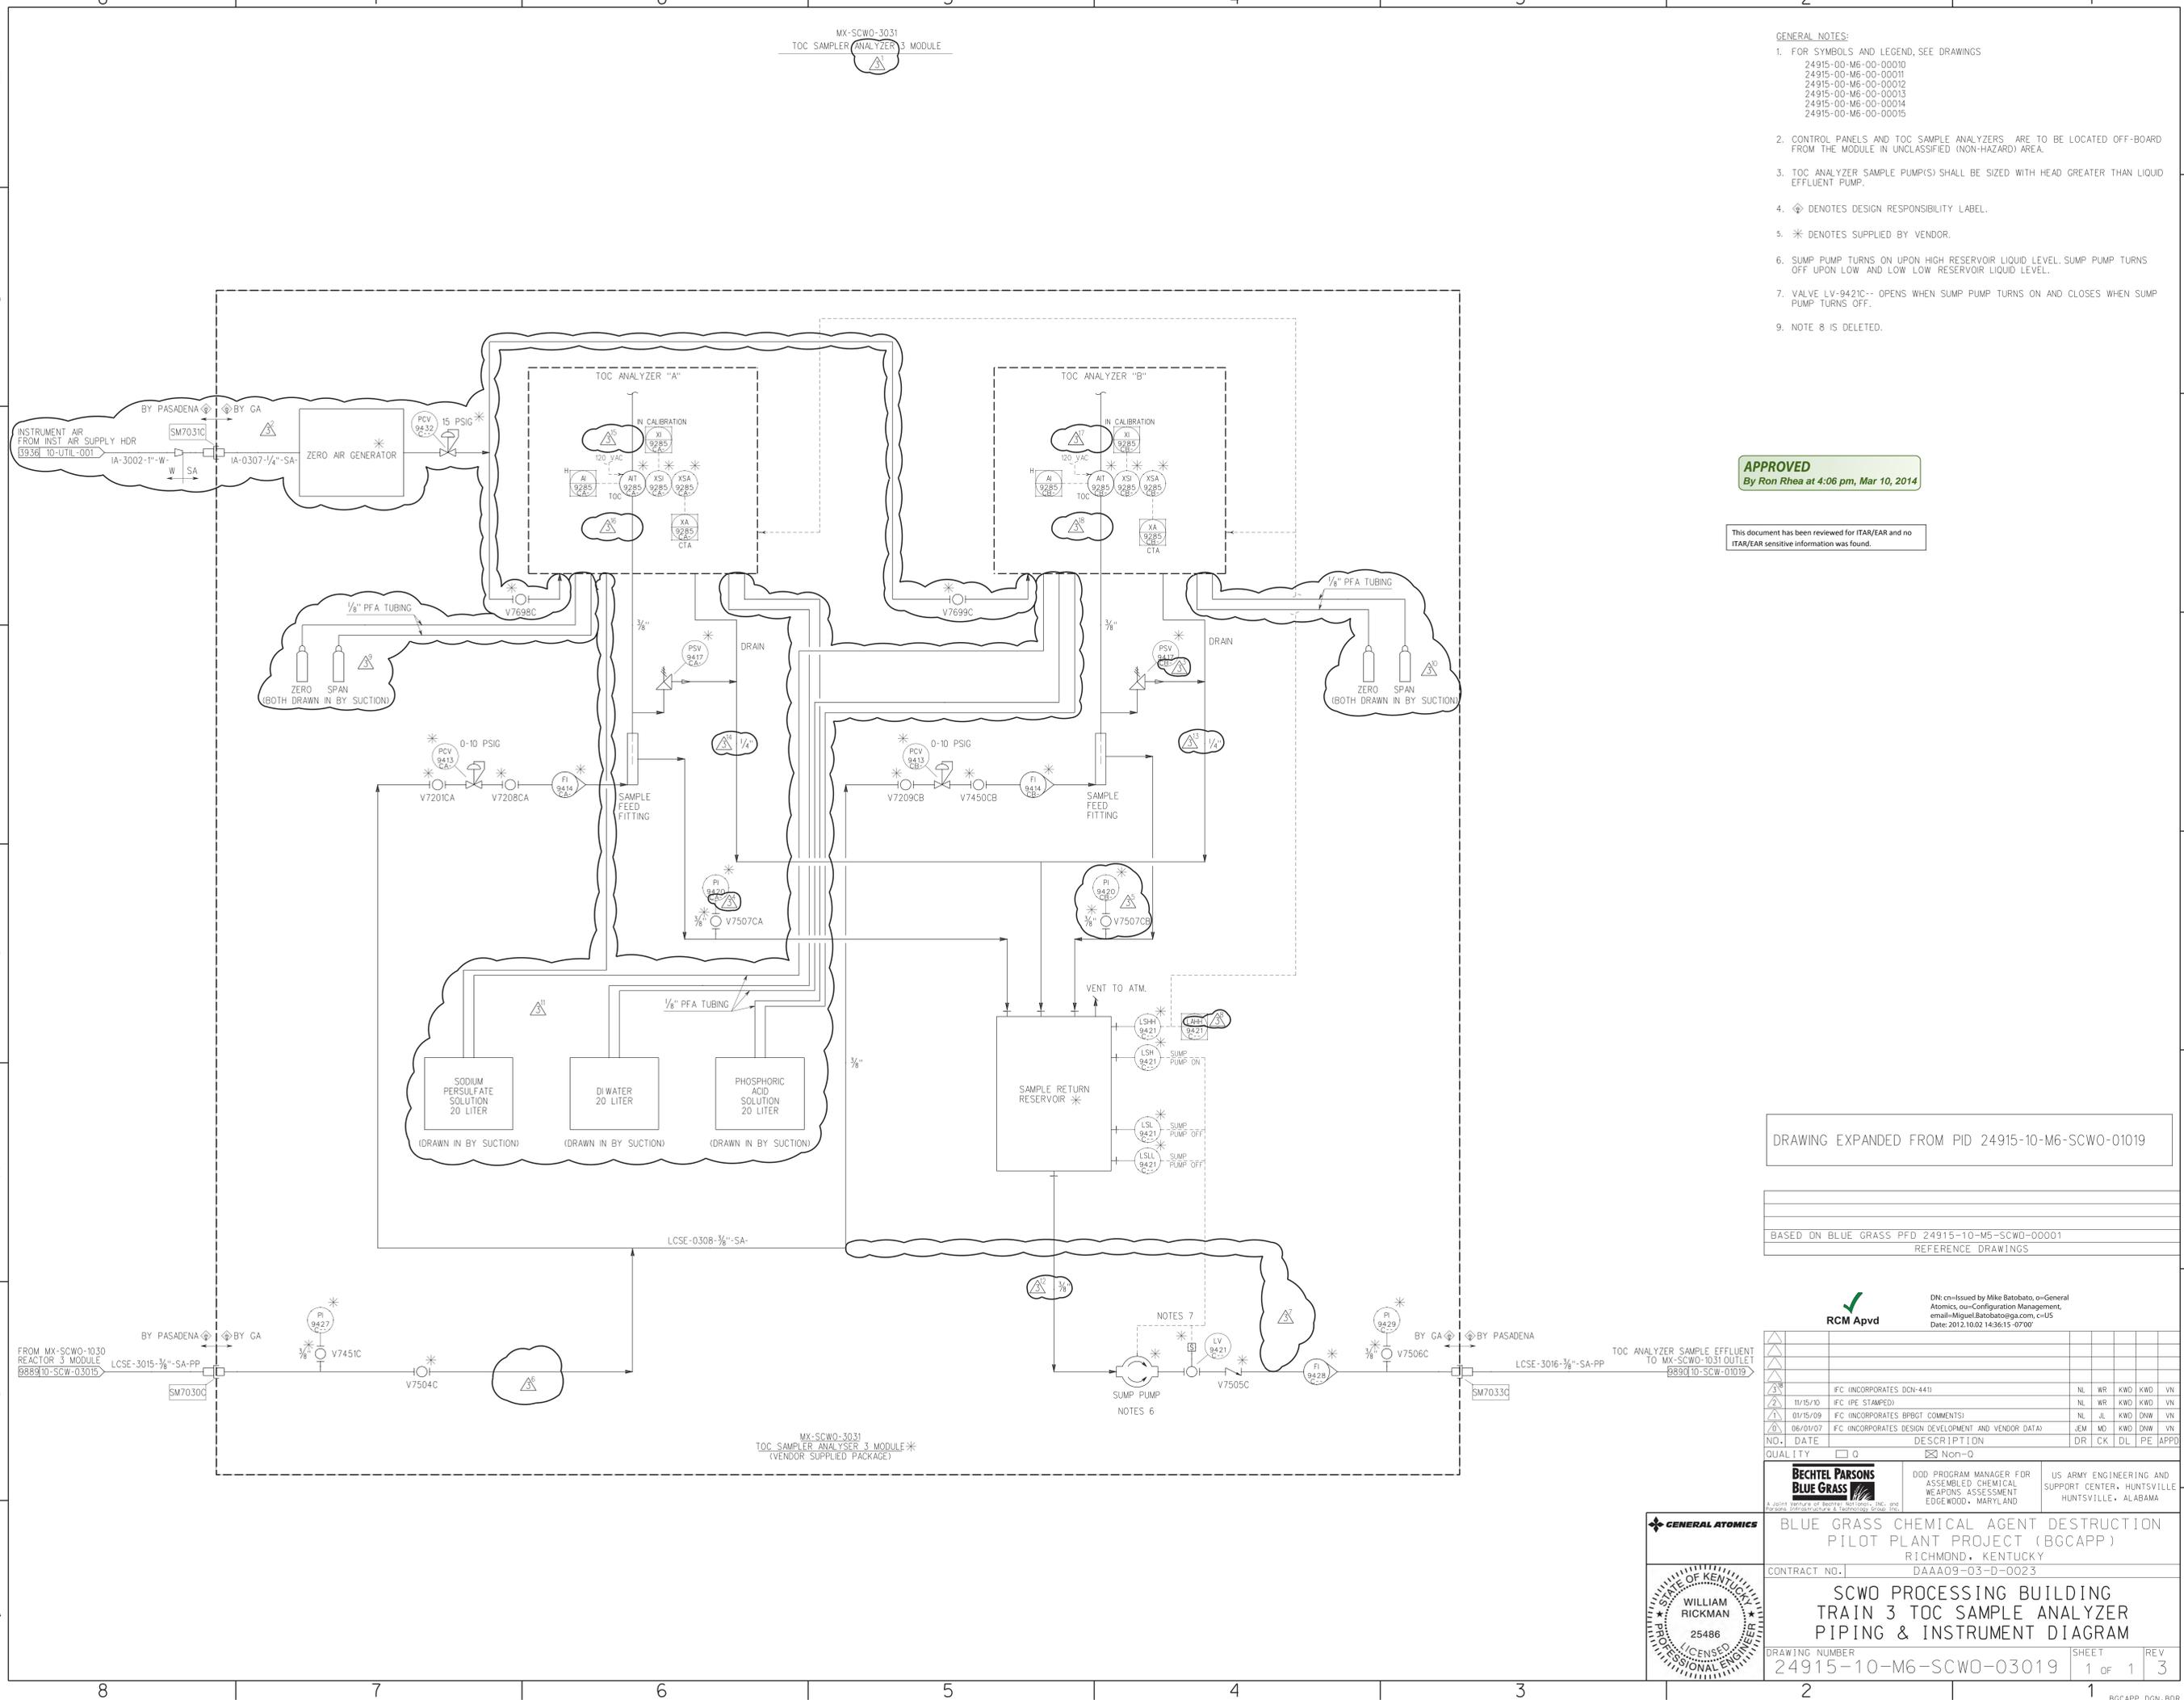


DRAWING EXPANDED FROM PID 24915-10-M6-SCWO-01019

BASED ON BLUE GRASS PFD 24915-10-M6-SCWO-00001
REFERENCE DRAWINGS

RCM Apvd
DN: cn=Issued by Mike Batobato, o=General Atomics, ou=Configuration Management, email=Miguel.Batobato@ga.com, c=US Date: 2012.10.02 14:36:15 -0700

NO.	DATE	DESCRIPTION	DR	CK	DL	PE	APPD
1	06/01/07	FC (INCORPORATES DESIGN DEVELOPMENT AND VENDOR DATA)	JEM	MD	KWD	DNW	VN
2	01/15/09	FC (INCORPORATES BFBGT COMMENTS)	NL	JL	KWD	DNW	VN
3	11/15/10	FC (IPE STAMPED)	NL	WR	KWD	DNW	VN
4		FC (INCORPORATES DCN-441)	NL	WR	KWD	DNW	VN

QUALITY 0 Non-0

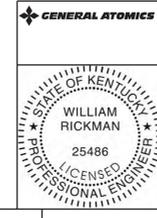

BECHTEL PARSONS BLUE GRASS
DOD PROGRAM MANAGER FOR ASSEMBLED CHEMICAL WEAPONS ASSESSMENT EDGEWOOD, MARYLAND
US ARMY ENGINEERING AND SUPPORT CENTER, HUNTSVILLE, ALABAMA

BLUE GRASS CHEMICAL AGENT DESTRUCTION PILOT PLANT PROJECT (BGCAPP)
RICHMOND, KENTUCKY
CONTRACT NO. DAAA09-03-D-0023

SCWO PROCESSING BUILDING TRAIN 3 TOC SAMPLER ANALYZER PIPING & INSTRUMENT DIAGRAM

DRAWING NUMBER: 24915-10-M6-SCWO-03019
SHEET: 1 of 1
REV: 3

10mscwo3019.pid 07/27/12